


V1 Comment:

(iii)Paving in Rural Areas. Parking areas for more than 25 cars in rural areas shall be paved with asphalt, concrete, Modular Porous Block Pavement or the equivalent. Parking lots for less than 25 cars in rural areas may use rock or gravel or other measures instead of pavement to prevent erosion or runoff of sediment and other contaminants and tracking of sediment onto paved roadways. Any access to a paved County-maintained road shall be paved for a distance of at least 50 feet from the paved County road.

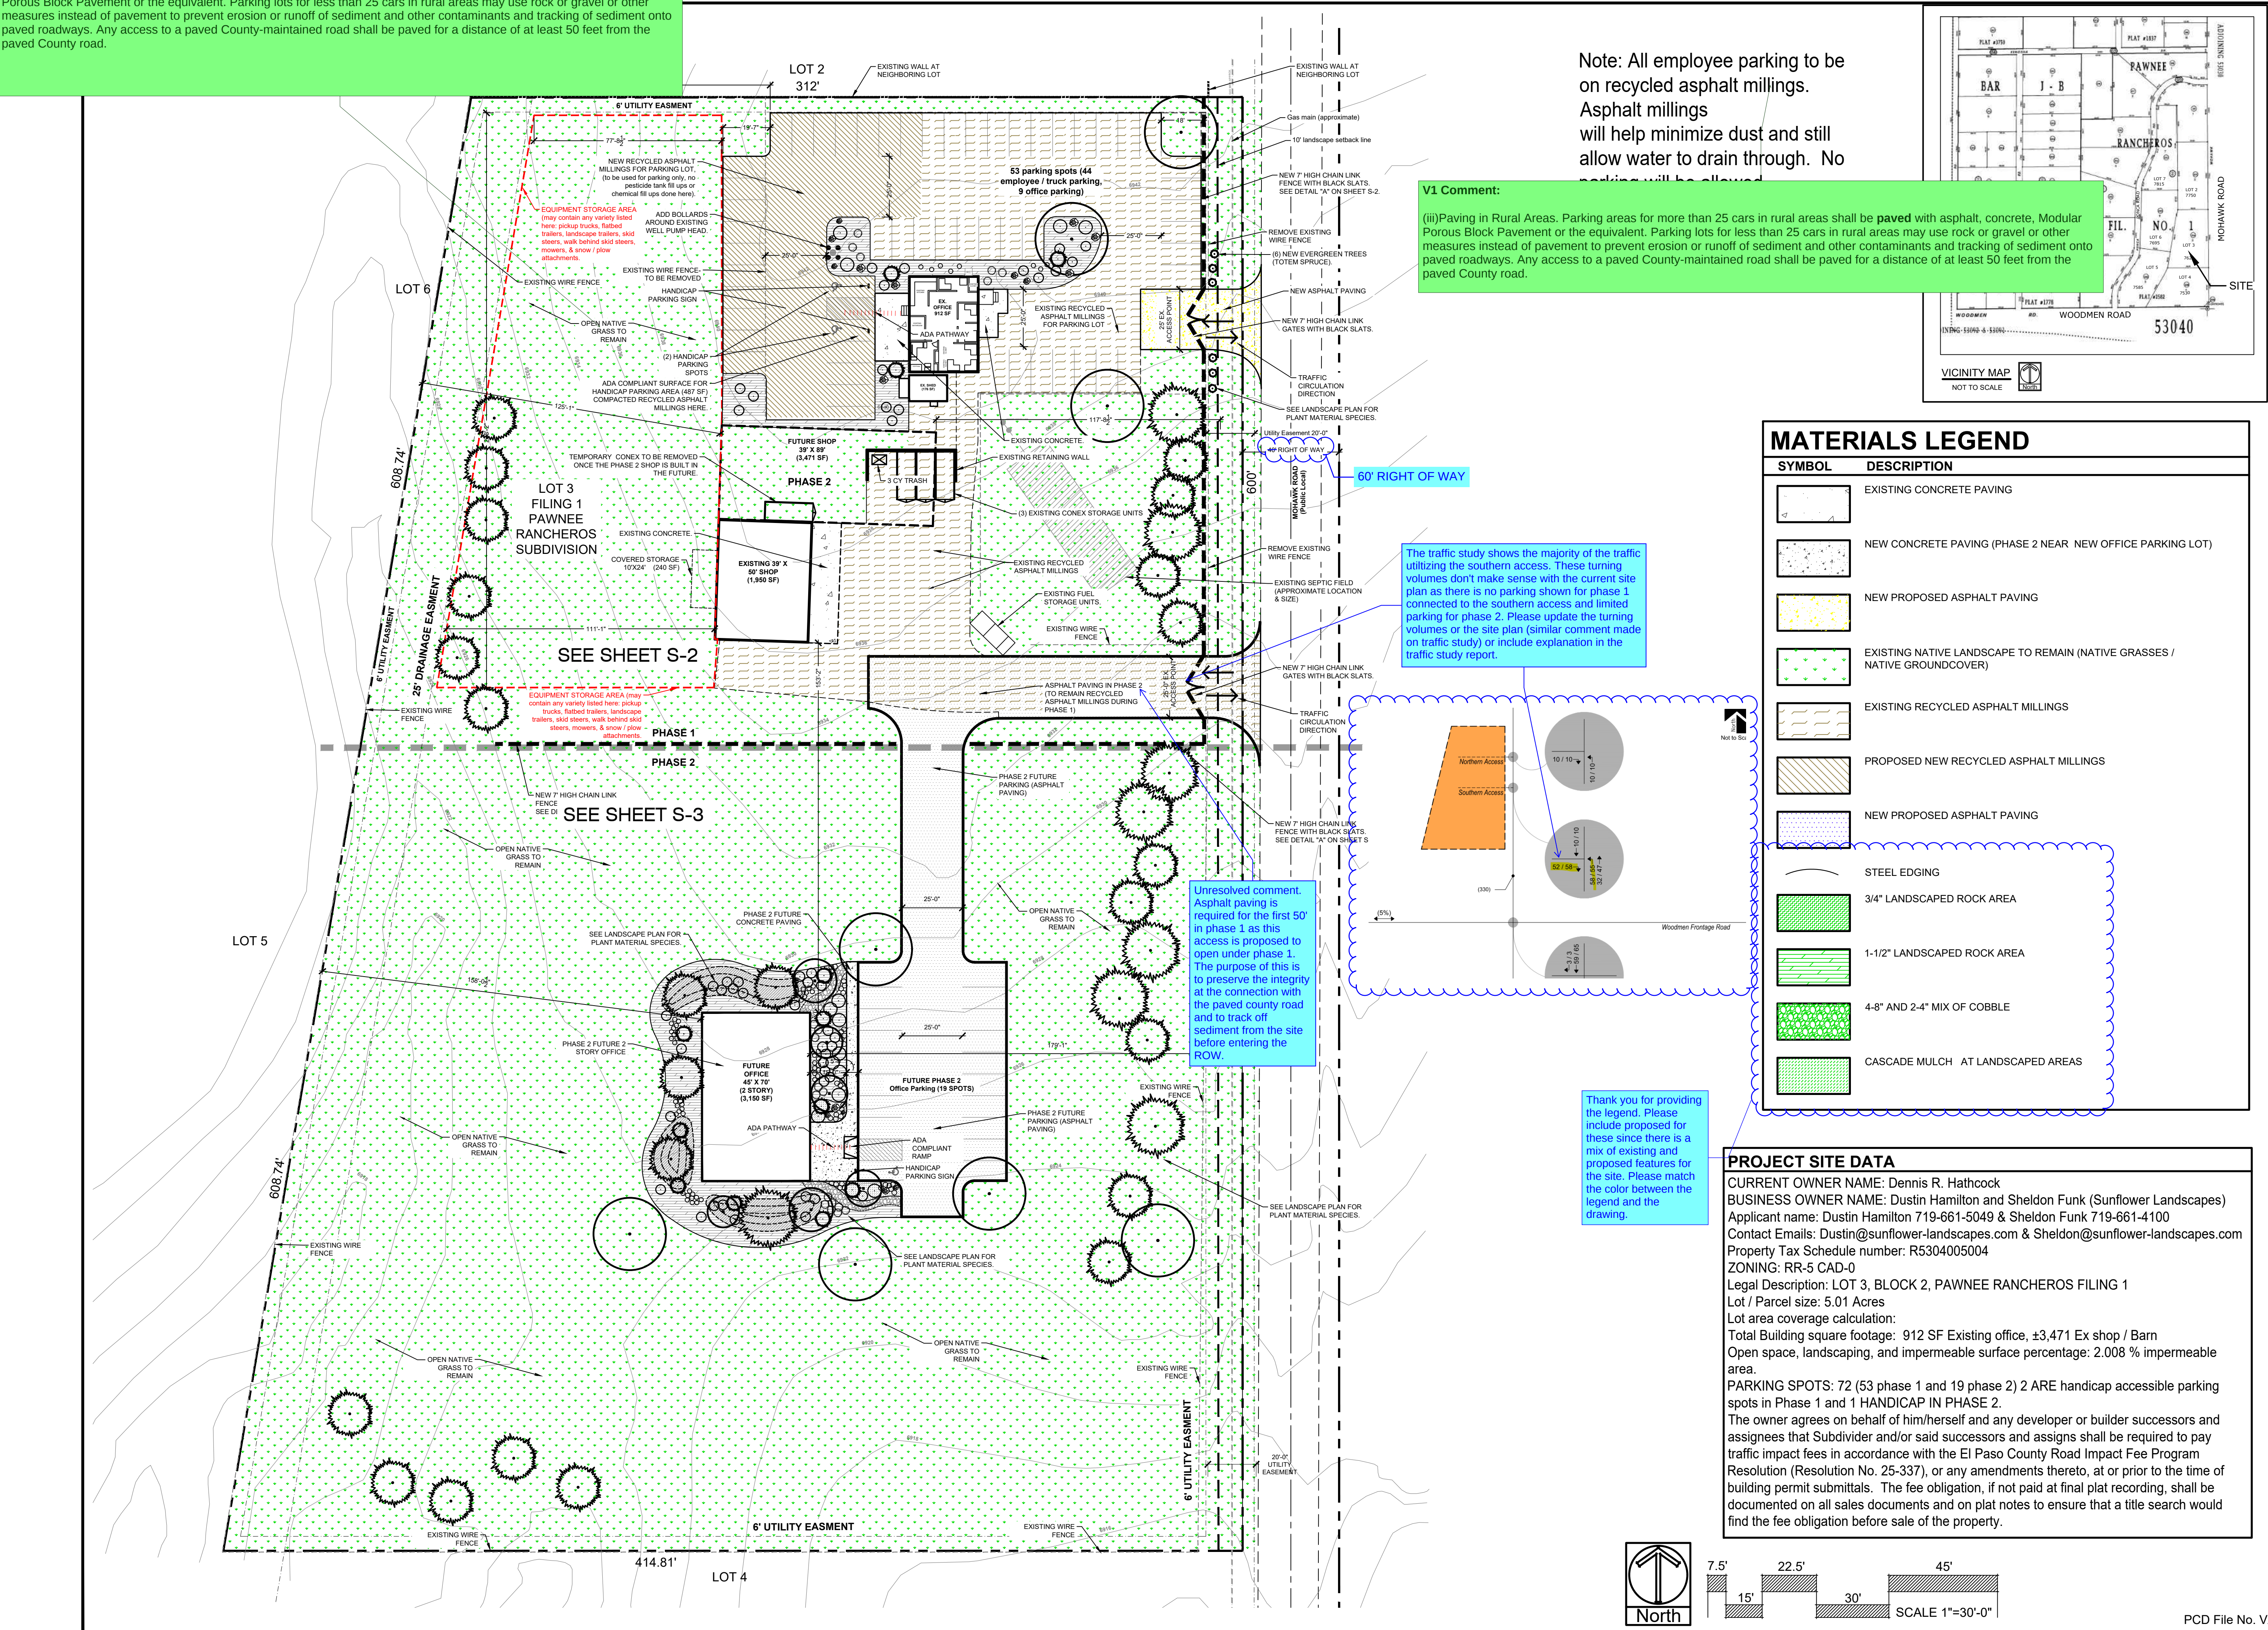

Note: All employee parking to be on recycled asphalt millings. Asphalt millings will help minimize dust and still allow water to drain through. No parking will be allowed on the road.

V1 Comment:

(iii)Paving in Rural Areas. Parking areas for more than 25 cars in rural areas shall be paved with asphalt, concrete, Modular Porous Block Pavement or the equivalent. Parking lots for less than 25 cars in rural areas may use rock or gravel or other measures instead of pavement to prevent erosion or runoff of sediment and other contaminants and tracking of sediment onto paved roadways. Any access to a paved County-maintained road shall be paved for a distance of at least 50 feet from the paved County road.

The traffic study shows the majority of the traffic utilizing the southern access. These turning volumes don't make sense with the current site plan as there is no parking shown for phase 1 connected to the southern access and limited parking for phase 2. Please update the turning volumes or the site plan (similar comment made on traffic study) or include explanation in the traffic study report.

Unresolved comment. Asphalt paving is required for the first 50' in phase 1 as this access is proposed to open under phase 1. The purpose of this is to preserve the integrity at the connection with the paved county road and to track off sediment from the site before entering the ROW.

Thank you for providing the legend. Please include proposed for these since there is a mix of existing and proposed features for the site. Please match the color between the legend and the drawing.

MATERIALS LEGEND

SYMBOL	DESCRIPTION
	EXISTING CONCRETE PAVING
	NEW CONCRETE PAVING (PHASE 2 NEAR NEW OFFICE PARKING LOT)
	NEW PROPOSED ASPHALT PAVING
	EXISTING NATIVE LANDSCAPE TO REMAIN (NATIVE GRASSES / NATIVE GROUNDCOVER)
	EXISTING RECYCLED ASPHALT MILLINGS
	PROPOSED NEW RECYCLED ASPHALT MILLINGS
	NEW PROPOSED ASPHALT PAVING
	STEEL EDGING
	3/4" LANDSCAPED ROCK AREA
	1-1/2" LANDSCAPED ROCK AREA
	4-8" AND 2-4" MIX OF COBBLE
	CASCADE MULCH AT LANDSCAPED AREAS

PROJECT SITE DATA


CURRENT OWNER NAME: Dennis R. Hathcock
BUSINESS OWNER NAME: Dustin Hamilton and Sheldon Funk (Sunflower Landscapes)
Applicant name: Dustin Hamilton 719-661-5049 & Sheldon Funk 719-661-4100
Contact Emails: Dustin@sunflower-landscapes.com & Sheldon@sunflower-landscapes.com
Property Tax Schedule number: R5304005004
ZONING: RR-5 CAD-0
Legal Description: LOT 3, BLOCK 2, PAWNEE RANCHEROS FILING 1
Lot / Parcel size: 5.01 Acres
Lot area coverage calculation:
Total Building square footage: 912 SF Existing office, ±3,471 Ex shop / Barn
Open space, landscaping, and impermeable surface percentage: 2.008 % impermeable area.
PARKING SPOTS: 72 (53 phase 1 and 19 phase 2) 2 ARE handicap accessible parking spots in Phase 1 and 1 HANDICAP IN PHASE 2.
The owner agrees on behalf of him/herself and any developer or builder successors and assignees that Subdivider and/or said successors and assigns shall be required to pay traffic impact fees in accordance with the El Paso County Road Impact Fee Program Resolution (Resolution No. 25-337), or any amendments thereto, at or prior to the time of building permit submittals. The fee obligation, if not paid at final plat recording, shall be documented on all sales documents and on plat notes to ensure that a title search would find the fee obligation before sale of the property.

SUNFLOWER LANDSCAPES
OFFICE / YARD
7620 MOHAWK ROAD
COLORADO SPRINGS, CO

JOB NUMBER	2790-0326
DATE	8/6/2026
DRAWN BY	MB
DRAWING DESCRIPTION	SITE PLAN - OVERALL
SHEET #	S-1

V3_Site Plan Drawing.pdf Markup Summary

JoeLetke (2)

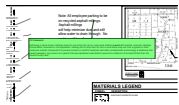

Subject: Planner
Page Label: [1] SITE 2789-0326 v.7-S-1
Author: JoeLetke
Date: 9/10/2026 8:02:17 AM
Status:
Color: ■
Layer:
Space:

V1 Comment:

(iii)Paving in Rural Areas. Parking areas for more than 25 cars in rural areas shall be paved with asphalt, concrete, Modular Porous Block Pavement or the equivalent. Parking lots for less than 25 cars in rural areas may use rock or gravel or other measures instead of pavement to prevent erosion or runoff of sediment and other contaminants and tracking of sediment onto paved roadways. Any access to a paved County-maintained road shall be paved for a distance of at least 50 feet from the paved County road.




Subject: Planner
Page Label: [1] SITE 2789-0326 v.7-S-1
Author: JoeLetke
Date: 9/10/2026 7:49:32 AM
Status:
Color: ■
Layer:
Space:


V1 Comment:

(iii)Paving in Rural Areas. Parking areas for more than 25 cars in rural areas shall be paved with asphalt, concrete, Modular Porous Block Pavement or the equivalent. Parking lots for less than 25 cars in rural areas may use rock or gravel or other measures instead of pavement to prevent erosion or runoff of sediment and other contaminants and tracking of sediment onto paved roadways. Any access to a paved County-maintained road shall be paved for a distance of at least 50 feet from the paved County road.

Joseph Sandstrom (5)

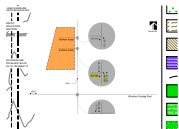

Subject: Image
Page Label: [1] SITE 2789-0326 v.7-S-1
Author: Joseph Sandstrom
Date: 9/15/2026 7:57:41 AM
Status:
Color: ■
Layer:
Space:

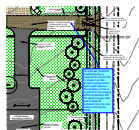


Subject: Callout
Page Label: [1] SITE 2789-0326 v.7-S-1
Author: Joseph Sandstrom
Date: 9/15/2026 8:57:56 AM
Status:
Color: ■
Layer:
Space:

Unresolved comment. Asphalt paving is required for the first 50' in phase 1 as this access is proposed to open under phase 1. The purpose of this is to preserve the integrity at the connection with the paved county road and to track off sediment from the site before entering the ROW.




Subject: Cloud+
Page Label: [1] SITE 2789-0326 v.7-S-1
Author: Joseph Sandstrom
Date: 9/15/2026 7:28:16 AM
Status:
Color: 
Layer:
Space:

Thank you for providing the legend. Please include proposed for these since there is a mix of existing and proposed features for the site. Please match the color between the legend and the drawing.

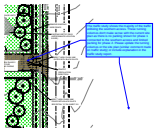

Subject: Callout
Page Label: [1] SITE 2789-0326 v.7-S-1
Author: Joseph Sandstrom
Date: 9/15/2026 8:56:35 AM
Status:
Color: 
Layer:
Space:

The traffic study shows the majority of the traffic utilizing the southern access. These turning volumes don't make sense with the current site plan as there is no parking shown for phase 1 connected to the southern access and limited parking for phase 2. Please update the turning volumes or the site plan (similar comment made on traffic study) or include explanation in the traffic study report.

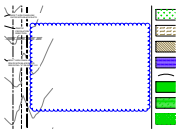


Subject: Cloud
Page Label: [1] SITE 2789-0326 v.7-S-1
Author: Joseph Sandstrom
Date: 9/15/2026 7:57:50 AM
Status:
Color: 
Layer:
Space:

60' RIGHT OF WAY

Ibesler (2)



Subject: Cloud+
Page Label: [1] SITE 2789-0326 v.7-S-1
Author: Ibesler
Date: 9/11/2026 11:46:57 AM
Status:
Color: 
Layer:
Space:

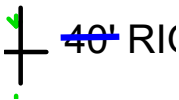

Subject: Line
Page Label: [1] SITE 2789-0326 v.7-S-1
Author: Ibesler
Date: 9/11/2026 11:47:05 AM
Status:
Color: 
Layer:
Space: