



EXTERIOR FINISH SCHEDULE		
LABEL	MATERIAL	COLOR / MANUFACTURER
CMU1	SPLIT-FACE CMU	INTEGRAL COLOR (DARK GREY) TO MATCH SW 7025 "BACKDROP"
CMU2	SMOOTH-FACE CMU	INTEGRAL COLOR (LIGHT GREY) TO MATCH SW 7638 "JOGGING PATH"
S-1	STUCCO	MATCH SW 6755 "STARBOARD" (GREEN)
S-2	STUCCO	MATCH SW 6903 "CHEERFUL" (YELLOW)
S-3	STUCCO	DRYVITT MOONLIGHT
S-4	STUCCO	SW 6755 "STARBOARD" (GREEN)
P-1	PAINT	SW 6755 "STARBOARD" (GREEN)
P-2	PAINT	SW 6903 "CHEERFUL" (YELLOW)
P-3	PAINT	SW 7025 "BACKDROP" (DARK GREY)
M-1	STANDING SEAM ROOFING	MATCH SW 6755 "STARBOARD" (GREEN)

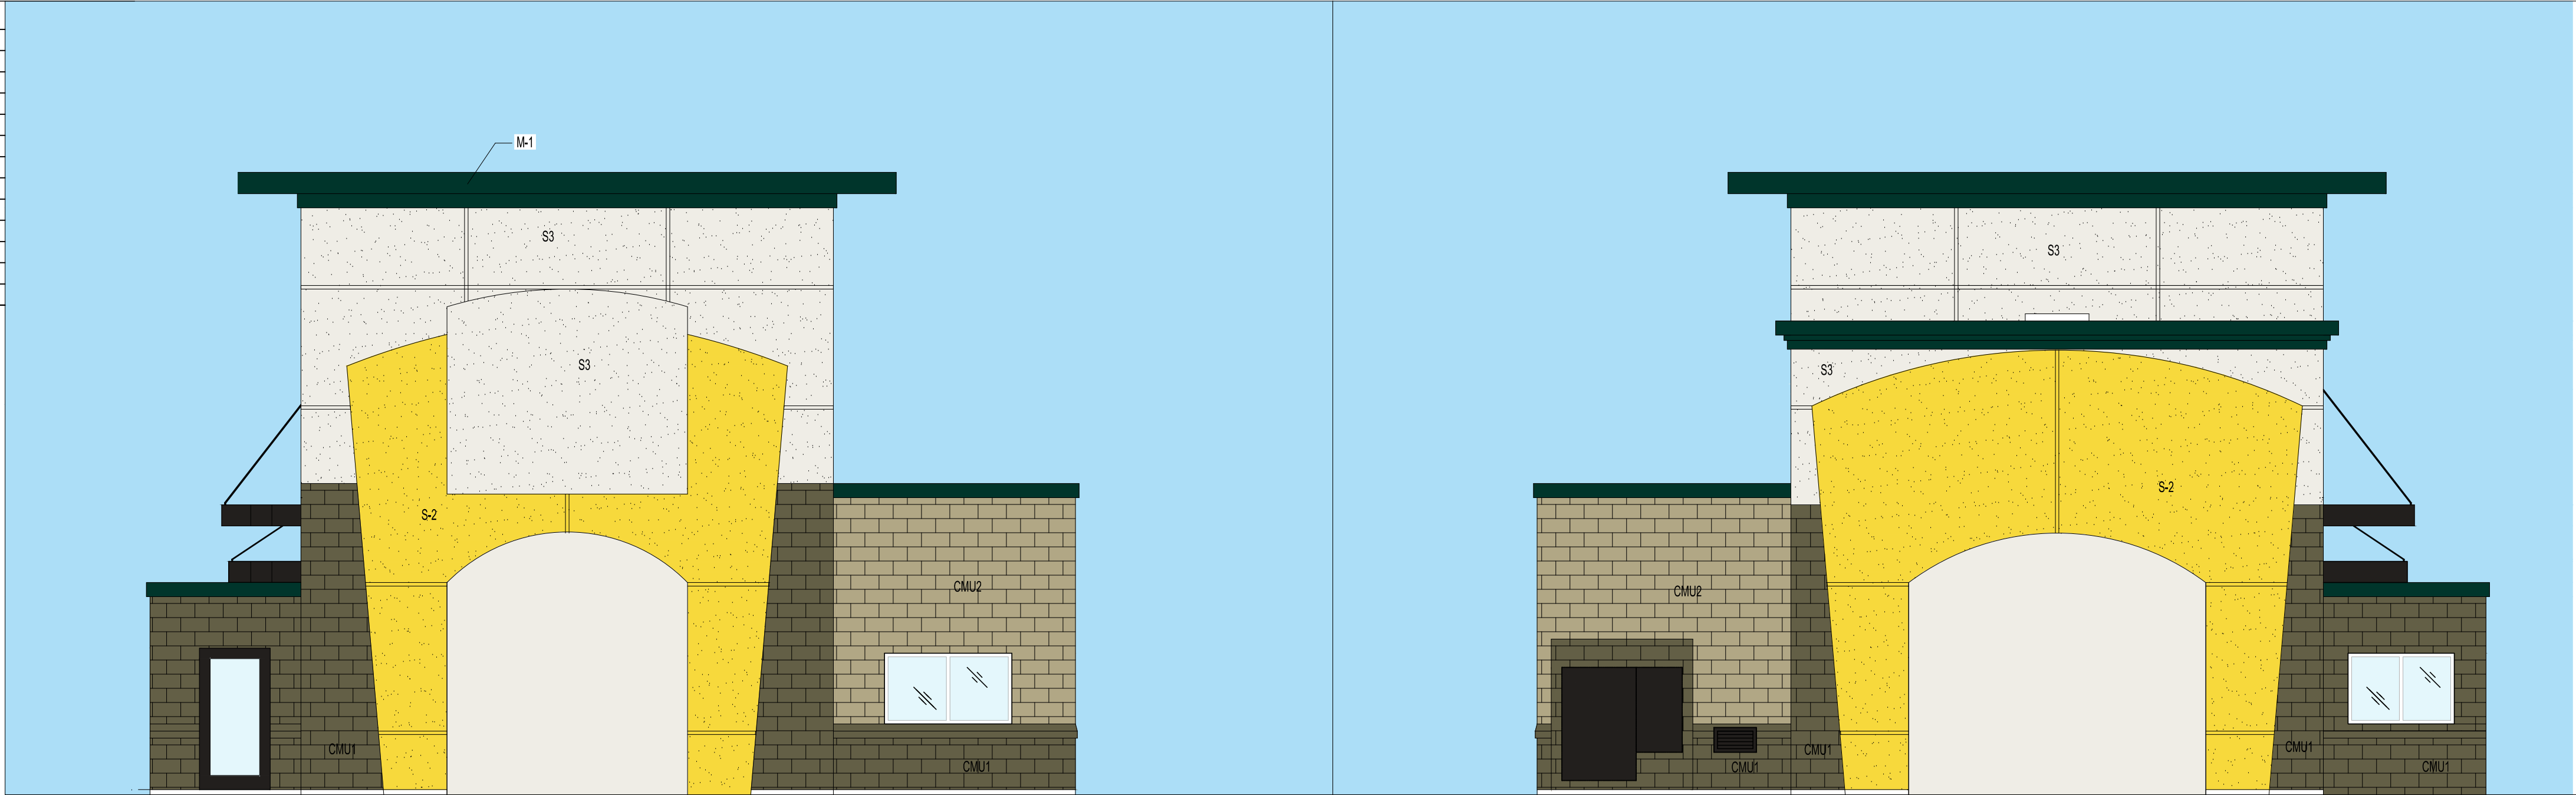


EXTERIOR ELEVATION SCALE: 3/16" = 1'-0" 04

EXTERIOR ELEVATION SCALE: 3/16" = 1'-0" 03

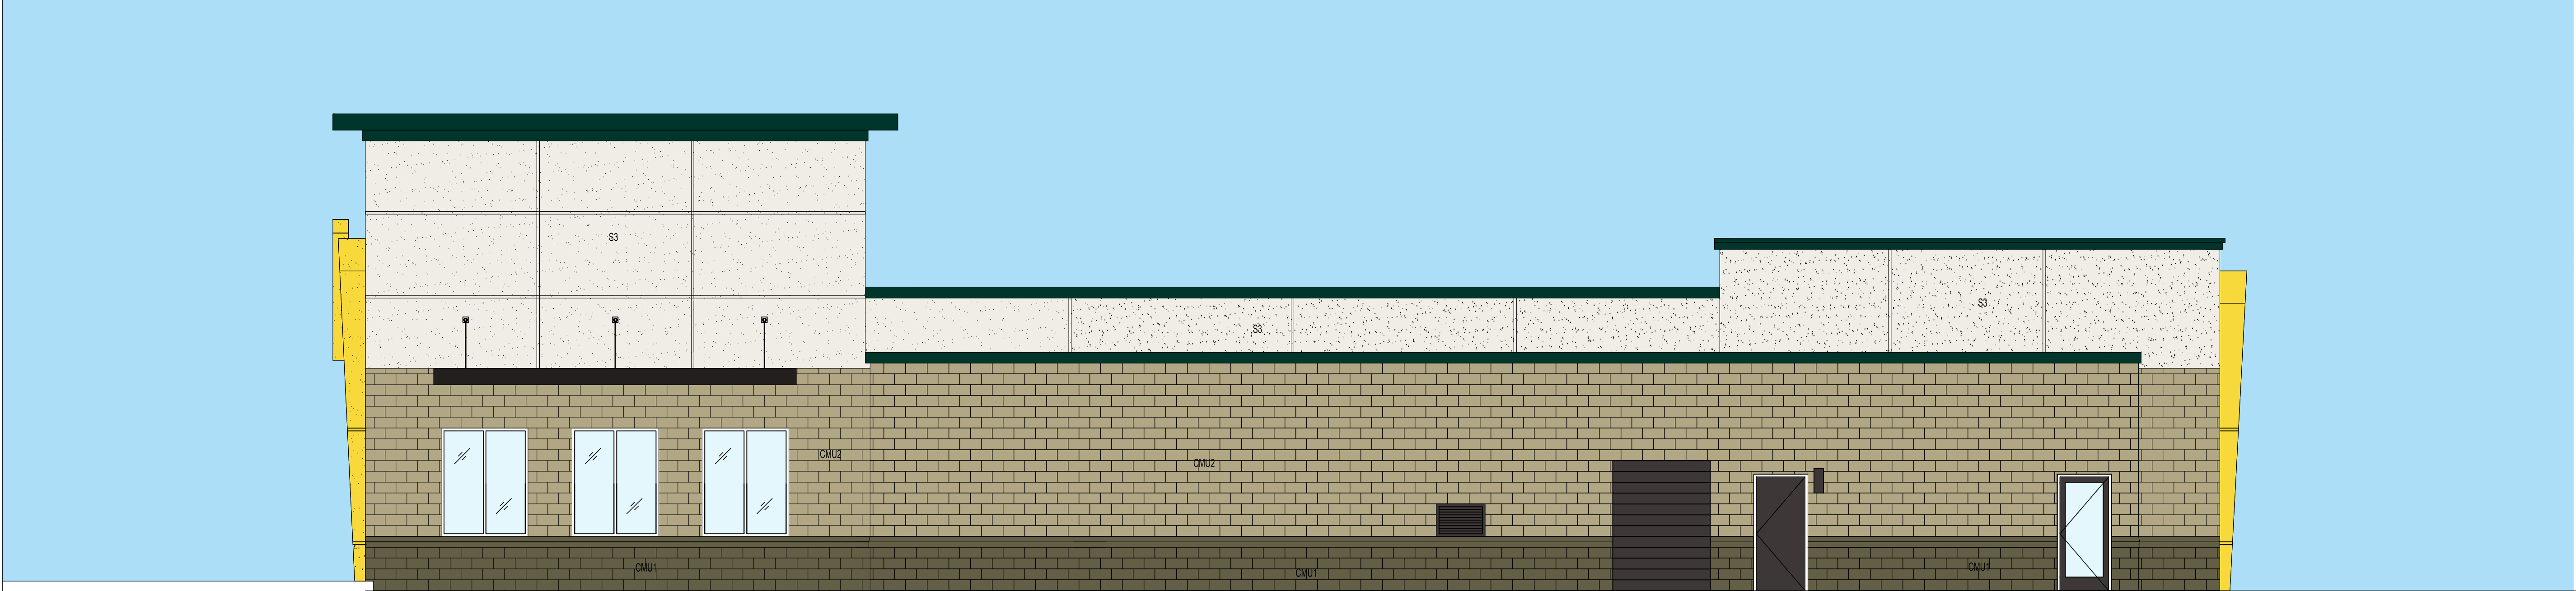

EXTERIOR ELEVATION SCALE: 3/16" = 1'-0" 02

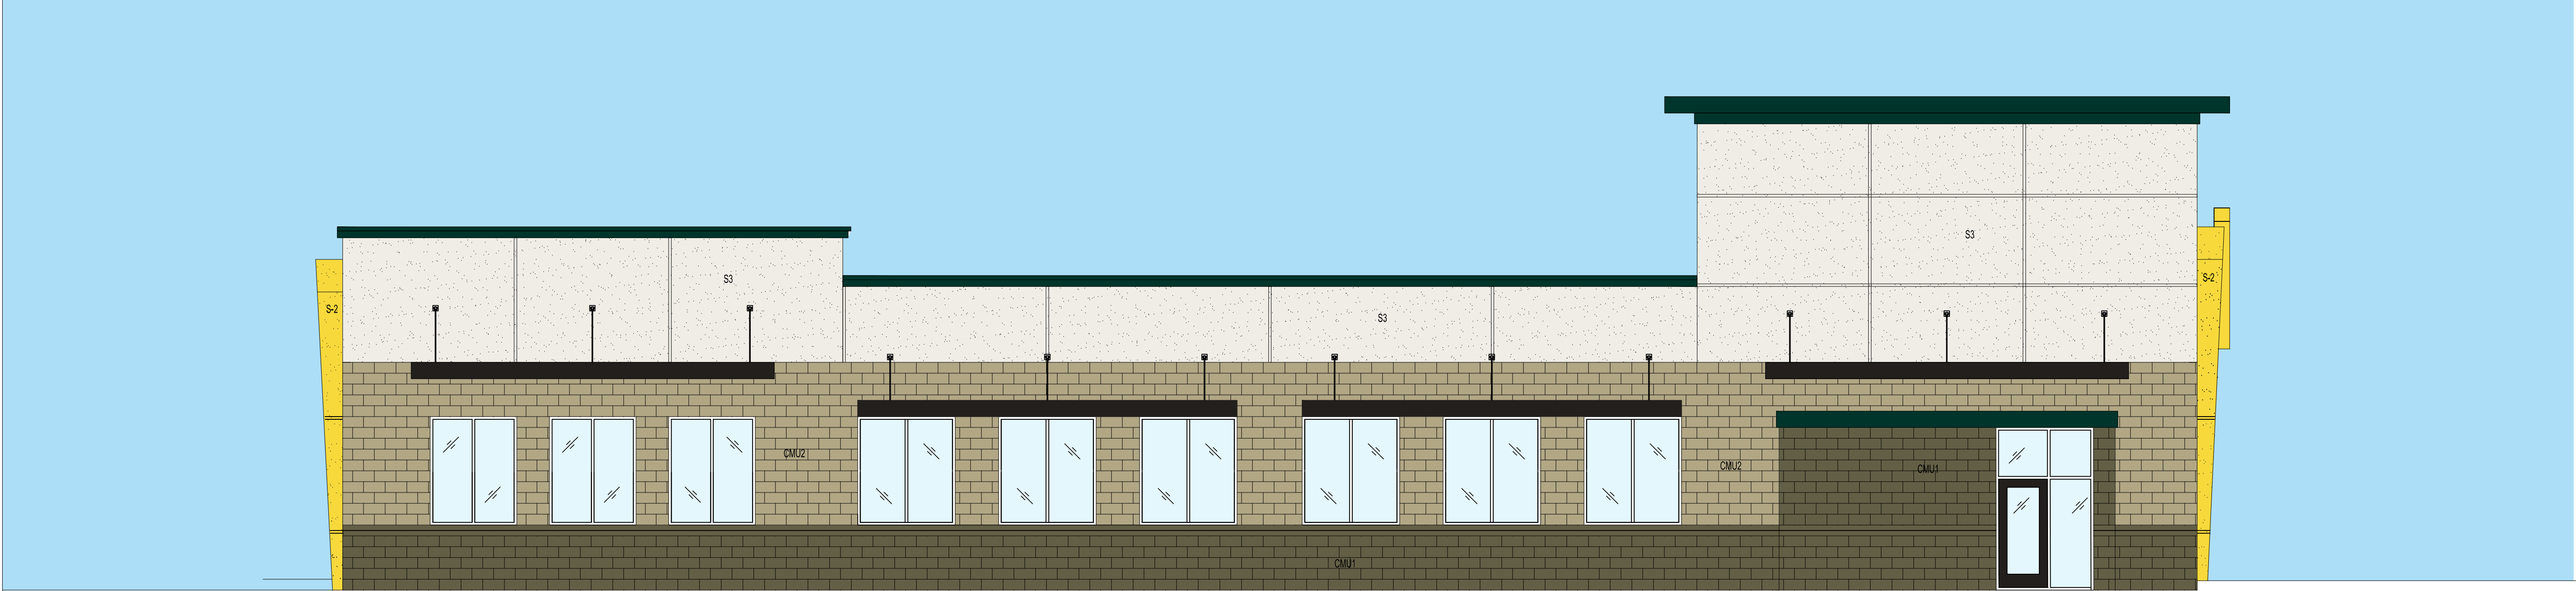

EXTERIOR ELEVATION SCALE: 3/16" = 1'-0" 01

PROJECT NOTES

Elevations of the structure are required on the plan to verify the height restrictions are met

Please include elevations of the vacuum canopy

PROJECT TITLE
Constitutional and Marksheffel




DATE: January 3 2019

REVISIONS:

A200


EXTERIOR FINISH SCHEDULE		
LABEL	MATERIAL	COLOR / MANUFACTURER
CMU1	SPLIT-FACE CMU	INTEGRAL COLOR (DARK GREY) TO MATCH SW 7025 "BACKDROP"
CMU2	SMOOTH FACE CMU	INTEGRAL COLOR (LIGHT GREY) TO MATCH SW 7638 "JOGGING PATH"
S-1	STUCCO	MATCH SW 6755 "STARBOARD" (GREEN)
S-2	STUCCO	MATCH SW 6903 "CHEERFUL" (YELLOW)
S-3	STUCCO	DRYVITT MOONLIGHT
S-4	STUCCO	SW 6755 "STARBOARD" (GREEN)
P-1	PAINT	SW 6755 "STARBOARD" (GREEN)
P-2	PAINT	SW 6903 "CHEERFUL" (YELLOW)
P-3	PAINT	SW 7025 "BACKDROP" (DARK GREY)
M-1	STANDING SEAM ROOFING	MATCH SW 6755 "STARBOARD" (GREEN)

Provide approved address identification. The address identification shall be legible and placed in a position that is visible from the street or road fronting the property. Address identification characters shall contrast with their background. Address numbers shall be Arabic numbers or alphabetical letters. Numbers shall not be spelled out. Each character shall be a minimum of 4 inches (102 mm) high with a minimum stroke width of 1/2 inch (12.7 mm)
Verify Approved Address With Eagle Mountain

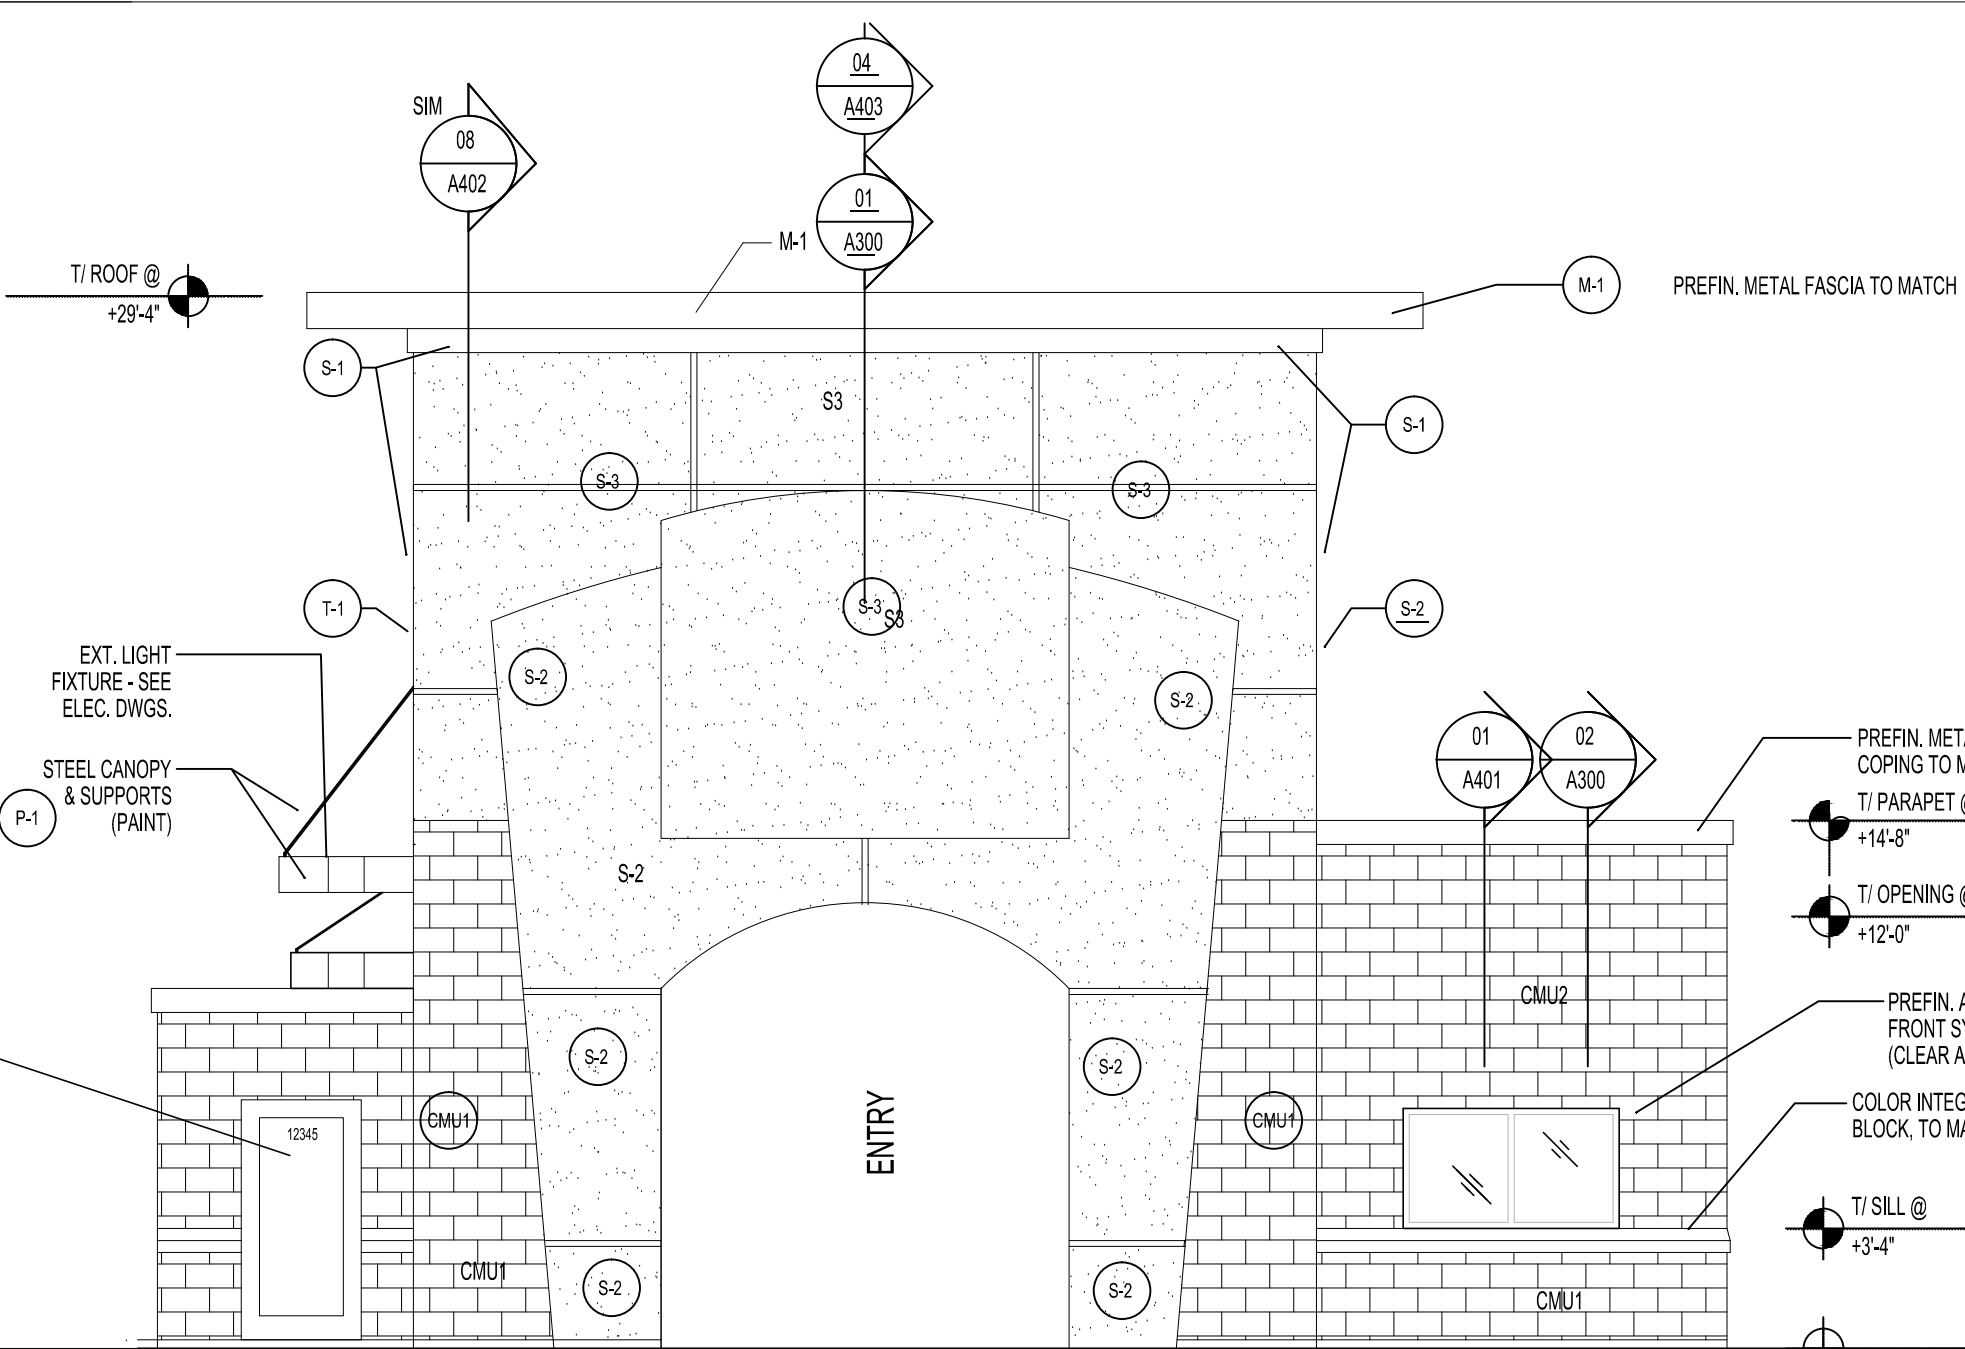


EXTERIOR ELEVATION

SCALE: 3/16" = 1'-0" 04

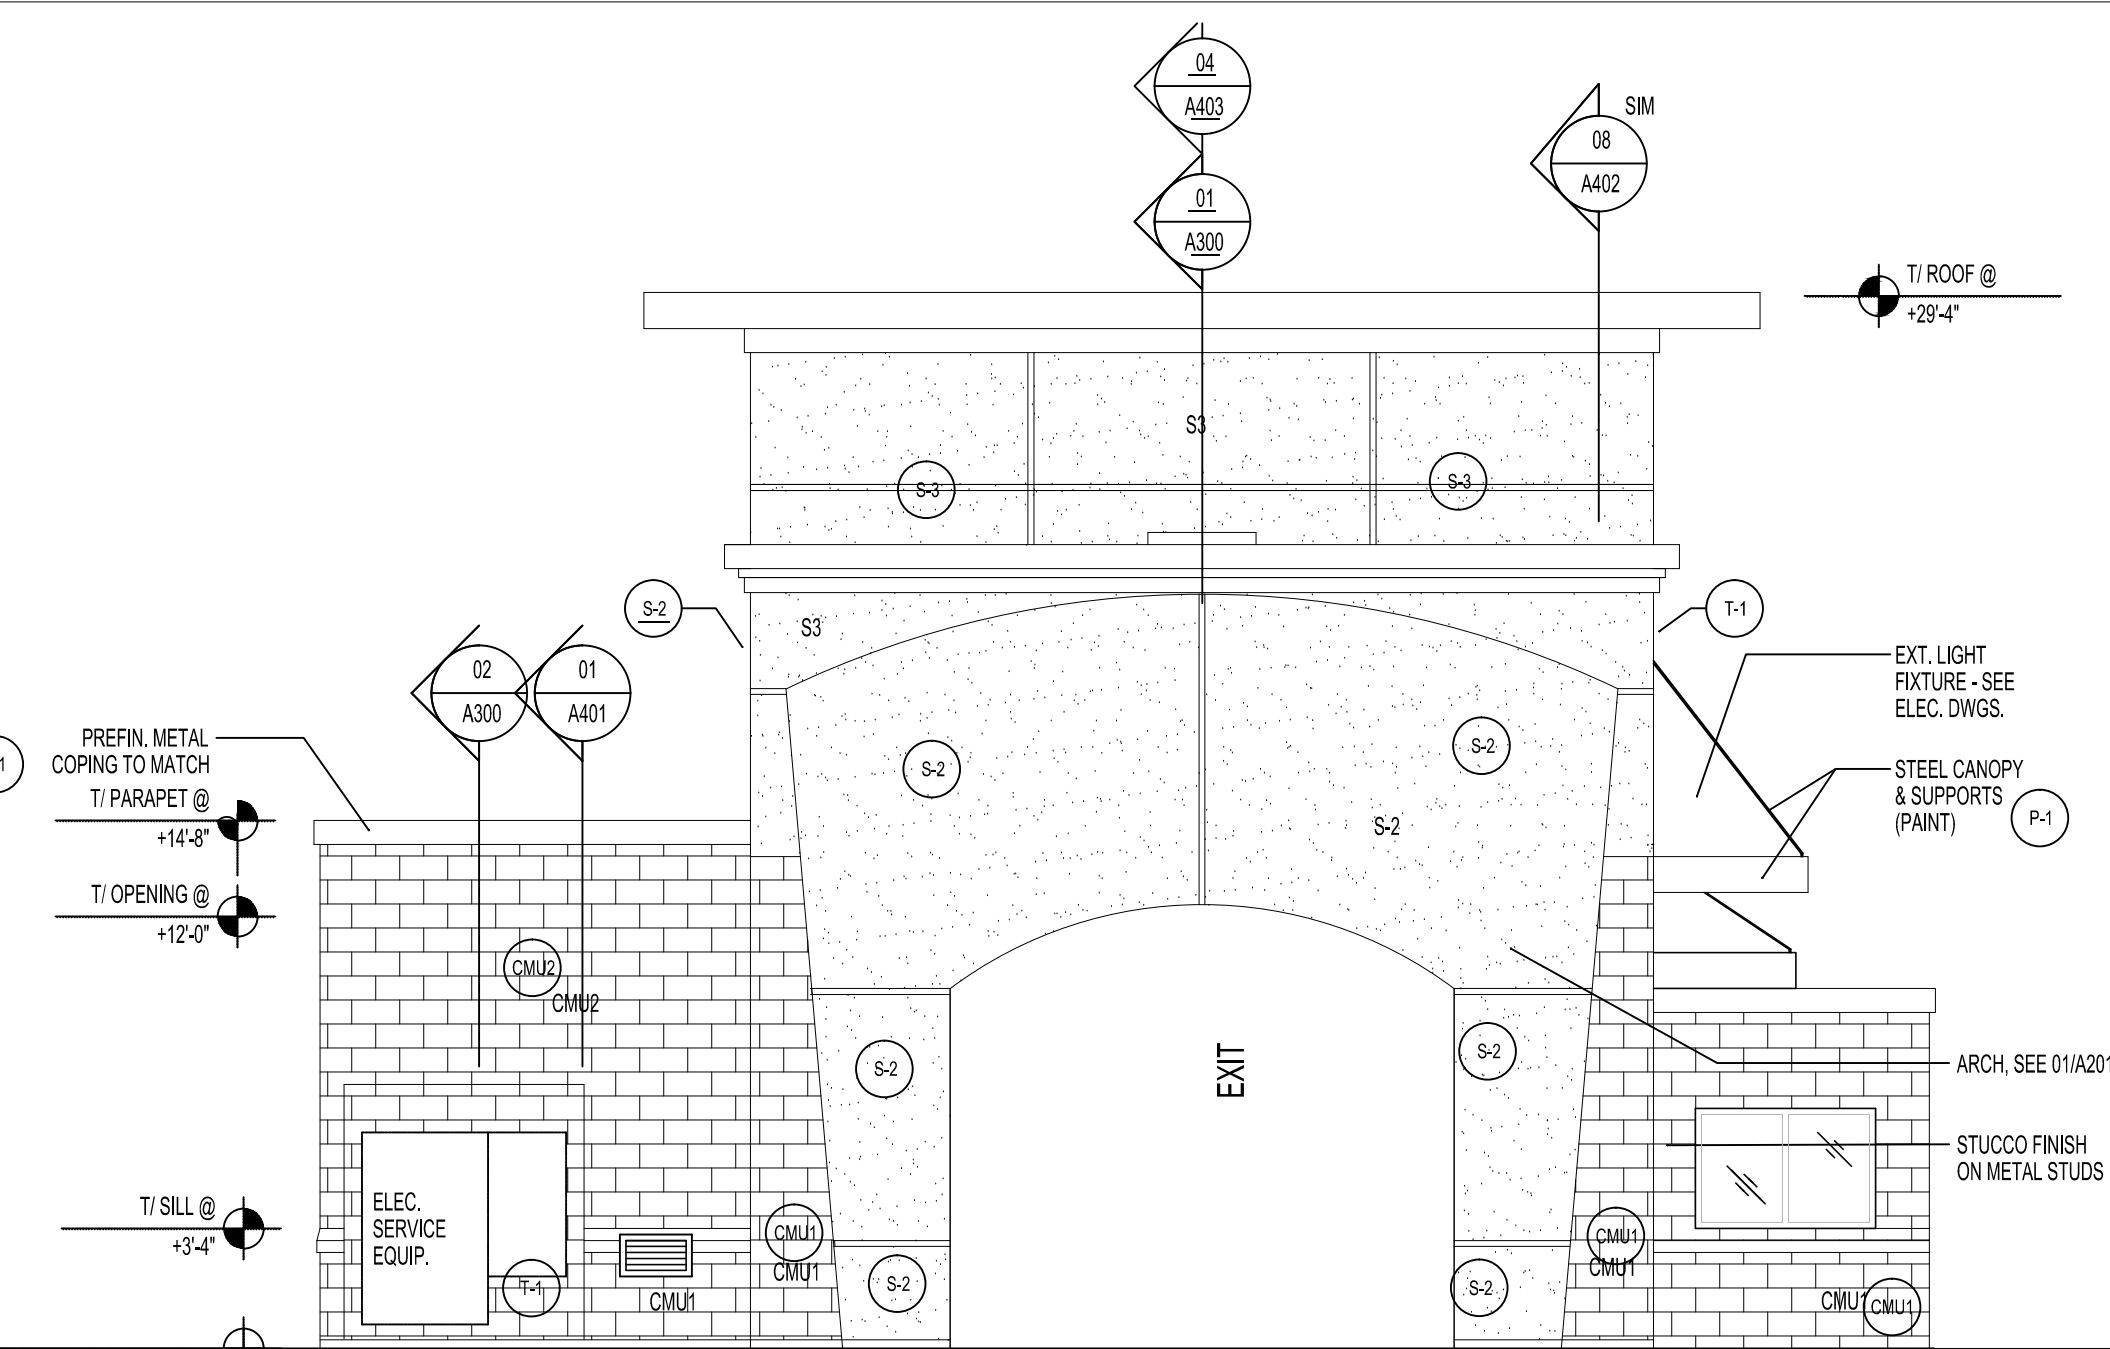


EXTERIOR ELEVATION

SCALE: 3/16" = 1'-0" 03

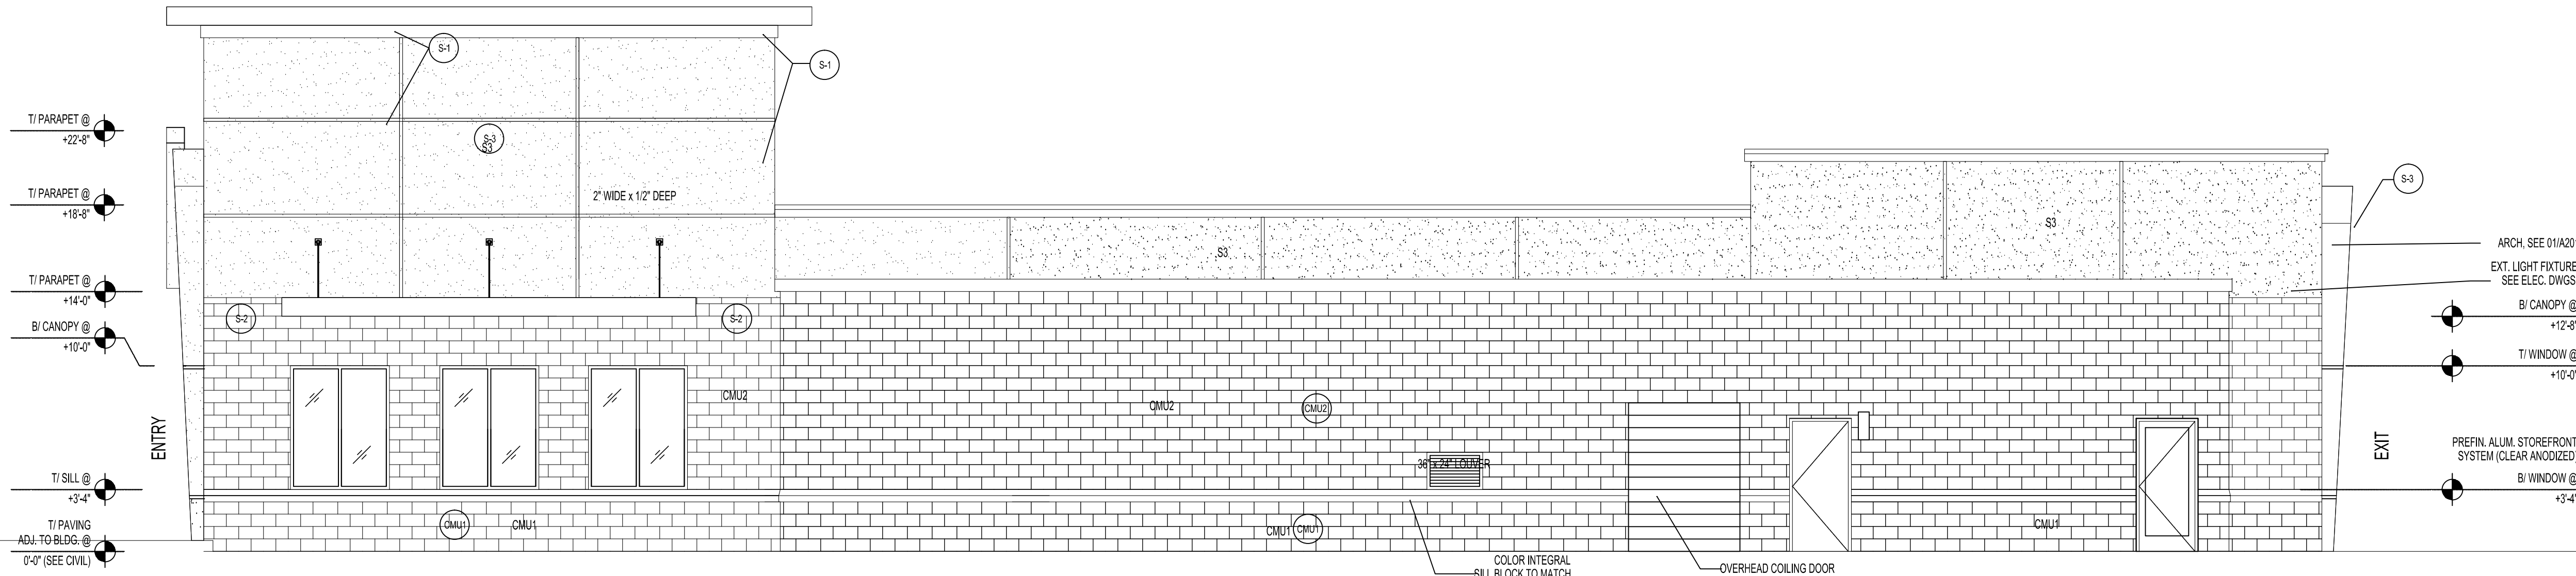

EXTERIOR ELEVATION

SCALE: 3/16" = 1'-0" 02

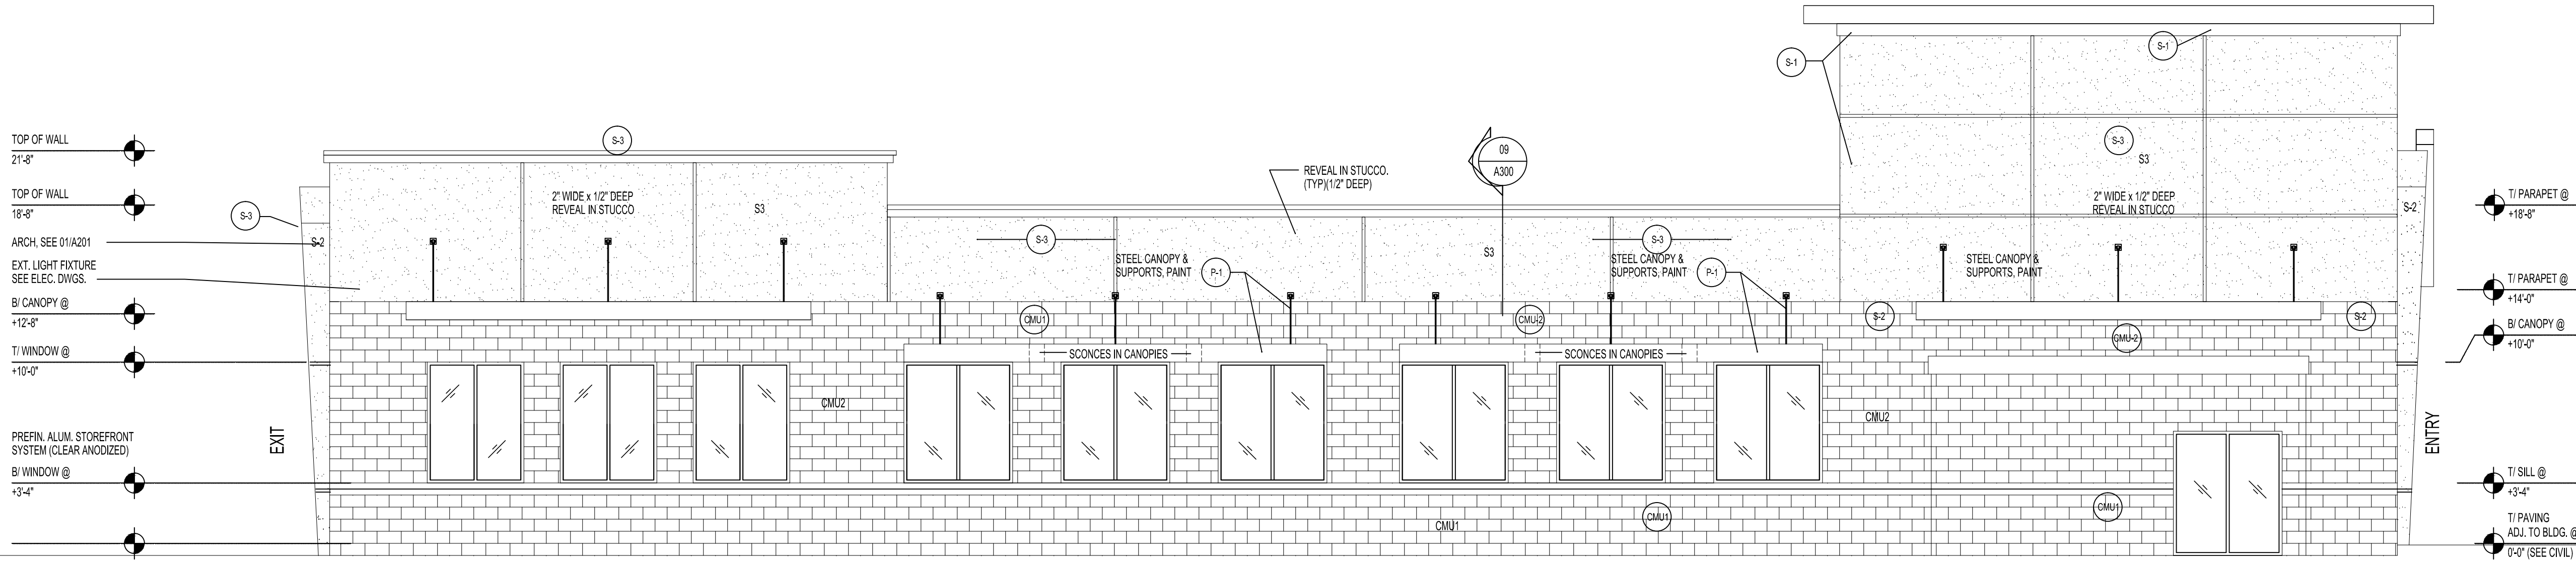

EXTERIOR ELEVATION

SCALE: 3/16" = 1'-0" 01

PROJECT NOTES

PROJECT TITLE
Constitutional and Marksheffel




DATE: January 3 2019
REVISIONS:

A200

Markup Summary


dsdsevigny (2)

Elevations of the structure are required on the plan to verify the height restrictions are met

Subject: Text Box
Page Label: 1
Lock: Locked
Author: dsdsevigny
Date: 2/22/2019 12:50:40 PM
Color: 

Elevations of the structure are required on the plan to verify the height restrictions are met

Please include elevations of the vacuum canopy

Subject: Text Box
Page Label: 1
Lock: Locked
Author: dsdsevigny
Date: 2/22/2019 12:50:41 PM
Color: 

Please include elevations of the vacuum canopy