

# QUICK QUACK Constitution Colorado Springs, CO

# INDEX

C-0 Cover Sheet

C-1 Site Development Plan

C-2 ADA Route Plan

C-3 Utility Plan

C-4 Details

C-5 Utility Details

LP101 Landscape Planting Plan

LD501 Planting Details

LS600 Landscape Specifications

Photometric Plan

A100 Dimension Floor Plan

A104 Canopy Elevations

A200 Exterior Elevations A200 Exterior Color Elevations


Signage Plans

# LEGEND & ABBREVIATION TABLE


R.O.W./PROPERTY LINE	
EASEMENT LINE	
CENTER LINE	
PROPOSED TRAIL	
PROPOSED WATER LINE	www
PROPOSED PRESSURIZED IRRIGATION	IRR IRR
PROPOSED GROUND WATER DRAIN	GWGWGW
PROPOSED SEWER LINE	— ss — ss — ss — ss — ss —
PROPOSED STORM DRAIN LINE	SDSDSD
EXISTING SEWER LINE	SSSSSS
EXISTING WATER LINE	W W W W
EXISTING STORM DRAIN LINE	SDSDSDSDSDSDSDSDSDSDSDSD
EXISTING CONTOUR	4247
FINISHED CONTOUR	

EXISTING CURB AND GUTTER	
PROPOSED CURB AND GUTTER	
INVERT ELEVATION	I.E.
TOP BACK CURB	TBC
TOP ASPHALT	ТА
TOP OF GRATE	TOG
FINISHED GRADE	FG
TOP OF CONCRETE	TC
HIGH WATER ELEVATION	HWE
CATCH BASIN	
SURFACE FLOW DIRECTION	
PROPOSED STREET LIGHT	::
STORM DRAIN MANHOLE	D
SANITARY SEWER MANHOLE	S
PROPOSED WATER VALVE	₩V ⊠

DEVELOPER: PROJECT ENGINEER: LARVIN POLLOCK JOSEPH EARNEST ELEVATE ENGINEERING LONESTAR BUILDERS 492 WEST 1200 NORTH ENGINEERING QQ UTAH COUNTY PO BOX 887 SPRINGVILLE, UT 84663 SPRINGVILLE, UT 84663 (801) 718-5993 LARVIN@ELEVATENG.COM (801) 400-1944 JOSÉPH@LONESTARBUILDERSINC.COM ELEVATE ENGINI 492 WEST 1200 NORTH SPRINGVILLE, UT 84663 PHONE: (801) 718-5993 <u>SITE DATA</u> SF (1.04 ACRES) SF± 8.8% LOT AREA: 45,370 BUILDING AREA: 3,980 SF± 62.9% 28,554 PAVEMENT AREA: SF± 28.3% LANDSCAPE AREA: 12,836 ш ZONING: CR (COMMERCIAL REGIONAL) PERMITTED USÈ BUILDING DATA CONSTRUCTION TYPE: V-B OCCUPANCY TYPE: B SPRINKLERS: NO BUILDING HEIGHT: 29'6" ĹЦ SETBACKS: FRONT=50 FEET REAR=0 FEET SIDE=0 FEET ш PARKING TABULATION REQUIRED: 1 SPACE PER BAY OR STALL PROVIDED: 2 STALLS 1 ADA STALL 0951 TAX SCHEDULE NUMBER 5404210067 õ TION S SS TITU RIN NONS' AD  $\overline{O}$ \_\_\_\_\_ ACK VER  $\triangleleft$  $\mathbf{O}$ QU, CO  $\bigcirc$ QUICK IARKSHEF  $\geq$ GENERAL NOTE: 437 "THE PARTIES RESPONSIBLE FOR THIS PLAN HAVE  $\sim$ FAMILIARIZED THEMSELVES WITH ALL CURRENT ACCESSIBILITY CRITERIA AND SPECIFICATIONS AND THE PROPOSED PLAN . SITE ELEMENTS REQUIRED BY THE APPLICABLE ALL ADA DESIGN STANDARDS AND GUIDELINES AS PUBLISHED BY STATES DEPARTMENT OF JUSTICE. APPROVAL OF THIS PLAN BY EL PASO COUNTY DOES NOT ASSURE COMPLIANCE WITH THE ADA OR ANY REGULATIONS OR GUIDELINES ENACTED OR PROMULGATED UNDER OR WITH RESPECT TO SUCH LAWS." FILE # PPR-19-004 . Mar 18, 2019

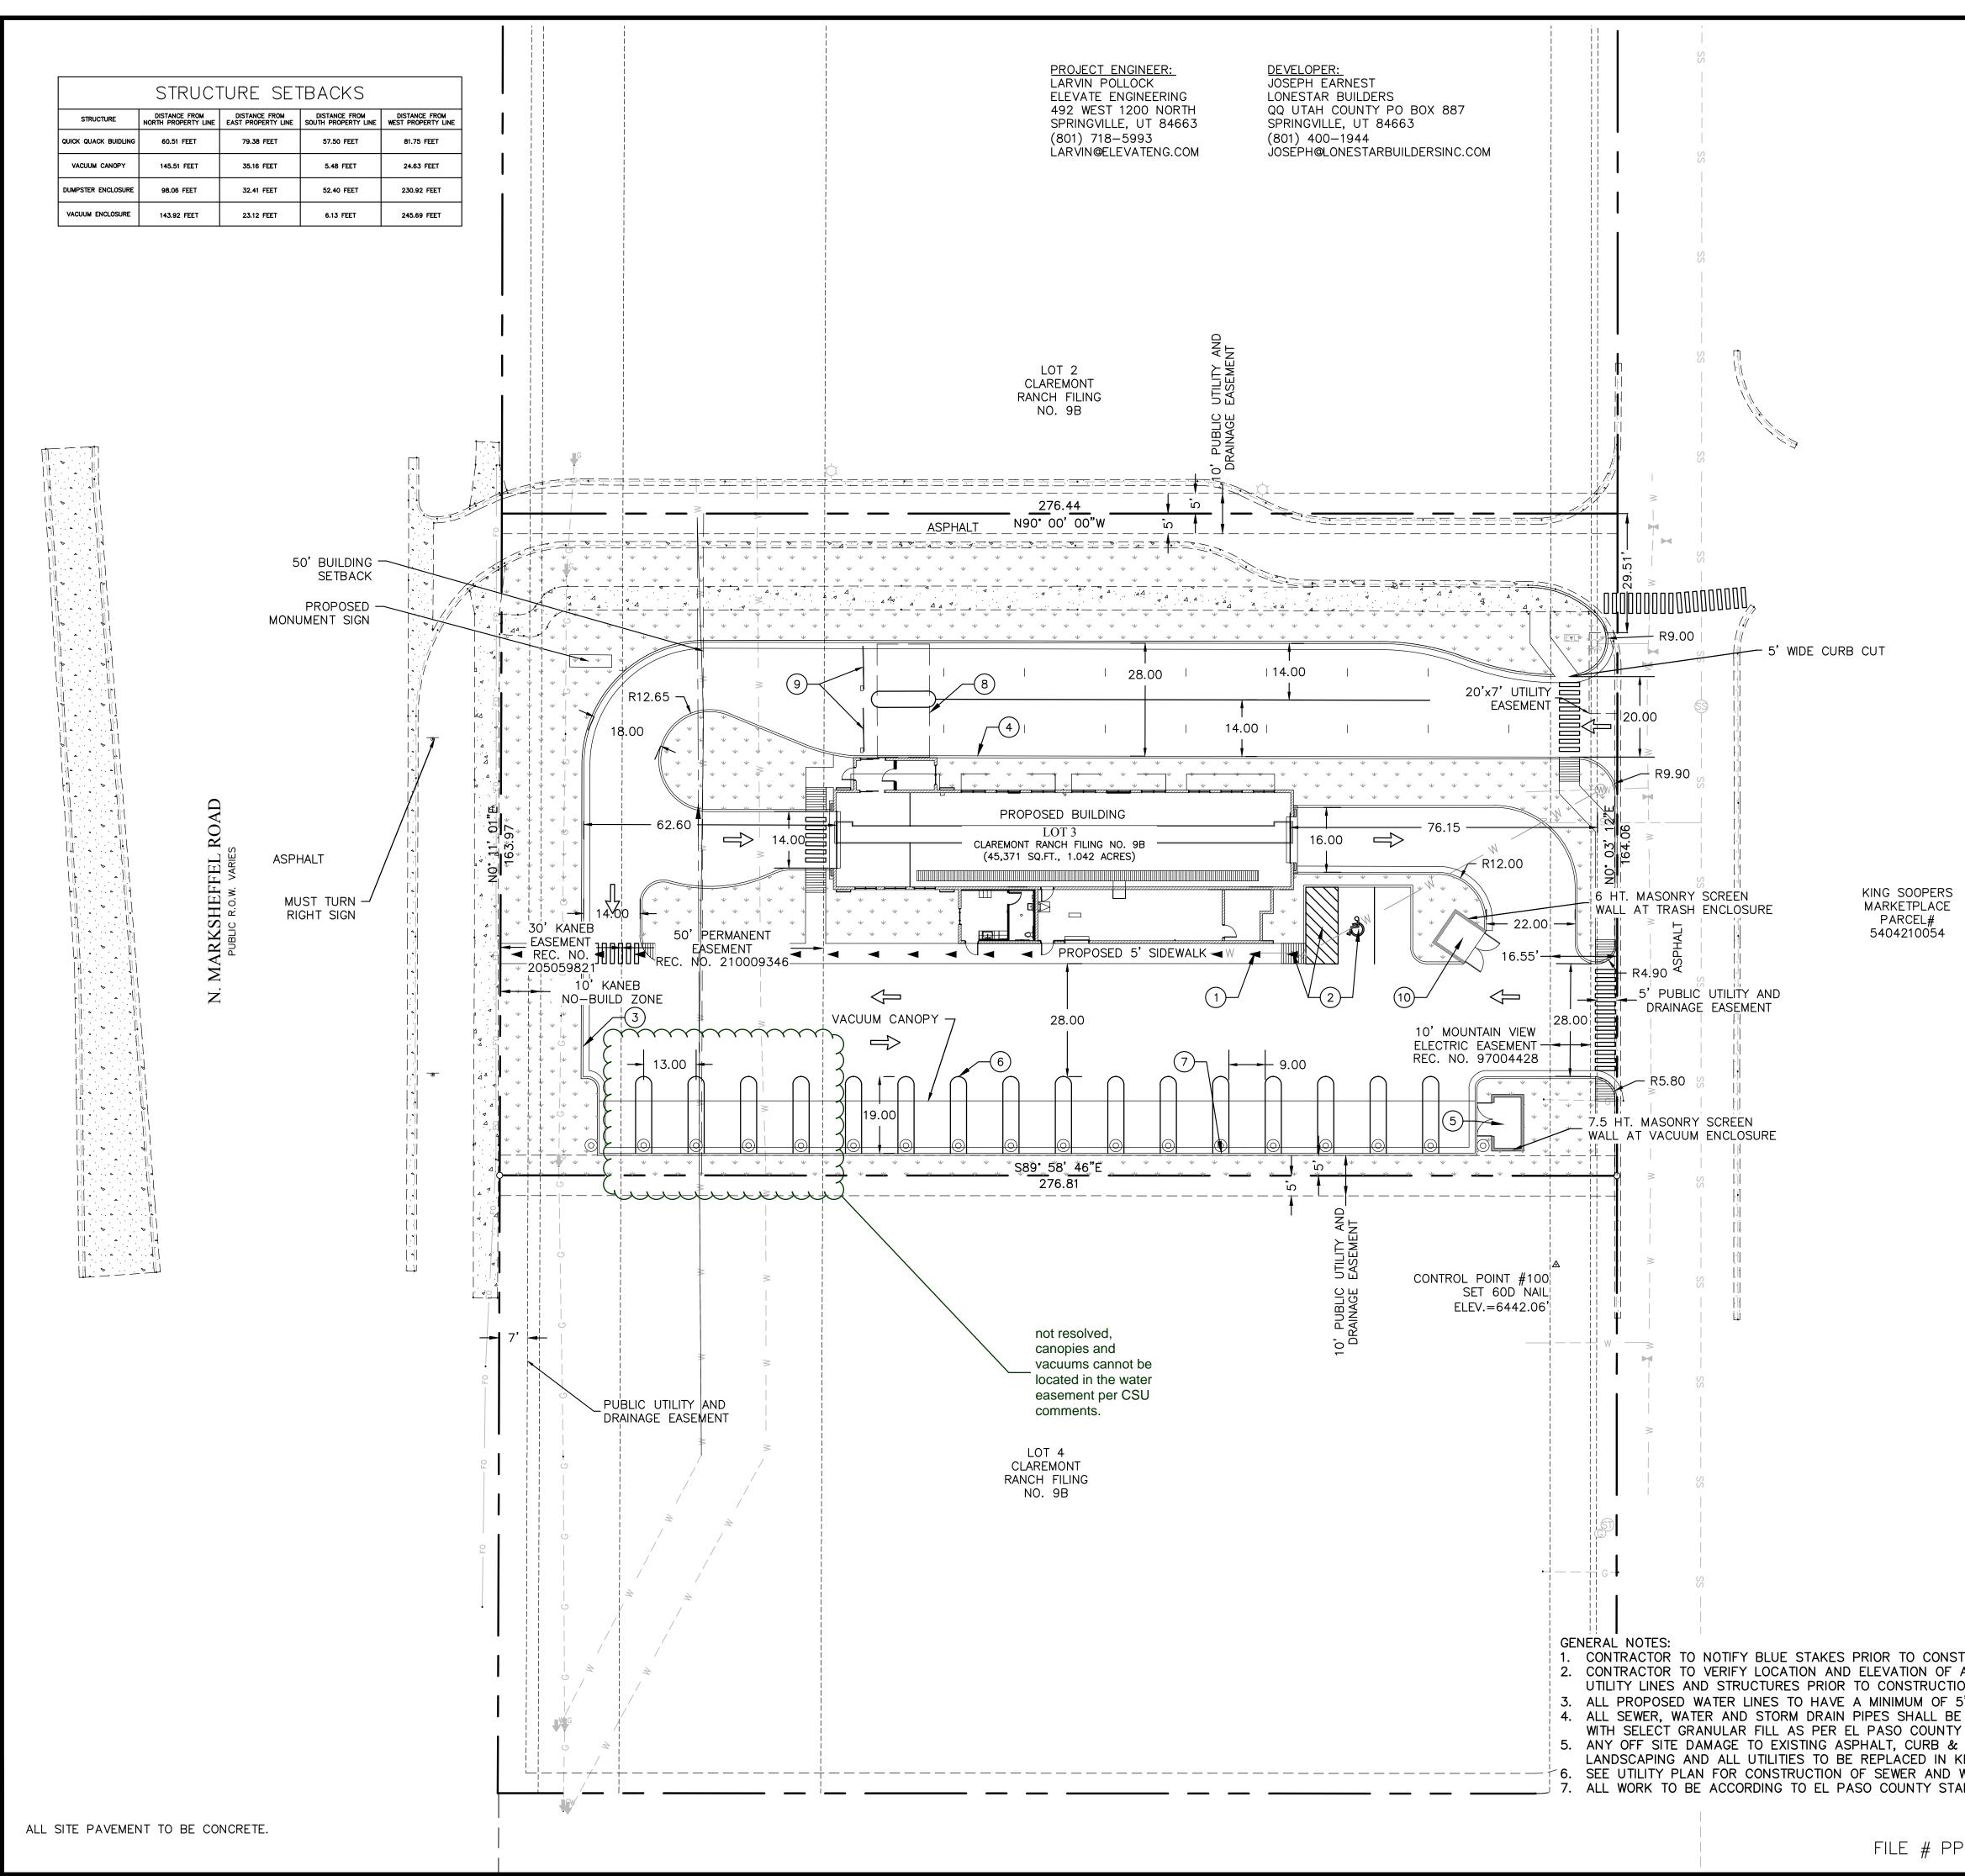


	DATE
LEGEND	BΥ DESIGNER: DL
LOT LINES (PROPERTY)	INGINEERING NORTH B4663 B-5993 B-5993 B-5993
LANDSCAPE AREA	ELEVATE E 492 WEST 1200 SPRINGVILLE, UT PHONE: (801) 71 larvin@elevateng.com
SITE DATA         LOT AREA:       45,370 SF (1.04 ACRES)         BUILDING AREA:       3,980 SF± 8.8%         PAVEMENT AREA:       28,819 SF± 63.5%         LANDSCAPE AREA:       12,571 SF± 27.7%         ZONING: CR (COMMERCIAL REGIONAL)         PERMITTED USE         BUILDING DATA         CONSTRUCTION TYPE: V-B         OCCUPANCY TYPE: B         SPRINKLERS: NO         BUILDING HEIGHT:         PARKING TABULATION         REQUIRED: 1 SPACE PER BAY OR STALL         PROVIDED: 2 STALLS         1 ADA STALL         VACUUM STALLS:       17 STALLS         TUNNEL LENGTH:       114 FEET         STACKING:       16 STALLS	
NOTES:         1       PROPOSED 5' SIDEWALK PER CITY OF COLORADO SPRINGS STD D-8L. SEE SHEET C-4 FOR DETAILS.         2       ALL HANDICAP STALLS AND RAMPS TO BE INSTALLED PER ADA AND APWA STANDARDS. SEE SHEET C-4 FOR DETAILS.         3       PROPOSED CURB & GUTTER TYPE E PER EL PASO COUNTY STD SD-2-20. SEE SHEET C-4 FOR DETAILS.         4       STD D-6. SEE SHEET C-4 FOR DETAILS.         5       APRON. INSTALL OWNER PROVIDED VACUUM EQUIPMENT, UNDERGROUND TRUNK LINES, PIPING, ETC. COORDINATE WITH ARCHITECTURAL PLANS.         6       AINT 4" SOLID YELLOW PAINT STRIPE AS SHOWN (TYPICAL).         7       PLANTERS/GARBAGE RECEPTACLE (TYPICAL). COORDINATE WITH ARCHITECTURAL PLANS FOR DETAILS.         8       INSTALL OWNER PROVIDED TACUMAL PLANS FOR DETAILS.         9       INSTALL OWNER PROVIDED TO DETAILS.         9       INSTALL OWNER PROVIDED TO DETAILS.         9       INSTALL OWNER PROVIDED TO DETAILS.         9       INSTALL OWNER PROVIDED AND TRUNK BALL"         7       PLANTERS/GARBAGE RECEPTACLE (TYPICAL). COORDINATE WITH ARCHITECTURAL PLANS FOR DETAILS.         10       INSTALL OWNER PROVIDED GATES AND LOOP DETECTION SYSTEM. COORDINATE TIMING OF INSTALLATION PRIOR TO CONSTRUCTION OF PAVEMENT. SEE ARCHITECTURAL PLANS FOR DETAILS.         10       PROPOSED DUMPSTER LOCATION. SEE SHEET C-4 FOR DETAILS.	QUICK QUACK CONSTITUTION SITE PLAN 2437 MARKSHEFFEL ROAD COLORADO SPRINGS, CO 80951
Boole in Feet	SHEET: DATE:
	LOT LINES (PROPERTY) ENSTING CURB AND GUTTER PROPOSED CURB AND GUTTER STRING BULDING SETBACK LANDSCAFE SETBACK LANDSCAFE SETBACK LANDSCAFE SETBACK LANDSCAFE SETBACK LANDSCAFE SETBACK LANDSCAFE SETBACK LANDSCAFE SETBACK LANDSCAFE SETBACK LANDSCAFE AREA CONCRETE AREA SILE DATA SILE

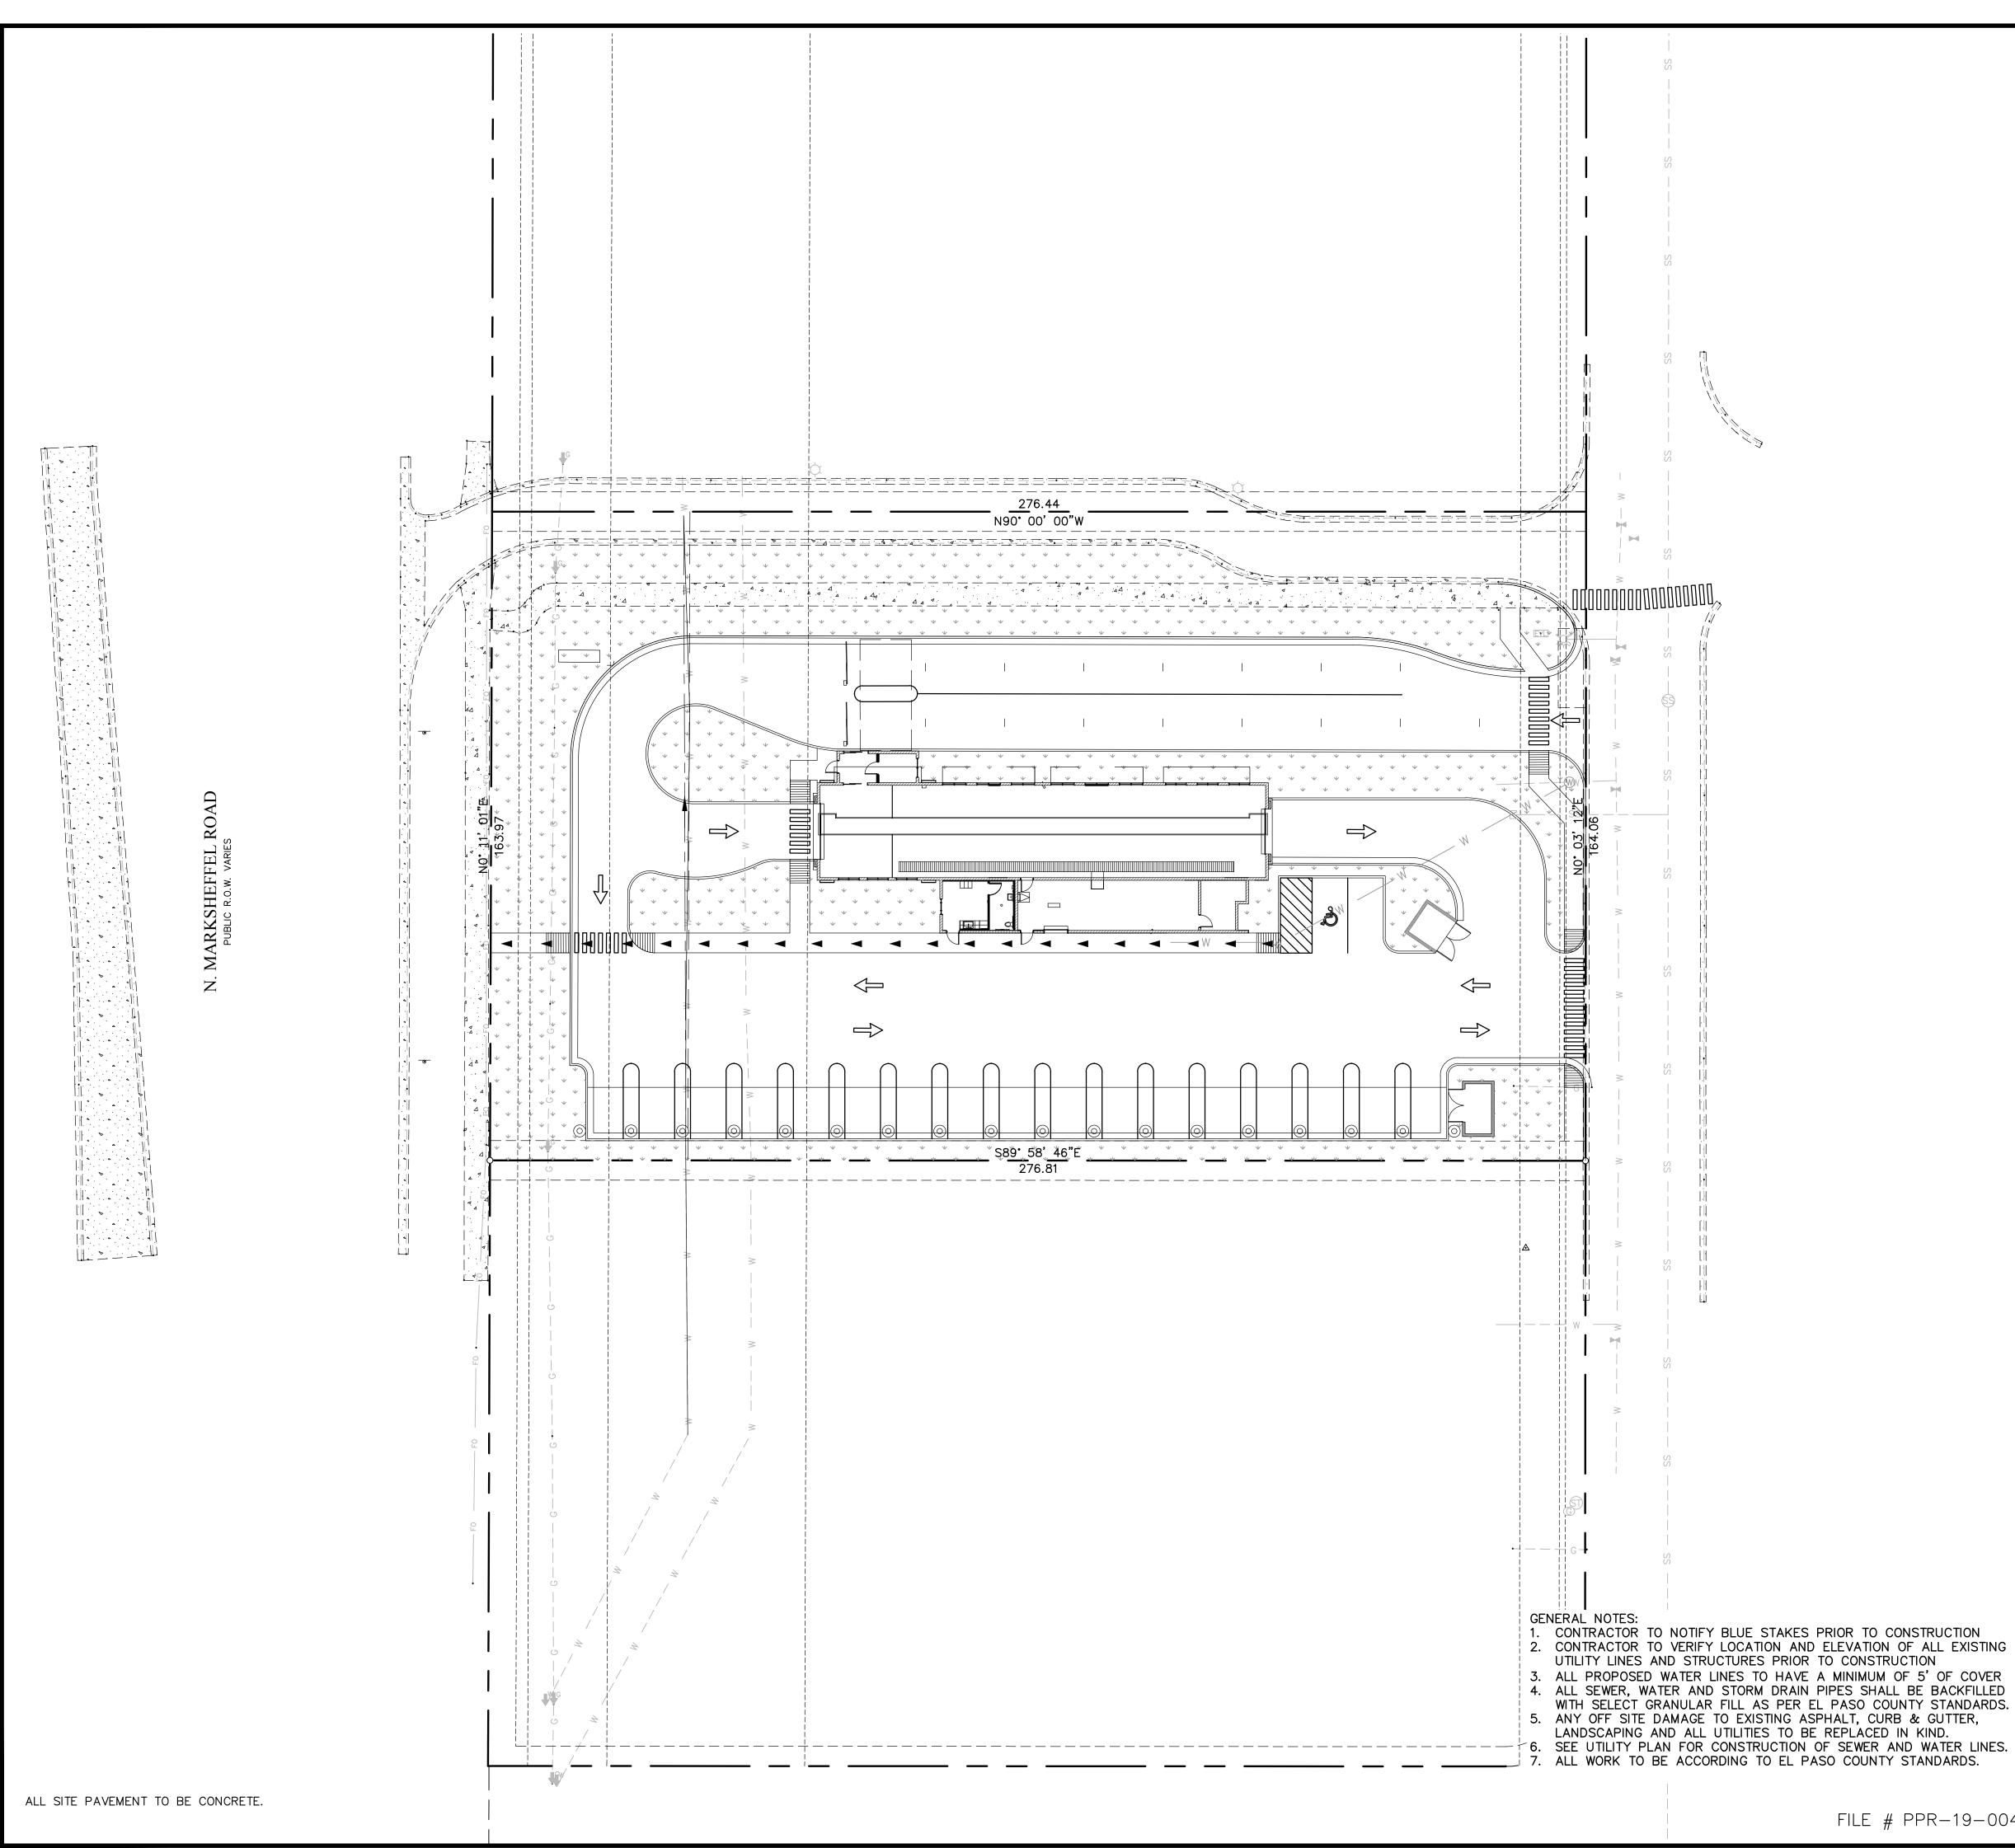

\\Mac\Home\Elevate Engineering Dropbox\QQ CO Colorado Springs Constitution\QQ CO CONSTITUTION 1H.dwg — — Mar 12, 2019—2:29pm

FILE	#	PPR-19-004
------	---	------------

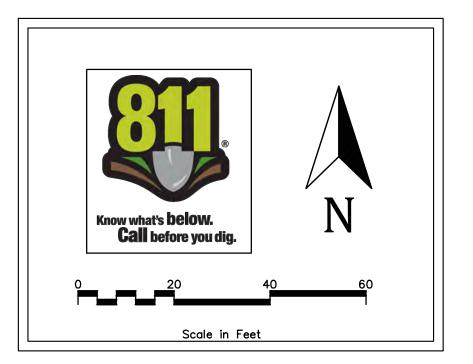

LEGEND

\_ \_\_ \_\_ \_

-----

TBC

FFE

\* \* \* \* \* \*

- - -

. <

LOT LINES (PROPERTY)

BUILDING SETBACK

EXISTING BUILDING

EXISTING FENCE

EASEMENT

LANDSCAPE SETBACK

TOP BACK OF CURB

LANDSCAPE AREA

CONCRETE AREA

ACCESSIBLE ROUTE

FINISHED FLOOR ELEVATION


STRIPING

EXISTING CURB AND GUTTER

PROPOSED CURB AND GUTTER


QUICK QUACK CONSTITUTION	QUICK QUACK CONSTITUTION
ADA ROUTE PLAN	ADA ROUTE PLAN
2437 MARKSHEFFEL ROAD COLORADO SPRINGS, CO 80951	7 MARKSHEFFEL ROAD COLORADO SPRINGS, CO 80951
E N G N E R N G N E R N G R R R R R R R R R R R R R R R R R	E N G N E R N G N E
QUICK QUACK CONSTITUTION	QUICK QUACK CONSTITUTION
ADA ROUTE PLAN	ADA ROUTE PLAN
7 MARKSHEFFEL ROAD COLORADO SPRINGS, CO 80951	7 MARKSHEFFEL ROAD COLORADO SPRINGS, CO 80951
E N G I N E R I N G	E N G I N E R I N G
F N G I N E R I N G	F N G I N E R I N G
F N G I N E R I N G	F N G I N E R I N G
F N G I N E R I N G	F N G I N E R I N G
F N G I N E R I N G	F N G I N E R I N G
QUICK QUACK CONSTITUTION	QUICK QUACK CONSTITUTION
ADA ROUTE PLAN	ADA ROUTE PLAN
7 MARKSHEFFEL ROAD COLORADO SPRINGS, CO 80951	7 MARKSHEFFEL ROAD COLORADO SPRINGS, CO 80951
E N G I N E R I N G	E N G I N E R I N G
QUICK QUACK CONSTITUTION	QUICK QUACK CONSTITUTION
ADA ROUTE PLAN	ADA ROUTE PLAN
7 MARKSHEFFEL ROAD COLORADO SPRINGS, CO 809	7 MARKSHEFFEL ROAD COLORADO SPRINGS, CO 809
QUICK QUACK CONSTITUTION	QUICK QUACK CONSTITUTION
ADA ROUTE PLAN	ADA ROUTE PLAN
7 MARKSHEFFEL ROAD COLORADO SPRINGS, CO 809	7 MARKSHEFFEL ROAD COLORADO SPRINGS, CO 809
	010RADO LICENS 010RADO LICENS 01010 POZOS 0054520 0054520


<sup>.</sup>Mar 12, 2019

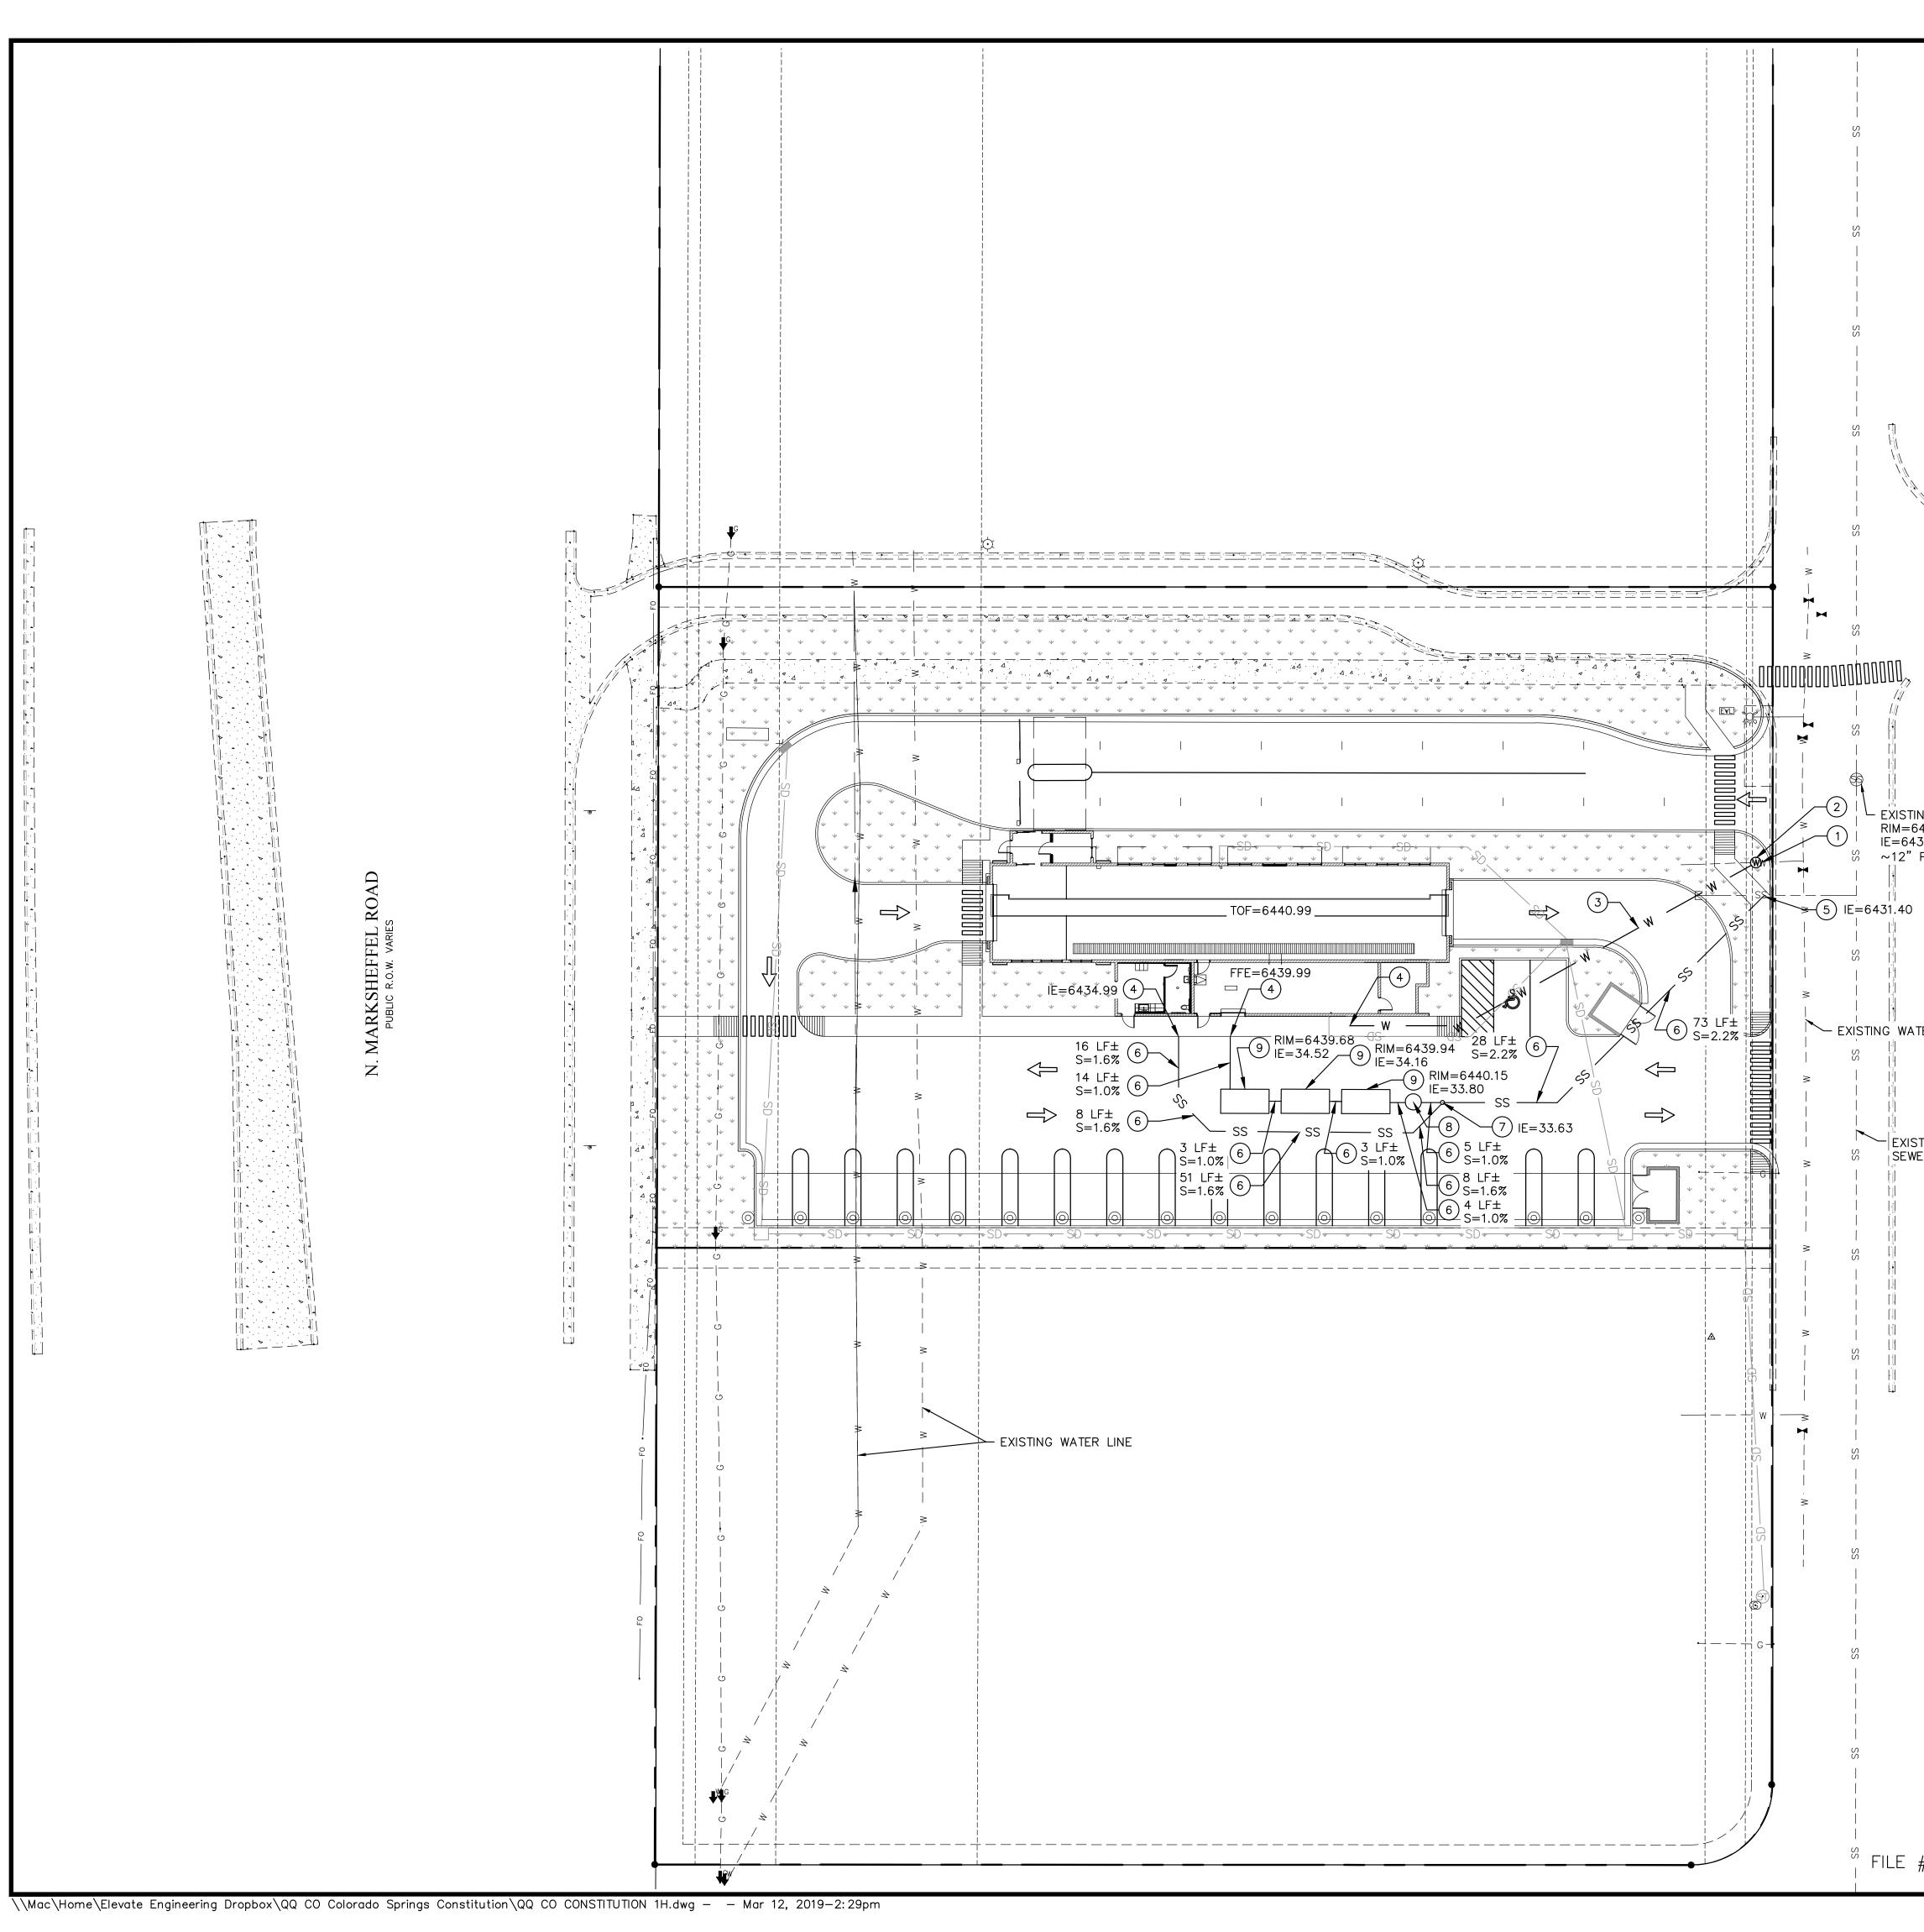


	PROPERTY/ROW LINE         EXISTING CURB AND GUTTER         PROPOSED CURB AND GUTTER         PROPOSED STORM DRAIN LINE         EXISTING STORM DRAIN LINE	VO. REVISIONS BY DATE
	PROPOSED SEWER LINE-ss - ss - ss - ss -EXISTING SEWER LINE-ssss -PROPOSED WATER LINEwEXISTING WATER LINEwEASEMENT	ELEVATE ENGINEERING 492 WEST 1200 NORTH SPRINGVILLE, UT 84663 PHONE: (801) 718-5993 larvin@elevateng.com
ING SEWER MANHOLE 5443.01 -31.01 PVC	<ul> <li>DESIGN NOTES:</li> <li>(1) CONNECT TO EXISTING WATER STUB.</li> <li>(2) INSTALL 2" WATER METER PER CITY STANDARD DRAWING. SEE SHEET C-5 FOR DETAILS.</li> <li>(3) INSTALL 2" POLY WATER LINE PER CITY STANDARDS.</li> <li>(4) END ALL UTILITIES 5' FROM BUILDING, SEE PLUMBING PLANS FOR CONTINUATION.</li> <li>(5) CONNECT TO EXISTING SEWER STUB PER CITY STANDARDS. SEE SHEET C-5 FOR DETAILS. CONTRACTOR TO VERIFY LOCATION AND ELEVATION PRIOR TO ANY CONSTRUCTION.</li> <li>(6) INSTALL 6" PVC SDR-35 SEWER PIPE AT 1% MIN. SLOPE.</li> <li>(7) INSTALL 6" CLEANOUT.</li> <li>(8) INSTALL 48" SANITARY SEWER SAMPLING MANHOLE PER APWA PLAN 411. SEE SHEET C-5 FOR DETAILS. RIM=6440.30 IE=6433.76 OUT=6433.68</li> </ul>	
STING 12" PVC ÆR LINE	<ul> <li>INSTALL 1500 GAL. GREASE INTERCEPTOR/RECLAIM TANKS. INSTALL 3' OF 6" Ø PVC SDR-35 SEWER PIPE AT 1% MIN. SLOPE BETWEEN TANKS. COORDINATE WITH PLUMBING PLANS FOR DETAILS.</li> <li>CENERAL NOTES:         <ol> <li>CONTRACTOR TO NOTIFY BLUE STAKES PRIOR TO CONSTRUCTION</li> <li>CONTRACTOR TO VERIFY LOCATION AND ELEVATION OF ALL EXISTING UTILITY LINES AND STRUCTURES PRIOR TO CONSTRUCTION</li> <li>ALL PROPOSED WATER LINES TO HAVE A MINIMUM OF 5' OF COVER</li> <li>ALL SEWER, WATER AND STORM DRAIN PIPES SHALL BE BACKFILLED WITH SELECT GRANULAR FILL AS PER <u>CITY</u> STANDARDS.</li> <li>ANY OFF SITE DAMAGE TO EXISTING ASPHALT, CURB &amp; GUTTER, LANDSCAPING AND DRAINAGE PLAN FOR CONSTRUCTION OF SEWER AND WATER LINES.</li> <li>ALL WORK TO BE ACCORDING TO <u>CITY</u> STANDARDS.</li> </ol> </li> <li>PRIVATE UTILITIES CONTRACTOR TO CONTACT THE FOLLOWING COMPANIES PRIOR TO ANY CONSTRUCTION. EXACT LOCATION OF THESE UTILITIES TO BE DESIGNED AND COORDINATED BY THE FOLLOWING COMPANIES.</li> <li>DOMINION ENERGY – 801–853–6597 ROCKY MOUNTAIN POWER – 801–756–1310 CENTURY LINK – 801–536–6975</li> </ul>	QUICK QUACK CONSTITUTION UTILITY PLAN 2437 MARKSHEFFEL ROAD COLORADO SPRINGS, CO 80951
# PPR-19-004	Know what's below. Call before you dig.	SHEET:

DATE: Mar 12, 2019

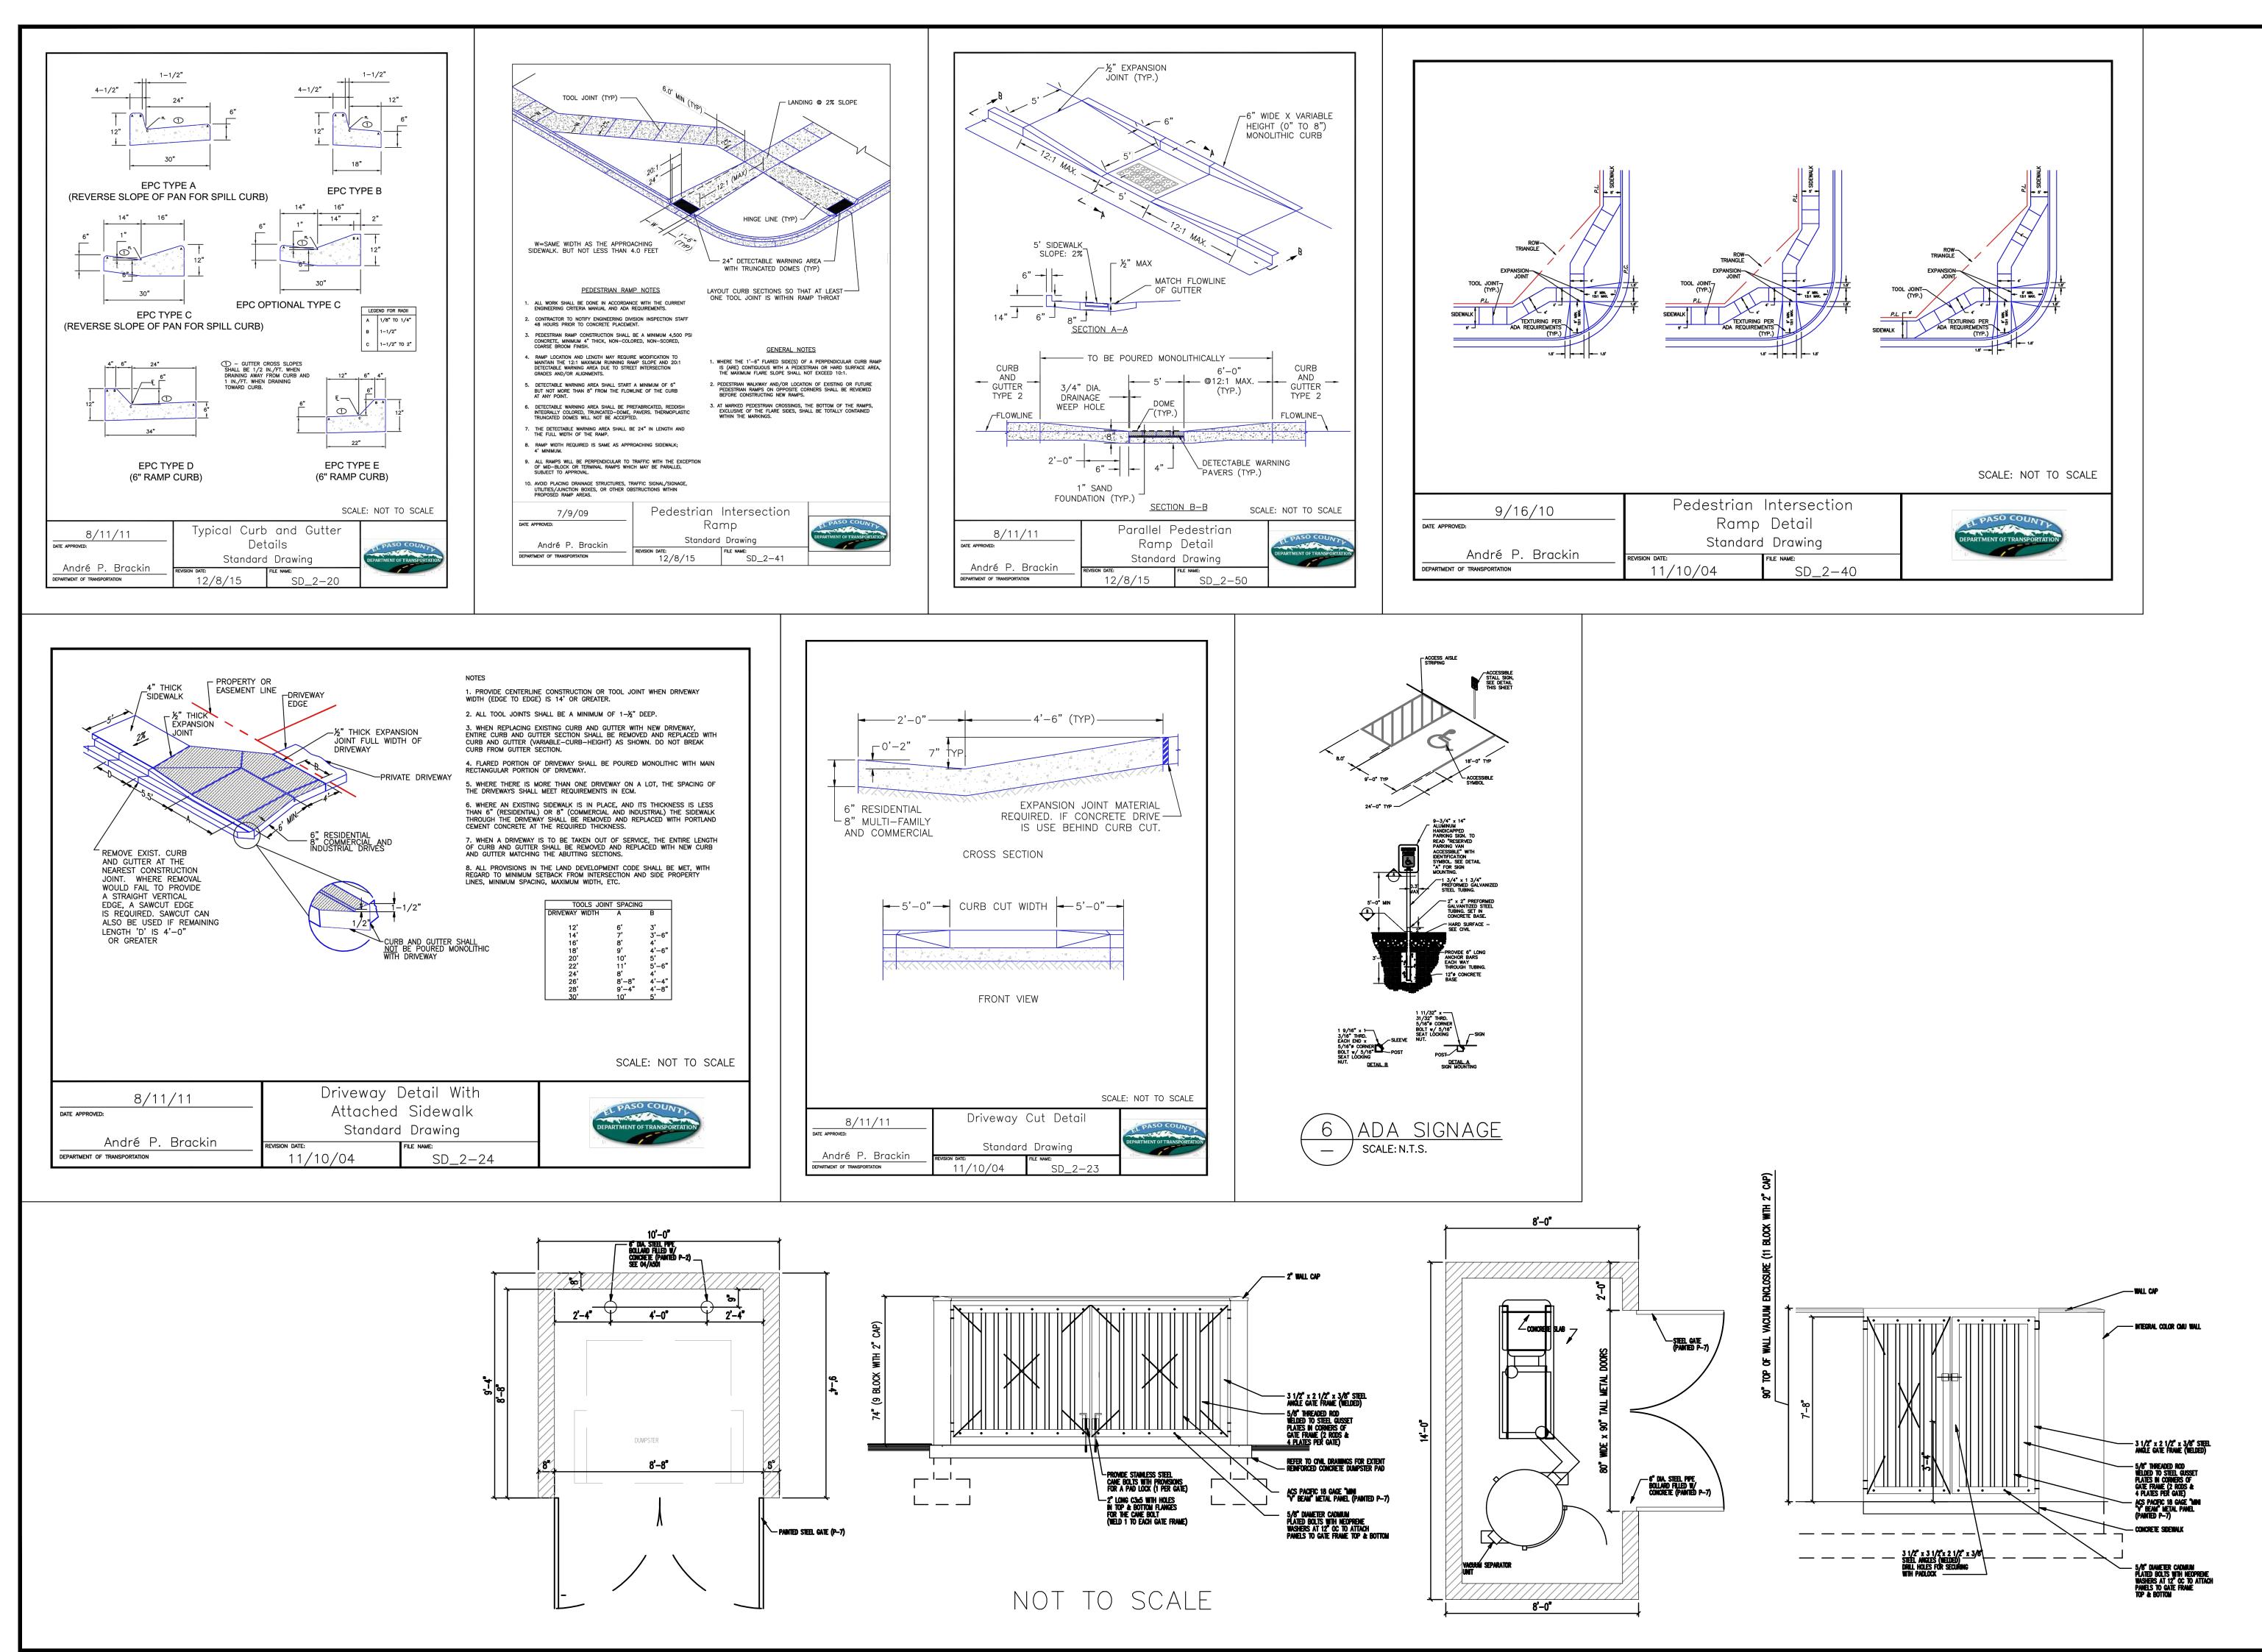

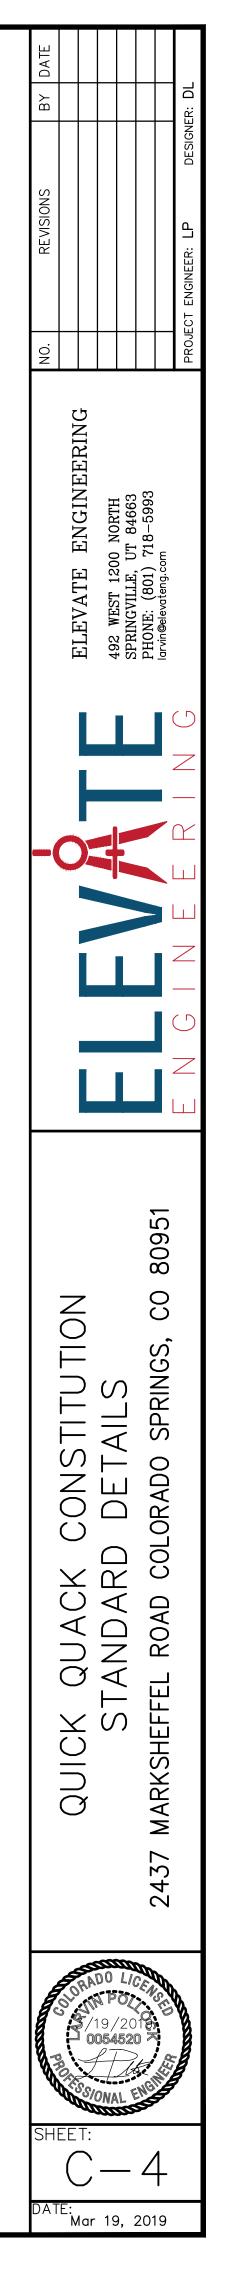

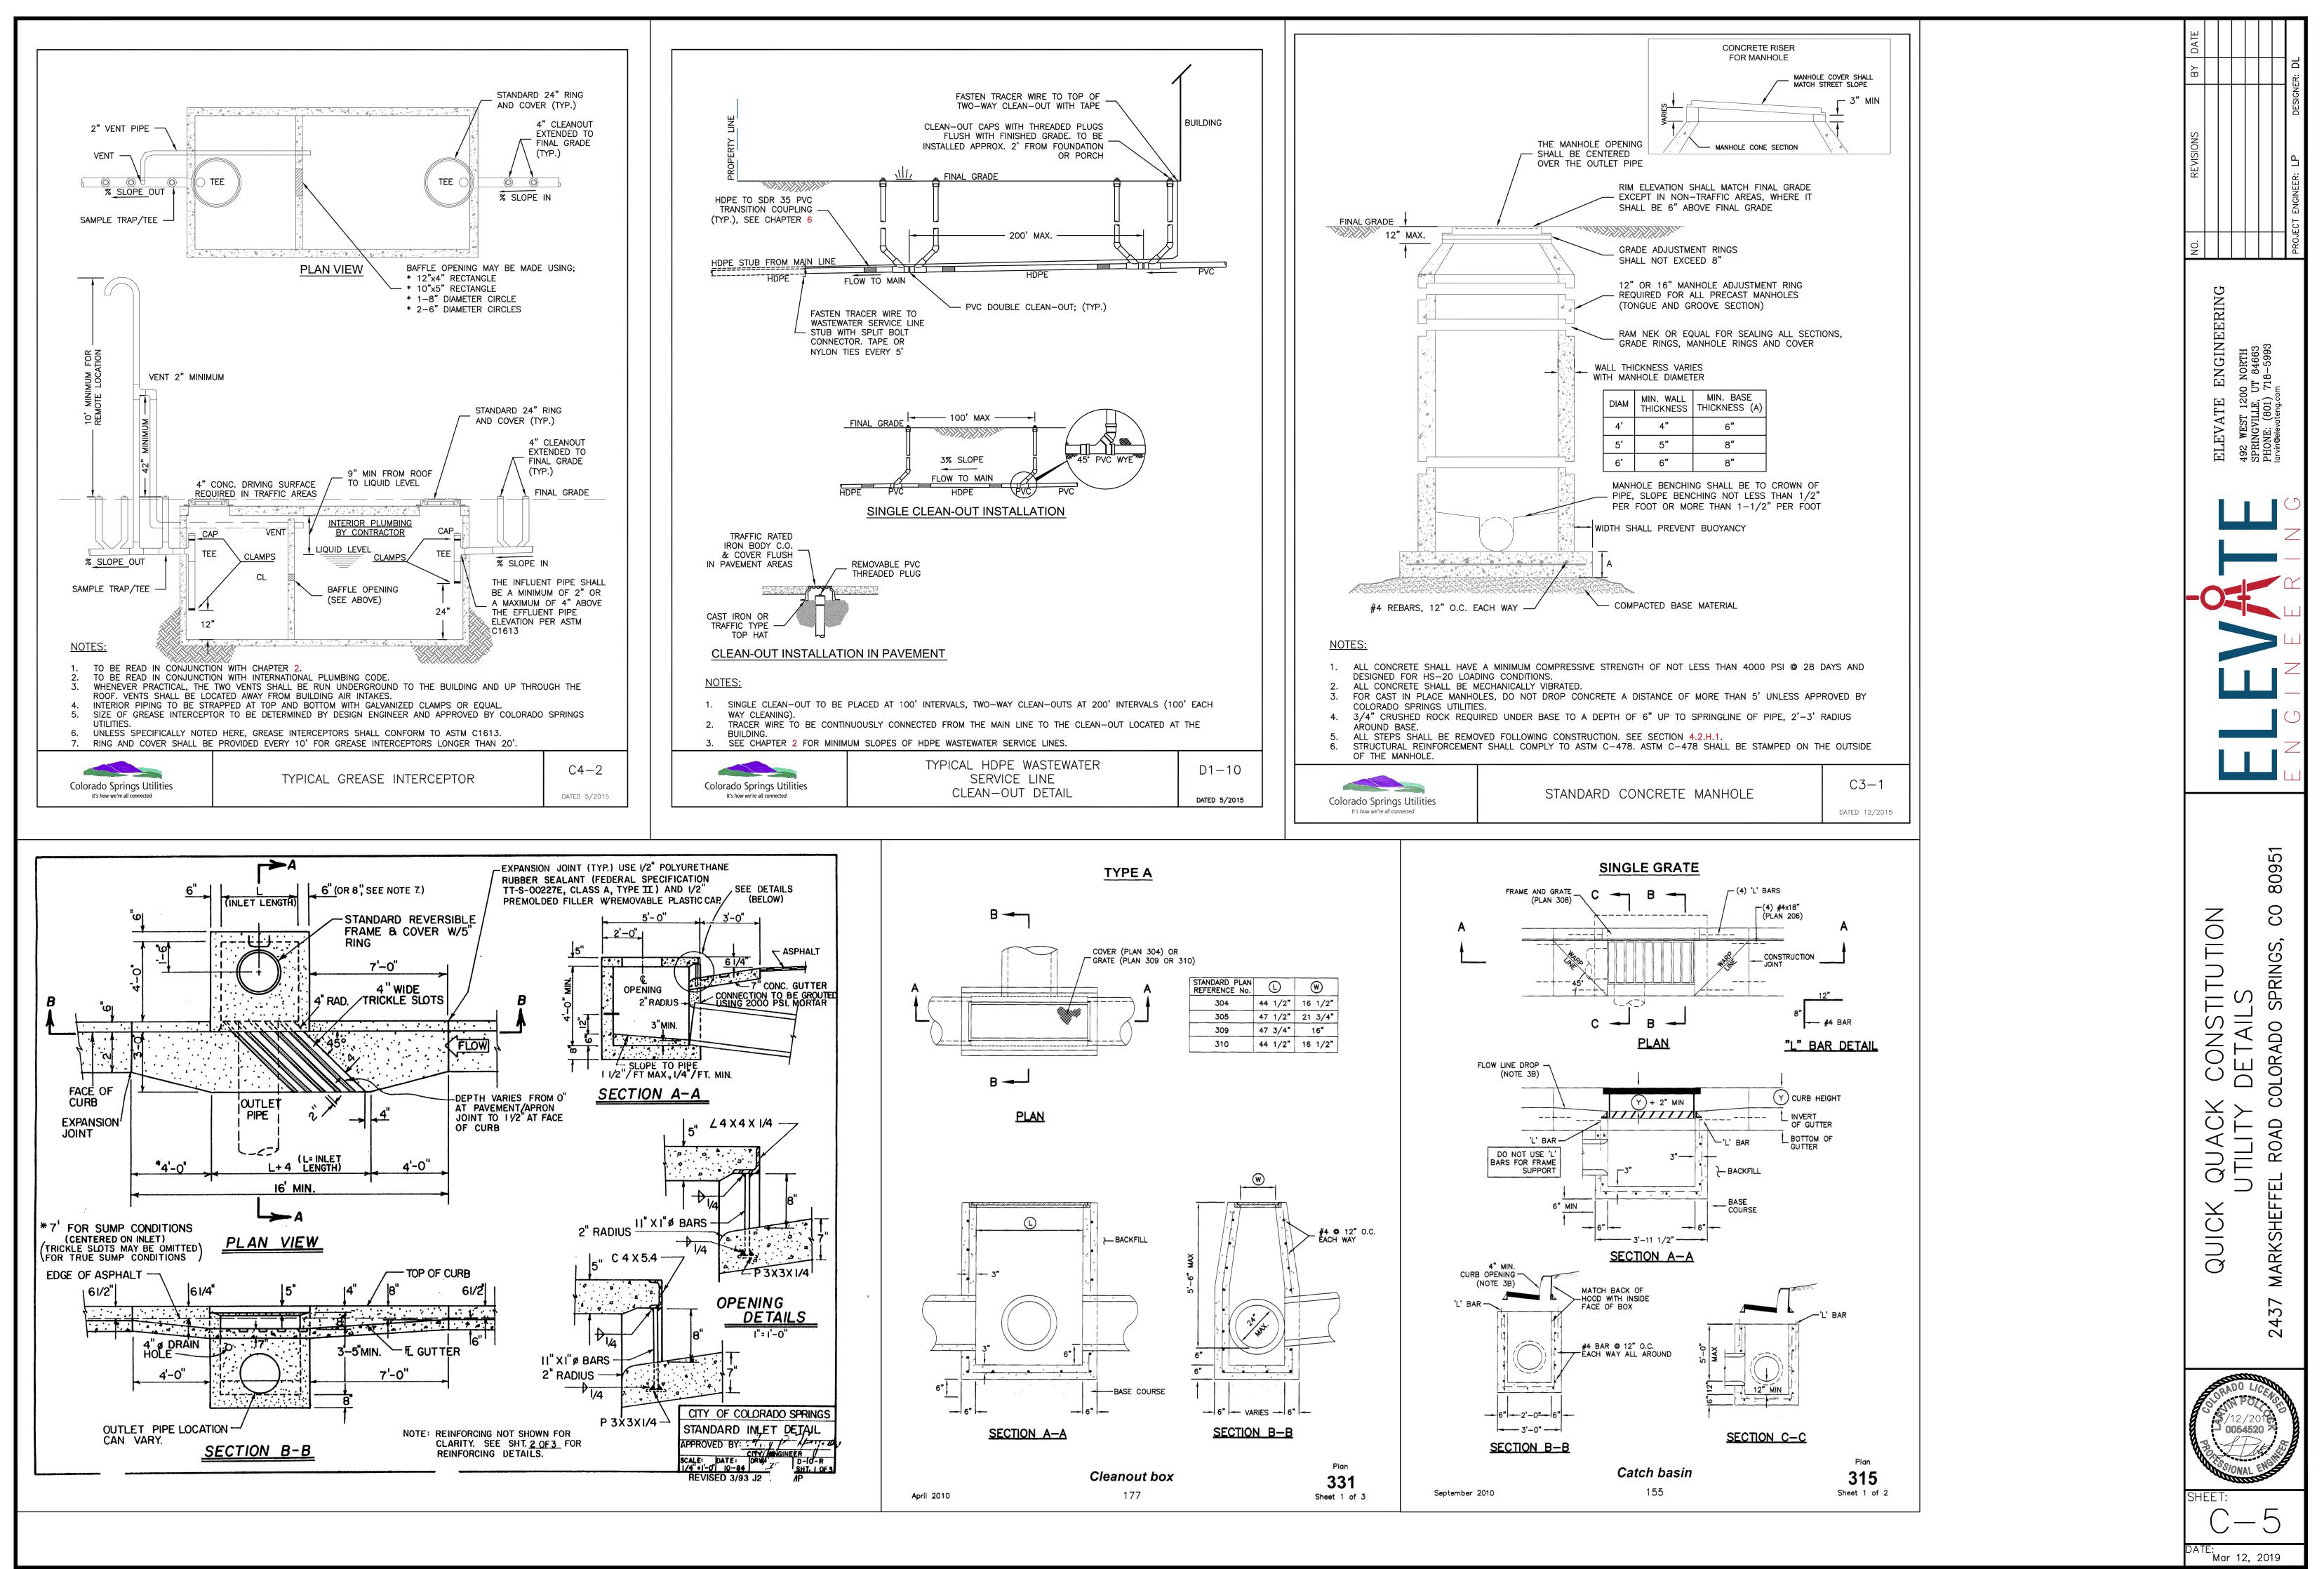

## REFERENCE NOTES SCHEDULE

SYMBOL	DESCRIPTION	QTY
1-01	PLANTING AREAS. WOOD MULCH. SEE SPECIFICATIONS.	12,583 sf
1-02	EXISTING PARKSTRIP TO REMAIN.	

### PLANT SCHEDULE

	CONIFERS	BOTANICAL NAME / COMMON NAME	<u>CONT</u>	CAL	<u>SIZE</u>	QTY
ىبى		Abies concolor `Candicans` / Candicans White Fir	B & B		6`	3
Juny	• E	Pinus aristata / Bristlecone Pine	B & B		6`	1
	DECIDUOUS TREES	BOTANICAL NAME / COMMON NAME	CONT	CAL	<u>SIZE</u>	QTY
<i>—</i>	$\mathbf{\cdot}$	Fraxinus pennsylvanica `Summit` / Summit Ash	B & B	1.5"Cal		6
	• >	Prunus virginiana `Canada Red` / Canada Red Chokecherry	B & B	1" Cal		6
	SHRUBS AM	<u>BOTANICAL NAME / COMMON NAME</u> Arctostaphylos uva-ursi `Massachusetts` / Massachusetts Manzanita	<u>CONT</u> 5 gal			<u>QTY</u> 28
	CE	Cercocarpus montanus / Alderleaf Mountain Mahogany	5 gal			7
	CF	Cornus stolonifera `Farrow` / Arctic Fire Dogwood	5 gal			70
	Jb	Juniperus horizontalis 'Blue Chip' / Blue Chip Juniper	5 gal			41
	PB	Prunus besseyi `Pawnee Buttes` / Sand Cherry	5 gal			44
	Rf	Rhamnus frangula `Columnaris` / Tall Hedge Buckthorn	5 gal			10
	ANNUALS/PERENNIALS Wg	BOTANICAL NAME / COMMON NAME Gaura lindheimeri / Wandflower	<u>CONT</u> 1 gal			<u>QTY</u> 40
	PF	Penstemon x `Firebird` / Firebird Beard Tongue	1 gal			41
	<u>GRASSES</u> M	BOTANICAL NAME / COMMON NAME Muhlenbergia montana / Mountain Muhly	<u>CONT</u> 1 gal			<u>QTY</u> 32
	Sg	Panicum virgatum / Switch Grass	1 gal			51

DUE TO THE SCALE AND NATURE OF THE SITE, ONLY ONE HYDROZONE WAS NEEDED.

Name of project:	QUICK QUACK CARWASH	Date:	19 DECEMBER 2018
name of project.			

Climate zone (from Figure 4 of Landscape Policy Manual) - circle one:

Foothills

Foothills & Plains

Plains

#### **Plant Communities**

- to be labeled by number(s) on diagram:

- **1** Semiarid Shrublands
- **2** Pinon-Juniper Woodlands
- **3** Prairie

ON: PRIOR TO PERFORMING ANY WORK ON THI

- **4** Lower Elevation Riparian
- **5**—Foothill Shrublands
- 6 Ponderosa Pine Forest
- **7** Upper Elevation Riparian
- **8** Douglas-fir Forest

Hydrozones (supplemental water) - to be labeled by letter(s) on diagram:

**V** - Very Low (0 to 7 inches per year)


**L** - Low (7 to 15 inches per year)

M - Moderate (15 to 25 inches per year)

**H** - High (more than 25 inches per year)

FING PERFORMED ACCORDING TO THESE PLANS ABOVE OR BELOW GROUND. IE CONDITIONS ARE FOUND THAT MAY PREVENT WORK FROM BEING PERFORMED AS PER PLAN. CONTRACTOR SHALL CONTACT LANDSCAPE ARCHITECT PRIOR


TOTAL INTERNAL LANDSCAPE PROVIDED: 12,583 SF.

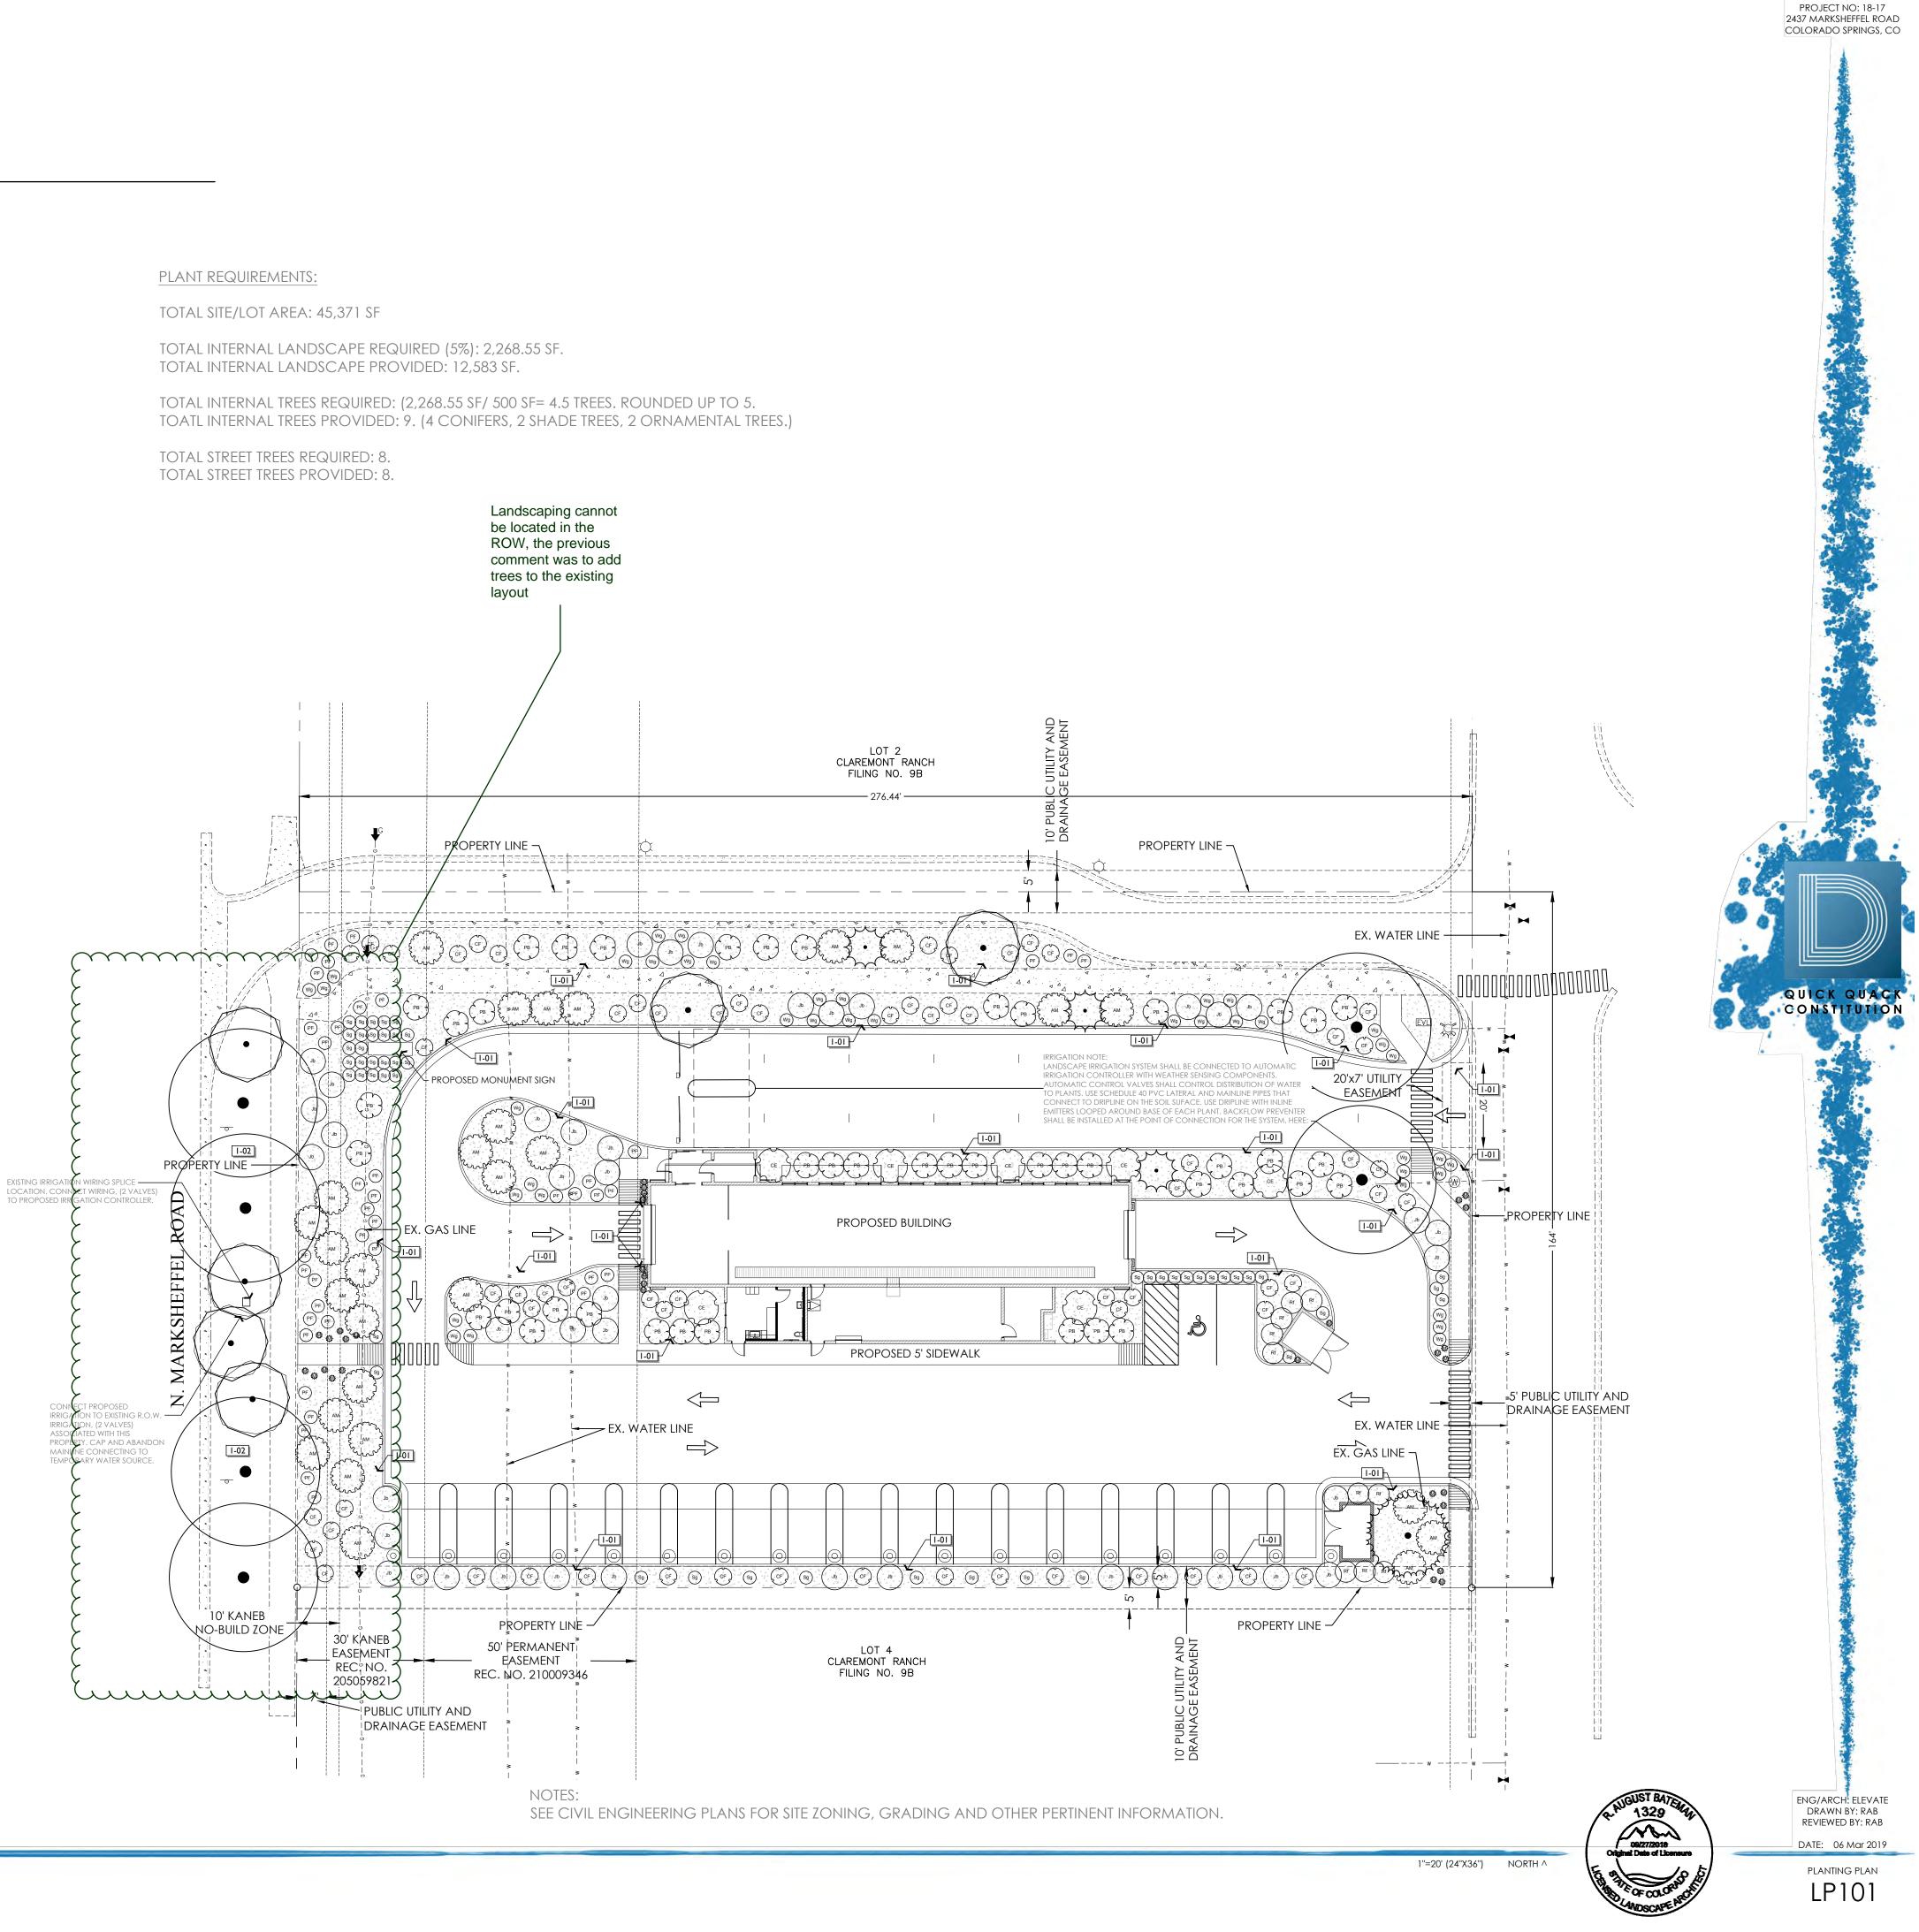

LIVE

DESIGN

www.livedsgn.com

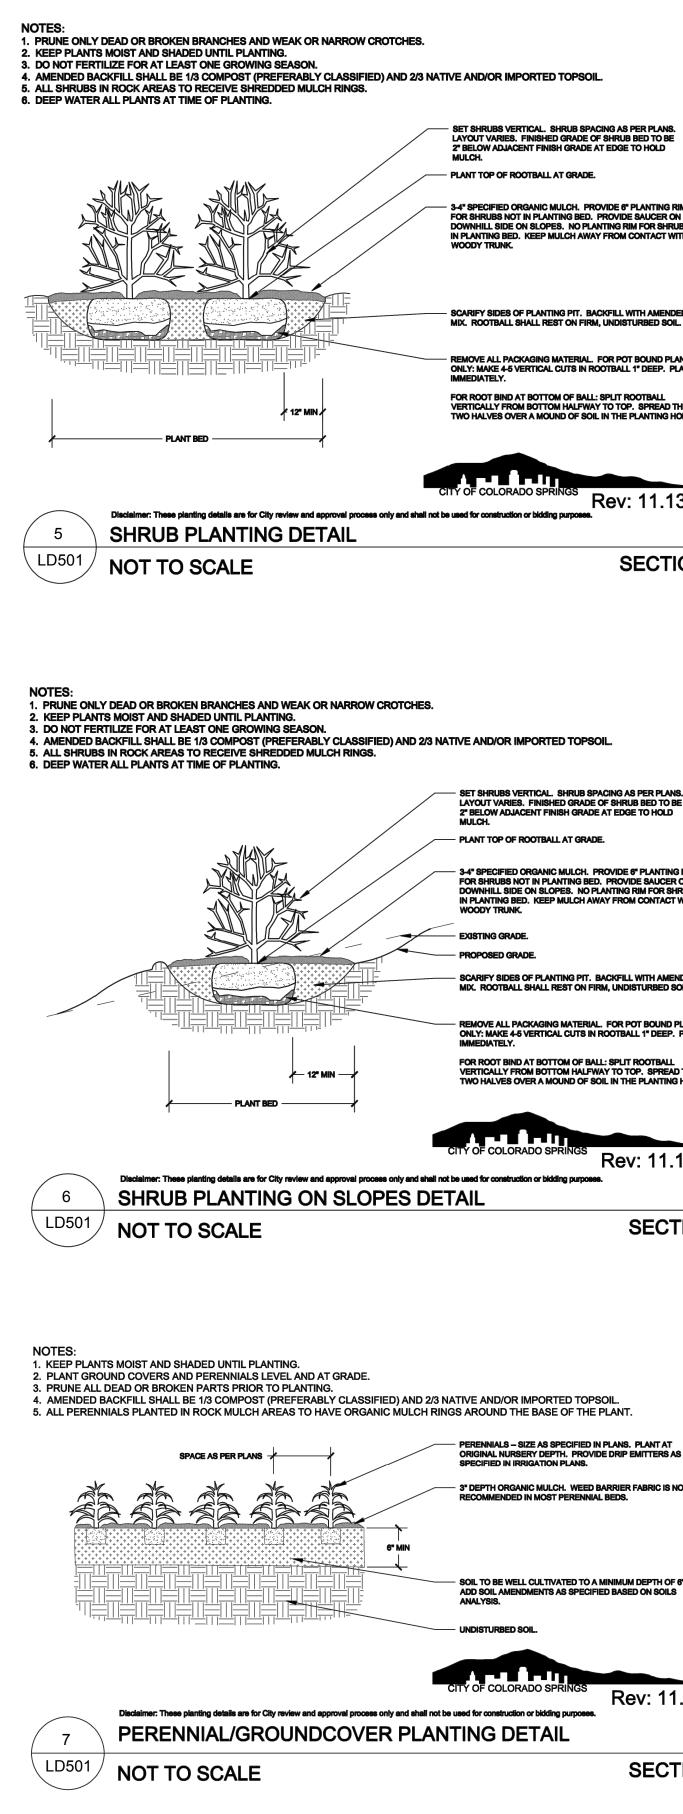

ENTION: PRIOR TO PERFORMING ANY WORK ON THIS PLAN (

SEING PERFORMED ACCORDING TO THESE PLANS ABOVE OR BELOW GROUND. IF CONDITIONS ARE FOUND THAT MAY PREVENT WORK FROM BEING PERFORMED AS PER PLAN, CONTRACTOR SHALL CONTACT LANDSCAPE ARCHITECT PRIOR TO PROCEEDING. ANY DAMAGE TO UTILITIES SHALL BE THE CONTRACTORS SOLE RESPONSIBILITY (I.E. ELECTRICAL, GAS, WATER, SEWER, ETC.). EVERY EFFORT HAS BEEN MADE TO ENSURE ACCURACY WITH THESE DRAWINGS. QUANTITIES (IF and

sf) listed are for reference only. Contractor shall verify all measurements and quantities on these plans. Architect shall not be responsible for discrepancies between quantities listed in legends and plan. WHERE DISCREPANCIES EXIST BETWEEN SPECIFICATIONS. DETAILS, AND/OR DRAWINGS. CONTRACTOR SHALL CONTACT LANDSCAPE ARCHITECT PRIOR TO PROCEEDING. CONTRACTOR SHALL INSPECT THE SITE TO VERIFY THAT DRAWINGS. ARE CONSISTENT WITH SURVEYED BASE INFORMATION. DURING CONSTRUCTION IF DISCREPANCIES ARE FOUND BETWEEN THESE PLANS AND THE SITE, CONTRACTOR SHALL CONTACT THE LANDSCAPE ARCHITECT PRIOR TO PROCEEDING.

- SET SHRUBS VERTICAL. SHRUB SPACING AS PER PLANS. LAYOUT VARIES. FINISHED GRADE OF SHRUB BED TO BE 2° BELOW ADJACENT FINISH GRADE AT EDGE TO HOLD

- 3-4" SPECIFIED ORGANIC MULCH. PROVIDE 6" PLANTING RIM FOR SHRUBS NOT IN PLANTING BED. PROVIDE SAUCER ON DOWNHILL SIDE ON SLOPES. NO PLANTING RIM FOR SHRUBS IN PLANTING BED. KEEP MULCH AWAY FROM CONTACT WITH WOODY TRUNK

- SCARIFY SIDES OF PLANTING PIT. BACKFILL WITH AMENDED SOIL MIX. ROOTBALL SHALL REST ON FIRM, UNDISTURBED SOIL

- REMOVE ALL PACKAGING MATERIAL. FOR POT BOUND PLANTS ONLY: MAKE 4-5 VERTICAL CUTS IN ROOTBALL 1" DEEP. PLANT

FOR ROOT BIND AT BOTTOM OF BALL: SPLIT ROOTBALL VERTICALLY FROM BOTTOM HALFWAY TO TOP. SPREAD THE TWO HALVES OVER A MOUND OF SOIL IN THE PLANTING HOLE.

Rev: 11.13.08

SECTION

- SET SHRUBS VERTICAL. SHRUB SPACING AS PER PLANS. LAYOUT VARIES, FINISHED GRADE OF SHRUB BED TO BE 2" BELOW ADJACENT FINISH GRADE AT EDGE TO HOLD MULCH.

- 3-4" SPECIFIED ORGANIC MULCH. PROVIDE 6" PLANTING RIM FOR SHRUBS NOT IN PLANTING BED. PROVIDE SAUCER ON DOWNHILL SIDE ON SLOPES. NO PLANTING RIM FOR SHRUBS IN PLANTING BED. KEEP MULCH AWAY FROM CONTACT WITH

SCARIFY SIDES OF PLANTING PIT. BACKFILL WITH AMENDED SOIL MIX. ROOTBALL SHALL REST ON FIRM, UNDISTURBED SOIL.

- REMOVE ALL PACKAGING MATERIAL. FOR POT BOUND PLANTS ONLY: MAKE 4-5 VERTICAL CUTS IN ROOTBALL 1" DEEP. PLANT

FOR ROOT BIND AT BOTTOM OF BALL: SPLIT ROOTBALL VERTICALLY FROM BOTTOM HALFWAY TO TOP. SPREAD THE TWO HALVES OVER A MOUND OF SOIL IN THE PLANTING HOLE.

Rev: 11.13.08

SECTION


NNIALS - SIZE AS SPECIFIED IN PLANS. PLANT AT


- 3" DEPTH ORGANIC MULCH. WEED BARRIER FABRIC IS NOT RECOMMENDED IN MOST PERENNIAL BEDS.

SOIL TO BE WELL CULTIVATED TO A MINIMUM DEPTH OF 6 ADD SOIL AMENDMENTS AS SPECIFIED BASED ON SOILS ANALYSIS.

Rev: 11.13.08

SECTION

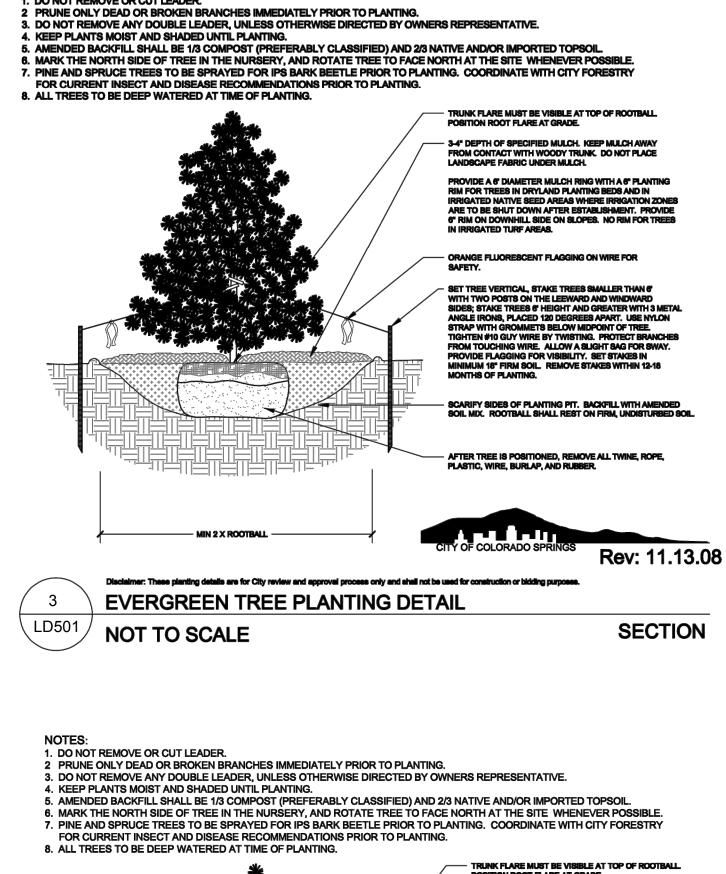

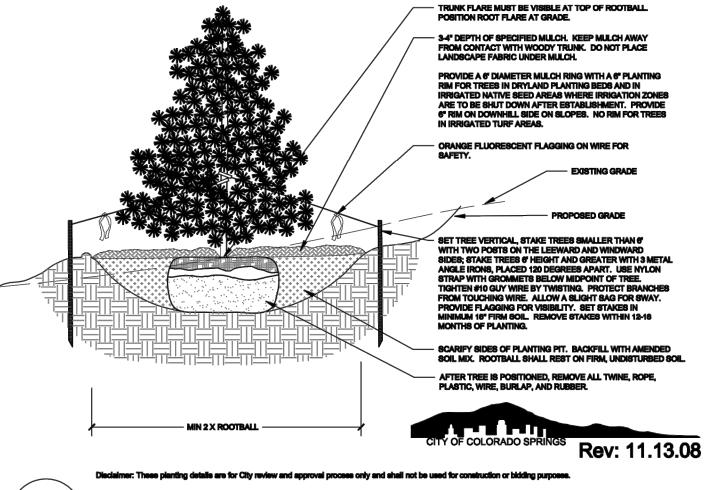




NOTES:

1. DO NOT REMOVE OR CUT LEADER.

EVERGREEN TREE PLANTING ON SLOPES DETAIL NOT TO SCALE

SECTION

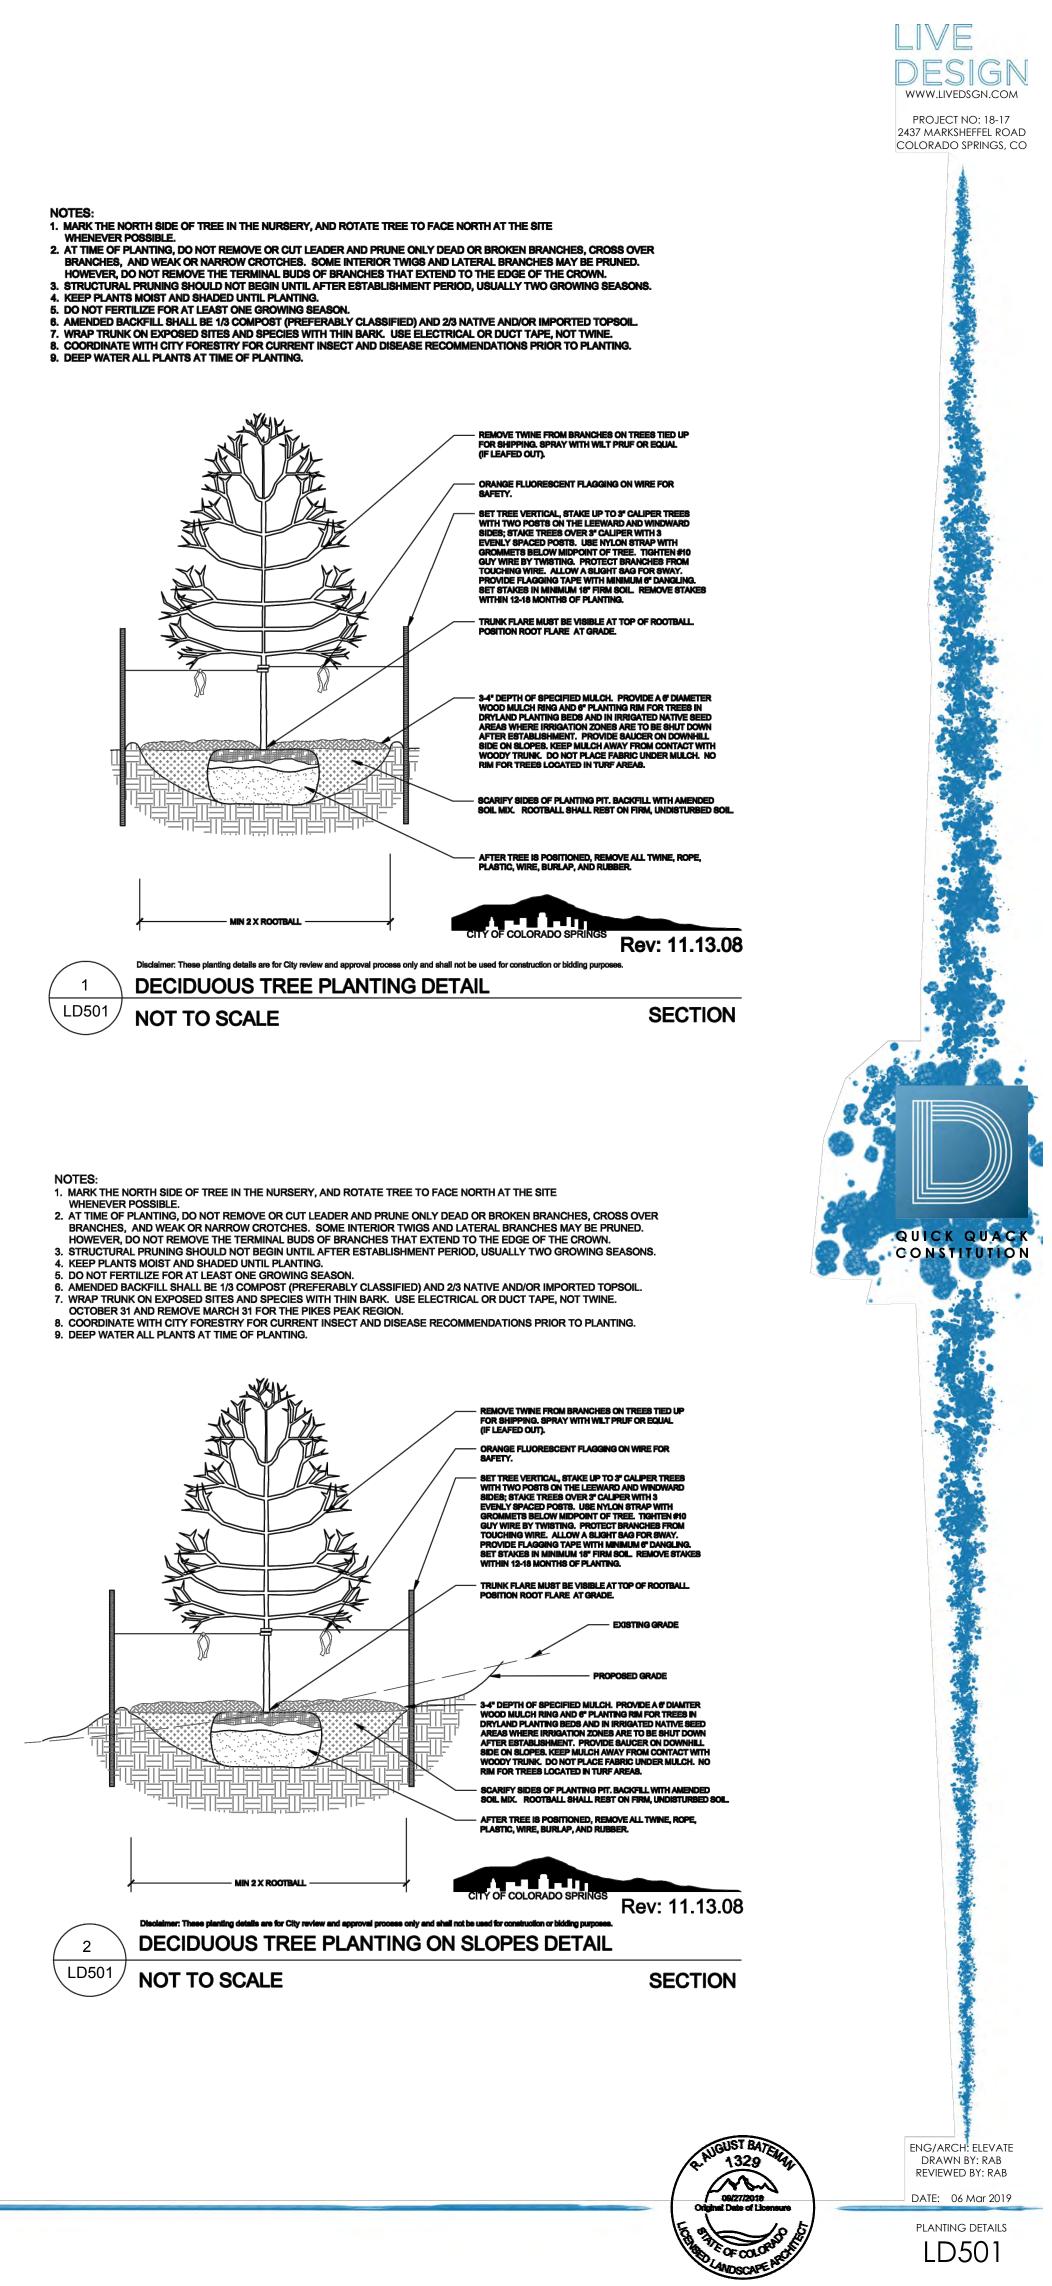

#### ION 1 - PLANT MATERIAL

#### 1.01 SCOPE OF WORK

A. Work as evident on drawings and specified herein or required to complete all landscaping and shall include, but not necessarily limited to the following work:

- 1. Furnish imported topsoil from outside sources as needed.(see sub-section 2.01.)
- 2. Ensure all necessary permits are obtained prior to construction and staging.
- 3. Excavate tree/shrub pits.
- 4. Provide and plant all materials indicated on plan and plant list.
- 5. Stake and protect all trees and planted areas as specified and detailed.
- 6. Clean all areas prior to Acceptance of the Work, including debris, stains, and dirt from walks and other surfaces.
- B. These specifications are complimentary to the drawings.
- C. Related Sections:
- SECTION 2 Turf Sod and Soil Preparation

**1.02 QUALITY ASSURANCE** 

A. Regulatory Requirements

1. Comply with applicable requirements of Federal, State and Local laws, regulations and codes having jurisdiction at the project site. Contractor shall be responsible for certificates of inspection of plant material that may be required by Federal and Local authorities to accompany shipments of plants.

**Reference Standards** 

1. "Standardized Plant Name" by the American Joint Committee of Horticultural Nomenclature. 2. "American Standard of Nursery Stock" by the American Association of Nurseryman

3. American National Standards Institute (ANSI); Publication Z60.1.

C. Substitutions

Source Quality Control

Contractor's Qualifications

1. Substitutions of plant material will not be permitted unless authorized in writing by the Landscape Architect. If proof is submitted that any plant specified is not obtainable, a proposal will be considered for use of the nearest equivalent size or variety with corresponding adjustment of Contract Price. Such proof shall be substantiated and submitted in writing to the Landscape Architect at least thirty (30) days prior to start of the work under this Section. These provisions shall not relieve Contractor of the responsibility of obtaining specified materials in advance if special growing conditions or other arrangements must be made in order to supply specified materials.

1. Plants shall be subject to inspection and approval by the Landscape Architect/Owner at place of growth and upon delivery for conformity to specifications. Such approvals shall not impair the right of inspection and rejection during progress of the Work. Submit written request for inspection of plant material at place of growth and quantity of plants to be inspected. The Landscape Architect reserves the right to refuse inspection at this time if, in his judgement, a sufficient quantity of plants is not available for inspection.

2. All plants may be inspected at the nursery by the Landscape Architect or Owner and shall be tagged with self-locking tags. Plants delivered to the site without these tags or with broken tags shall be sufficient reason for rejection.

1. All bidders shall be required to present proof of their qualifications, contract sample, Utah state licensure, insurance coverage, experience, and ability to perform the scope of work set forth in these specifications according to the following construction deadlines pending unforeseen delays related to the weather or other conditions outside the contractors control.

1.03 PROJECT PERSONNEL AND SITE PROTECTION

ATTENTION:

The Contractor shall have a designated foreman in direct and personal charge of the work, and the foreman shall be on the job at least eighty-five (85) percent of the working hours. The Owner's Authorized Representative may "shut down" the work under contract if the supervision is not, in his opinion, adequate to protect the interests of the Owner. Such "shut down" time to be counted as working days and will not extend the time of the contract.

All existing site elements including but not limited to the following shall be protected: All existing utilities, existing hardscapes (drives/curbs/walks/patios), etc. shall be protected from impact damage of any sort, staining from leaky trucks or equipment, or other damage.

1.04 PACKAGING, DELIVERY, STORAGE AND HANDLING

A. Plants shall be properly marked for identification and for checking. Each block of plants and at least 25% of each variety of separate plants in any one shipment shall have legible labels securely attached upon delivery to the site. Product Handling:

During hot weather and when practical, the contractor may be required to transport plant materials between sunset and sunrise if transported in an open trailer or un-refrigerated box.

Dug material should be maintained and watered as required at the nursery to guarantee their vitality and health until shipping

Protect all trunks, stems, branches, and root balls during tree tying, wrapping and loading operations from damage.

Load balls or containers onto transport vehicle and secure in a manner that protects the structural integrity of the root balls. The contractor shall be solely responsible for the safe transportation of plants to the site and their condition upon arrival. Trees

damaged, dehydrated or abused during transit or storage will be rejected

Plant materials shall not be stored on concrete or asphalt or left exposed to the sun.

Roots and balls of plants shall be adequately protected at all times from the sun and drying winds. The Landscape Architect may inspect any phase of this operation and may reject any plant material improperly handled during any

phase of this operation. Nothing in this Section shall be interpreted as relieving the contractor of the responsibility of providing healthy, viable plants, nor shall it

have any effect upon the terms of the warranty specified herein. Deliver packaged materials in containers showing weight, analysis and name of manufacturer. Protect materials from deterioration

during delivery, and while stored at the site.

Delivery and plantings, storage of dry bulk materials and other shall be coordinated with project General Contractor to ensure appropriate staging area. Protect dry bulk materials from inclement weather conditions such as wind and moisture. 1.06 SUBMITTALS

approval by the Landscape Architect prior to commencement of all work under this contract for the following items:

1. Specified granular and tablet Fertilizers (certification, rate of application and number to tablets per plant pit) 2. Weed control, Pre-emergent and anti-desiccant (certification)

3. Tree guys (literature) 4. Lawn Edging (literature) See plan

5. Wood Mulch (sample)

work in area of site. Once accepted, revise dates only as approved in writing, after documentation of reasons for delay.

1.07 PROJECT WARRANTY

A. Warranty trees and other plant materials, for a period of one year after date of substantial completion, against defects including death and unsatisfactory growth, except for defects resulting from neglect by Owner, abuse or damage by others, or unusual phenomena or incidents which are beyond Landscape Installer's control.

B. Remove and replace trees or other plants found to be dead or in unhealthy condition during warranty period. Replace trees or other plants that are in doubtful condition at end of warranty period; unless, in opinion of Architect, it is advisable to extend warranty period for a full growing season.

C. All replacements shall be plants of the same kind, size, and quality as originally specified and they shall be furnished, planted, guyed and maintained as specified at no additional cost.

D. Another inspection shall be conducted at end of extended warranty period to determine acceptance or rejection. Only one replacement (per tree or plant) will be required at end of warranty period, except for losses or replacements due to failure to comply with specified requirements.

NION: prior to performing any work on this plan contractor shall identify through bluestakes and on-site observation any and all utilities and hazards or conditions that may prevent work fro SEING PERFORMED ACCORDING TO THESE PLANS ABOVE OR BELOW GROUND. IF CONDITIONS ARE FOUND THAT MAY PREVENT WORK FROM BEING PERFORMED AS PER PLAN, CONTRACTOR SHALL CONTACT LANDSCAPE ARCHITECT PRIOR

#### 2.01 SOIL, SOIL AMMENDMENTS

A. Topsoil may or may not be stockpiled on site for contractor use.

Contractor shall ensure the following amount of topsoil is found in all planter and lawn areas over a non-compacted sub-grade

• Planter Areas: 12 inch depth.

Contractor shall amend top soil on site based on the results of soil test.

#### Contractor shall have agronomy soils test performed or provide a soil certificate for proposed imported soil. Test results shall be submitted to Landscape Architect for approval prior to delivery of the topsoil to jobsite. Imported topsoil shall be obtained from well-drained arable land and shall be free from sub-soil, refuse, roots, heavy or stiff clay, stones 1 inch and larger in largest dimension, coarse sand, sticks, brush, litter, and other deleterious substances. Amend soil as needed to meet the 'Ideal' parameters in the chart below:

A. Furnish two (1) copies of manufacturer's literature, plans, samples, certifications, delivery tickets, or laboratory analytical data for

Submit proposed plant placement schedule to owner, indicating dates for each type of landscape work during normal seasons for such

Soil Parameter	Acceptable	Ideal	Non Ideal - Possibly Toxic	Notes
рн	5.5-8.4	6.0-7.5	< 5.5 <sup>1</sup> and > 8.5 <sup>2</sup>	low pH corrected by addition of lime (lab can give amount needed); high pH difficult to correctinstead solve sodium problems if any and deal with fertility issues caused by high pH
EC, dS/m	< 2.5	<1.0-1.5	> 4.0-6.0	lower salt content by leaching with good quality water (solve sodium problems if any prior to leaching)
CaCO3 (calcareousness), %	<10	d	>30-80	difficult to correct; generally requires more phosphorus and some micronutrient fertilizers
SAR <sup>3</sup> (ESP)	< 8 (< 10)	<4 (<5)	> 11 (>14)	lower by addition of gypsum or similar (lab can give amounts needed)
OM, %	>1.0	> 3.0	N/A	
Sand % <sup>4</sup>	< 85%	< 75%	N/A	
Silt/Clay ratio	<2 if total of	two is 25-35% (ratio is not critical if outsic	le this range)	
CEC <sup>5</sup> ,	>12	15-25	N/A	
color	all	red, brown, black (avoid gray & yellow)	N/A	
aggregate (5-20 mm) stability, not dispersed (cloudy)	>1 hour	> 2 hours	N/A	
Saturated Infiltration Rate (as measured after 3 full irrigations)	>0.2 inch/hour	>0.6 inch/hour	<0.1 inch/hour	difficult to correct; select different soil
Subsoil drainage rate	> 0.04 inch/hour	>0.1 inch/hour	<0.01 inch/hour	difficult to correct; select different soil
Bulk Density, g/cm <sup>3</sup>	1.3-1.6	1.3-1.5	>1.7-1.8	correct with tillage, but does not always correct problem permanently
NO <sub>3</sub> -N <sup>5</sup> , ppm	any	any	see EC	add fertilizer to meet plant needs
P - Bicarbonate, ppm	any	10-60 ppm	N/A	add fertilizer to meet plant needs; if P is high = environmental problems
P - Bray P1, ppm (only noncalcareous)	any	20-80 ppm	N/A	add fertilizer to meet plant needs; if P is high = environmental problems
P - Mehlich 3, ppm (only				add fertilizer to meet plant needs; if P is high = environmental
noncalcare ous)	any	22-90 ppm	N/A	problems
K, ppm	150-300	> 300	N/A	add fertilizer to meet plant needs
Ca, ppm	> 300	> 500	N/A	add fertilizer to meet plant needs
Mg, ppm	>50	100-800	N/A	add fertilizer to meet plant needs
Na	see SAR (ESP)			
s <sup>7</sup> , ppm	any	<200	see EC	add fertilizer to meet plant needs
Zn, ppm	>1.0	< 1.0-5.0	>100?	add fertilizer to meet plant needs if value is low; if too high then rejer soil
Fe, ppm	>4	>6 (and pH < 7.2 or tolerant species)	Unlikely	
Mn, ppm	>6	>8	>80?	add fertilizer to meet plant needs if value is low; if too high then reject soil
	4.1.5	157		add fertilizer to meet plant needs if value is low; if too high then rejer
Cu, ppm	0.2-2.0	0.4-2.0	> 20?	soil
B, ppm	0.8-2.0	1-2	>2-4	add fertilizer to meet plant needs if value is low; if too high leach B from soil
Cl, ppm	any	12-175	> 175-700	add fertilizer to meet plant needs if value is low; if too high leach Cl from soil
"Al, ppm	1.0-10	0	>10-20	if high, raise soil pH to greater than 5.5 with lime (see pH)

2.02 PLANT MATERIALS

A. Plants shall be typical of their species and variety, have normal growth habits, well developed branches, dense foliage, vigorous, ibrous root system

Plants shall be free from defects and injuries. All shipments of plant stock shall comply with existing State and Federal laws and regulations governing plant disease and infection and interstate movement of nursery stock

Quality and size of plants, spread of roots, and size of balls shall be in accordance with USA-Z60.1-1973, "American Standard for Nursery Stock" as published by the American Association of Nurserymen. The caliper of trees shall be measured six (6) inches above the surface of the ground. Plant lists indicate minimum size requirements only. Plant materials shall be equal to or greater in size than those specified

Plants shall not be pruned before planting.

All trees must have straight trunks with single leader intact, except in the case of specimen plants or otherwise indicated by the plan. Bark shall be free of abrasion, all cuts over 1-1/4" shall have callused over.

Trees shall not be accepted which have had their leaders cut or which have leaders damaged so that cutting is necessary. Trees and shrubs shall be true to name.

Upon request, Contractor shall furnish the landscape architect a list indicating the source of each of the different plants to be supplied. All Plants shall be ball and burlap or container grown unless otherwise indicated on the Plant Material List.

All plants shall be even in growth with balanced root and top growth and shall be No.1 in grade or type conforming to the latest edition of American Standard for Nursery Stock.

Plant material shall be nursery grown and shall have received the proper fertilizing, watering, root pruning and such other care as is normally given for a particular plant under nursery conditions. All plants shall be hardy under climate conditions similar to those in the locality of the project.

All material shall be freshly dug according to American Standard for Nursery Stock. All ball and burlap material shall be of firm earth from the original soil in which the plant grew. The ball shall be wrapped with burlap and tightly tied or enclosed in a tight fitting wire basket to hold it firm and intact. Any plants with broken or loose balls or manufactured balls will be rejected.

All plant material in containers shall have been established in that container. Any newly potted material will be rejected.

2.03 FERTILIZER FOR PLANT MATERIAL

A. Fertilize trees and shrubs with a fertilizer tablet having a slow release nitrogen, phosphorus and potash (20-10-5) plus sulphur and iron formulation. 21 gram tablets manufactured by Agriform or equal. Jobe Tree Spikes are acceptable. Execution: Position plant in hole and backfill by  $\frac{1}{2}$  the ball root height. Place tablet(s) beside the root ball about 1 inch from root tips. Do not place tablets in the bottom of the plant hole. Complete backfill, tamp and water.

•	1-2 Gallon Size:	1 Tablet
•	3-5 Gallon Size:	3 Tablets
•	15 Gallon Size:	7 Tablets
•	1.5" Caliper Trees:	6 Tablets
•	2" Caliper Trees:	8 Tablets
•	3" Caliper Trees:	12 Tablets

Any fertilizer that becomes caked or otherwise damaged, making it unsuitable for use will not be accepted. 2.04 ORGANIC/INORGANIC MULCH

Provide and place minimum three inch depth of medium wood mulch. Mulch shall be brown in color. No weed barrier fabric shall be installed under organic mulch. Submit sample to owner for approval prior to bulk delivery. 2.05 WEED CONTROL / PRE-EMERGENT

During construction, landscape contractor shall ensure all installed landscaped areas remain weed free. All spray applicated weed control shall be applied by a certified chemical applicator and shall adhere to all local and state governing codes and manufacturer's recommended application rates and processes. Contractor shall be aware of high wind conditions and shall in no case apply weed control during a wind event that may carry product beyond it's desired location.

Pre-Emergent weed killer shall be granulated and shall be "Treflan" or "Dacthal", or approved 12 month weed preventer. Product shall be delivered to the site in its original container, bearing the manufacturer's label and instructions for handling and application. Pre-Emergent shall be applied by landscape contractor following final topsoil grade and plant placement and prior to organic mulch placement. Care shall be taken to avoid spreading of Pre-Emergent on adjacent hardscapes and lawn areas. Ensure proper coverage as per manufacturer's recommendation.

3.01 GENERAL

A. Before commencing Contractor shall become familiar with and obtain any necessary permits required for staging and performing work on the property according to Colorado Springs City or other governing ordinances.

B Proceed with and complete landscape work as rapidly as portions of site become available, working within seasonal limitations for each kind of landscape work required. C. Plant or install materials during normal planting seasons for each type of landscape work required. Correlate planting with specified

maintenance periods to provide maintenance from date of substantial completion for that portion of the work. Actual planting shall be performed only when weather and soil conditions are suitable and in accordance with locally accepted practice and as approved by the landscape architect

D. Contractor shall be responsible to determine location of all underground utilities and perform work in a manner which will in all cases avoid possible damage. Hand excavate, as required. Low voltage and line voltage electrical lines may exist throughout the site as well as drain lines and sumps. Very all locations with General Contractor.

E. The Contractor is responsible for all damage to these utilities. In the event that damage to existing utilities is found, the owner shall coordinate the repair and labor to fix the work and shall back charge the contractor for these services.

F. Contractor shall only layout quantity of plantings that can be installed same day. Following layout of plantings as per plans and prior to planting, landscape architect shall inspect layout for approval and may adjust as necessary prior to installation. Landscape contractor shall notify landscape architect 48 hours in advance of plants being placed G. If underground construction, obstructions, or large rocks are encountered in excavation of planting areas, other locations for the

planting may be selected by the landscape architect.

H. Plant totals are for convenience only and are not guaranteed. Verify amounts shown on drawings. All planting indicated on drawings is required unless indicated otherwise.

3.02 PREPARATION OF PLANTING BEDS

A. The Contractor shall furnish and spread topsoil on planting bed areas as required to meet lines, grades and elevations as needed, after light rolling and natural settlement. Finish grade of all planting bed areas shall be minimum of 4 inch below grade of any adjacent ardscape to allow for 3" depth of organic mulc

B. Where possible, light equipment shall be utilized to deliver and spread topsoil to planter areas. Sub-grade or topsoil shall not be driven on, placed or spread when ground is muddy from precipitation. Allow ground to adequately dry to avoid compaction of sub-grade and

C. Fine grade planting bed areas to smooth, even surface with loose, uniformly fine texture. Roll, rake and drag planting bed areas, remove ridges and fill depressions, as required to meet finish grades. Limit fine grading to areas which can be planted immediately after grading.

D. Beds shall be raked smooth and put in first class condition before final acceptance and placement of pre-emergent weed control and organic mulch

3 EXCAVATION FOR PLANTING

Obstruction Below Ground: Do not plant any plant with a large obstruction directly below the root ball. In the event that rock or obstructions are encountered in any plant pit excavation, alternate locations may be selected by the Landscape Architect

responsibility of the Landscape Contractor to ensure proper drainage in all pits. Minimum drainage requirements shall be the loss of water at the rate of 6" drop in water level per hour. All rock or hardpan encountered shall be disposed of from the site.

Holes for trees and shrubs shall be three times (3x) the ball diameter for trees and two to three times (2-3x) the ball diameter for shrubs as per planting details where possible. Subsoil excavated from tree and shrub pits may be used as backfill material for planting if it is free from sub-soil, refuse, roots, heavy or stiff clay, stones 1 inch and larger in largest dimension, coarse sand, sticks, brush, litter, and other deleterious substances.. Mix excavated soil by 50% volume with imported topsoil prior to backfilling.

Tree rings in lawn areas, if any, shall be circular in outline, with a diameter at least two (2) feet greater than the diameter of the ball of each plant to be planted and edged with specified edging.

to the Owner.

3.04 SETTING AND BACKFILLING PLANTS

Placing Plants: Plants shall be set with the root ball at the same natural relationship as it had in the nursery. The top of the root ball should be 1-2" above the finished grade. Plants shall be handled by the root ball, not by the trunk or by the stems. Balls must be handled carefully and the trees must be skidded (not dropped) into the hole.

Place specified fertilizer tablets as specified.

Backfill shall be worked around the ball and tamped to eliminate air pockets. Water plants when the hole is two-thirds (2/3) full of backfill. At this point, any tie wire, twine, burlap, grow bags, etc., tied or wrapped around the stem or plant ball shall be loosened and pulled away from the plant. The burlap on the ball shall be laid back from the top of the ball and any excess burlap and ties shall be cutoff and removed from the planting except where wire cage prohibits removal of burlap. Wire cage shall not be removed.

Soil treatment: A pre-emergent herbicide such as "Dacthal" or "Treflan", or an approved equal shall be delivered to the site in its original container, bearing the manufacturer's label and instructions for handling and application. All trees and shrubs are to receive pre-emergent.

All plants shall be watered and straightened the same day as planted. No holes will be left open over night. Container grown plants shall have containers cut open and the plants carefully removed so that the earth around roots of plant remain

unbroken. Plants shall then be planted in the same manner as ball plants.

If planting of trees occurs after lawn work, protect lawn areas and promptly repair damage to lawns resulting from planting operations.

All plant material must be watered the same day it is planted in order to comply with these specifications. Any plant not watered at the time of planting may be rejected at the option of the landscape architect

As needed, the Contractor shall hand water newly planted trees twice a week for eight weeks with a minimum of five (5) gallons per tree per watering unless irrigation system is in place and provides adequate water. All plant material shall be staked and guyed as shown on detail. The stakes will be driven after the tree has been set-in, but before backfilling begins so as to avoid damage to the roots. Any deviation will not be accepted

3.05 PROTECTION AND CLEAN-UP

A. The Contractor shall remove at the end of each day: excess soil or other litter from roads or other hardscape surfaces (curbs/gutters, walks, driveways, stone patios, steps, walls, decks etc.) and other waste material. All planting sites shall be left in a condition acceptable to the landscape architect. If any remedial action is necessary by the landscape architect, the cost of such action (\$50.00 minimum) shall be withheld from payment due the Contractor. Delays in clean-up caused by weather conditions are to be reported to the landscape architect on the day such delays occur, together with and estimate of when clean-up can be affected...

3.06 INSPECTION AND ACCEPTANCE

acceptability

B. When inspected landscape work does not comply with requirements, replace rejected work and continue specified maintenance until re-inspected by Landscape Architect and found to be acceptable. Remove rejected plants and materials promptly from the project site

C. Final acceptance shall require that the site be clean and free of any signs of construction in progress. All hardscape areas shall be in like new condition including public streets adjacent to the property that were affected by the construction process.

CTION 2 - TURF SOD AND SOIL PREPARATION

NOT USED.

NOT USED.

rolling and natural settlement

removed from topsoil during finish grading.

not create a muddy soil condition.

3.02 SOD INSTALLATION

3.03 CARE AFTER SOD INSTALLATION

B. Inspection For Substantial Completion

3.05 TURF WARRANTY AND MAINTENANCE

3.06 EROSION CONTROL PROTECTION

A. Pre-Inspection Walk-Through

NOT USED.

NOT USED.

NOT USED.

3.04 INSPECTION

3.01 PREPARATION OF SOILS

Report any unusual subsoil condition (ie. roadbase, rocks, etc.) that will require special treatment to the landscape architect. Where possible, light equipment shall be utilized to deliver and spread topsoil to lawn areas. Sub-grade or topsoil shall not be driven on, placed or spread when ground is muddy from precipitation. Allow ground to adequately dry to avoid compaction of sub-grade and

Limit preparation to areas that will be planted promptly after preparation.

Surface drainage shall be ensured and, if shown, shall be directed in the manner indicated on the drawings. Fill low spots and pockets with topsoil and grade to drain properly.

Allow for sod root mass and blade height thickness in areas to be sodded.

1. Notify landscape architect 48 hours in advance to schedule pre-inspection

1. Contact landscape architect 48 hours in advance to schedule inspection.

Drainage: In the event that impervious rock or hardpan is encountered during digging operations, in tree pits or shrub pits, it shall be the

Where turf areas are damaged by planting operations, they shall be replaced by equal quality turf by the Landscape Contractor at no cost

Remove debris, rock, and other deleterious material excavated from plants pits from the site.

Plant trees after final grades are established and prior to planting/placement of lawns, unless otherwise acceptable to landscape architect

A. When landscape work is completed, including maintenance, landscape architect may, upon request, make an inspection to determine

The Contractor shall ensure 6 inches of topsoil in sodded areas or as required to meet lines, grades and elevations shown, after light

Finish grading shall consist of loosening sub-grade and placing soil, as specified. Bring areas to uniform grade by floating or hand raking. Make minor adjustments of finish grades at the direction of Landscape Architect.

All rocks half inch and larger and non-conforming foreign matter such as building rubble, concrete, wire, cans, sticks, etc., shall be

Fine grade lawn areas to smooth, even surface with loose, uniformly fine texture. Roll, rake and drag lawn areas, remove ridges and fill depressions, as required to meet finish grades. Limit fine grading to areas which can be planted immediately after grading.

Moisten prepared lawn areas before planting if soil is dry. Water thoroughly and allow surface moisture to dry before planting lawn. Do

Restore lawn areas to specified condition if eroded or otherwise disturbed after fine grading and prior to planting.

The topsoil shall be placed, water settled, re-graded, and brought to finish grades at a compaction rate of 80% to 85% optimum

oisture content. Add additional topsoil as needed to insure minimum depth requirement

2. Work of this section shall be completely installed prior to scheduling of walk-through. B. Generate a "punch list" of items to be corrected, prior to Final Inspection for Substantial Completion. 4. Furnish all required material and equipment and perform all work required to correct deficiencies.

2. Items deemed not acceptable by landscape architect shall be re-worked to the complete satisfaction of the landscape architect.

Temporary erosion control Best Management Practices (BMP'S) shall be utilized where the potential for erosion may occur. BMP's may

include but are not limited to the following: silt fencing, fiber rolls or wattles, erosion control blankets or other means may be needed to ensure proper soil stability during and after construction and until the slopes have been established by the re-vegetation process. Installation of erosion control materials shall be installed as per the manufacturer's recommendation for the existing site conditions.









bol         Qty         Label         Arrangement         LMF         Lum. Lument           8         T1         SINGLE         1.000         N.A.           1         SF2b         BACK-BACK         1.000         17291           3         SF1         SINGLE         1.000         17291           20         LFL8         LFL 8FT         1.000         N.A.           2         LFL4         SINGLE         1.000         N.A.           2         F10         WALL MOUNT         1.000         2490           4         F1         SINGLE         1.000         4584	Lum. Watts         Part Number           30         RS-30WLED-DO-xx-120           130         OSQ-A-NM-4ME-K-57K-UL-xx           130         OSQ-A-NM-4ME-K-57K-UL-xx           70         LFL-A-8-DO-UL-SV-53K-SA           35         LFL-A-4-DO-UL-SV-53K-SA           19         XSPW-B-WM-3ME-2L-57K-UL-BZ           66         FLD-OL-SN-D2-14-E-UL-SV-700	Canopy lights are not shown on the layout. Canopy lights are downward facing and should not be cause of glare due to angle and degree of canopy sloping.
culation Summary (Footcandles calculated using initial lumens @25°C) el Units Avg Max Min	Avg/Min Max/Min	
berty LineFc0.000.00.0ementFc4.4325.90.0PavementFc0.506.70.0	N.A.         N.A.           N.A.         N.A.           N.A.         N.A.	
RE MOUNTING HEIGHTS: MOUNTED - 18' AFG (16' POLE + 2' BASE) PY - 12' AFG "IONAL EQUIPMENT REQUIRED: -SSP-4011-16-D5-xx (16' x 4" SQUARE POLE, 3@90° MOUNT) OSED POLES MEET 120MPH SUSTAINED WIND LOADS Q-DAxx DIRECT ARM MOUNT STOMER TO VERIFY MOUNTING, VOLTAGE, AND COLOR & TO PLACING ORDER	$\begin{array}{c ccccccccccccccccccccccccccccccccccc$	$\begin{array}{c ccccccccccccccccccccccccccccccccccc$
eld/Baffle 6" away from the fixture to achieve the spill goal.	$\begin{array}{cccccccccccccccccccccccccccccccccccc$	$\begin{array}{c ccccccccccccccccccccccccccccccccccc$
Section 6.2.3(B)(1)(d) Maximum Levels, on-site lighting shall not exceed 10 footcandles throughout the site.	$\begin{array}{c ccccccccccccccccccccccccccccccccccc$	LFL4 LFL8 T1 PROPORED BULFL8 NG T1 T1 FL8 6.1 5.9 7.26 6.5 5.6 5.6 5.6 5.6 5.6 5.6 5.6 5.6 5.
NORTH W E S	0.0  0.0  0.0  0.0  0.0  0.0  0.1	2 0.3 0.4 0.5 0.7 0.9 120 01.1 1.2 1.1 1.1 1.5 3.0 4.2 3.2 4.3 3.6 3.1 3.280 00 0.3 0.2 0.1 0.1 0.1 0.2 0.1 0.1 0.1 0.1 0.2 0.2 0.3 0.3 0 0 0 0 0 0 0 0 0 0 0 0 0 0 0 0
		$\begin{array}{cccccccccccccccccccccccccccccccccccc$



Illumination results shown on this lighting design are based on project parameters provided to Cree, Inc. used inconjunction with luminaire test procedures conducted under laboratory conditions. Actual project conditions differing from these design parameters may affect field results. The customer is responsible for verifying dimensional accuracy along with compliance with any applicable electrical, lighting,or energy code.

# SR-34704

Project Name: QQ - 2437 Marksheffel Rd., Colorado Springs, CO 80951


Footcandles calculated at grade

Filename: QQ-181210CSCOBAFR2


	Layout By: Ben Foster	
2.A	GI <sub>Date:3/5/2019</sub>	


Scale 1" = 16' 32


64

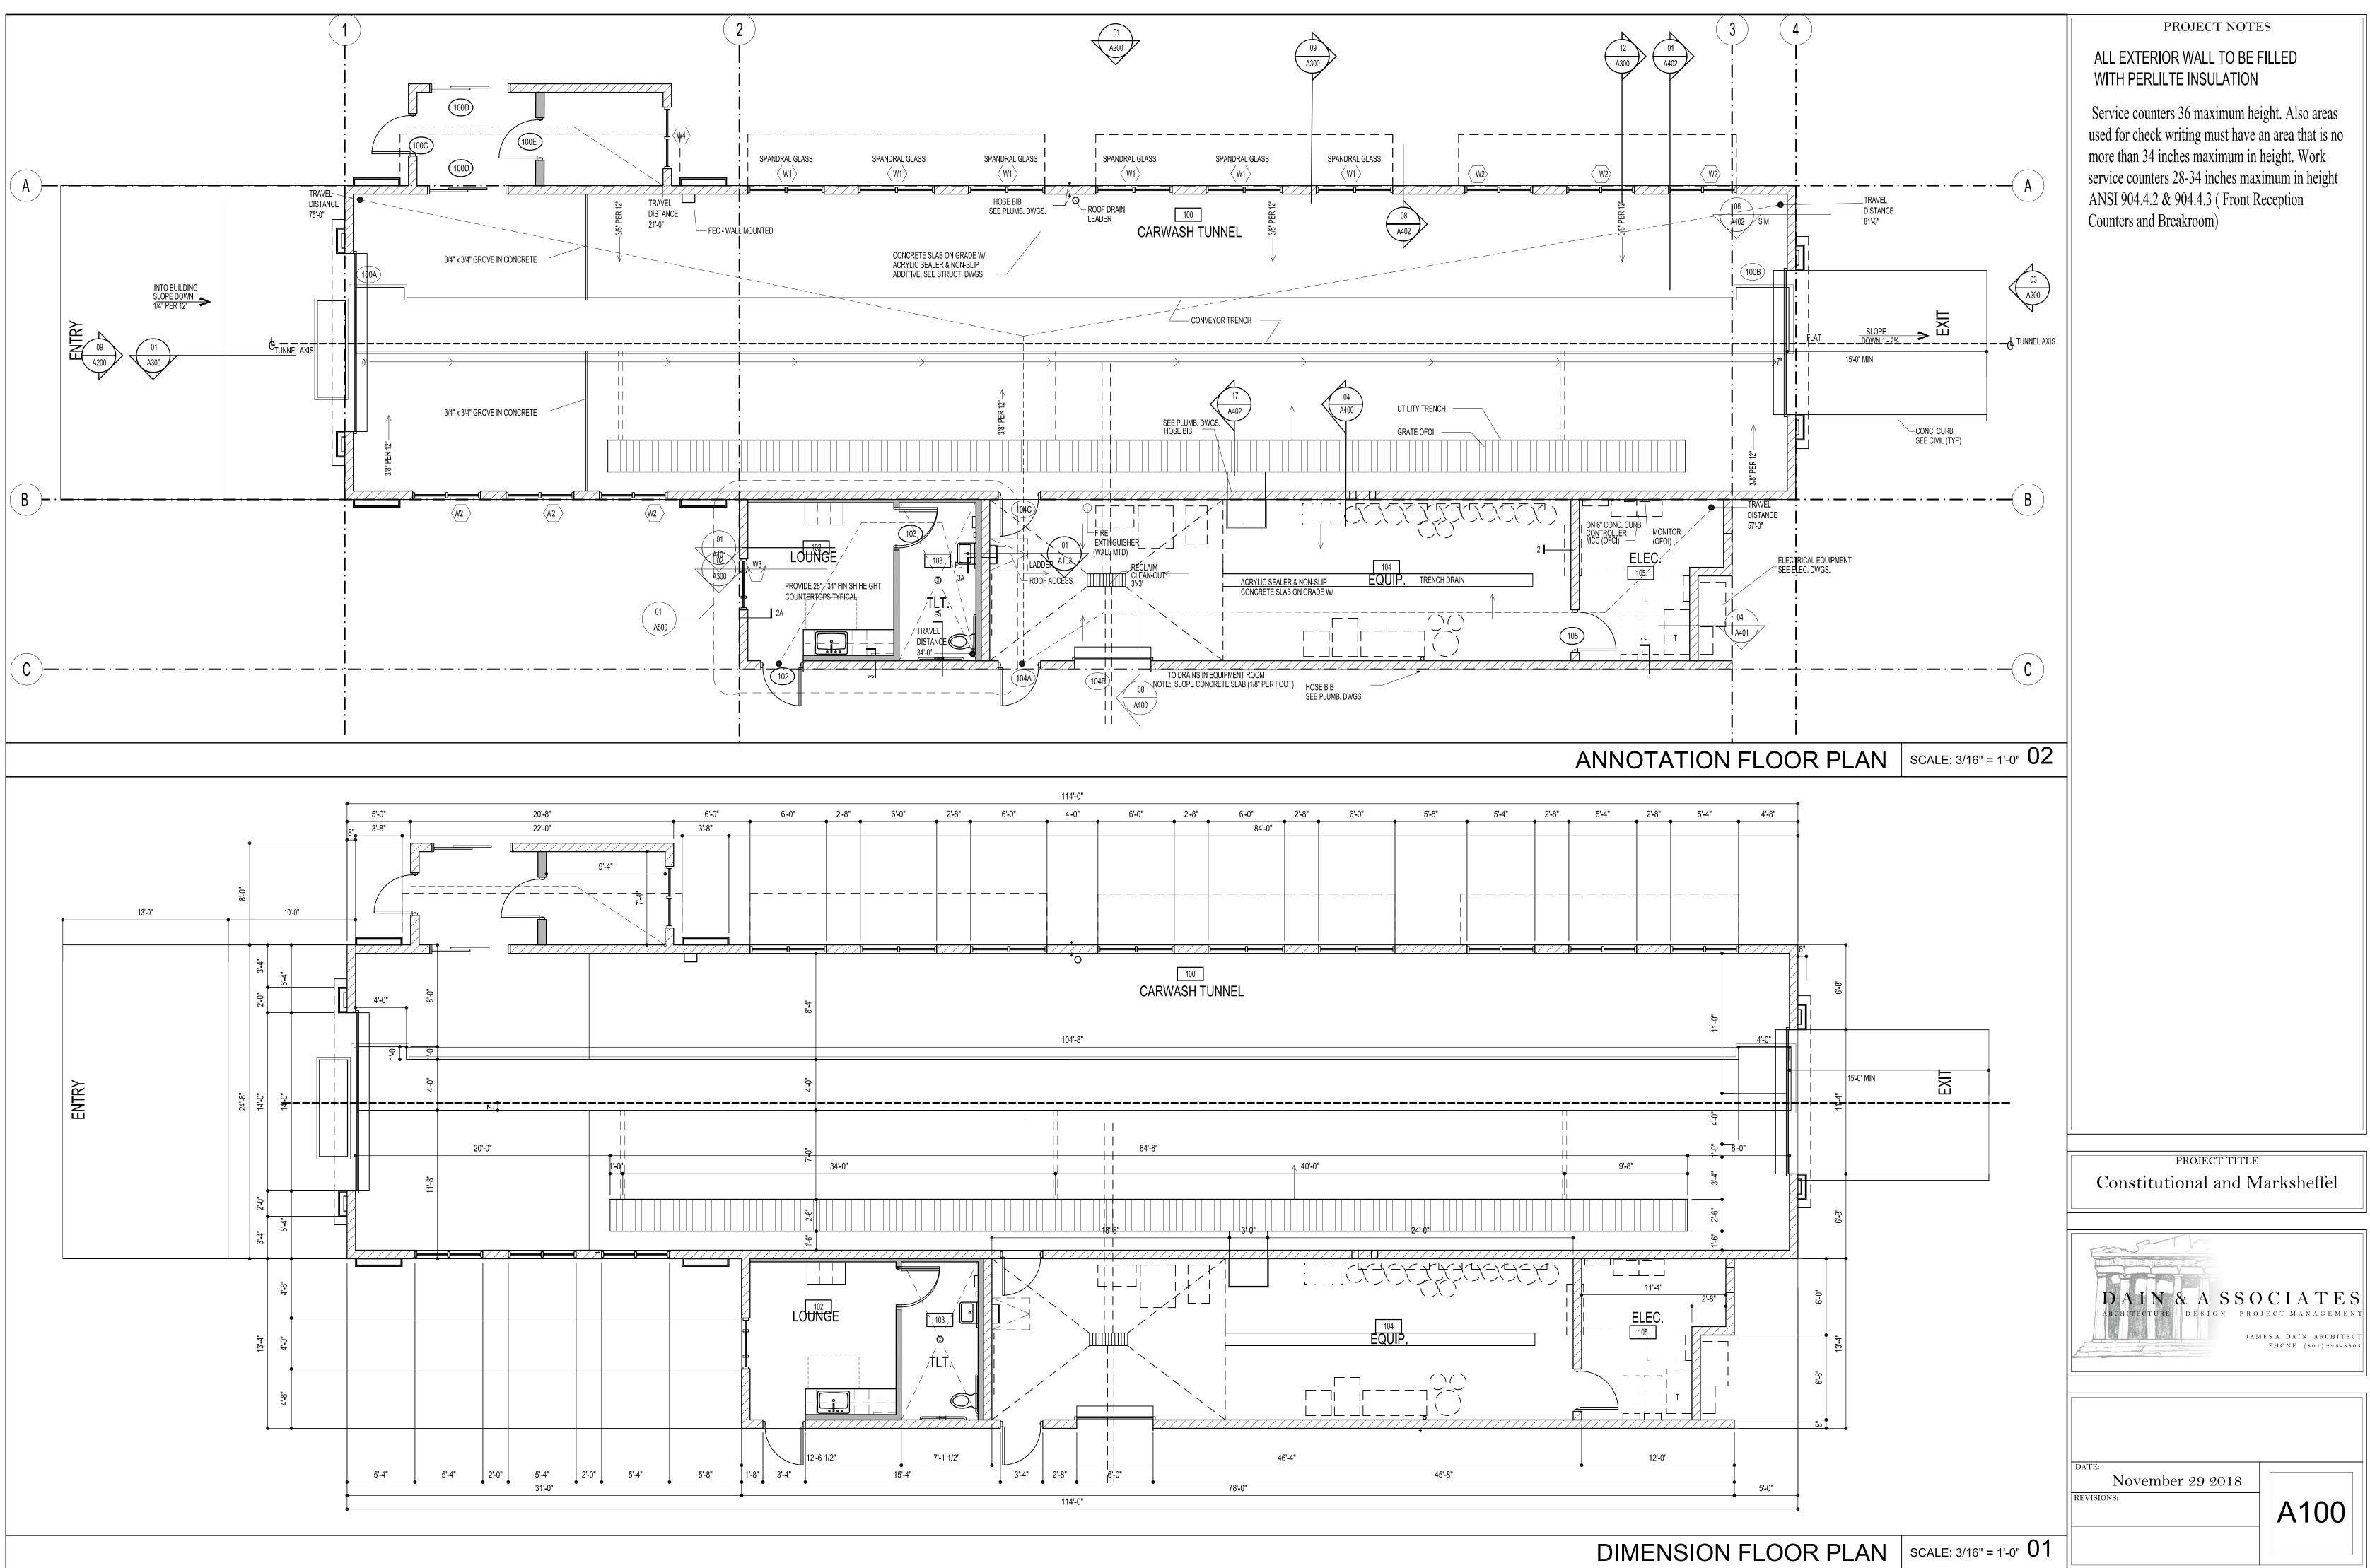





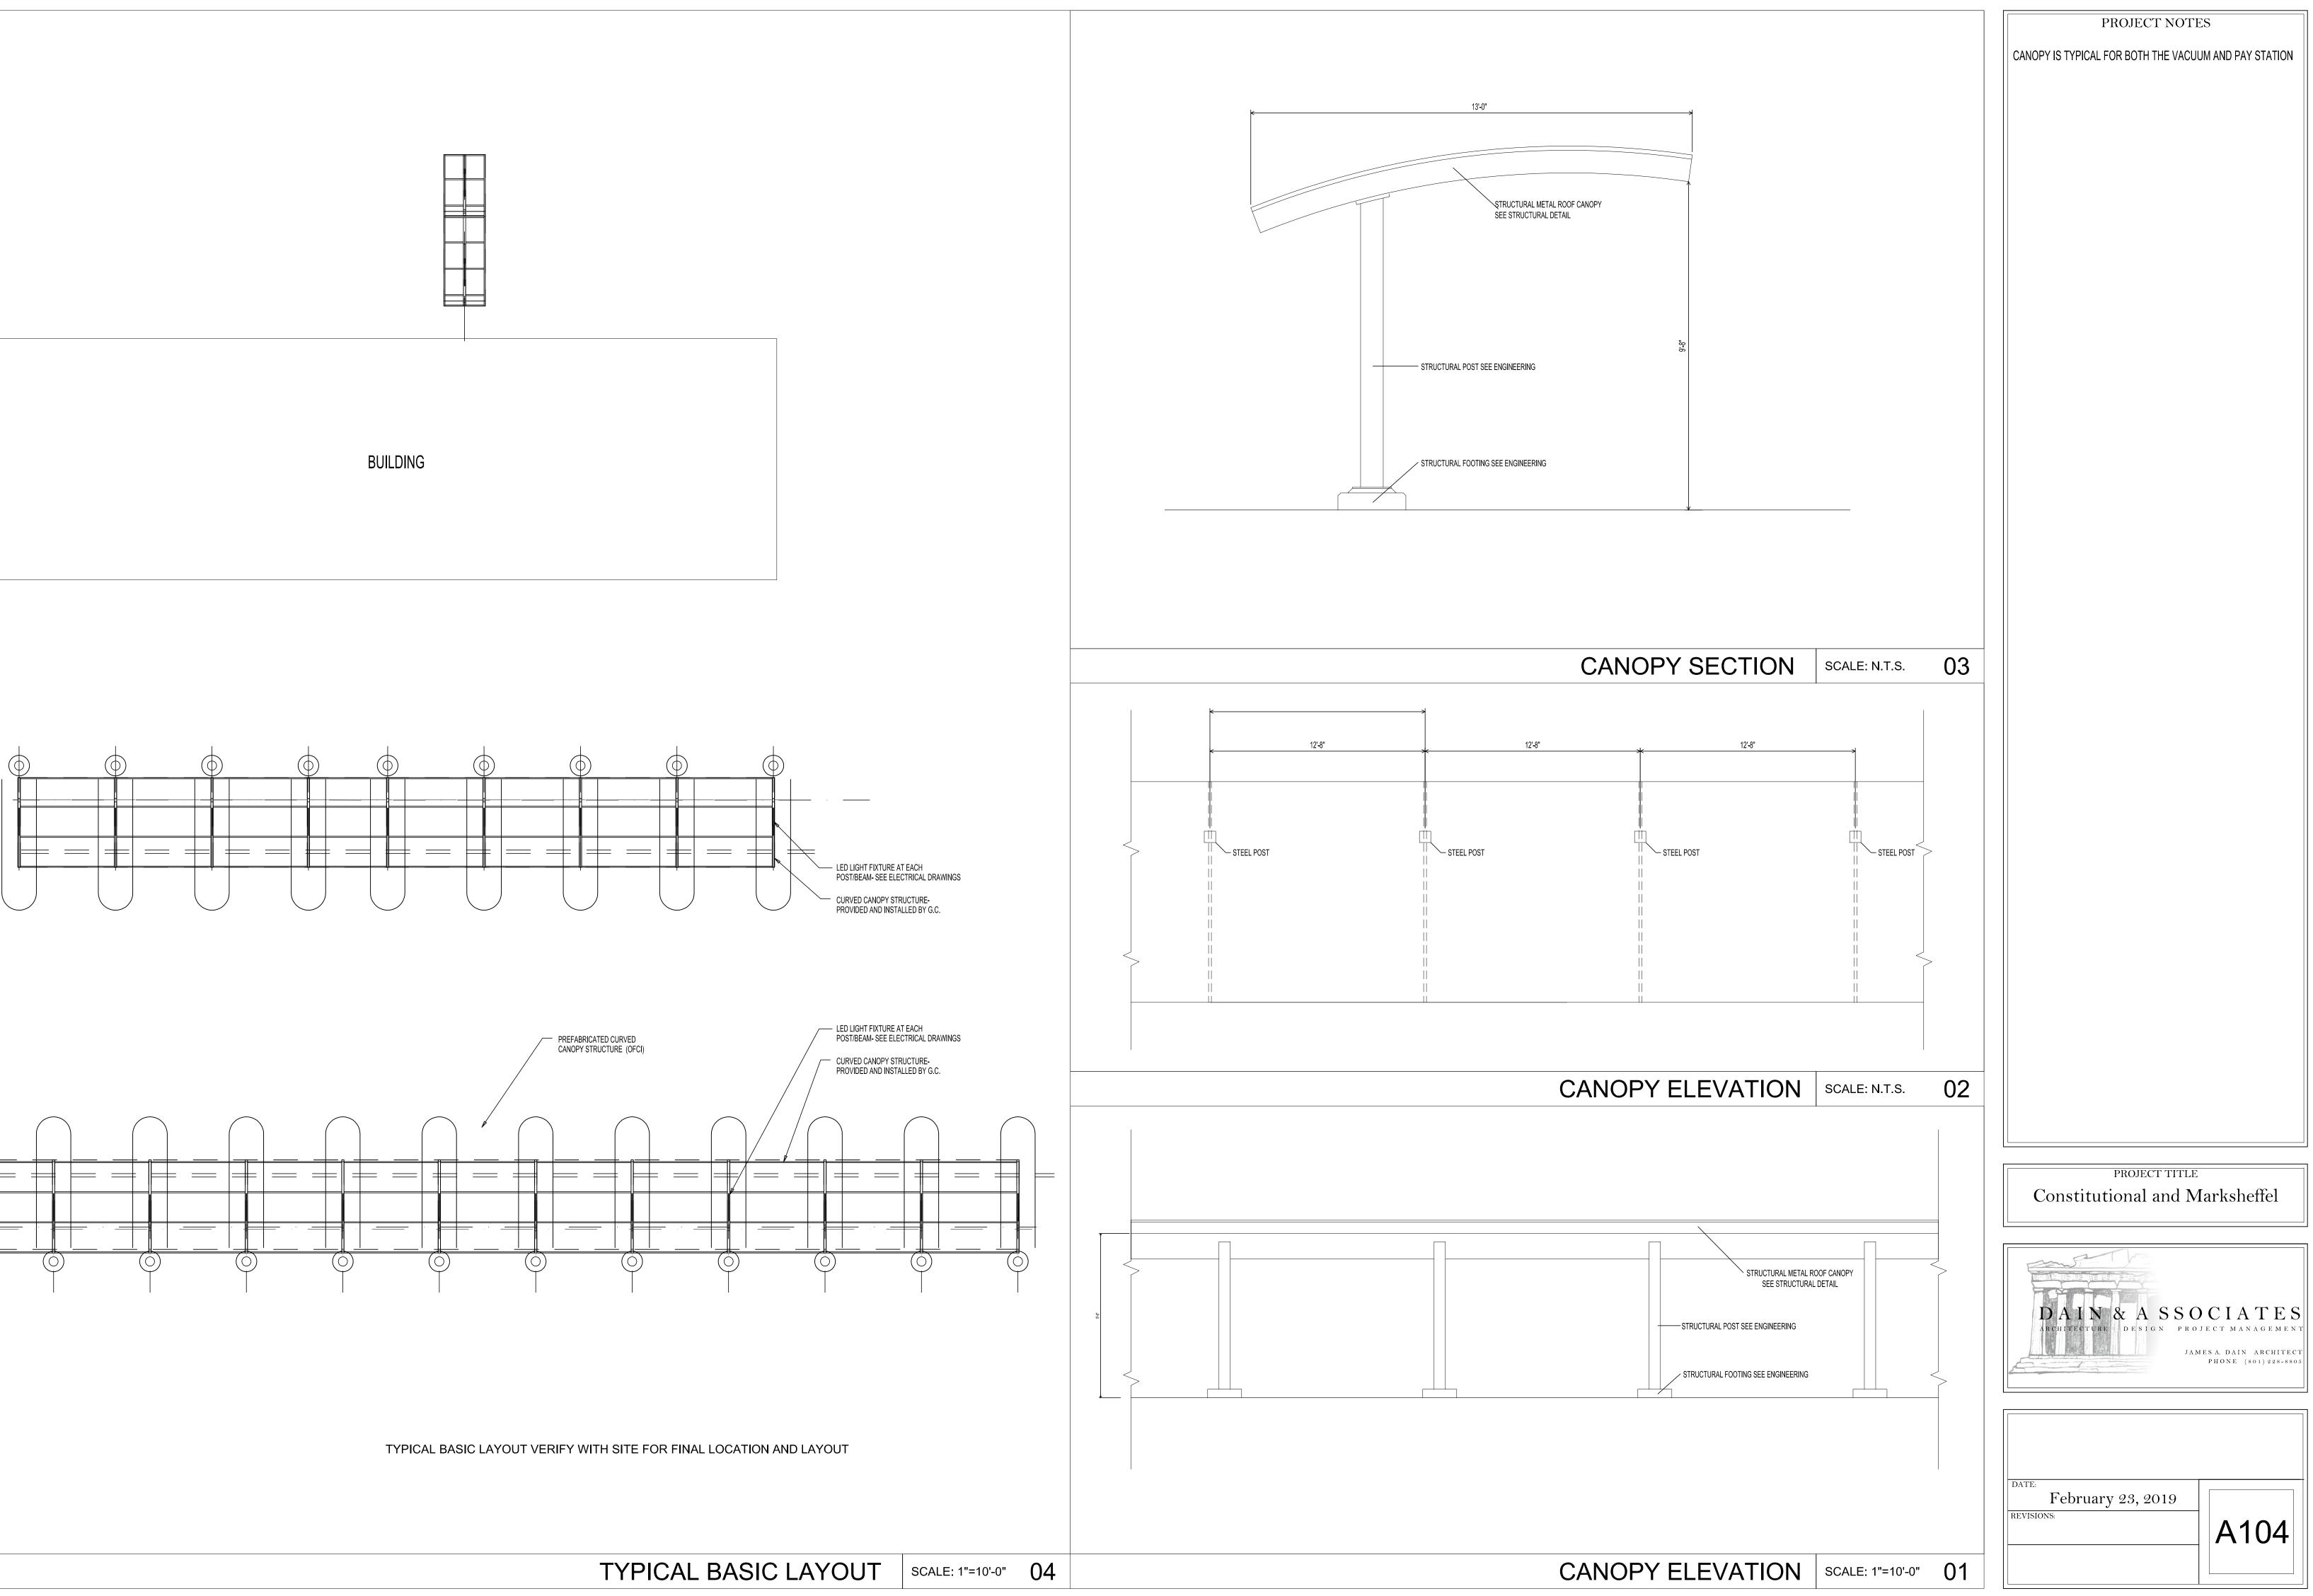

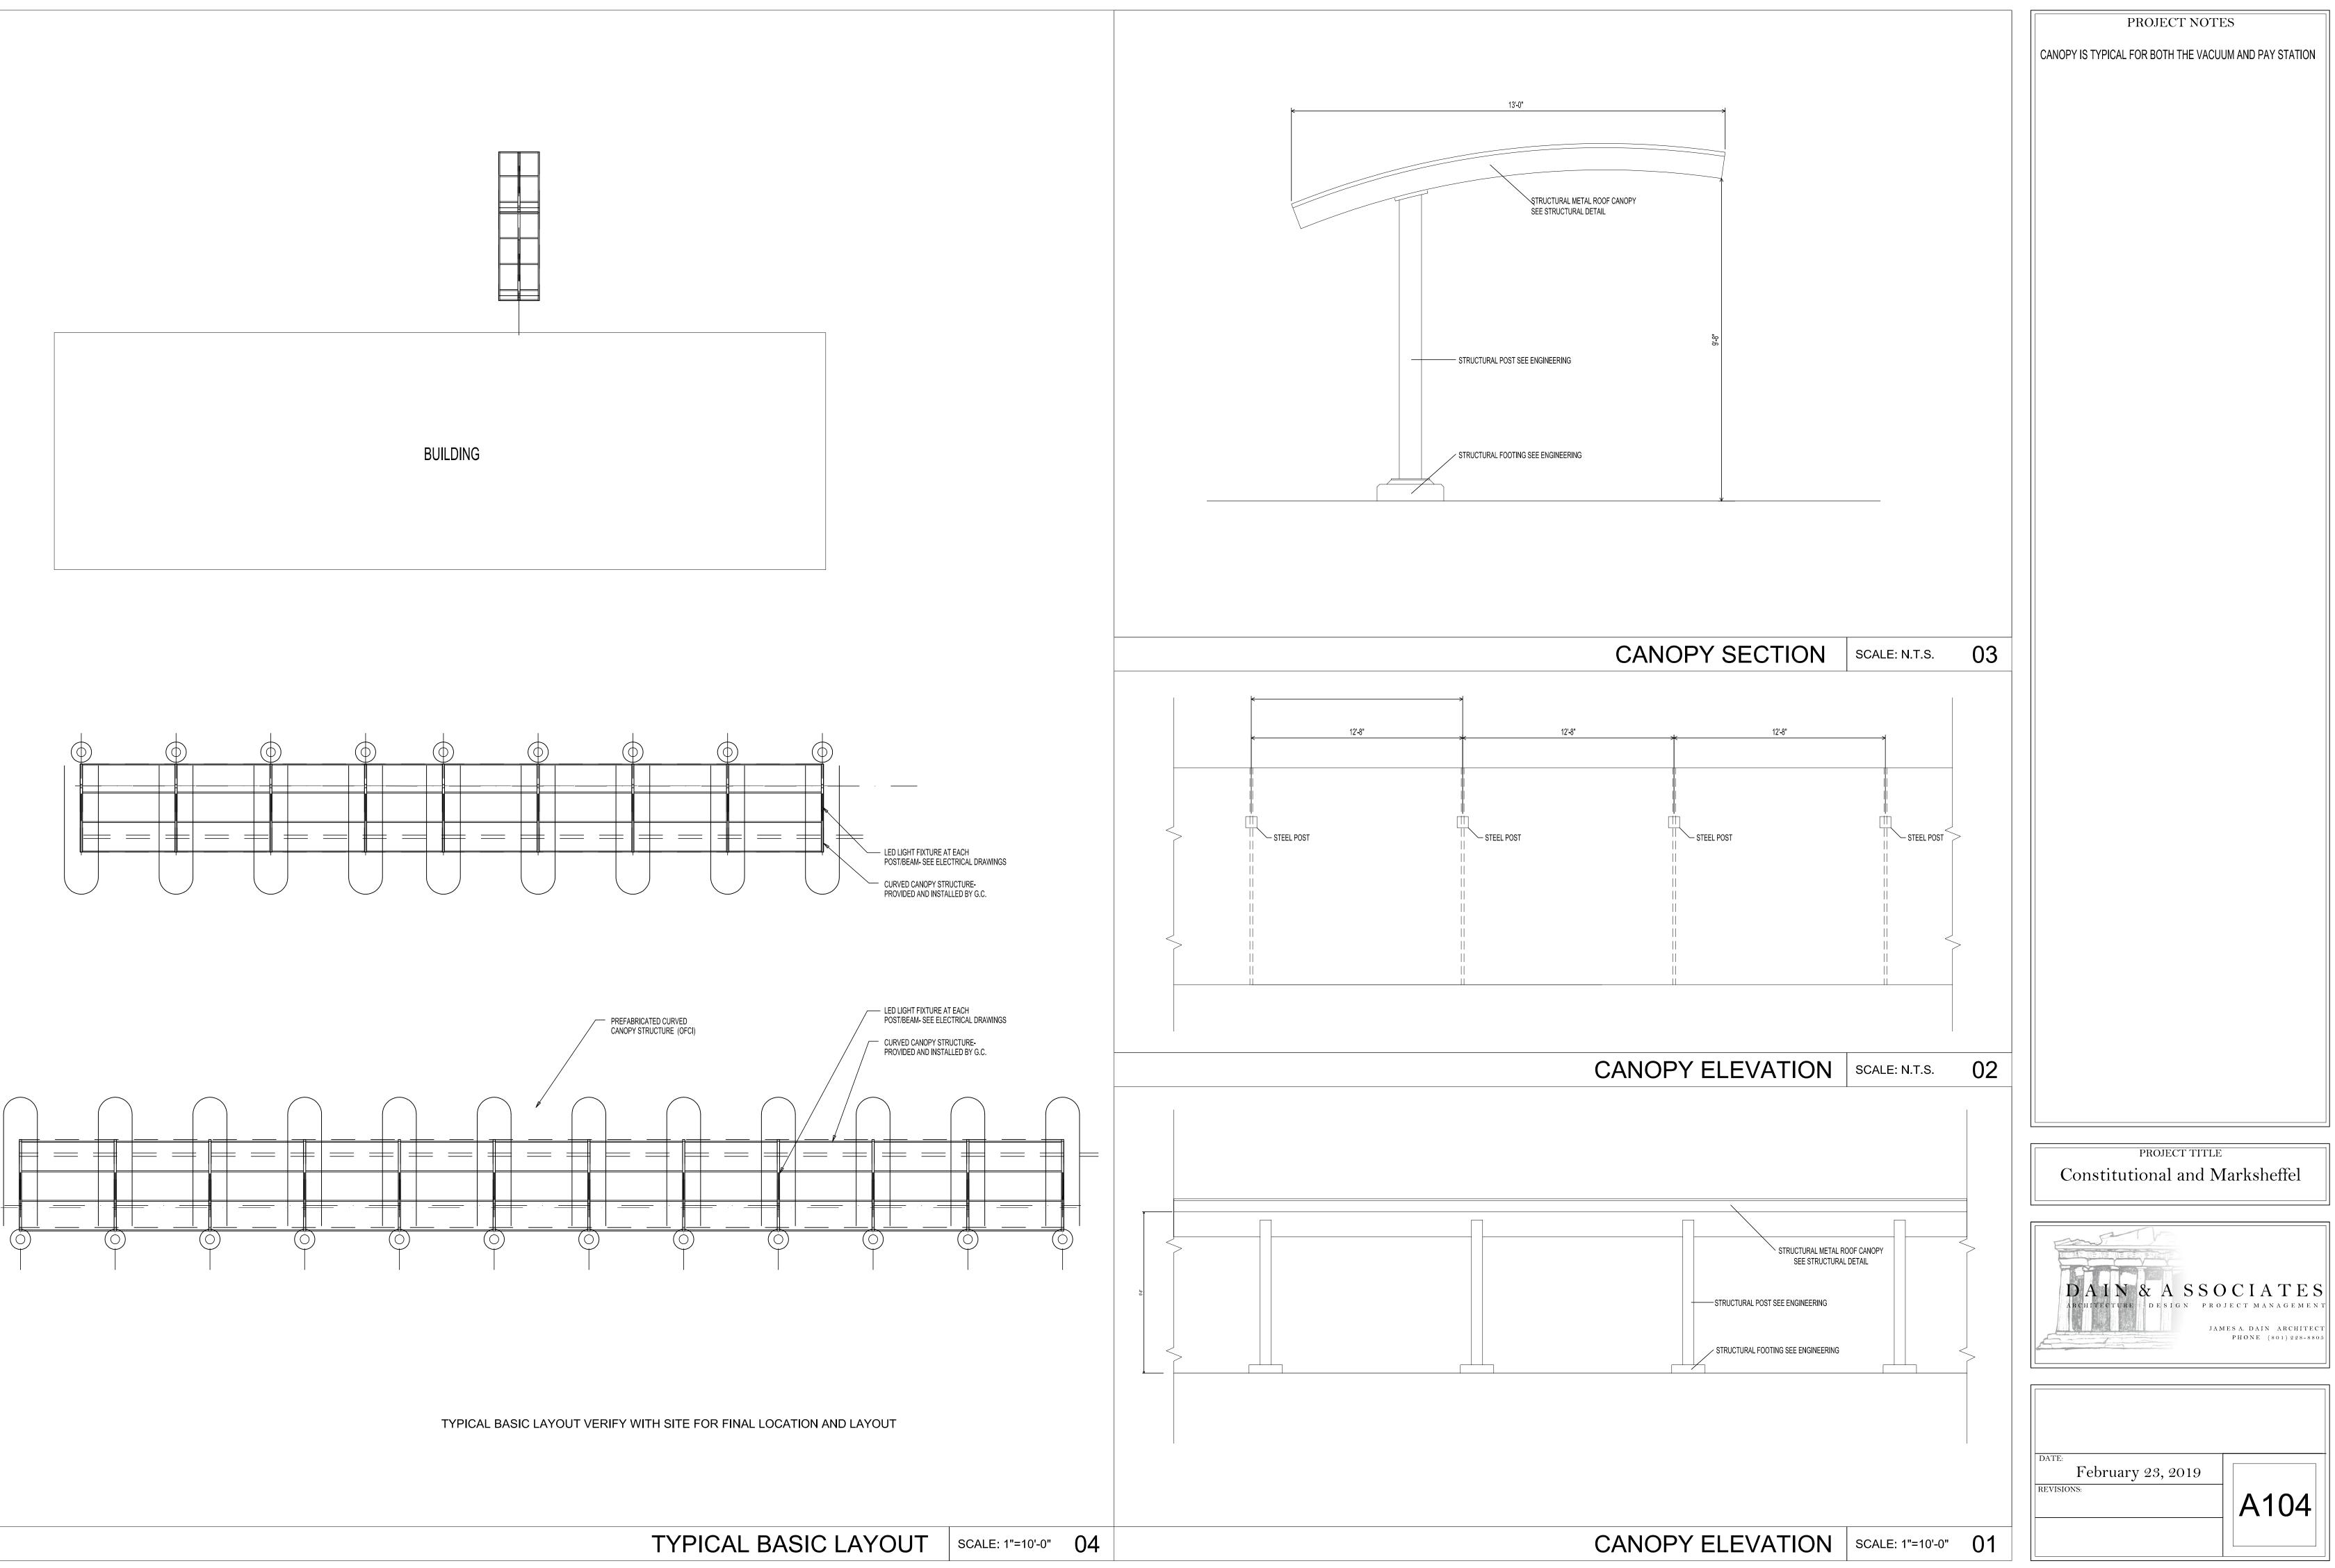

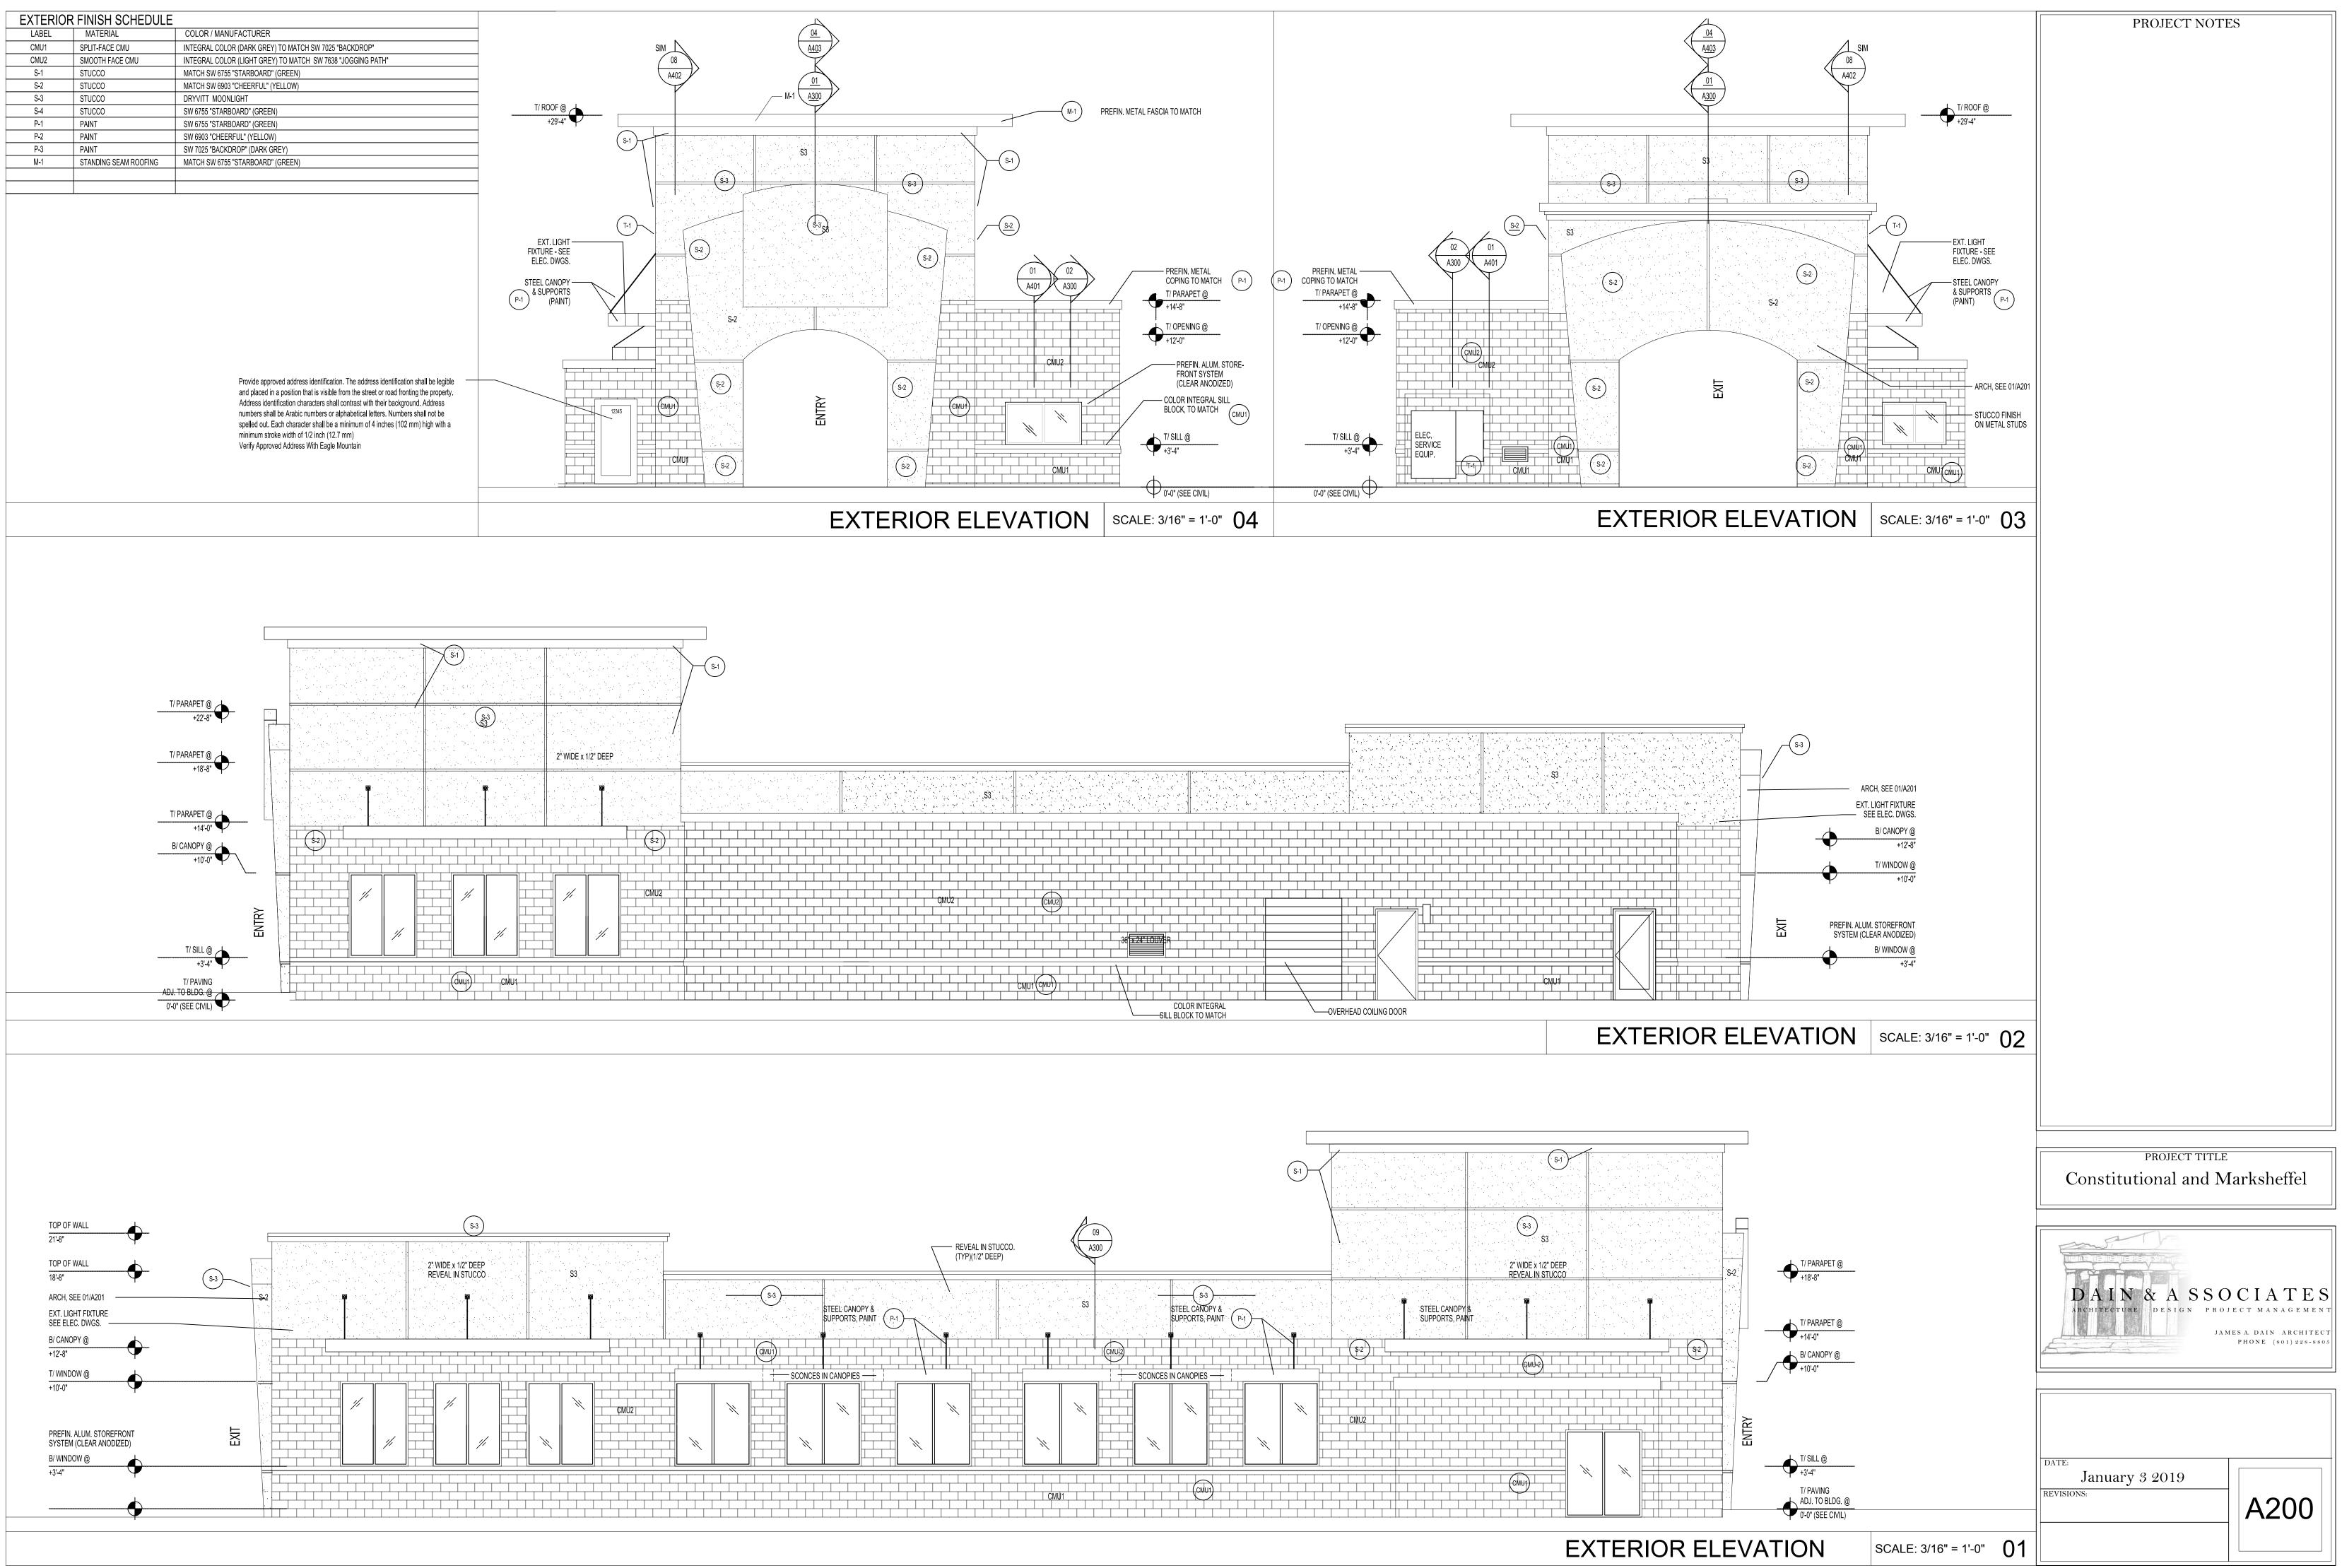

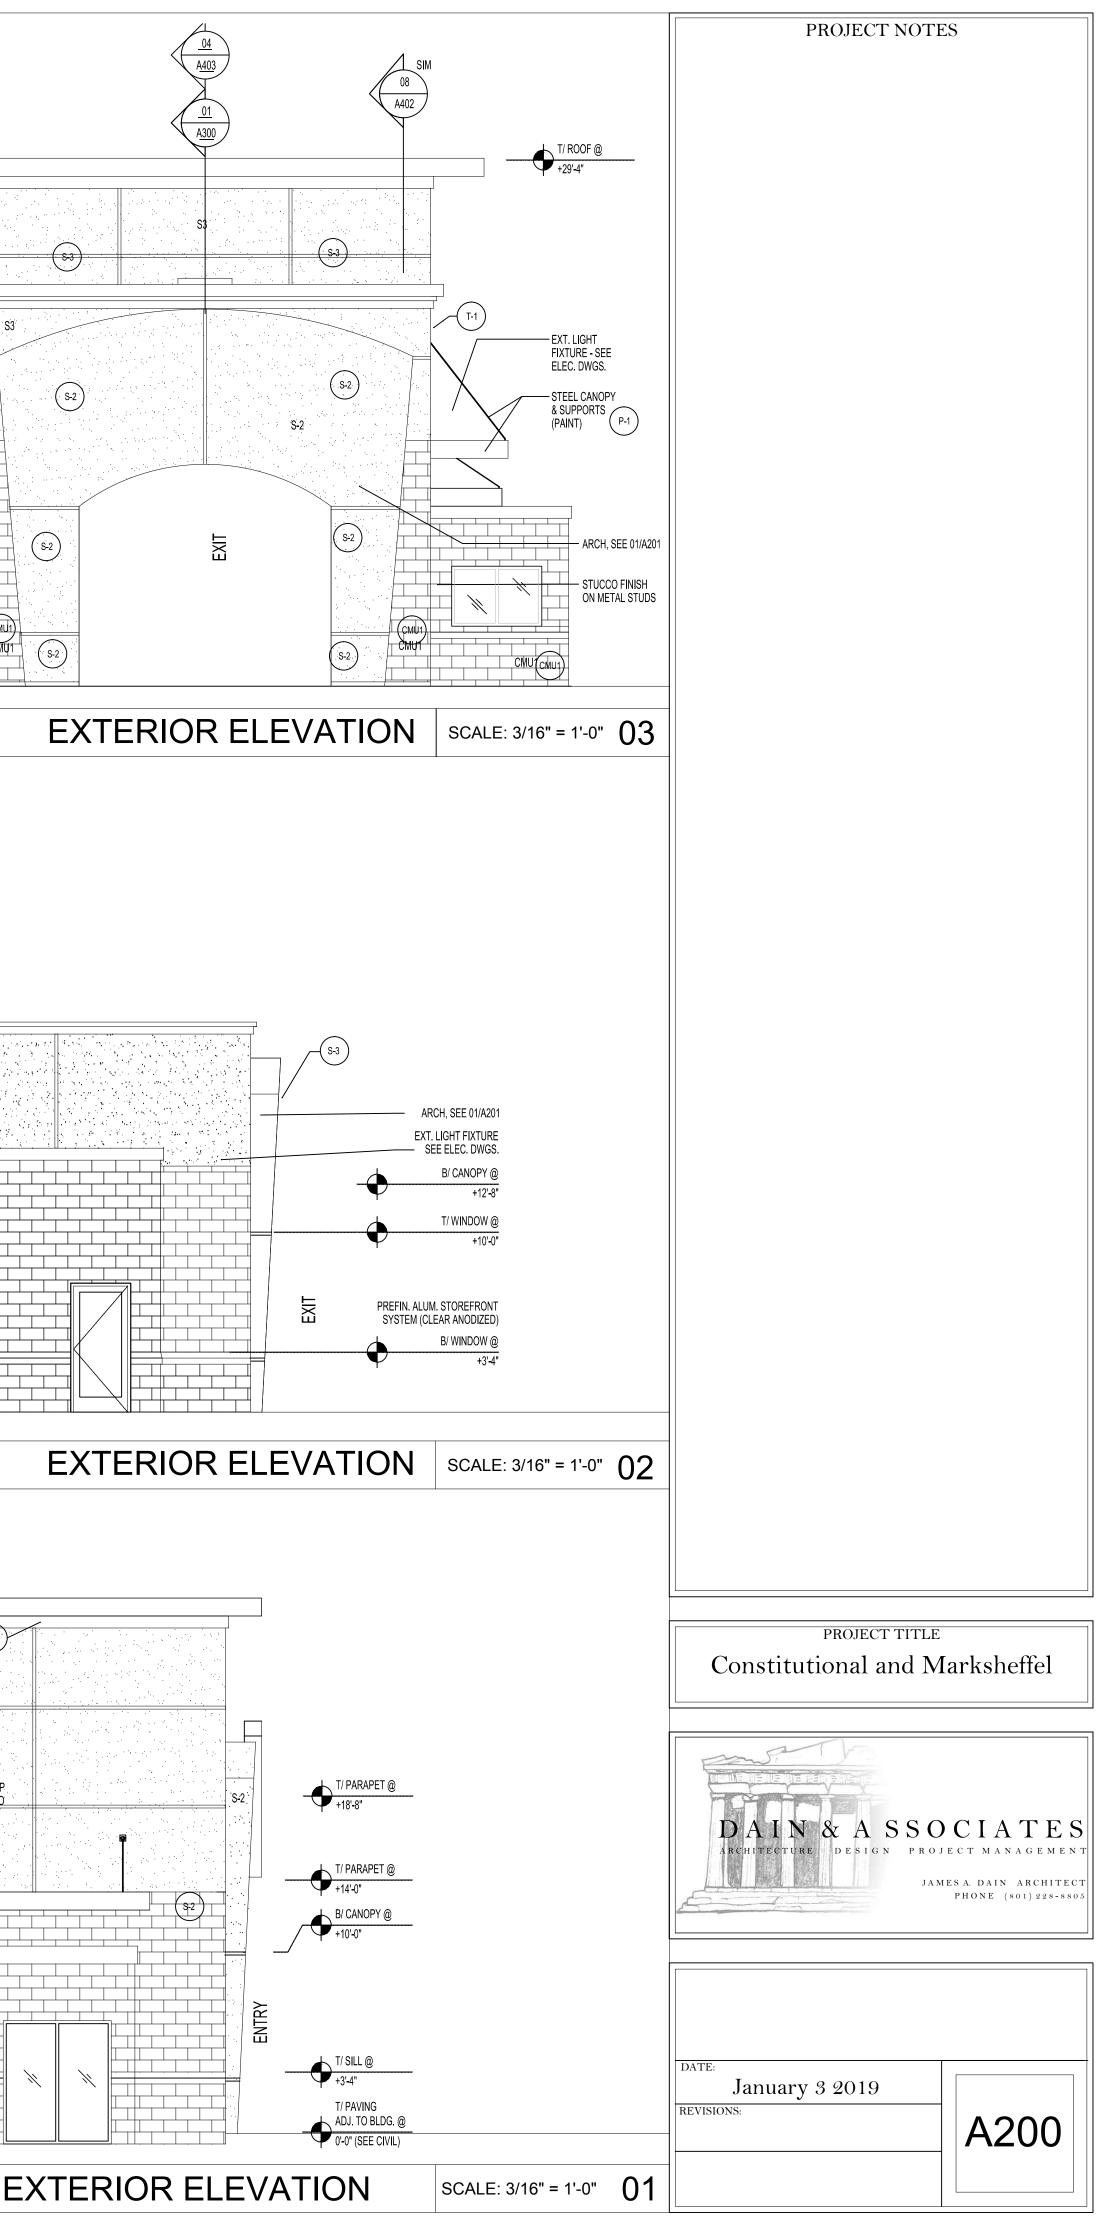

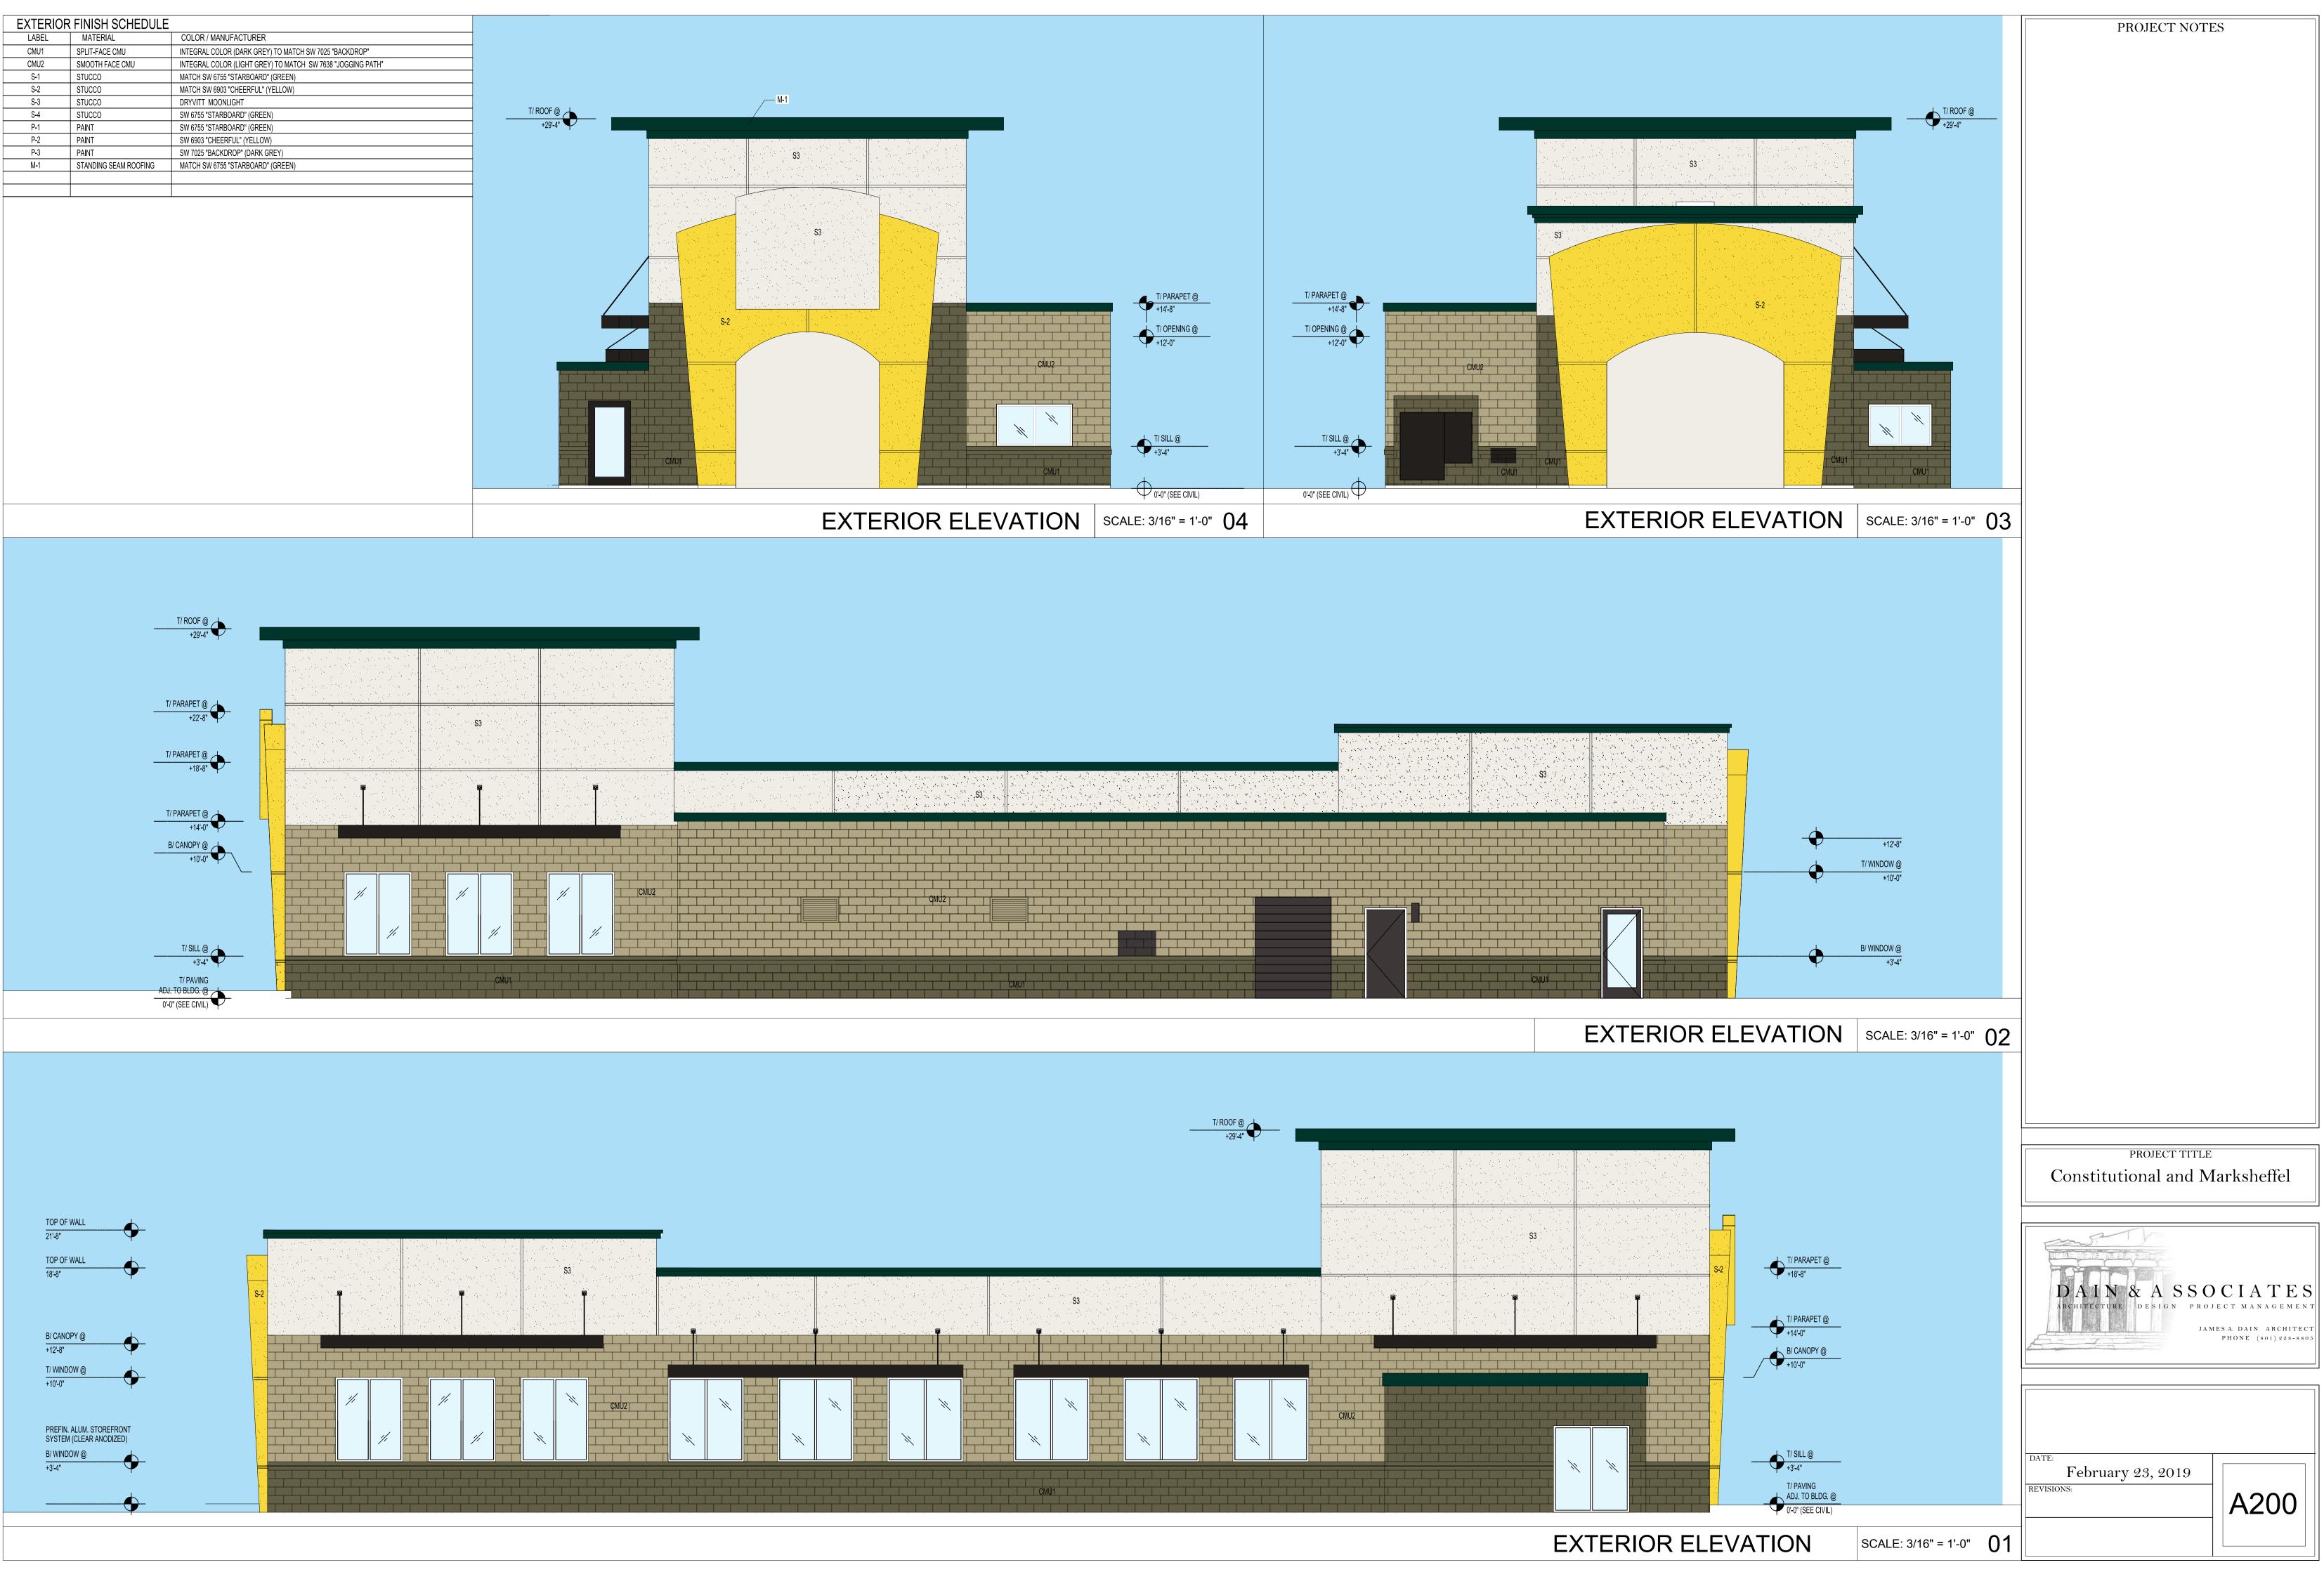

T/ ROOF @ +29'-4"	
	\$3
\$3	


	-	
\$3		S3
	Image: Second	

## QUICK QUACK CAR WASH | PROPOSED SIGNAGE | WALL SIGN

#### MANUFACTURE AND INSTALL

#### (2) SETS OF FRONT LIT WALL SIGNS WITH VACUUM-FORMED FACES

- FACES: 3/16" CLEAR PLEX, VACUUM-FORMED WITH VINYL AND PAINTED GRAPHICS ON 2ND SURFACE
- RETAINERS: ALL ALUMINUM, 2" PAINTED WHITE
- RETURNS: ALL ALUMINUM 8" DEEP, PAINTED WHITE
- BACKS: ALL ALUMINUM STOCK COLOR
- **G** ILLUMINATION: WHITE LEDs \*\*CANNOT EXCEED 2 FT CANDLES AS MEASURED 1 FT. FROM THE SURFACE OF THE SIGN\*\*
- **9** POWER SUPPLY: HOUSED IN SIGN CABINET
- G FLUSH MOUNTED TO FASCIA (SEE ATTACHMENT DETAIL)
- DISCONNECT SWITCH AT SIGN
- 120V SERVICE SUPPLIED BY OTHERS

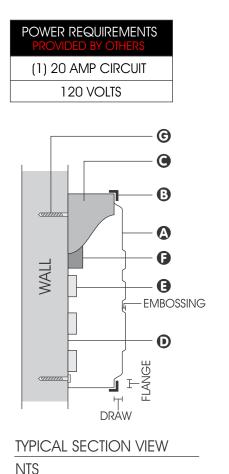


A separate sign permit will be required, please inform the planner if you will also will be applying for the sign permit so I can create the project

5'-0"



PMS BLACK, 3M BLACK 230-22

#### **NIGHT VIEW**

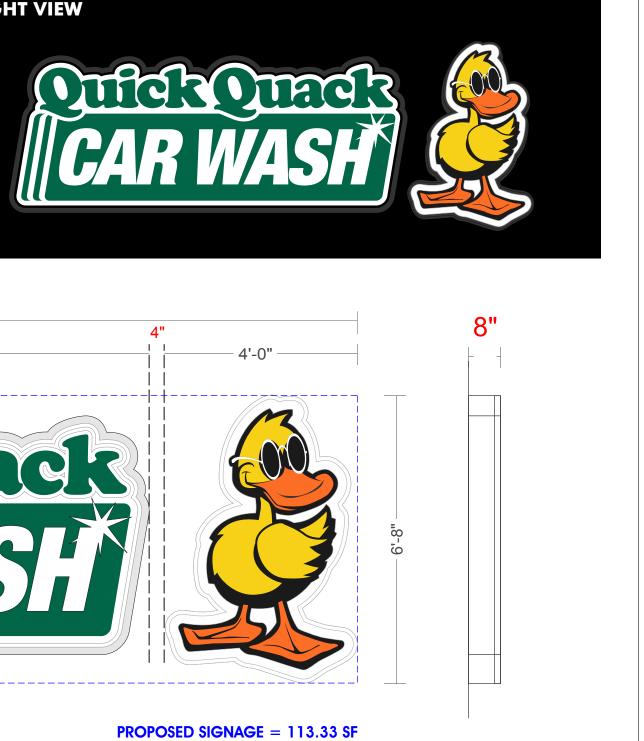



#### **PROPOSED LAYOUT**

SCALE: 1/2"=1'-0"

UTAH C 1852 N.

Utah Contractors: 375809-5501 • Nevada:60486 • Colorado:237787 • Idaho:RCE-29969

THIS IS AN ORIGINAL UNPUBLISHED DRAWING CREATED BY ALLIED ELECTRIC SIGN. IT IS SUBMITTED FOR YOUR PERSONAL USE IN CONNECTION WITH THE PROJECT BEING PLANNED FOR YOU. IT IS NOT TO BE REPRODUCED, COPIED OR EXHIBITED.



COUNTY: . 1300 W. 89-3645 d-sign.com	DRAWING STEPS CONCEPT ESTIMATING PFRMIT/LANDLORD PRODUCTION/INSTALL	DRAWING REVIEW SURVEY PRODUCTION REVIEW INSTALL REVIEW	Client: Quick Quack Car Wash Address: Colorado Springs, CO File Name: Quick Quack (Saratoga Springs, UT) - Sign Packa	SALES APPROVAL: Designer: Richard Sales: Regina ge - 09-07-2016	CUSTOMER APPROVAL SIGNATURE	REVISIONS
ALT LAKE CITY:	1920 S. 900 W., SALT	LAKE CITY, UT	• (801) 972-5503 <b>OGDEN:</b> 2924 Pennsylvania Avenu	e • (801) 621-4612		

SALT • (001) (001)





1 of 6


# QUICK QUACK CAR WASH | PROPOSED SIGNAGE | WALL SIGN

#### MANUFACTURE AND INSTALL


#### (1) SET OF NON-ILLUMINATED WALL SIGNS WITH **VACUUM-FORMED FACES**

#### (1) SET OF ILLUMINATED WALL SIGNS WITH VACUUM-FORMED FACES

- ▲ FACES: 3/16" CLEAR PLEX, VACUUM-FORMED WITH VINYL AND PAINTED GRAPHICS ON 2ND SURFACE
- O RETAINERS: ALL ALUMINUM, 2" PAINTED WHITE
- RETURNS: ALL ALUMINUM 8" DEEP, PAINTED WHITE
- BACKS: ALL ALUMINUM STOCK COLOR
- **G** ILLUMINATION: WHITE LEDs
- POWER SUPPLY: HOUSED IN SIGN CABINET
- G FLUSH MOUNTED TO FASCIA (SEE ATTACHMENT DETAIL)
- DISCONNECT SWITCH AT SIGN
- 120V SERVICE SUPPLIED BY OTHERS

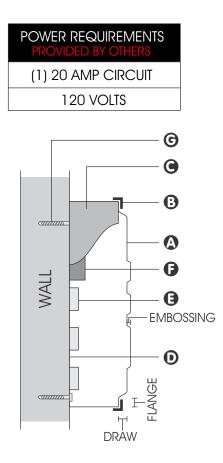

A separate sign permit will be required, please inform the planner if you will also will be applying for the sign permit so I can create the project

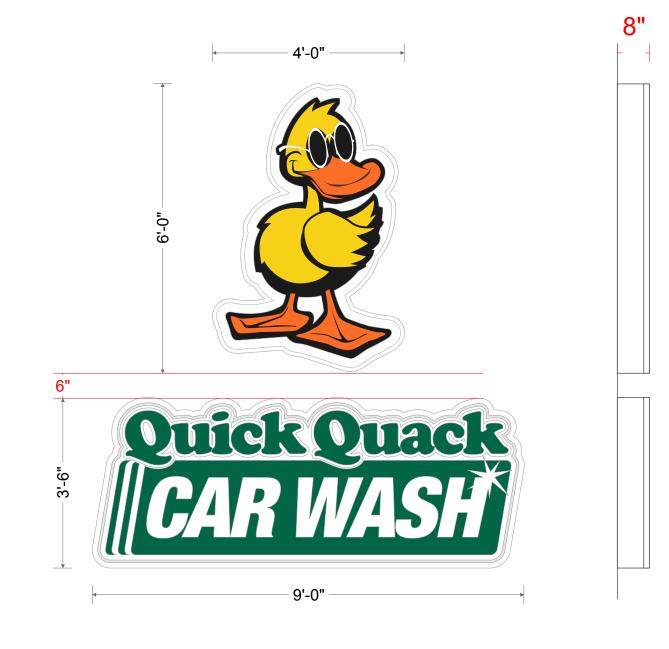

#### **PROPOSED LAYOUT**

DRAWING STEPS

PERMIT/LANDLORD

PRODUCTION/INSTA

SUDVE

NSTALL REVI

DUCTION REVIEW

ESTIMATING

SCALE: 1/2"=1'-0"

UTAH COUNTY:

(801) 489-3645

**PROPOSED SIGNAGE = 55.50 SF** 

Client: Quick Quack Car Wash

Colorado Springs, CO

File Name: Quick Quack (Saratoga Springs, UT) - Sign Package - 09-07-2016

Utah Contractors: 375809-5501 • Nevada:60486 • Colorado:237787 • Idaho:RCE-29969

THIS IS AN ORIGINAL UNPUBLISHED DRAWING CREATED BY ALLIED ELECTRIC SIGN. IT IS SUBMITTED FOR YOUR PERSONAL USE IN CONNECTION WITH THE PROJECT BEING PLANNED FOR YOU. IT IS NOT TO BE REPRODUCED, COPIED OR EXHIBITED.

SALES APPROVAL:




SALT LAKE CITY: 1920 S. 900 W., SALT LAKE CITY, UT • (801) 972-5503 OGDEN: 2924 Pennsylvania Avenue • (801) 621-4612

Address:



ACCURATE FIELD SURVEY REQUIRED PRIOR TO FABRICATION

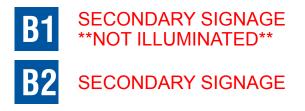

PMS 3425, 3M EMERALD GREEN 230-126 PMS 7404. 3M YELLOW 230015 PMS ORANGE 021, 3M ORANGE 230-44 PMS BLACK, 3M BLACK 230-22

2 of 6

APPROVAL:	CUSTOMER APPROVAL	REVISIONS
Designer: Richard		KE VIOIONO
Sales: Regina	SIGNATURE	
07-2016		






# QUICK QUACK CAR WASH | PROPOSED SIGNAGE | METAL CANOPIES

#### MANUFACTURE AND INSTALL

#### (4) SUSPENDED METAL CANOPIES

- PROJECTION: (4) @ 4'-0"
- **G** DROP: (2) @ 3'-8", (2) @ 7'-0"
- **G** WIDTH: (4) @ 23'-4"
- TURNBUCKLE AND RODS, PAINTED P1
- CANOPY FRAME: 2"x12" ALL ALUMINUM CONSTRUCTION, PAINTED P1

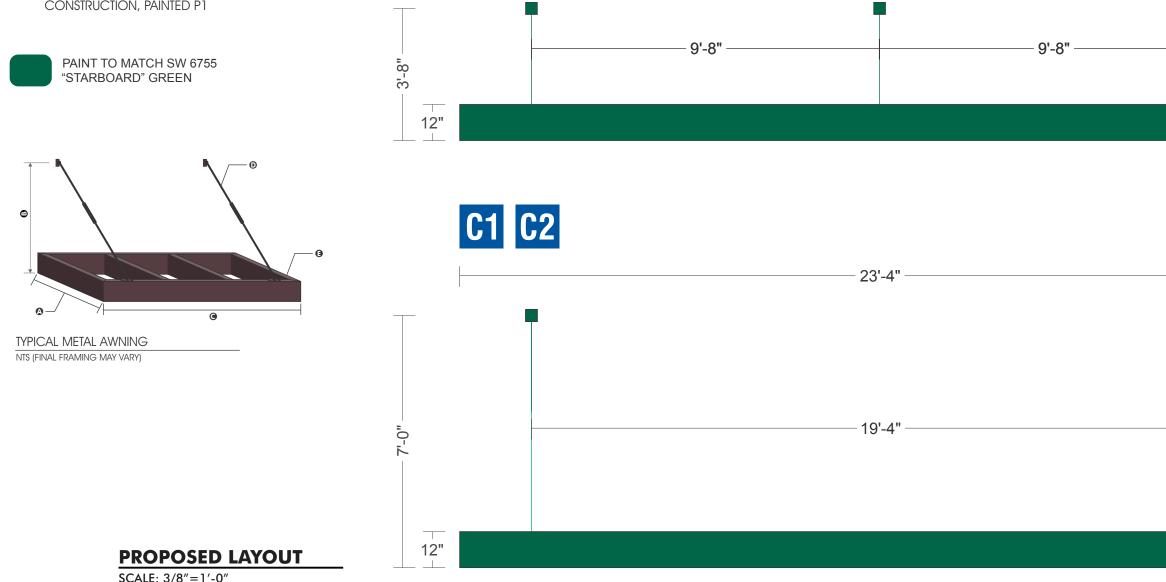


C3 C4 C5

Utah Contractors: 375809-5501 • Nevada:60486 • Colorado:237787 • Idaho:RCE-29969

THIS IS AN ORIGINAL UNPUBLISHED DRAWING CREATED BY ALLIED ELECTRIC SIGN. IT IS SUBMITTED FOR YOUR PERSONAL USE IN CONNECTION WITH THE PROJECT BEING PLANNED FOR YOU. IT IS NOT TO BE REPRODUCED, COPIED OR EXHIBITED.

23'-4"




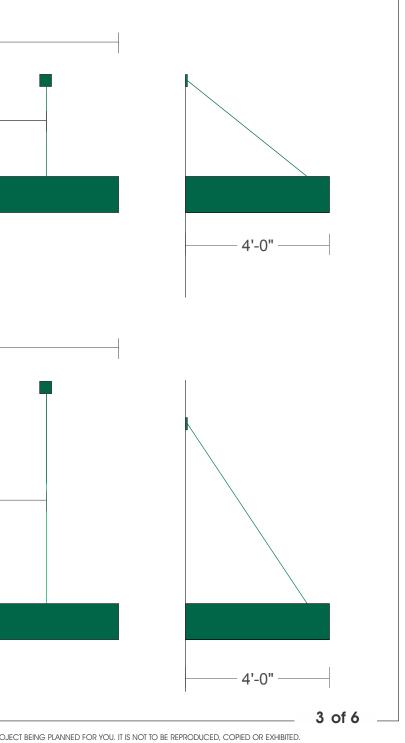

ard ina CUSTOMER APPROVAL REVISIONS



# QUICK QUACK CAR WASH | PROPOSED SIGNAGE | ELEVATIONS

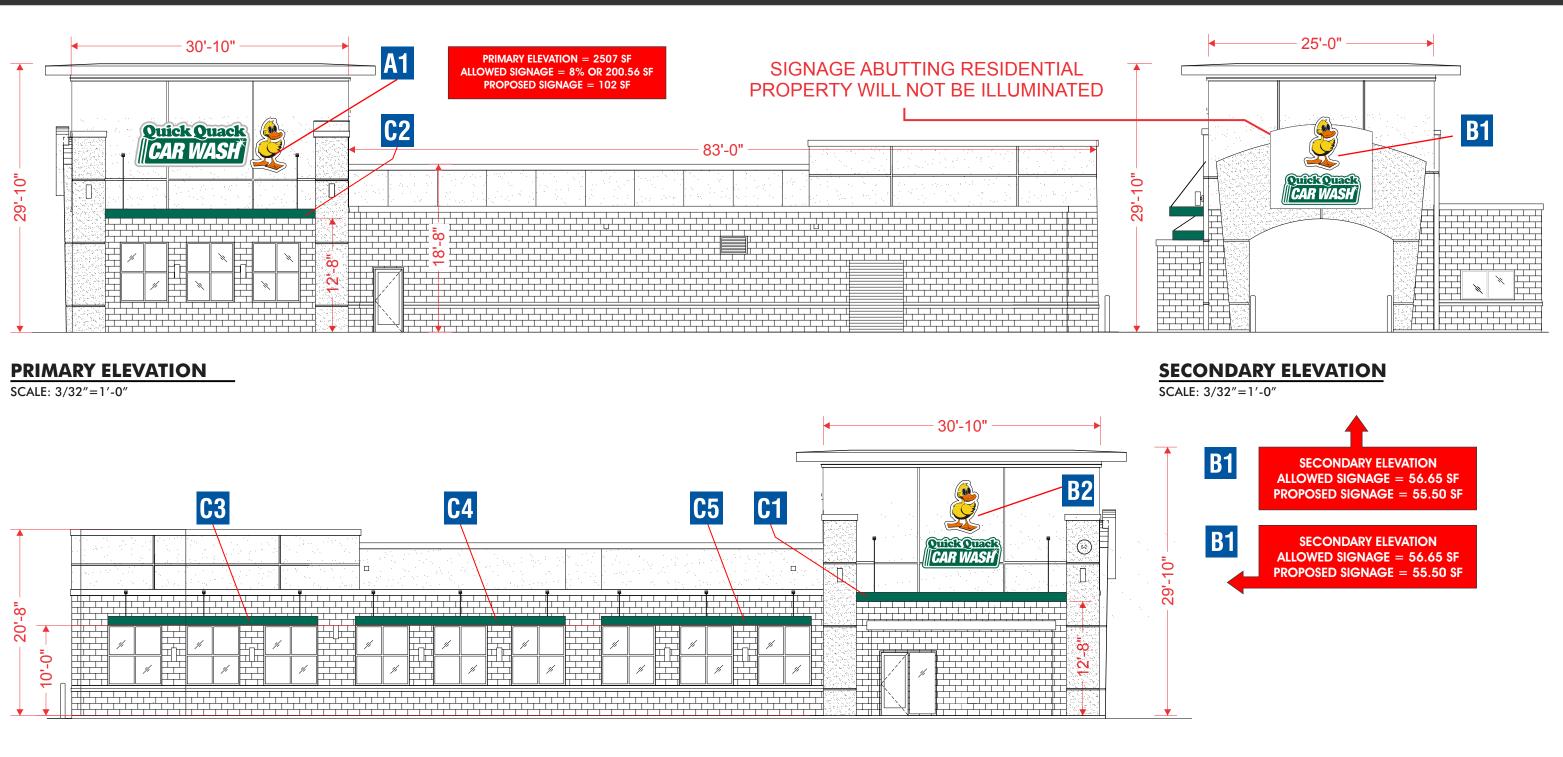

#### **SECONDARY ELEVATION**

SCALE: 3/32"=1'-0"

Utah Contractors: 375809-5501 • Nevada:60486 • Colorado:237787 • Idaho:RCE-29969

THIS IS AN ORIGINAL UNPUBLISHED DRAWING CREATED BY ALLIED ELECTRIC SIGN. IT IS SUBMITTED FOR YOUR PERSONAL USE IN CONNECTION WITH THE PROJECT BEING PLANNED FOR YOU. IT IS NOT TO BE REPRODUCED, COPIED OR EXHIBITED.



	CUSTOMER APPROVAL	REVISIONS
hard		
gina	SIGNATURE	



4 of 6

## QUICK QUACK CAR WASH | PROPOSED SIGNAGE | MONUMENT SIGN

#### **PROPOSED SIGNAGE** = 25 sq.ft.(1) D/F MONUMENT SIGN MAIN SIGN BODY: ALL ALUMINUM CONSTRUCTION, PAINTED P1-P2 FACES: 3/16" CLEAR PLEX, VACUUM-FORMED WITH VINYL 5'-0' AND PAINTED GRAPHICS ON 2ND SURFACE • RETAINERS: 1" .090 ALUMINUM" PAINTED P2 4'-2' • REVEAL: 1" PAINTED WHITE • "OPEN" SIGN: ALL ALUMINUM CONSTRUCTION, 3/16" TRANS WHTE SG PLEX WITH VINYL GRAPHICS APPLIED ADDRESS: 1/4" FCO ALUMINUM PAINTED BLACK G STONE BASE: \*\*TO MATCH BUILDING\*\* INSTALLED BY 3RD PARTY MOW PAD: CONC. 3" ABOVE GRADE 0 • INTERNALLY ILLUMINATED WITH WHITE LEDs B B \*\*CANNOT EXCEED 2 FT CANDLES AS MEASURED 1 FT. FROM THE SURFACE OF THE SIGN\*\* 3'-8" • POWER SUPPLY HOUSED IN SIGN BODY SUPPORT AND FOOTING (TBD) Quick Quack DISCONNECT SWITCH AT SIGN • 120V SERVICE SUPPLIED BY OTHERS • ELECTRICAL SWEEP BY OTHERS R WASH ELECTRICAL GROUNDED TO PIPE SUPPORT **A** D THIS IS A SIGN CABINET 0 PMS 3425. 3M EMERALD GREEN 230-126 **NOT AN ELECTRONIC MESSAGE SIGN** PMS 7404. 3M YELLOW 230015 Ø 1'-2" PMS ORANGE 021, 3M ORANGE 230-44 PMS BLACK, 3M BLACK 230-22 G 0 **BASE TO MATCH** 1350 6" **MATERIAL AND COLOR** 0 OF BUILDING \*\*TBD\*\* N 0 **PROPOSED LAYOUT** SCALE: 3/4"=1'-0" 5'-4"

DRAWING STEPS

ESTIMATING

WING REV

SUDVE

Utah Contractors: 375809-5501 • Nevada:60486 • Colorado:237787 • Idaho:RCE-29969

THIS IS AN ORIGINAL UNPUBLISHED DRAWING CREATED BY ALLIED ELECTRIC SIGN. IT IS SUBMITTED FOR YOUR PERSONAL USE IN CONNECTION WITH THE PROJECT BEING PLANNED FOR YOU. IT IS NOT TO BE REPRODUCED, COPIED OR EXHIBITED.

SALES APPROVAL:




MANUFACTURE AND INSTALL

ODUCTION REVIEW Colorado Springs, CO Sales: Rea (801) 489-3645 PERMIT/LANDLORD NSTALL REVIE File Name: Quick Quack (Saratoga Springs, UT) - Sign Package - 09-07-2016 PRODUCTION/INSTAL WWW.ALLIED-SIGN.COM

Client: Quick Quack Car Wash

SALT LAKE CITY: 1920 S. 900 W., SALT LAKE CITY, UT • (801) 972-5503 OGDEN: 2924 Pennsylvania Avenue • (801) 621-4612

Address:

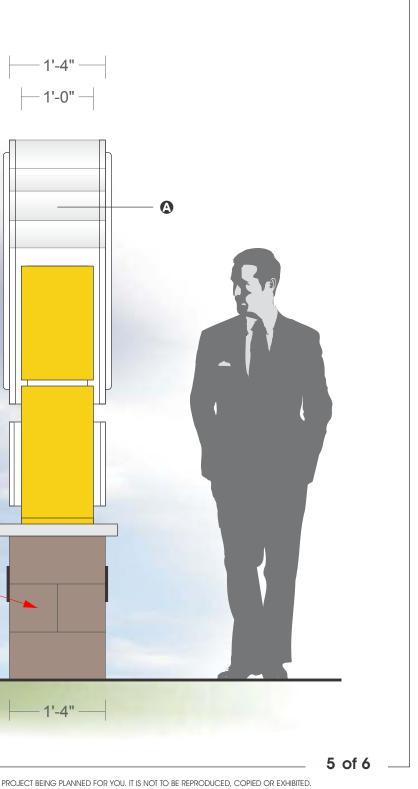

APPROVAL: Designer: Richard Sales: Regina 07-2016	CUSTOMER APPROVAL SIGNATURE	REVISIONS
1) 621-4612	<u> 19</u> 9	

# Markup Summary

dsdsevigny (6)		
Vacuum stalls in water easiement not resolved. All plans contact CSU to resolve or remove stalls from water easiement	Subject: Text Box Page Label: [1] QQ CO CONSTITUTION 1H-COVER Lock: Locked Author: dsdsevigny Date: 4/2/2019 10:52:55 AM Color:	Vacuum stalls in water easement not resolved. All plans subject to change. Please contact CSU to resolve or remove stalls from water easement
	Subject: Cloud+ Page Label: [2] QQ CO CONSTITUTION 1H-SITE Lock: Locked Author: dsdsevigny Date: 4/2/2019 10:52:56 AM Color:	not resolved, canopies and vacuums cannot be located in the water easement per CSU comments.
	Subject: Cloud+ Page Label: [6] QQ CO CONSTITUTION 1H-DETAILS (2) Lock: Locked Author: dsdsevigny Date: 4/2/2019 10:52:57 AM Color:	Landscaping cannot be located in the ROW, the previous comment was to add trees to the existing layout
Section 62.3(8)(1)(4) Maximum Levels, on-site Righting shall not exceed 10 both rules throughout the site.	Subject: Text Box Page Label: [6] QQ CO CONSTITUTION 1H-DETAILS (2) Lock: Locked Author: dsdsevigny Date: 4/2/2019 10:52:58 AM Color:	Section 6.2.3(B)(1)(d) Maximum Levels, on-site lighting shall not exceed 10 footcandles throughout the site.
	Subject: Text Box Page Label: [6] QQ CO CONSTITUTION 1H-DETAILS (2) Lock: Locked Author: dsdsevigny Date: 4/2/2019 10:52:59 AM Color:	A separate sign permit will be required, please inform the planner if you will also will be applying for the sign permit so I can create the project
transformed by the second sec	Subject: Text Box Page Label: [6] QQ CO CONSTITUTION 1H-DETAILS (2) Lock: Locked Author: dsdsevigny Date: 4/2/2019 10:53:00 AM Color:	A separate sign permit will be required, please inform the planner if you will also will be applying for the sign permit so I can create the project