FLYING HORSE NORTH

PRELIMINARY PLAN

A AND C

B, E, F, H, I, J

D AND G

M, N

O, P, Q, R, S, T

FUTURE FILING

BB, GG

X, Y, Z, AA, DD, EE

U, V, W

CC, DD, FF

All phases have been

LOT TYPICALS*

10' SIDE BLDG. SETBACK

TYPICAL LOT

30' FRONT

BLDG. SETBACK

identified on the phasing plan above. All tracts should be

included for each

2 PARCELS OF LAND BEING A PORTION OF SECTIONS 34, 35, AND 36, TOWNSHIP 11 SOUTH, RANGE 66 WEST, AND A PORTION OF SECTIONS 30 AND 31, TOWNSHIP 11 SOUTH, RANGE 65 WEST OF THE SIXTH PRINCIPAL MERIDIAN, EL PASO COUNTY, COLORADO

LEGAL DESCRIPTION

A PARCEL OF LAND BEING ALL OF SECTION 36 TOWNSHIP 11 SOUTH, RANGE 66 WEST OF THE SIXTH PRINCIPAL MERIDIAN, AND A PORTION OF SECTIONS 30 AND 31, TOWNSHIP 11 SOUTH, RANGE 65 WEST OF THE SIXTH PRINCIPAL MERIDIAN, ALL IN EL PASO COUNTY, COLORADO, BEING MORE PARTICULARLY DESCRIBED AS FOLLOWS:

BASIS OF BEARINGS: THE SOUTH LINE OF THE NORTHEAST QUARTER OF THE SOUTHWEST QUARTER OF SECTION 3, TOWNSHIP 12 SOUTH, RANGE 66 WEST OF THE SIXTH PRINCIPAL MERIDIAN, BEING MONUMENTED AT THE WEST END BY A 2" ALUMINUM CAP STAMPED "24964" AND THE EAST END BY A 2 1/2" ALUMINUM CAP STAMPED "CCES LLC PLS 30118", IS ASSUMED TO BEAR S89°51'39"E, A

COMMENCING AT THE NORTHWEST CORNER OF SECTION 36, TOWNSHIP 11 SOUTH, RANGE 66 WEST OF THE SIXTH PRINCIPAL MERIDIAN, EL PASO COUNTY, COLORADO, SAID POINT BEING THE POINT OF

THENCE N89°06'04"E, ON THE SOUTHERLY BOUNDARY OF HIGH FOREST RANCH FILING NO. 2, RECORDED UNDER RECEPTION NO. 202134767, RECORDS OF EL PASO COUNTY, COLORADO AND THE NORTH LINE OF NORTHWEST QUARTER OF THE NORTHWEST QUARTER OF SECTION 36. TOWNSHIP 11 SOUTH, RANGE 66 WEST OF THE SIXTH PRINCIPAL MERIDIAN, EL PASO COUNTY, COLORADO, A DISTANCE OF 1332.12 FEET TO THE SOUTHEASTERLY CORNER OF SAID HIGH FOREST RANCH FILING NO. 2, SAID POINT BEING THE WEST SIXTEENTH CORNER OF SAID SECTION 36; THENCE N89°07'00"E. ON THE NORTH LINE OF THE NORTHEAST QUARTER OF THE NORTHWEST QUARTER OF SAID SECTION 36. A DISTANCE OF 1331.92 FEET TO THE NORTH QUARTER CORNER OF SAID SECTION THENCE N89°01'18"E. ON THE NORTH LINE OF THE NORTHWEST QUARTER OF THE NORTHEAST QUARTER OF SAID SECTION 36. A DISTANCE OF 1331 92 FEET TO THE FAST SIXTEENTH CORNER OF SAID SECTION THENCE N89°03'58"E, ON THE NORTH LINE OF THE NORTHEAST QUARTER OF THE NORTHEAST QUARTER OF SAID SECTION 36, A DISTANCE OF 1332.09 FEET TO THE NORTHEAST CORNER OF SAID SECTION 36; THENCE N89°06'20"E, ON THE NORTH LINE OF THE NORTHWEST QUARTER OF THE NORTHWEST QUARTER OF SECTION 31. TOWNSHIP 11 SOUTH, RANGE 65 WEST OF THE SIXTH PRINCIPAL MERIDIAN, EL PASO COUNTY, COLORADO, A DISTANCE OF 1474.13 FEET TO THE WEST SIXTEENTH CORNER OF SAID SECTION 31: THENCE NO0°08'36"E, ON THE WEST LINE OF THE SOUTHEAST QUARTER OF THE SOUTHWEST QUARTER OF SECTION 30, TOWNSHIP 11 SOUTH, RANGE 65 WEST OF THE SIXTH PRINCIPAL MERIDIAN, EL PASO COUNTY, COLORADO, A DISTANCE OF 1325.48 FEET TO THE SOUTHWEST SIXTEENTH CORNER OF SAID SECTION 30; THENCE N89°03'20"E, ON THE NORTH LINE OF SAID SOUTHEAST QUARTER OF THE SOUTHWEST QUARTER OF SECTION 30, A DISTANCE OF 920.27 FEET TO THE SOUTHWEST CORNER OF THE EASTERLY TWELVE (12) ACRES OF THE NORTHEAST QUARTER OF THE SOUTHWEST QUARTER OF SAID SECTION 30; THENCE NOO°08'15"E ON THE WEST LINE OF SAID FASTERLY (12) TWELVE ACRES OF THE NORTHEAST QUARTER OF THE SOUTHWEST QUARTER OF SECTION 30. A DISTANCE OF 1326 26 FEET TO THE NORTHWESTERLY CORNER OF SAID EAST (12) TWELVE ACRES OF THE NORTHEAST QUARTER OF THE SOUTHWEST QUARTER OF SECTION 30, SAID POINT BEING ON THE NORTH LINE OF SAID NORTHEAST

THENCE N89°01'31"E, ON THE NORTH LINE OF SAID NORTHEAST QUARTER OF THE SOUTHWEST QUARTER OF SECTION 30, A DISTANCE OF 399.42 FEET TO THE CENTER QUARTER OF SAID SECTION 30; THENCE NO0°08'48"E, ON THE WEST LINE OF THE NORTHEAST QUARTER OF SAID SECTION 30, A DISTANCE OF 2604.74 FEET TO A POINT ON THE SOUTHERLY BOUNDARY OF A PARCEL OF LAND DESCRIBED IN A DOCUMENT RECORDED UNDER RECEPTION NO. 210081316; THENCE ON SAID SOUTHERLY BOUNDARY, THE FOLLOWING (3) THREE COURSES

QUARTER OF THE SOUTHWEST QUARTER OF SECTION 30 (HELD MONUMENTS DEPICTED ON LAND SURVEY PLAT DEPOSITED UNDER RECEPTION NO. 91000488 BY BERGE-BREWER & ASSOCIATES, INC ON JULY

1. N88°58'45"E, A DISTANCE OF 2270.00 FEET; 2. S71°21'27"E, A DISTANCE OF 29.72 FEET,

3. N88°58'45"E, A DISTANCE OF 299.96 FEET TO A POINT ON A LINE 30.00 FEET WEST OF AND PARALLEL TO THE EAST LINE OF SAID NORTHEAST QUARTER OF SECTION 30;

THENCE S00°00'48"W, ON SAID PARALLEL LINE, A DISTANCE OF 2595.64 FEET TO A POINT ON A LINE 30.00 FEET WEST OF AND PARALLEL TO THE EAST LINE OF THE SOUTHEAST QUARTER SAID SECTION 30; THENCE S00°00'53"W, ON SAID PARALLEL LINE, A DISTANCE OF 2656.67 FEET TO A POINT ON THE SOUTH LINE OF THE SOUTHEAST QUARTER OF THE SOUTHEAST QUARTER OF SAID SECTION 30; THENCE S89°04'37"W, ON SAID SOUTH LINE, A DISTANCE OF 1290.01 FEET TO THE EAST SIXTEENTH CORNER OF SAID SECTION 31;

THENCE S00°00'11"E, ON THE EAST LINE OF THE NORTHWEST QUARTER OF THE NORTHEAST QUARTER OF SAID SECTION 31, A DISTANCE OF 1326.67 FEET TO THE NORTHEAST SIXTEENTH CORNER OF SAID THENCE N89°08'21"E, ON THE NORTH LINE OF THE SOUTHEAST QUARTER OF THE NORTHEAST QUARTER OF SAID SECTION 31, A DISTANCE OF 1289.57 FEET TO A POINT ON A LINE 30.00 FEET WEST OF AND PARALLEL TO THE EAST LINE OF SAID SOUTHEAST QUARTER OF THE NORTHEAST QUARTER OF SECTION 31; THENCE SO0°00'54"W, ON SAID PARALLEL LINE, A DISTANCE OF 1328.09 FEET TO A POINT ON THE SOUTH LINE OF THE SOUTHEAST QUARTER OF THE NORTHEAST QUARTER OF SAID SECTION 31, SAID POINT BEING ON THE NORTHERLY BOUNDARY OF COUNTRY VIEW ESTATES. BECORDED UNDER RECEPTION NO. 99011204 THENCE S89°11'15"W, ON SAID SOUTH LINE AND THE NORTHERLY BOUNDARY OF SAID COUNTRY VIEW ESTATES AND ITS WESTERLY EXTENSION, A DISTANCE OF 2608.28 FEET TO THE CENTER QUARTER CORNER THENCE S89°11'00"W, ON THE SOUTH LINE OF THE SOUTHEAST QUARTER OF THE NORTHWEST QUARTER OF SAID SECTION 31, A DISTANCE OF 1320.84 FEET TO THE CENTER-WEST SIXTEENTH CORNER OF SAID THENCE S00°00'34"W, ON THE EAST LINE OF THE NORTHWEST QUARTER OF THE SOUTHWEST QUARTER OF SAID SECTION 31, A DISTANCE OF 1329.16 FEET TO THE SOUTHWEST SIXTEENTH CORNER OF SAID SECTION 31, SAID POINT BEING ON THE NORTHERLY BOUNDARY OF PALMER DIVIDE, RECORDED UNDER RECEPTION NO. 205084216; THENCE S89°24'17"W, ON THE SOUTH LINE OF SAID NORTHWEST QUARTER OF THE SOUTHWEST QUARTER OF SECTION 31 AND SAID NORTHERLY BOUNDARY OF PALMER DIVIDE AND ITS WESTERLY EXTENSION, A DISTANCE OF 1440 81 FEET TO THE SOUTH SIXTEENTH CORNER OF SAID SECTION 31: THENCE S00°28'30"E, ON THE EAST LINE OF THE SOUTHEAST QUARTER OF THE SOUTHEAST QUARTER OF SAID SECTION 36, A DISTANCE OF 1323.57 FEET TO THE SOUTHEAST CORNER OF SAID SECTION 36, SAID POINT ALSO BEING THE NORTHEASTERLY CORNER OF EDMONDS SUBDIVISION, RECORDED IN PLAT BOOK H-3 AT PAGE 60; THENCE S89°20'59"W, ON THE SOUTH LINE OF THE SOUTHEAST QUARTER OF SAID SECTION 36, THE NORTHERLY BOUNDARY OF SAID EDMONDS SUBDIVISION AND THE NORTHERLY BOUNDARY OF CATHEDRAL PINES SUBDIVISION FILING NO. 2. RECORDED UNDER RECEPTION NO. 205164426. A DISTANCE OF 2674 51 FEET TO THE SOUTH QUARTER CORNER OF SAID SECTION 36: THENCE S89°20'35"W, ON THE SOUTH LINE OF THE SOUTHWEST QUARTER OF SAID SECTION 30, CONTINUING ON SAID NORTHERLY BOUNDARY OF CATHEDRAL PINES SUBDIVISION FILING NO. 2 AND ON THE NORTHERLY BOUNDARY OF CATHEDRAL PINES SUBDIVISION FILING NO. 3, RECORDED UNDER RECEPTION NO. 206712390, A DISTANCE OF 2674.51 FEET TO THE SOUTHWEST CORNER OF SAID SECTION 36; THENCE N00°14'34"W, ON THE WEST LINE OF SAID SECTION 36, A DISTANCE OF 5269.38 FEET TO THE POINT OF BEGINNING.

IN ADDITION TO: WEST PARCEL

WEST PARCEL

A PARCEL OF LAND BEING A PORTION OF SECTIONS 34 AND 35, TOWNSHIP 11 SOUTH, RANGE 66 WEST OF THE SIXTH PRINCIPAL MERIDIAN, EL PASO COUNTY, COLORADO, BEING MORE PARTICULARLY DESCRIBED

BASIS OF BEARINGS: THE EAST LINE OF SECTION 35, TOWNSHIP 11 SOUTH, RANGE 66 WEST OF THE SIXTH PRINCIPAL MERIDIAN, BEING MONUMENTED AT THE NORTH END BY A 2 1/2" ALUMINUM CAP STAMPED "22564" AND THE SOUTH END BY A 2 1/2" ALUMINUM CAP STAMPED "9132", IS ASSUMED TO BEAR S00°14'34"E, A DISTANCE OF 5269.38 FEET.

COMMENCING AT THE NORTHEAST CORNER OF SECTION 35, TOWNSHIP 11 SOUTH, RANGE 66 WEST OF THE SIXTH PRINCIPAL MERIDIAN, EL PASO COUNTY, COLORADO, SAID POINT BEING THE POINT OF

THENCE S00°14'34"E. ON THE EAST LINE OF SAID SECTION 35. A DISTANCE OF 523.85 FEET TO A POINT ON CURVE: THENCE ON THE ARC OF A CURVE TO THE LEFT WHOSE CENTER BEARS S33°01'51"W, HAVING A DELTA OF 38°24'48", A RADIUS OF 535.00 FEET AND A DISTANCE OF 358.69 FEET TO A POINT OF TANGENT;

THENCE S84°37'03"W, A DISTANCE OF 175.44 FEET TO A POINT OF CURVE; THENCE ON THE ARC OF A CURVE TO THE RIGHT HAVING A DELTA OF 11°13'59", A RADIUS OF 615.00 FEET AND A DISTANCE OF 120.57 FEET TO A POINT OF TANGENT;

THENCE N84°08'58"W, A DISTANCE OF 684.98 FEET TO A POINT OF CURVE; THENCE ON THE ARC OF A CURVE TO THE RIGHT HAVING A DELTA OF 25°13'51", A RADIUS OF 615.00 FEET AND A DISTANCE OF 270.82 FEET TO A POINT OF TANGENT;

THENCE N58°55'07"W, A DISTANCE OF 166.51 FEET TO A POINT OF CURVE; IHENCE ON THE ARC OF A CURVE TO THE LEFT HAVING A DELTA OF 31°18'40", A RADIUS OF 535.00 FEET AND A DISTANCE OF 292.37 FEET TO A POINT OF TANGENT;

THENCE S89°46'13"W. A DISTANCE OF 1674.58 FEET TO A POINT OF CURVE: THENCE ON THE ARC OF A CURVE TO THE LEFT HAVING A DELTA OF 24°52'43", A RADIUS OF 1960.00 FEET AND A DISTANCE OF 851.06 FEET TO A POINT OF TANGENT; THENCE S64°53'30"W, A DISTANCE OF 459.47 FEET TO A POINT OF CURVE;

THENCE ON THE ARC OF A CURVE TO THE RIGHT HAVING A DELTA OF 21°22'27", A RADIUS OF 1040.00 FEET AND A DISTANCE OF 387.97 FEET TO A POINT OF TANGENT THENCE S86°15'57"W, A DISTANCE OF 692.41 FEET TO A POINT OF CURVE; THENCE ON THE ARC OF A CURVE TO THE LEFT HAVING A DELTA OF 51°05'38", A RADIUS OF 535.00 FEET AND A DISTANCE OF 477.09 FEET TO A POINT OF TANGENT;

THENCE S35°10'18"W, A DISTANCE OF 291.93 FEET TO A POINT OF CURVE; IHENCE ON THE ARC OF A CURVE TO THE RIGHT HAVING A DELTA OF 53°07'49", A RADIUS OF 615.00 FEET AND A DISTANCE OF 570.29 FEET TO A POINT OF TANGENT;

THENCE S88°18'07"W, A DISTANCE OF 160.75 FEET TO A POINT ON THE EASTERLY RIGHT OF WAY LINE OF STATE HIGHWAY 83; THENCE NO1°41'53"W, ON SAID EASTERLY RIGHT OF WAY LINE A DISTANCE OF 90.00 FEET TO THE SOUTHWESTERLY CORNER OF LOT 1 AS PLATTED IN WESCOTT FIRE STATION NO. 3, RECORDED UNDER

RECEPTION NO. 212713192 RECORDS OF EL PASO COUNTY, COLORADO;

THENCE ON THE SOUTHERLY, EASTERLY AND NORTHERLY BOUNDARY OF SAID LOT 1 THE FOLLOWING (5) FIVE COURSES;

1.N88°18'07"E, A DISTANCE OF 165.75 FEET TO A POINT OF CURVE; 2.ON THE ARC OF A CURVE TO THE LEFT HAVING A DELTA OF 54°10'43", A RADIUS OF 460.00 FEET AND A DISTANCE OF 434.97 FEET TO A POINT OF REVERSE CURVE; 3.ON THE ARC OF A CURVE TO THE RIGHT HAVING A DELTA OF 15°19'05", A RADIUS OF 560.00 FEET AND A DISTANCE OF 149.72 FEET TO A POINT ON CURVE;

4 N38°00'00"W. A DISTANCE OF 141 67 FEFT: 5.S88°20'00"W, A DISTANCE OF 587.56 FEET TO A POINT ON THE EASTERLY RIGHT OF WAY OF SAID STATE HIGHWAY 83;

THENCE ON SAID EASTERLY RIGHT OF WAY THE FOLLOWING (3) THREE COURSES;

1.N01°41'53"W, A DISTANCE OF 446.49 FEET; 2.N00°02'53"W, A DISTANCE OF 245.49 FEET TO A POINT ON CURVE;

3.ON THE ARC OF A CURVE TO THE RIGHT WHOSE CENTER BEARS S87°06'46"E, HAVING A DELTA OF 07°31'38", A RADIUS OF 1380.65 FEET AND A DISTANCE OF 181.38 FEET TO A POINT ON CURVE, SAID POINT BEING THE SOUTHWESTERLY CORNER OF HIGH FOREST RANCH FILING NO. 1, RECORDED UNDER RECEPTION NO. 201036672, SAID POINT ALSO BEING ON THE NORTH LINE OF THE NORTHWEST QUARTER OF THE NORTHEAST QUARTER OF SECTION 34, TOWNSHIP 11 SOUTH, RANGE 66 WEST OF THE SIXTH PRINCIPAL MERIDIAN, EL PASO COUNTY, COLORADO;

THENCE N89°54'54"E, ON THE SOUTHERLY BOUNDARY OF SAID HIGH FOREST RANCH FILING NO. 1, AND SAID NORTH LINE OF THE NORTHWEST QUARTER OF THE NORTHEAST QUARTER OF SECTION 34, A DISTANCE OF 584.61 FEET TO THE EAST SIXTEENTH CORNER OF SAID SECTION 34; THENCE S89°57'36"E, ON THE NORTH LINE OF THE NORTHEAST QUARTER OF THE NORTHEAST QUARTER OF SAID SECTION 34 AND CONTINUING ON SAID SOUTHERLY BOUNDARY OF HIGH FOREST RANCH FILING NO. 1, A DISTANCE OF 1319:30 FEET TO THE NORTHEAST CORNER OF SAID SECTION 34; THENCE N89°46'13"E, CONTINUING ON SAID SOUTHERLY BOUNDARY OF HIGH FOREST RANCH FILING NO. 1 AND ON THE NORTH LINE OF THE NORTHWEST QUARTER OF SECTION 35, TOWNSHIP 11 SOUTH, RANGE 66 WEST OF THE SIXTH PRINCIPAL MERIDIAN, EL PASO COUNTY, COLORADO, A DISTANCE OF 2660.56 FEET TO THE NORTH QUARTER CORNER OF SAID SECTION 35; THENCE N89°45'50"E, CONTINUING ON SAID SOUTHERLY BOUNDARY OF HIGH FOREST RANCH FILING NO. 1, ON THE NORTH LINE OF THE NORTHEAST QUARTER OF SAID SECTION 35 AND THE SOUTHERLY

THENCE ON SAID SOUTHERLY BOUNDARY OF HIGH FOREST RANCH FILING NO. 2, THE FOLLOWING (5) FIVE COURSES:

BOUNDARY OF HIGH FOREST RANCH FILING NO. 2, RECORDED UNDER RECEPTION NO. 202134767, A DISTANCE OF 2048.33 FEET;

1.N44°21'15"E, A DISTANCE OF 120.12 FEET; 2.N27°42'44"E, A DISTANCE OF 30.37 FEET

3.N83°51'56"E, A DISTANCE OF 62.76 FEET: 4.S79°32'21"E. A DISTANCE OF 69.45 FEET

5.S46°40'23"E, A DISTANCE OF 153.82 FEET TO A POINT ON SAID NORTH LINE OF THE NORTHEAST QUARTER OF SAID SECTION 35;

THENCE N89°48'10"E, ON SAID SOUTHERLY BOUNDARY OF HIGH FOREST RANCH FILING NO. 2 AND SAID NORTH LINE OF THE NORTHEAST QUARTER OF SECTION 35, A DISTANCE OF 270.47 FEET TO THE POINT OF

CONTAINING A CALCULATED AREA OF 70.926 ACRES.

LEGAL DESCRIPTION STATEMENT:

I, DOUGLAS P. REINELT, A LICENSED PROFESSIONAL LAND SURVEYOR IN THE STATE OF COLORADO, DO HEREBY STATE THAT THE ABOVE LEGAL WAS PREPARED UNDER MY RESPONSIBLE CHARGE AND ON THE BASIS OF MY KNOWLEDGE, INFORMATION AND BELIEF, IS CORRECT

DOUGLAS P. REINELT, PROFESSIONAL LAND SURVEYOR COLORADO P.L.S. NO. 30118 FOR AND ON BEHALF OF CLASSIC CONSULTING ENGINEERS AND SURVEYORS

GENERAL NOTES:

1. All roads will be asphalt with gravel shoulders.

2. Drainage easements will be shown on Final Plats 3. Purchasers of lots within this subdivision are hereby alerted that these lots contain storm water conveyance paths. Said purchasers acknowledge acceptance of these flows onto, and through, these lots. the purchaser of these lots shall be responsible for maintaining these paths and for providing measures to eliminate erosion, if such

4. This property is subject to the findings summary and conclusions of a geologic hazard report prepared by Entech dated february 22, 2016. A copy of said report has been submitted with the zone change request for Flying Horse North PUD. Contact the El Paso County Land use review team, if you would like to review said report. 5. Development Requirements:

Maximum lot coverage: twenty (20) percent Maximum building height: thirty (35) feet. The golf clubhouse or recreational facility may have a maximum height of forty five (45) feet.

C. Setback minimums: a. Front yard: thirty (30) feet minimum

b. Side vard; ten (10) feet minimum Corner lot: the side yard setback for the side street yard shall be twenty (20) feet minimum

c. Rear yard: thirty five (35) feet minimum Minimum Lot Size: 2.5 Acres

Accessory building must comply with the setbacks established above, except that the rear yard setback may be reduced to twenty (20) feet for any lots that do not abut a public street or the golf course. Accessory structures are governed by architectural covenants regarding building solors and materials to be consistent with the primary structure of the site.

6. All development of lots are subject to the development guidelines and provisions of the approved PUD Resolution File No#216145436.


tagecoach Rd and note the conditions for the access. Add a note stating roundabout design are not final and may


result in changes to lot sizes. These changes may be done administratively with the final plat. List out the specific lots.

Add a note identifying the 6 lots allowed to have access to

Reference the recorded PUD as well (217032585)

تتتتت

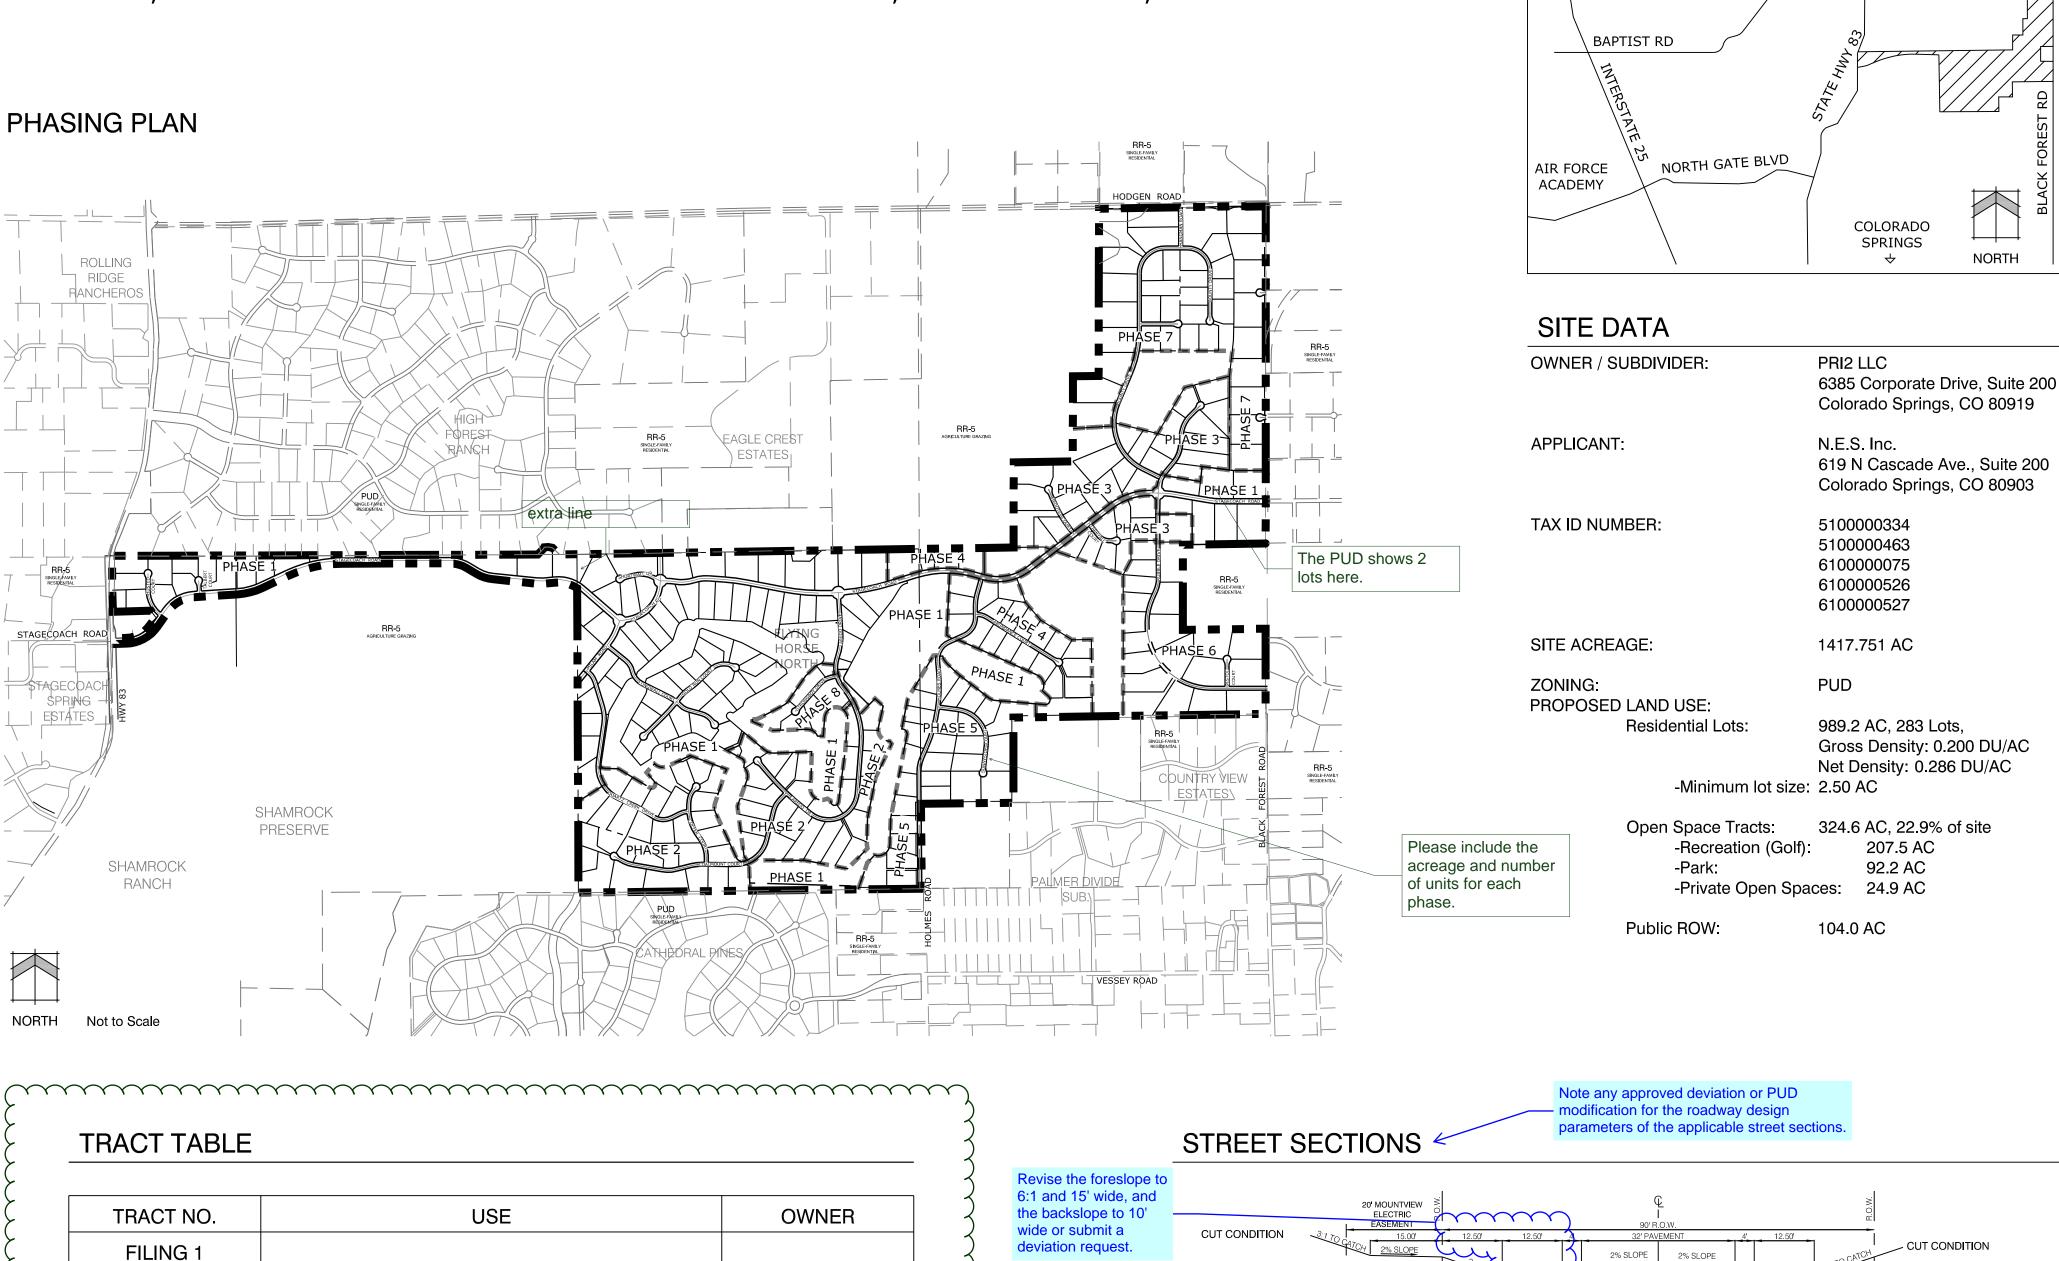

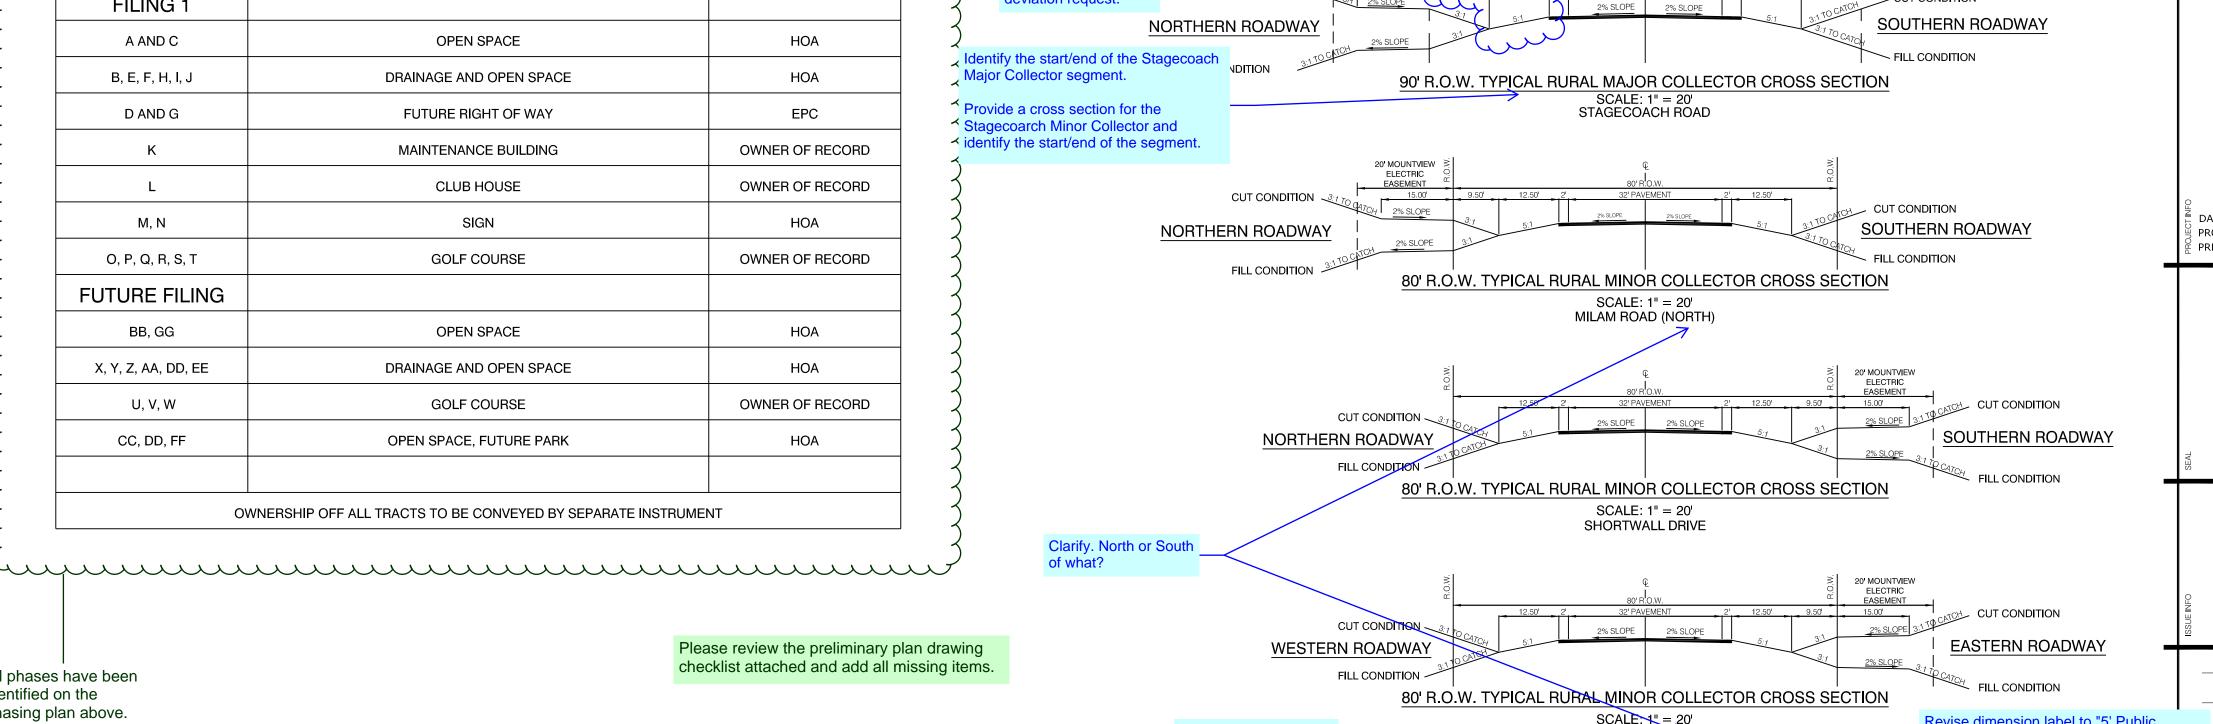


VICINITY MAP

↓ MONUMENT

STATE HWY 105

WALKER RD

HODGEN RD

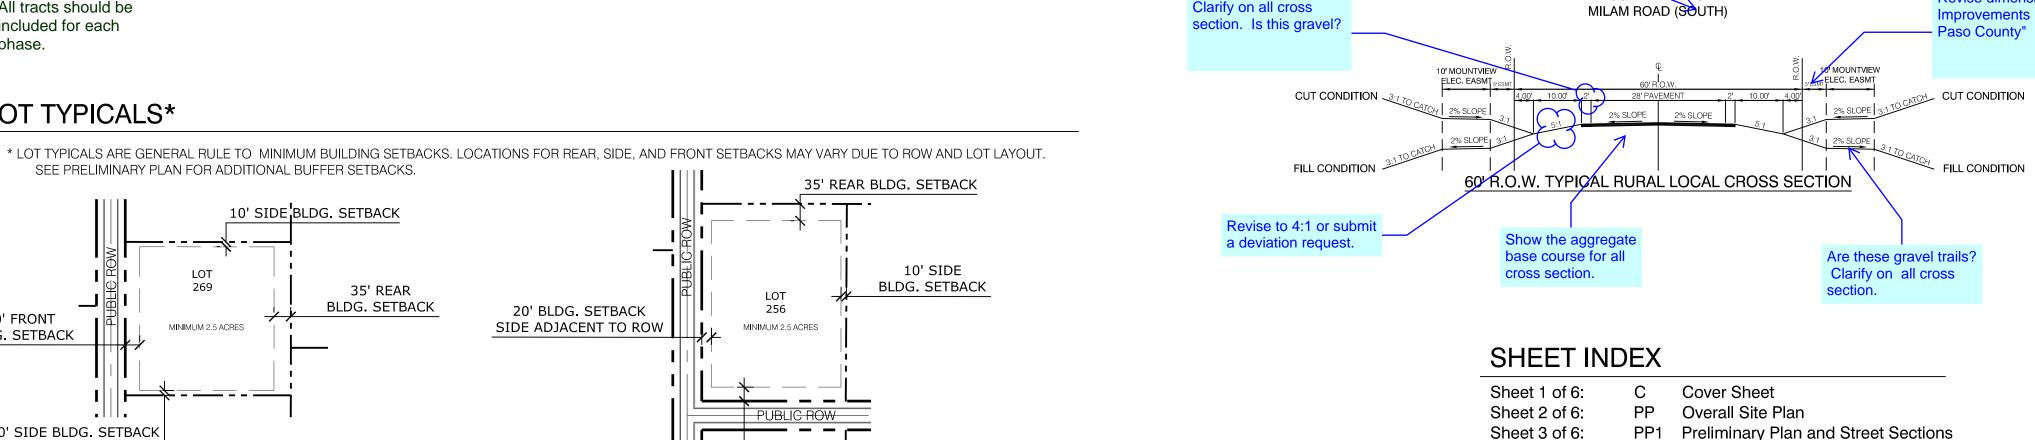

30' FRONT BLDG. SETBACK

Land Planning

Landscape

Architecture

Urban Design

619 N. Cascade Avenue, Suite 200

Colorado Springs, CO 80903

Tel. 719.471.0073

Fax 719.471.0267

www.nescolorado.com

© 2012. All Rights Reserved.

FLYING HORSE

PRELIMINARY PLAN

PROJECT MGR: J. MAYNARD, J. ROMERO PREPARED BY: K. MARSHALL

ENTITLEMENT

DESCRIPTION:

mprovements Easement Granted to El

COVER SHEET

PP2 Preliminary Plan

PP3 Preliminary Plan


PP4 Preliminary Plan & Street Sections


Sheet 4 of 6:


Sheet 5 of 6:


Sheet 6 of 6:


PCD File # SP-17-012

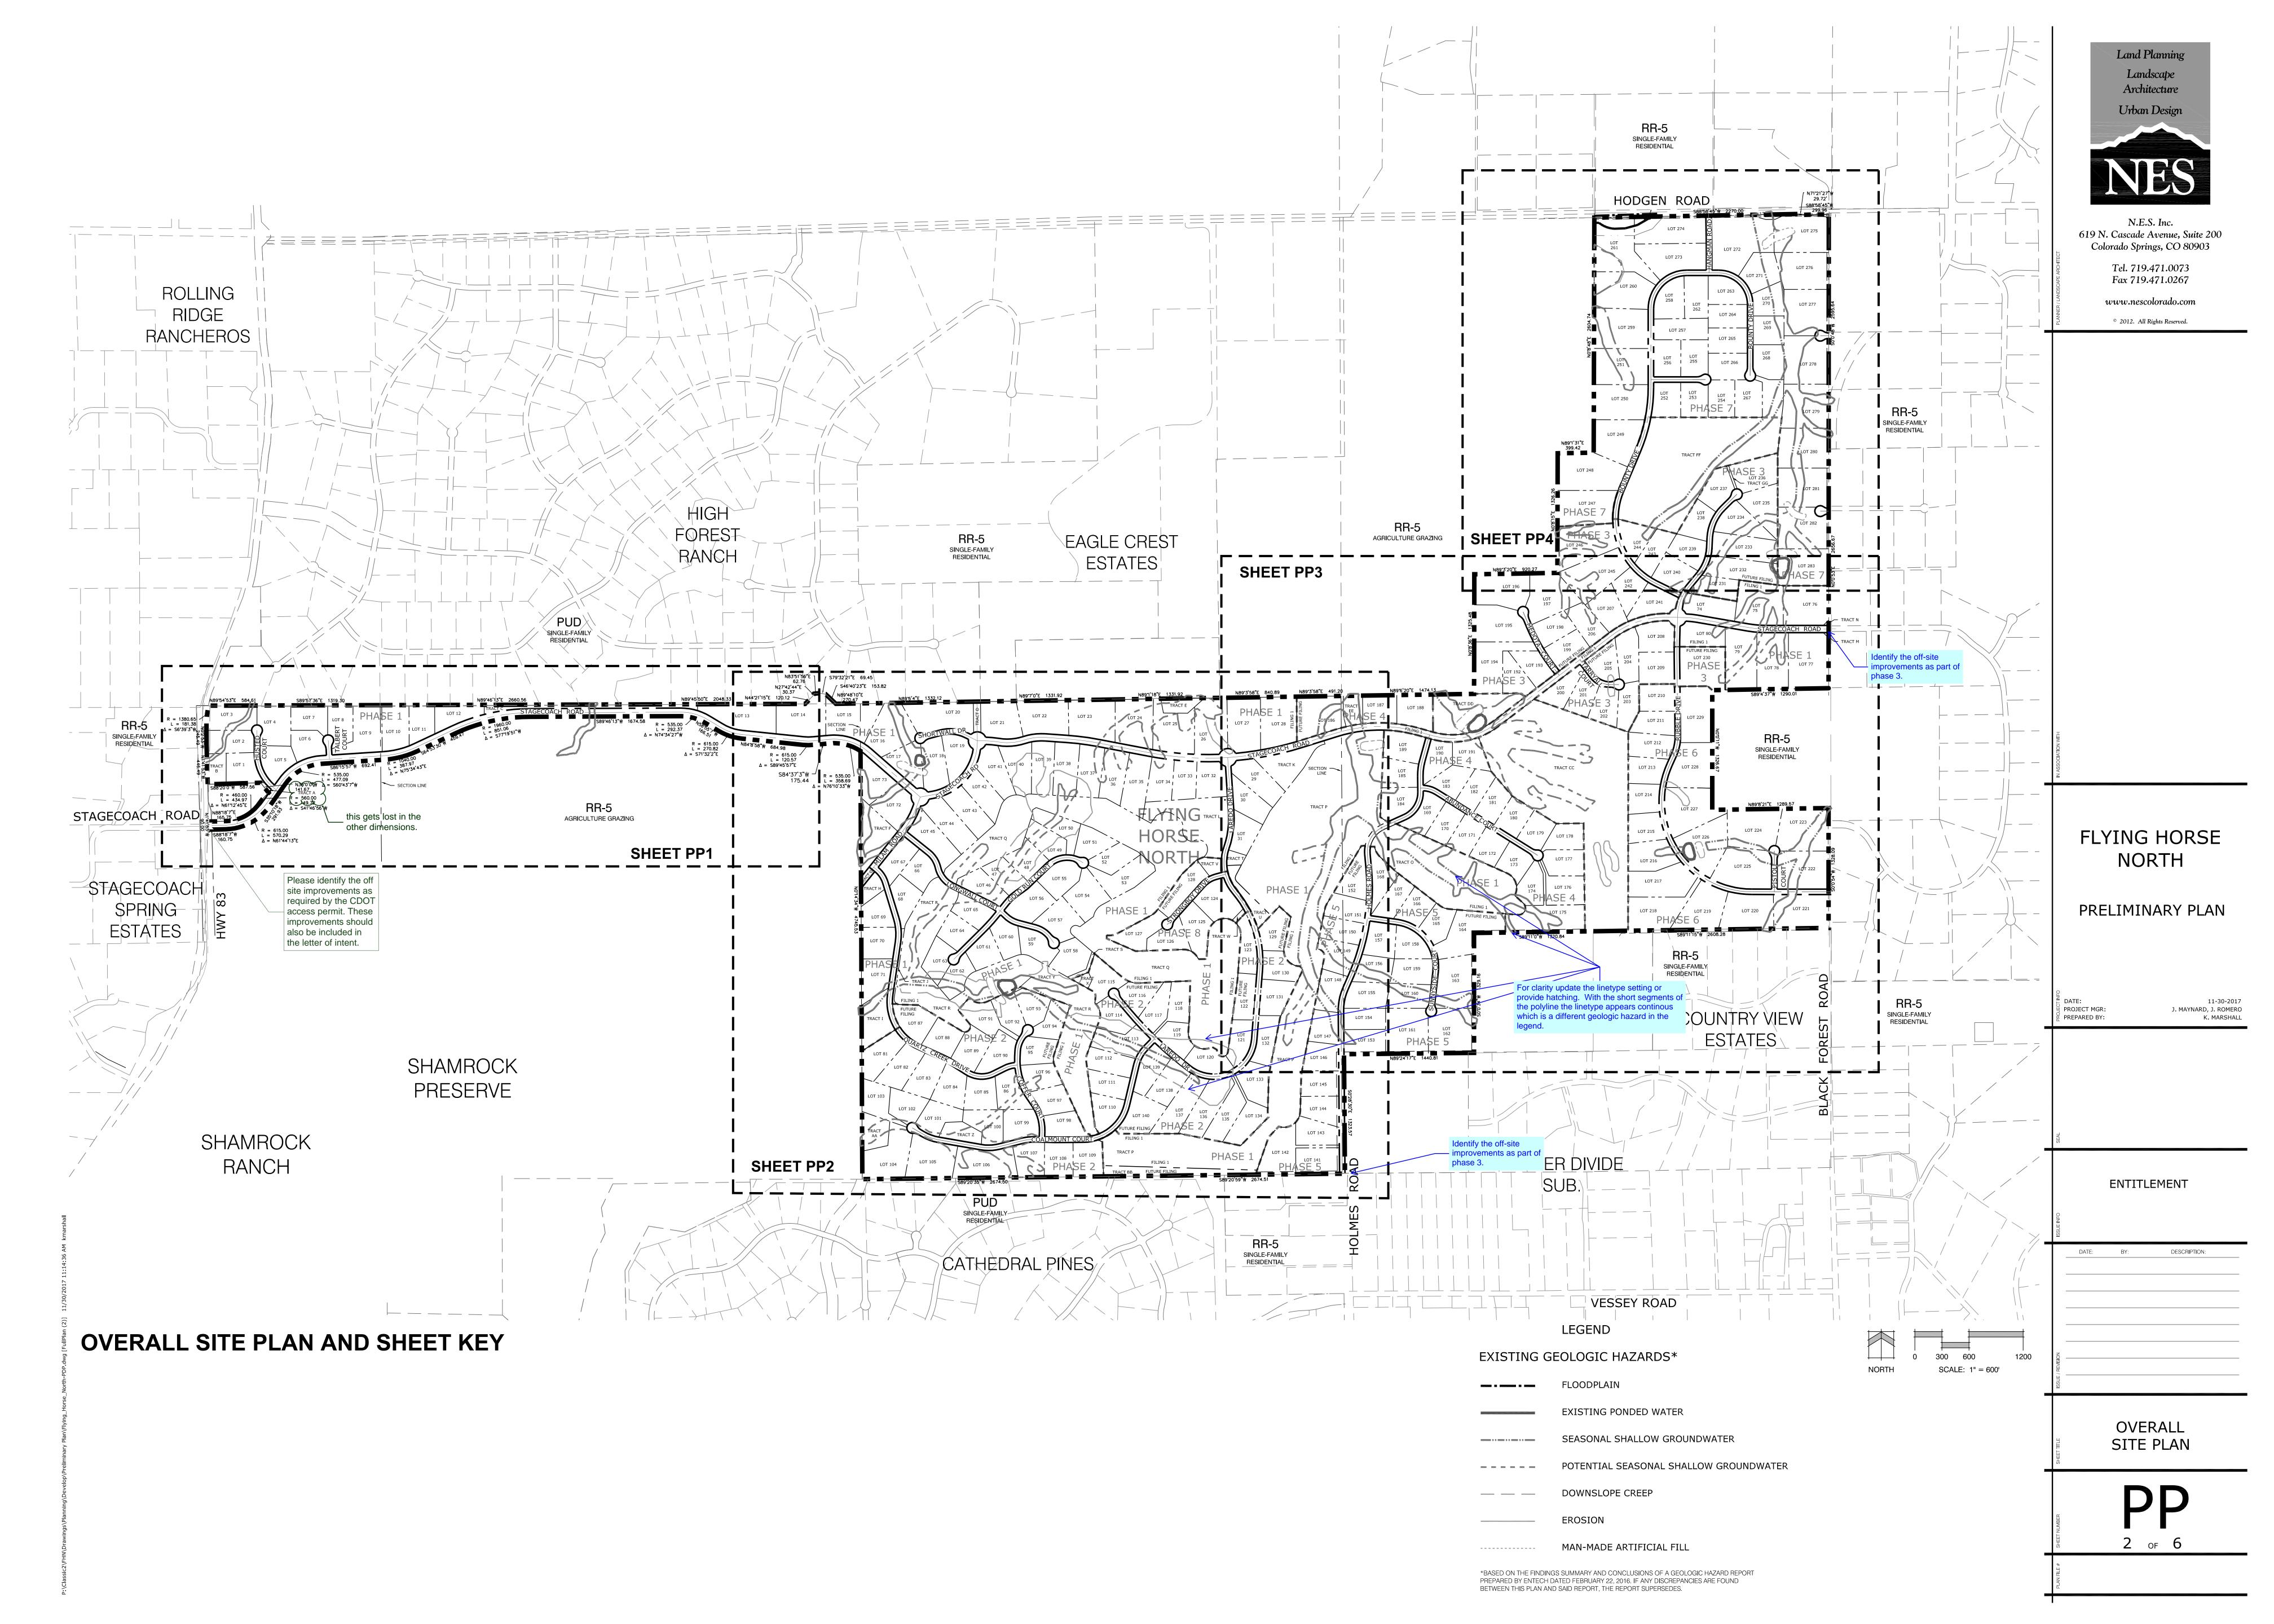

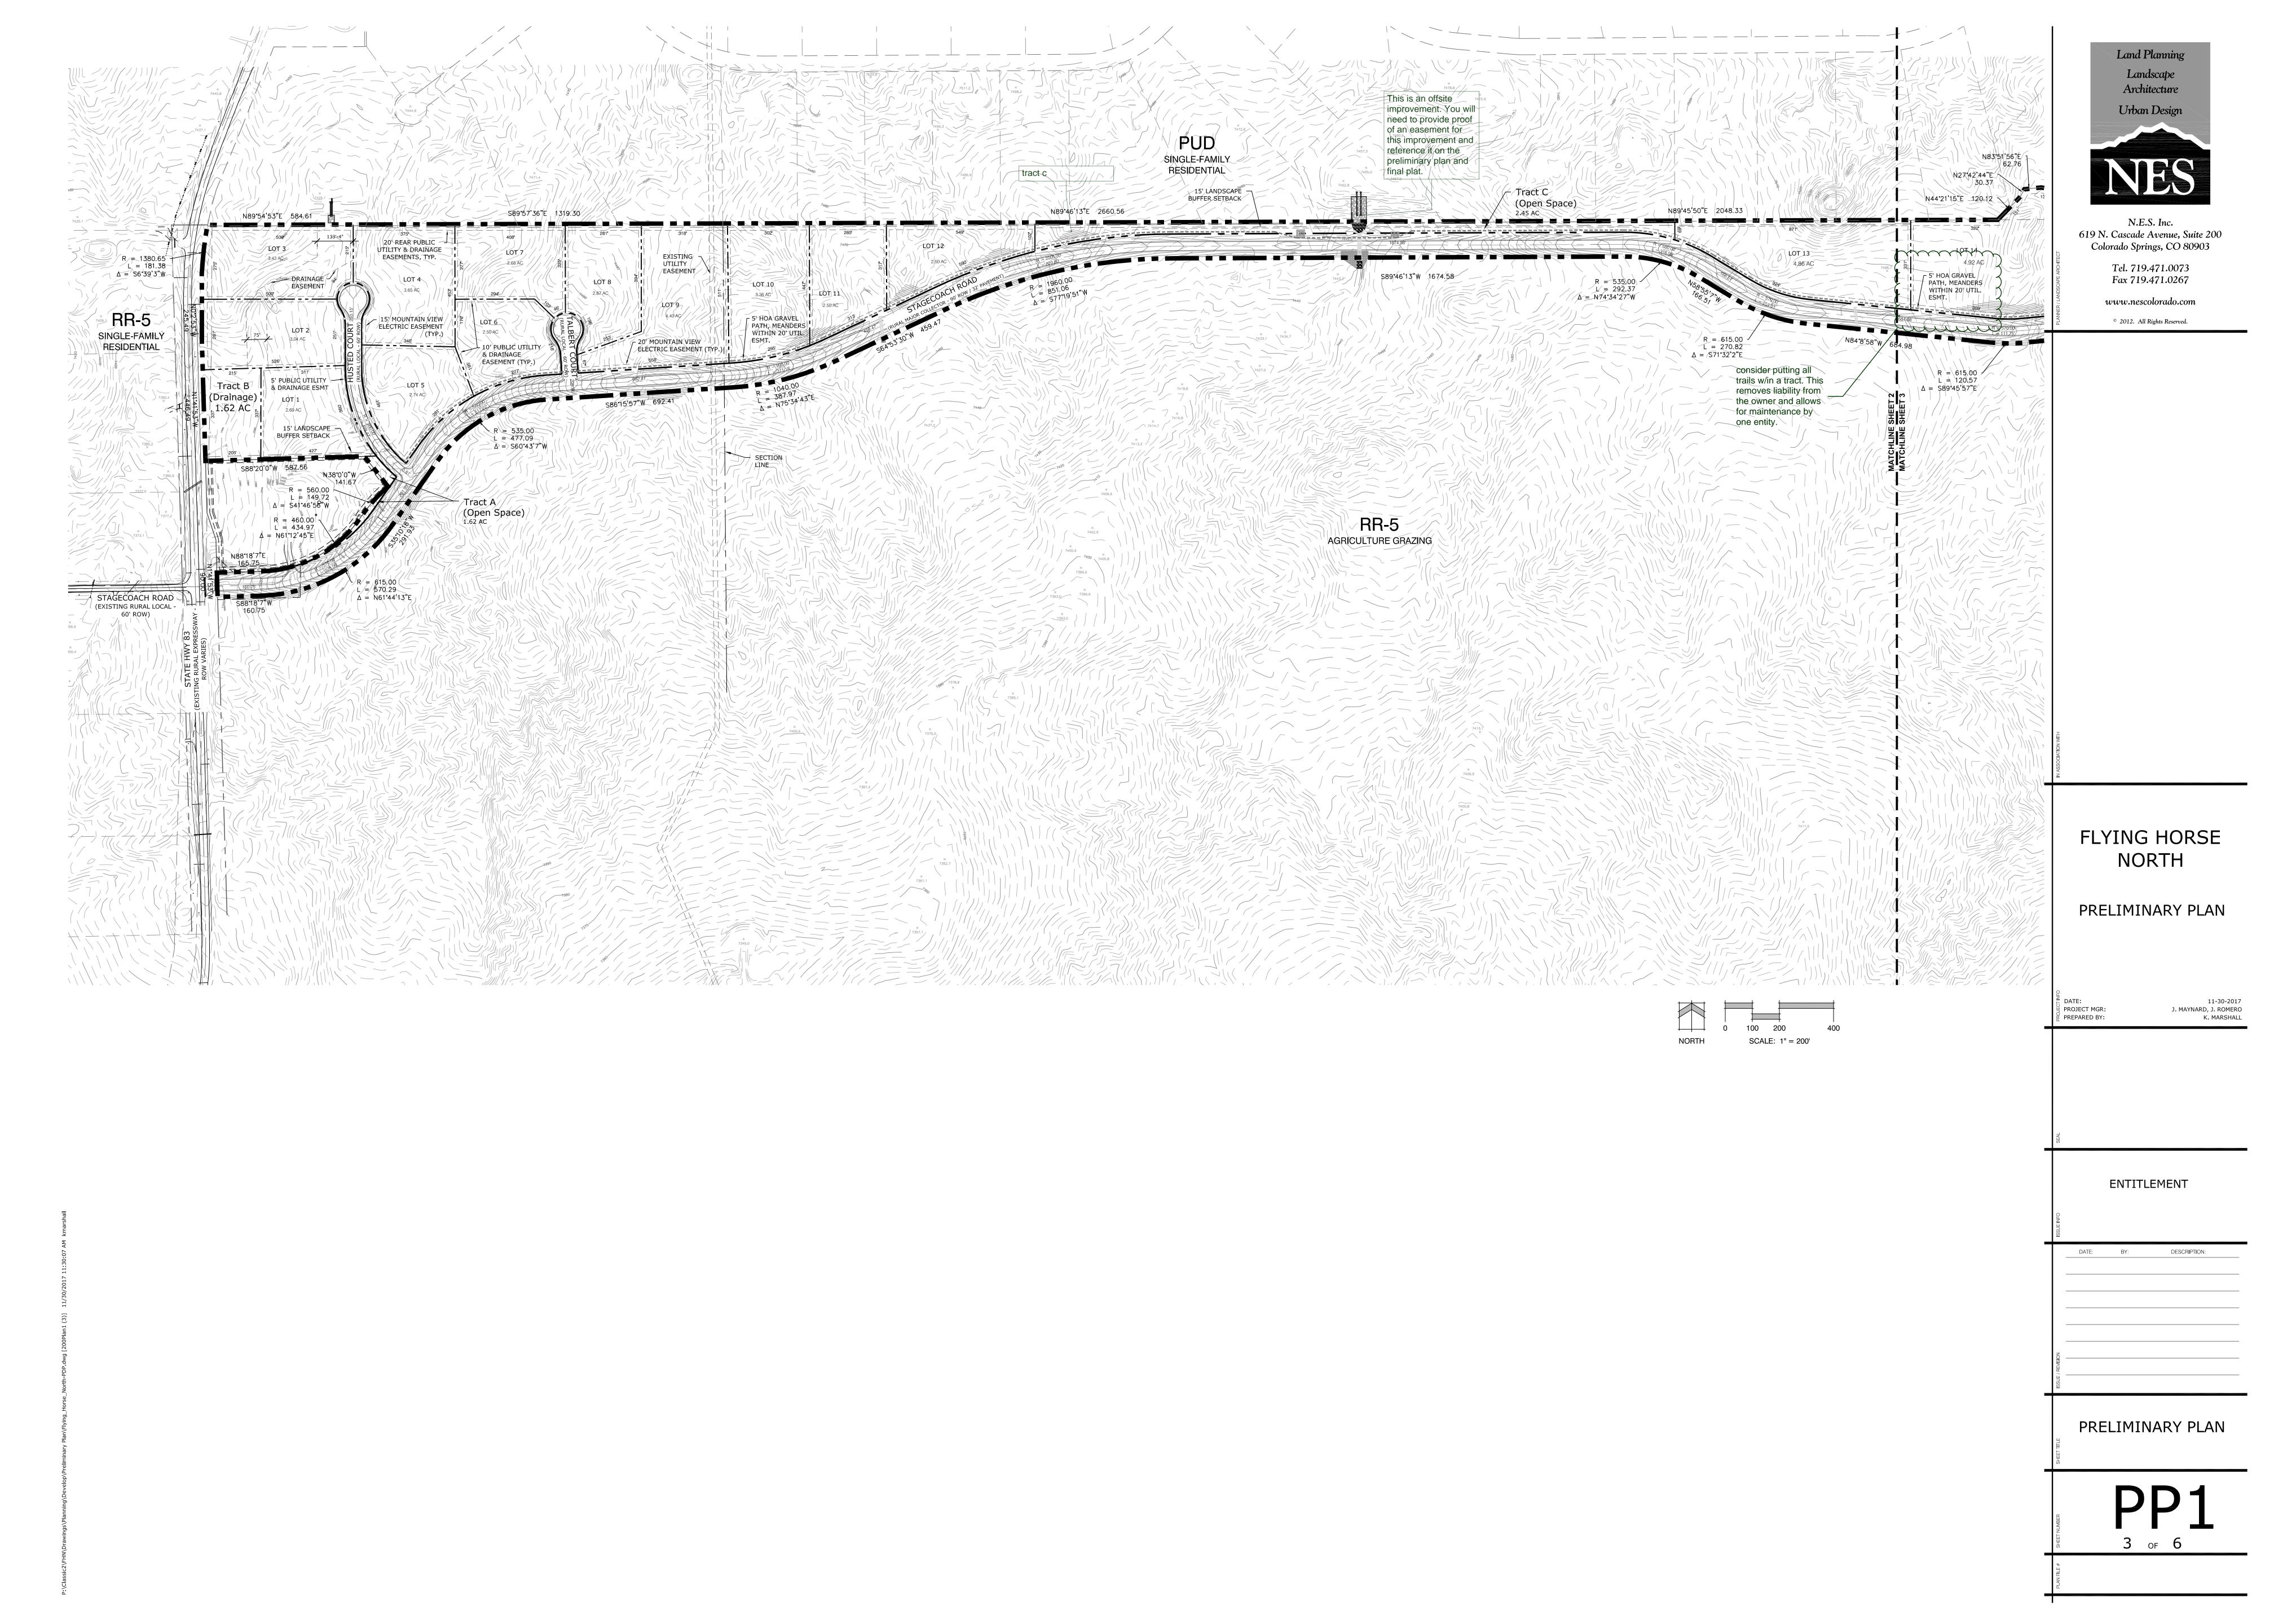

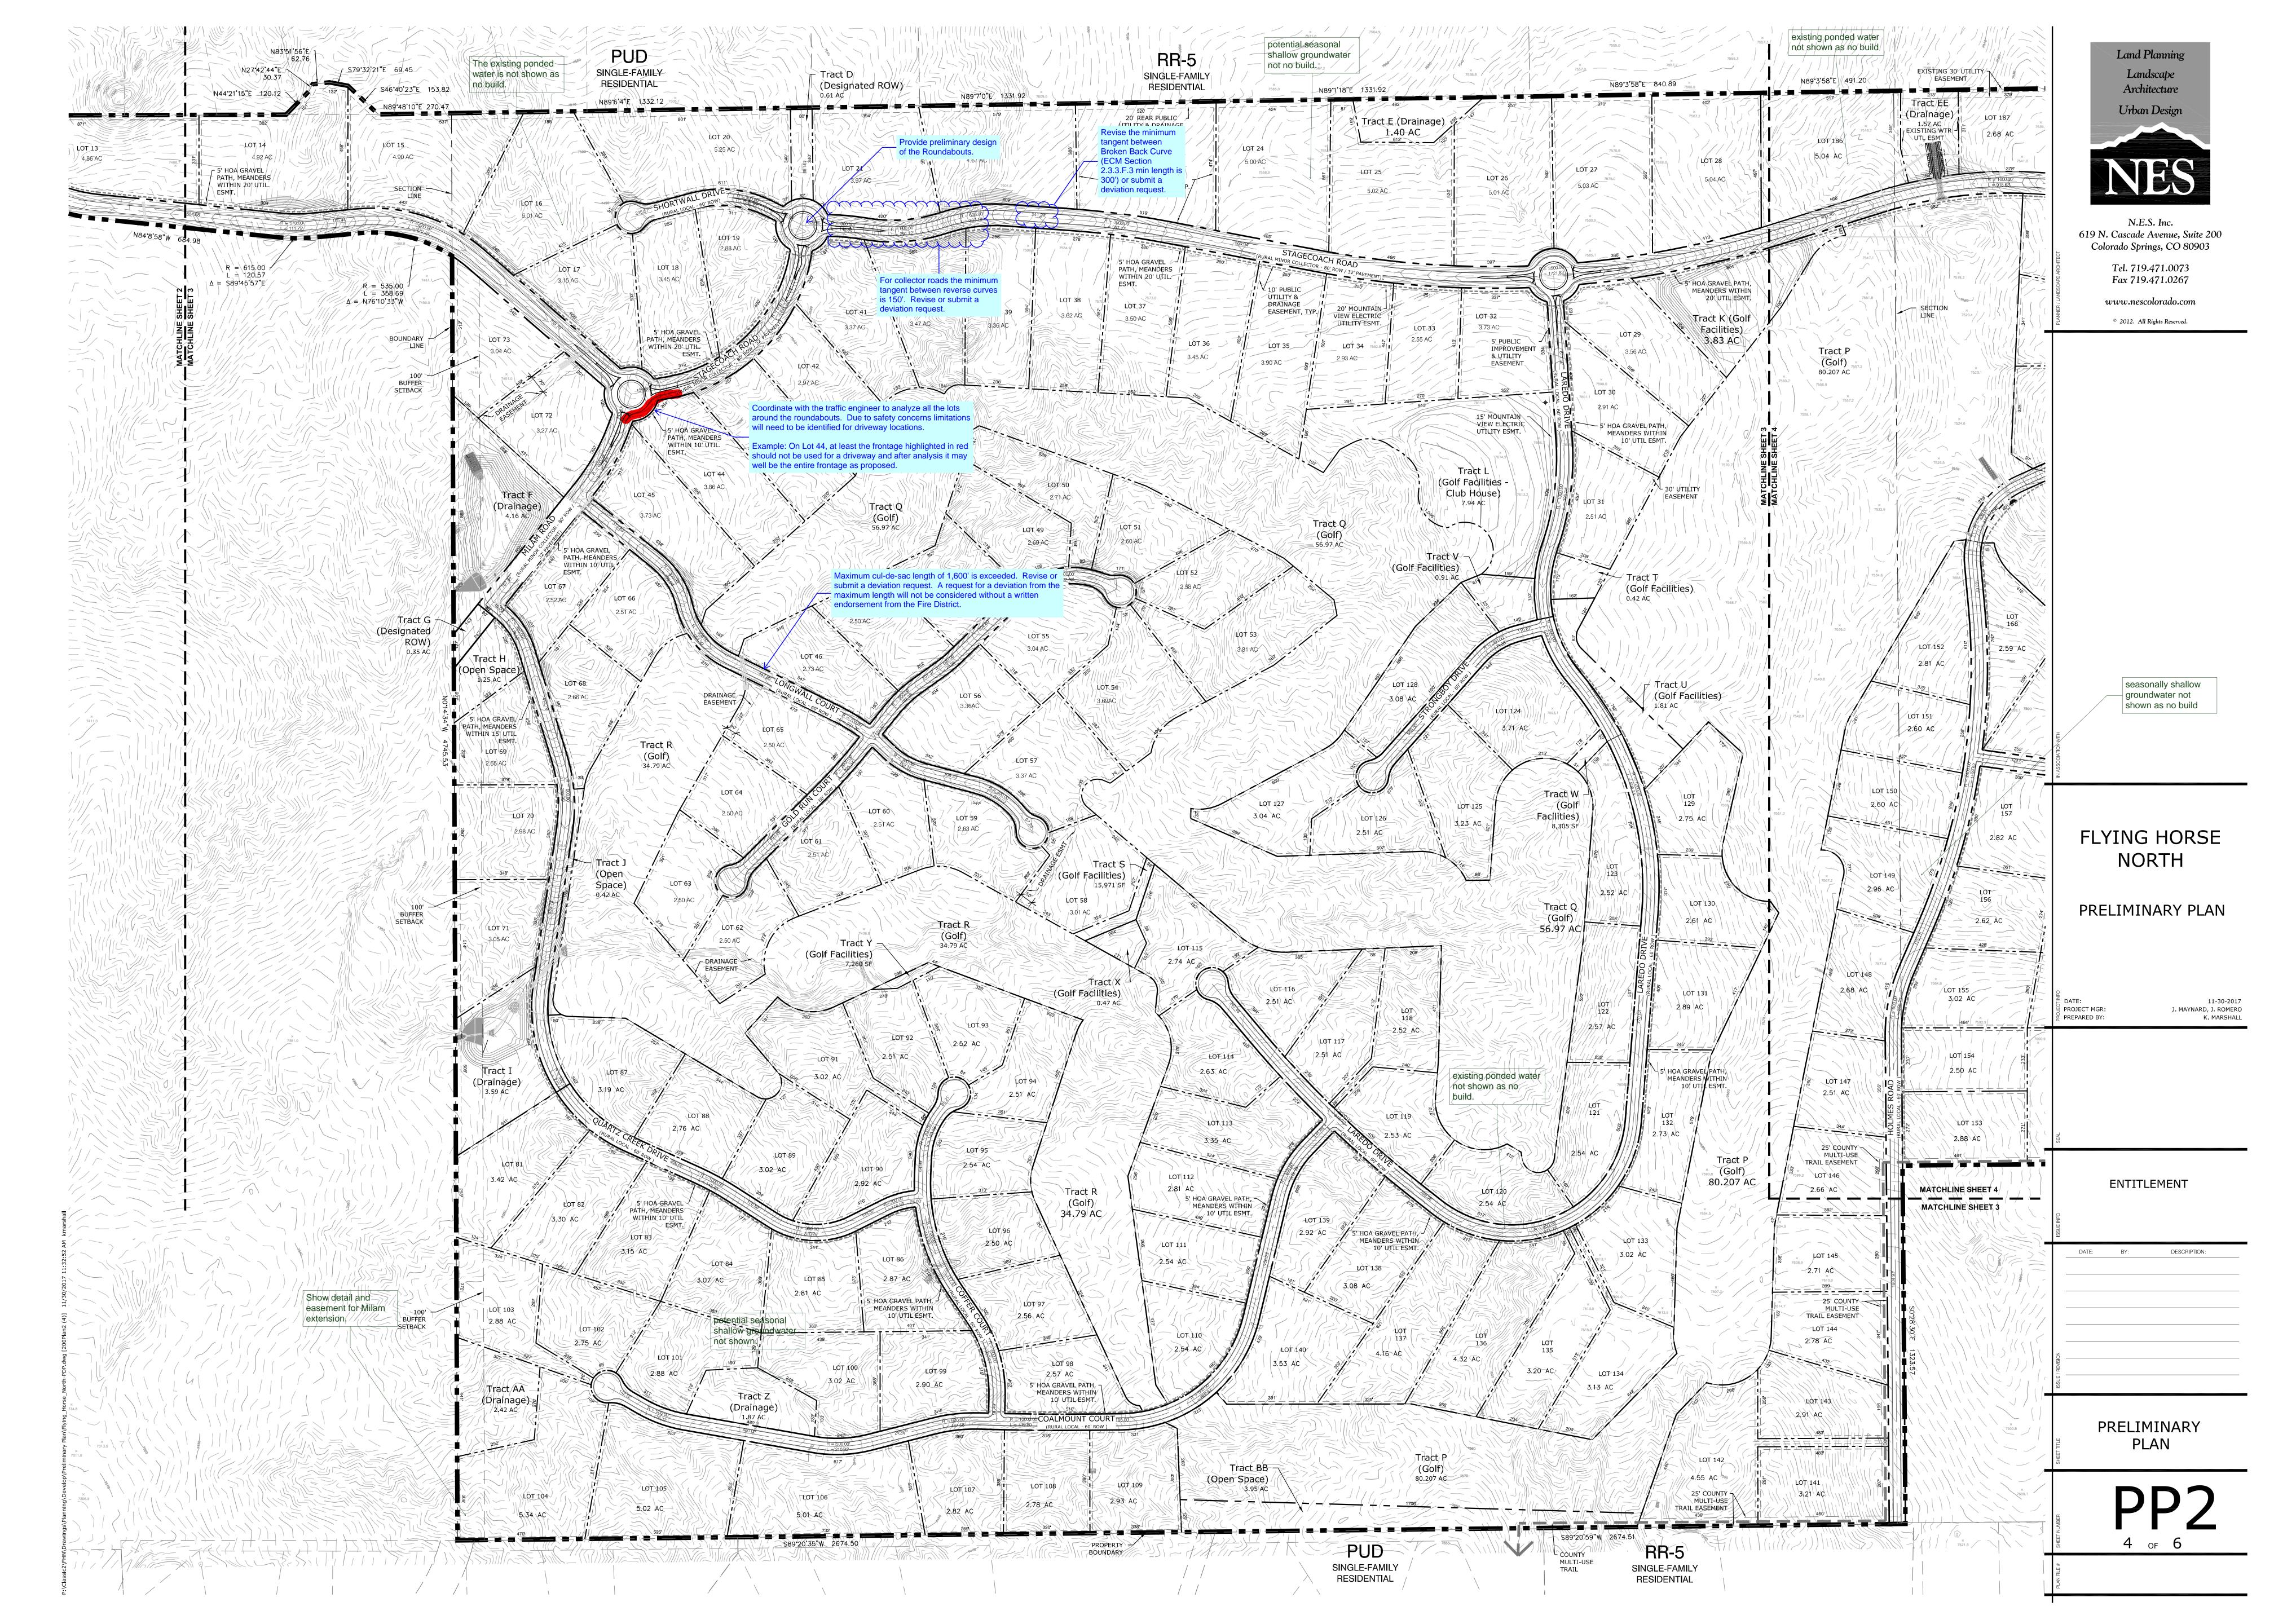

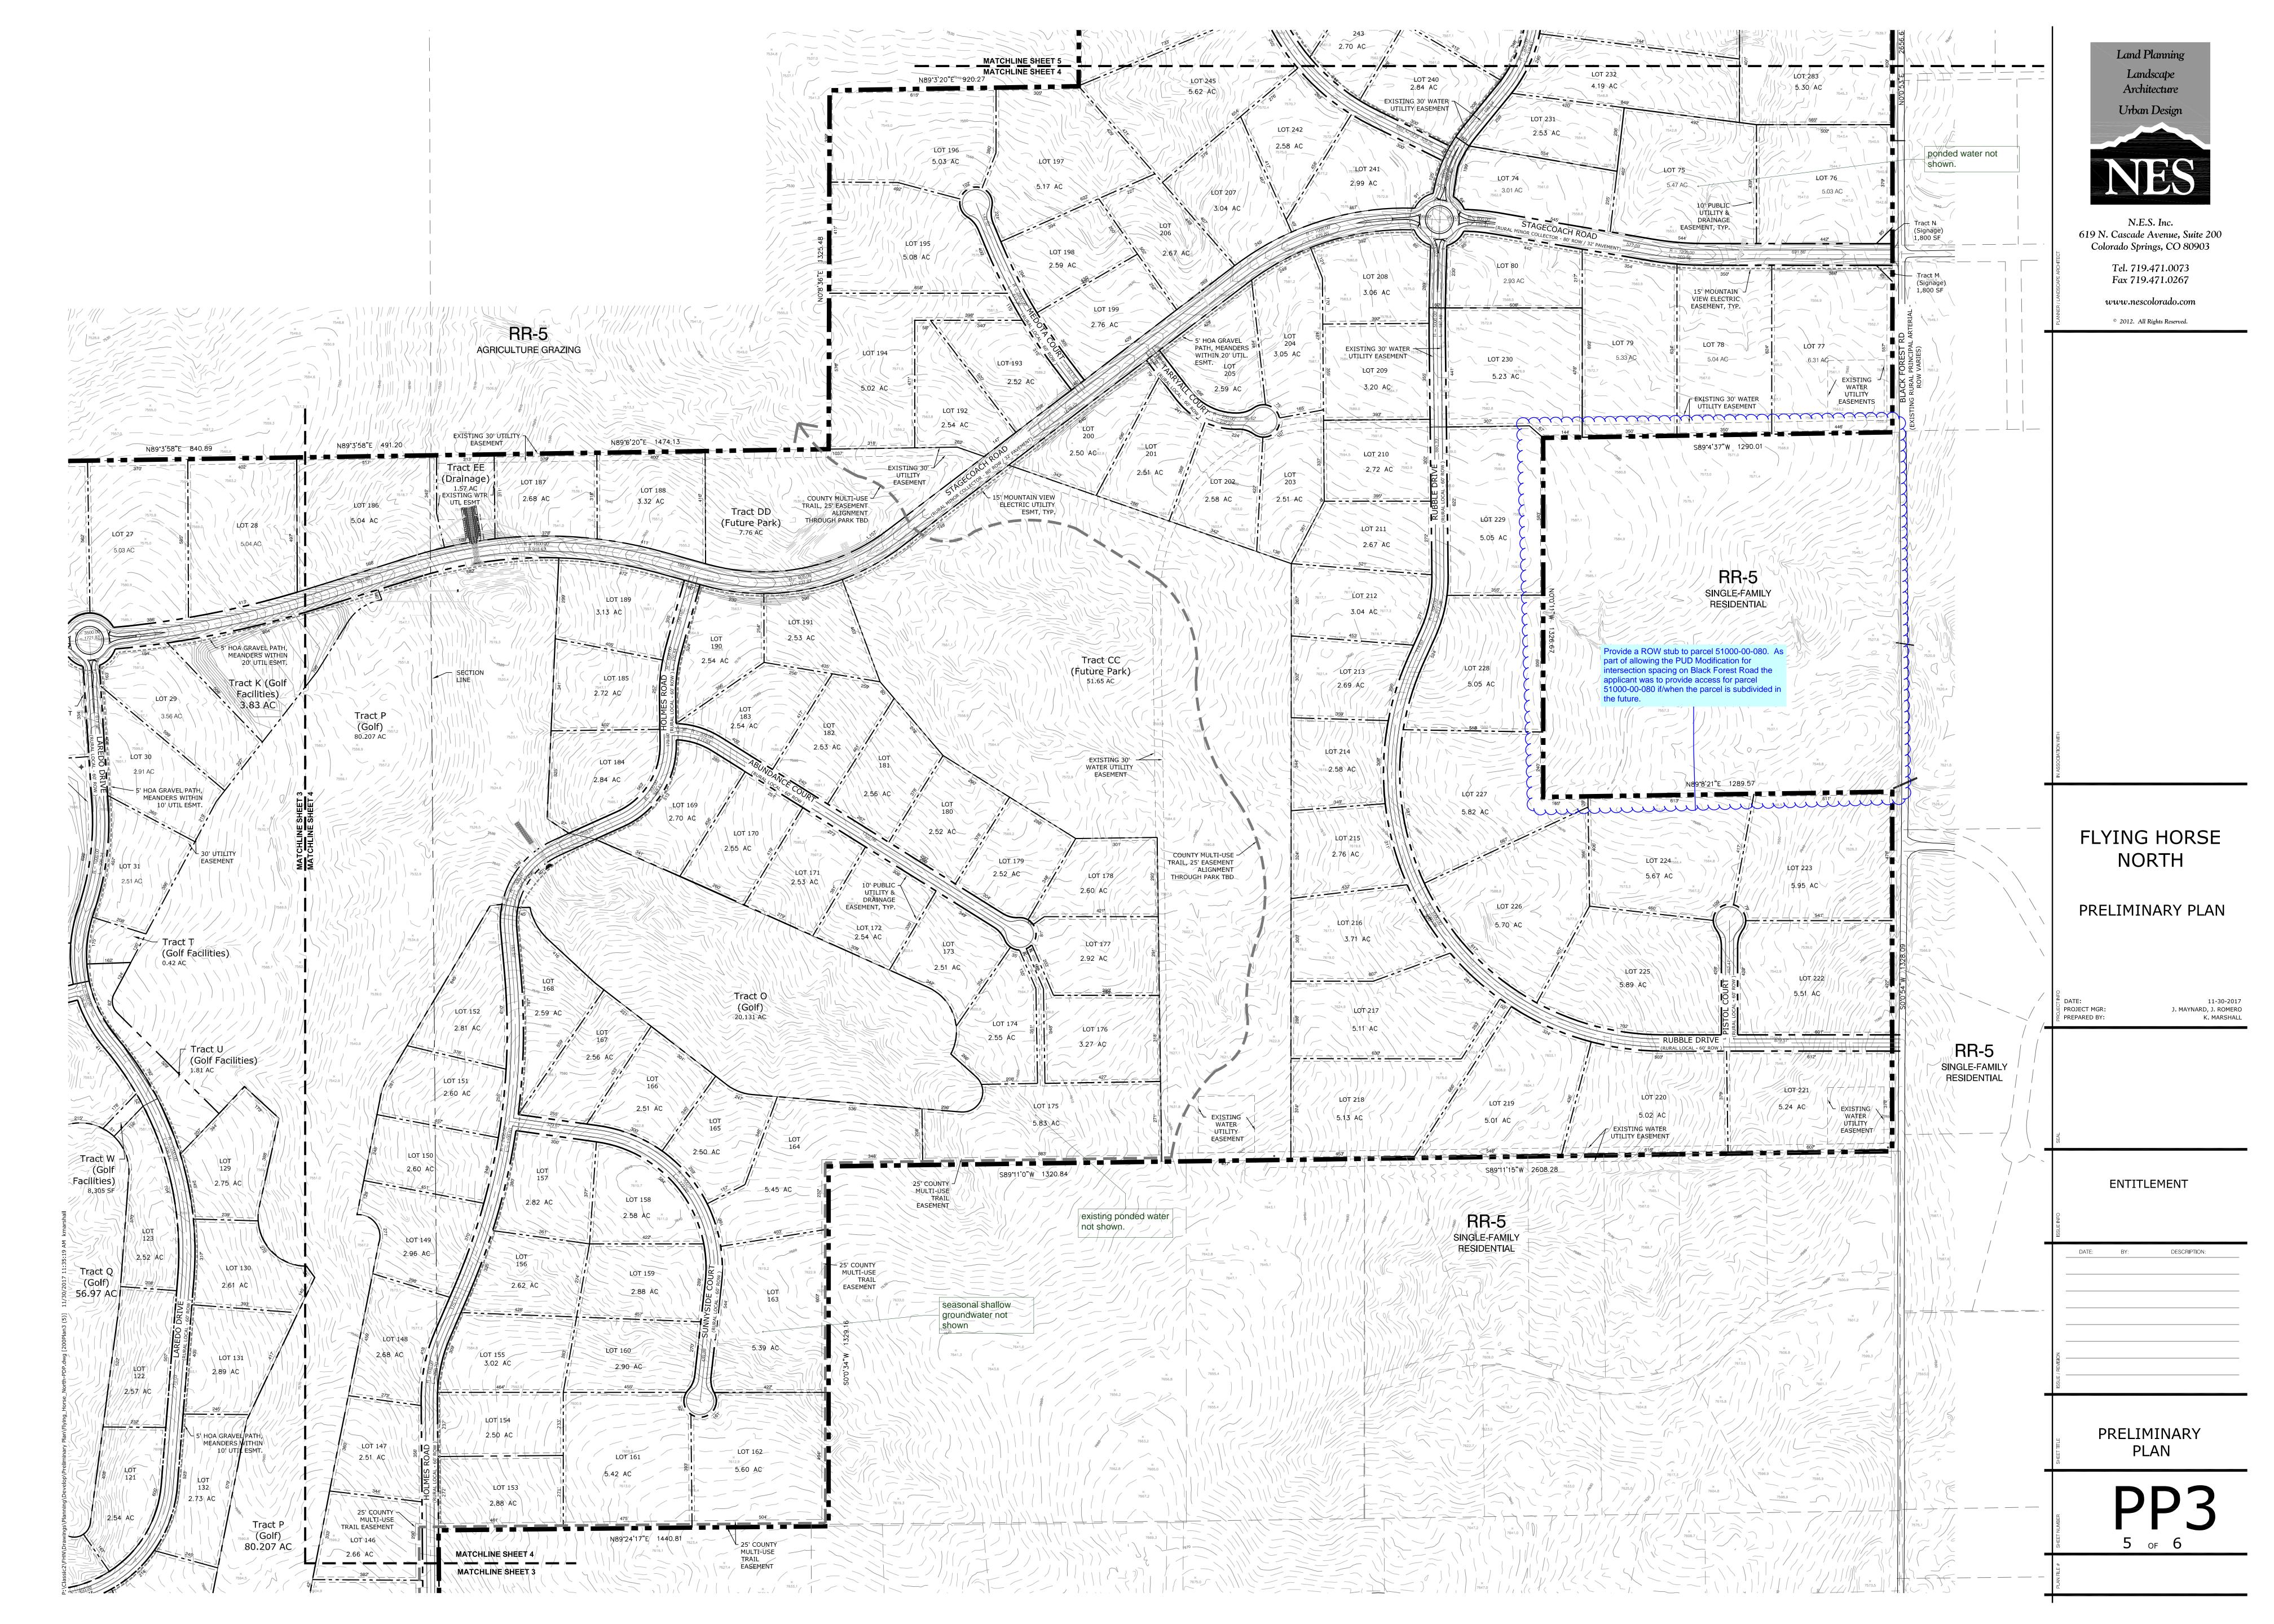

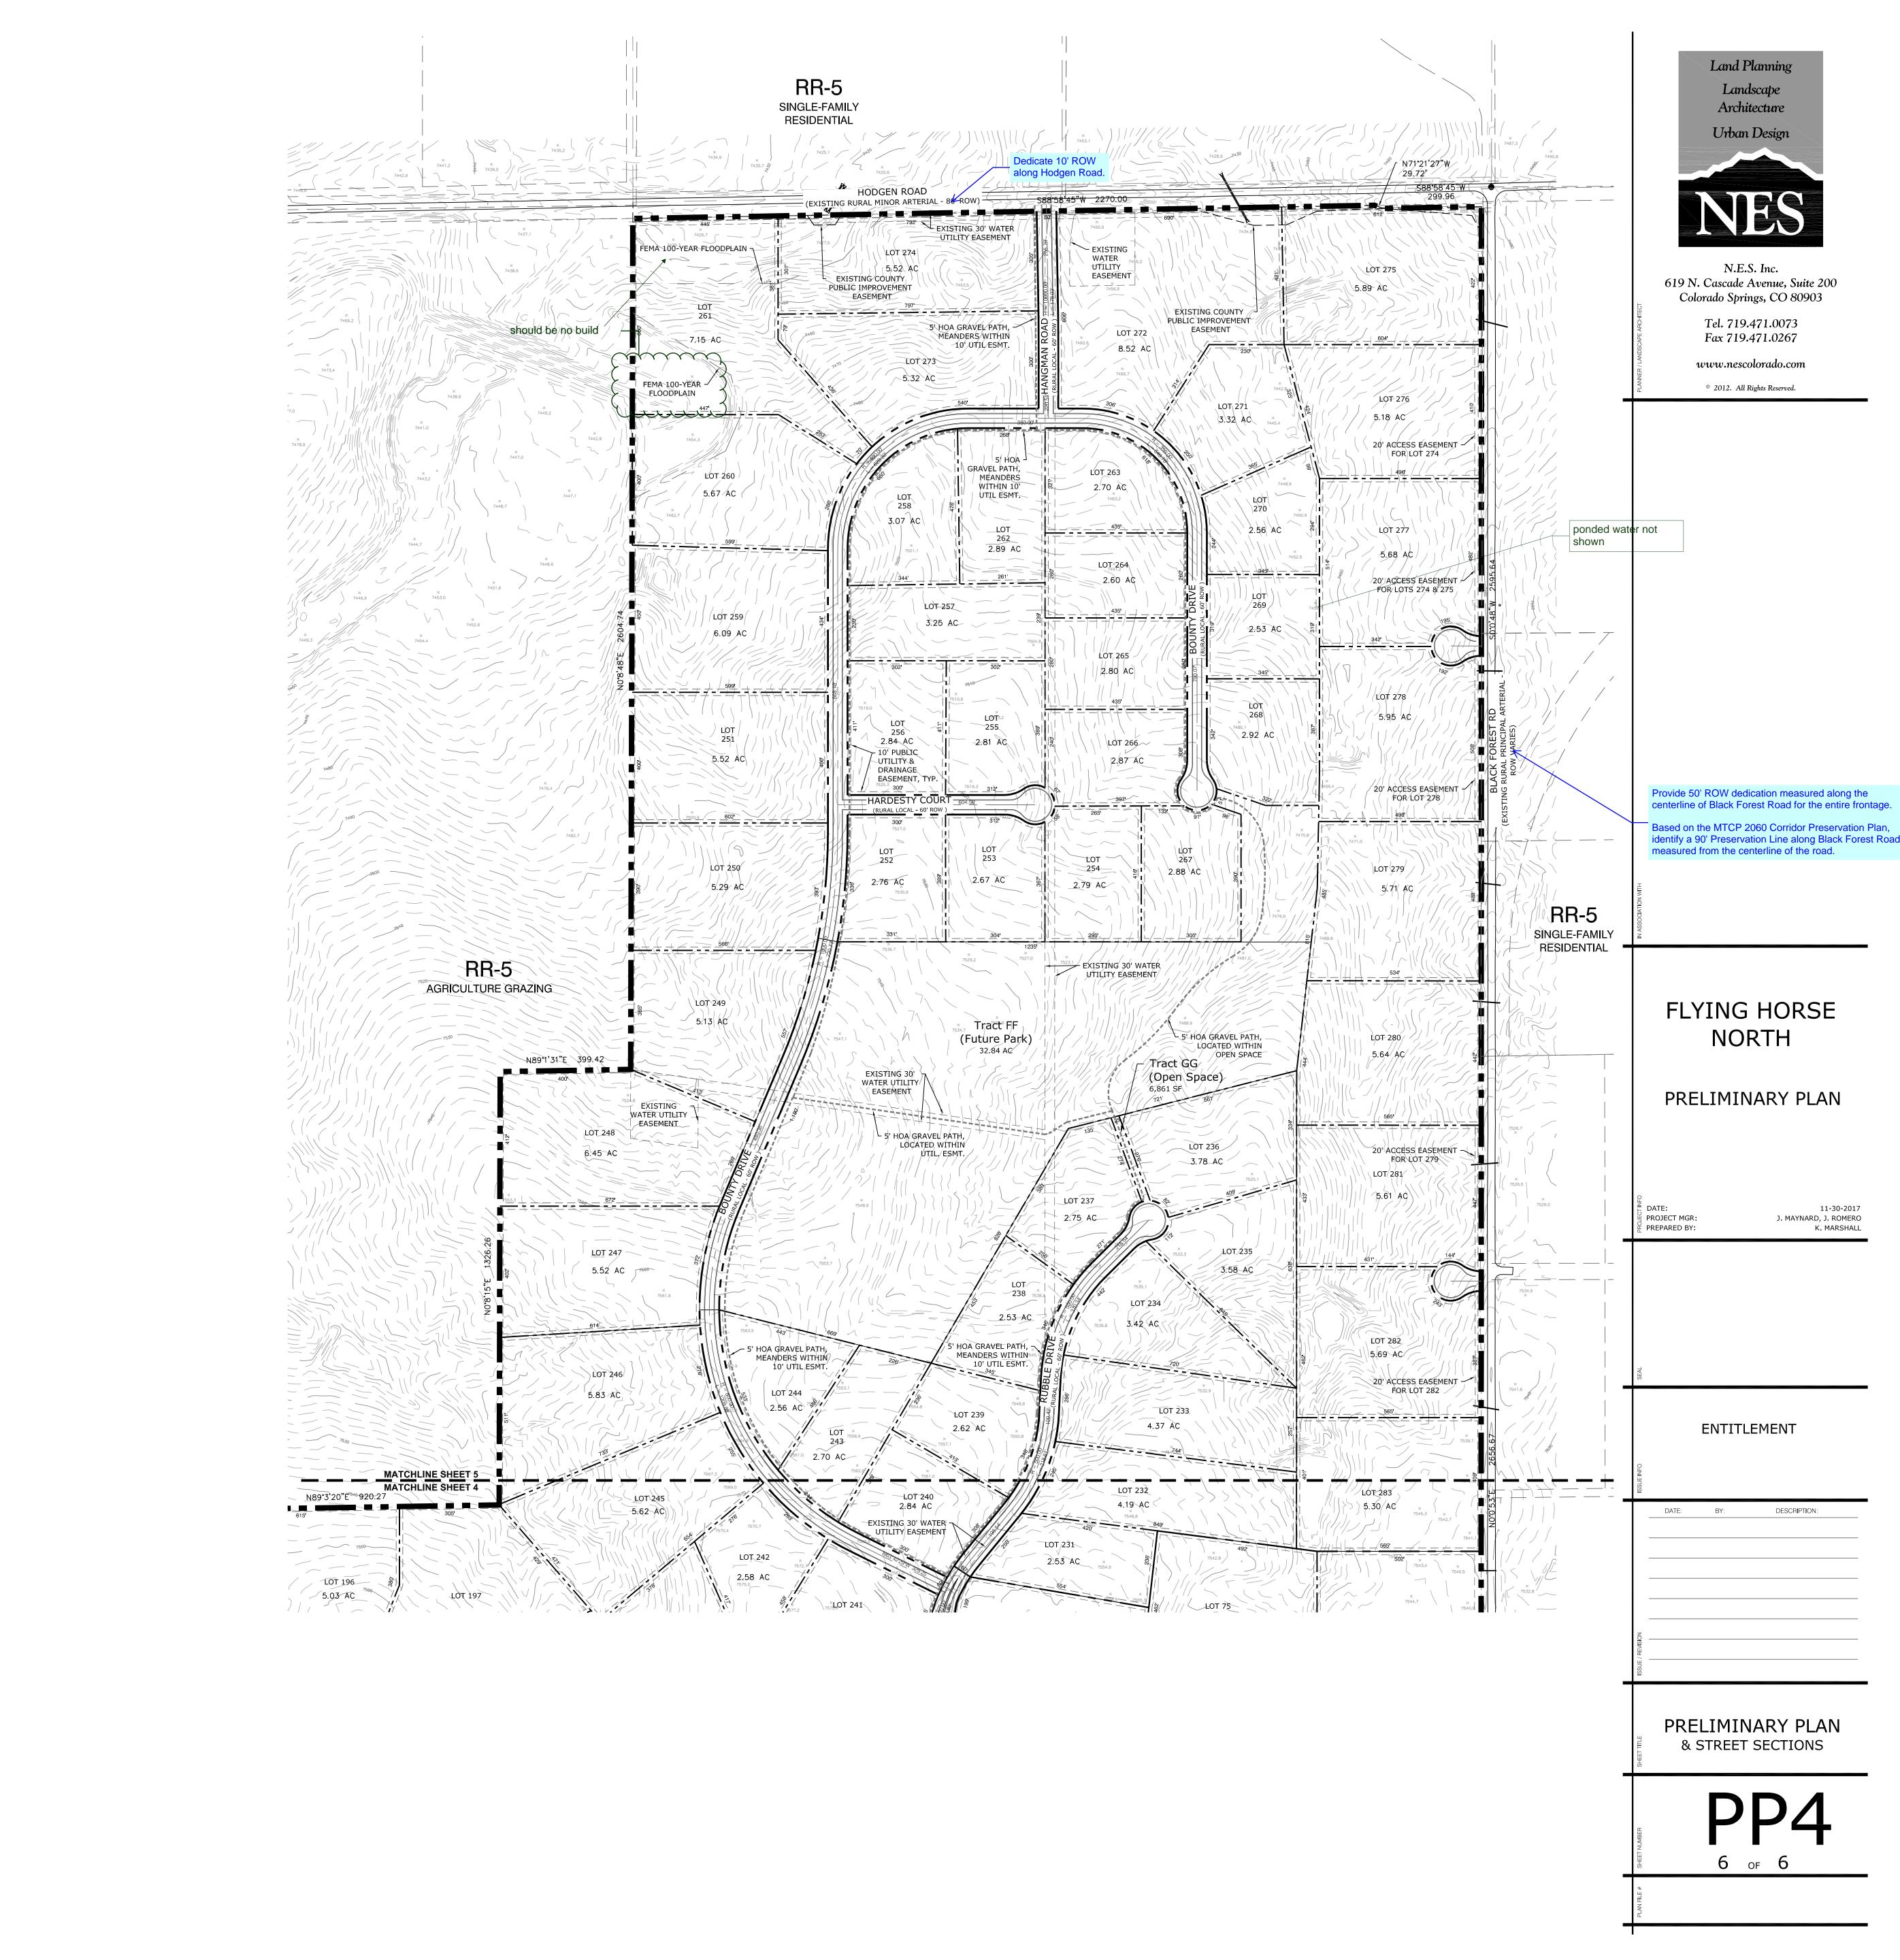

Markup Summary

Lock: Locked

Author: dsdlaforce

dsdlaforce (23)		
STREET SECTION	Subject: Cloud+ Page Label: FHN-PDP(1) Cover Lock: Locked Author: dsdlaforce	Revise the foreslope to 6:1 and 15' wide, and the backslope to 10' wide or submit a deviation request.
DAMES	Subject: Callout Page Label: FHN-PDP(1) Cover Lock: Locked Author: dsdlaforce	Show the aggregate base course for all cross section.
THE STATE OF THE S	Subject: Cloud+ Page Label: FHN-PDP(1) Cover Lock: Locked Author: dsdlaforce	Clarify on all cross section. Is this gravel?
OSS SECTION Are these gared traits? Clarly on all cross section.	Subject: Callout Page Label: FHN-PDP(1) Cover Lock: Locked Author: dsdlaforce	Are these gravel trails? Clarify on all cross section.
The state of	Subject: Text Box Page Label: FHN-PDP(1) Cover Lock: Locked Author: dsdlaforce	Add a note identifying the 6 lots allowed to have access to Stagecoach Rd and note the conditions for the access.
MAGEST IN A SECRET IN A SEC	Subject: Cloud+ Page Label: FHN-PDP(1) Cover Lock: Locked Author: dsdlaforce	Revise to 4:1 or submit a deviation request.
	Subject: Callout Page Label: FHN-PDP(1) Cover Lock: Locked Author: dsdlaforce	Clarify. North or South of what?
STREET SCILLAGE	Subject: Callout Page Label: FHN-PDP(1) Cover Lock: Locked Author: dsdlaforce	Identify the start/end of the Stagecoach Major Collector segment. Provide a cross section for the Stagecoarch Minor Collector and identify the start/end of the segment.
C. The well \$10.100 for \$1 per 5. March 19.100 for \$1 per 6. Account \$10 per order, but well-assumed and the discrete former and the second	Subject: Text Box Page Label: FHN-PDP(1) Cover	Add a note stating roundabout design are not final and may result in changes to lot sizes. These

and may result in changes to lot sizes. These

changes may be done administratively with the final plat. List out the specific lots.




Subject: Callout

Page Label: FHN-PDP(1) Cover

Lock: Locked
Author: dsdlaforce

Revise dimension label to "5' Public Improvements Easement Granted to El Paso County"

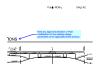

Subject: Callout

Page Label: FHN-PDP(1) Cover

Lock: Locked Author: dsdlaforce Note any approved deviation or PUD modification for the roadway design parameters of the

applicable street sections.



Subject: Callout

Page Label: FHN-PDP(2) Overall

Lock: Locked
Author: dsdlaforce

Identify the off-site improvements as part of phase



Subject: Callout

Page Label: FHN-PDP(2) Overall

Lock: Locked Author: dsdlaforce For clarity update the linetype setting or provide hatching. With the short segments of the polyline the linetype appears continuous which is a different geologic hazard in the legend.



Subject: Callout

Page Label: FHN-PDP(2) Overall

Lock: Locked
Author: dsdlaforce

Identify the off-site improvements as part of phase

3.



Subject: Callout

Page Label: FHN-PDP(4) PP2


Lock: Locked Author: dsdlaforce Provide preliminary design of the Roundabouts.



Subject: Highlight

Page Label: FHN-PDP(4) PP2

Lock: Locked Author: dsdlaforce

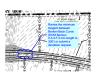

Subject: Cloud+

Page Label: FHN-PDP(4) PP2

Lock: Locked Author: dsdlaforce Revise the minimum tangent between Broken Back Curve (ECM Section 2.3.3.F.3 min length is 2001) or submit a deviction request.

300') or submit a deviation request.



Subject: Callout

Page Label: FHN-PDP(4) PP2

Lock: Locked
Author: dsdlaforce

Coordinate with the traffic engineer to analyze all the lots around the roundabouts. Due to safety concerns limitations will need to be identified for driveway locations.

Example: On Lot 44, at least the frontage highlighted in red should not be used for a driveway and after analysis it may well be the

entire frontage as proposed.




Subject: Callout

Page Label: FHN-PDP(4) PP2

Lock: Locked
Author: dsdlaforce

Maximum cul-de-sac length of 1,600' is exceeded. Revise or submit a deviation request. A request for a deviation from the maximum length will not be considered without a written endorsement from the Fire District.

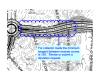

Subject: Cloud+

Page Label: FHN-PDP(4) PP2

Lock: Locked
Author: dsdlaforce

For collector roads the minimum tangent between reverse curves is 150'. Revise or submit a

deviation request.



Subject: Cloud+

Page Label: FHN-PDP(5) PP3

Lock: Locked Author: dsdlaforce Provide a ROW stub to parcel 51000-00-080. As part of allowing the PUD Modification for intersection spacing on Black Forest Road the applicant was to provide access for parcel 51000-00-080 if/when the parcel is subdivided in

the future.



Subject: Callout

Page Label: FHN-PDP(6) PP4

Lock: Locked
Author: dsdlaforce

Dedicate 10' ROW along Hodgen Road.



Subject: Callout

Page Label: FHN-PDP(6) PP4

Lock: Locked
Author: dsdlaforce

Provide 50' ROW dedication measured along the centerline of Black Forest Road for the entire frontage.

Based on the MTCP 2060 Corridor Preservation Plan, identify a 90' Preservation Line along Black Forest Road measured from the centerline of the road.

dsdruiz (25)



Subject: Cloud+

Page Label: FHN-PDP(1) Cover

Lock: Locked Author: dsdruiz All phases have been identified on the phasing plan above. All tracts should be included for each phase.



Subject: Text Box

Page Label: FHN-PDP(1) Cover

Lock: Locked Author: dsdruiz PCD File # SP-17-012

Please review the preliminary plan drawing

Subject: Text Box

Page Label: FHN-PDP(1) Cover

Lock: Locked Author: dsdruiz

Please review the preliminary plan drawing checklist attached and add all missing items.



Subject: Cloud+

Page Label: FHN-PDP(1) Cover

Lock: Locked Author: dsdruiz Reference the recorded PUD as well (217032585)



Subject: Callout

Page Label: FHN-PDP(1) Cover

Lock: Locked Author: dsdruiz extra line



Subject: Callout

Page Label: FHN-PDP(1) Cover

Lock: Locked Author: dsdruiz Please include the acreage and number of units for each phase.



Subject: Callout

Page Label: FHN-PDP(1) Cover

Lock: Locked Author: dsdruiz The PUD shows 2 lots here.



Subject: Callout

Page Label: FHN-PDP(2) Overall

Lock: Locked Author: dsdruiz Please identify the off site improvements as required by the CDOT access permit. These improvements should also be included in the letter

of intent.



Subject: Cloud+

Page Label: FHN-PDP(2) Overall

Lock: Locked Author: dsdruiz this gets lost in the other dimensions.



Subject: Callout

Page Label: FHN-PDP(3) PP1

Lock: Locked
Author: dsdruiz

This is an offsite improvement. You will need to provide proof of an easement for this improvement and reference it on the preliminary plan and final

plat.



Subject: Cloud+

Page Label: FHN-PDP(3) PP1

Lock: Locked Author: dsdruiz consider putting all trails w/in a tract. This removes liability from the owner and allows for maintenance

by one entity.



Subject: Callout

Page Label: FHN-PDP(3) PP1

Lock: Locked Author: dsdruiz tract c



Subject: Callout

Page Label: FHN-PDP(4) PP2

Lock: Locked Author: dsdruiz potential seasonal shallow groundwater not shown.



Subject: Callout

Page Label: FHN-PDP(4) PP2

Lock: Locked **Author:** dsdruiz

The existing ponded water is not shown as no build.



Subject: Callout

Page Label: FHN-PDP(4) PP2

Lock: Locked Author: dsdruiz potential seasonal shallow groundwater not no build.



Subject: Callout

Page Label: FHN-PDP(4) PP2

Lock: Locked Author: dsdruiz existing ponded water not shown as no build.



Subject: Callout

Page Label: FHN-PDP(4) PP2

Lock: Locked Author: dsdruiz existing ponded water not shown as no build



Subject: Callout

Page Label: FHN-PDP(4) PP2

Lock: Locked Author: dsdruiz seasonally shallow groundwater not shown as no

build


.....



Subject: Callout

Page Label: FHN-PDP(4) PP2

Lock: Locked Author: dsdruiz Show detail and easement for Milam extension.

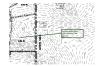

Subject: Callout

Page Label: FHN-PDP(5) PP3

Lock: Locked
Author: dsdruiz

seasonal shallow groundwater not shown



Subject: Callout

Page Label: FHN-PDP(5) PP3

Lock: Locked Author: dsdruiz existing ponded water not shown.



Subject: Callout

Page Label: FHN-PDP(5) PP3

Lock: Locked Author: dsdruiz ponded water not shown.



Subject: Callout

Page Label: FHN-PDP(6) PP4

Lock: Locked Author: dsdruiz

ponded water not shown



Subject: Cloud+

Page Label: FHN-PDP(6) PP4

Lock: Locked
Author: dsdruiz

should be no build



Subject: Arrow

Page Label: FHN-PDP(6) PP4

Lock: Locked Author: dsdruiz