

1

7015 1520 0001 5953 4125

U.S. Postal Service™
CERTIFIED MAIL® RECEIPT
 Domestic Mail Only

For delivery information, visit our website at www.usps.com®.

PALMER LAKE CO 80133

Certified Mail Fee	\$3.35
Extra Services & Fees (check box, add fee as appropriate)	\$0.00
<input type="checkbox"/> Return Receipt (hardcopy)	\$0.00
<input type="checkbox"/> Return Receipt (electronic)	\$0.00
<input type="checkbox"/> Certified Mail Restricted Delivery	\$0.00
<input type="checkbox"/> Adult Signature Required	\$0.00
<input type="checkbox"/> Adult Signature Restricted Delivery	\$0.00
Postage	\$0.49
Total Postage and Fees	\$3.84

Sent To: **Sidney Shoemaker**
 Street and Apt. No., or PO Box No.: **12625 Rockbrook Rd.**
 City, State, ZIP+4®: **Palma lake Co 80133**

PS Form 3800, April 2015 PSN 7530-02-000-9047 See Reverse for Instructions

A copy of the letter sent to the adjacent neighbors is required, and parcel 7109014003 will need to be notified as you are in a cul-de-sac.

4

7015 1520 0001 5953 4144

U.S. Postal Service™
CERTIFIED MAIL® RECEIPT
 Domestic Mail Only

For delivery information, visit our website at www.usps.com®.

APD AE 09751

Certified Mail Fee	\$3.35
Extra Services & Fees (check box, add fee as appropriate)	\$0.00
<input type="checkbox"/> Return Receipt (hardcopy)	\$0.00
<input type="checkbox"/> Return Receipt (electronic)	\$0.00
<input type="checkbox"/> Certified Mail Restricted Delivery	\$0.00
<input type="checkbox"/> Adult Signature Required	\$0.00
<input type="checkbox"/> Adult Signature Restricted Delivery	\$0.00
Postage	\$0.49
Total Postage and Fees	\$3.84

Sent To: **Michael & Pilalac Sturgeon**
 Street and Apt. No., or PO Box No.: **CME 489 Box 1450**
 City, State, ZIP+4®: **APD AE 09751-0015**

PS Form 3800, April 2015 PSN 7530-02-000-9047 See Reverse for Instructions

2

7015 1520 0001 5953 4132

U.S. Postal Service™
CERTIFIED MAIL® RECEIPT
 Domestic Mail Only

For delivery information, visit our website at www.usps.com®.

PALMER LAKE CO 80133

Certified Mail Fee	\$3.35
Extra Services & Fees (check box, add fee as appropriate)	\$0.00
<input type="checkbox"/> Return Receipt (hardcopy)	\$0.00
<input type="checkbox"/> Return Receipt (electronic)	\$0.00
<input type="checkbox"/> Certified Mail Restricted Delivery	\$0.00
<input type="checkbox"/> Adult Signature Required	\$0.00
<input type="checkbox"/> Adult Signature Restricted Delivery	\$0.00
Postage	\$0.49
Total Postage and Fees	\$3.84

Sent To: **Ronald & Michelle Reser**
 Street and Apt. No., or PO Box No.: **P O Box 1643**
 City, State, ZIP+4®: **Palma lake Co 80133**

PS Form 3800, April 2015 PSN 7530-02-000-9047 See Reverse for Instructions

3

7015 1520 0001 5953 4118

U.S. Postal Service™
CERTIFIED MAIL® RECEIPT
 Domestic Mail Only

For delivery information, visit our website at www.usps.com®.

MONUMENT CO 80132

Certified Mail Fee	\$3.35
Extra Services & Fees (check box, add fee as appropriate)	\$0.00
<input type="checkbox"/> Return Receipt (hardcopy)	\$0.00
<input type="checkbox"/> Return Receipt (electronic)	\$0.00
<input type="checkbox"/> Certified Mail Restricted Delivery	\$0.00
<input type="checkbox"/> Adult Signature Required	\$0.00
<input type="checkbox"/> Adult Signature Restricted Delivery	\$0.00
Postage	\$0.49
Total Postage and Fees	\$3.84

Sent To: **Trudence Pevins**
 Street and Apt. No., or PO Box No.: **PO Box 3033**
 City, State, ZIP+4®: **Monument Co 80132-3033**

PS Form 3800, April 2015 PSN 7530-02-000-9047 See Reverse for Instructions

7015 1520 0001 5953 4156

U.S. Postal Service™
CERTIFIED MAIL® RECEIPT
 Domestic Mail Only

For delivery information, visit our website at www.usps.com®.

PALMER LAKE CO 80133

Certified Mail Fee	\$3.35
Extra Services & Fees (check box, add fee as appropriate)	\$0.00
<input type="checkbox"/> Return Receipt (hardcopy)	\$0.00
<input type="checkbox"/> Return Receipt (electronic)	\$0.00
<input type="checkbox"/> Certified Mail Restricted Delivery	\$0.00
<input type="checkbox"/> Adult Signature Required	\$0.00
<input type="checkbox"/> Adult Signature Restricted Delivery	\$0.00
Postage	\$0.49
Total Postage and Fees	\$3.84

Sent To: **Matthew Ruggles & Janet Delgado**
 Street and Apt. No., or PO Box No.: **18715 Rockbrook Rd**
 City, State, ZIP+4®: **Palma lake Co 80133**

PS Form 3800, April 2015 PSN 7530-02-000-9047 See Reverse for Instructions

5

El Paso County Assessor's Office


0 09-11-67

SCHEDULE: 7109000053

OWNER: YARBROUGH AMY M

YARBROUGH RICHARD D

COPYRIGHT 2010 by the Board of County Commissioners, El Paso County, Colorado. All rights reserved. No part of this document or data contained hereon may be reproduced, used to prepare derivative products, or distributed without the specific written approval of the Board of County Commissioners, El Paso County, Colorado. This document was prepared from the best data available at the time of plotting and is for internal use only. El Paso County, Colorado, makes no claim as to the completeness or accuracy of the data contained hereon.

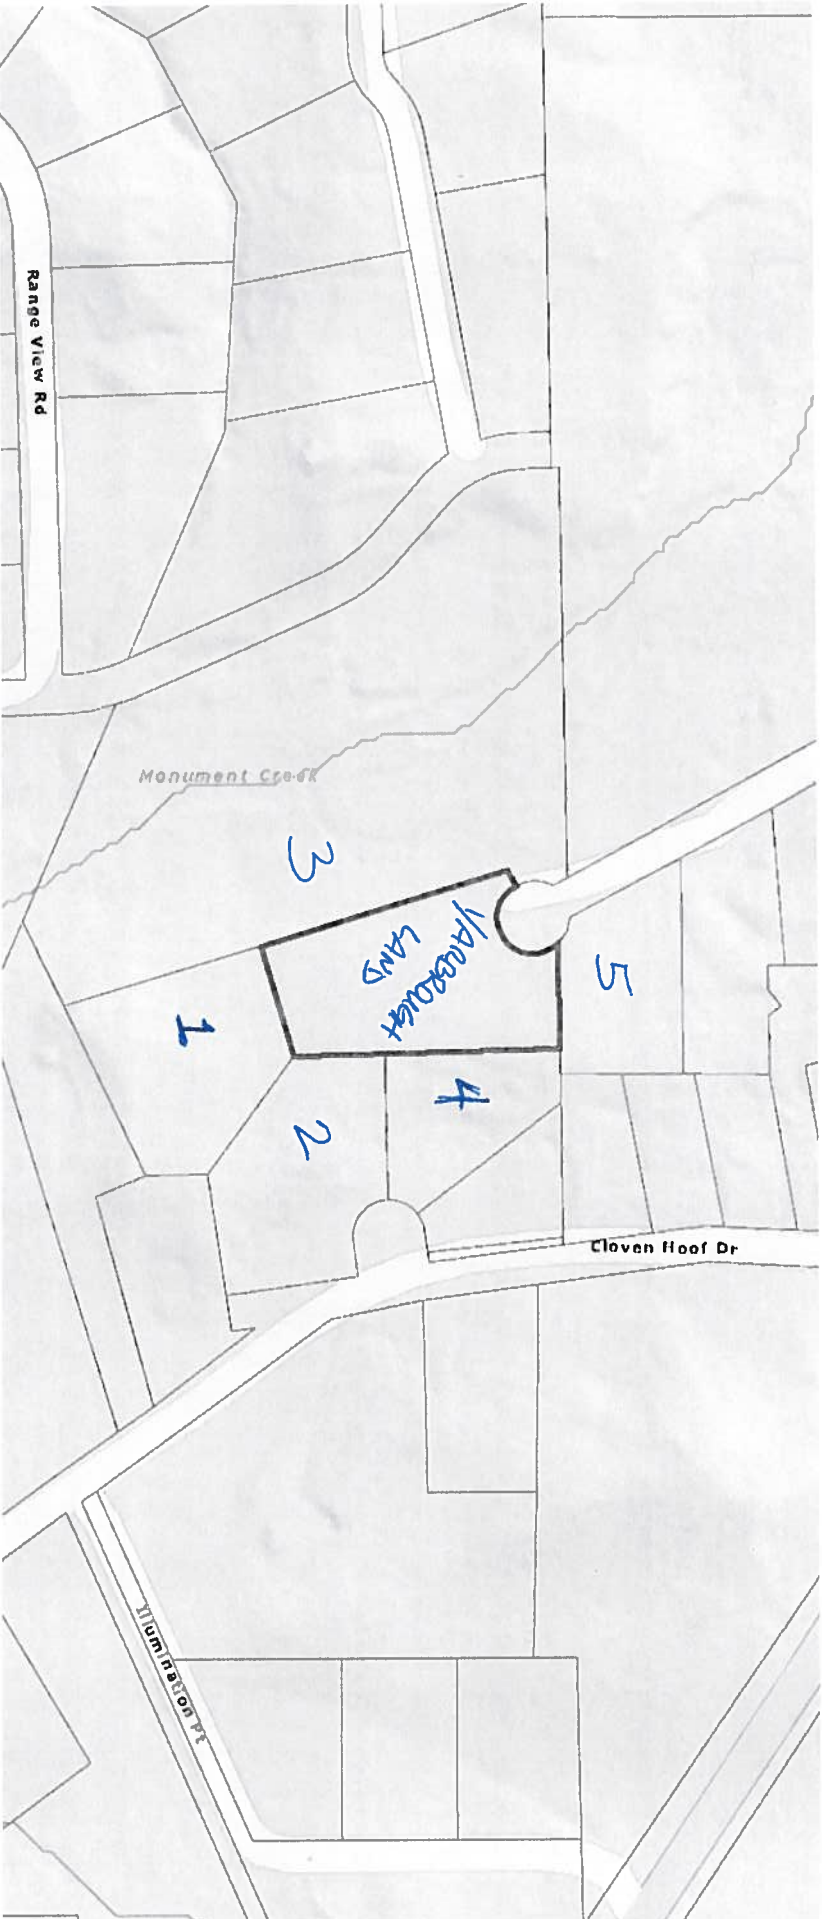

Markup Summary

Locked (1)

A copy of the letter sent to the adjacent neighbors is required, and parcel 7109014003 will need to be notified as you are in a cul-de-sac.

Subject: Text Box
Page Label: 1
Lock: Locked
Status:
Checkmark: Unchecked
Author: dsdsevigny
Date: 3/15/2018 9:15:58 AM
Color: ■

A copy of the letter sent to the adjacent neighbors is required, and parcel 7109014003 will need to be notified as you are in a cul-de-sac.