

FINAL
DRAINAGE PLAN AND REPORT

**8140 and 8150
CESSNA DRIVE**

**PROPOSED AIRPORT HANGER
LOT 7 BLOCK 1
MEADOW LAKE AIRPORT
FILING NO. 2**

County Fil No.: PPR2138

July 9, 2021

Revised
November 10, 2021

Prepared for

RYAN SCHNEIDER

Oliver E. Watts, Consulting Engineer, Inc.
Colorado Springs, Colorado

OLIVER E. WATTS, PE-LS
OLIVER E. WATTS, CONSULTING ENGINEER, INC.
CIVIL ENGINEERING AND SURVEYING
614 ELKTON DRIVE
COLORADO SPRINGS, COLORADO 80907
(719) 593-0173
fax (719) 265-9660
olliewatts@aol.com
Celebrating over 42 years in business

November 10, 2021

El Paso County Planning and Community Development
2880 International Circle
Colorado Springs, CO 80910

ATTN: *Jennifer Irvine, P.E.*

SUBJECT: Final Drainage Plan and Report
Building at 8140 and 8150 Cessna Drive

Transmitted herewith for your review and approval is the drainage plan and report for the proposed 8140 and 8150 Cessna Drive in El Paso County. This report will accompany the development plan submittal. It has been revised per the County review of 9-21-22 and our clarification meeting with County staff on 10-6-21.

Please contact me if I may provide any further information.

Oliver E. Watts, Consulting Engineer, Inc.

BY: _____
Oliver E. Watts, President

Encl:

Drainage Report 4 pages
Computations, 8 Pages
FEMA Panel No. 08041C0554 G
SCS Soils Map and Interpretation Sheet
Backup Information, 6 sheets
Existing Conditions Drainage Map, Dwg 20-5498-04
Drainage Plan, Dwg 20-5498-05

Table of Contents

1. Cover
2. Transmittal Letter
3. Table of Contents
4. Signatures / approvals page
5. Drainage Report 8 pages
6. Vicinity Map
7. Computations, 8 pages
8. FEMA Panels No. 08041C0554 G
9. SCS Soils Map and Interpretation Sheet, 2 pages
10. Backup Information, 5 pages
11. Drainage Plan, Existing Conditions Dwg 20-5498-04
12. Drainage Plan, Proposed Conditions Dwg 20-5498-07

1. ENGINEER'S STATEMENT:

The attached drainage plan and report were prepared under my direction and supervision and are correct to the best of my knowledge and belief. Said drainage report has been prepared according to the criteria established by the County for drainage reports and said report is in conformity with the applicable master plan of the drainage basin. I accept responsibility for any liability caused by any negligent acts, errors or omissions on my part in preparing this report.

Oliver E. Watts, Consulting Engineer, Inc.

Oliver E. Watts Colo. PE-LS No. 9853 date

2. OWNERS / DEVELOPER'S STATEMENT:

I the owner / developer have read and will comply with all of the requirements specified in this drainage report and plan.

Ryan Schneider

By: _____
2610 Fairmont Street
Colorado Springs, CO 80909

EL PASO COUNTY:

Filed in accordance with the requirements of the El Paso Land Development Code, Drainage Criteria Manual Volumes 1 and 2, and the Engineering Criteria Manual, as amended.

Jennifer Irvine, P.E., date
County Engineer / ECM Administrator

Conditions:

4. LOCATION AND DESCRIPTION:

The proposed building is located at 8140 and 8150 Cessna Drive. The legal description is Lot 7, Block 1, Meadow Lake Airport Filing No. 2; being in Section 4, Township 13 South, Range 64 West of the 6th P.M., in El Paso County. The site is 3.262 acres total. It is proposed that an airport hanger, along with parking lot and sidewalks be constructed on the east portion of the property. Approximately 2.292 acres of the site will undergo construction, excavation and grading. The details of the proposal are shown on the enclosed drainage plan. Parking area, driveway and sidewalks will be asphalt, and the remaining area outside the building will be landscaped. The property is in the Sand Creek drainage basin. The lot is currently undeveloped in a range land condition; approximately 85% of the lot is covered with native grasses.

5. FLOOD PLAIN STATEMENT:

This subdivision is not within the limits of a flood plain or flood hazard area, according to FEMA map panel number 08041C0554 G, dated December 7, 2018, a copy of which is enclosed for reference.

6. METHOD AND CRITERIA:

The method used for all computations is that specified in the City-County Drainage Criteria Manual, using the rational method for areas of the size of the development. All computations are enclosed for reference and review.

The soils in the subdivision have been mapped by the local USDA/SCS office, and a soils map and interpretation sheet are enclosed for reference. All soils in this area are of the Perrypark complex, being in hydrologic group "B".

7. DESCRIPTION OF RUNOFF:

EXISTING DRAINAGE CONDITIONS

The site is located as shown on the enclosed drainage plans in the Meadow Lake Airport of El Paso County. The natural basin consists of basins A through C on the enclosed existing drainage conditions map that discharges 0.57 cfs (5-year runoff) / 4.12 cfs (100-year runoff) historically, as shown on the existing conditions drainage plan. No offsite basins runoff into this development.

PROPOSED DRAINAGE CONDITIONS

The area will be graded to conform to the existing topography shown on the drainage plan, routing all runoff into a lot area at the southeast portion of the construction site. No clearing will be necessary within the construction site.

Runoff will be routed southeasterly along airport taxiways to a northerly taxiway where storm sewers will pick up the runoff from respective basins and direct it to the proposed full spectrum detention pond located in the southeast corner of the lot, in accordance with County criteria, since the total disturbed area is over 1 acre. The total runoff into the pond will be 2.9 cfs / 7.7 cfs. As shown on the enclosed computation sheet the 100 year storage required is 0.248 acre feet, which occurs at a depth of 4.13'.

Runoff is directed (sheet flow) by grading down the traffic runways to the storm sewer shown on

the drainage plan and routed to the detention pond.

The outfall storm sewer will be routed to the existing drainage channel along side of the main entry taxiway as shown on the enclosed drainage plan, considered the suitable outfall for the site. 228.16 LF of 12" PVC is proposed for an outfall storm sewer, discharging into the existing channel along Cessna Drive.

FOUR STEP PROCESS

The following process has been followed to minimize adverse impacts of urbanization

Step1 Employ Runoff Reduction Practices – The extent of impervious materials is minimized consistent with the objectives of the facility. No curb and gutter or other items that might concentrate runoff are proposed. Standard BMP's are provided as shown on the grading and erosion control plan; Vehicle tracking control, stockpile and staging area protection, and a concrete washout basin. Silt fence is not used as requested by the Airport, as it is considered a hazard to taxiing aircraft – instead drainage berms and swales are used as indicated by the finish topography and identified on the erosion control plan.

Step 1: Employ Runoff Reduction Practices

To reduce runoff peaks and volumes from urbanizing areas, employ a practice generally termed "minimizing directly connected impervious areas" (MDCIA). The principal behind MDCIA is twofold -- to reduce impervious areas and to route runoff from impervious surfaces over grassy areas to slow down runoff and promote infiltration. The benefits are less runoff, less stormwater pollution, and less cost for drainage infrastructure. There are several approaches to reduce the effective imperviousness of a development site:

Reduced Pavement Area

Sometimes, creative site layout can reduce the extent of paved areas including parking, thereby saving on initial capital cost of pavement and then saving on pavement maintenance, repair, and replacement over time.

Grass Swales

The use of grass swales instead of storm sewers slows down runoff, promotes infiltration, and also reducing effective imperviousness. It also may reduce the size and cost of downstream storm sewers and detention.

Implementing these approaches on a new development site is discussed further in the DCM2 section titled Employing Runoff Reduction Techniques. This section provides a procedure for estimating a reduced imperviousness based on the use of grass buffers and swales. The latter three of the approaches for reducing imperviousness are structural BMPs and are described in detail in Section 4.2 of DCM2 (New Development BMP Fact sheets):

Grass Buffer.

Grass Swale.

Modular Block Porous Pavement (or Stabilized-Grass Porous Pavement).

Step 2 Stabilize Drainageways – The development of this project does not create Drainageways

and is not anticipated to have any negative effects on downstream Drainageways. Grass swales along the north and south sides of the building are minimized and slopes are minimized, and they will outfall onto the proposed parking lot which will direct the flows to inlets and eventually the detention pond. Runoff across the asphalt pavement will not be concentrated along the said swales.

Step 2: Stabilize Drainageways

Drainageway, natural and manmade, erosion can be a major source of sediment and associated constituents, such as phosphorus. Natural Drainageways are often subject to bed and bank erosion when urbanizing areas increase the frequency, rate, and volume of runoff. Therefore, Drainageways are required to be stabilized. One of three basic methods of stabilization may be selected.

Constructed Grass, Riprap, or Concrete-Lined Channel

These methods of channel stabilization have been in practice for some time. The water quality benefit associated with these channels is the reduction of severe bed and bank erosion that can occur in the absence of a stabilized channel. On the other hand, the hard-lined low flow channels that are often used do not offer much in the way of water quality enhancement or wetland habitat. The use of riprap or concrete lined flood conveyance channels is not recommended, unless hydraulic or physical conditions require such an alternative. A grass lined channel is recommended along the north line of Basin A.

Step 3 Provide Water Quality Capture Volume – The limit of disturbance for the proposed construction is 2.292 acres, therefore water quality / water detention provisions are required and necessary. Therefore the full spectrum detention pond is proposed.

Step 3: Provide Water Quality Capture Volume (WQCV)

All sites defined as "New Development and Significant Redevelopment" and all stormwater quantity detention, as listed above in the Section I.7.1B, shall address providing the WQCV. One or more of six types of water quality basins, each drain for long-term settling of sediment particles, may be selected. Information on selection of one or more of these WQCV facilities at a site is provided in the section providing Capture Volume (WQCV). An Extended Detention Basin is recommended for this

Please describe what water quality is being required for. Is it only for the one hangar that is being proposed now? Please address water quality for the future hangars.

Step 4 Consider Need for Industrial and Commercial BMP's – This submittal provides a final grading and erosion control plans with BMP's in place. The proposed project will use (dirt) berms, a vehicle tracking control pad, and concrete washout area, reseeding and landscaping to mitigate the potential for erosion across the site. The proposed BMP's are considered fully adequate.

8. COST ESTIMATE:

All facilities are private.

Item No.	Description	Quantity	Unit Cost	Cost
1	Firebaugh Grated Inlet	2 ea	\$ 1500.00	\$ 3000.00
2	12 PVC storm sewer	364 lf	35.00	12740.00

3	Detention Pond	900 CY	6.00	5400.00
4	Outlet Structure	1 Ea	3000.00	3000.00
Subtotal Construction Cost				\$ 24140.00
Engineering			10%	2414.00
Total Estimated Cost				\$26554.00

9. FEES:

No subdivision is required, therefore fees are not due.

10. SUMMARY

The proposed building at this address provides a minimum encroachment in an attractive natural setting in order to aid in the operation of the Meadow Lake Airport. There will be no adverse effects on downstream or surrounding properties.

The drainage analysis has been prepared in accordance with the current El Paso County Drainage Criteria Manual. Supporting information and calculations are included in this report.

References

1. El Paso County Engineering Criteria Manual, December 13, 2016
2. City of Colorado Springs Drainage Criteria Manual, Volumes 1 and 2, May, 2014
3. El Paso County Drainage Criteria Manuals, Volumes 1 and 2 (and updates), October 31, 2018
4. Urban Drainage Criteria Manuals, Volumes 1, 2 and 3, 2016 and 2019

MAJOR BASIN	SUB BASIN	AREA		BASIN		Tc MIN	I in./hr.		SOIL GRP	DEV. TYPE	C		FLOW		RETURN PERIOD -years-		
		PLANIM READ	ACRES	LENGTH -FT.-	HEIGHT -FT.-						5-ry qp -CFS-	100-yr qp -CFS-					
HISTORIC	A-C	COGO	2.943	300	6	25			A	R/L	0.08	0.35			5	100	
			V=0.7	+220	4	+5											
						30	2.4	4.0					0.57	4.12			
HYDROLOGICAL COMPUTATION – BASIC DATA																	
PROJ: 8140 CESSNA	BY: O.E. WATTS																
RATIONAL METHOD	DATE: 7/9/21																
OLIVER E. WATTS, CONSULTING ENGINEER, INC.										614 ELKTON DRIVE COLORADO SPRINGS, CO 80907							
												PAGE 1		OF			
														8			


Please include calculations to include the future hangars impervious areas since pond will have to be retrofitted in the future in another site development plan.

MAJOR BASIN	SUB BASIN	AREA		BASIN		T _c MIN	I in./hr.		SOIL GRP	DEV. TYPE	C		FLOW		RETURN PERIOD -years-		
		PLANIM READ	ACRES	LENGTH -FT.-	HEIGHT -FT.-								5-ry qp -CFS-	100-yr qp -CFS-			
DEVELOPED	A	COGO	0.196	300	5	12			A	ROOF	0.73	0.81			5	100	
		V=1.1	0.062	+150	2.5	+2				A.C.	0.90	0.96					
			0.434								R/L	0.08	0.36				
							14	3.4	2.8		MIX	0.338	0.535	0.8	1.8		
	B	COGO	0.124	300	6	6.0			A	FOOF	0.73	0.81					
		V=2.0	0.198	+1580	1.8	+1.5				A.C.	0.90	0.96					
			0.568							R/L	0.08	0.35					
			0.890				7.5	4.6	7.8		MI	0.352	0.550	1.4	3.8		
	C	COGO	0.150	300	5	20.7			A	ROOF	0.73	0.81					
		V=2.0	0.279	+165	+1.65	+0.1				A.C.	0.90	0.96					
			0.932				20.8			R/L	0.08	0.365					
			1.361					3.0	4.9		MI	0.320	0.523	1.3	3.4		
	+B		0.890	+136.37	V=4.05	+0.5											
	TOTAL		2.251			21.3	2.9	4.9		MI	0.333	0.536	2.2	5.9			
	+A		0.692	+31.24	V=7.64	+0.1					0.338	0.535					
	TOTAL		2.943			24.4	2.9	4.9		MI	0.334	0.536	2.9	7.7			
HYDROLOGICAL COMPUTATION – BASIC DATA															PAGE 2 OF 8		
PROJ: 8140 CESSNA RATIONAL METHOD BY: O.E. WATTS DATE: 7/9/21										OLIVER E. WATTS, CONSULTING ENGINEER, INC. 614 ELKTON DRIVE COLORADO SPRINGS, CO 80907							

STREET AND STORM SEWER CALCULATIONS

STREET	LOCATION	DISTANCE -ft.-	ELEVATION & SLOPE	TOTAL RUNOFF -cfs- 5-yr./100-yr	STREET FLOW / CAPACITY -cfs- 5-yr./100-yr	PIPE FLOW -cfs-	TYPE PIPE, CATCH BASIN & SLOPE %	
PRIVATE	C		31.61/30.11	1.3/3.5		3.5	FIREBAUGH GRATE	
		130.37	0.67%			3.5	12" PVC S=0.67% V=4.45	
	B		30.70/29.20				FIREBAUGH GRATE	
		31.24		2.2/5.9		5.9	12" PVC V=7.5	
	C		28 OUT				OUTLET STRUCTURE	
		228.16	2.63%			5.9	12" PVC, 1.62% MIN.	
	OF DITCH		22					
	SPILLWAY		d=dc			5.9	B=10' D=1' Z=4:1 d=0.33'	
STREET AND STORM SEWER CALCULATIONS PROJECT: 8140 CESSNA				BY: O.E. WATTS DATE: 7/9/21			OLIVER E. WATTS, CONSULTING ENGINEER, INC. 614 ELKTON DRIVE COLORADO SPRINGS, CO 80907	
							Page:3 Of Pages: 8	

418

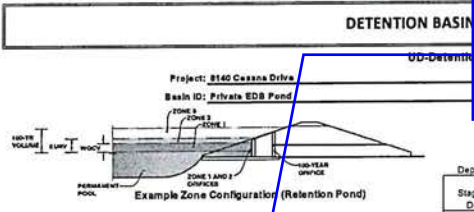

Please adjust watershed area to include area that drains to the pond. If the entire site drains to the pond it should be 3.26 acres.

Required Volume Calculation

Selected BMP Type =	EDB	
Watershed Area =	2.94	Acres
Watershed Length =	610	
Watershed Slope =	0.016	ft/ft
Watershed Imperviousness =	48.00%	percent
Percentage Hydrologic Soil Group A =	100.0%	percent
Percentage Hydrologic Soil Group B =	0.0%	percent
Percentage Hydrologic Soil Group C/D =	0.0%	percent
Desired WQCV Drain Time =	40.0	hours
Location for 1-hr Rainfall Depth =	User Input	
Water Quality Capture Volume (WQCV) =	0.048	acre-feet
Excess Urban Runoff Volume (EURV) =	0.152	acre-feet
2-yr Runoff Volume (P1 = 1.19 in) =	0.104	acre-feet
5-yr Runoff Volume (P1 = 1.5 in) =	0.137	acre-feet
10-yr Runoff Volume (P1 = 1.75 in) =	0.169	acre-feet
25-yr Runoff Volume (P1 = 2 in) =	0.212	acre-feet
50-yr Runoff Volume (P1 = 2.25 in) =	0.269	acre-feet
100-yr Runoff Volume (P1 = 2.52 in) =	0.337	acre-feet
500-yr Runoff Volume (P1 = 0 in) =	0.000	acre-feet
Approximate 2-yr Detention Volume =	0.098	acre-feet
Approximate 5-yr Detention Volume =	0.129	acre-feet
Approximate 10-yr Detention Volume =	0.158	acre-feet
Approximate 25-yr Detention Volume =	0.194	acre-feet
Approximate 50-yr Detention Volume =	0.218	acre-feet
Approximate 100-yr Detention Volume =	0.248	acre-feet

Optional User Override 1-hr Precipitation

1.19	inches
1.50	inches
1.75	inches
2.00	inches
2.25	inches
2.52	inches
	inches

Stage-storage Calculation

Select Zone 1 Storage Volume (Required) =		acre-feet
Select Zone 2 Storage Volume (Optional) =		acre-feet
Select Zone 3 Storage Volume (Optional) =		acre-feet
Total Detention Basin Volume =		acre-feet
Initial Surcharge Volume (SV) =	User	ft ³
Initial Surcharge Depth (SD) =	User	ft
Total Available Detention Depth (L _{avail}) =	User	ft
Depth of Trickie Channel (H _{tc}) =	User	ft
Slope of Trickie Channel (S _{tc}) =	User	ft/ft
Slopes of Main Basin Sides (S _{mb}) =	User	H/V
Basin Length-to-Width Ratio (R _{l/w}) =	User	
Initial Surcharge Area (A _{sv}) =	User	ft ²
Surcharge Volume Length (L _{sv}) =	User	ft
Surcharge Volume Width (W _{sv}) =	User	ft
Depth of Basin Floor (H _{100p}) =	User	ft
Length of Basin Floor (L _{100p}) =	User	ft
Width of Basin Floor (W _{100p}) =	User	ft
Area of Basin Floor (A _{100p}) =	User	ft ²
Volume of Basin Floor (V _{100p}) =	User	ft ³
Depth of Main Basin (H _{mb}) =	User	ft
Length of Main Basin (L _{mb}) =	User	ft
Width of Main Basin (W _{mb}) =	User	ft
Area of Main Basin (A _{mb}) =	User	ft ²
Volume of Main Basin (V _{mb}) =	User	ft ³
Calculated Total Basin Volume (V _{total}) =	User	acre-feet


Please include impervious amounts for future hangars that are shown in the site development plan, it appears that it is more than 50%.

Depth Increment =	Stage - Storage Description	Stage (ft)	Q ₁ (cfs)	Q ₂ (cfs)	Q ₃ (cfs)	Q ₄ (cfs)	Q ₅ (cfs)
Top of Micropool
		4.00	4,265	0.098
		5.00	5,330	0.122
			9,930	0.228
			14,438	0.331

S10

DETENTION BASIN STAGE-STORAGE TABLE BUILDER


UD-Detention, Version 3.07 (February 2017)

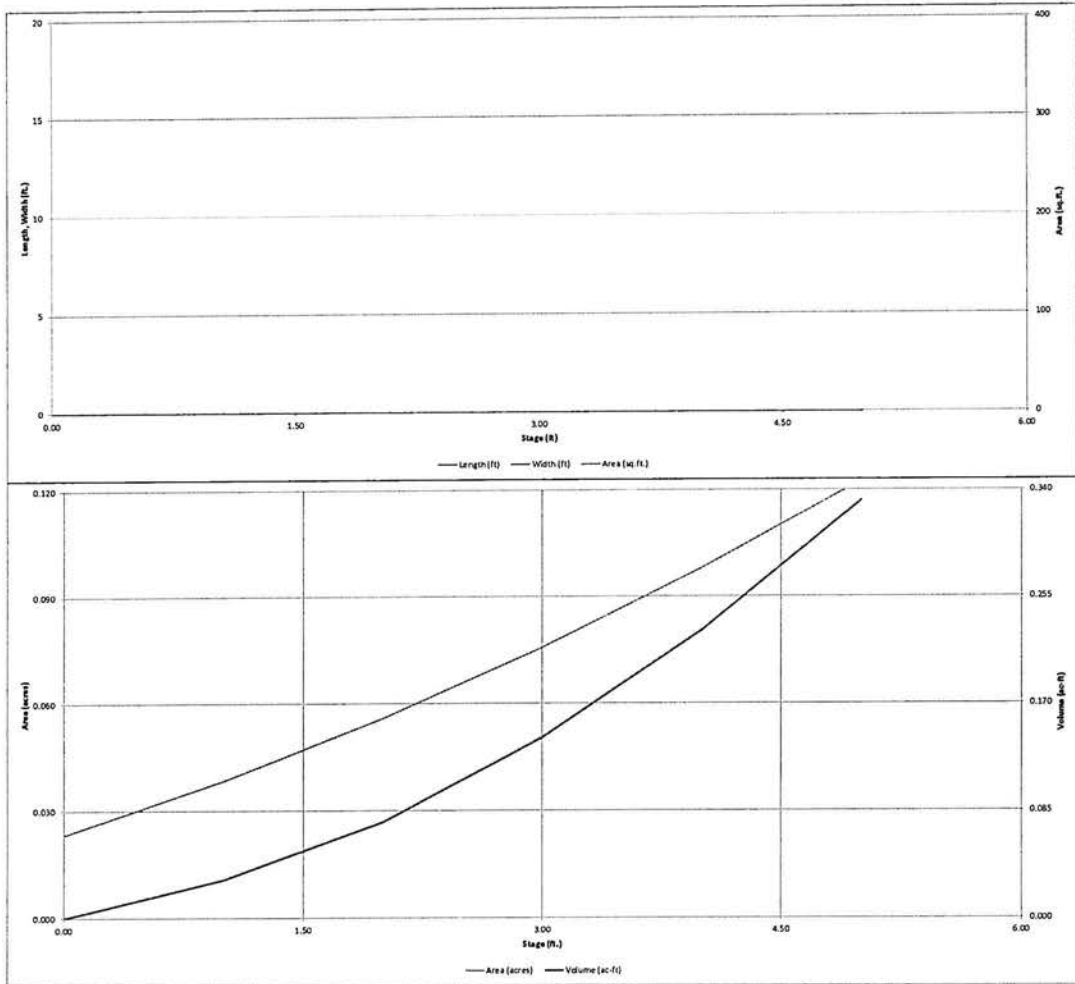

Detention Basin Outlet Structure Design

UD-Detention, Version 3.07 (February 2017)

Project: 8140 CESSNA DRIVE
Basin ID: Private EDB

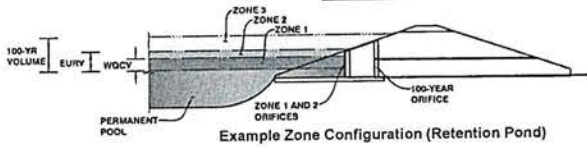

Zone	Stage (ft)	Zone Volume (ac-ft)	Outlet Type
Zone 1	#N/A		Orifice Plate
Zone 2			Not Utilized
Zone 3			
Total			

Please fill out zones for pond.

User Input: Orifice at Underdrain Outlet (typically used to drain WQCV in a Filtration BMP)

Underdrain Orifice Invert Depth = ft (distance below the filtration media surface)
Underdrain Orifice Diameter = inches

Calculated Parameters for Underdrain Orifice:
Underdrain Orifice Area = ft²
Underdrain Orifice Centroid = feet

User Input: Orifice Plate with one or more orifices or Elliptical Slot Weir (typically used to drain WQCV and/or EURV in a sedimentation BMP)

Invert of Lowest Orifice = ft (relative to basin bottom at Stage = 0 ft)
Depth at top of Zone using Orifice Plate = ft (relative to basin bottom at Stage = 0 ft)
Orifice Plate: Orifice Vertical Spacing = inches
Orifice Plate: Orifice Area per Row = inches

Calculated Parameters for Orifice Plate:
WQ Orifice Area per Row = ft²
Elliptical Half-Width = feet
Elliptical Slot Centroid = feet
Elliptical Slot Area = ft²

Please fill out.

User Input: Stage and Total Area of Each Orifice Row (numbered from lowest to highest)

	Row 1 (required)	Row 2 (optional)	Row 3 (optional)	Row 4 (optional)	Row 5 (optional)	Row 6 (optional)	Row 7 (optional)	Row 8 (optional)
Stage of Orifice Centroid (ft)	0.00	1.00	2.00	N/A	N/A	N/A	N/A	N/A
Orifice Area (sq. inches)	N/A	N/A	N/A	N/A	N/A	N/A	N/A	N/A

	Row 9 (optional)	Row 10 (optional)	Row 11 (optional)	Row 12 (optional)	Row 13 (optional)	Row 14 (optional)	Row 15 (optional)	Row 16 (optional)
Stage of Orifice Centroid (ft)	N/A	N/A	N/A	N/A	N/A	N/A	N/A	N/A
Orifice Area (sq. inches)	N/A	N/A	N/A	N/A	N/A	N/A	N/A	N/A

User Input: Vertical Orifice (Circular or Rectangular)

	Not Selected	Not Selected	
Invert of Vertical Orifice =		N/A	ft (relative to basin bottom at Stage = 0 ft)
Depth at top of Zone using Vertical Orifice =		N/A	ft (relative to basin bottom at Stage = 0 ft)
Vertical Orifice Diameter =		N/A	inches

Calculated Parameters for Vertical Orifice

	Not Selected	Not Selected	
Vertical Orifice Area =		N/A	ft ²
Vertical Orifice Centroid =		N/A	feet

User Input: Overflow Weir (Dropbox) and Grate (Flat or Sloped)

	Not Selected	Not Selected	
Overflow Weir Front Edge Height, H _o =	1.00		ft (relative to basin bottom at Stage = 0 ft)
Overflow Weir Front Edge Length =	4.00		feet
Overflow Weir Slope =	4.00		H:V (enter zero for flat grate)
Horiz. Length of Weir Sides =	4.00		feet
Overflow Grate Open Area % =	70%		% grate open area/total area
Debris Clogging % =	50%		%

Calculated Parameters for Overflow Weir

	Not Selected	Not Selected	
Height of Grate Upper Edge, H _g =	2.00		feet
Overflow Weir Slope Length =	4.12		feet
Grate Open Area / 100-yr Orifice Area =	14.70		should be ≥ 4
Overflow Grate Open Area w/o Debris =	11.54		ft ²
Overflow Grate Open Area w/ Debris =	5.77		ft ²

User Input: Outlet Pipe w/ Flow Restriction Plate (Circular Orifice, Restrictor Plate, or Rectangular Orifice)

	Not Selected	Not Selected	
Depth to Invert of Outlet Pipe =	1.00		ft (distance below basin bottom at Stage = 0 ft)
Circular Orifice Diameter =	12.00		inches

Calculated Parameters for Outlet Pipe w/ Flow Restriction Plate

	Not Selected	Not Selected	
Outlet Orifice Area =	0.79		ft ²
Outlet Orifice Centroid =	0.50		feet
Half-Central Angle of Restrictor Plate on Pipe =	N/A	N/A	radians

User Input: Emergency Spillway (Rectangular or Trapezoidal)

Spillway Invert Stage = ft (relative to basin bottom at Stage = 0 ft)
Spillway Crest Length = feet
Spillway End Slopes = H:V
Freeboard above Max Water Surface = feet

Calculated Parameters for Spillway

Spillway Design Flow Depth = feet
Stage at Top of Freeboard = feet
Basin Area at Top of Freeboard = acres

Routed Hydrograph Results




	WQCV	EURV	2 Year	5 Year	10 Year	25 Year	50 Year	100 Year	500 Year
Design Storm Return Period =	0.53	1.07	1.19	1.50	1.75	2.00	2.25	2.52	0.00
One-Hour Rainfall Depth (in) =	0.048	0.152	0.104	0.137	0.169	0.212	0.269	0.337	0.000
Calculated Runoff Volume (acre-ft) =									
OPTIONAL Override Runoff Volume (acre-ft) =									
Inflow Hydrograph Volume (acre-ft) =	0.048	0.152	0.103	0.136	0.168	0.212	0.268	0.336	#N/A
Predevelopment Unit Peak Flow, q (cfs/acre) =	0.00	0.00	0.00	0.00	0.01	0.02	0.16	0.39	0.00
Predevelopment Peak Q (cfs) =	0.0	0.0	0.0	0.0	0.0	0.1	0.5	1.1	0.0
Peak Inflow Q (cfs) =	0.7	2.2	1.5	2.0	2.5	3.1	3.9	4.9	#N/A
Peak Outflow Q (cfs) =	#VALUE!	#VALUE!	#VALUE!	#VALUE!	#VALUE!	#VALUE!	#VALUE!	#VALUE!	#N/A
Ratio Peak Outflow to Predevelopment Q =	#VALUE!	#VALUE!	#VALUE!	#VALUE!	#VALUE!	#VALUE!	#VALUE!	#VALUE!	#N/A
Structure Controlling Flow =	#VALUE!	#VALUE!	#VALUE!	#VALUE!	#VALUE!	#VALUE!	#VALUE!	#VALUE!	#N/A
Max Velocity through Grate 1 (fps) =	#VALUE!	#VALUE!	#VALUE!	#VALUE!	#VALUE!	#VALUE!	#VALUE!	#VALUE!	#N/A
Max Velocity through Grate 2 (fps) =	#VALUE!	#VALUE!	#VALUE!	#VALUE!	#VALUE!	#VALUE!	#VALUE!	#VALUE!	#N/A
Time to Drain 97% of Inflow Volume (hours) =	#VALUE!	#VALUE!	#VALUE!	#VALUE!	#VALUE!	#VALUE!	#VALUE!	#VALUE!	#N/A
Time to Drain 99% of Inflow Volume (hours) =	#VALUE!	#VALUE!	#VALUE!	#VALUE!	#VALUE!	#VALUE!	#VALUE!	#VALUE!	#N/A
Maximum Ponding Depth (ft) =	#VALUE!	#VALUE!	#VALUE!	#VALUE!	#VALUE!	#VALUE!	#VALUE!	#VALUE!	#N/A
Area at Maximum Ponding Depth (acres) =	#VALUE!	#VALUE!	#VALUE!	#VALUE!	#VALUE!	#VALUE!	#VALUE!	#VALUE!	#N/A
Maximum Volume Stored (acre-ft) =	#VALUE!	#VALUE!	#VALUE!	#VALUE!	#VALUE!	#VALUE!	#VALUE!	#VALUE!	#N/A

Please fill out.

76

Detention Basin Outlet Structure Design

UD-Detention, Version 3.07 (February 2017)

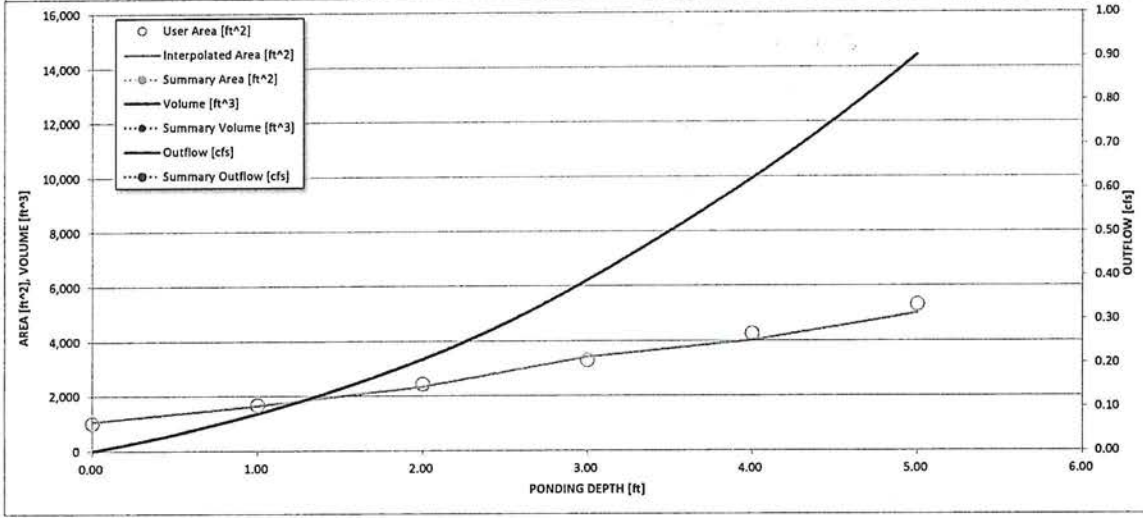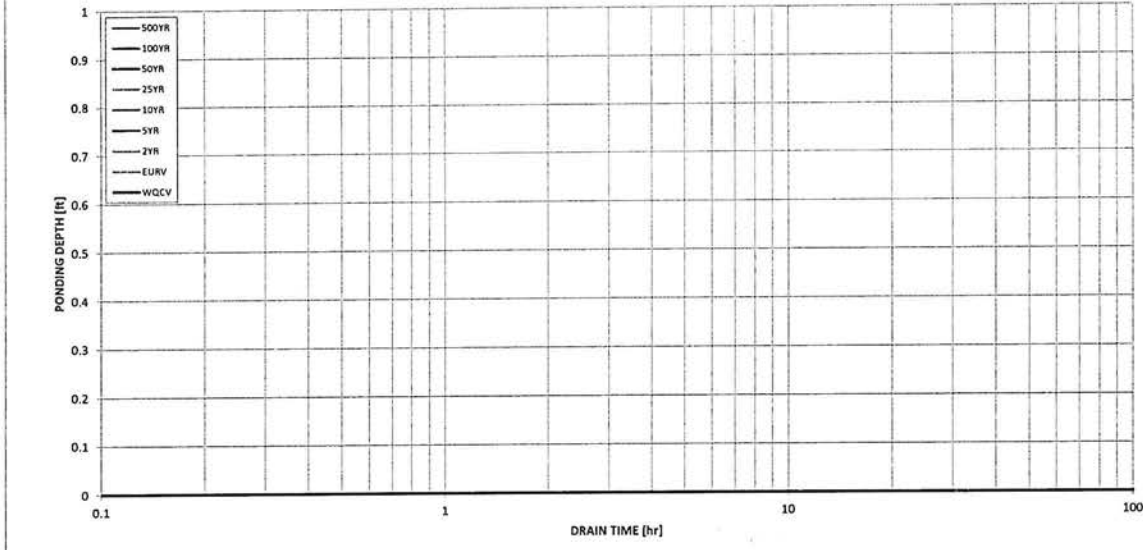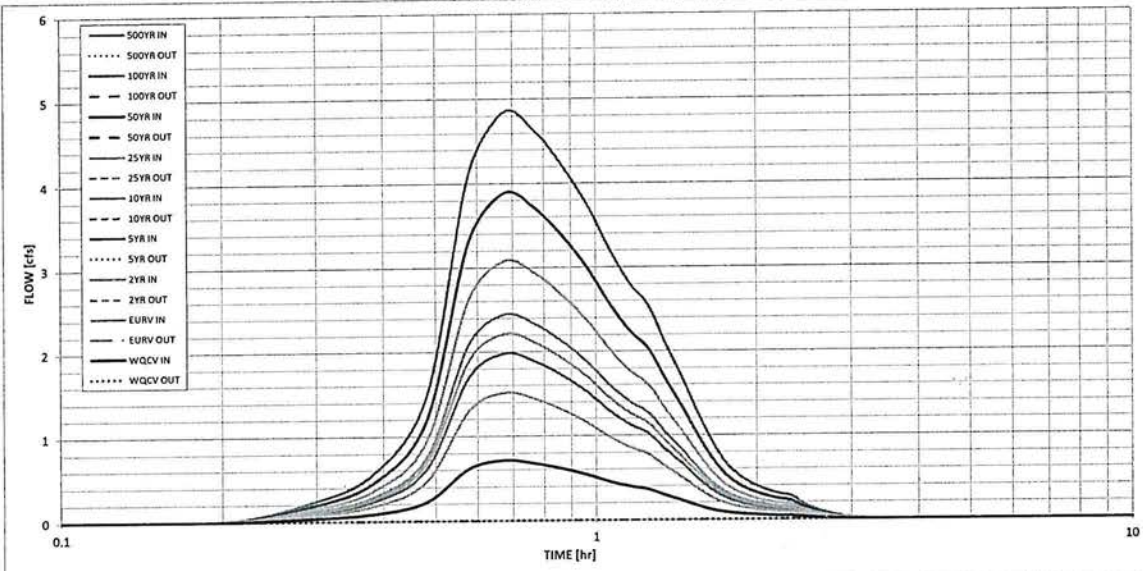


S-A-V-D Chart Axis Override	X-axis	Left Y-Axis	Right Y-Axis
minimum bound			
maximum bound			

National Flood Hazard Layer FIRMeTte



104°34'29"W 38°57'16"N

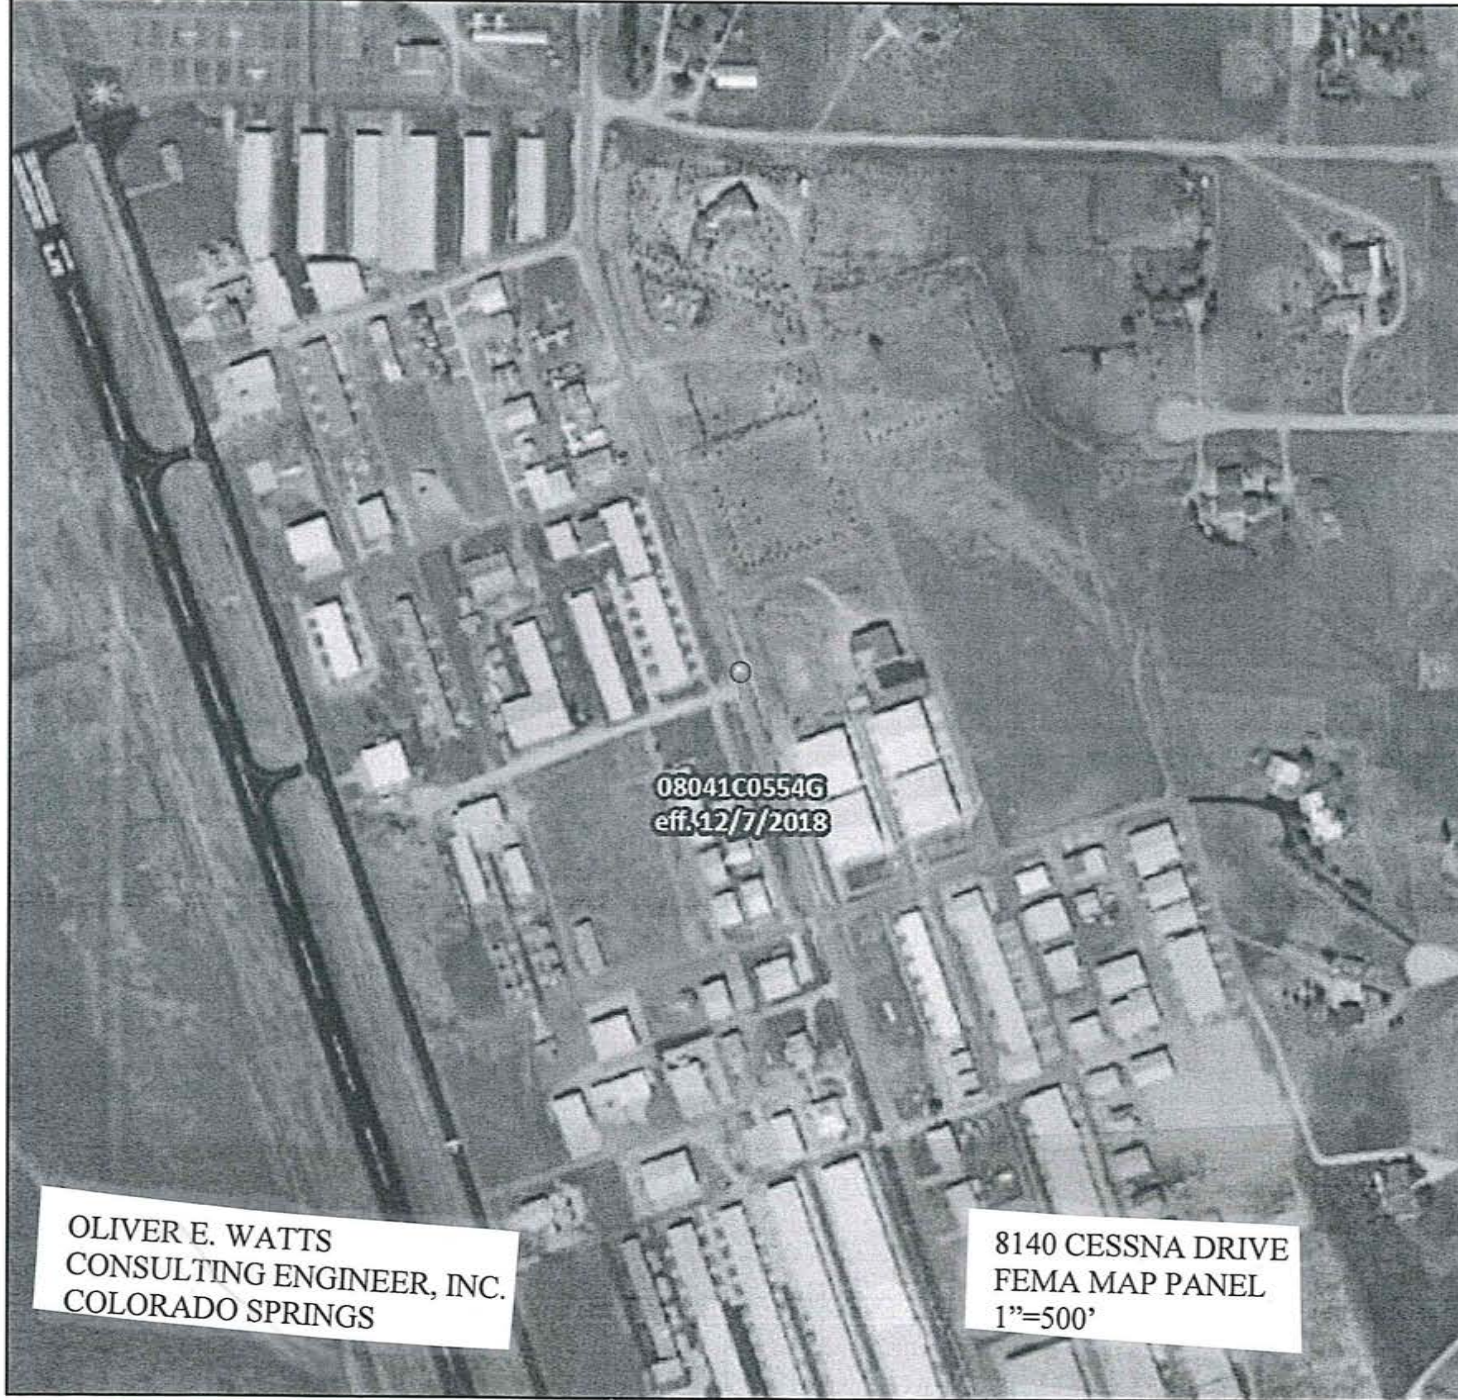

OLIVER E. WATTS
CONSULTING ENGINEER, INC.
COLORADO SPRINGS

8140 CESSNA DRIVE
FEMA MAP PANEL
1"=500'



104°33'51"W 38°56'48"N

Legend

SEE FIS REPORT FOR DETAILED LEGEND AND INDEX MAP FOR FIRM PANEL LAYOUT


SPECIAL FLOOD HAZARD AREAS		Without Base Flood Elevation (BFE) <i>Zone A, V, A99</i>
		With BFE or Depth <i>Zone AE, AO, AH, VE, AR</i>
		Regulatory Floodway
OTHER AREAS OF FLOOD HAZARD		0.2% Annual Chance Flood Hazard, Area of 1% annual chance flood with average depth less than one foot or with drainage areas of less than one square mile <i>Zone I</i>
		Future Conditions 1% Annual Chance Flood Hazard <i>Zone X</i>
		Area with Reduced Flood Risk due to Levee. See Notes, <i>Zone X</i>
		Area with Flood Risk due to Levee <i>Zone D</i>
OTHER AREAS		NO SCREEN Area of Minimal Flood Hazard <i>Zone X</i>
		Effective LOMRs
GENERAL STRUCTURES		Area of Undetermined Flood Hazard <i>Zone</i>
		Channel, Culvert, or Storm Sewer
OTHER FEATURES		Levee, Dike, or Floodwall
		20.2 Cross Sections with 1% Annual Chance Water Surface Elevation
MAP PANELS		17.5 Coastal Transect
		Base Flood Elevation Line (BFE)
		Limit of Study
		Jurisdiction Boundary
		Coastal Transect Baseline
		Profile Baseline
		Hydrographic Feature
MAP PANELS		Digital Data Available
		No Digital Data Available
		Unmapped

The pin displayed on the map is an approximate point selected by the user and does not represent an authoritative property location.

This map complies with FEMA's standards for the use of digital flood maps if it is not void as described below. The basemap shown complies with FEMA's basemap accuracy standards

The flood hazard information is derived directly from the authoritative NFHL web services provided by FEMA. This map was exported on 7/9/2021 at 12:31 PM and does not reflect changes or amendments subsequent to this date and time. The NFHL and effective information may change or become superseded by new data over time.

This map image is void if the one or more of the following map elements do not appear: basemap imagery, flood zone labels, legend, scale bar, map creation date, community identifiers, FIRM panel number, and FIRM effective date. Map images for unmapped and unmodernized areas cannot be used for regulatory purposes.

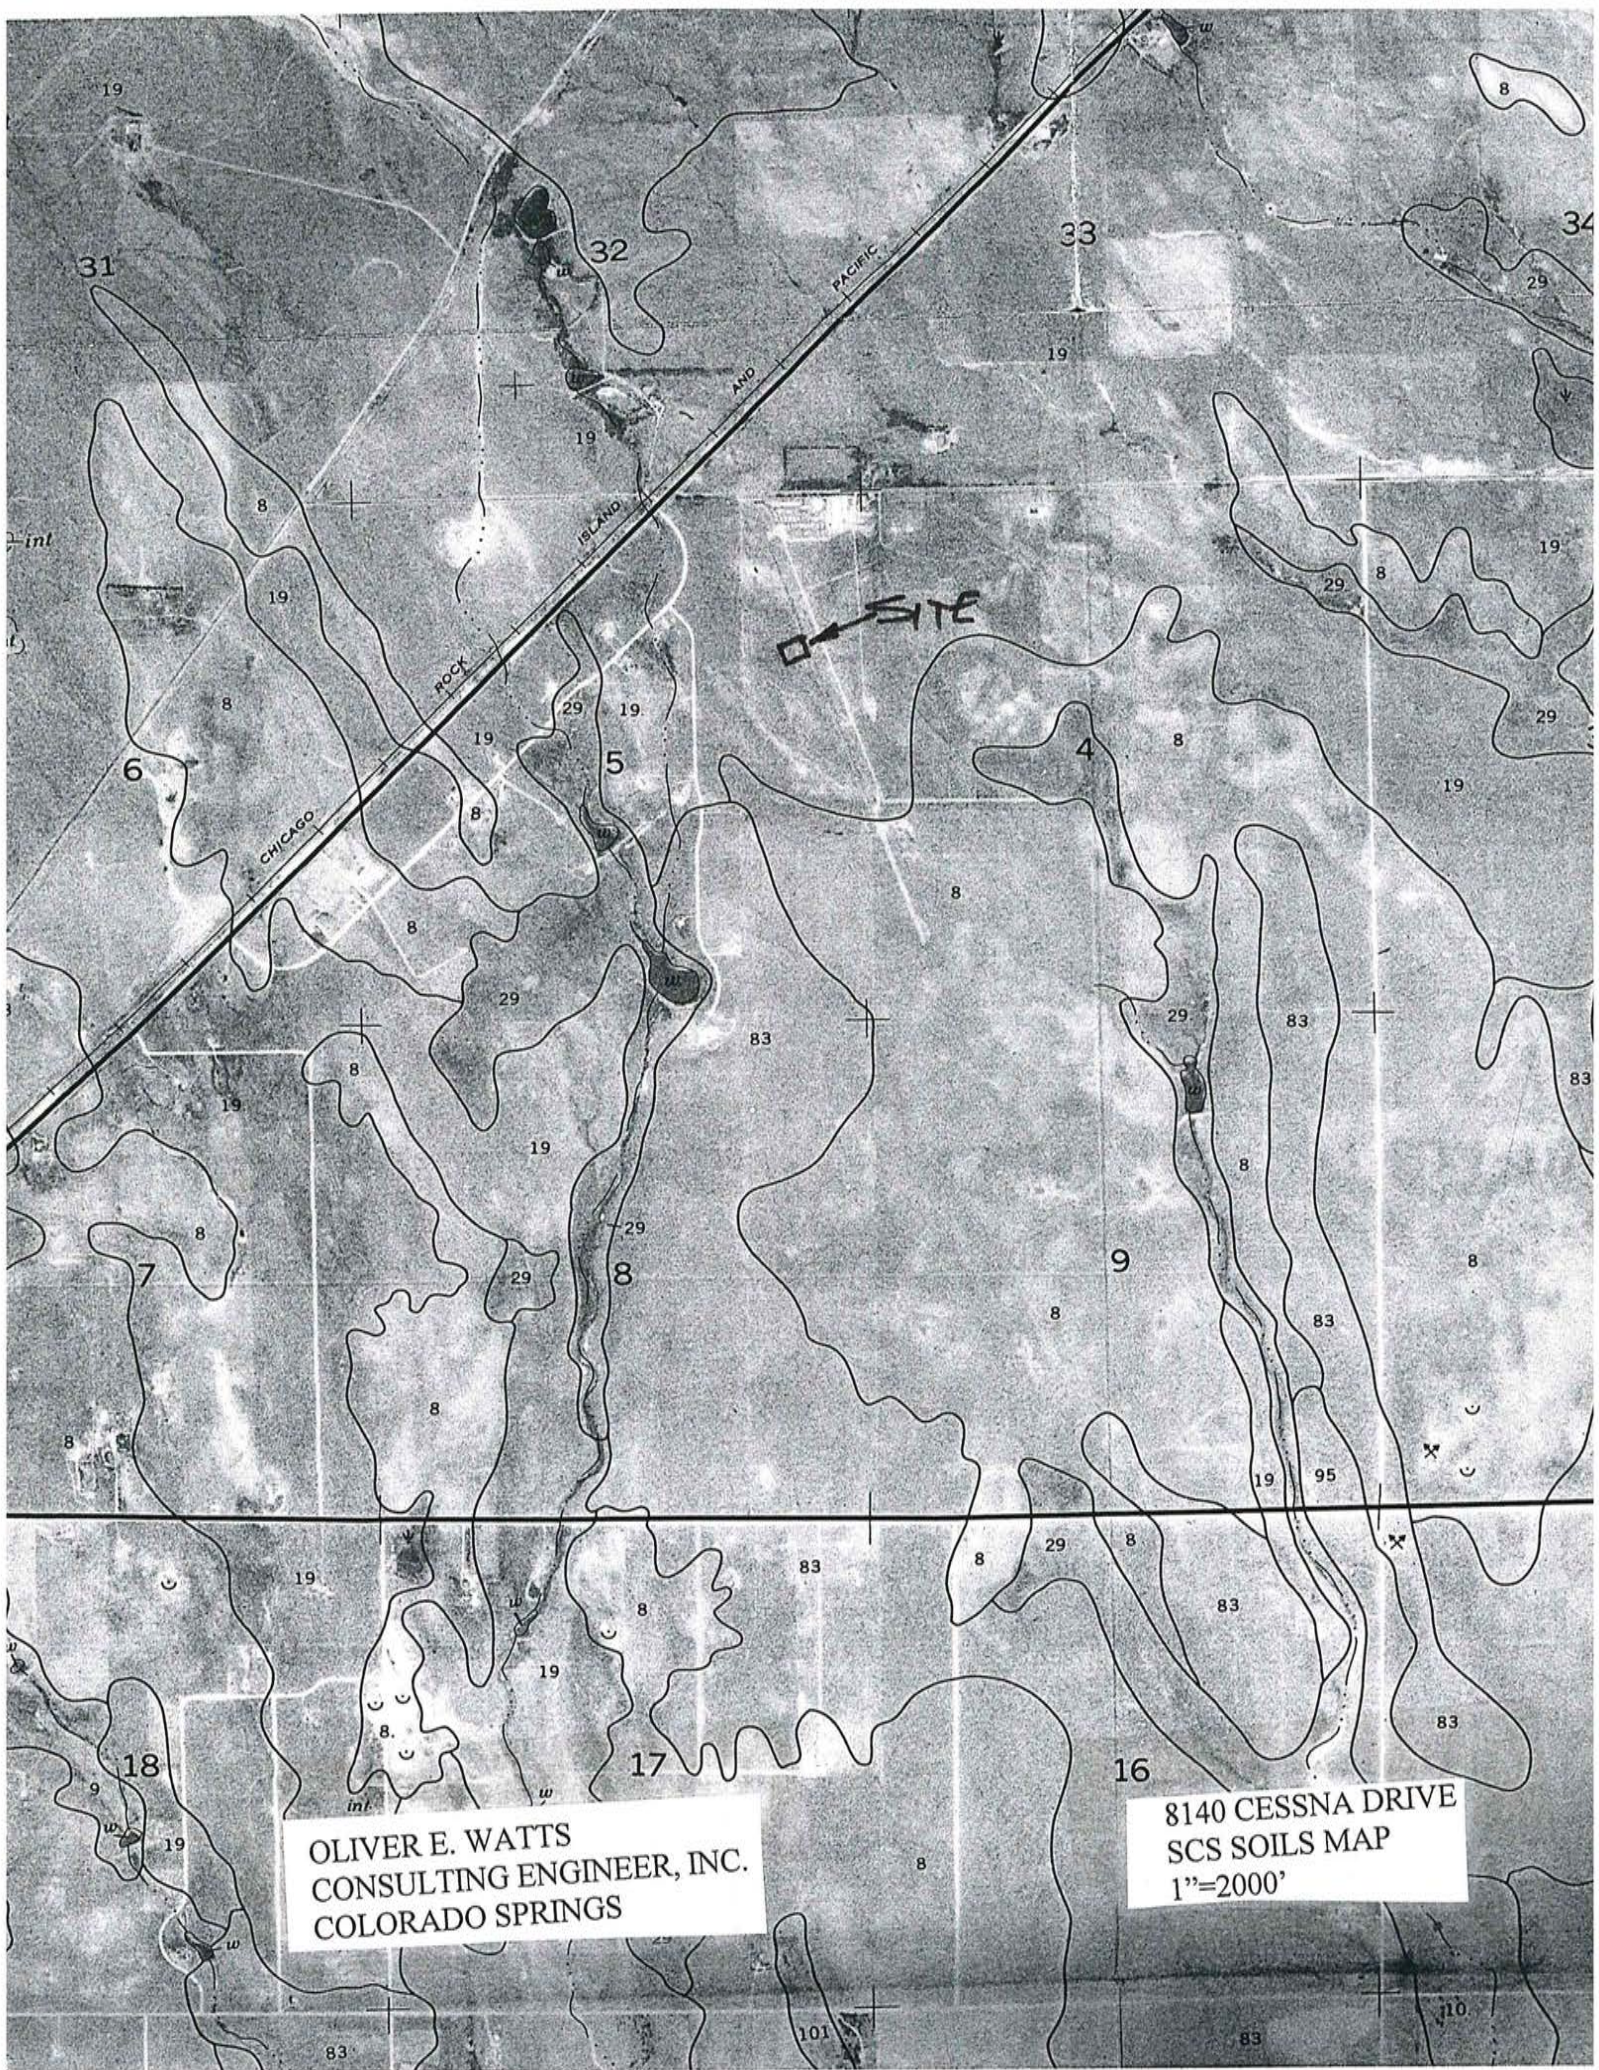

SITE

OLIVER E. WATTS
CONSULTING ENGINEER, INC.
COLORADO SPRINGS

8140 CESSNA DRIVE
SCS SOILS MAP
1"=2000'

EL PASO COUNTY AREA, COLORADO

TABLE 16.--SOIL AND WATER FEATURES

[Absence of an entry indicates the feature is not a concern. See "flooding" in Glossary for definition of terms as "rare," "brief," and "very brief." The symbol > means greater than]

Soil name and map symbol	Hydro-logic group	Flooding			Bedrock		Potential frost action
		Frequency	Duration	Months	Depth	Hardness	
Alamosa: 1-----	C	Frequent-----	Brief-----	May-Jun	>60	---	High.
Ascalon: 2, 3-----	B	None-----	---	---	>60	---	Moderate.
Badland: 4-----	D	---	---	---	---	---	---
Bijou: 5, 6, 7-----	B	None-----	---	---	>60	---	Low.
Blakeland: 8-----	A	None-----	---	---	>60	---	Low.
¹⁹ : Blakeland part-	A	None-----	---	---	>60	---	Low.
Fluvaquentic Haplaquolls part-----	D	Common-----	Very brief-----	Mar-Aug	>60	---	High.
Blendon: 10-----	B	None-----	---	---	>60	---	Moderate.
Bresser: 11, 12, 13-----	B	None-----	---	---	>60	---	Low.
Brussett: 14, 15-----	B	None-----	---	---	>60	---	Moderate.
Chaseville: 16, 17-----	A	None-----	---	---	>60	---	Low.
¹¹⁸ : Chaseville part	A	None-----	---	---	>60	---	Low.
Midway part----	D	None-----	---	---	10-20	Rippable	Moderate.
Columbine: 19-----	A	None to rare	---	---	>60	---	Low.
Connerton: ¹²⁰ : Connerton part-	B	None-----	---	---	>60	---	High.
Rock outcrop part-----	D	---	---	---	---	---	---
Cruckton: 21-----	B	None-----	---	---	>60	---	Moderate.
Cushman: 22, 23-----	C	None-----	---	---	20-40	Rippable	Moderate.
¹²⁴ : Cushman part----	C	None-----	---	---	20-40	Rippable	Moderate.
Kutch part----	C	None-----	---	---	20-40	Rippable	Moderate.
Elbeth: 25, 26-----	B	None-----	---	---	>60	---	Moderate.
¹²⁷ : Elbeth part----	B	None-----	---	---	>60	---	Moderate.

See footnote at end of table.

Table 6-6. Runoff Coefficients for Rational Method
(Source: UDFCD 2001)

Land Use or Surface Characteristics	Percent Impervious	Runoff Coefficients											
		2-year		5-year		10-year		25-year		50-year		100-year	
		HSG A&B	HSG C&D	HSG A&B	HSG C&D	HSG A&B	HSG C&D	HSG A&B	HSG C&D	HSG A&B	HSG C&D	HSG A&B	HSG C&D
Business													
Commercial Areas	95	0.79	0.80	0.81	0.82	0.83	0.84	0.85	0.87	0.87	0.88	0.88	0.89
Neighborhood Areas	70	0.45	0.49	0.49	0.53	0.53	0.57	0.58	0.62	0.60	0.65	0.62	0.68
Residential													
1/8 Acre or less	65	0.41	0.45	0.45	0.49	0.49	0.54	0.54	0.59	0.57	0.62	0.59	0.65
1/4 Acre	40	0.23	0.28	0.30	0.35	0.36	0.42	0.42	0.50	0.46	0.54	0.50	0.58
1/3 Acre	30	0.18	0.22	0.25	0.30	0.32	0.38	0.39	0.47	0.43	0.52	0.47	0.57
1/2 Acre	25	0.15	0.20	0.22	0.28	0.30	0.36	0.37	0.46	0.41	0.51	0.46	0.56
1 Acre	20	0.12	0.17	0.20	0.26	0.27	0.34	0.35	0.44	0.40	0.50	0.44	0.55
Industrial													
Light Areas	80	0.57	0.60	0.59	0.63	0.63	0.66	0.66	0.70	0.68	0.72	0.70	0.74
Heavy Areas	90	0.71	0.73	0.73	0.75	0.75	0.77	0.78	0.80	0.80	0.82	0.81	0.83
Parks and Cemeteries	7	0.05	0.09	0.12	0.19	0.20	0.29	0.30	0.40	0.34	0.46	0.39	0.52
Playgrounds	13	0.07	0.13	0.16	0.23	0.24	0.31	0.32	0.42	0.37	0.48	0.41	0.54
Railroad Yard Areas	40	0.23	0.28	0.30	0.35	0.36	0.42	0.42	0.50	0.46	0.54	0.50	0.58
Undeveloped Areas													
Historic Flow Analysis-- Greenbelts, Agriculture	2	0.03	0.05	0.09	0.16	0.17	0.26	0.26	0.38	0.31	0.45	0.36	0.51
Pasture/Meadow	0	0.02	0.04	0.08	0.15	0.15	0.25	0.25	0.37	0.30	0.44	0.35	0.50
Forest	0	0.02	0.04	0.08	0.15	0.15	0.25	0.25	0.37	0.30	0.44	0.35	0.50
Exposed Rock	100	0.89	0.89	0.90	0.90	0.92	0.92	0.94	0.94	0.95	0.95	0.96	0.96
Offsite Flow Analysis (when landuse is undefined)	45	0.26	0.31	0.32	0.37	0.38	0.44	0.44	0.51	0.48	0.55	0.51	0.59
Streets													
Paved	100	0.89	0.89	0.90	0.90	0.92	0.92	0.94	0.94	0.95	0.95	0.96	0.96
Gravel	80	0.57	0.60	0.59	0.63	0.63	0.66	0.66	0.70	0.68	0.72	0.70	0.74
Drive and Walks	100	0.89	0.89	0.90	0.90	0.92	0.92	0.94	0.94	0.95	0.95	0.96	0.96
Roofs	90	0.71	0.73	0.73	0.75	0.75	0.77	0.78	0.80	0.80	0.82	0.81	0.83
Lawns	0	0.02	0.04	0.08	0.15	0.15	0.25	0.25	0.37	0.30	0.44	0.35	0.50

3.2 Time of Concentration

One of the basic assumptions underlying the Rational Method is that runoff is a function of the average rainfall rate during the time required for water to flow from the hydraulically most remote part of the drainage area under consideration to the design point. However, in practice, the time of concentration can be an empirical value that results in reasonable and acceptable peak flow calculations.

For urban areas, the time of concentration (t_c) consists of an initial time or overland flow time (t_i) plus the travel time (t_t) in the storm sewer, paved gutter, roadside drainage ditch, or drainage channel. For non-urban areas, the time of concentration consists of an overland flow time (t_i) plus the time of travel in a concentrated form, such as a swale or drainageway. The travel portion (t_t) of the time of concentration can be estimated from the hydraulic properties of the storm sewer, gutter, swale, ditch, or drainageway. Initial time, on the other hand, will vary with surface slope, depression storage, surface cover, antecedent rainfall, and infiltration capacity of the soil, as well as distance of surface flow. The time of concentration is represented by Equation 6-7 for both urban and non-urban areas.

$$t_c = t_i + t_t \quad (\text{Eq. 6-7})$$

Where:

t_c = time of concentration (min)

t_i = overland (initial) flow time (min)

t_t = travel time in the ditch, channel, gutter, storm sewer, etc. (min)

3.2.1 Overland (Initial) Flow Time

The overland flow time, t_i , may be calculated using Equation 6-8.

$$t_i = \frac{0.395(1.1 - C_5)\sqrt{L}}{S^{0.33}} \quad (\text{Eq. 6-8})$$

Where:

t_i = overland (initial) flow time (min)

C_5 = runoff coefficient for 5-year frequency (see Table 6-6)

L = length of overland flow (300 ft maximum for non-urban land uses, 100 ft maximum for urban land uses)

S = average basin slope (ft/ft)

Note that in some urban watersheds, the overland flow time may be very small because flows quickly concentrate and channelize.

3.2.2 Travel Time

For catchments with overland and channelized flow, the time of concentration needs to be considered in combination with the travel time, t_t , which is calculated using the hydraulic properties of the swale, ditch, or channel. For preliminary work, the overland travel time, t_t , can be estimated with the help of Figure 6-25 or Equation 6-9 (Guo 1999).

$$V = C_v S_w^{0.5} \quad (\text{Eq. 6-9})$$

Where:

V = velocity (ft/s)

C_v = conveyance coefficient (from Table 6-7)

S_w = watercourse slope (ft/ft)

Table 6-7. Conveyance Coefficient, C_v

Type of Land Surface	C_v
Heavy meadow	2.5
Tillage/field	5
Riprap (not buried)*	6.5
Short pasture and lawns	7
Nearly bare ground	10
Grassed waterway	15
Paved areas and shallow paved swales	20

* For buried riprap, select C_v value based on type of vegetative cover.

The travel time is calculated by dividing the flow distance (in feet) by the velocity calculated using Equation 6-9 and converting units to minutes.

The time of concentration (t_c) is then the sum of the overland flow time (t_t) and the travel time (t_l) per Equation 6-7.

3.2.3 First Design Point Time of Concentration in Urban Catchments

Using this procedure, the time of concentration at the first design point (typically the first inlet in the system) in an urbanized catchment should not exceed the time of concentration calculated using Equation 6-10. The first design point is defined as the point where runoff first enters the storm sewer system.

$$t_c = \frac{L}{180} + 10 \quad (\text{Eq. 6-10})$$

Where:

t_c = maximum time of concentration at the first design point in an urban watershed (min)

L = waterway length (ft)

Equation 6-10 was developed using the rainfall-runoff data collected in the Denver region and, in essence, represents regional "calibration" of the Rational Method. Normally, Equation 6-10 will result in a lesser time of concentration at the first design point and will govern in an urbanized watershed. For subsequent design points, the time of concentration is calculated by accumulating the travel times in downstream drainageway reaches.


3.2.4 Minimum Time of Concentration

If the calculations result in a t_c of less than 10 minutes for undeveloped conditions, it is recommended that a minimum value of 10 minutes be used. The minimum t_c for urbanized areas is 5 minutes.

3.2.5 Post-Development Time of Concentration

As Equation 6-8 indicates, the time of concentration is a function of the 5-year runoff coefficient for a drainage basin. Typically, higher levels of imperviousness (higher 5-year runoff coefficients) correspond to shorter times of concentration, and lower levels of imperviousness correspond to longer times of

Figure 6-5. Colorado Springs Rainfall Intensity Duration Frequency

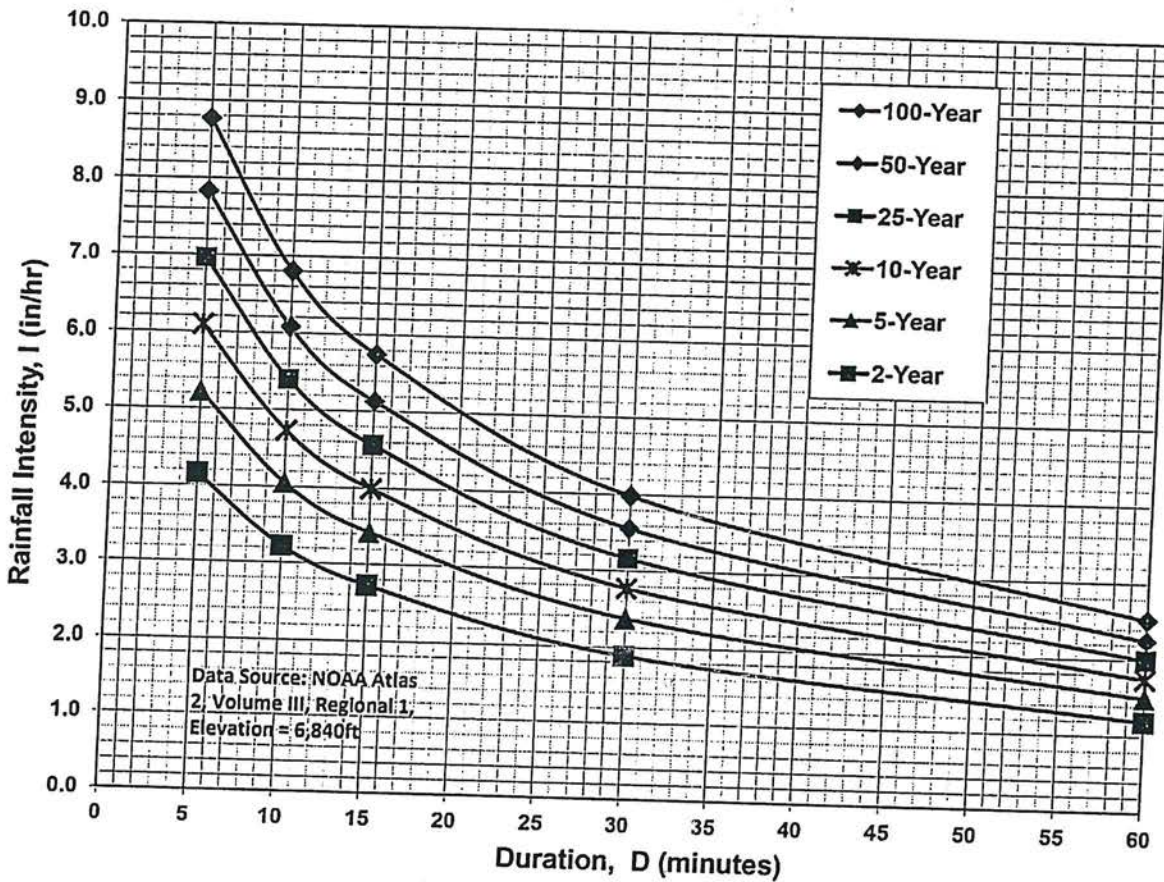

IDF Equations

$$I_{100} = -2.52 \ln(D) + 12.735$$

$$I_{50} = -2.25 \ln(D) + 11.375$$

$$I_{25} = -2.00 \ln(D) + 10.111$$

$$I_{10} = -1.75 \ln(D) + 8.847$$

$$I_5 = -1.50 \ln(D) + 7.583$$

$$I_2 = -1.19 \ln(D) + 6.035$$

Note: Values calculated by equations may not precisely duplicate values read from figure.

$$Q = \frac{0.463}{n} D^{8/3} S^{1/2}$$


$$Q = KS^{1/2}$$




DIAMETER - IN. -	AREA - FT ² -	D 8/3 - FT -	K			
			N=0.010	N=0.013	N=0.024	N=0.02
2	0.02182	0.008413	0.3895	---	---	---
4	0.08727	0.053420	2.4733	---	---	---
6	0.19630	0.157500	7.2922	5.609	---	---
8	0.34910	0.339200	15.7050	12.081	---	---
10	0.54540	0.615000	28.4745	21.903	---	---
12	0.78540	1.000000	46.3000	35.615	---	---
15	1.22720	1.813100	83.9465	64.574	---	---
18	1.76710	2.948300	136.5100	105.000	56.88	52.9
21	2.40530	4.447400	205.9100	158.400	85.80	79.2
24	3.14160	6.349600	293.9900	226.140	122.49	113.0
27	3.97610	8.692700	402.4700	309.590	167.70	154.7
30	4.90870	11.512600	533.0300	410.030	222.10	205.0
33	5.93960	14.844100	---	528.680	---	---
36	7.06860	18.720800	866.7700	666.700	361.20	333.0
39	8.29580	23.175100	---	825.400	---	---
42	9.62110	28.238900	---	1005.000	544.80	502.0
48	12.56640	40.317500	---	1436.000	777.80	718.0
54	15.90430	55.195000	---	1966.000	1065.00	983.0
60	19.63500	73.100400	---	2604.000	1410.00	1302.0
66	23.75830	94.254200	---	3357.000	1818.00	1678.0
72	28.27430	118.869400	---	4234.000	2293.00	2117.0
78	33.18310	147.152900	---	5241.000	2839.00	2620.0
84	38.48450	179.306000	---	6386.000	3459.00	3193.0
90	44.17860	215.524500	---	7676.000	4158.00	3838.0
96	50.26550	256.000000	---	9118.000	4939.00	4559.0
108	63.61730	350.466600	---	12480.000	6761.00	6140.0
120	78.53980	464.158900	---	16530.000	8954.00	8265.0

Oliver E. Watts
 Consulting Engi
 Colorado Spring

46 7080

LOGARITHMIC 2 X 1 CYCLES
KEUFFEL & ESSER CO. MADE IN U.S.A.

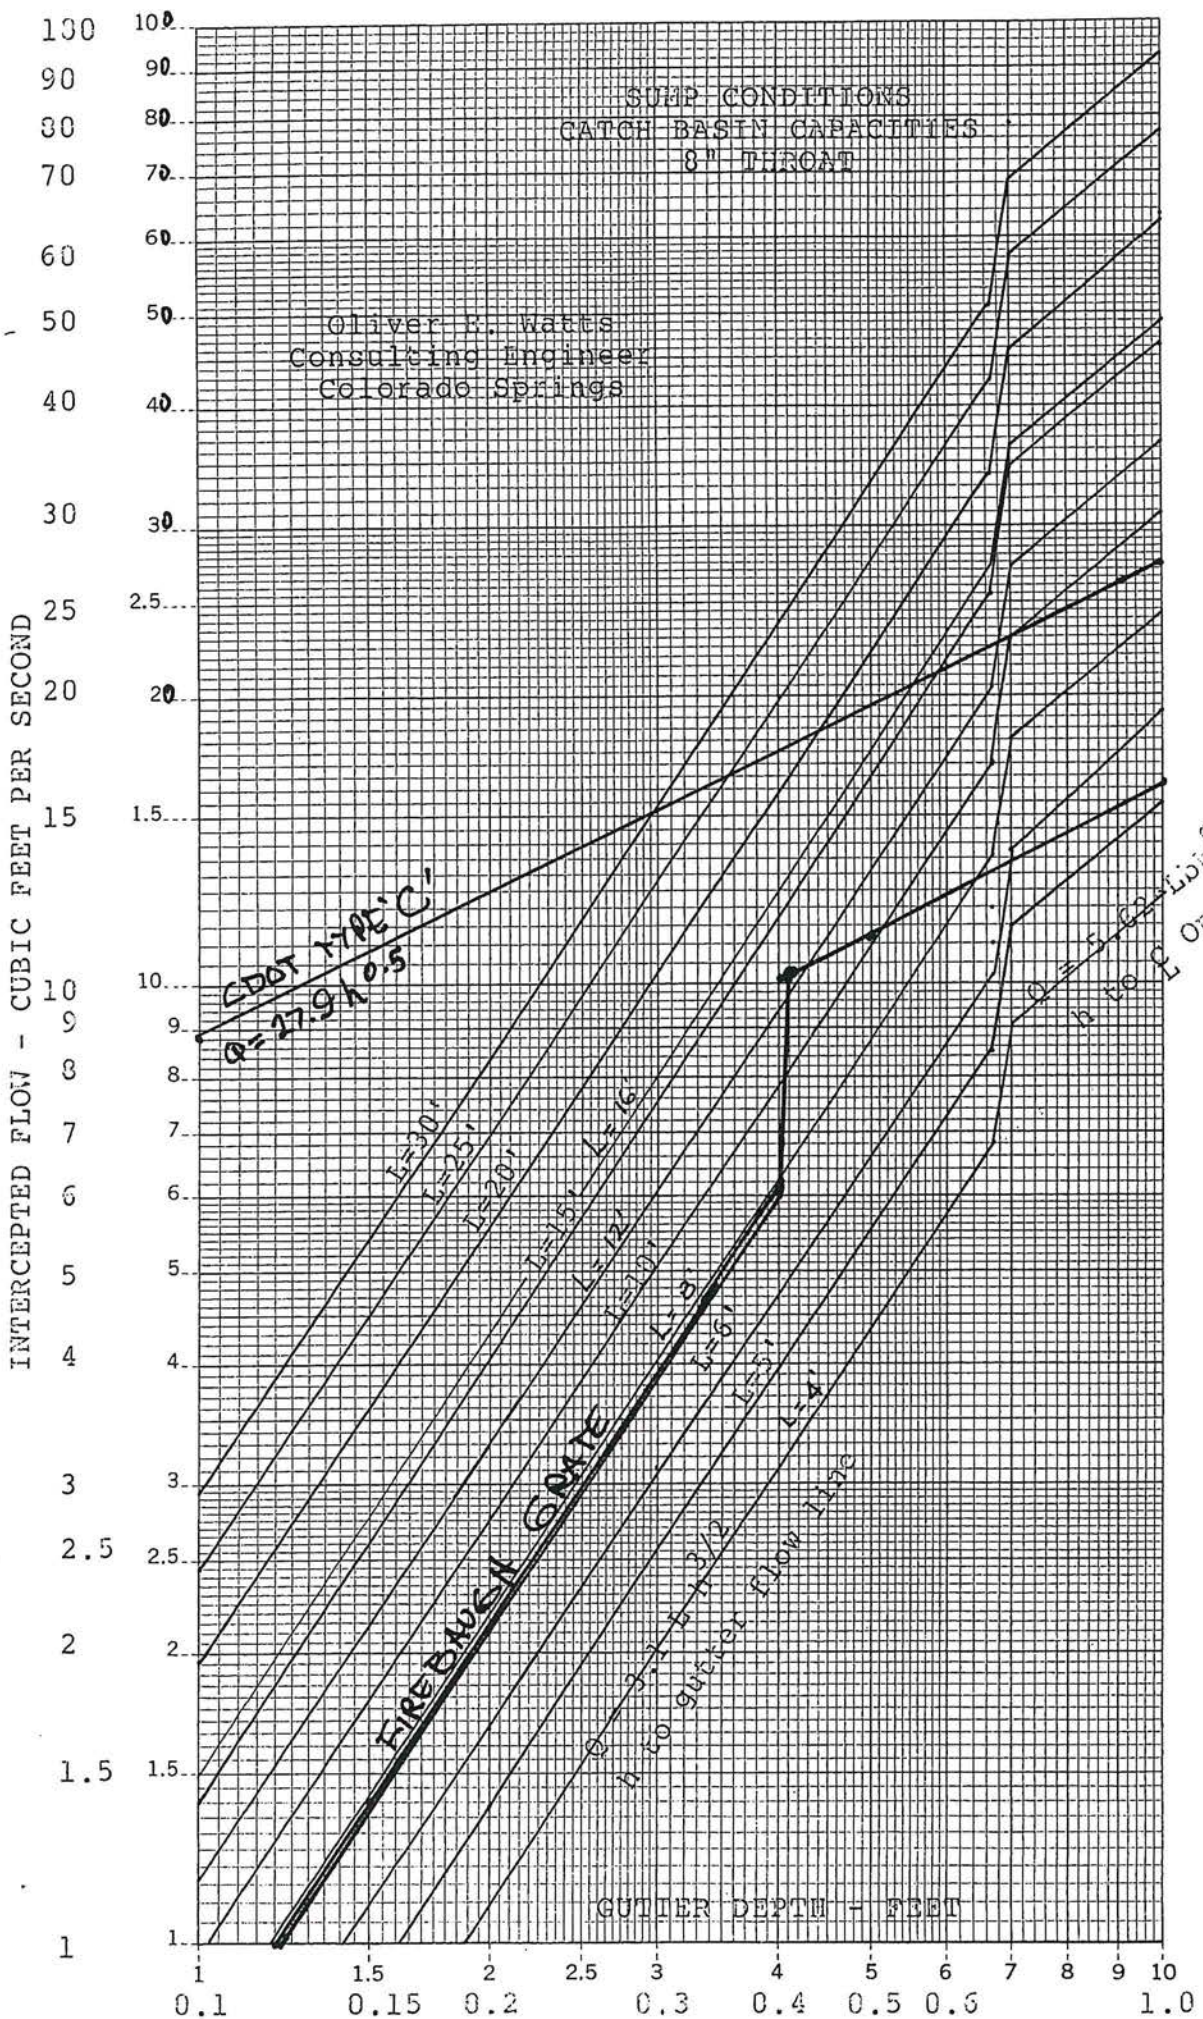

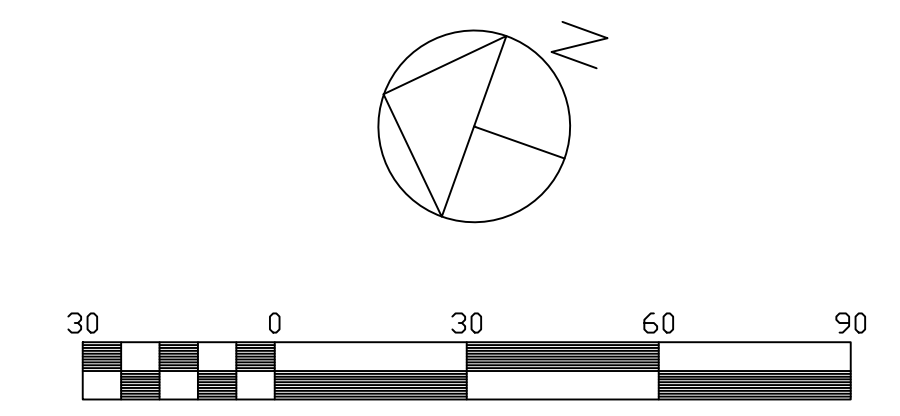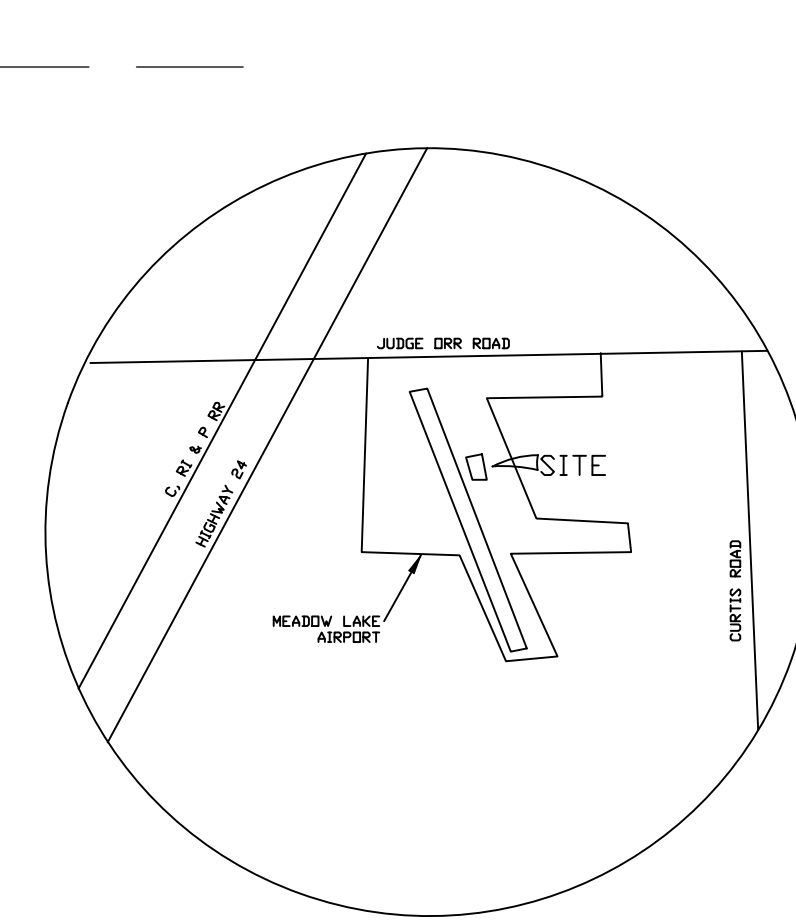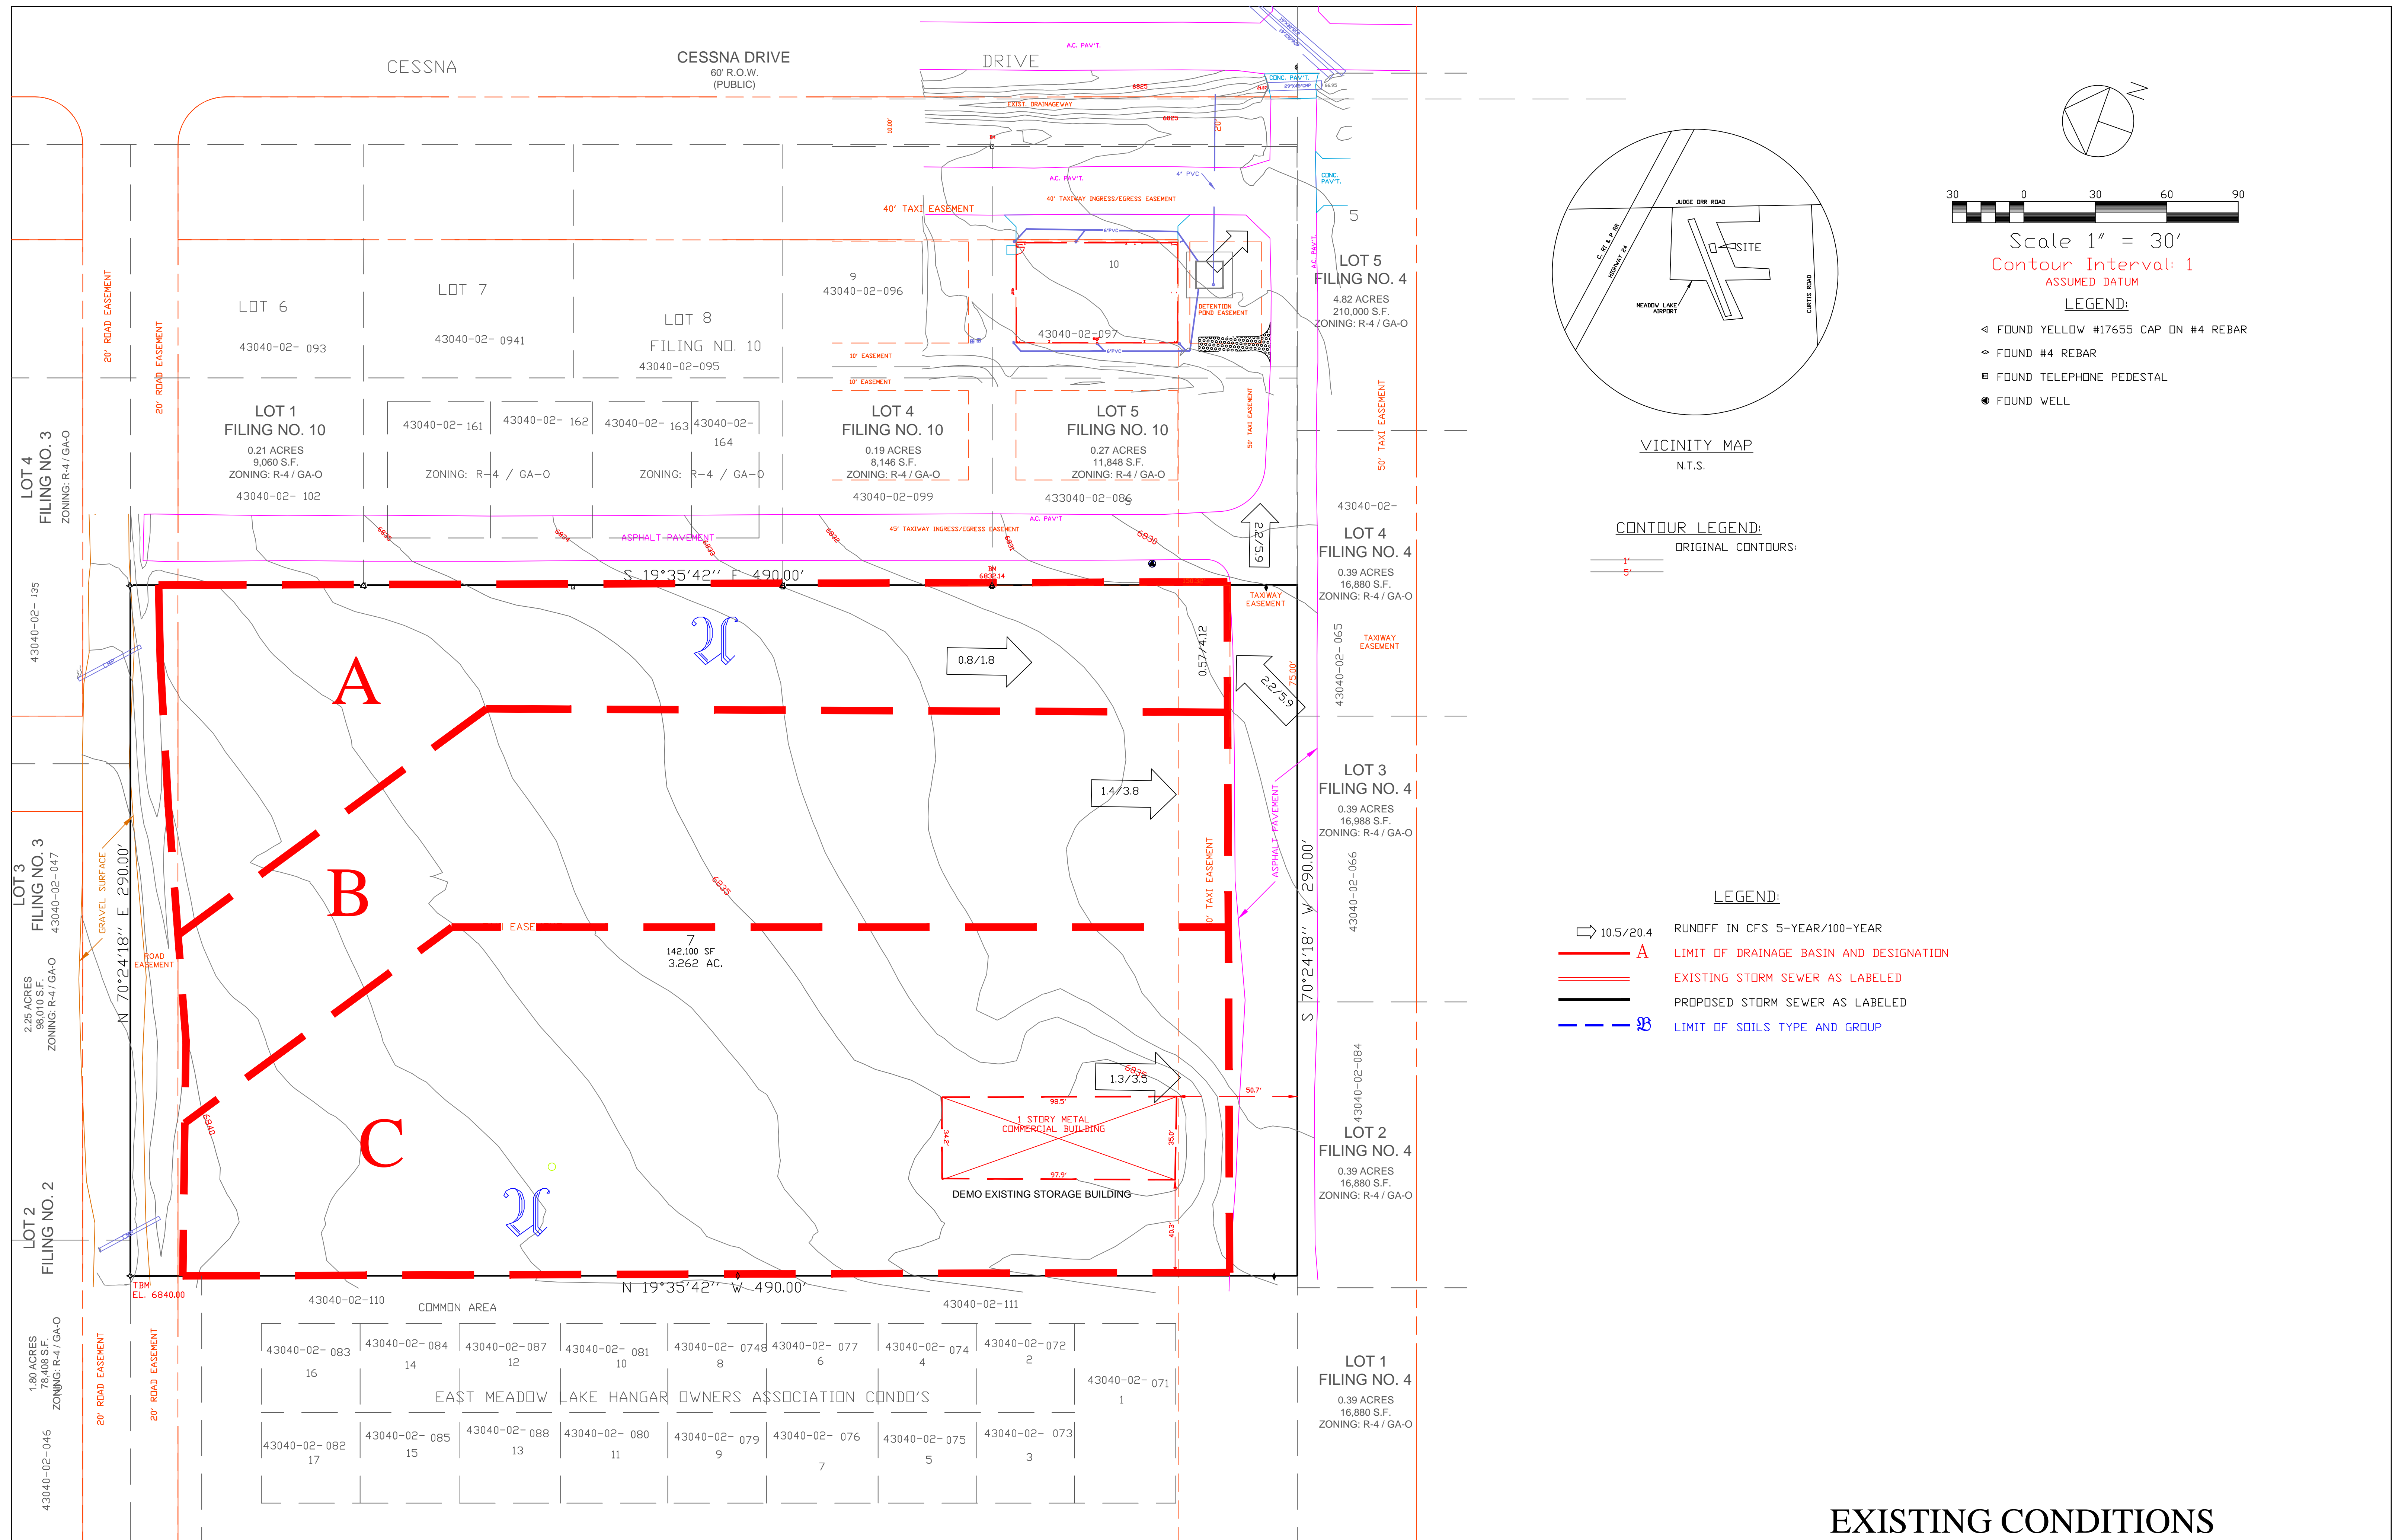

- LEGEND:**
- ◁ FOUND YELLOW #17655 CAP ON #4 REBAR
 - ◇ FOUND #4 REBAR
 - FOUND TELEPHONE PEDESTAL
 - FOUND WELL



CONTOUR LEGEND:
 ORIGINAL CONTOURS:
 1' ———
 5' ———

- LEGEND:**
- ⇨ 10.5/20.4 RUNOFF IN CFS 5-YEAR/100-YEAR
 - A — LIMIT OF DRAINAGE BASIN AND DESIGNATION
 - — — EXISTING STORM SEWER AS LABELED
 - — — PROPOSED STORM SEWER AS LABELED
 - B — LIMIT OF SOILS TYPE AND GROUP


EXISTING CONDITIONS

DRAWN BY: D.E. WATTS DATE: 7-9-21 DWG. NO.: 210-5498-03 SURVEYED BY: DEV. ES.V. 8-14-20	APPROVED BY: PROJ. NO.: DWG.	REVISIONS	OLIVER E. WATTS CONSULTING ENGINEER COLORADO SPRINGS	PROJECT 8140 CESSNA DRIVE LOT 7, BLOCK 1, MEADOW LAKE AIRPORT FIL. NO. 2 EL PASO COUNTY	SHIT. NO. 1 OF 1
--------------------------------------------------------------------------------------------------	------------------------------------	-----------	------------------------------------------------------------	-----------------------------------------------------------------------------------------------------	---------------------

provide calcs for existing drainage ditch capacities and proposed flows

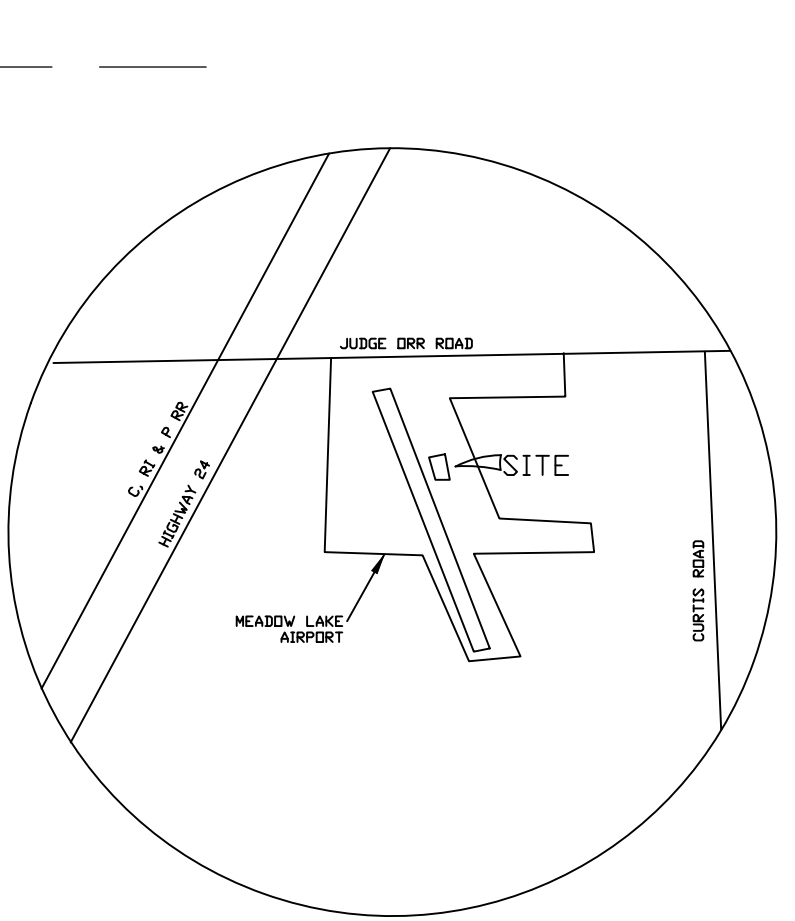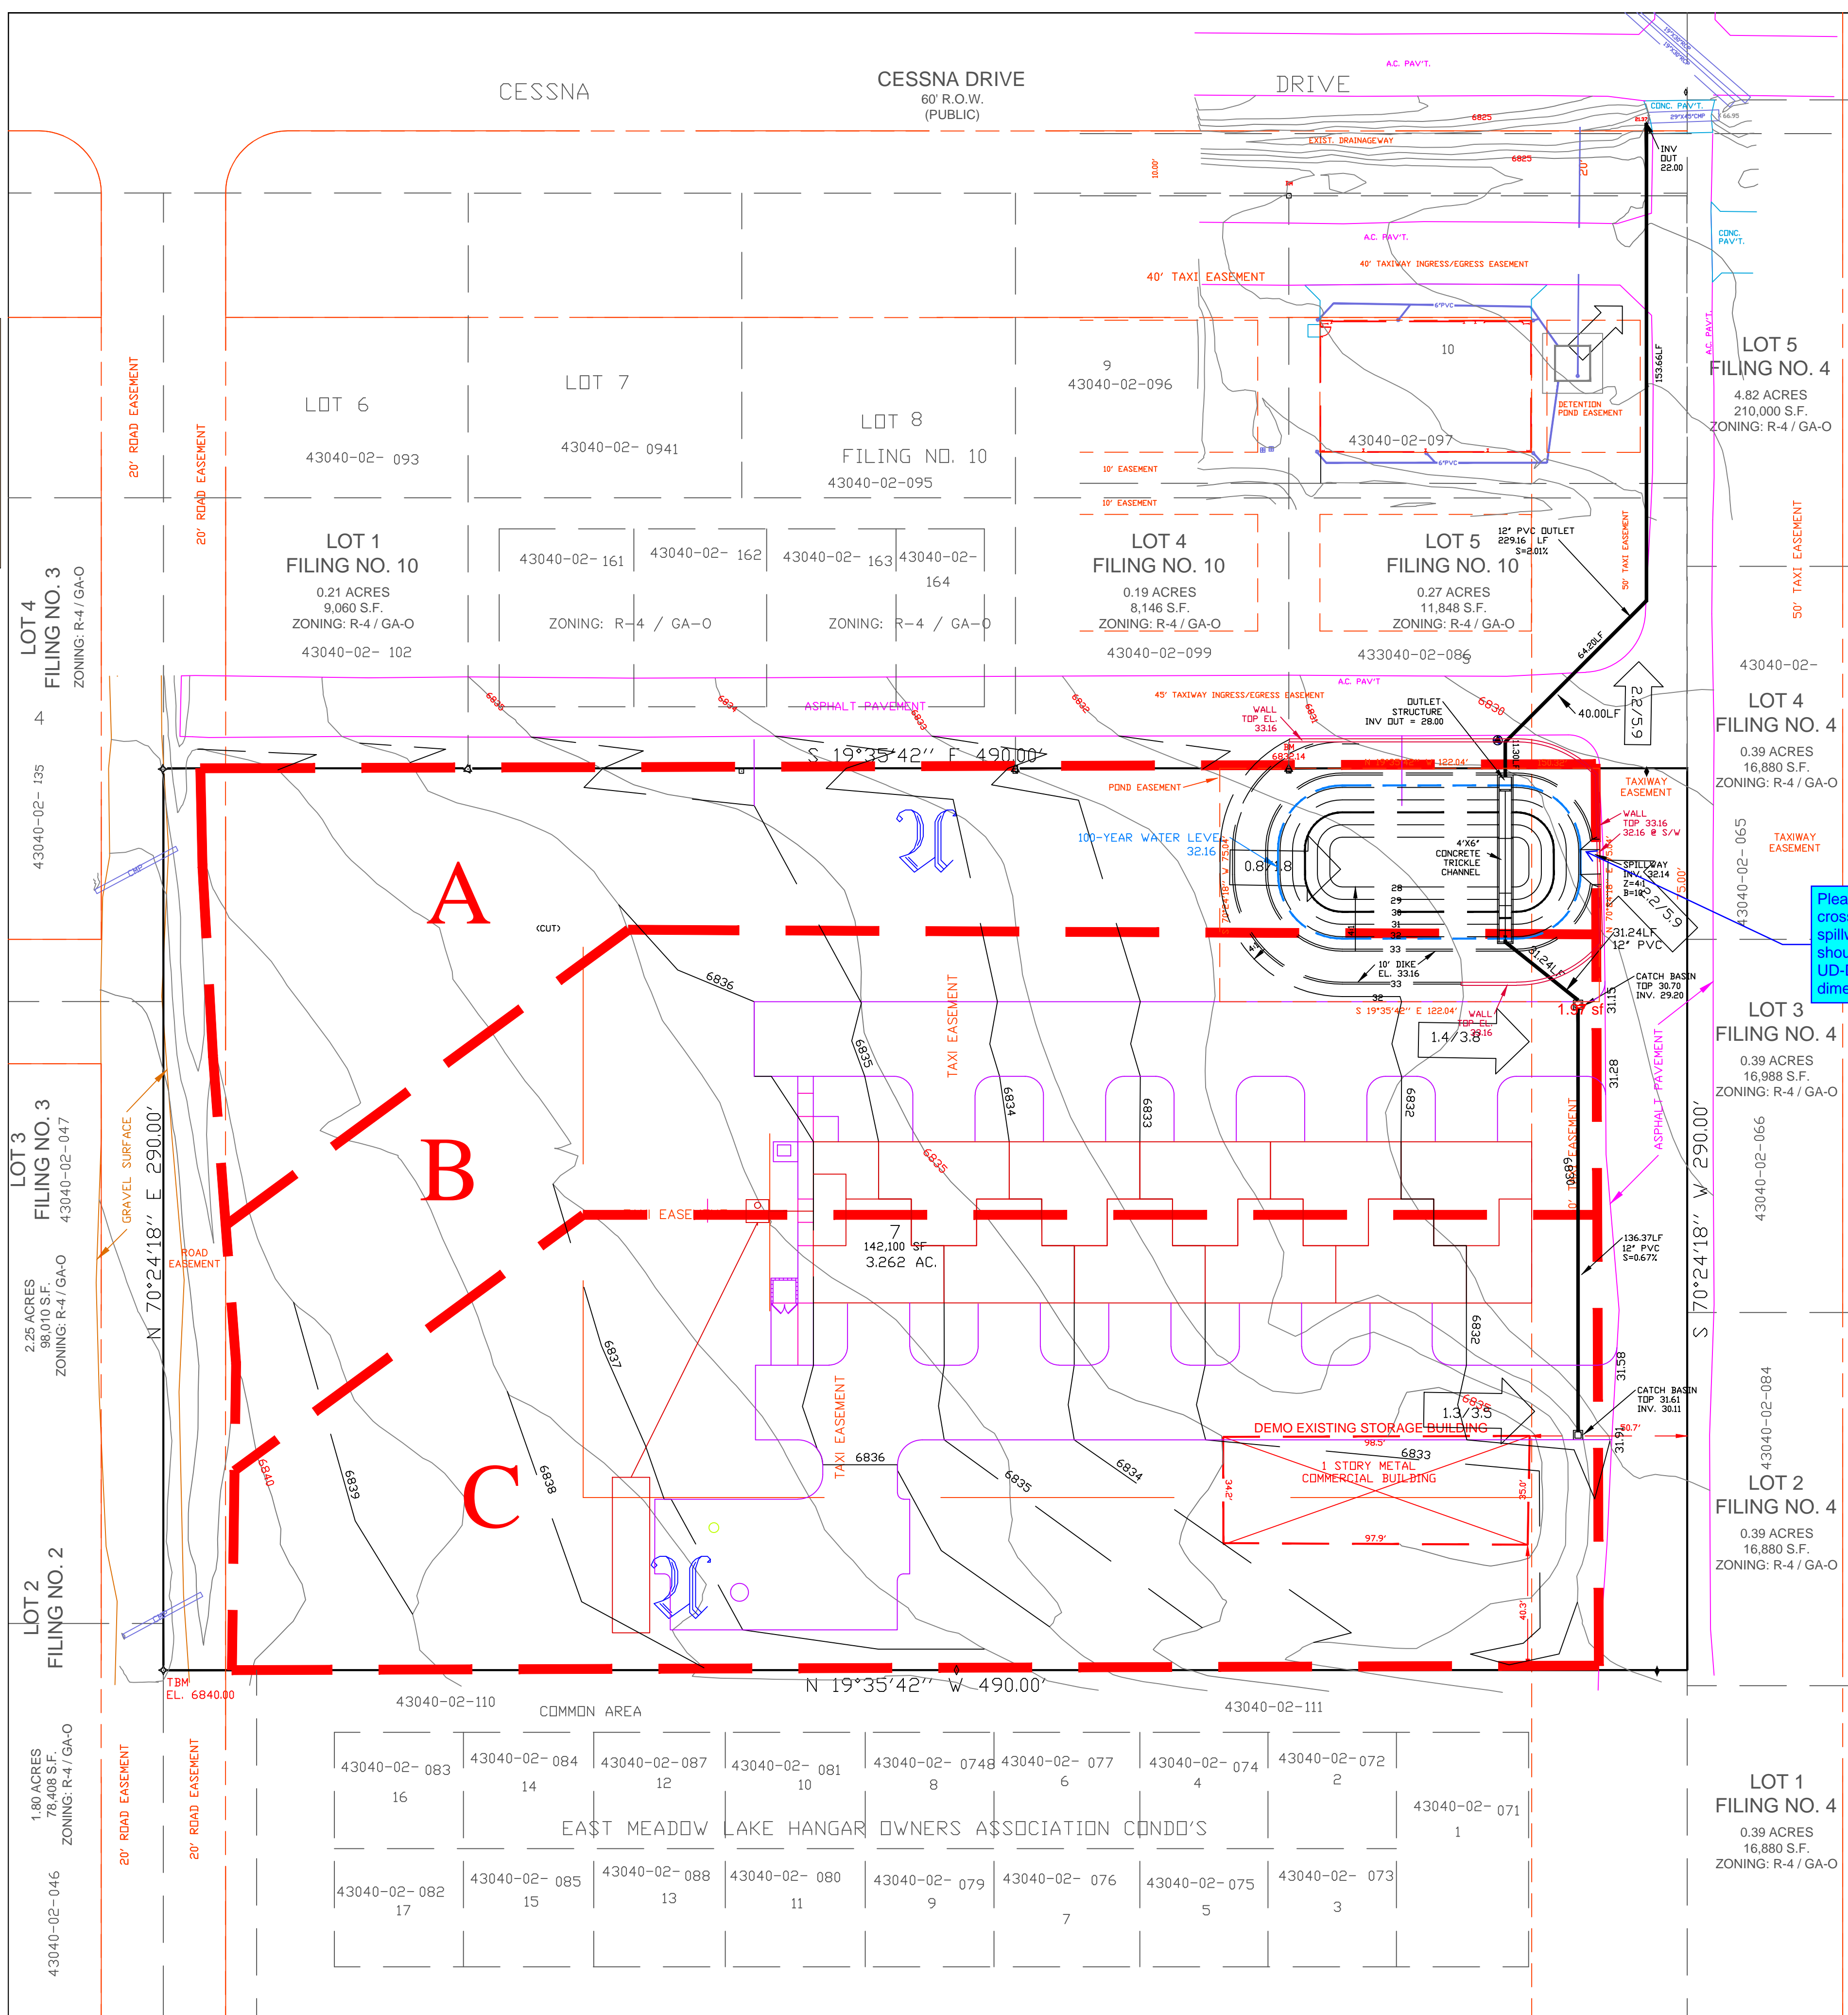

VICINITY MAP
N.T.S.

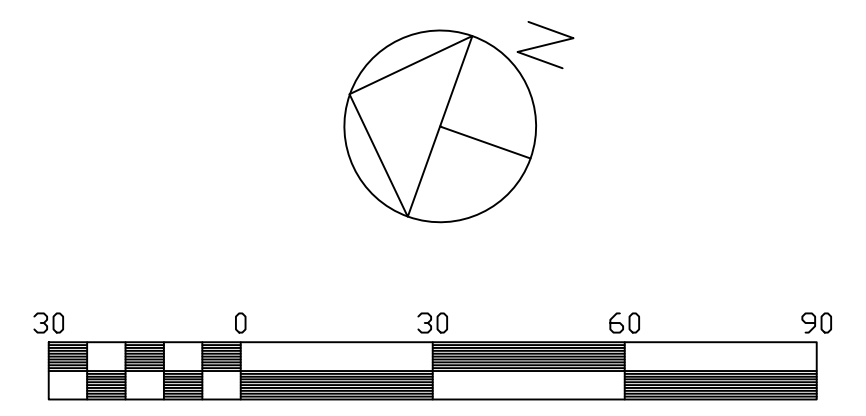


Scale 1" = 30'
Contour Interval: 1'
ASSUMED DATUM


- LEGEND:
- ◁ FOUND YELLOW #17655 CAP ON #4 REBAR
 - ◇ FOUND #4 REBAR
 - FOUND TELEPHONE PEDESTAL
 - FOUND WELL

CONTOUR LEGEND:

- ORIGINAL CONTOURS:
- FINISH CONTOURS:

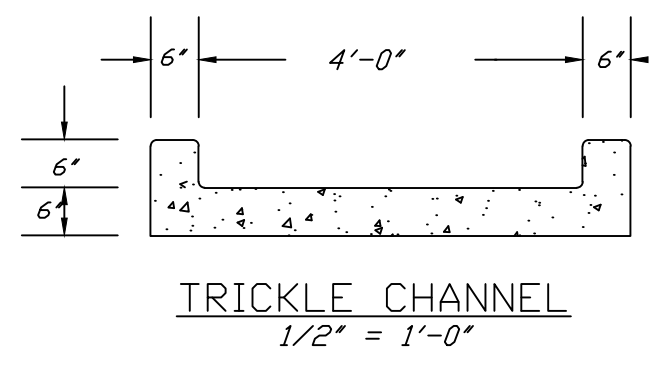

TRICKLE CHANNEL
1/2" = 1'-0"

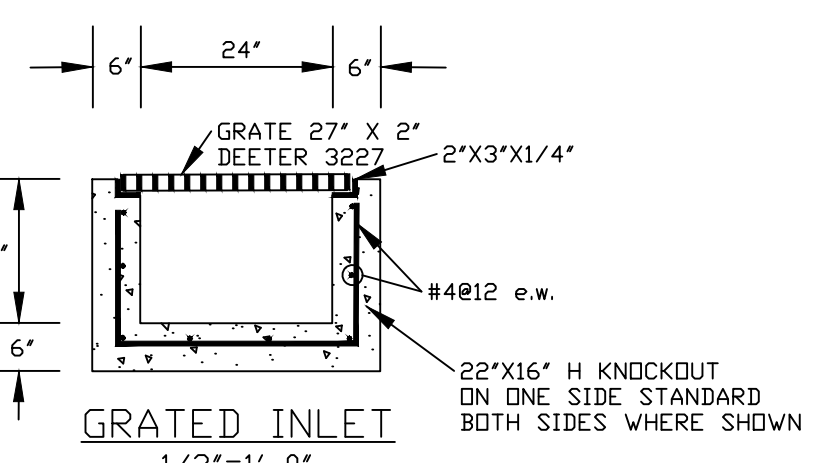


GRATED INLET
1/2" = 1'-0"
INLETS SHALL CONFORM TO FIREBAUGH PRECAST CO. STD. INLET OR EQUAL

- 10.5/20.4 RUNOFF IN CFS 5-YEAR/100-YEAR
- A LIMIT OF DRAINAGE BASIN AND DESIGNATION
- EXISTING STORM SEWER AS LABELED
- PROPOSED STORM SEWER AS LABELED
- B LIMIT OF SOILS TYPE AND GROUP


Please provide a cross section of the spillway. Dimensions should match UD-Detention input dimensions.

DRAWN BY: D.E. WATTS DATE: 7-9-21 DWG. NO.: 20-5498-05 SURVEYED BY: DEV. ES.V. 8-14-20	APPROVED BY: PROJ. NO.: DWG.	REVISIONS	OLIVER E. WATTS CONSULTING ENGINEER COLORADO SPRINGS	PROJECT 8140 CESSNA DRIVE LOT 7, BLOCK 1, MEADOW LAKE AIRPORT FIL. NO. 2 EL PASO COUNTY	SHEET NO. DRAINAGE PLAN 1 OF 1
-------------------------------------------------------------------------------------------------	------------------------------------	-----------	------------------------------------------------------------	-----------------------------------------------------------------------------------------------------	---------------------------------------------

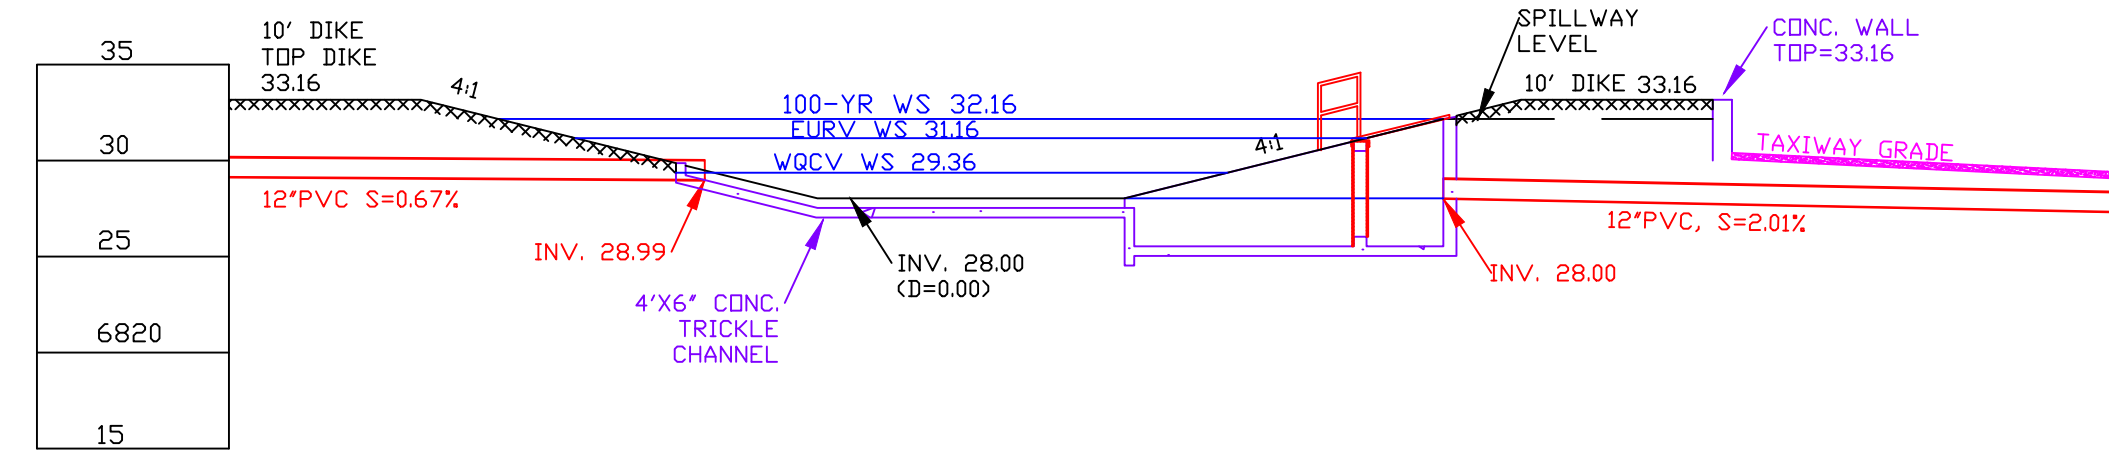


OUTLET WORKS SECTION

1"=10'

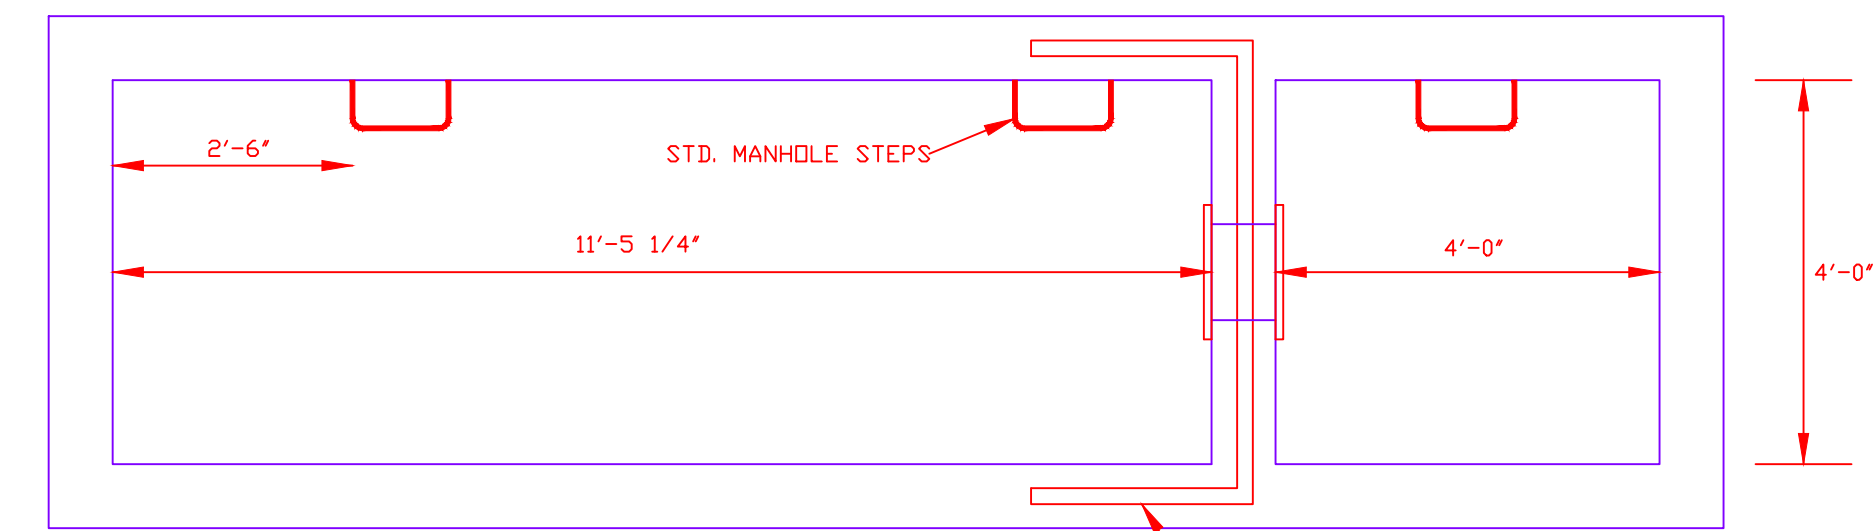

PLAN

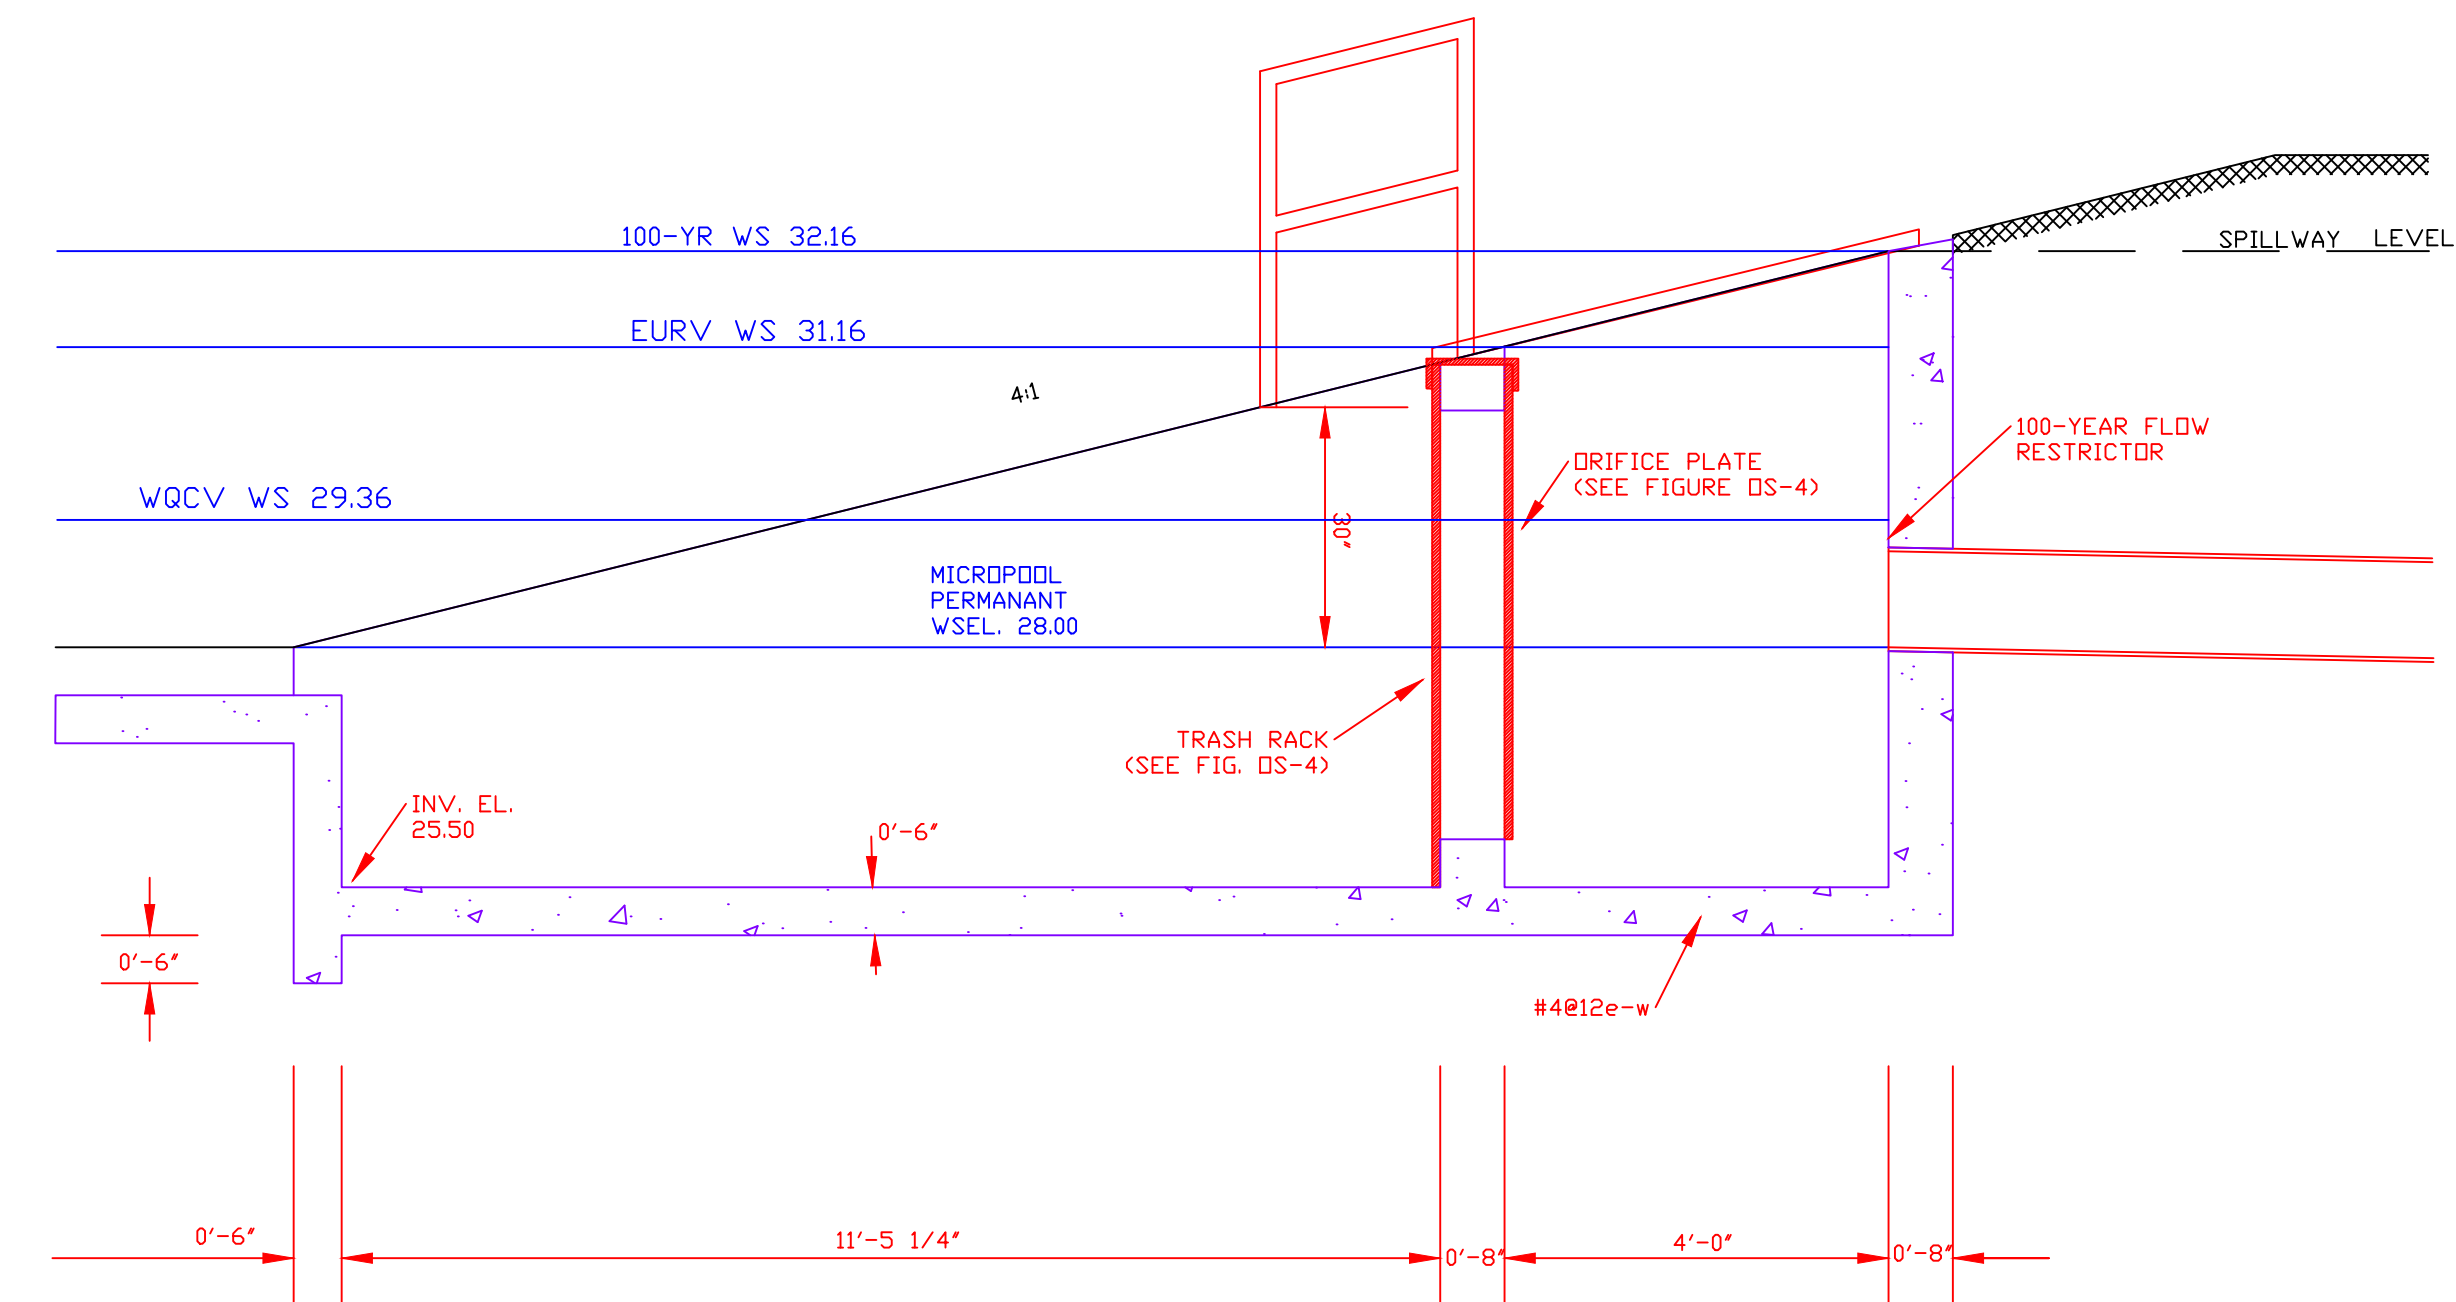

PROFILE

OUTLET WORKS

1/2"=1'-0"

NOTE:
ALL TRASH RACKS SHOULD BE
SIZED PER FIGURE OS-1


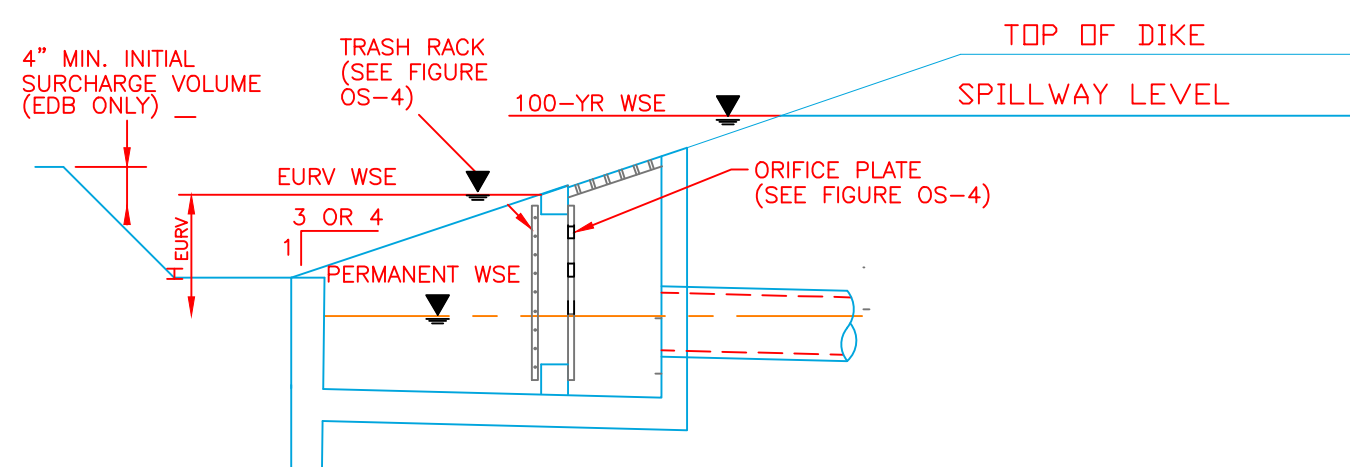


FIGURE OS-2 TYPICAL OUTLET STRUCTURE
FOR FULL SPECTRUM DETENTION

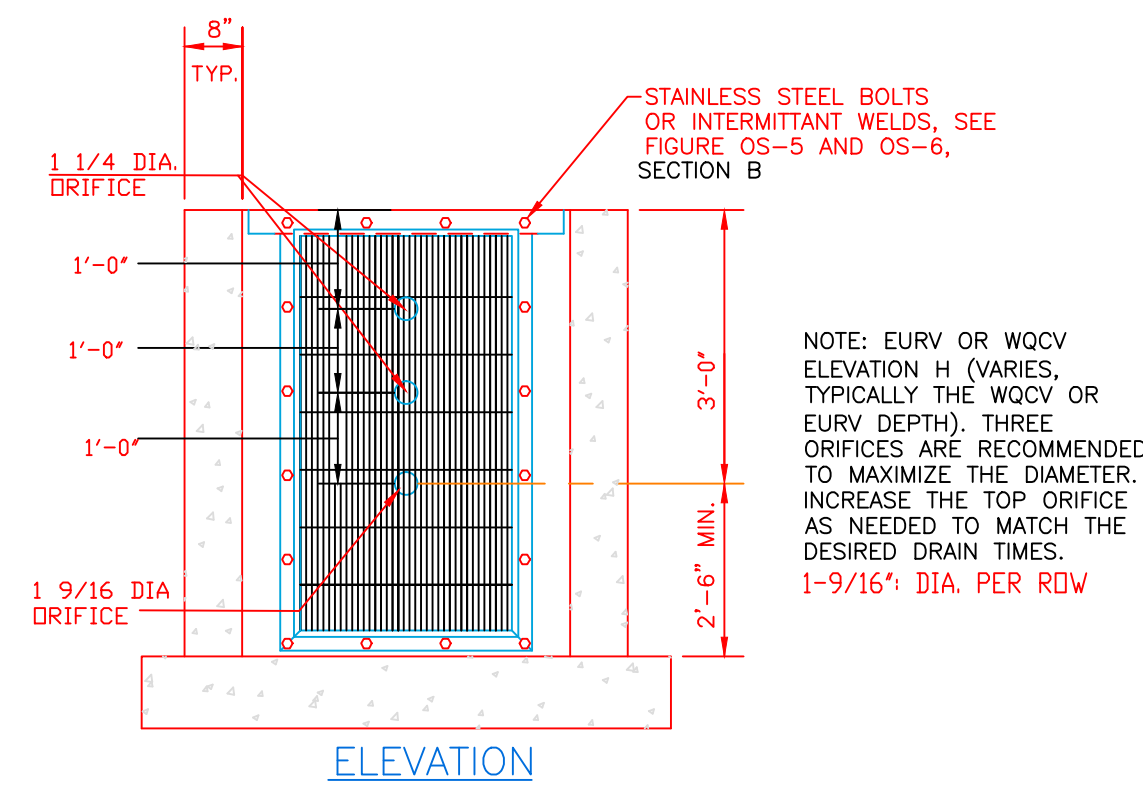

ORIFICE PLATE NOTES:

1. PROVIDE CONTINUOUS NEOPRENE GASKET MATERIAL BETWEEN THE ORIFICE PLATE AND CONCRETE.
2. BOLT PLATE TO CONCRETE 12" ON CENTER MAX.

EURV AND WQCV TRASH RACKS:


1. WELL-SCREEN TRASH RACKS SHALL BE STAINLESS STEEL AND SHALL BE ATTACHED BY INTERMITTENT WELDS ALONG THE EDGE OF THE MOUNTING FRAME.
2. BAR GATE TRASH RACKS SHALL BE ALUMINUM AND SHALL BE BOLTED USING STAINLESS STEEL HARDWARE.
3. TRASH RACK OPEN AREAS ARE FOR SPECIFIED TRASH RACK MATERIALS. TOTAL TRASH RACK SIZE MAY NEED TO BE ADJUSTED FOR MATERIALS HAVING DIFFERENT OPEN AREA/GROSS AREA RATIO (R VALUE).
4. STRUCTURAL DESIGN OF TRASH RACKS SHALL BE BASED ON FULL HYDROSTATIC HEAD WITH ZERO HEAD DOWNSTREAM OF THE RACK.

OVERFLOW SAFETY GRATES:


1. ALL SAFETY GRATES SHALL BE MOUNTED USING STAINLESS STEEL HARDWARE AND PROVIDED WITH HINGED AND LOCKABLE OR BOLTABLE ACCESS PANELS.
2. SAFETY GRATES SHALL BE STAINLESS STEEL, ALUMINUM, OR STEEL. STEEL GRATES SHALL BE HOT DIP GALVANIZED AND MAY BE HOT POWDER COATED AFTER GALVANIZING.
3. SAFETY GRATES SHALL BE DESIGNED SUCH THAT THE DIAGONAL DIMENSION OF EACH OPENING IS SMALLER THAN THE DIAMETER OF THE OUTLET PIPE.
4. STRUCTURAL DESIGN OF SAFETY GRATES SHALL BE BASED ON FULL HYDROSTATIC HEAD WITH ZERO HEAD DOWNSTREAM OF THE RACK.

FIGURE OS-4 ORIFICE PLATE AND TRASH RACK
DETAILS AND NOTES

NTS

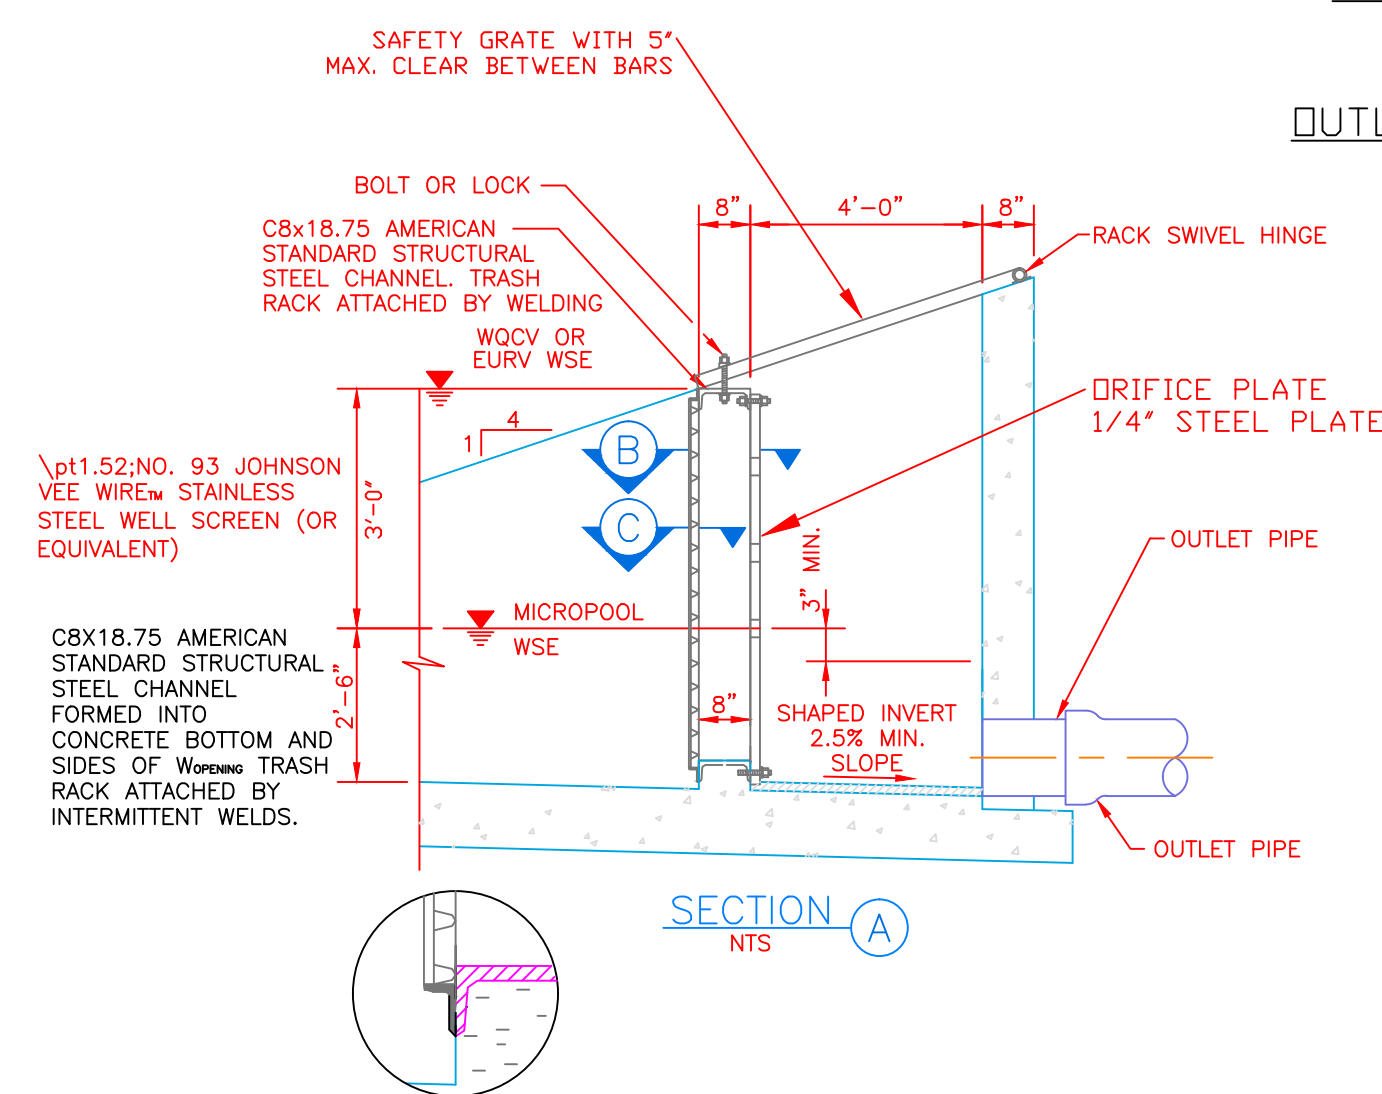

SECTION A
NTS

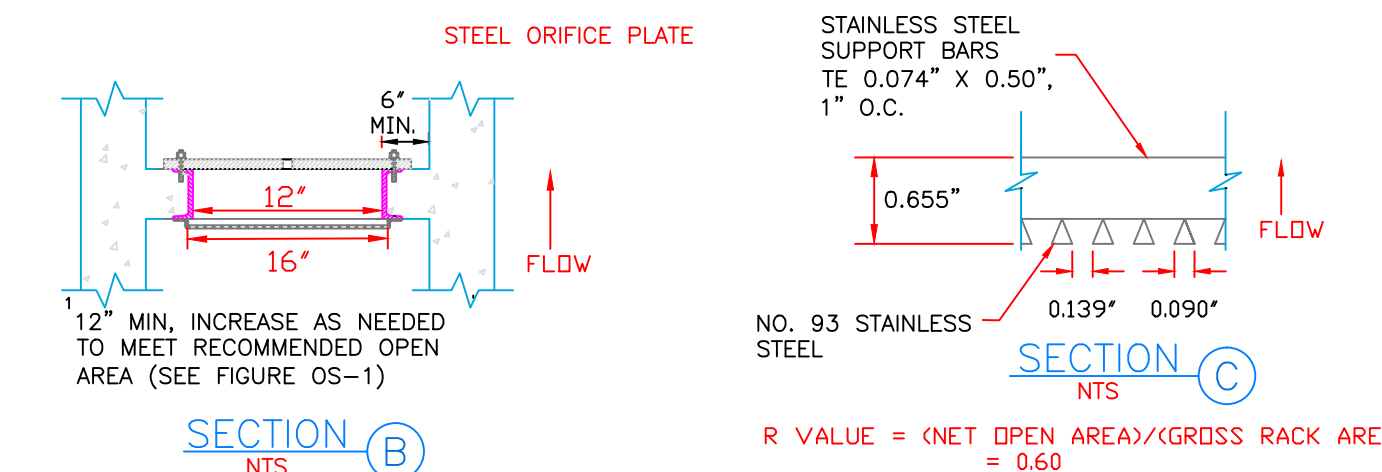

SECTION B
NTS

SECTION C
NTS

FIGURE OS-5 TYPICAL OUTLET STRUCTURE
WITH WELL SCREEN TRASH RACK

OLIVER E. WATTS
CONSULTING ENGINEER
COLORADO SPRINGS

PROJECT
8140 CESSNA DRIVE
LOT 7, BLOCK 1, MEADOW LAKE
AIRPORT FILING NO. 2
EL PASO COUNTY

SHT. NAME
EDB OUTLET DETAILS

SHT. NO.
2
OF
5


DRAWN BY: O.E. WATTS
DATE: 11-8-21
DWG. NO.: 20-5498-08

APPROVED BY:
PROJ. NO.
DWG.

REVISIONS

Drainage Report - Final_V2_Comments.pdf Markup Summary


Area Measurement (1)

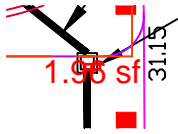

Subject: Area Measurement
Page Label: 29
Author: lpackman
Date: 12/30/2021 8:26:48 AM
Status:
Color: ■
Layer:
Space:

1.97 sf

Callout (4)

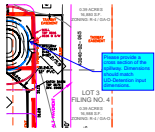


Subject: Callout
Page Label: 29
Author: lpackman
Date: 12/30/2021 10:32:45 AM
Status:
Color: ■
Layer:
Space:

Please provide a cross section of the spillway. Dimensions should match UD-Detention input dimensions.




Subject: Callout
Page Label: 14
Author: lpackman
Date: 12/30/2021 10:49:34 AM
Status:
Color: ■
Layer:
Space:

Please include impervious amounts for future hangars that are shown in the site development plan, it appears that it is more than 50%.

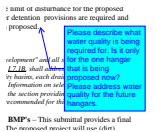

Subject: Callout
Page Label: 7
Author: lpackman
Date: 12/30/2021 10:59:37 AM
Status:
Color: ■
Layer:
Space:

Please describe what water quality is being required for. Is it only for the one hangar that is being proposed now? Please address water quality for the future hangars.

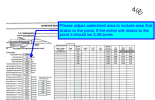

Subject: Callout
Page Label: 14
Author: lpackman
Date: 12/30/2021 8:09:47 AM
Status:
Color: ■
Layer:
Space:


Please adjust watershed area to include area that drains to the pond. If the entire site drains to the pond it should be 3.26 acres.

Cloud+ (3)




Subject: Cloud+
Page Label: 16
Author: lpackman
Date: 12/29/2021 3:42:34 PM
Status:
Color: ■
Layer:
Space:

Please fill out.

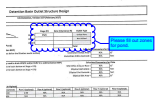

Subject: Cloud+
Page Label: 16
Author: lpackman
Date: 12/30/2021 9:25:42 AM
Status:
Color: ■
Layer:
Space:


Please fill out zones for pond.

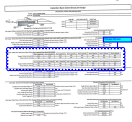

Subject: Cloud+
Page Label: 16
Author: lpackman
Date: 12/30/2021 9:26:30 AM
Status:
Color: ■
Layer:
Space:

Please fill out.



Engineer (1)

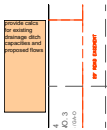

Subject: Engineer
Page Label: 29
Author: dotprete
Date: 1/2/2022 11:45:12 AM
Status:
Color: ■
Layer:
Space:

provide calcs for existing drainage ditch capacities and proposed flows

 Text Box (1)

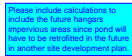

Subject: Text Box
Page Label: 12
Author: lpackman
Date: 12/30/2021 10:53:24 AM
Status:
Color: ■
Layer:
Space:

Please include calculations to include the future hangars impervious areas since pond will have to be retrofitted in the future in another site development plan.