



SIGN PACKAGE

DATE: 02.22.22

REQUISITE CHECKLIST

ALL REQUIREMENTS MUST BE MET BEFORE BEING RELEASED TO PRODUCTION

SURVEY

ALL VECTOR AND / OR HIGH RESOLUTION ART

*DATE CHECKED (Designer name): Joe Example 11.16.21

ART CONFIRMED BY

XXX 10.16.21


ALL PAINT / VINYL / PRINT COLORS (CMYK or PMS) /
ALL STONE, BRICK, VENEER, AND FINISHES

DESIGNER NOTES

- NOTES (art received / remaining, etc.)
- NOTES
- NOTES
RED LINE OVER TITLE BLOCK ON DRAWING PAGES INDICATES DRAWING IS NOT READY FOR PRODUCTION - ALL TBD ITEMS MUST BE RESOLVED.

SITEPLAN

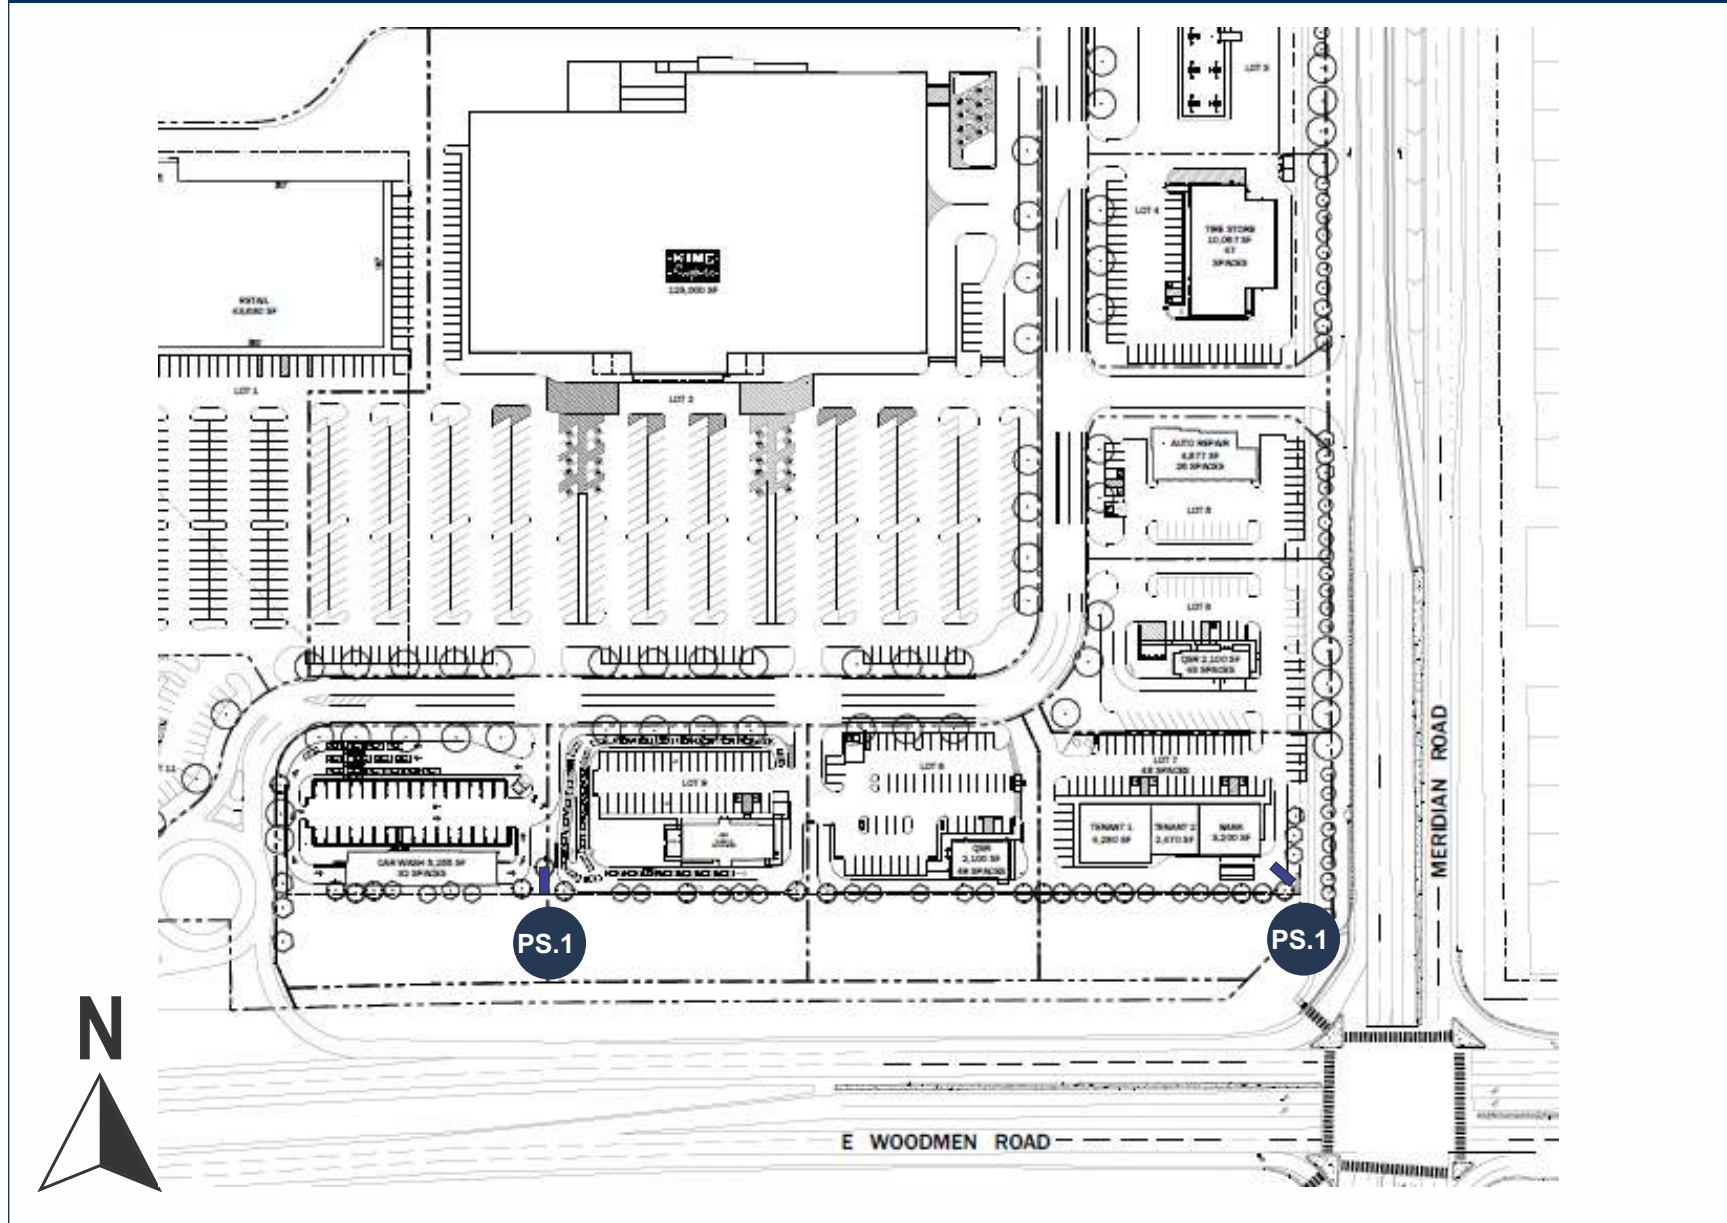

N.T.S.

WORK SCOPE

PS.1 D/F INTERNALLY LIT CABINET SIGN (QTY 2)

CODE ALLOWANCE

CODE INFORMATION...

REV.	DATE	BY	DESCRIPTION
1	00.00.00	XX	XXXX
2	00.00.00	XX	XXXX
3	00.00.00	XX	XXXX
4	00.00.00	XX	XXXX
5	00.00.00	XX	XXXX
6	00.00.00	XX	XXXX
7	00.00.00	XX	XXXX
8	00.00.00	XX	XXXX
9	00.00.00	XX	XXXX
10	00.00.00	XX	XXXX

CLIENT APPROVAL	DATE
LANDLORD APPROVAL	DATE

PS.1 D/F INTERNALLY LIT PYLON SIGN (Qty 2) - PART NUMBER

SQUARE FOOTAGE: 300

SURVEY REQUIRED
VECTOR ART REQUIRED



NIGHT VIEW
SCALE: NTS

SPECIFICATIONS


- FABRICATED ALUMINUM PYLON PAINTED AS INDICATED
- INTERNALLY ILLUMINATED W/7100K WHITE LEDS
- FUEL PRICING MODULES TO BE PROVIDED BY "KING SOOPERS"

NOTES

COLORS / FINISHES

- P-1 MP DARK GREY TBD
- P-2 SATIN ALUMINUM - SATIN FINISH
- V-1 OPAQUE WHITE VINYL

FONTS
TBD

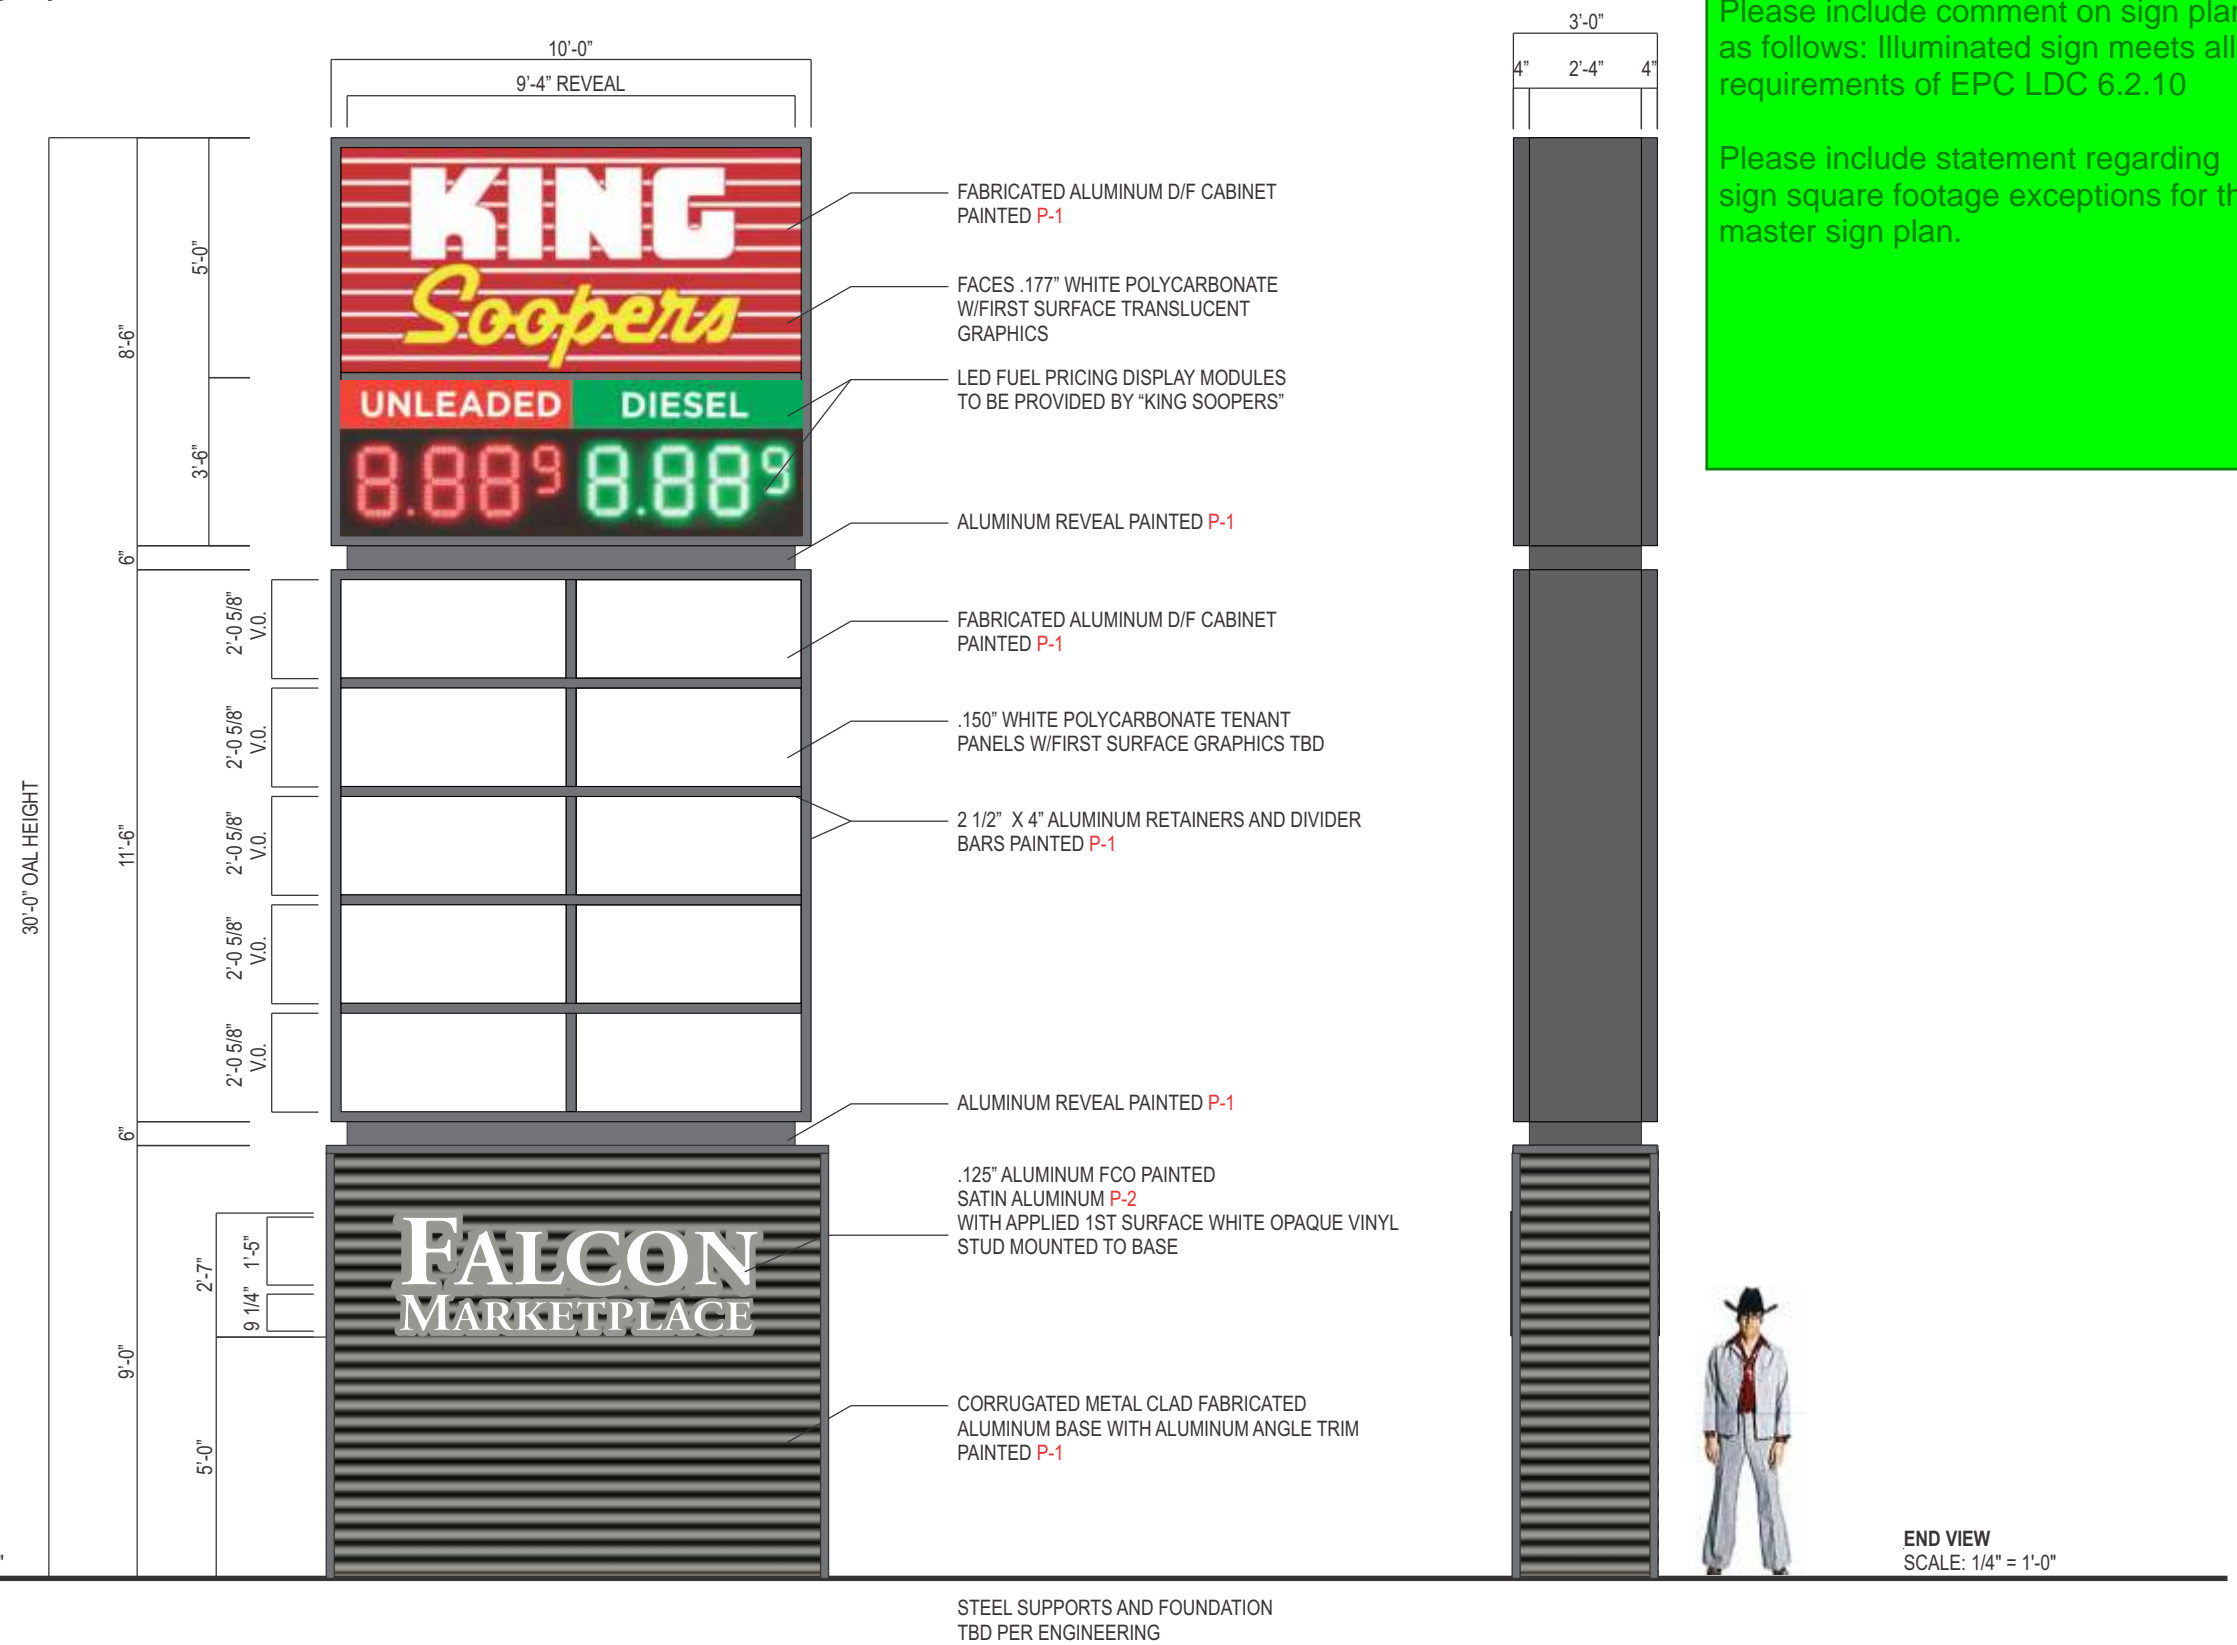

Please include comment on sign plan as follows: Illuminated sign meets all requirements of EPC LDC 6.2.10

Please include statement regarding sign square footage exceptions for the master sign plan.

<p>JONES SIGN Your Vision. Accomplished. <small>A MORTENSEN COMPANY</small></p>	<p>JOB #: 15968-R0</p> <p>DATE: 02.22.2022</p> <p>DESIGNER: S. Wiands</p> <p>SALES REP: R. Wilson</p> <p>PROJ MGR: N. Wallace</p>	<table border="1" style="width: 100%; border-collapse: collapse; font-size: 8px;"> <thead> <tr> <th>REV.</th> <th>DATE</th> <th>BY</th> <th>DESCRIPTION</th> </tr> </thead> <tbody> <tr><td>1</td><td>00.00.00</td><td>XX</td><td>XXXX</td></tr> <tr><td>2</td><td>00.00.00</td><td>XX</td><td>XXXX</td></tr> <tr><td>3</td><td>00.00.00</td><td>XX</td><td>XXXX</td></tr> <tr><td>4</td><td>00.00.00</td><td>XX</td><td>XXXX</td></tr> <tr><td>5</td><td>00.00.00</td><td>XX</td><td>XXXX</td></tr> <tr><td>6</td><td>00.00.00</td><td>XX</td><td>XXXX</td></tr> <tr><td>7</td><td>00.00.00</td><td>XX</td><td>XXXX</td></tr> <tr><td>8</td><td>00.00.00</td><td>XX</td><td>XXXX</td></tr> <tr><td>9</td><td>00.00.00</td><td>XX</td><td>XXXX</td></tr> <tr><td>10</td><td>00.00.00</td><td>XX</td><td>XXXX</td></tr> </tbody> </table>	REV.	DATE	BY	DESCRIPTION	1	00.00.00	XX	XXXX	2	00.00.00	XX	XXXX	3	00.00.00	XX	XXXX	4	00.00.00	XX	XXXX	5	00.00.00	XX	XXXX	6	00.00.00	XX	XXXX	7	00.00.00	XX	XXXX	8	00.00.00	XX	XXXX	9	00.00.00	XX	XXXX	10	00.00.00	XX	XXXX	<table border="1" style="width: 100%; border-collapse: collapse;"> <tr> <td style="width: 50%;">CLIENT APPROVAL</td> <td style="width: 50%;">DATE</td> </tr> <tr> <td style="height: 40px;"></td> <td></td> </tr> <tr> <td>LANDLORD APPROVAL</td> <td>DATE</td> </tr> </table>	CLIENT APPROVAL	DATE			LANDLORD APPROVAL	DATE		<p>Falcon Marketplace</p> <p>Meridian & Woodmen</p> <p>El Paso County, CO</p>	<p>SHEET NUMBER</p> <h1 style="font-size: 2em; margin: 0;">2.0</h1>
		REV.	DATE	BY	DESCRIPTION																																																			
1	00.00.00	XX	XXXX																																																					
2	00.00.00	XX	XXXX																																																					
3	00.00.00	XX	XXXX																																																					
4	00.00.00	XX	XXXX																																																					
5	00.00.00	XX	XXXX																																																					
6	00.00.00	XX	XXXX																																																					
7	00.00.00	XX	XXXX																																																					
8	00.00.00	XX	XXXX																																																					
9	00.00.00	XX	XXXX																																																					
10	00.00.00	XX	XXXX																																																					
CLIENT APPROVAL	DATE																																																							
LANDLORD APPROVAL	DATE																																																							

This is an original, unpublished drawing by Jones Sign Co., Inc. It is for your personal use in conjunction with a project being planned for you by JONES SIGN. It is not to be shown to anyone outside of your organization, nor is it to be used, reproduced, copied or exhibited in any fashion. Use of this design or the salient elements of this design in any sign done by any other company, without the express written permission of JONES SIGN, is forbidden by law and carries a civil forfeiture of up to 25% of the purchase price of the sign. JONES SIGN will endeavor to closely match colors, including PMS, where specified. We cannot guarantee exact matches due to varying compatibility of surface materials and paints used. All sizes and dimensions are illustrated for client's conception of project and are not to be understood as being exact size or exact scale.