

PREPARED ESPECIALLY FOR

CALIBER COLLISION

SITE # TBD
10706 MALTESE POINT
FALCON, CO 80831

YOUR PARTNER IN BUILDING AN **OUTSTANDING** IMAGE





DESIGN SIGN STATUS - MAIN ID WALL SIGNS			
SIGN #	LOCATION	SIGN TYPE	TECHNICALLY VERIFIED
1	NORTH ELEVATION	RELOCATE ILLUMINATED CHANNEL LETTERS ON R/W	X

DESIGN SIGN STATUS - FREESTANDING SIGNS			
2	MALTESE POINT	D/F MONUMENT SIGN - ILLUMINATED	

DESIGN SIGN STATUS - SECONDARY WALL SIGNS / DIRECTIONALS / PANELS			
3	SOUTH ELEVATION	CUSTOM - FCO LETTERS ON BACKER PANEL	X
4	WEST ELEVATION-TBD	RELOCATE PANEL SIGN PARTS DLVRY- NON-ILLUM	X

Please show distance of freestanding sign from property line.

Section 6.2.10.D.2.b.iii:
 "Low profile signs may be located in a setback area, but shall be located no closer than 3 feet from a lot line, parcel, or tract line."

Please show distance between proposed freestanding sign and existing freestanding sign within same commercial/industrial center. Google maps shows "Collision Center" sign on site, in between 10706 and 10682 Maltese.

Section 6.2.10.D.2.b.v:
 "No freestanding sign shall be closer than 500 feet to any other freestanding sign along the same road frontage if the signs are located in the same commercial center or industrial center"



SITE MAP/AERIAL VIEW
 SCALE: N.T.S.

DRAWING TYPE
 CONCEPTUAL TECHNICAL

REVISIONS	
1)	Updated Monument Type; Raised Sign #1
2)	Updated Sign #3
3)	
4)	

It is the intent and purpose of this color rendering to provide a basic color representation of your sign finish and color. However, digital media and printed colors will vary from actual paint finish and color. Existing painted surfaces will have a perceptible difference in shade and sheen from your sign finish. Providing a sample of the paint you wish to match or a Matthews paint color formula will minimize the differences.

<p>...bringing your image to light!</p> <p>16265 Star Rd., Nampa, ID 83687 - toll free: 800.592.8058 - tele: 208.345.4020 </p>	<p>NAMPA PLANT - UL #433195-001</p> <p><small>U.S. & P.R. - All signs conform to UL-48/2161 (labeled accordingly) & must comply with UL-41.1 install procedures. Canada - all signs must be CAS compliant. This sign(s) is intended to be installed in accordance with requirements of article 600 of the National Electrical Code and/or applicable local codes. This includes proper grounding and bonding of the sign.</small></p>	Client: CALIBER COLLISION	Design Number:	File Location: CCC-TBD-FalconCO-122722-R2	Page No.
		Site: # TBD 10706 MALTESE POINT FALCON, CO 80831	Date: 12/27/22		2 of 9
		Designer: Sb / RA	Account Manager: JG		

EXISTING CONDITIONS




NORTH ELEVATION @ 10778 MALTESE POINT

SCALE: NTS

ALLOWED SQ. FT.: 88.5

PROPOSED SQ. FT.: 68.5

PROPOSED CONDITIONS

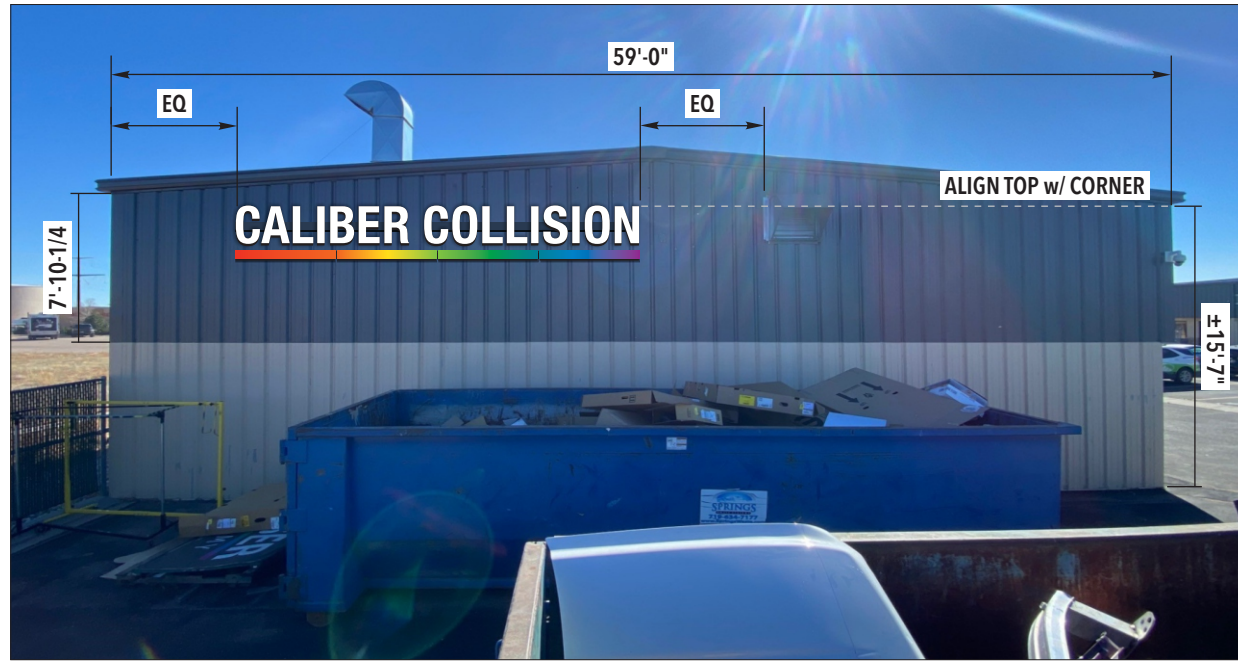

NORTH ELEVATION @ 10706 MALTESE POINT

SCALE: 3/32" = 1'-0"

GENERAL NOTES

RACEWAY WILL NEED TO BE PAINTED TO MATCH CORRUGATED BACKGROUND


CITY CODE & ALLOWANCES

1.5 SQ. FT. OF SIGN AREA AGGREGATE ALLOWED PER 1 LF. OF STREET FRONTAGE



SIMULATED NIGHT VIEW

SCALE: N.T.S.

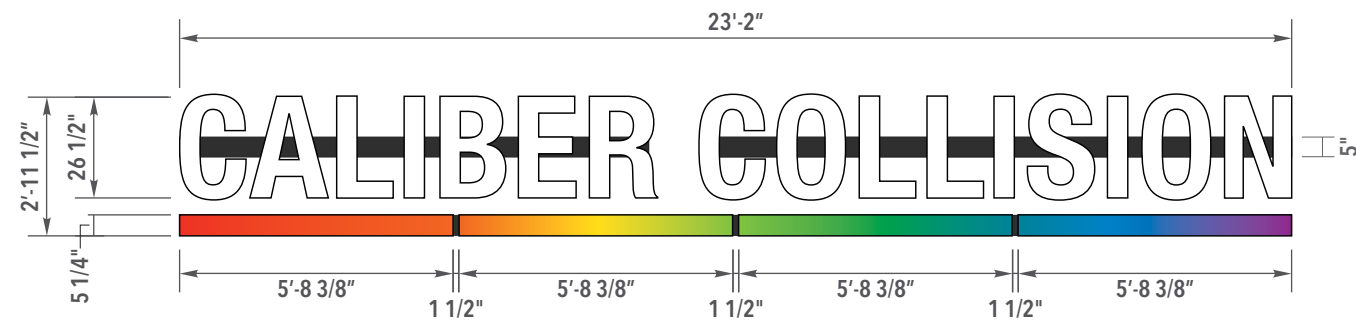

1 RELOCATE EXISTING ILLUMINATED CHANNEL LETTERS - RACEWAY
SCALE: 1/4" = 1'-0"

It is the intent and purpose of this color rendering to provide a basic color representation of your sign finish and color. However, digital media and printed colors will vary from actual paint finish and color. Existing painted surfaces will have a perceptible difference in shade and sheen from your sign finish. Providing a sample of the paint you wish to match or a Matthews paint color formula will minimize the differences.

<p>image national signs ...bringing your image to light!</p> <p>16265 Star Rd., Nampa, ID 83687 - toll free: 800.592.8058 - tele: 208.345.4020 imagenational.com</p>	<p>NAMPA PLANT - UL #433195-001</p> <p>U.S. & P.R. - All signs conform to UL-48/2161 (labeled accordingly) & must comply with UL-41.1 install procedures. Canada - all signs must be CAS compliant. This sign(s) is intended to be installed in accordance with requirements of article 600 of the National Electrical Code and/or applicable local codes. This includes proper grounding and bonding of the sign.</p>	<p>Client: CALIBER COLLISION</p>	<p>Design Number:</p>	<p>File Location: CCC-TBD-FalconCO-122722-R2</p>	<p>Page No.</p>
		<p>Site: # TBD 10706 MALTESE POINT FALCON, CO 80831</p>	<p>Date: 12/27/22</p> <p>Designer: Sb / RA</p> <p>Account Manager: JG</p>		<p>3 of 9</p>

PROPOSED CONDITIONS (EAST)



MONUMENT SIGN @ MALTESE POINT

SCALE: NTS
 ALLOWED SQ. FT.: 40.0
 PROPOSED SQ. FT.: 30.1

PROPOSED CONDITIONS (EAST)



GENERAL NOTES

NEW ELECTRICAL CIRCUIT REQUIRED
 LANDSCAPE REPAIRS AS NEEDED


CITY CODE & ALLOWANCES

1.5 SQ. FT. OF SIGN AREA AGGREGATE ALLOWED PER 1 LF. OF STREET FRONTAGE



SIMULATED NIGHT VIEW

SCALE: N.T.S.

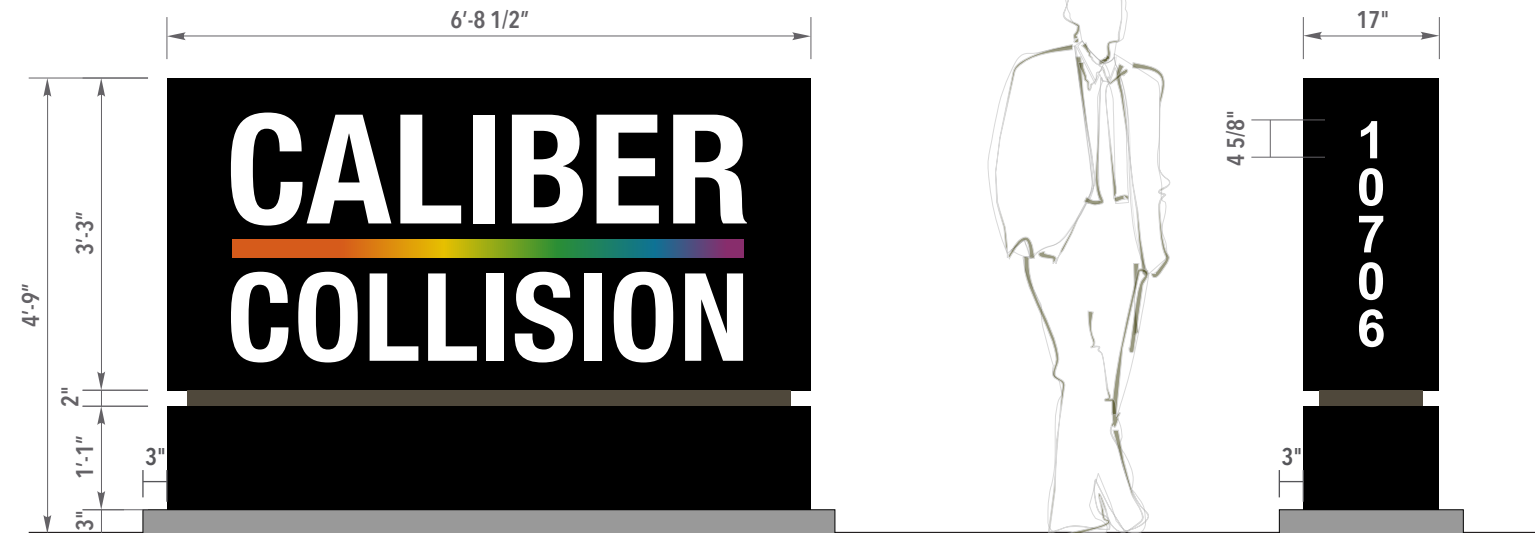

2 D/F ILLUMINATED MONUMENT SIGN
 SCALE: 1/2" = 1'-0"

It is the intent and purpose of this color rendering to provide a basic color representation of your sign finish and color. However, digital media and printed colors will vary from actual paint finish and color. Existing painted surfaces will have a perceptible difference in shade and sheen from your sign finish. Providing a sample of the paint you wish to match or a Matthews paint color formula will minimize the differences.

<p>image national signs ...bringing your image to light!</p> <p>16265 Star Rd., Nampa, ID 83687 - toll free: 800.592.8058 - tele: 208.345.4020 imagenational.com</p>	<p>NAMPA PLANT - UL #433195-001</p> <p><small>U.S. & P.R. - All signs conform to UL-48/2161 (labeled accordingly) & must comply with UL-41.1 install procedures. Canada - all signs must be CAS compliant. This sign(s) is intended to be installed in accordance with requirements of article 600 of the National Electrical Code and/or applicable local codes. This includes proper grounding and bonding of the sign.</small></p>	Client: CALIBER COLLISION	Design Number:	File Location: CCC-TBD-FalconCO-122722-R2	Page No.
		Site: # TBD 10706 MALTESE POINT FALCON, CO 80831	Date: 12/27/22 Designer: Sb / RA Account Manager: JG		4 of 9

PROPOSED CONDITIONS



SOUTH ELEVATION


SCALE: 1/16" = 1'-0"

ALLOWED SQ. FT.: 88.5
 PROPOSED SQ. FT.: 20.0

GENERAL NOTES

CITY CODE & ALLOWANCES

1.5 SQ. FT. OF SIGN AREA AGGREGATE ALLOWED PER 1 LF. OF STREET FRONTAGE

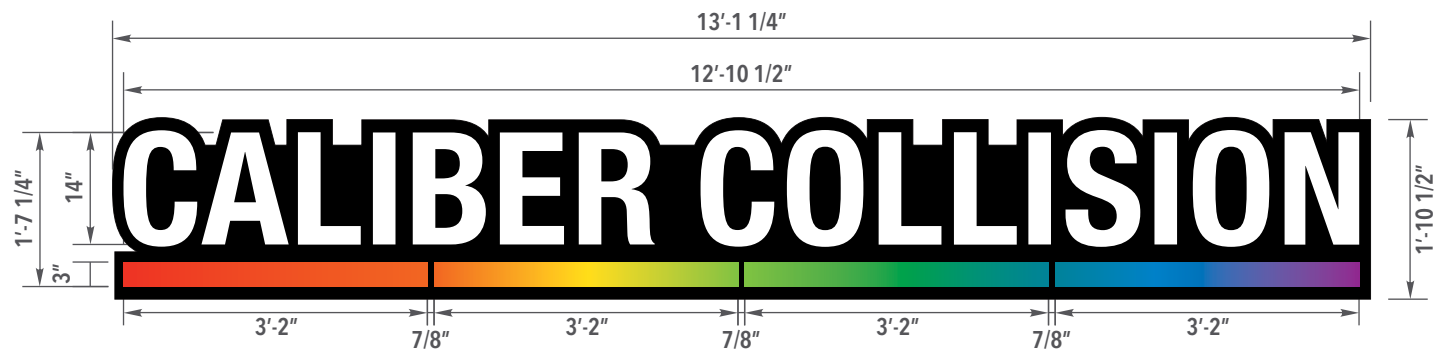

3 CUSTOM - FCO LETTERS ON BACKER PANEL
 SCALE: 3/4" = 1'-0"



It is the intent and purpose of this color rendering to provide a basic color representation of your sign finish and color. However, digital media and printed colors will vary from actual paint finish and color. Existing painted surfaces will have a perceptible difference in shade and sheen from your sign finish. Providing a sample of the paint you wish to match or a Matthews paint color formula will minimize the differences.

<p>image national signs ...bringing your image to light!</p> <p>16265 Star Rd., Nampa, ID 83687 - toll free: 800.592.8058 - tele: 208.345.4020 imagenational.com</p>	<p>NAMPA PLANT - UL #433195-001</p> <p>U.S. & P.R. - All signs conform to UL-48/2161 (labeled accordingly) & must comply with UL-41.1 install procedures. Canada - all signs must be CAS compliant. This sign(s) is intended to be installed in accordance with requirements of article 600 of the National Electrical Code and/or applicable local codes. This includes proper grounding and bonding of the sign.</p>	Client: CALIBER COLLISION	Design Number:	File Location: CCC-TBD-FalconCO-122722-R2	Page No.
		Site: # TBD 10706 MALTESE POINT FALCON, CO 80831	Date: 12/27/22 Designer: Sb / RA Account Manager: JG		5 of 9

EXISTING CONDITIONS



WEST ELEVATION @ 10778 MALTESE POINT

SCALE: 3/8" = 1'-0"

6.0 SQ. FT.

GENERAL NOTES


REMOVE EXISTING PANEL SIGN AND INSTALL ON NEW BUILDING

INSTALLATION LOCATION TBD

CITY CODE & ALLOWANCES




4 RELOCATE PANEL SIGN PARTS DLVRY- NON-ILLUM
SCALE: 1-1/2" = 1'-0"

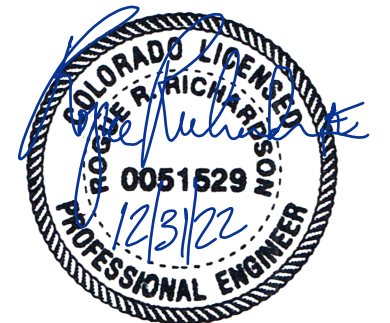

It is the intent and purpose of this color rendering to provide a basic color representation of your sign finish and color. However, digital media and printed colors will vary from actual paint finish and color. Existing painted surfaces will have a perceptible difference in shade and sheen from your sign finish. Providing a sample of the paint you wish to match or a Matthews paint color formula will minimize the differences.

<p>image national signs ...bringing your image to light!</p> <p>16265 Star Rd., Nampa, ID 83687 - toll free: 800.592.8058 - tele: 208.345.4020 imagenational.com</p>	<p>NAMPA PLANT - UL #433195-001</p> <p><small>U.S. & P.R. - All signs conform to UL-48/2161 (labeled accordingly) & must comply with UL-41.1 install procedures. Canada - all signs must be CAS compliant. This sign(s) is intended to be installed in accordance with requirements of article 600 of the National Electrical Code and/or applicable local codes. This includes proper grounding and bonding of the sign.</small></p>	<p>Client: CALIBER COLLISION</p>	<p>Design Number:</p>	<p>File Location: CCC-TBD-FalconCO-122722-R2</p>	<p>Page No.</p>
		<p>Site: # TBD 10706 MALTESE POINT FALCON, CO 80831</p>	<p>Date: 12/27/22</p>		<p>6 of 9</p>
			<p>Designer: Sb / RA</p>		
		<p>Account Manager: JG</p>			

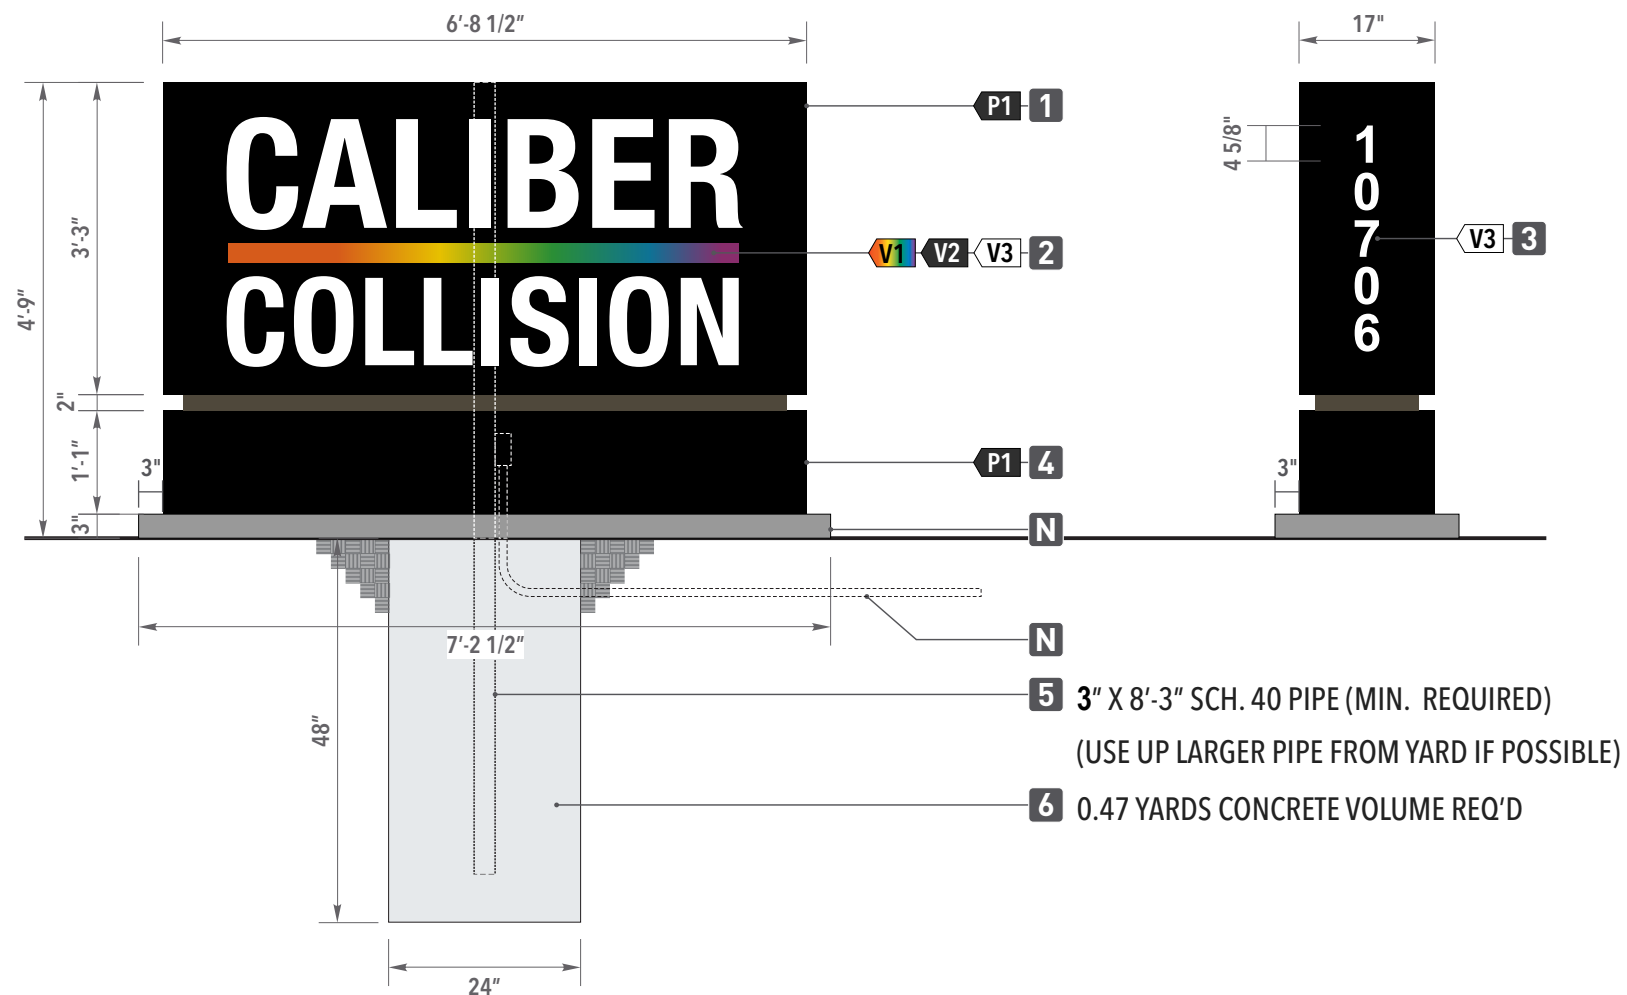

2 D/F ILLUMINATED MONUMENT SIGN
SCALE: 1/2" = 1'-0"

FABRICATION SPECIFICATIONS

1	CABINET	CONSTRUCTION	SIGN COMP BLEED FRAME
		TYPE	D/F
		PAINT COLOR	PER COLOR KEY (P1)
		ILLUMINATION	SLOAN LED 6500K
2	FACE	MATERIAL	3M Pangraphics w/ Vinyl
		VINYL COLOR	PER KEY (V1)(V2) (V3) (V4)
3	ADDRESS	VINYL	PER COLOR KEY (V1, V2)
4	BASE	CONSTRUCTION	EXTRUDED ALUMINUM
5	SUPPORT	TYPE	3" SCH. 40 PIPE
6	FOOTING	TYPE	0.47 YARDS CONCRETE VOLUME

NOTES

- N** • (1) 20 AMP CIRCUIT REQUIRED TO SIGN BY OTHERS
- DISCONNECT SWITCH ON NON-STREET SIDE
- 3" TALL CONCRETE PAD BY IMAGE NATIONAL INSTALLER TO EXTEND 3" PAST BASE OF SIGN ON ALL SIDES

COLOR KEY


V1	VINYL	3M IJ3630-20 - COLOR BAR GRAPHICS
V2	VINYL	3M 3630-22 - BLACK VINYL
V3	VINYL	3M 3660M UV PROTECTIVE FILM- ENTIRE FACE
P1	PAINT	MP 923 BLACK SATIN FINISH

NOTE: THE COLORS DEPICTED ON THIS RENDERING REPRESENT COLOR INTENT ONLY AND MAY NOT MATCH ACTUAL COLORS ON FINISHED PRODUCT. PLEASE REFER TO COLOR CALL-OUTS AND SPECIFIED VENDOR SAMPLES FOR APPROVED COLOR SPECIFICATIONS.




It is the intent and purpose of this color rendering to provide a basic color representation of your sign finish and color. However, digital media and printed colors will vary from actual paint finish and color. Existing painted surfaces will have a perceptible difference in shade and sheen from your sign finish. Providing a sample of the paint you wish to match or a Matthews paint color formula will minimize the differences.

<p>...bringing your image to light!</p> <p>16265 Star Rd., Nampa, ID 83687 - toll free: 800.592.8058 - tele: 208.345.4020 imagenational.com</p>	<p>NAMPA PLANT - UL #433195-001</p> <p><small>U.S. & P.R. - All signs conform to UL-48/2161 (labeled accordingly) & must comply with UL-41.1 install procedures. Canada - all signs must be CAS compliant. This sign(s) is intended to be installed in accordance with requirements of article 600 of the National Electrical Code and/or applicable local codes. This includes proper grounding and bonding of the sign.</small></p>	<p>Client: CALIBER COLLISION</p> <p>Site: # TBD 10706 MALTESE POINT FALCON, CO 80831</p>	<p>Design Number:</p> <p>Date: 12/27/22</p> <p>Designer: Sb / RA</p> <p>Account Manager: JG</p>	<p>File Location: CCC-TBD-FalconCO-122722-R2</p>	<p>Page No.</p> <p>7 of 9</p>

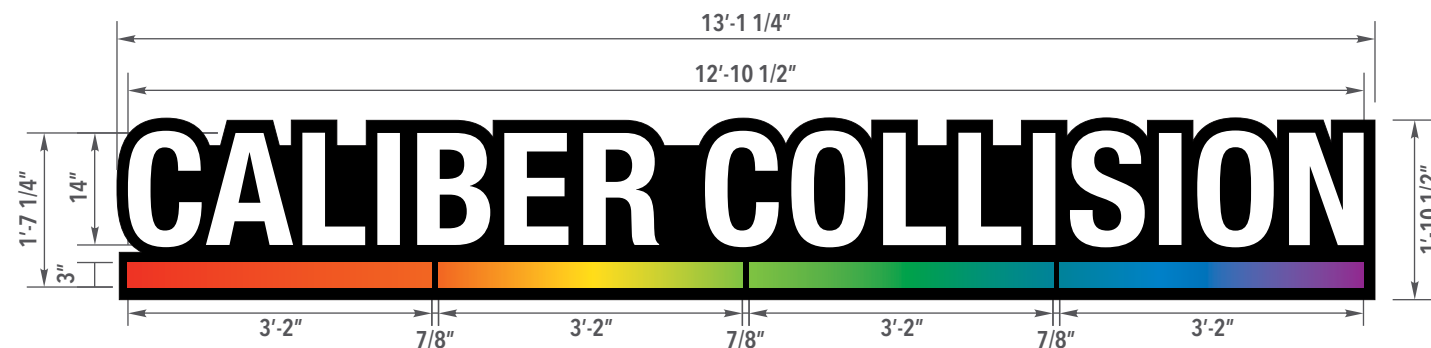

3 **CUSTOM** - FCO LETTERS ON BACKER PANEL
SCALE: 3/4" = 1'-0"

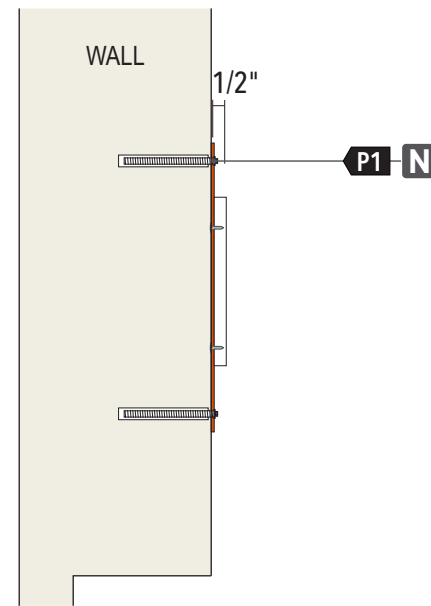

SIDE SECTION DETAIL
SCALE: 1 1/2" = 1'-0"

FABRICATION SPECIFICATIONS

1	PANEL	MATERIAL	1/8" ALUMINUM
		COLOR	PER COLOR KEY (P1)
		MOUNTING	1/4" x 6" STUDS
2	FCO LETTERS	MATERIAL	1/2" WHITE ACRYLIC
		BARS COLOR	PER COLOR KEY (G1)
		MOUNTING	#10 x 3/8" C.S. SCREWS

NOTES

N MOUNTING HARDWARE PAINTED TO MATCH BACKGROUND OF SIGN.

COLOR KEY

G1	VINYL	DIGITAL PRINT WITH UV COATING
P1	PAINT	MP 923 BLACK SATIN FINISH

NOTE: THE COLORS DEPICTED ON THIS RENDERING REPRESENT COLOR INTENT ONLY AND MAY NOT MATCH ACTUAL COLORS ON FINISHED PRODUCT. PLEASE REFER TO COLOR CALL-OUTS AND SPECIFIED VENDOR SAMPLES FOR APPROVED COLOR SPECIFICATIONS.

'CUSTOM' DESCRIPTION

FLAT CUT LETTERS ON BACKER ARE NOT PART OF THE SIGN FAMILY



It is the intent and purpose of this color rendering to provide a basic color representation of your sign finish and color. However, digital media and printed colors will vary from actual paint finish and color. Existing painted surfaces will have a perceptible difference in shade and sheen from your sign finish. Providing a sample of the paint you wish to match or a Matthews paint color formula will minimize the differences.

image national signs **in**
...bringing your image to light!

16265 Star Rd., Nampa, ID 83687 - toll free: 800.592.8058 - tele: 208.345.4020
imagenational.com



NAMPA PLANT -
UL #433195-001

U.S. & P.R. - All signs conform to UL-48/2161 (labeled accordingly) & must comply with UL-41.1 install procedures. Canada - all signs must be CAS compliant. This sign(s) is intended to be installed in accordance with requirements of article 600 of the National Electrical Code and/or applicable local codes. This includes proper grounding and bonding of the sign.

Client: CALIBER COLLISION

Site: # TBD
10706 MALTESE POINT
FALCON, CO 80831

Design Number:

Date: 12/27/22

Designer: Sb / RA

Account Manager: JG

File Location: CCC-TBD-FalconCO-122722-R2

CALIBER COLLISION

Page No.

8 of 9



It is the intent and purpose of this color rendering to provide a basic color representation of your sign finish and color. However, digital media and printed colors will vary from actual paint finish and color. Existing painted surfaces will have a perceptible difference in shade and sheen from your sign finish. Providing a sample of the paint you wish to match or a Matthews paint color formula will minimize the differences.

	<p>NAMPA PLANT - UL #433195-001</p> <p>U.S. & P.R. - All signs conform to UL-48/2161 (labeled accordingly) & must comply with UL-41.1 install procedures. Canada - all signs must be CAS compliant. This sign(s) is intended to be installed in accordance with requirements of article 600 of the National Electrical Code and/or applicable local codes. This includes proper grounding and bonding of the sign.</p>	Client: CALIBER COLLISION	Design Number:	File Location: CCC-TBD-FalconCO-122722-R2	Page No.
		Site: # TBD 10706 MALTESE POINT FALCON, CO 80831	Date: 12/27/22		9 of 9
			Designer: Sb / RA		
		Account Manager: JG			