



property line

Not to scale

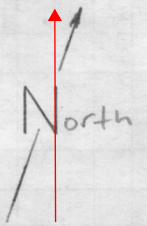

Show and label all existing structures on plan with dimensions to property lines. The letter of intent indicates that there are 4 outbuildings and 1 shed. Only 2 existing outbuildings are shown.

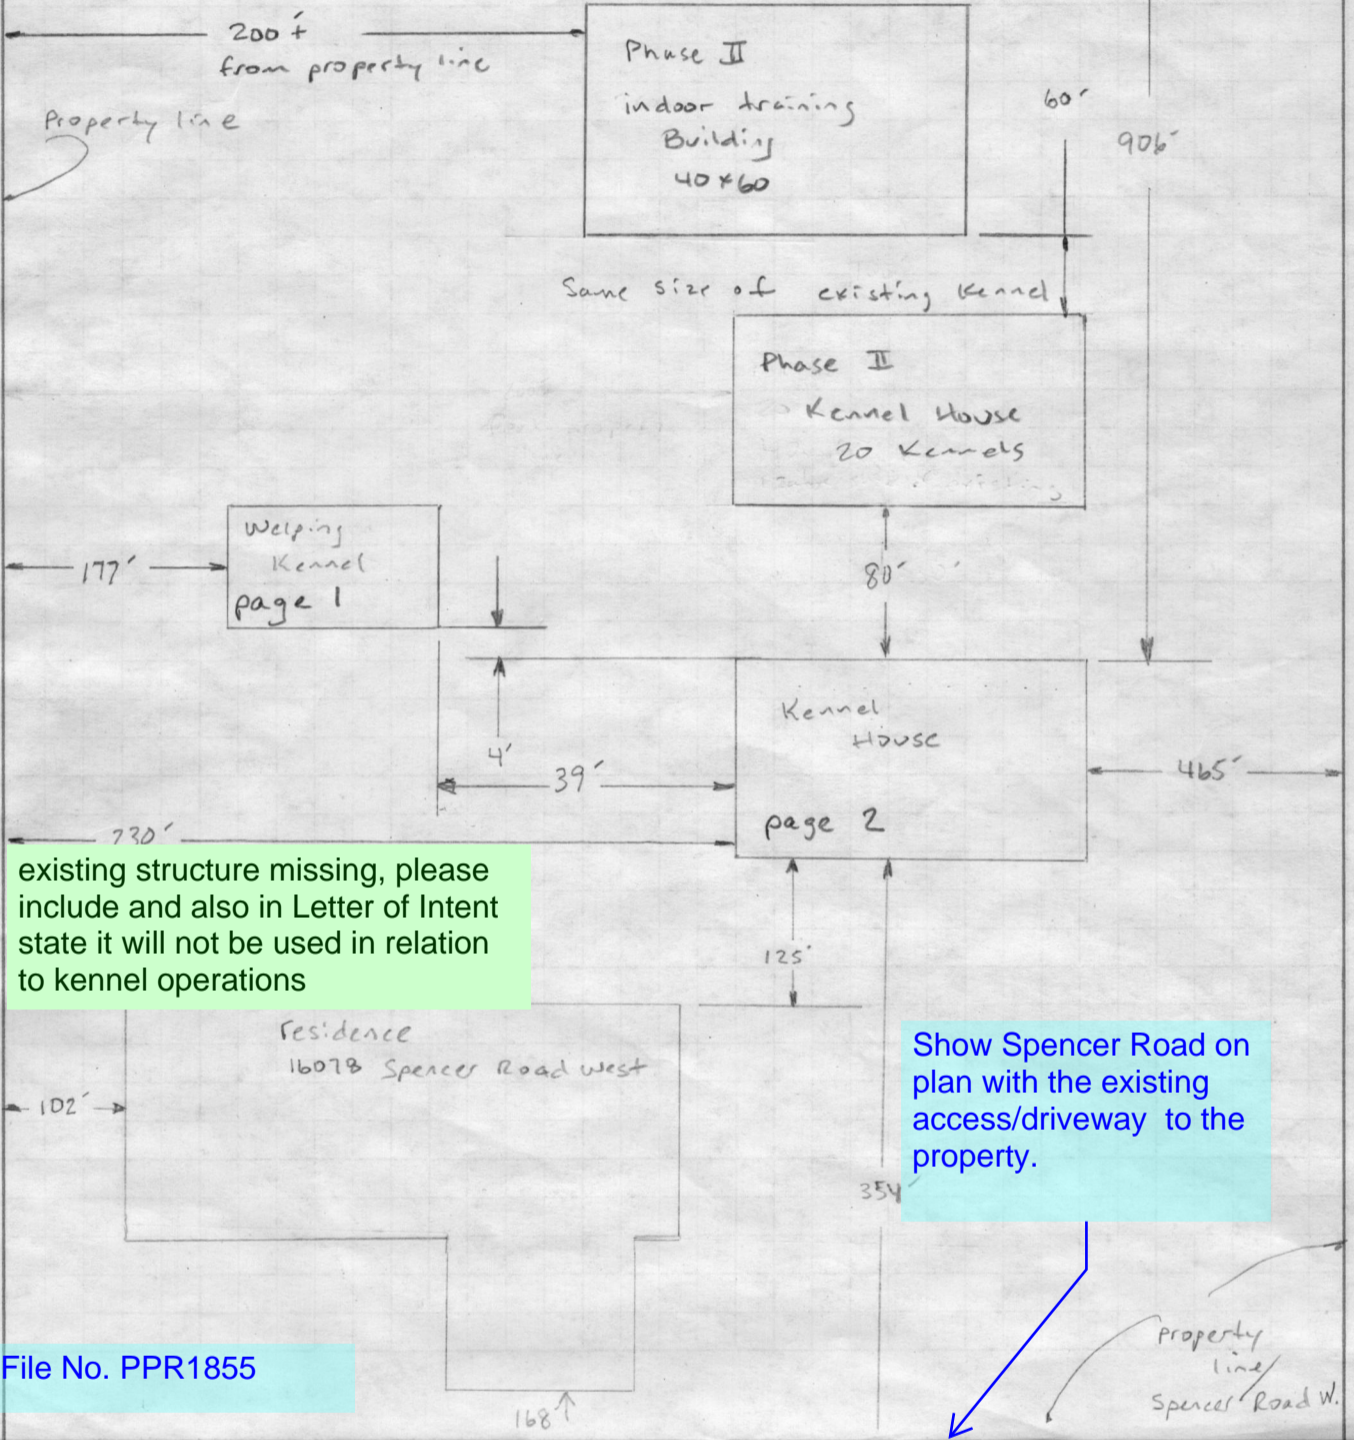

existing structure missing, please include and also in Letter of Intent state it will not be used in relation to kennel operations



Show Spencer Road on plan with the existing access/driveway to the property.

Add PCD File No. PPR1855

Landscape plans

Shrubs & tree for looks


Helping Kennel

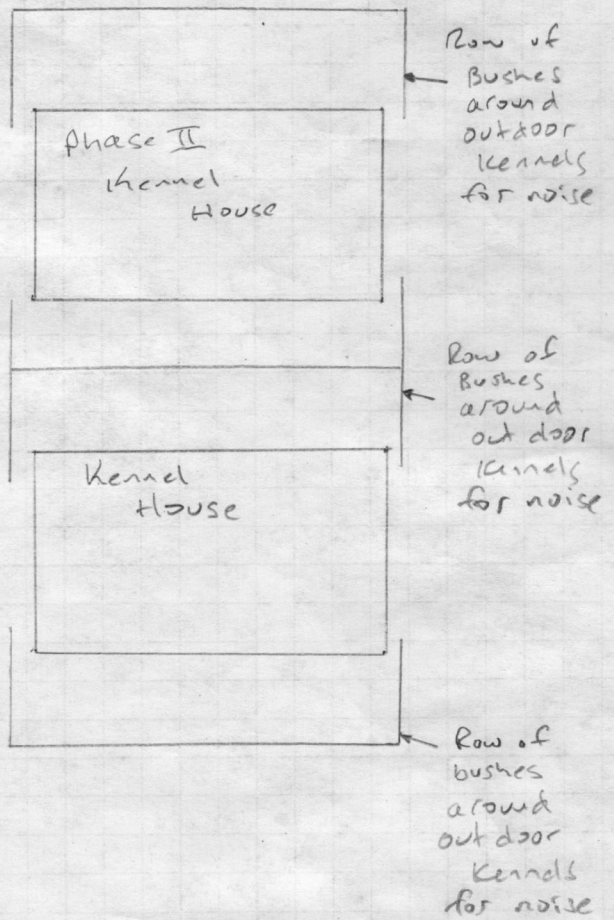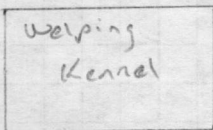


Not a Landscape plan. This needs to have a legend of what the plant or tree is, the required amount, then the provided amount. If you cannot meet the minimum of Chapter 6 of the Land Development Code, you must request an 'Alternative Landscape Design' in your letter of intent.

Markup Summary

Daniel Torres (4)

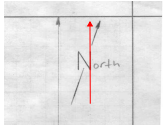


Subject: Arrow
Page Label: 1
Lock: Locked
Author: Daniel Torres
Date: 1/14/2019 10:32:44 AM
Color: ■

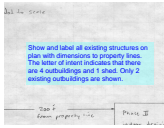

Subject: Text Box
Page Label: 1
Lock: Locked
Author: Daniel Torres
Date: 1/14/2019 10:32:44 AM
Color: ■

Show and label all existing structures on plan with dimensions to property lines. The letter of intent indicates that there are 4 outbuildings and 1 shed. Only 2 existing outbuildings are shown.

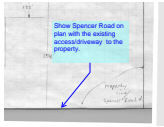

Subject: Callout
Page Label: 1
Lock: Locked
Author: Daniel Torres
Date: 1/14/2019 10:32:45 AM
Color: ■


Show Spencer Road on plan with the existing access/driveway to the property.



Subject: Text Box
Page Label: 1
Lock: Locked
Author: Daniel Torres
Date: 1/14/2019 10:32:46 AM
Color: ■


Add PCD File No. PPR1855

dsdseivigny (2)

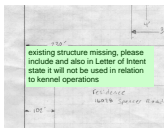

Subject: Text Box
Page Label: 1
Lock: Locked
Author: dsdseivigny
Date: 1/14/2019 10:32:37 AM
Color: ■

existing structure missing, please include and also in Letter of Intent state it will not be used in relation to kennel operations

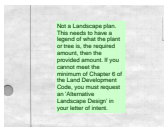

Subject: Text Box
Page Label: 2
Lock: Locked
Author: dsdseivigny
Date: 1/14/2019 10:32:42 AM
Color: ■

Not a Landscape plan. This needs to have a legend of what the plant or tree is, the required amount, then the provided amount. If you cannot meet the minimum of Chapter 6 of the Land Development Code, you must request an 'Alternative Landscape Design' in your letter of intent.