

VERIFY LOCATION PRIOR TO POURING TO ASSURE NO INTERFERENCE WITH UTILITIES

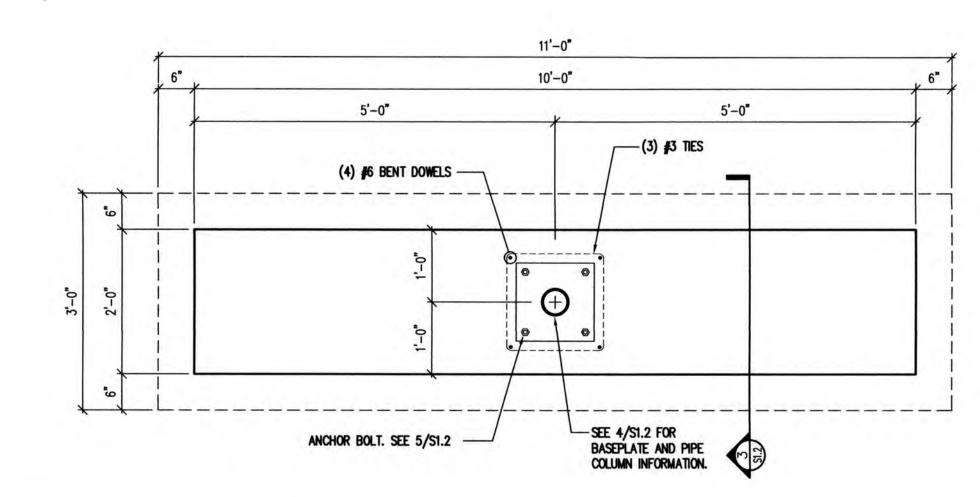



MONUMENT SIGN FOUNDATION PLAN SCALE: 3/4" = 1'-0"

GROUND SIGN ELEVATION

\$1.2 | SCALE: 1/2" = 1'-0"

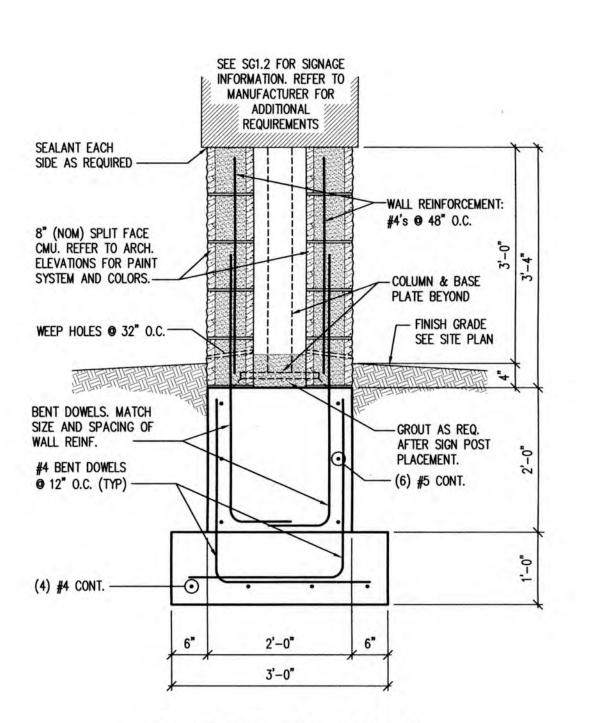

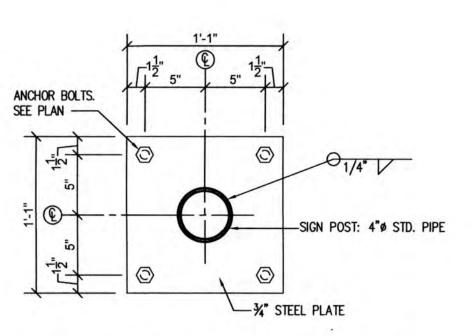

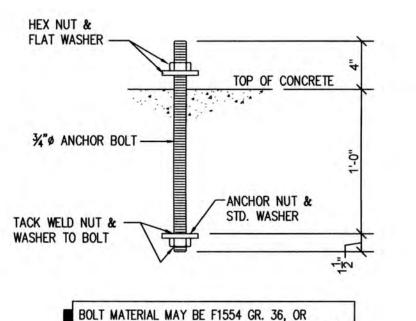

CONTINUOUSLY THREADED A36 ROD. ALL ANCHOR BOLTS SHALL BE CLEAN AND FREE OF ALL OIL,

GREASE, ICE, ETC.

SCALE: 1 1/2" = 1'-0"

SIGN BASE PLATE

\$1.2 | SCALE: 1 1/2" = 1'-0"

5 ANCHOR BOLT DETAIL

MONUMENT SIGN FOUNDATION SECTION

\$1.2 SCALE: 3/4" = 1'-0"



- A. REFER TO PROJECT MANUAL FOR ADDITIONAL REQUIREMENTS.
- B. CONTACT OWNER'S OR TENANT'S DESIGNATED PROJECT ADMINISTRATOR FOR QUESTIONS OR CLARIFICATIONS.
- C. SITE SIGN FOUNDATIONS AND ROUGH-IN ELECTRICAL TO BE
- PROVIDED BY CONTRACTOR.
- REQUIRED GOVERNMENTAL PERMITS FOR PERMANENT TYPE SIGNAGE TO BE PROVIDED BY OWNER OR OTHERS (N.I.C.).

DESIGN CRITERIA

A. GOVERNING BUILDING CODE
2017 PIKES PEAK REGIONAL BUILDING CODE (2015 IBC)

- RISK CATEGORY II
- $V_{ULT} = 130 \text{ mph}$ $V_{ASD} = 100.7 \text{ mph}$
- **EXPOSURE "C"**

- SDC = B
- C.3. $S_S = 0.185$
- C.4. $S_1 = 0.059$ C.5. $S_{DS} = 0.197$
- $S_{D1} = 0.094$

STRUCTURAL NOTES

- A GEOTECHNICAL ANALYSIS HAS BEEN PERFORMED ON THIS SITE. SEE PROJECT MANUAL FOR GEOTECHNICAL INFORMATION. APPROPRIATE RECOMMENDATIONS STATED IN THE GEOTECHNICAL REPORT ISSUED BY TERRACON CONSULTANTS, INC DATED SEPTEMBER 20, 2019 SHALL BE FOLLOWED.
- THESE FOUNDATIONS HAVE BEEN DESIGNED FOR A VERTICAL SOIL BEARING OF 2500 psf.
- BRACE POLE SIGN AGAINST LATERAL FORCES UNTIL CONCRETE HAS REACHED SPECIFIED COMPRESSIVE DESIGN STRENGTH.
- D. ALL READY MIX CONCRETE SHALL BE 4000 psi FOR ALL CONCRETE PLACEMENT. DO NOT ADD WATER TO THE MIX DESIGN AFTER DELIVERY TO THE PROJECT SITE.
- E. EXPOSED EXTERIOR CONCRETE SHALL BE AIR-ENTRAINED (TOTAL AIR
- F. HOT OR COLD WEATHER CONCRETING SHALL BE IN ACCORDANCE WITH ACI 305-89 AND ACI 306-1-90, RESPECTIVELY.
- G. ANY CONCRETE PLACED BY MEANS OF PUMPING SHALL BE DONE IN ACCORDANCE WITH ACI 304.2R (82).
- H. CEMENT SHALL CONFORM TO A.S.T.M. C-150 TYPE I/II.
- AGGREGATES SHALL CONFORM TO A.S.T.M. C-33 FOR NORMAL WEIGHT CONCRETE.
- READY MIX CONCRETE SHALL BE MIXED AND DELIVERED IN ACCORDANCE WITH A.S.T.M. C-94.
- K. ADMIXTURES MAY BE USED WITH THE APPROVAL OF THE STRUCTURAL ENGINEER. ADMIXTURES USED TO INCREASE THE WORKABILITY OF THE CONCRETE SHALL NOT BE CONSIDERED TO REDUCE THE CEMENT CONTENT. NO CALCIUM CHLORIDE ADMIXTURES ALLOWED.
- FABRICATOR QUALIFICATIONS: FABRICATOR MUST PARTICIPATE IN THE AISC QUALITY CONTROL PROGRAM AND BE DESIGNATED AN


MATERIALS: STRUCTURAL STEEL.. ASTM A992, GRADE 50ksi PLATES, ANGLES, AND MISC STEEL.. ASTM A36ksi ASTM F1554, GRADE 36


 ANCHOR RODS... HIGH STRENGTH BOLTS .. **ASTM F3125** WELDING ELECTRODES. AWS A5.1 (E70XX)

ASTM A53, GRADE B ROUND HSS... ASTM A500, GRADE B, Fy = 42ksi

CMU NOTES

- A. CMU SHALL CONFORM TO CURRENT BUILDING CODE PROVISIONS.
- VERTICAL CELLS TO BE FILLED SHALL ALIGN TO MAINTAIN AN UNOBSTRUCTED VERTICAL SHAFT NOT LESS THAN 2"x3".
- C. PROVIDE 9 ga. LADDER TYPE JOINT REINFORCEMENT AT 16" O.C.
- D. CENTER VERTICAL REINFORCEMENT WITH 9 ga. HOT DIP GALVANIZED REBAR POSITIONERS 24" AT O.C.

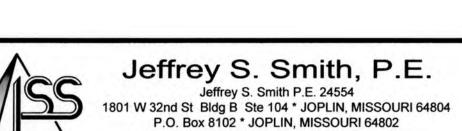

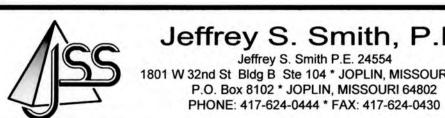




AIA SCHNEIDER,

RCHITECT CRAIG

COMM # 4369 DATE: 10-11-19 REVISION

S1.2

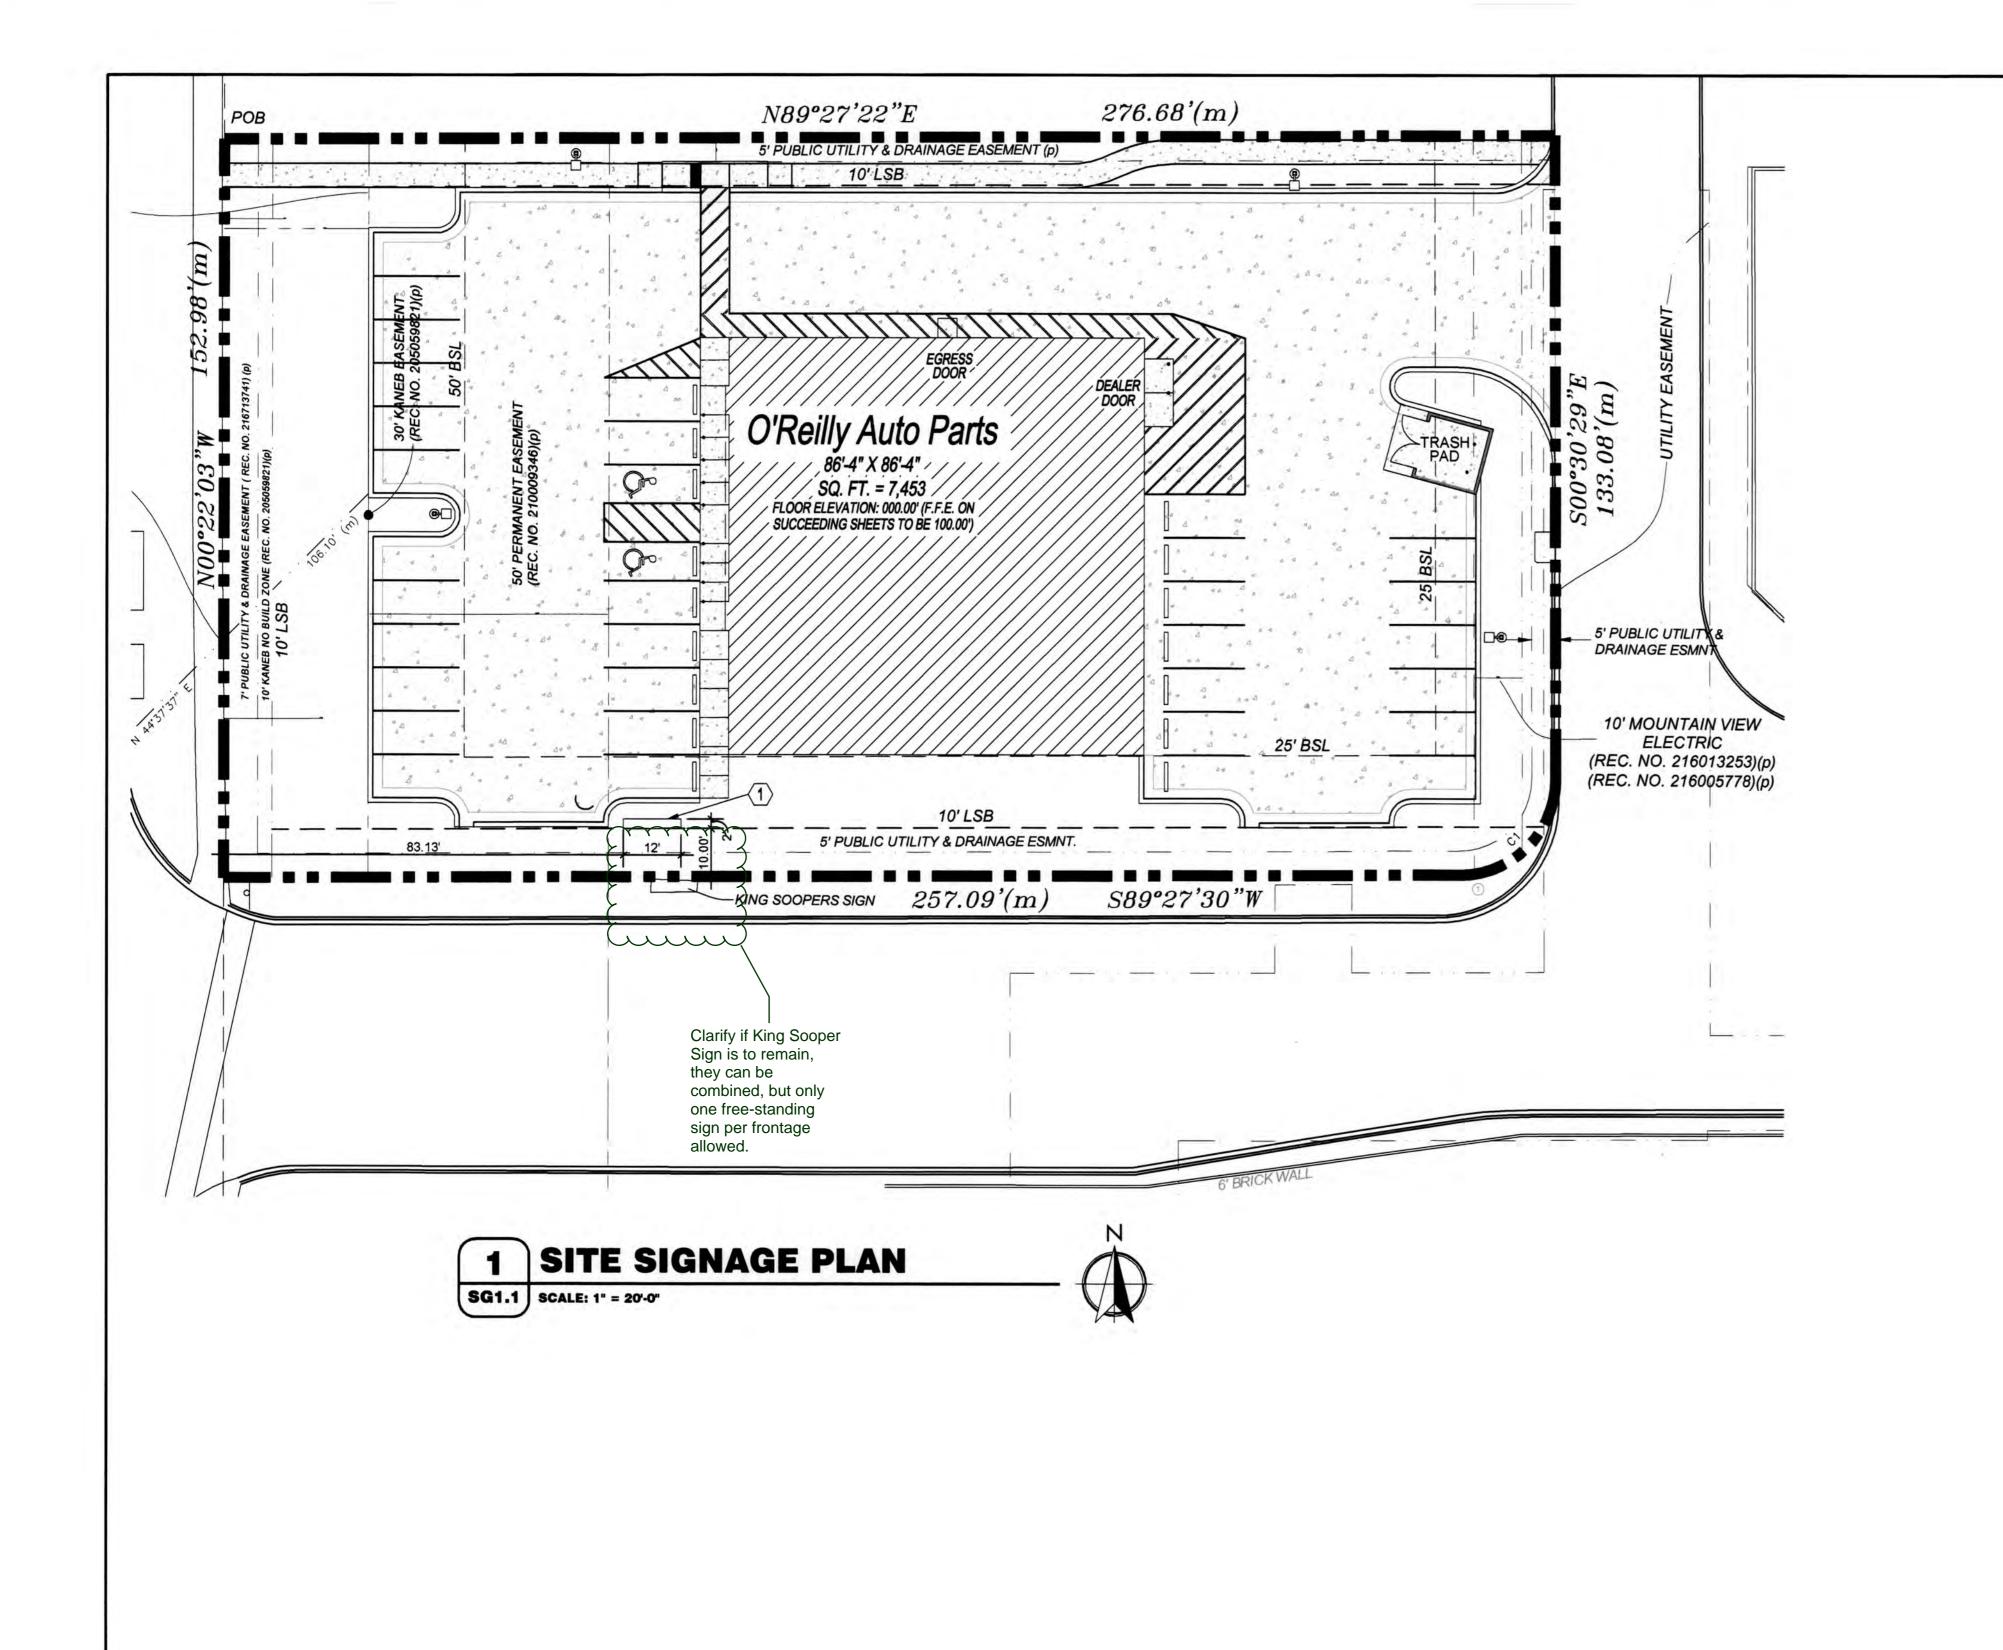

GENERAL NOTES

- A REFER TO PROJECT MANUAL AND SCOPE OF WORK SCHEDULE FOR ADDITIONAL REQUIREMENTS.
- B SITE DIMENSIONS TO FACE OF CONCRETE FOUNDATION, SIDEWALK, CURB GUTTER LINE, PROPERTY LINE, OR CENTER LINE OF STRIPING UNLESS OTHERWISE NOTED.
- C COORDINATE WORK WITH OTHER SITE RELATED DEVELOPMENT DRAWINGS.
- D PRIOR TO INSTALLATION, CONTRACTOR TO VERIFY LOCATIONS OF LIGHT POLES, LANDSCAPING, AND UTILITIES DO NOT CONFLICT WITH SITE SIGN LOCATION SHOWN. REFER TO US1 AND CIVIL FOR UTILITY LOCATIONS. IF CONFLICT IS DISCOVERED, CONTRACTOR TO NOTIFY OWNER'S REPRESENTATIVE PRIOR TO PROCEEDING WITH THE WORK.
- "COMING SOON" TEMPORARY CONSTRUCTION SIGN TO BE PROVIDED BY CONTRACTOR. APPLIED SIGNAGE GRAPHICS TO BE OWNER FURNISHED AND CONTRACTOR INSTALLED. LOCATE TEMPORARY CONSTRUCTION SIGN ON SITE SO AS TO BE VISIBLE TO PUBLIC FROM RIGHT-OF-WAY. REFER TO DETAIL 1/SG1.2.

SPECIAL NOTE:
AVOID OBSCURING VISIBILITY OF SITE SIGN FROM RIGHT
OF WAY WITH LARGE PLANTINGS AND LANDSCAPING. SUBMIT LANDSCAPING LAYOUT FOR FINAL OWNER REVIEW AND APPROVAL PRIOR TO INSTALLATION.

KEY NOTES

1 SITE SIGN, REFER TO ELEVATION 2/SG1.2

DESIGN BY OTHERS. FOR

REFERENCE ONLY

AI SCHNEIDER, RCHITECT

CRAIG


AUTO PARTS

COMM # 4369 DATE: 10-11-19 REVISION

SG1.1


CAUTION:
INFORMATION ON THIS DRAWING
CONCERNING TYPE AND LOCATION
OF UNDERGROUND AND OTHER
UTILITIES IS NOT GUARANTEED TO
BE ACCURATE OR ALL INCLUSIVE.
THE CONTRACTOR IS RESPONSIBLE
FOR MAKING HIS OWN
DETERMINATION AS TO THE TYPE
AND LOCATION OF UNDERGROUND
AND OTHER UTILITIES AS MAY BE
NECESSARY TO AVOID DAMAGE
THERETO.

Know what's below Call before you dig.

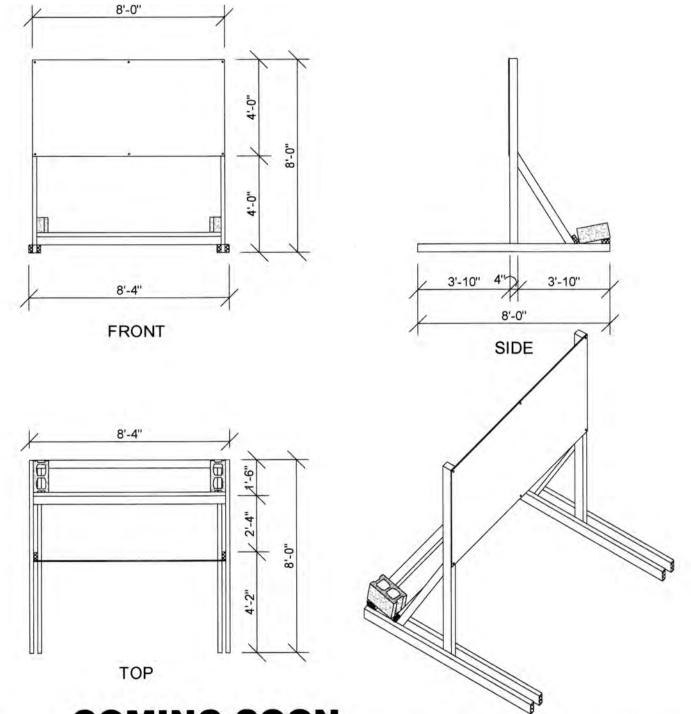

COMING SOON
TEMPORARY CONSTRUCTION SIGN

SG1.2 SCALE: 1/4" = 1'-0"

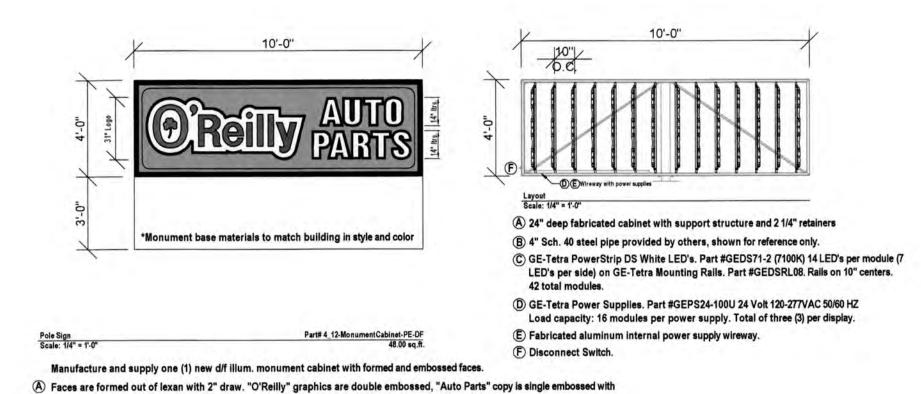

B 24" deep fabricated cabinet with 2 1/4" (removable) non-hinged retainers. Cabinet internally set up to receive steel pipe (pipe by others). Vertical GE (GEDS71-2) White DS LED Illumination. Paint cabinet to: Gloss Black. Internal pipe/cabinet exposure calculation: C80

painted graphics on 2nd surface. Graphics to match PMS 200c Red, PMS 342c Green, Black and White.

2 GROUND SIGN ELEVATION

SG1.2 | SCALE: 1/4" = 1'-0"

GENERAL NOTES

- (A) REFER TO PROJECT MANUAL FOR ADDITIONAL REQUIREMENTS.
- B CONTACT OWNER'S OR TENANT'S DESIGNATED PROJECT ADMINISTRATOR FOR QUESTIONS OR CLARIFICATIONS.
- C PERMANENT SIGNAGE OWNER FURNISHED AND INSTALLED, (REFER TO SCOPE OF WORK SCHEDULE). SIGNAGE GRAPHICS PROVIDED FOR REFERENCE ONLY (N.I.C.) AND CONTRACTOR'S COORDINATION WITH SPECIFIC PROJECT CONSTRUCTION CONDITIONS.
- D SITE SIGN ROUGH-IN ELECTRICAL TO BE PROVIDED BY CONTRACTOR.
- REQUIRED GOVERNMENTAL PERMITS FOR PERMANENT TYPE SIGNAGE TO BE PROVIDED BY SIGN COMPANY PER OWNER'S DIRECTION (N.I.C.).
- F "COMING SOON" TEMPORARY CONSTRUCTION SIGN TO BE PROVIDED BY GENERAL CONTRACTOR. APPLIED SIGNAGE GRAPHICS TO BE OWNER FURNISHED AND GENERAL CONTRACTOR INSTALLED. LOCATE TEMPORARY CONSTRUCTION SIGN ON SITE SO AS TO BE VISIBLE TO PUBLIC FROM RIGHT-OF-WAY.
- G UNLESS OTHERWISE INDICATED, SITE POLE SIGN FOUNDATION CONSTRUCTION BY SIGN CONTRACTOR (BY OTHERS - NOT IN CONTRACT) AND SITE MONUMENT SIGN FOUNDATION CONSTRUCTION BY GENERAL CONTRACTOR (BASE BID).

SPECIAL NOTE: SIGN DESIGN BY OTHERS, REFER TO SIGN CONTRACTOR'S SHOP DRAWINGS FOR ADDITIONAL REQUIREMENTS.

- FABRICATED BODY

- FORMED FACES

_ 2 1/4" RETAINER (REMOVABLE)

CABINET SET UP TO RECEIVE STEEL PIPE. (PIPE BY OTHERS)

- MONUMENT BASE, BY OTHERS (VARIES PER LOCATION)

REFER TO SHEET \$1.2 FOR SIGN FOUNDATION SYSTEM STRUCTURAL REQUIREMENTS.

oo DESIGN BY OTHERS. FOR REFERENCE

ONLY

SCHNEIDER,

V

CRAIG

0

AUTO


REVISION DATE:

SG1.2

PARTS

GENERAL NOTES

- (A) CONTACT OWNER'S OR TENANT'S DESIGNATED PROJECT ADMINISTRATOR FOR QUESTIONS OR CLARIFICATIONS.
- (B) BUILDING PERMANENT SIGNAGE OWNER FURNISHED AND INSTALLED, (REFER TO SCOPE OF WORK SCHEDULE). SIGNAGE GRAPHICS PROVIDED FOR REFERENCE ONLY (N.I.C.) AND CONTRACTOR'S COORDINATION WITH SPECIFIC PROJECT CONSTRUCTION CONDITIONS. CONTRACTOR TO PROVIDE BACKING AND ROUGH-IN ELECTRICAL AS REQUIRED FOR INSTALLATION. REFER TO A2.1 FOR EXTERIOR BUILDING FINISH.
- (C) REQUIRED GOVERNMENTAL PERMITS FOR PERMANENT TYPE SIGNAGE TO BE PROVIDED BY OWNER OR OTHERS (N.I.C.).

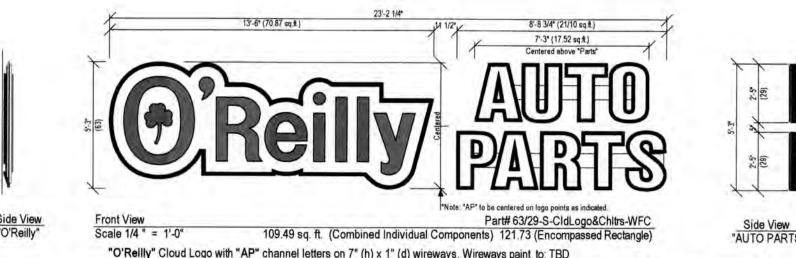


"O'Reilly" Cloud Logo with "AP" channel letters on 7" (h) x 1" (d) wireways. Wireways paint to: TBD "O'Reilly" Cloud Logo is formed polycarb with double embossment with 2nd surface painted graphics. Paint match to: Green (PMS#342c), Black and White.

"AP" to have formed polycarb caps with 1/4" letter "bumps". Black 5" aluminum coil returns. 2nd surface Black and White paint. WHITE LED illumination.


FRONT WALL SIGN ELEVATION

SG2.1 | SCALE: 1/4" = 1'-0"

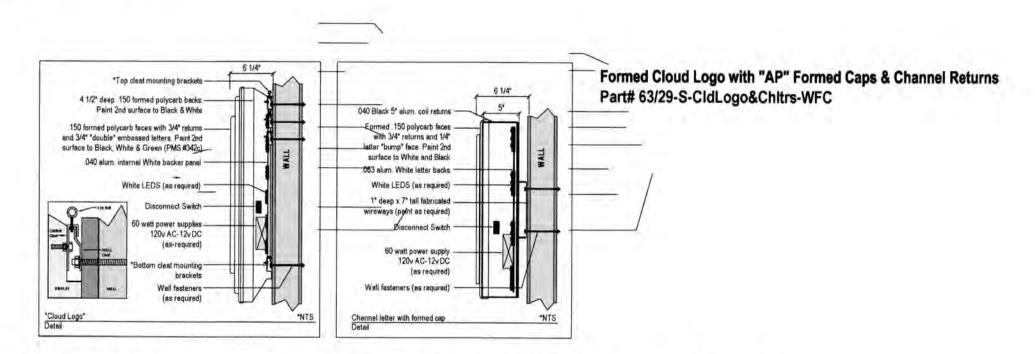

FRONT WALL SIGN MOUNTING DETAILS


SG2.1 SCALE: 1/4" = 1'-0"

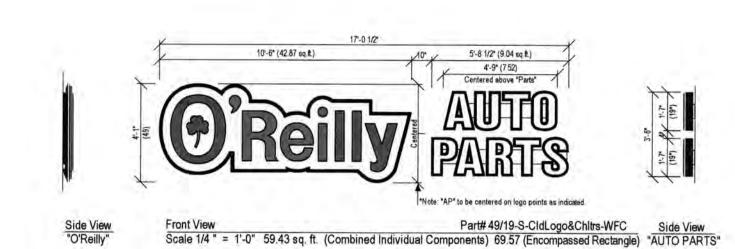

"O'Reilly" Cloud Logo with "AP" channel letters on 7" (h) x 1" (d) wireways. Wireways paint to: TBD
"O'Reilly" Cloud Logo is formed polycarb with double embossment with 2nd surface painted graphics. Paint match to: Green (PMS#342c), Black and White. "AP" to have formed polycarb caps with 1/4 " letter "bumps". Black 5" aluminum coil returns. 2nd surface Black and White paint. WHITE LED illumination

5 FRONT WALL SIGN ELEVATION

SG2.1 SCALE: 1/4" = 1'-0"

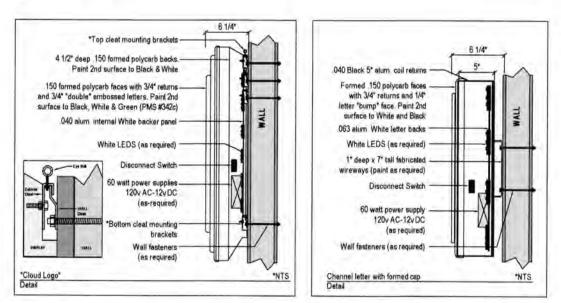

Formed Cloud Logo with "AP" Formed Caps & Channel Returns
Part# 49/19-S-CldLogo&Chitrs-WFC

FRONT WALL SIGN DETAILS

SCALE: 1/4" = 1'-0"

DESIGN BY OTHERS. FOR REFERENCE ONLY

SCHNEIDER,

M

RAIG

PARTS

AUTO

COMM # 4369 DATE: 10-11-19 REVISION

SG2.1

Sign Plan_V1.pdf Markup Summary

Cloud+ (1)



Subject: Cloud+ Page Label: 2 Lock: Locked Author: dsdsevigny Date: 2/5/2020 12:08:25 PM

Status: Color: ■ Layer: Space: Clarify if King Sooper Sign is to remain, they can be combined, but only one free-standing sign per frontage allowed.

Text Box (1)



Subject: Text Box Page Label: 1 Lock: Locked Author: dsdsevigny Date: 2/5/2020 12:08:22 PM

Status: Color: ■ Layer: Space: General Note: a sign permit will be required to be submitted separately. It can be initiated online at

epcdevplanreview.com