



**WOODMEN HILLS METROPOLITAN DISTRICT
 REGIONAL WATER RECLAMATION FACILITY**
 NORTH/SOUTH BUILDING ELEVATIONS

Project No.:	112.88
Scale:	AS NOTED
Date:	05/22/17
Design:	RMM
Drawn:	RMM
Check:	JPM
Revised:	

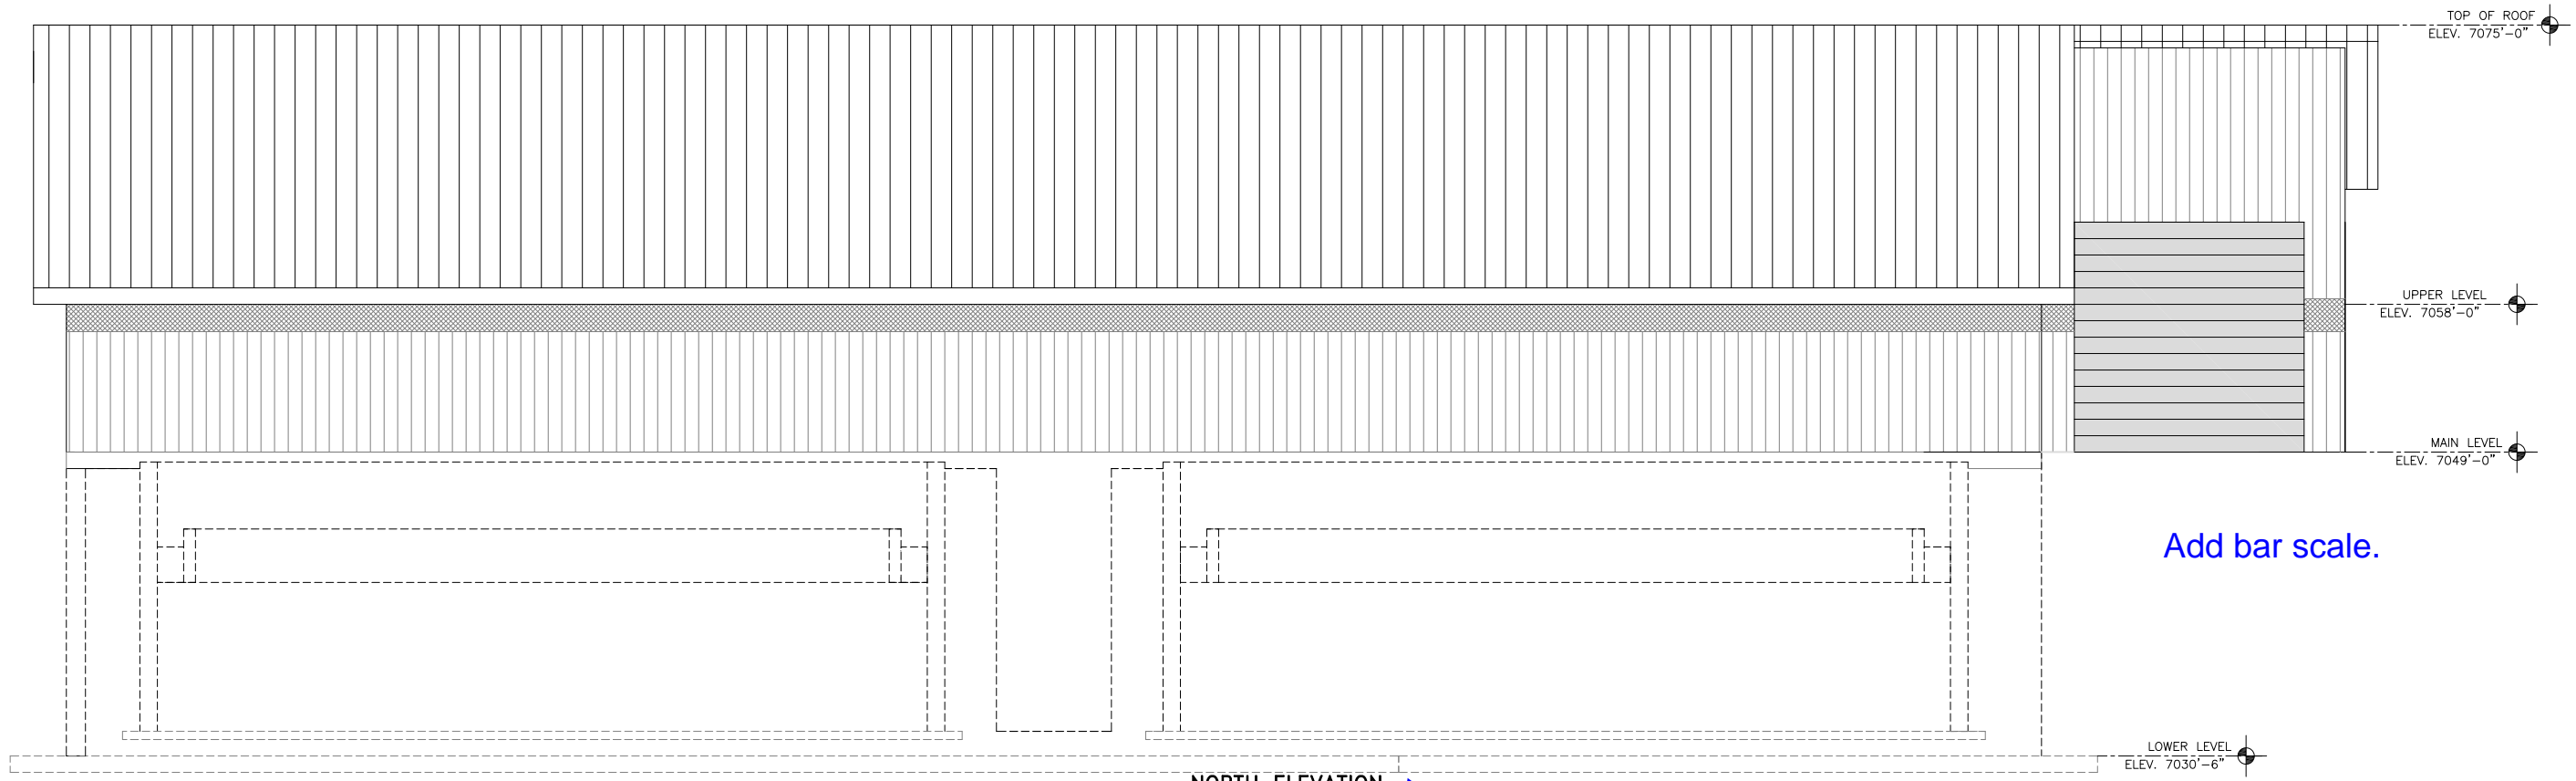


NORTH ELEVATION
 11x17 SCALE: 3/32"=1'-0"
 24x36 SCALE: 3/16"=1'-0"

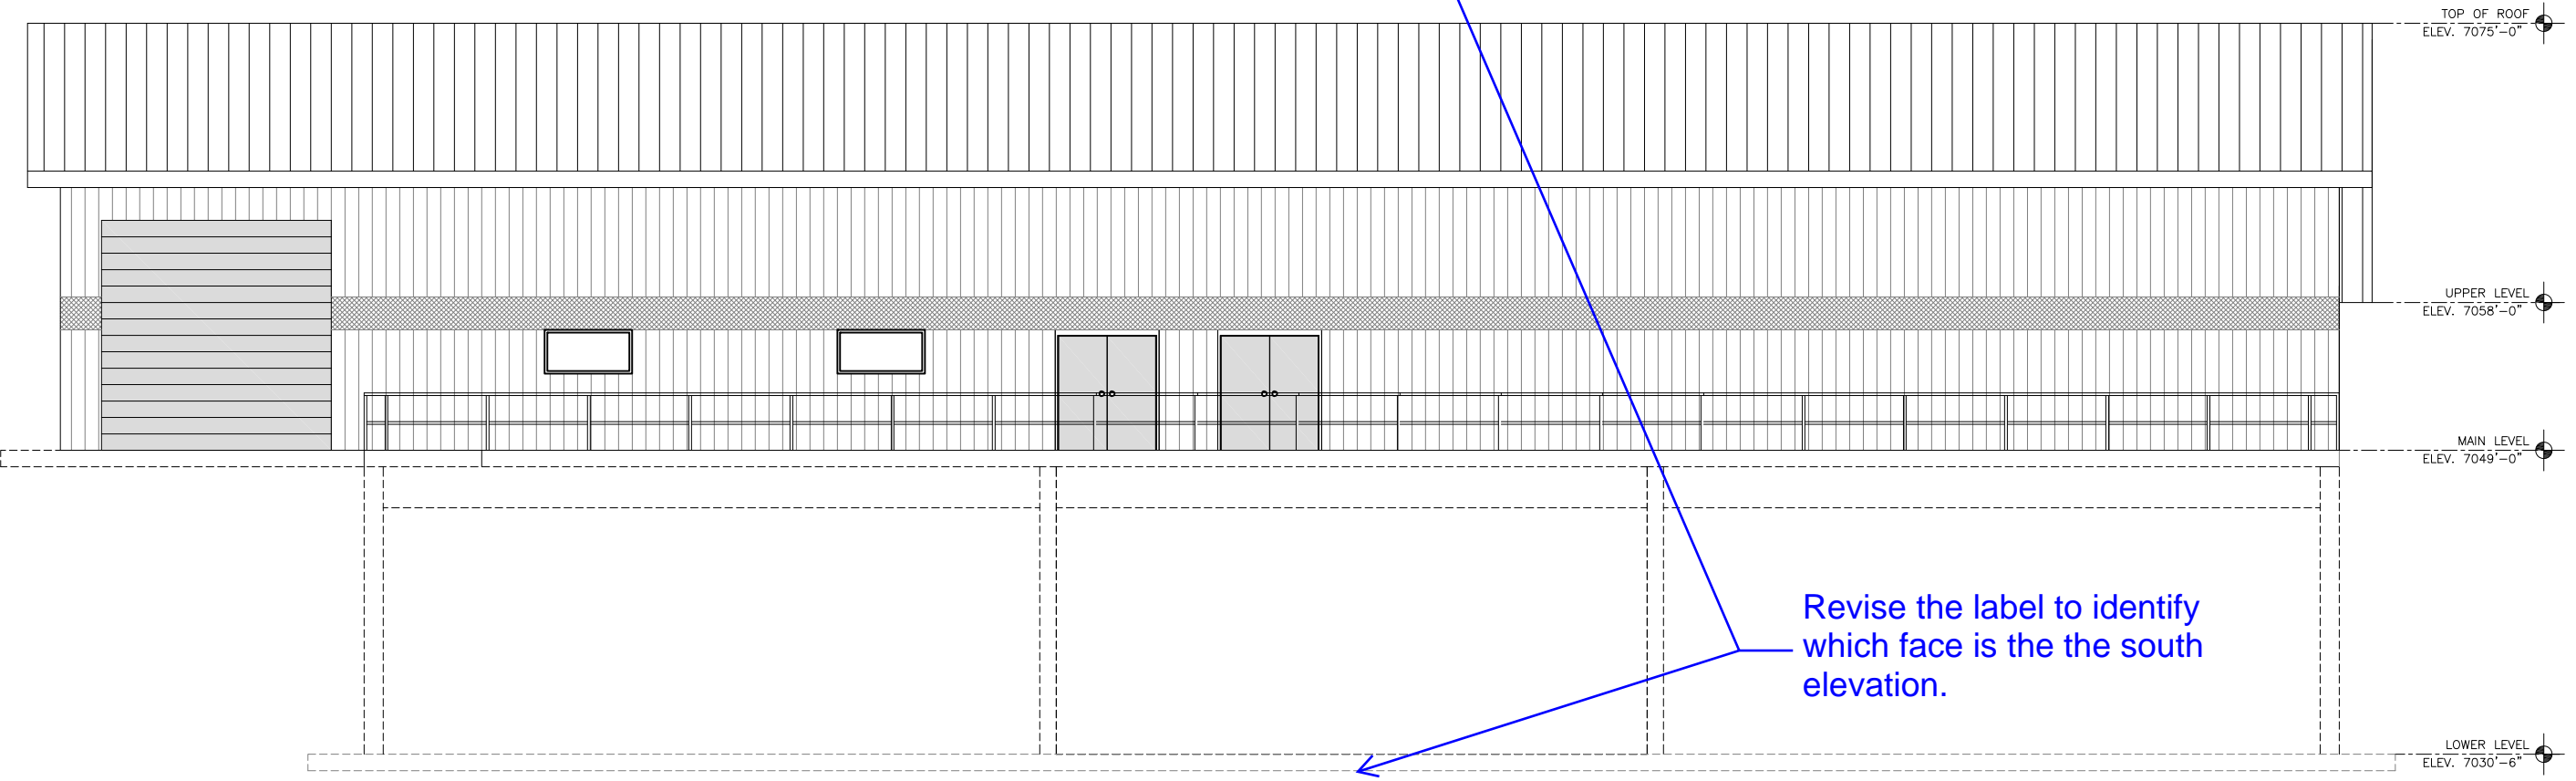


NORTH ELEVATION
 11x17 SCALE: 3/32"=1'-0"
 24x36 SCALE: 3/16"=1'-0"

Revise the label to identify which face is the the south elevation.

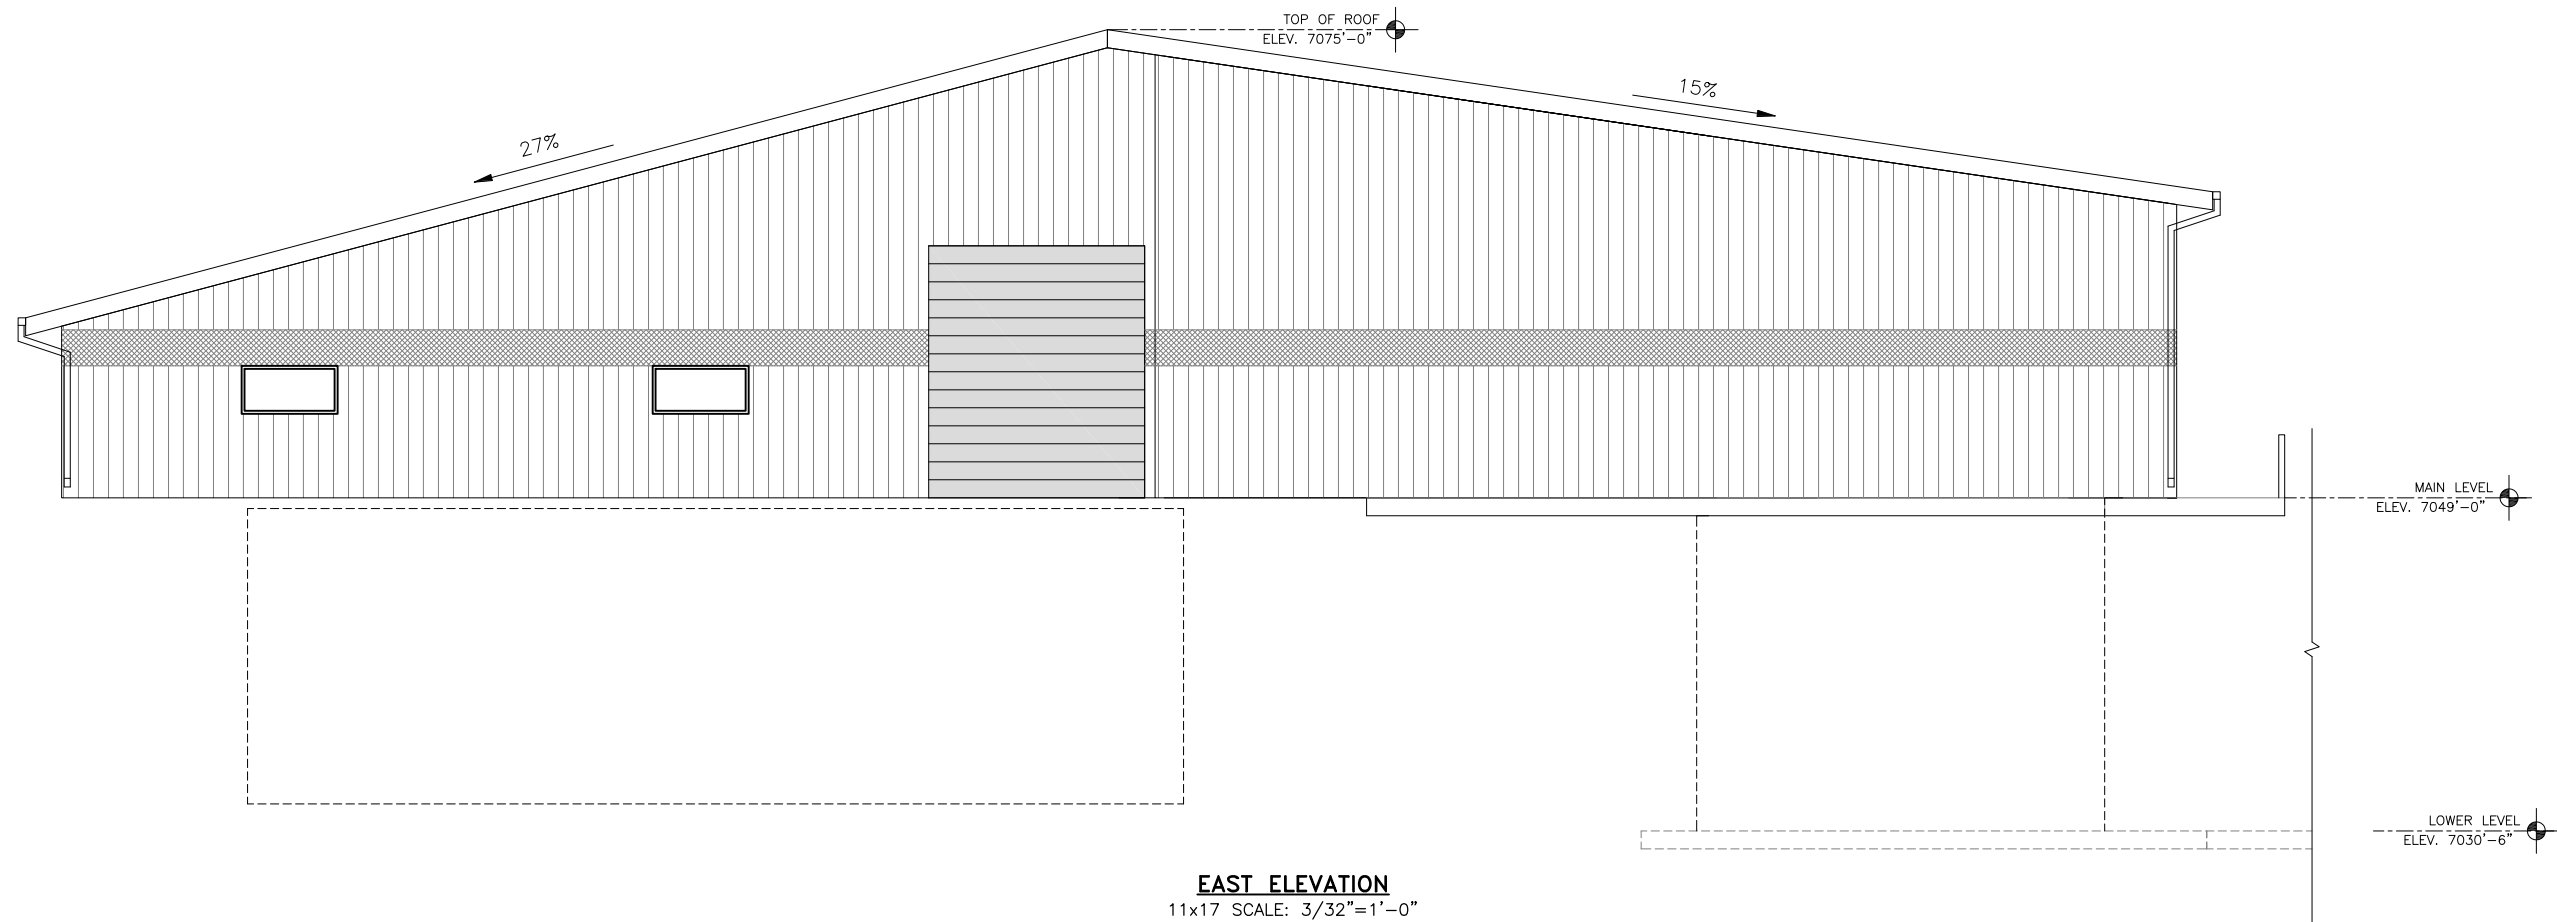

EAST ELEVATION
 11x17 SCALE: 3/32"=1'-0"
 24x36 SCALE: 3/16"=1'-0"

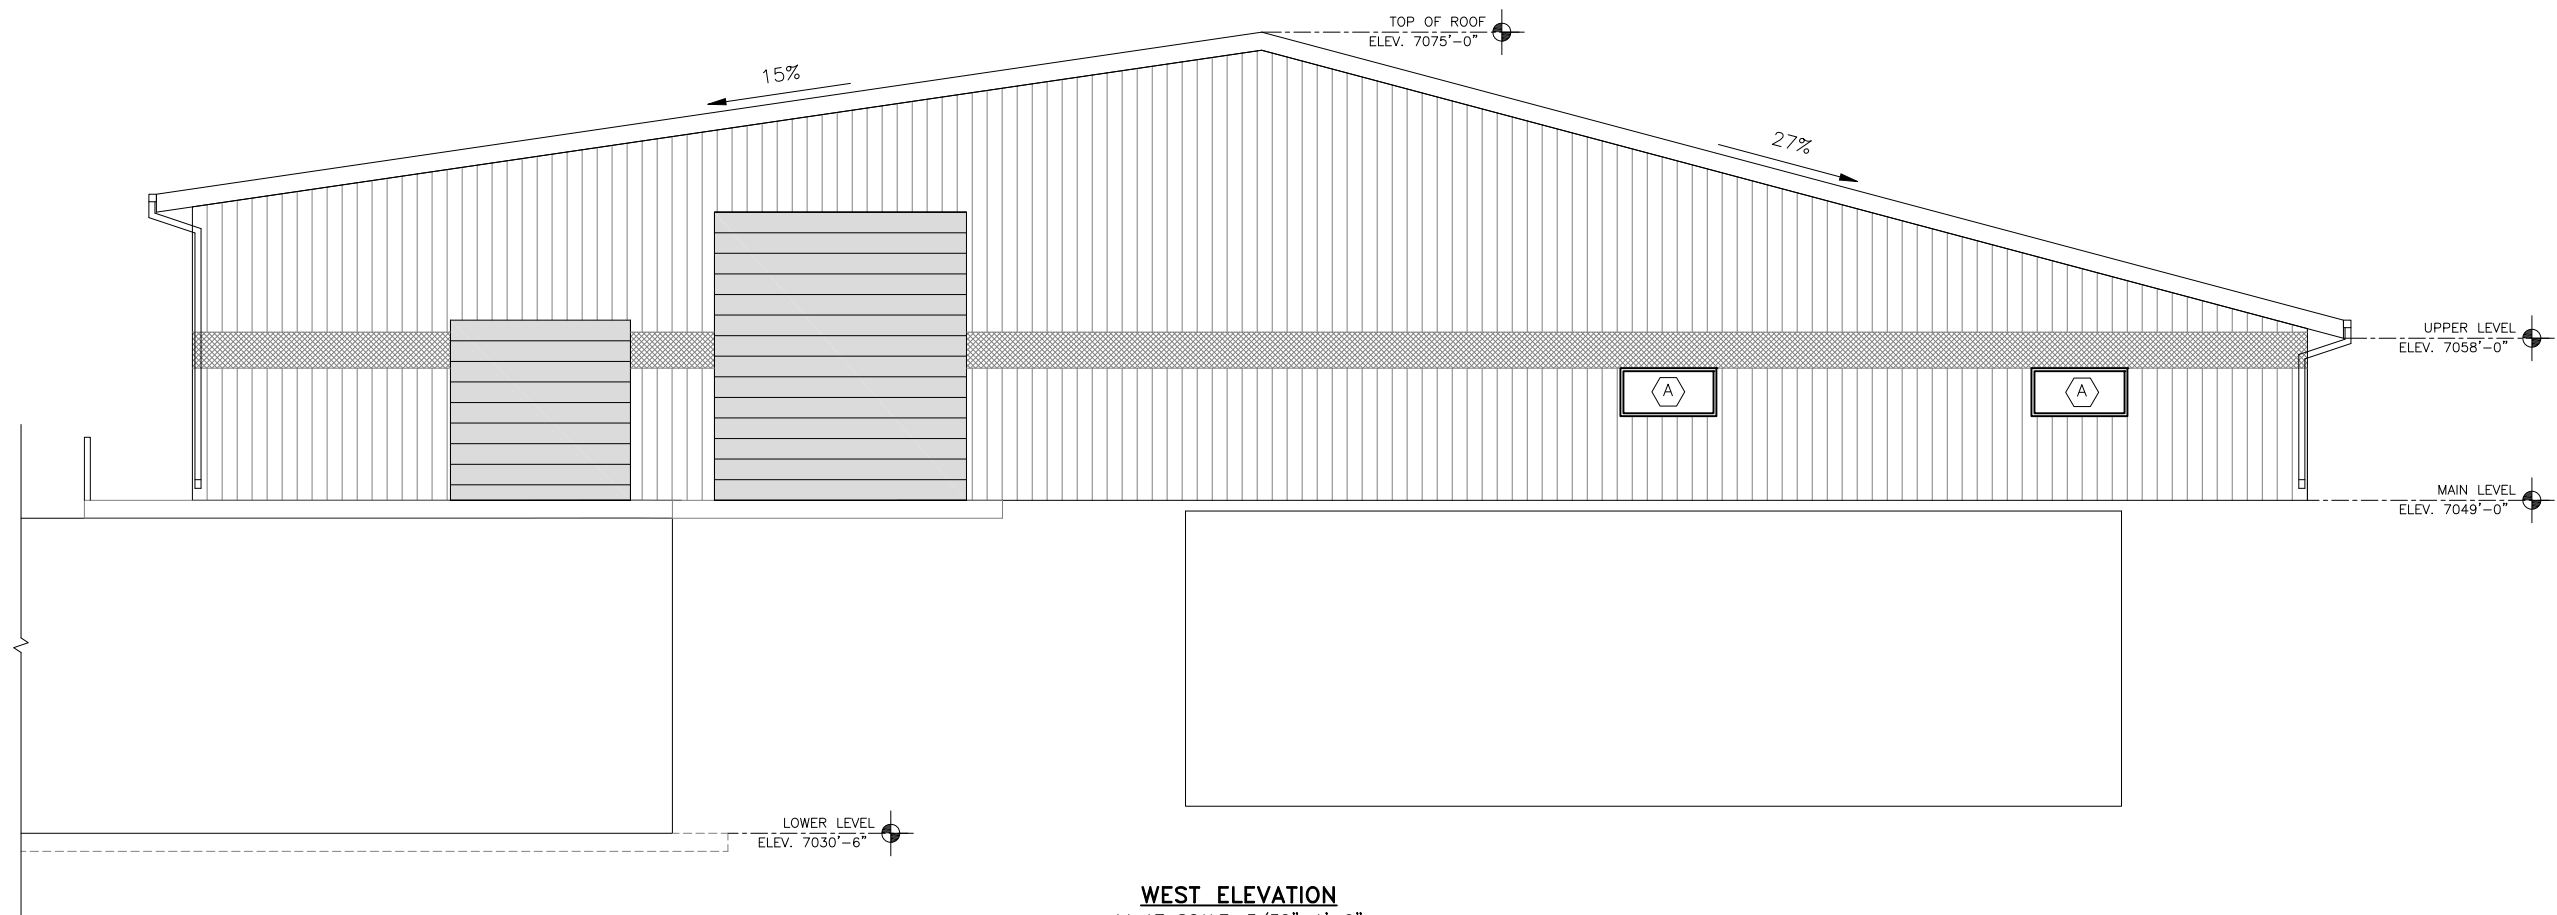


WEST ELEVATION
 11x17 SCALE: 3/32"=1'-0"
 24x36 SCALE: 3/16"=1'-0"

Project No.:	112.88
Scale:	AS NOTED
Date:	05/22/17
Design:	RMM
Drawn:	RMM
Check:	JPM
Revised:	

Markup Summary

dsdlaforce (2)

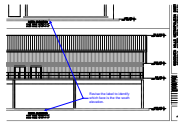

Subject: Callout
Page Label: 1
Lock: Locked
Author: dsdlaforce

Revise the label to identify which face is the the south elevation.



[Add bar scale.](#)

Subject: Text Box
Page Label: 1
Lock: Locked
Author: dsdlaforce

Add bar scale.