

WOODMEN HILLS METROPOLITAN DISTRICT
 REGIONAL WATER RECLAMATION FACILITY



LANDSCAPE PLAN


Project No.:	112.88
Scale:	AS NOTED
Date:	05/22/17
Design:	RMM
Drawn:	RMM
Check:	JPM
Revised:	



add property line and include all existing landscaping.

These are existing. Per the letter of intent you are not adding any landscaping. Please revise.

- LEGEND
-  PROPOSED TREE (TO BE REPLACED IF REMOVED)
 -  PROPOSED BUSH (TO BE REPLACED IF REMOVED)

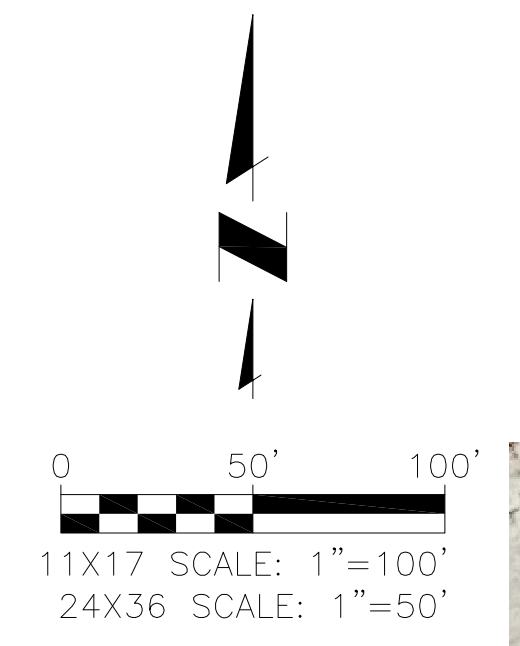

PROPOSED RIGHT-OUT (REQUIRES CURB CUTS, PERMITTING & ADHERANCE TO EL PASO COUNTY PUBLIC WORKS DEPT.)

INSTALL NEW CANTILEVER SECURITY GATE PER DETAIL ON SHEET C10.

EXISTING EFFLUENT METERING FLUME

MERIDIAN RANCH GOLF COURSE, LLC

MERIDIAN RANCH GOLF COURSE, LLC

Markup Summary

dsdruiz (2)



Subject: Callout
Page Label: 1
Lock: Locked
Author: dsdruiz

These are existing. Per the letter of intent you are not adding any landscaping. Please revise.



Subject: Text Box
Page Label: 1
Lock: Locked
Author: dsdruiz

add property line and include all existing landscaping.