

# FLYING HORSE NORTH SKETCH PLAN

A PORTION OF SECTIONS 34, 35 AND 36 TOWNSHIP 11 SOUTH, RANGE 66 WEST, AND A PORTION OF SECTIONS 30 AND 31, TOWNSHIP 11 SOUTH, RANGE 65 WEST OF THE SIXTH PRINCIPAL MERIDIAN, EL PASO COUNTY, COLORADO

staff refers to this as conventional zoning

## NOTES

### GENERAL NOTES

- A TOTAL OF 1,471 DWELLING UNITS ARE PROPOSED WITHIN THE FLYING HORSE NORTH SKETCH PLAN ON APPROXIMATELY 912.5 ACRES. THE SUBMITTAL ALSO, INCLUDES A LUXURY RESORT HOTEL AND GOLF CASITAS (UNITS) WITH 225 KEYS (ROOMS).
- CLUSTERING OF UNITS WITHIN RESIDENTIAL DISTRICTS IS PERMITTED, BUT NOT REQUIRED, SO LONG AS THE OVERALL DENSITY LIMIT IS NOT EXCEEDED. THE USE OF CLUSTERING IS ENCOURAGED TO PROMOTE COMMON OPEN SPACE, PROTECT NATURAL FEATURES, AND PROVIDE CREATIVE AND FLEXIBLE DESIGN ALTERNATIVES.
- A DENSITY TRANSFER MAY BE PERMITTED ON FLYING HORSE NORTH FOR ALL RESIDENTIAL DISTRICTS. THIS TRANSFER WOULD BE PROPOSED AT THE TIME OF REZONING AND/OR PRELIMINARY PLAN (WHERE APPROPRIATE) AND WOULD NEED TO BE REVIEWED BY STAFF TO ENSURE THAT THE OVERALL DEVELOPMENT CONCEPT IS ADHERED TO. A DENSITY TRANSFER NOT TO EXCEED TWENTY PERCENT (20%) OF THE MAXIMUM UNITS FOR EACH PARCEL IS PERMITTED. THE TRANSFERRED DENSITY SHALL MEET ALL MINIMUM REQUIREMENTS OF THE RECEIVING AREA SUCH AS LOT SIZE, SETBACKS, ETC. IN NO CASE SHALL THE OVERALL DENSITY CAP EXCEED THE TOTAL UNITS APPROVED FOR THE PROJECT.
- SPECIFIC DEVELOPMENT STANDARDS SUCH AS SETBACKS, LOT COVERAGE, BUILDING HEIGHTS AND LAND USES SHALL BE ADDRESSED WITH A SUBSEQUENT ZONING OF THE PROPERTY AT A LATER DATE. THESE STANDARDS WILL EITHER FOLLOW SPECIFIC PROPOSED PUD DEVELOPMENT PLANS OR PER COUNTY ZONING STANDARDS IF FOLLOWING "STRAIGHT ZONING" OF THE COUNTY.
- ALL COMMON LANDSCAPE, OPEN SPACE, PARKS, TRACTS AND DRAINAGE FACILITIES WITHIN THIS DEVELOPMENT SHALL BE OWNED AND MAINTAINED BY THE HOA (TO BE NAMED) OR FLYING HORSE NORTH METROPOLITAN DISTRICT WITH THE EXCEPTION OF THE COUNTY TRAIL AS DEPICTED ON THE SKETCH PLAN.
- ALL DETENTION PONDS AND CROSS LOT DRAINAGE DITCHES WILL BE LOCATED WITHIN DRAINAGE EASEMENTS PROVIDING ACCESS FOR MAINTENANCE TO THE FLYING HORSE NORTH METROPOLITAN DISTRICT OR HOA (TO BE NAMED).
- THERE SHALL BE NO DIRECT RESIDENTIAL LOT ACCESS TO BLACK FOREST ROAD EXCEPT FOR THE EXISTING STAGECOACH ROAD ACCESS AND POTENTIAL COMMERCIAL ACCESS.
- PARK IMPROVEMENTS PROVIDED BY THE DEVELOPER MAY BE APPLIED TO PARK LAND DEDICATION AND/OR FEES WITH REVIEW AND APPROVAL BY EL PASO COUNTY PARKS. ANY PARK IMPROVEMENTS WILL BE COORDINATED AT A LATER DATE WITH EL PASO COUNTY PARKS VIA PARK LAND AGREEMENTS.
- ALL ELECTRIC SERVICE SHALL BE PROVIDED BY MOUNTAIN VIEW ELECTRIC ASSOCIATION AND GAS TO BE PROVIDED BY BLACK HILLS ENERGY. NATURAL GAS EASEMENTS WILL BE PROVIDED AS REQUIRED.
- SITE LIGHTING, IF REQUIRED, WILL MEET THE REQUIREMENTS SET FORTH IN SECTION 6.2.3 OF EL PASO COUNTY LAND DEVELOPMENT CODE.
- THE DEVELOPER SHALL COMPLY WITH FEDERAL AND STATE LAWS, REGULATIONS, ORDINANCES, REVIEW AND PERMIT REQUIREMENTS, AN OTHER AGENCY REQUIREMENTS, IF ANY, OF APPLICABLE AGENCIES INCLUDING, BUT NOT LIMITED TO, THE COLORADO PARKS AND WILDLIFE, COLORADO DEPARTMENT OF TRANSPORTATION, U.S. ARMY CORPS OF ENGINEERS, AND THE U.S. FISH AND WILDLIFE SERVICE REGARDING THE ENDANGERED SPECIES ACT, PARTICULARLY AS IT RELATES TO ANY LISTED SPECIES.
- THE FOLLOWING DISTRICTS WILL SERVE THE PROPERTY
  - LEWIS-PALMER DISTRICT 38 AND ACADEMY DISTRICT 20
  - FIRE EMERGENCY - BLACK FOREST FIRE PROTECTION DISTRICT
  - EMERGENCY SERVICES - BLACK FOREST FIRE PROTECTION DISTRICT
  - TELECOM/FIBER - FORCE BROADBAND & COMCAST
  - PIKES PEAK LIBRARY DISTRICT
  - ELECTRICAL SERVICES - MVEA
- THE MAILBOX KIOSK WILL BE DETERMINED WITH EACH FINAL PLAT AND IN COORDINATION WITH THE U.S. POSTAL SERVICE.

add information regarding the fire station that it can be relocated anywhere in the SKP area. please also add information that if the Fire Department determines there is no need, that the land need not be dedicated to them.

### FLOODPLAIN NOTES:

- PORTIONS OF THIS PROPERTY ARE LOCATED WITHIN A DESIGNATED FEMA FLOODPLAIN AS DETERMINED BY THE FEMA NATIONAL FLOOD INSURANCE PROGRAM FLOOD INSURANCE MAP NUMBERS '08041C0305G' AND '08041C0315G' WITH AN EFFECTIVE DATE OF DECEMBER 7, 2018.
- THE EXISTING FLOODPLAIN BOUNDARIES ARE INTENDED TO REMAIN AND DEVELOPMENT WILL OCCUR OUTSIDE THE FLOODPLAIN LIMITS.
- NO STRUCTURES OR SOLID FENCES ARE PERMITTED WITHIN THE DESIGNATED FLOODPLAIN AREA.

### PUBLIC STREETS

- PER THE INTERGOVERNMENTAL AGREEMENT, THE CITY OF COLORADO SPRINGS WILL REQUIRE THE STREETS TO BE DESIGNED AND CONSTRUCTED TO THE CITY STANDARDS.
- SIDEWALKS OR WALKWAYS WILL BE PROVIDED ALONG ALL STREETS AND INTERIOR TO DEVELOPMENT PARCELS, PARKS AND TRAIL SYSTEMS.
- PUBLIC STREETS WITHIN THIS DEVELOPMENT SHALL PROVIDE FOR LEVELS OF VEHICULAR CIRCULATION REQUIRED BY THE TRAFFIC STUDY AND SHALL BE PAVED.
- UNTIL APPROVED BY THE COUNTY ENGINEER ALL ACCESS POINTS SHOWN ON THIS PLAN ARE CONCEPTUAL AND NON-BINDING UPON THE COUNTY APPROVAL OF THIS SKETCH PLAN AMENDMENT SHALL NOT BE INTERPRETED TO INCLUDE APPROVAL OF ANY ACCESS TO ANY PUBLIC ROADS. THE COUNTY ENGINEER SHALL APPROVE ALL ACCESSES IN ACCORDANCE WITH THE REQUIREMENTS AND PROCEDURES OF THE ENGINEERING CRITERIA MANUAL AT THE TIME OF PUD DEVELOPMENT PLAN AND/OR SUBDIVISION SUBMITTAL AND REVIEW.

### PRIVATE STREETS

- ANY FUTURE PRIVATE STREETS, IF PROPOSED, WILL BE PRIVATELY OWNED AND MAINTAINED BY THE FLYING HORSE NORTH METROPOLITAN DISTRICT NO. 1 OR HOA (HOMEOWNERS ASSOCIATION-TO BE NAMED).

### PHASING PLAN:


- THE FLYING HORSE NORTH PROJECT WILL BE DEVELOPED IN MULTIPLE PHASES AND PLATTED IN MULTIPLE FILINGS, WHICH HAVE YET TO BE DETERMINED. THE SEQUENCE OF CONSTRUCTION AND DEVELOPMENT IS NOT DEPENDENT UPON UTILITIES OR INFRASTRUCTURE.

### GEOLOGIC HAZARDS DISCLOSURE STATEMENT:

- AREAS OF PROPOSED SUBDIVISION HAVE BEEN FOUND TO BE IMPACTED BY GEOLOGICAL CONDITIONS, INCLUDING SEASONAL AND POTENTIALLY SEASONAL SHALLOW GROUND WATER, ARTIFICIAL FILL, LOOSE AND EXPANSIVE SOILS AND SLOPE STABILITY. THESE CONDITIONS CAN BE MITIGATED BY AVOIDANCE, RE-GRADING, PROPER ENGINEERING DESIGN, AND CONSTRUCTION TECHNIQUES. A MAP OF THE HAZARD AREAS AND PROPOSED MITIGATION MEASURES CAN BE FOUND IN THE GEOLOGICAL HAZARD STUDY AND WASTEWATER STUDY PREPARED BY ENTECH ENGINEERING INC., DATED JANUARY 15, 2019. FURTHER STUDIES OF THESE CONDITIONS SHALL BE PROVIDED WITH EITHER PRELIMINARY OR FINAL PLANS.


### ZONING MAP

SCALE = N.T.S.

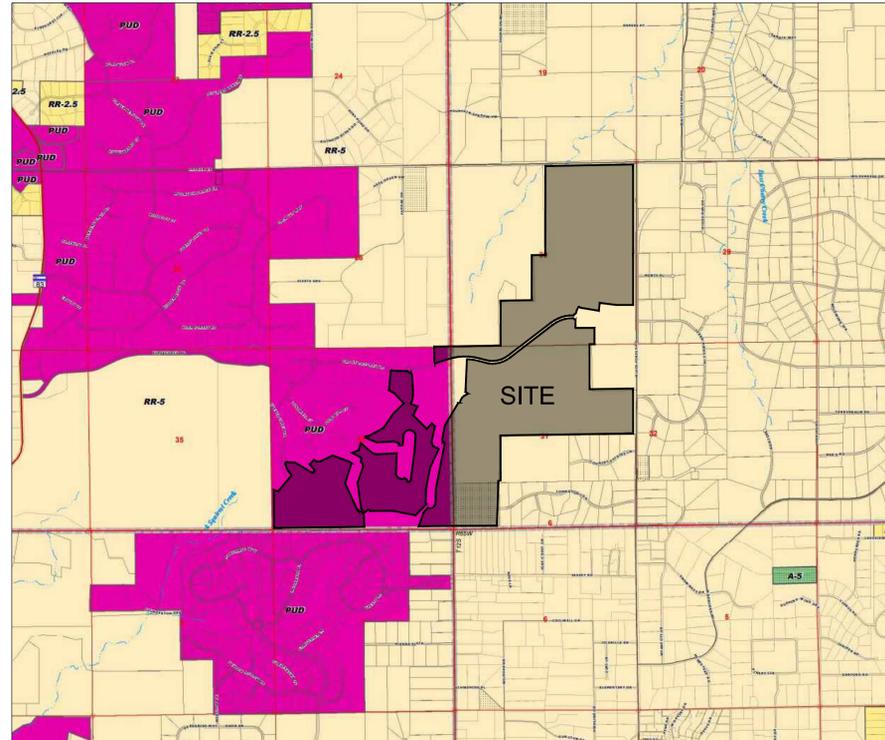

### VICINITY MAP

SCALE = N.T.S.

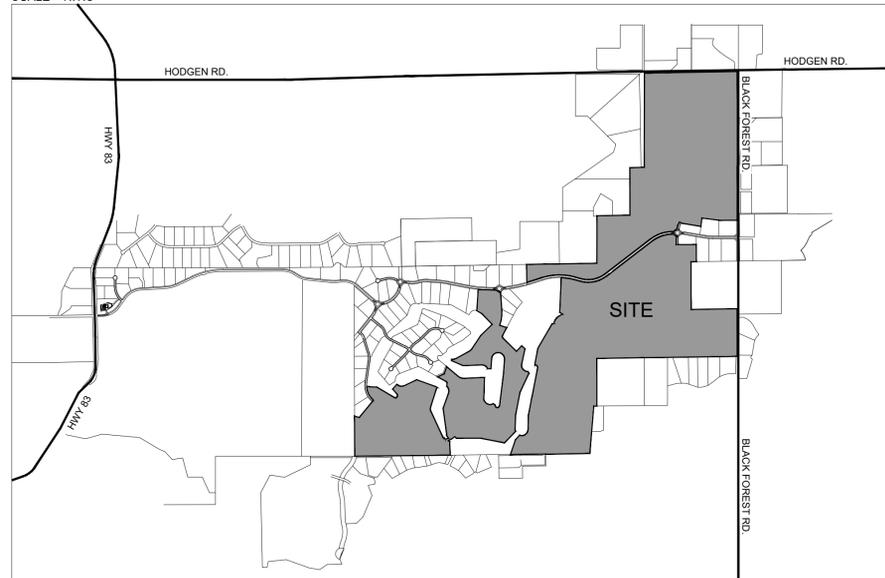

### SHEET INDEX

- SHEET 1 OF 4: COVER SHEET
- SHEET 2 OF 4: SKETCH PLAN
- SHEET 3 OF 4: ADJACENT PROPERTY MAP
- SHEET 4 OF 4: ADJACENT PROPERTY OWNERS

OWNER/DEVELOPER:  
FLYING HORSE DEVELOPMENT LLC  
2138 FLYING HORSE CLUB DRIVE  
COLORADO SPRINGS, CO 80921

PLANNER/LANDSCAPE ARCHITECT:  
HRGREEN DEVELOPMENT, LLC  
1975 RESEARCH PARKWAY SUITE 230  
COLORADO SPRINGS, CO 80920  
720.602.4941

CIVIL ENGINEER:  
HRGREEN DEVELOPMENT, LLC  
1975 RESEARCH PARKWAY SUITE 230  
COLORADO SPRINGS, CO 80920  
720.602.4965

ECOLOGIST:  
BRISTLECONE ECOLOGY  
2023 W. SCOTT PLACE  
DENVER, CO 80211  
971.237.3906

TRANSPORTATION CONSULTANTS:  
SM ROCHA, LLC  
DENVER, CO 80211  
303.458.9798

### SITE DATA

EXISTING LAND USE:	VACANT
EXISTING ZONING:	PUD & RR-5
SITE ACREAGE:	912.5 AC
MAXIMUM NUMBER OF UNITS:	1,571
MAXIMUM GROSS DENSITY:	1.72 DU/AC
TOTAL AREAS (SEE LAND USE CHART ON SHEET 2)	
RESIDENTIAL:	644.3 AC
ESTATE LOTS	161.7 AC
LOW DENSITY	346.4 AC
MEDIUM DENSITY	97.7 AC
HIGH DENSITY	38.5 AC
PARK/OPEN SPACE:	200.9 AC
OPEN SPACE	182.4 AC
PARKS/POCKET PARKS	18.5 AC
OPEN SPACE WITHIN PARCELS	(-37.4 AC)*
AMENITIES:	6.7 AC
FITNESS CENTER	4.3 AC
CLUBHOUSE	2.4 AC
HOTEL/GOLF CASITAS	18.0 AC
ROAD RIGHT-OF-WAY	63.0 AC
COMMERCIAL:	17.0 AC

NOTE (\*) - 37.4 ACRES OF OPEN SPACE WILL BE INCLUDED WITHIN PARCELS, HOWEVER, IS NOT SHOWN ON THE PLAN.

there is a - sign shown

SKP223

COUNTY FILE NUMBER: #####

HR GREEN Xref: xref-1-ARCH-DH01

DRAWN BY: JAG JOB DATE: 3/1/2022  
APPROVED: PLS JOB NUMBER: 211030  
CAD DATE: 3/15/2022  
CAD FILE: J:\2021\211030\CAD\Drawings\CISketch-Plan\COVER-SHEET

BAR IS ONE INCH ON OFFICIAL DRAWINGS.  
IF NOT ONE INCH, ADJUST SCALE ACCORDINGLY.

NO.	DATE	BY	REVISION DESCRIPTION



FLYING HORSE NORTH DEVELOPMENT, LLC.  
EL PASO COUNTY, COLORADO

FLYING HORSE NORTH SKETCH PLAN  
COVER SHEET

SHEET SP.1  
1



# FLYING HORSE NORTH SKETCH PLAN

Recommend reviewing the Hodgen Rd access Management Plan (snippet to the left) and showing the connection from Hodgen Road w/ potential cul-de-sac at the south when Black Forest Rd realignment occurs.

### LEGEND

	ESTATE LOTS		SCHOOL DISTRICT LINE
	LOW DENSITY		FHN TRAIL
	1 ACRE LOTS		PUBLIC COUNTY TRAIL
	MEDIUM DENSITY		DRAINAGE WAY
	HIGH DENSITY		PARK/POCKET PARK
	HOSPITALITY/GOLF CLUB/COMMERCIAL		FITNESS CENTER
	HOTEL COMPLEX		POTENTIAL FIRE STATION
	CLUB		PROPOSED DETENTION
	HOTEL PARKING		
	ROADWAY		
	DETENTION		
	SITE BOUNDARY		

the drainage way is difficult to see as it is overlaid by other layers. please consider adjusting the line weight.

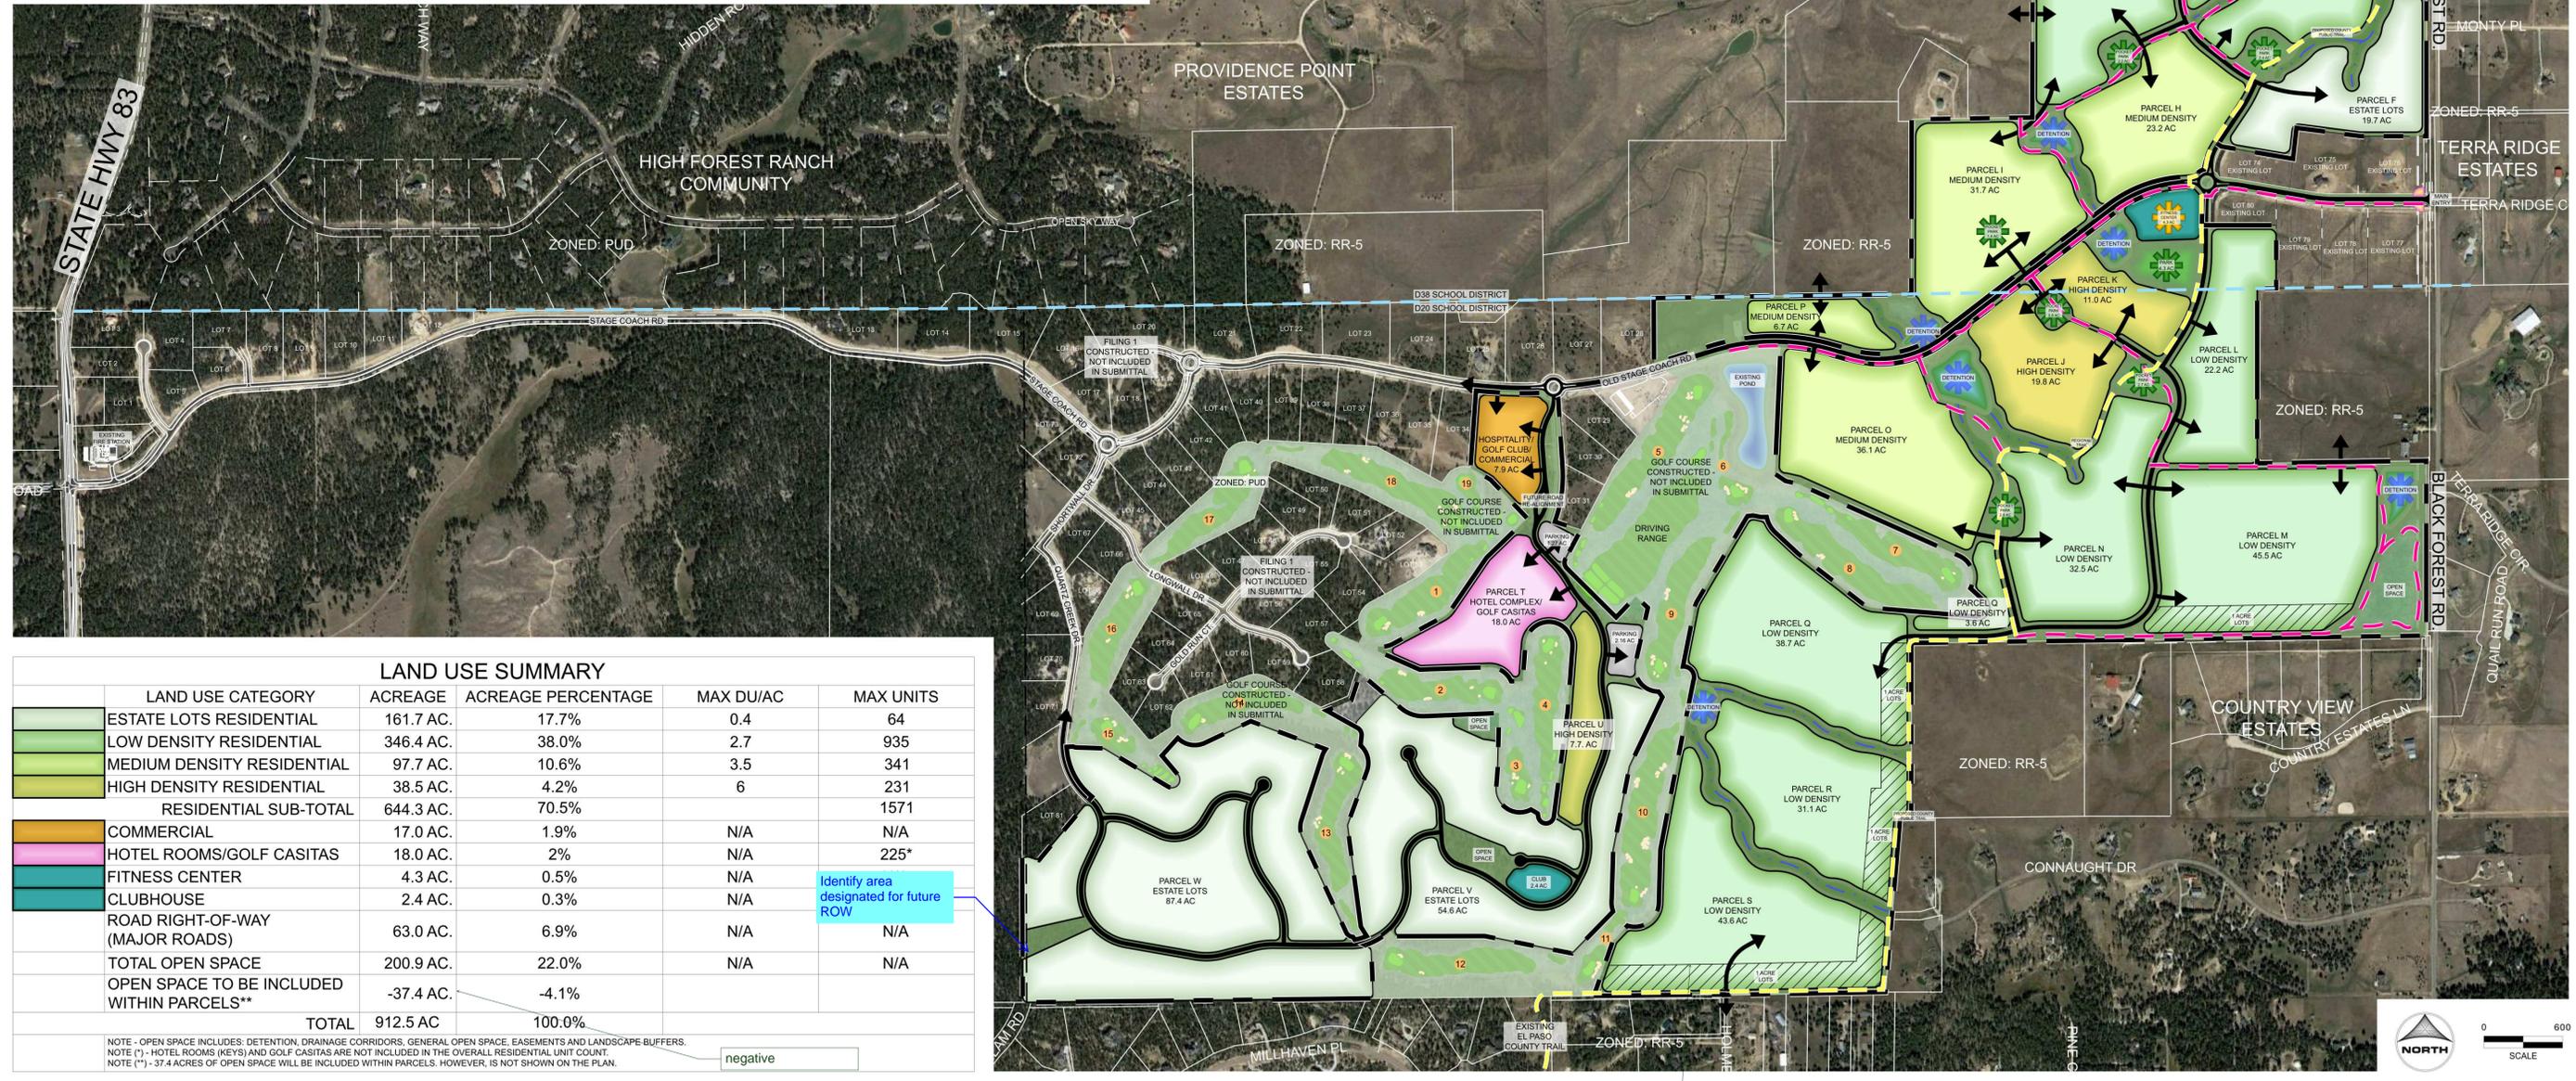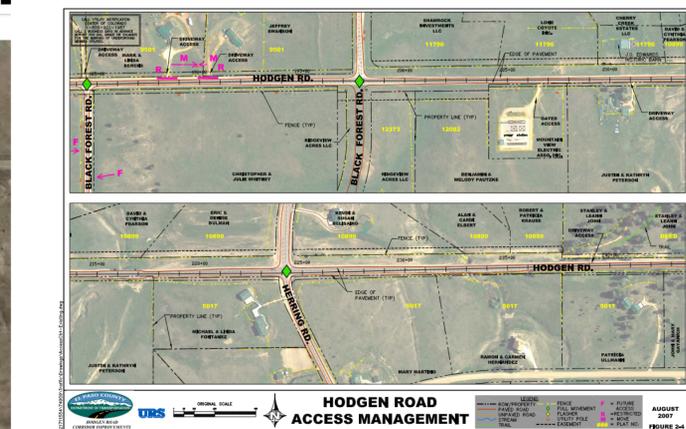

### LAND USE SUMMARY

LAND USE CATEGORY	ACREAGE	ACREAGE PERCENTAGE	MAX DU/AC	MAX UNITS
ESTATE LOTS RESIDENTIAL	161.7 AC.	17.7%	0.4	64
LOW DENSITY RESIDENTIAL	346.4 AC.	38.0%	2.7	935
MEDIUM DENSITY RESIDENTIAL	97.7 AC.	10.6%	3.5	341
HIGH DENSITY RESIDENTIAL	38.5 AC.	4.2%	6	231
<b>RESIDENTIAL SUB-TOTAL</b>	<b>644.3 AC.</b>	<b>70.5%</b>		<b>1571</b>
COMMERCIAL	17.0 AC.	1.9%	N/A	N/A
HOTEL ROOMS/GOLF CASITAS	18.0 AC.	2%	N/A	225*
FITNESS CENTER	4.3 AC.	0.5%	N/A	
CLUBHOUSE	2.4 AC.	0.3%	N/A	
ROAD RIGHT-OF-WAY (MAJOR ROADS)	63.0 AC.	6.9%	N/A	N/A
TOTAL OPEN SPACE	200.9 AC.	22.0%	N/A	N/A
OPEN SPACE TO BE INCLUDED WITHIN PARCELS**	-37.4 AC.	-4.1%		
<b>TOTAL</b>	<b>912.5 AC</b>	<b>100.0%</b>		

NOTE - OPEN SPACE INCLUDES: DETENTION, DRAINAGE CORRIDORS, GENERAL OPEN SPACE, EASEMENTS AND LANDSCAPE BUFFERS.  
 NOTE (\*) - HOTEL ROOMS (KEYS) AND GOLF CASITAS ARE NOT INCLUDED IN THE OVERALL RESIDENTIAL UNIT COUNT.  
 NOTE (\*\*) - 37.4 ACRES OF OPEN SPACE WILL BE INCLUDED WITHIN PARCELS. HOWEVER, IS NOT SHOWN ON THE PLAN.

HR GREEN Xrefs: EX: Topo; EX: Alt; wfp-1-ARCH-D101

DRAWN BY: JAG      JOB DATE: 2/25/2022  
 APPROVED: PLS      JOB NUMBER: 211030  
 CAD DATE: 2/25/2022  
 CAD FILE: J:\2021\211030\CAD\Drawings\C\Sketch-Plan\BUBBLE-PLAN

NO.	DATE	BY	REVISION DESCRIPTION




FLYING HORSE NORTH DEVELOPMENT, LLC.  
 EL PASO COUNTY, COLORADO

please provide a rough depth of the buffer area.

FLYING HORSE NORTH SKETCH PLAN  
 SKETCH PLAN DRAWING

SHEET SP.2 2

# FLYING HORSE NORTH SKETCH PLAN

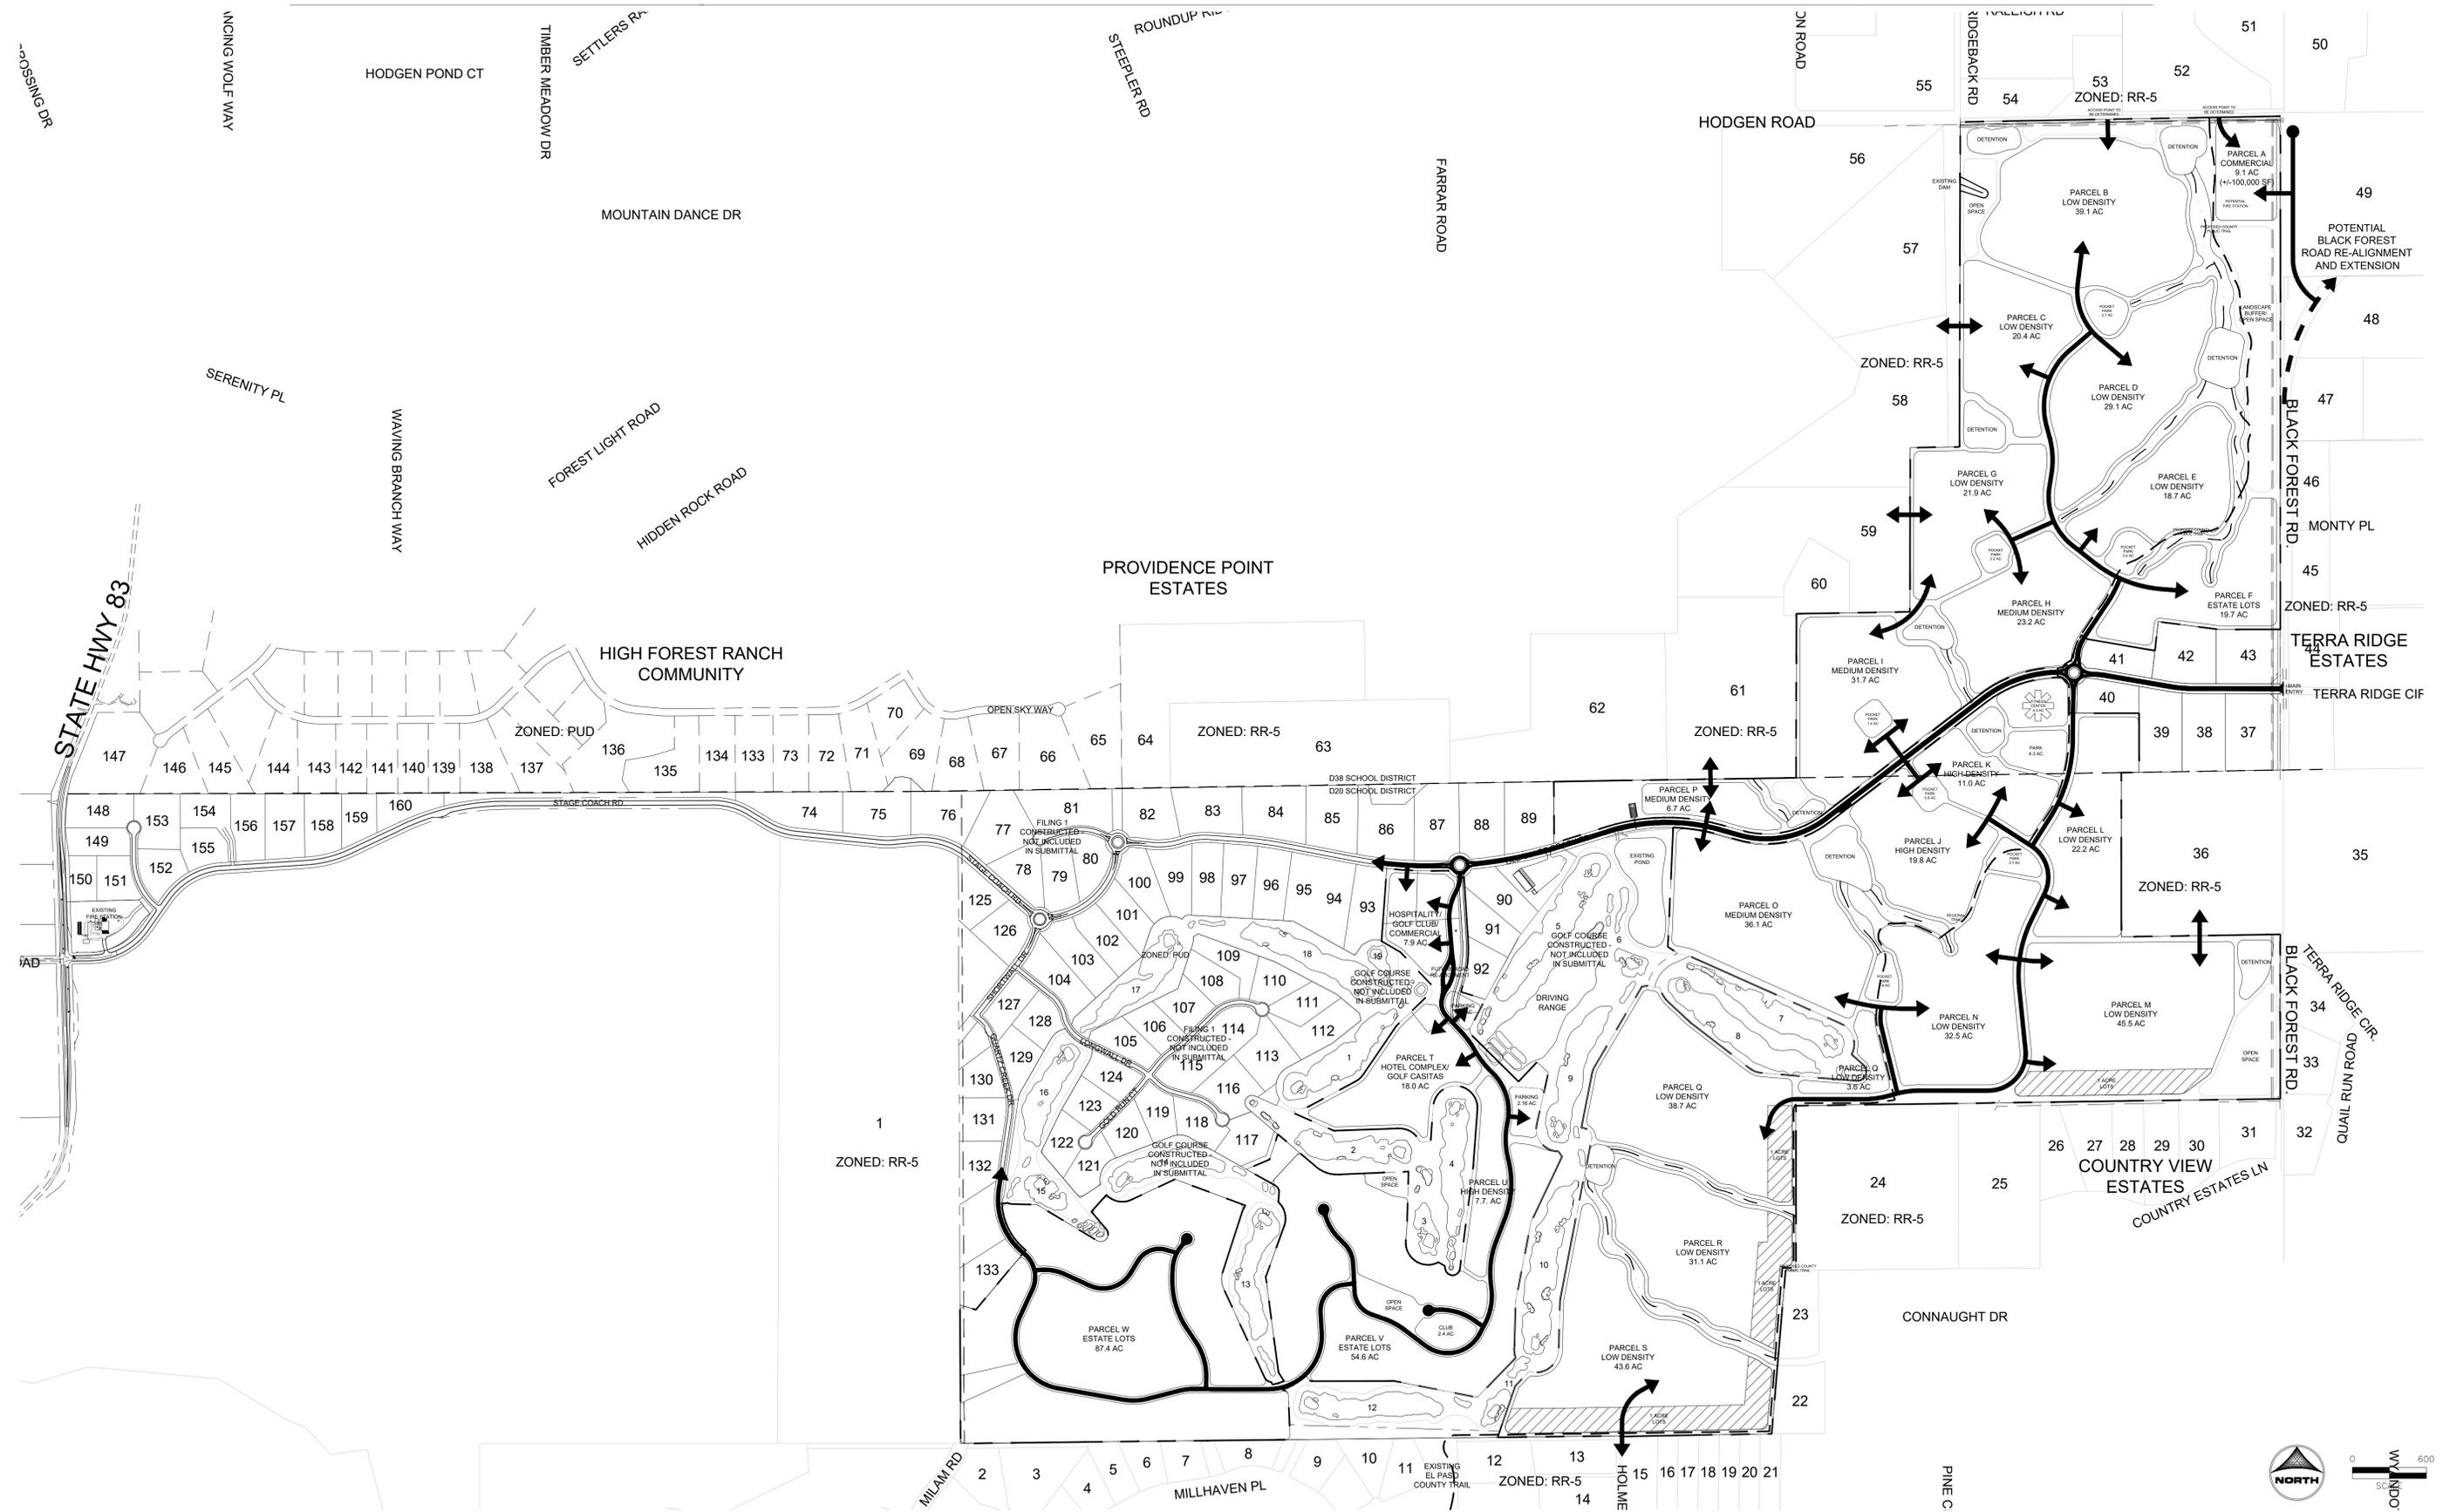

HR GREEN Xref: xref-ARCH-DH01-BUBBLE-PLAN-EX-A18

DRAWN BY: JAG      JOB DATE: 3/1/2022      BAR IS ONE INCH ON OFFICIAL DRAWINGS.  
 APPROVED: PLS      JOB NUMBER: 211030      0" = 1"      IF NOT ONE INCH, ADJUST SCALE ACCORDINGLY.  
 CAD DATE: 2/21/2022  
 CAD FILE: J:\2021\211030\CAD\Drawings\Sketch-Plan\ADJACENT-PROPERTY

NO.	DATE	BY	REVISION DESCRIPTION



FLYING HORSE NORTH DEVELOPMENT, LLC.  
 EL PASO COUNTY, COLORADO

FLYING HORSE NORTH SKETCH PLAN  
 ADJACENT PROPERTY DATA MAP

SHEET SP.3 3

Please revise per

# FLYING HORSE NORTH SKETCH PLAN

**ADJACENT PROPERTY OWNERS**

1. SHAMROCK SS LLC ZONING - RR-5 15555 HWY 83 COLORADO SPRINGS, CO	17.SELF BOB J ZONED - RR-5 5910 VESSEY ROAD COLORADO SPRINGS, CO	33. WINNINGHAM AARON JASON ZONED - RR-5 14940 QUAIL RUN ROAD COLORADO SPRINGS, CO	49. WHITNEY CHRISTOPHER D ZONED - RR-5 16485 BLACK FOREST ROAD COLORADO SPRINGS, CO	65. BREWER GEORGE F II ZONED - PUD 15501 OPEN SKY WAY COLORADO SPRINGS, CO	81. SIDWELL DUSTIN JEFFREY ZONED - PUD 4990 OLD STAGECOACH ROAD COLORADO SPRINGS, CO	97. KELLY J PHELAN TRUST ZONED - PUD 5155 OLD STAGECOACH ROAD COLORADO SPRINGS, CO	113. VILLAGREE LLC ZONED - PUD 5231 GOLD RUN COURT COLORADO SPRINGS, CO	129. ST AUBYN JARED ZONED - PUD 15233 QUARTZ CREEK DRIVE COLORADO SPRINGS, CO	145. HOUSE JAMIE GLEN ZONED - PUD 15575 WINDING TRAIL ROAD COLORADO SPRINGS, CO
2. BRI J FAMILY TRUST ZONED - PUD 4820 FOXCHASE WAY COLORADO SPRINGS, CO	18.JONES INGRID L ZONED - RR-5 5940 VESSEY ROAD COLORADO SPRINGS, CO	34. LYNDE ROBERT A ZONED - RR-5 15015 TERRA RIDGE CIRCLE COLORADO SPRINGS, CO	50. BERENS MARK E ZONED - RR-5 6850 HODGEN ROAD COLORADO SPRINGS, CO	66. MONTGOMERY MONTIE C ZONED - PUD 15547 OPEN SKY WAY COLORADO SPRINGS, CO	82. SPARKS DUSTIN R ZONED - PUD 5070 OLD STAGECOACH ROAD COLORADO SPRINGS, CO	98. WINGO JAMES D ZONED - PUD 5115 OLD STAGECOACH ROAD COLORADO SPRINGS, CO	114. S&J TRUST ZONED - PUD 5201 GOLD RUN COURT COLORADO SPRINGS, CO	130. MOMBER SIMON R ZONED - PUD 15232 QUARTZ CREEK DRIVE COLORADO SPRINGS, CO	146. MATALIUS ANDREW J III ZONED - PUD 15525 WINDING TRAIL ROAD COLORADO SPRINGS, CO
3. PIASECKI NANCY L REVOC TRUST ZONED - PUD 4940 FOXCHASE WAY COLORADO SPRINGS, CO	19.RUPP JERRREY D ZONED - RR-5 5970 VESSEY ROAD COLORADO SPRINGS, CO	35. SPLIT PINE RANCH LIVING TRUST ZONED - RR-5 15385 BLACK FOREST ROAD COLORADO SPRINGS, CO	51. MOLES JUSTIN ZONED - RR-5 16550 BLACK FOREST ROAD COLORADO SPRINGS, CO	67. RANGER CANDACE S LIVING TRUST ZONED - PUD 15593 OPEN SKY WAY COLORADO SPRINGS, CO	83. SPILLERS STEVEN HOWARD ZONED - PUD 5150 OLD STAGECOACH ROAD COLORADO SPRINGS, CO	99. KIM MICHAEL SANG-HAK ZONED - PUD 5075 OLD STAGECOACH ROAD COLORADO SPRINGS, CO	115. CHAVEZ XAVIER D ZONED - PUD 5141 GOLD RUN COURT COLORADO SPRINGS, CO	131. SHABE ERIC M ZONED - PUD 15182 QUARTZ CREEK DRIVE COLORADO SPRINGS, CO	147. WATSON RANDY ZONED - PUD 15520 WINDING TRAIL ROAD COLORADO SPRINGS, CO
4. BRINGARD FAMILY LICING TRUST ZONED - PUD 14465 MILLHAVEN PLACE COLORADO SPRINGS, CO	20. LITTLETON STANLEY ZONED - RR-5 6010 VESSEY ROAD COLORADO SPRINGS, CO	36. APODACA LESLIE E ZONED - RR-5 15380 BLACK FOREST ROAD COLORADO SPRINGS, CO	52. MUNSON BRANDON J ZONED - RR-5 16710 BLACK FOREST ROAD COLORADO SPRINGS, CO	68. JANNELLE EVA ALLEN REVOCABLE TRUST ZONED - PUD 15639 OPEN SKY WAY COLORADO SPRINGS, CO	84. PECK JAMES D ZONED - PUD 5230 OLD STAGECOACH ROAD COLORADO SPRINGS, CO	100. TEUSCHER KURT ZONED - PUD 5035 OLD STAGECOACH ROAD COLORADO SPRINGS, CO	116. DALY FAMILY TRUST ZONED - PUD 14911 LONGWALL DRIVE COLORADO SPRINGS, CO	132. ZACHAR MICHAEL R ZONED - PUD 15132 QUARTZ CREEK DRIVE COLORADO SPRINGS, CO	148. MARSHALL KARLYE ZONED - PUD 15480 BILLINGS COURT COLORADO SPRINGS, CO
5. ALLAN NEAL A ZONED - PUD 14425 MILLHAVEN PLACE COLORADO SPRINGS, CO	21. SWANSON BRECK C ZONED - RR-5 6030 VESSEY ROAD COLORADO SPRINGS, CO	37. DERKSEN PROPERTIES LLC ZONED - PUD 6755 OLD STAGECOACH ROAD COLORADO SPRINGS, CO	53. MILLER ROBERT S ZONED - RR-5 6520 HODGEN ROAD COLORADO SPRINGS, CO	69. STUDHOLME FAMILY TRUST ZONED - PUD 15685 OPEN SKY WAY COLORADO SPRINGS, CO	85. WELLER ERICH G ZONED - PUD 5310 OLD STAGECOACH ROAD COLORADO SPRINGS, CO	101. DOWNS BRADLEY JAMES ZONED - PUD 55305 OLD STAGECOACH ROAD COLORADO SPRINGS, CO	117. STIMPLE FAMILY LLLP ZONED - PUD 14842 LONGWALL DRIVE COLORADO SPRINGS, CO	133. HARVEY SETH A ZONED - PUD 15032 QUARTZ CREEK DRIVE COLORADO SPRINGS, CO	149. VANCE ERZA G ZONED - PUD 15450 BILLINGS COURT COLORADO SPRINGS, CO
6. ALEX & AUTUMM SIMPSON ZONED - PUD 14385 MILLHAVEN PLACE COLORADO SPRINGS, CO	22. HOOKS GROUP LP ZONED - RR-5 6005 CONNAUGHT DRIVE COLORADO SPRINGS, CO	38. NGUYEN LINH T ZONED - PUD 6715 OLD STAGECOACH ROAD COLORADO SPRINGS, CO	54. JOHN R SHANTZ & BELINDA S ZONED - RR-5 16547 RIDGEBACK ROAD COLORADO SPRINGS, CO	70. MAHER FAMILY REVOC LIVING TRUST ZONED - PUD 4961 HIGH FOREST ROAD COLORADO SPRINGS, CO	86. LAM TU T ZONED - PUD 5390 OLD STAGECOACH ROAD COLORADO SPRINGS, CO	102. KAVERMAN JOSEPH A ZONED - PUD 5215 OLD STAGECOACH ROAD COLORADO SPRINGS, CO	118. CREPS DARREL E III ZONED - PUD 14912 LONGWALL DRIVE COLORADO SPRINGS, CO	134. PITTS JOHN ZONED - PUD 4661 HIGH FOREST ROAD COLORADO SPRINGS, CO	150. PRI #2 LLC ZONED - PUD HIGHWAY 83 COLORADO SPRINGS, CO
7. MAITHILI VENKATACHALLAM ZONED - PUD 14345 MILLHAVEN PLACE COLORADO SPRINGS, CO	23. MCILRATH WILLIAM F TRUSTEE ZONED - RR-5 6010 CONNAUGHT DRIVE COLORADO SPRINGS, CO	39. MONACO57 LIVING TRUST ZONED - PUD 6675 OLD STAGECOACH ROAD COLORADO SPRINGS, CO	55. NAVARETTE JEANINE A ZONED - RR-5 6280 HODGEN ROAD COLORADO SPRINGS, CO	71. STEPHENSON TRAVIS ZONED - PUD 4901 HIGH FOREST ROAD COLORADO SPRINGS, CO	87. LUERS BEACH LLC ZONED - PUD 5470 OLD STAGECOACH ROAD COLORADO SPRINGS, CO	103. PIEPER RANDALL L ZONED - PUD 5125 OLD STAGECOACH ROAD COLORADO SPRINGS, CO	119. CAIN JASON ZONED - PUD 14982 LONGWALL DRIVE COLORADO SPRINGS, CO	135. LAVEZZO NICHOLAS J ZONED - PUD 1601 HIGH FOREST ROAD COLORADO SPRINGS, CO	151. MCKENZIE J THOMAS ZONED - PUD 15420 BILLINGS COURT COLORADO SPRINGS, CO
8. DULANEY KIMBERLY L ZONED - PUD 14325 MILLHAVEN PLACE COLORADO SPRINGS, CO	24. WAY MARGARET E ZONED - RR-5 14820 BLACK FOREST ROAD COLORADO SPRINGS, CO	40. ST HENRYS LLC ZONED - PUD 6595 OLD STAGECOACH ROAD COLORADO SPRINGS, CO	56. ANDREWS SCOTT W ZONED - PUD HODGEN ROAD COLORADO SPRINGS, CO	72. JOHNSON LIVING TRUST ZONED - PUD 4841 HIGH FOREST ROAD COLORADO SPRINGS, CO	88. GREENWOOD TAYLOR J ZONED - PUD 5550 OLD STAGECOACH ROAD COLORADO SPRINGS, CO	104. SHECTER TRUST ZONED - PUD 15291 LONGWALL DRIVE COLORADO SPRINGS, CO	120. DICKEY MICHAEL R ZONED - PUD 5021 GOLD RUN CT COLORADO SPRINGS, CO	136. HIGH FOREST RANCH HOMEOWNERS ZONED - PUD 4541 HIGH FOREST ROAD COLORADO SPRINGS, CO	152. JONE LUCAS ZONED - PUD 15419 BILLINGS COURT COLORADO SPRINGS, CO
9. SMITH PAUL R ZONED - PUD 14265 MILLHAVEN PLACE COLORADO SPRINGS, CO	25. ABELL LIVING TRUST ZONED - RR-5 6620 COUNTRY ESTATES LANE COLORADO SPRINGS, CO	41. SMITH AARON ZONED - PUD 6590 OLD STAGECOACH ROAD COLORADO SPRINGS, CO	57. DEIM CONNIE ZONED - RR-5 SUNDANCE RANCH LANE COLORADO SPRINGS, CO	73. RAMIREZ MELODY B ZONED - PUD 4781 HIGH FOREST ROAD COLORADO SPRINGS, CO	89. LONG RUSSEL I ZONED - PUD 5630 OLD STAGECOACH ROAD COLORADO SPRINGS, CO	105. CHRISTOPHER MICHAEL MARSHALL ZONED - PUD 15051 LONGWALL DRIVE COLORADO SPRINGS, CO	121. LIDDIARD JEREMY ZONED - PUD 5013 GOLD RUN CT COLORADO SPRINGS, CO	137. SALGADO PAUL R ZONED - PUD 4415 HIDDEN ROCK ROAD COLORADO SPRINGS, CO	153. ROGER WILLIAM T ZONED - PUD 15479 BILLINGS COURT COLORADO SPRINGS, CO
10.ANDERSON MATTHEW P ZONED - PUD 5025 VESSEY ROAD COLORADO SPRINGS, CO	26. HERRON PATRICK J ZONED - RR-5 6650 COUNTRY ESTATES LANE COLORADO SPRINGS, CO	42. HARRIS GEORGE D ZONED - PUD 6670 OLD STAGECOACH ROAD COLORADO SPRINGS, CO	58. BR&C INC ZONED - RR-5 30-11-65 COLORADO SPRINGS, CO	74. FOWLER NORMAN W ZONED - PUD 4670 OLD STAGECOACH ROAD COLORADO SPRINGS, CO	90. PECK MICHAEL S ZONED - PUD 5555 OLD STAGECOACH ROAD COLORADO SPRINGS, CO	106. BECKER JACOB J ZONED - PUD 5142 GOLD RUN COURT COLORADO SPRINGS, CO	122. MILLER SCOTT G ZONED - PUD 5012 GOLD RUN CT COLORADO SPRINGS, CO	138. JOHNSON GREGG ZONED - PUD 4365 HIDDEN ROCK ROAD COLORADO SPRINGS, CO	154. DOMBROWSKI MICHAEL J ZONED - PUD 3680 STAGECOACH ROAD COLORADO SPRINGS, CO
11.ESPENLAUB ECTON ZONED - PUD 4985 VESSEY ROAD COLORADO SPRINGS, CO	27. ABELL LIVING TRUST ZONED - RR-5 6620 COUNTRY ESTATES LANE COLORADO SPRINGS, CO	43. MCCGRATH DONALD T ZONED - PUD 6750 OLD STAGECOACH ROAD COLORADO SPRINGS, CO	59. BR&C INC ZONED - RR-5 30-11-65 COLORADO SPRINGS, CO	75. OLSON TYRONE L ZONED - PUD 4760 OLD STAGECOACH ROAD COLORADO SPRINGS, CO	91. RENNER LLC ZONED - PUD 15331 ALLEN RANCH ROAD COLORADO SPRINGS, CO	107. KEV PARTNERS LTD ZONED - PUD 5172 GOLD RUN COURT COLORADO SPRINGS, CO	123. BRENNAN THOMAS LIVING TRUST ZONED - PUD 5022 GOLD RUN CT COLORADO SPRINGS, CO	139. ROMANS LIVING TRUST ZONED - PUD 4315 HIDDEN ROCK ROAD COLORADO SPRINGS, CO	155. ROBIN SCOTT BROWN LIVING TRUST ZONED - PUD 3590 STAGECOACH ROAD COLORADO SPRINGS, CO
12.DILLINGHAM MICHAEL V ZONED - RR-5 14498 HOLMES ROAD COLORADO SPRINGS, CO	28. COPPOCK AARON O ZONED - RR-5 6680 COUNTRY ESTATES LANE COLORADO SPRINGS, CO	44. MIKUSKA ERIC ZONED - RR-5 15645 TERRA RIDGE CIRCLE COLORADO SPRINGS, CO	60. CHEROKEE METROPOLITAN DISTRICT ZONED - RR-5 30-11-65 COLORADO SPRINGS, CO	76. JONES CHRISTOPHER P ZONED - PUD 4850 OLD STAGECOACH ROAD COLORADO SPRINGS, CO	92. BOOGAARD RYAN ZONED - PUD 15271 ALLEN RANCH ROAD COLORADO SPRINGS, CO	108. HENDRICKS JAMES ZONED - PUD 5202 GOLD RUN COURT COLORADO SPRINGS, CO	124. WINTER CHARLES C ZONED - PUD 5082 GOLD RUN CT COLORADO SPRINGS, CO	140. RYAN CHRISTOPHER J ZONED - PUD 4265 HIDDEN ROCK ROAD COLORADO SPRINGS, CO	156. JACKOWIAK RYAN ZONED - PUD 3770 STAGECOACH ROAD COLORADO SPRINGS, CO
13.THOMAS JOHN K ZONED - RR-5 14490 HOLMES ROAD COLORADO SPRINGS, CO	29. MACEDO JUAN H LOMEIL ZONED - RR-5 6710 COUNTRY ESTATES LANE COLORADO SPRINGS, CO	45. GARD DIANA M ZONED - RR-5 6835 MONTY PLACE COLORADO SPRINGS, CO	61. SUNDANCE RANCH OF BLACK FOREST ZONED - RR-5 HODGEN ROAD COLORADO SPRINGS, CO	77. WALTERS MICHAEL A ZONED - PUD 4910 OLD STAGECOACH ROAD COLORADO SPRINGS, CO	93. ALEXANDER SCOTT E ZONED - PUD 5395 OLD STAGECOACH ROAD COLORADO SPRINGS, CO	109. C&C LIVING TRUST ZONED - PUD 5232 GOLD RUN COURT COLORADO SPRINGS, CO	125. THEOBARD CHARLES N ZONED - PUD 4945 OLD STAGECOACH ROAD COLORADO SPRINGS, CO	141. MARY CLAUDE F TRUSTEE ZONED - PUD 4215 HIDDEN ROCK ROAD COLORADO SPRINGS, CO	157. BALSICK LUKE A ZONED - PUD 3860 STAGECOACH ROAD COLORADO SPRINGS, CO
14.ERNST CHARLES H ZONED - RR-5 14410 HOMES ROAD COLORADO SPRINGS, CO	30. SOMBRIC WAYNE S ZONED - RR-5 6740 COUNTRY ESTATES LANE COLORADO SPRINGS, CO	46. FRANKOVIS JESSE J ZONED - RR-5 6840 MONTY PLACE COLORADO SPRINGS, CO	62. SUNDANCE RANCH OF BLACK FOREST ZONED - RR-5 HODGEN ROAD COLORADO SPRINGS, CO	78. YOUNG MICHAEL J ZONED - PUD 4915 OLD STAGECOACH ROAD COLORADO SPRINGS, CO	94. CLAWSON MATTHEW R ZONED - PUD 5355 OLD STAGECOACH ROAD COLORADO SPRINGS, CO	110. ALBRIGHT MARK PHILLIP ZONED - PUD 5262 GOLD RUN COURT COLORADO SPRINGS, CO	126. HOWARTH WILLIAM ZONED - PUD 15290 SHORTWALL DRIVE COLORADO SPRINGS, CO	142. STREVELL MICHAEL W ZONED - PUD 4165 HIDDEN ROCK ROAD COLORADO SPRINGS, CO	158. HIMES ELMER S ZONED - PUD 3950 STAGECOACH ROAD COLORADO SPRINGS, CO
15.WAUGH JOSHUA T ZONED - RR-5 14445 HOLMES ROAD COLORADO SPRINGS, CO	31. HOPSON SEAN ZONED - RR-5 6770 COUNTRY ESTATES LANE COLORADO SPRINGS, CO	47. OLIVAS SOCORRO J ZONED - RR-5 6905 ALPACA HEIGHTS COLORADO SPRINGS, CO	63. SHELL JAMES R II ZONED - RR-5 15550 FARRAR ROAD COLORADO SPRINGS, CO	79. DAY GREGORY ZONED -PUD 4955 OLD STAGECOACH ROAD COLORADO SPRINGS, CO	95. PLAISTOWE NORMAN H ZONED - PUD 5315 OLD STAGECOACH ROAD COLORADO SPRINGS, CO	111. VILIESIS TRUST ZONED - PUD 5292 GOLD RUN COURT COLORADO SPRINGS, CO	127. GERBER JOSEPH DAVID ZONED - PUD 15262 SHORTWALL DRIVE COLORADO SPRINGS, CO	143. GOULD TODD E ZONED - PUD 4115 HIDDEN ROCK ROAD COLORADO SPRINGS, CO	159. OTERO THEODOAORE M III ZONED - PUD 4040 STAGECOACH ROAD COLORADO SPRINGS, CO
16.HOFFPAUIR DAN W JR ZONED - RR-5 14495 HOMES ROAD COLORADO SPRINGS, CO	32. MCKINLEY DAVID R ZONED - RR-5 14920 QUAIL RUN ROAD COLORADO SPRINGS, CO	48. HILL DOUGLAS E ZONED - RR-5 6910 ALPACA HEIGHTS COLORADO SPRINGS, CO	64. SHELL JAMES R II ZONED - RR-5 15550 FARRAR ROAD COLORADO SPRINGS, CO	80. RZONCA THADDEUS ZONED - PUD 4995 OLD STAGECOACH ROAD COLORADO SPRINGS, CO	96. RAMPART ENTERPRISES INC ZONED - PUD 5235 OLD STAGECOACH ROAD COLORADO SPRINGS, CO	112. SHOPTAUGH GLENN MARK ZONED - PUD 5261 GOLD RUN COURT COLORADO SPRINGS, CO	128. COFFEY LAVANSON C III ZONED - PUD 15192 SHORTWALL DRIVE COLORADO SPRINGS, CO	144. DESAUTELS BRUCE T ZONED - PUD 4661 HIDDEN ROCK ROAD COLORADO SPRINGS, CO	160. HARRIS GUY MCALLISTER ZONED - PUD 4130 STAGECOACH ROAD COLORADO SPRINGS, CO

HR GREEN Xref: xref-1-ARCH-DH01-BUBBLEPLAN-EX-A18

DRAWN BY: JAG JOB DATE: 3/1/2022  
 APPROVED: PLS JOB NUMBER: 211030  
 CAD DATE: 3/15/2022  
 CAD FILE: J:\2021\211030\CAD\Drawings\CIS\Sketch-Plan\ADJACENT-PROPERTY

BAR IS ONE INCH ON  
 OFFICIAL DRAWINGS.  
 0 1" IF NOT ONE INCH,  
 ADJUST SCALE ACCORDINGLY.

NO.	DATE	BY	REVISION DESCRIPTION




FLYING HORSE NORTH  
 DEVELOPMENT, LLC.  
 EL PASO COUNTY, COLORADO

FLYING HORSE NORTH SKETCH PLAN  
 ADJACENT PROPERTY DATA OWNERS

SHEET  
 SP.4  
 4

# Sketch Plan Drawing(s)\_v1.pdf Markup Summary

1 (4)

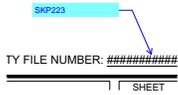

**Page Label: 1**  
**Author:** dsdlaforce

SKP223



**Page Label: 1**  
**Author:** dsdruiz

staff refers to this as conventional zoning



**Page Label: 1**  
**Author:** dsdruiz

there is a - sign shown



**Page Label: 1**  
**Author:** dsdruiz

add information regarding the fire station that it can be relocated anywhere in the SKP area. please also add information that if the Fire Department determines there is no need, that the land need not be dedicated to them.

2 (7)



**Page Label: 2**  
**Author:** dsdlaforce




**Page Label: 2**  
**Author:** dsdlaforce

Recommend reviewing the Hodgen Rd access Management Plan (snippet to the left) and showing the connection from Hodgen Road w/ potential cul-de-sac at the south when Black Forest Rd realignment occurs.




**Page Label: 2**  
**Author:** dsdlaforce

Delete access point

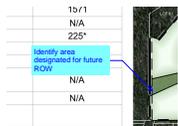

**Page Label: 2**  
**Author:** dsdlaforce

Identify area designated for future ROW

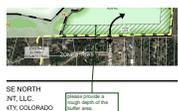

**Page Label: 2**  
**Author:** dsdruiz

please provide a rough depth of the buffer area.

NO.	DATE	BY	REVISION DESCRIPTION

**Page Label: 2**  
**Author: dsdrui**

negative



**Page Label: 2**  
**Author: dsdrui**

the drainage way is difficult to see as it is overlaid by other layers. please consider adjusting the line weight.

4 (1)



**Page Label: 4**  
**Author: dsdrui**

Please revise per