


John & Brenda Thomas
14490 Holmes Road


Charles & Cheryl Ernst
14410 Holmes Road

Jeremy Vereecke
14350 Holmes Road

Patrick & Kelly McGowan 14355 Holmes Road

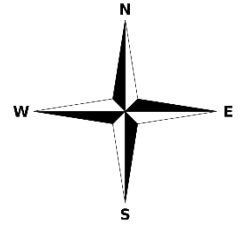


Taylor Irvin Trust
5880 Vessey Road

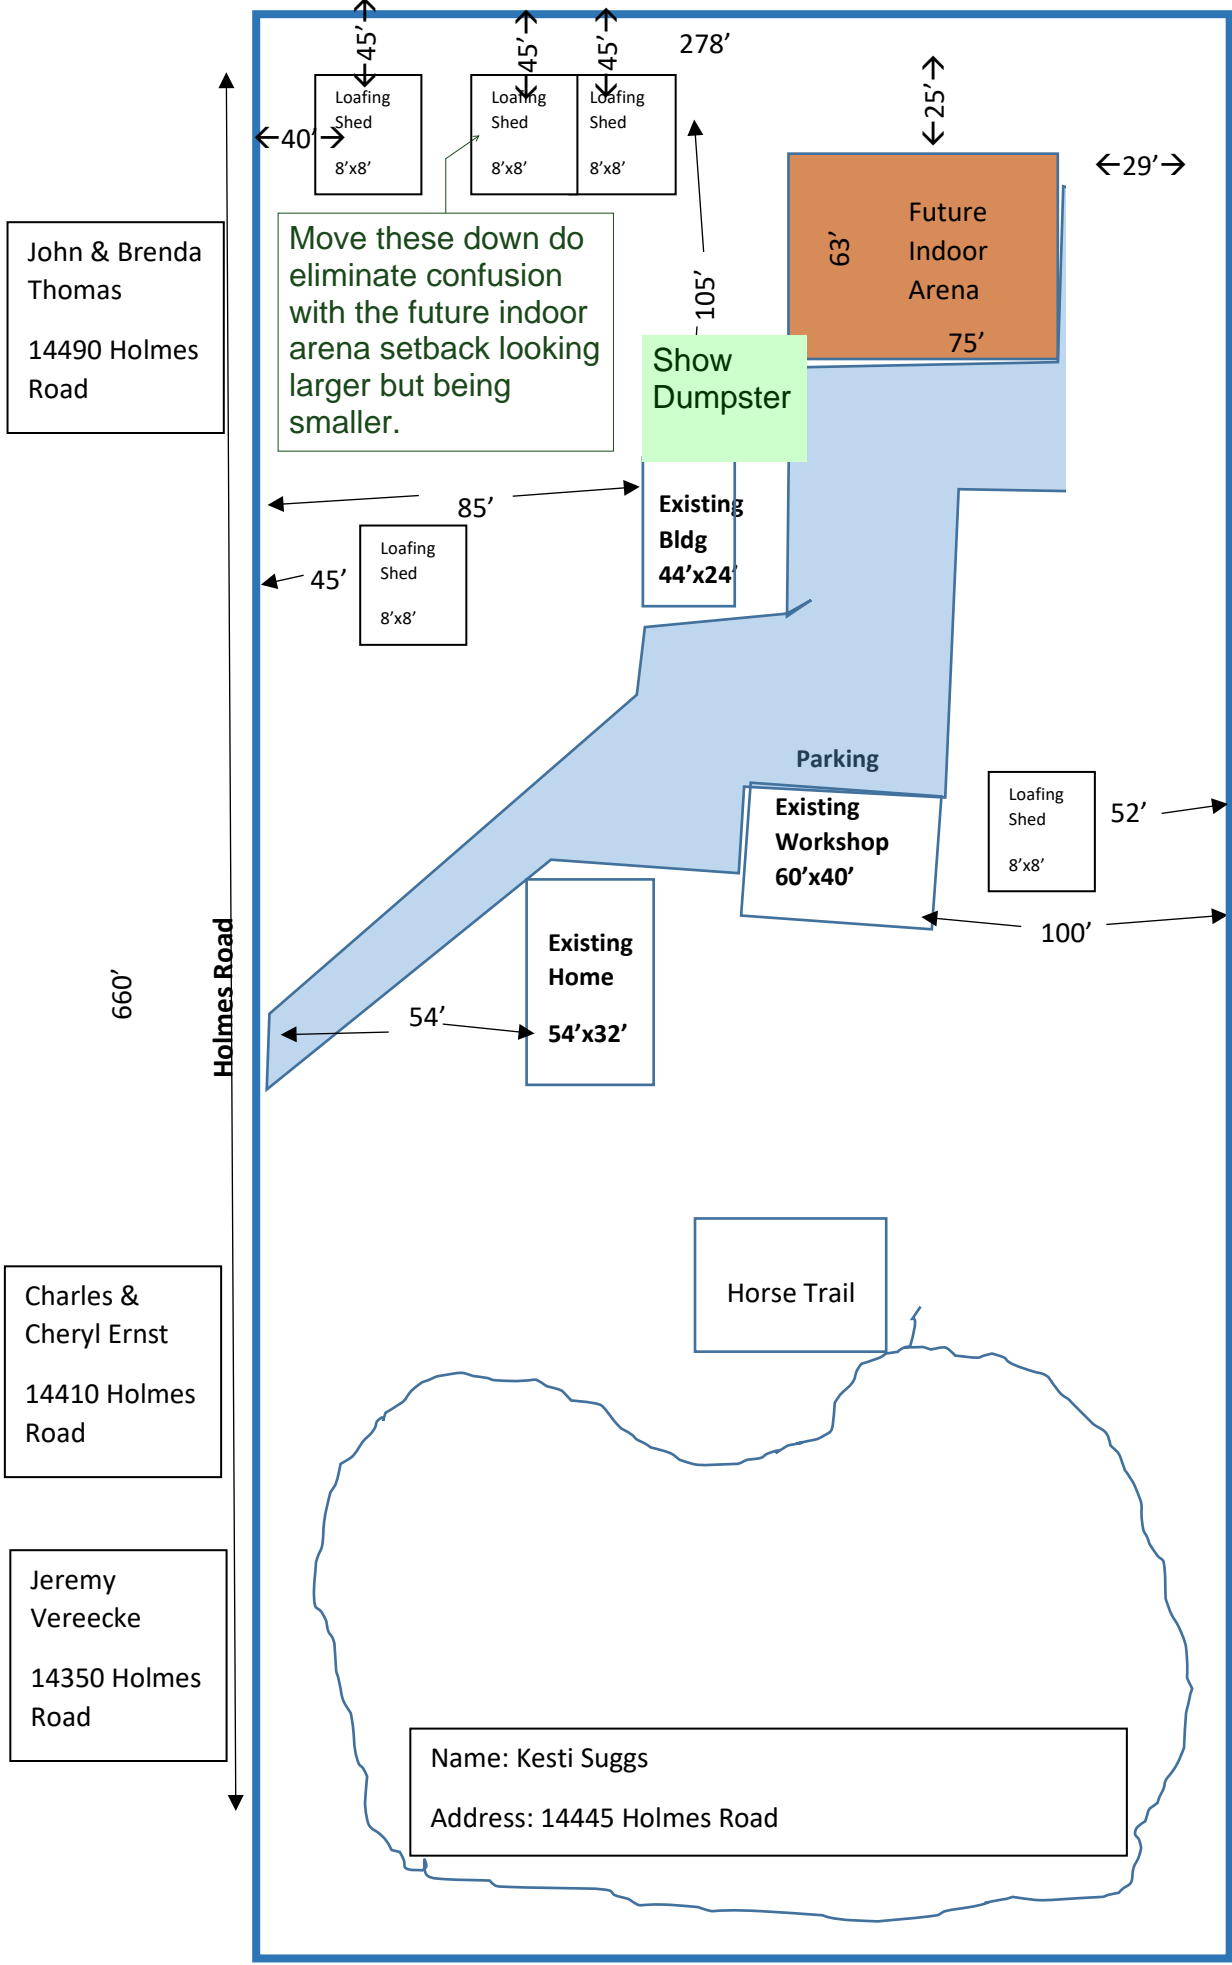

Name: Kesti Suggs
Address: 14445 Holmes Road


Markup Summary

dskendall (2)

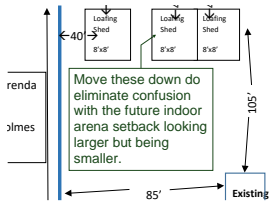

Subject: Callout
Page Label: 1
Author: dskendall
Date: 9/25/2018 4:42:05 PM
Color: ■

Move these down do eliminate confusion with the future indoor arena setback looking larger but being smaller.

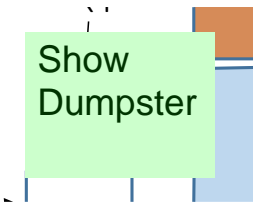

Subject: Text Box
Page Label: 1
Author: dskendall
Date: 9/25/2018 4:42:23 PM
Color: ■

Show Dumpster