



John & Brenda Thomas  
14490 Holmes Road

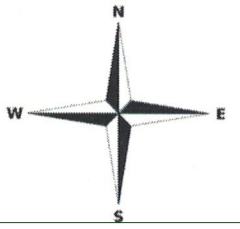

This looked close when I did a site visit, you may want to get a surveyor to show the exact boundaries and setbacks of buildings so you don't build your structure too close to the property line.

Taylor Irvin Trust  
5880 Vessey Road

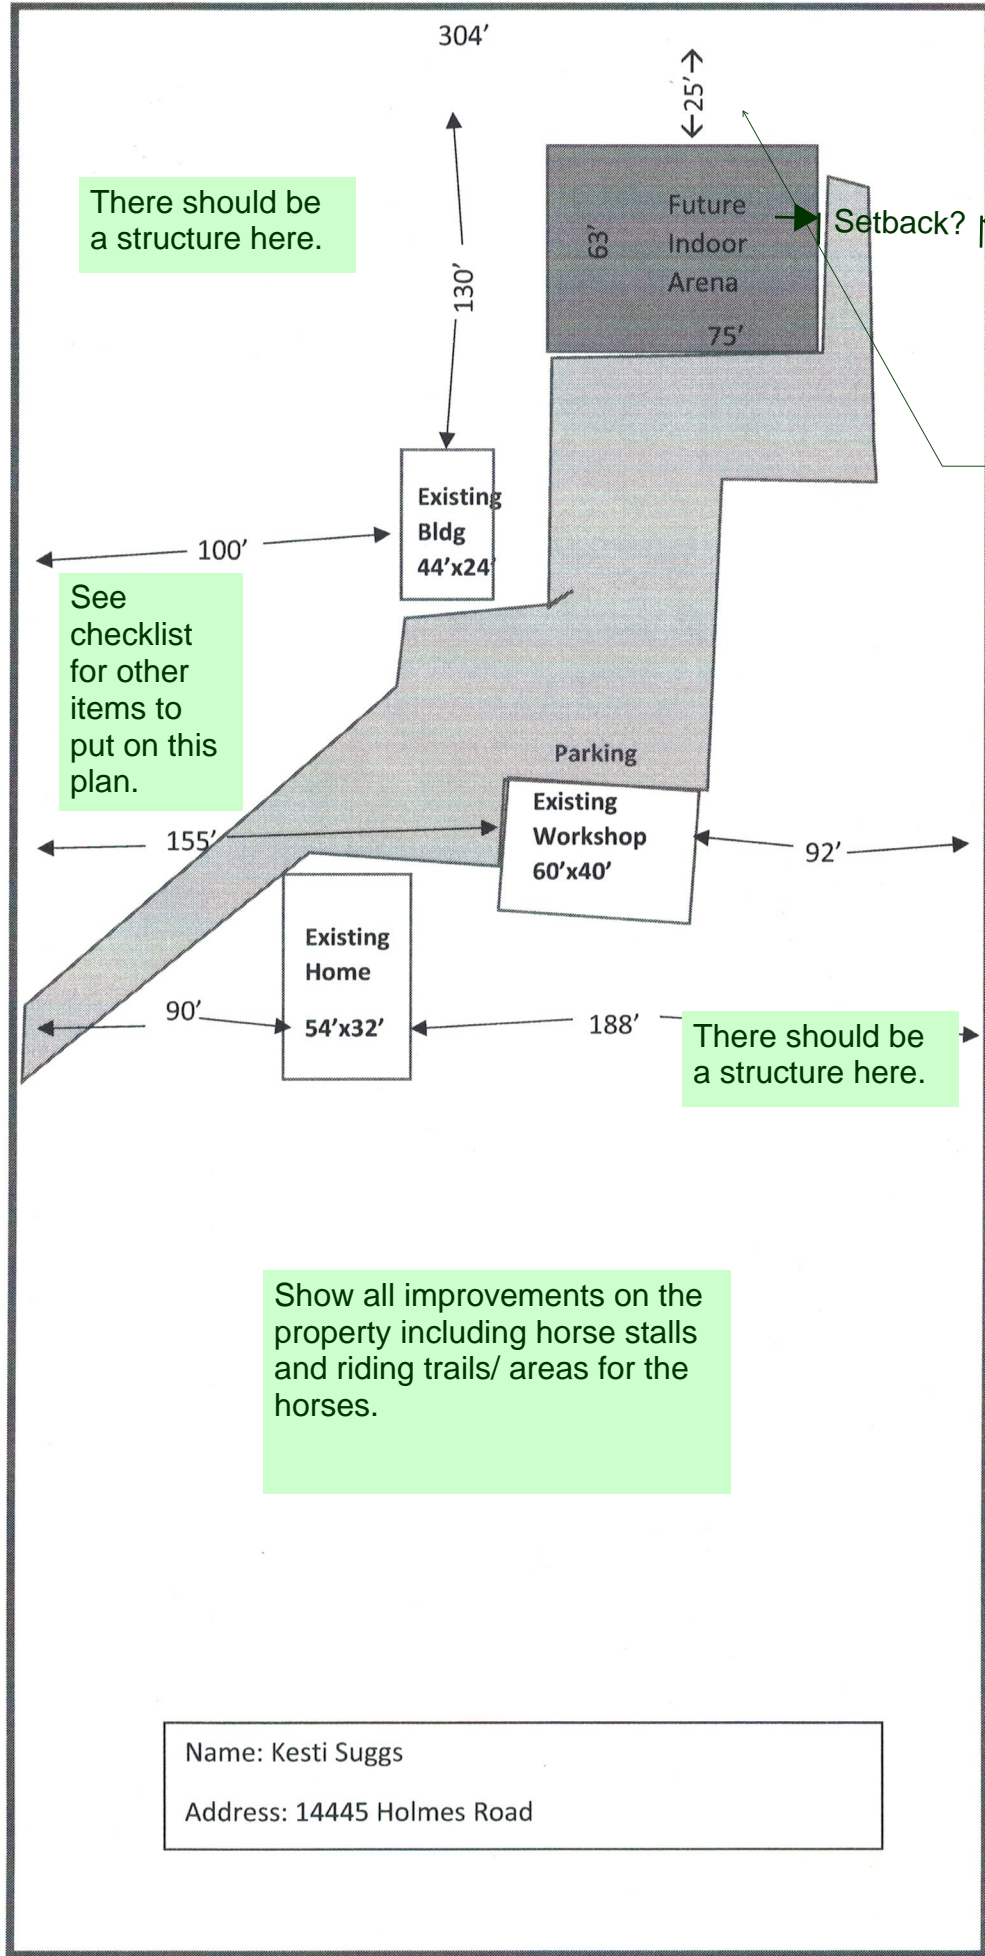


Name: Kesti Suggs  
Address: 14445 Holmes Road

Patrick & Kelly McGowan 14355 Holmes Road

# Markup Summary

dskendall (6)

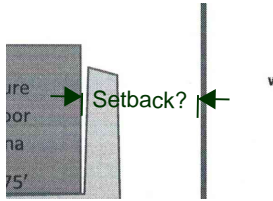

**Subject:** Dimension  
**Page Label:** 1  
**Author:** dskendall  
**Date:** 8/23/2018 4:19:14 PM  
**Color:** ■

Setback?

Show all improvements on the property including horse stalls and riding trails/ areas for the horses.

**Subject:** Text Box  
**Page Label:** 1  
**Author:** dskendall  
**Date:** 8/24/2018 8:11:30 AM  
**Color:** ■

Show all improvements on the property including horse stalls and riding trails/ areas for the horses.

There should be a structure here.


**Subject:** Text Box  
**Page Label:** 1  
**Author:** dskendall  
**Date:** 8/24/2018 8:12:03 AM  
**Color:** ■

There should be a structure here.

There should be a structure here.


**Subject:** Text Box  
**Page Label:** 1  
**Author:** dskendall  
**Date:** 8/24/2018 8:12:12 AM  
**Color:** ■

There should be a structure here.

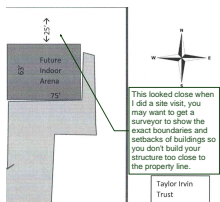

**Subject:** Callout  
**Page Label:** 1  
**Author:** dskendall  
**Date:** 8/24/2018 8:13:19 AM  
**Color:** ■

This looked close when I did a site visit, you may want to get a surveyor to show the exact boundaries and setbacks of buildings so you don't build your structure too close to the property line.

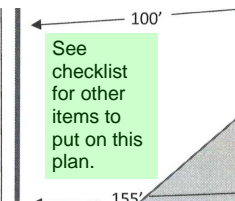

**Subject:** Text Box  
**Page Label:** 1  
**Author:** dskendall  
**Date:** 8/24/2018 8:17:32 AM  
**Color:** ■

See checklist for other items to put on this plan.