



VICINITY MAP
NO SCALE

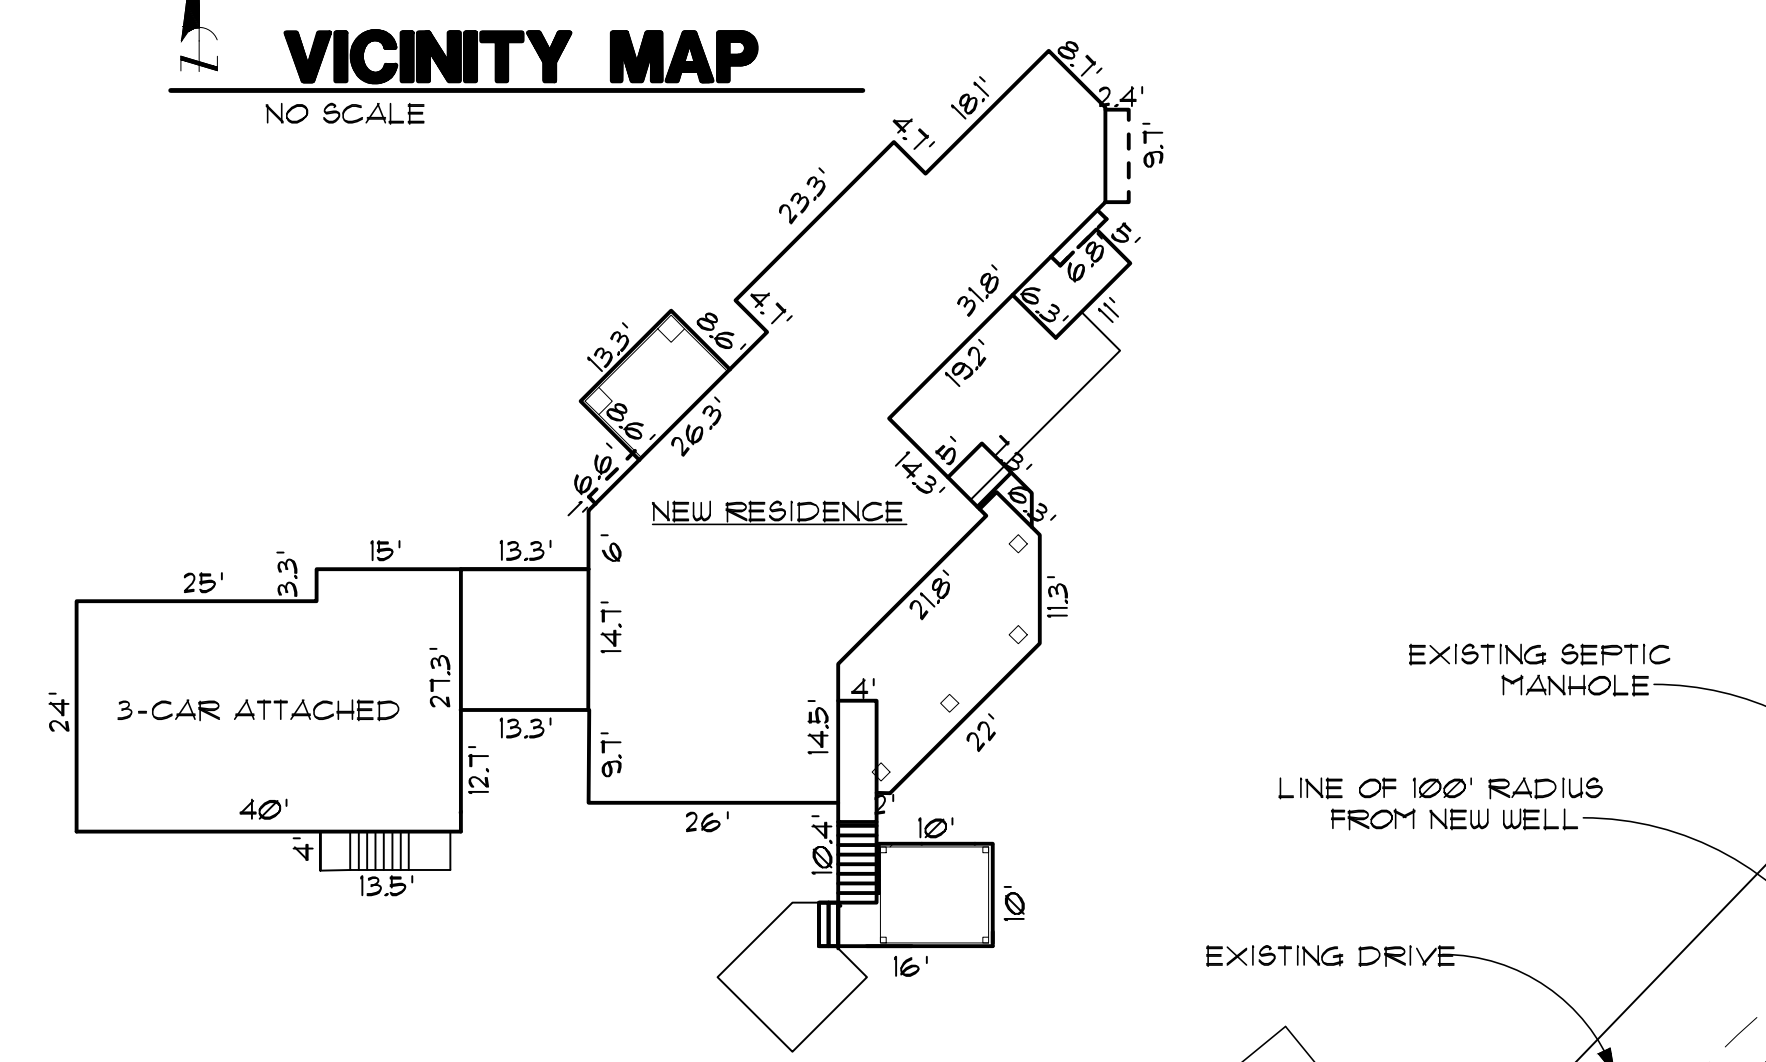

HOUSE FOOTPRINT
NO SCALE


Please indicate the distance of the proposed well sites from the proposed structure since they are within 100 feet of the structure

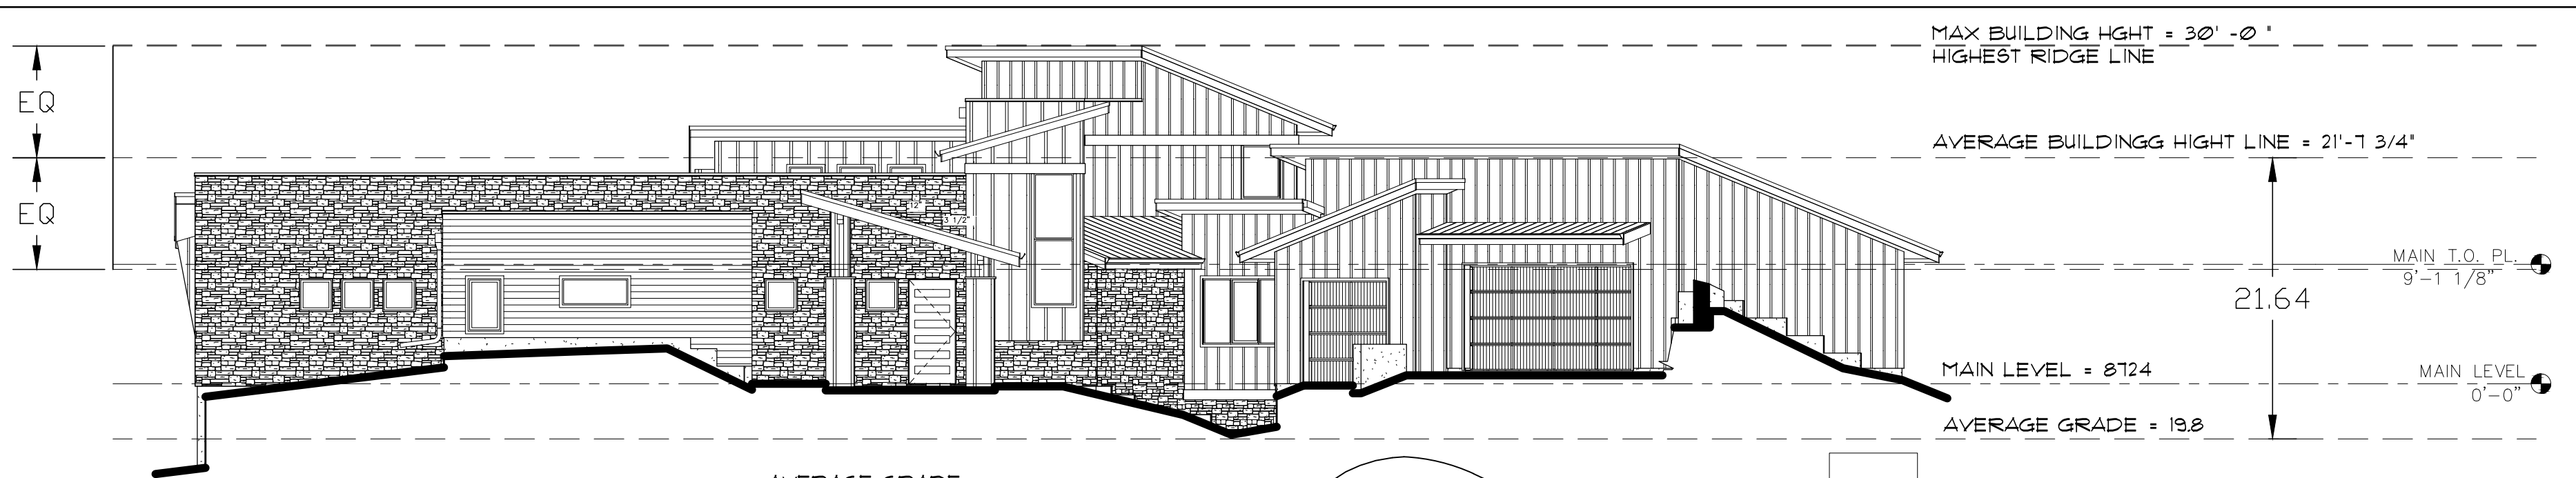

HOUSE ELEVATION
NO SCALE

AVERAGE GRADE:

27'x1 =	27
26'x1 =	26
25'x2 =	50
24'x6 =	144
23'x1 =	23
18'x1 =	18
17'x1 =	17
16'x1 =	16
15'x1 =	15
12'x2 =	60
396/20 =	19.8

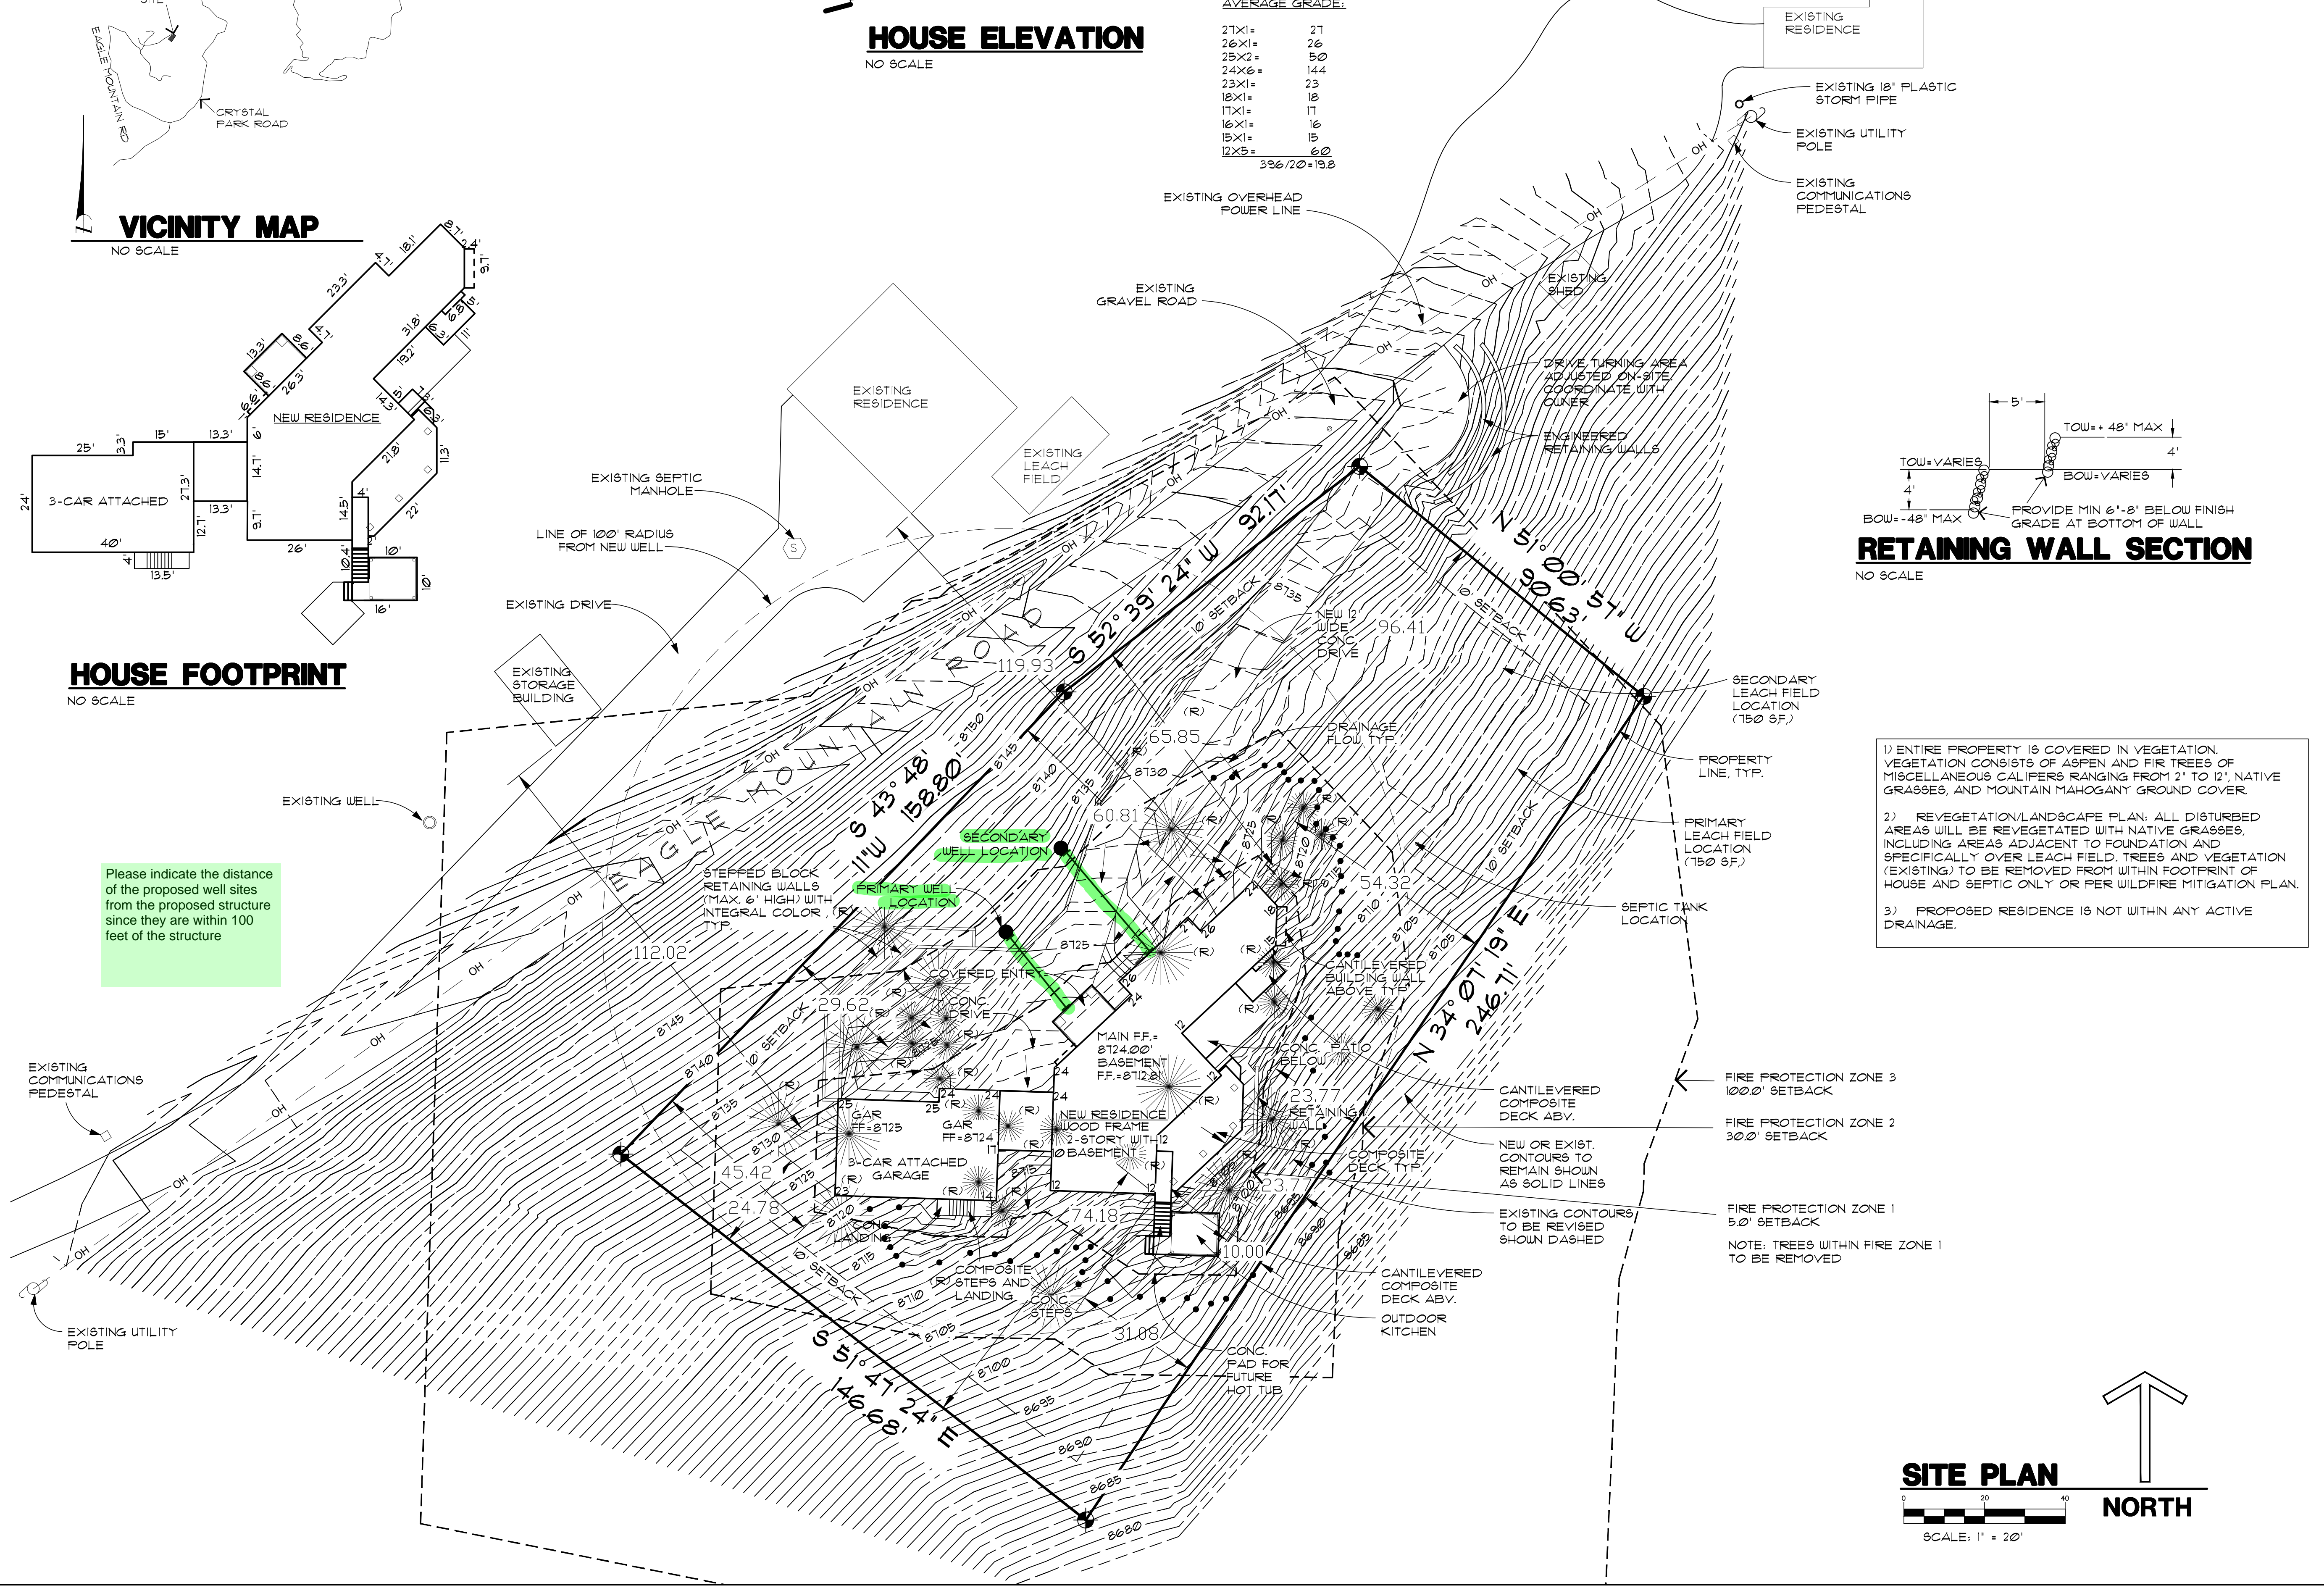

RETAINING WALL SECTION
NO SCALE

- ENTIRE PROPERTY IS COVERED IN VEGETATION. VEGETATION CONSISTS OF ASPEN AND FIR TREES OF MISCELLANEOUS CALIFERS RANGING FROM 2' TO 12', NATIVE GRASSES, AND MOUNTAIN MAHOGANY GROUND COVER.
- REVEGETATION/LANDSCAPE PLAN. ALL DISTURBED AREAS WILL BE REVEGETATED WITH NATIVE GRASSES, INCLUDING AREAS ADJACENT TO FOUNDATION AND SPECIFICALLY OVER LEACH FIELD. TREES AND VEGETATION (EXISTING) TO BE REMOVED FROM WITHIN FOOTPRINT OF HOUSE AND SEPTIC ONLY OR PER WILDFIRE MITIGATION PLAN.
- PROPOSED RESIDENCE IS NOT WITHIN ANY ACTIVE DRAINAGE.

SITE PLAN
SCALE: 1" = 20'
NORTH

SITE INFO:
ADDRESS:
6881 EAGLE MOUNTAIN RD
MANITOU SPRINGS, CO 80829
LEGAL:
SITE 6-122, SITE ADDITION TO CRYSTAL PARK SUBDIVISION #2 NW 1/4 OF SEC.18, TOWNSHIP 14.0 RANGE 67.0 F THE W SIXTH PM, EL PASO COUNTY, COLORADO.
SITE DATA:
LOT SIZE = 30,400 SQFT
BUILDING FOOTPRINT =
HOUSE = 2111 SQFT
GARAGE = 1010 SQFT
COV ENTRY = 104 SQFT
DECK = 446 SQFT
TOTAL = 3,791 SQFT
LOT COVERAGE = 12.3%
ZONING = FUD
TAX SCHEDULE =
BUILDING HEIGHT = SEE ELEVATIONS

SITE NOTES:

- Topographic information is to be supplied by others. See below for info.
- Dashed lines indicate existing contours. Solid lines indicate proposed contours.
- Contractor to verify easements.
- Contractor to limit cut and fill areas and limit material and vehicle storage to the building areas in order to minimize vegetation and site disturbance.
- Final landscaping to be determined by the Contractor/Owner(s). It shall minimize impact to the site. All landscaping to be completed by the Contractor/Owner(s).
- Use wattles and silt fencing to minimize erosion during construction. And also stabilize area with seeded blankets for erosion control as necessary.
- Earth materials are not to be stockpiled on streets or sidewalks, but on site or staging areas.
- Contractor is required to provide positive drainage away from and around structure in all directions as shown.
- Any boulder retaining walls shown shall be 48" max high and 48"-60" min apart laterally if (2) or more retaining walls exist. Or retaining walls shall be engineered by a licensed CO soils engineer.
- General Contractor, Subcontractors, Suppliers, and Owner(s) shall familiarize themselves & verify all notes, dimensions and information on drawings prior to starting construction. It shall be the responsibility of those parties to report any changes and/or discrepancies to the Designer. Questions regarding these drawings such as: drawing interpretation, dimensions, notes, scale and other similar questions shall be brought to the attention of the Designer immediately, in writing. Failure to do any of the above shall relieve the designer of any errors. Designer shall not be responsible for any changes not noted in writing to this plan.

SITE LEGEND:

- PROPERTY LINES & CORNERS
- EXISTING CONTOURS
- PROPOSED CONTOURS
- PROPOSED BOULDER RETAINING WALL
- EXISTING VEGETATION
- 100 = FINISH GRADE
- NO ROCK OUT CROPPING EXIST AT SITE

PROJECT COLORS:

ROOFING: BARNWOOD
STUCCO COLOR: CRYSTAL BROWN
GARAGE DOOR: PARK GREEN
STONE: OUTDOOR STONE BEGIE

REFERENCE INFO:

TOPO INFO:
ROCKY MOUNTAIN LAND SERVICES
2265 NORTHPARK DRIVE, SUIT 303
COLORADO SPRINGS, CO.
(719) 630-0559

SITE TERMS:

ABBREVIATIONS:
BOU= BOTTOM OF RETAINING WALL
(E)= EXISTING TO REMAIN
LL= LOWER LEVEL
ML= MAIN LEVEL
(N)= NEW CONSTRUCTION
(R)= REMOVE
R.O.W.= RIGHT OF WAY
SB= SETBACK
SQ. FT. OR SF= SQUARE FEET
TOP= TOP OF FOUNDATION
T.O.W.= TOP OF RETAINING WALL
UL= UPPER LEVEL
WO= WALKOUT

REVISIONS

LGA STUDIOS
201 E. Las Animas Street
Suite 113
Colorado Springs, CO. 80903
Phone: (719) 635-0880
Email: Office@LGAstudios.com
Website: www.lgastudios.com

CONTRACTOR
PALACE HOMES INC.
1216 W COLORADO AVE #110
Colorado Springs, CO 80904
Phone: (719) 457-6635
EMAIL: GORDON@PALACEHOMESINC.COM

THE ROSE RESIDENCE
6881 EAGLE MOUNTAIN RD
MANITOU SPRINGS, CO 80829
COMPUTER FILE # 24-2462

DRAWN BY: EAH
CHECKED BY: DARR
PLOT 06/05/24 1:33 PM

SITE PLAN
VICINITY MAP
SITE NOTES

Sheet #
SP1
OF 1 Sheets