

LOACTED IN THE WEST H TOWNS **BE IT KNOWN BY THESE PRESENTS:** THAT FALCON LATIGO, LLC, BEING THE OWNER OF THE FOLLOWING DESCRIBED TRACT OF LAND TO WIT: LEGAL DESCRIPTION: A PARCEL OF LAND LOCATED IN THE WEST HALF OF SECTION 16 AND A PORTION OF THE SOUTHEAST QUARTER OF SECTION 17, TOWNSHIP 12 SOUTH, RANGE 64 WEST OF THE 6TH PRINCIPAL MERIDIAN, COUNTY OF EL PASO, STATE OF COLORADO, BEING MORE PARTICULARLY DESCRIBED AS FOLLOWS: BASIS OF BEARINGS: THE SOUTH LINE OF SECTION 17, TOWNSHIP 12 SOUTH, RANGE 64 WEST OF THE 6TH PRINCIPAL MERIDIAN, BEING MONUMENTED AT THE SOUTHEAST CORNER BY A 3-1/4" ALUMINUM CAP STAMPED "LS 24964 2000" FLUSH WITH THE GROUND AND AT THE SOUTHWEST CORNER BY A 2-1/2" ALUMINUM CAP STAMPED "LS 25955 1996" 0.35" BELOW GROUND, BEARING N89°25'55"W. COMMENCING AT THE SOUTHEAST CORNER OF SECTION 17, TOWNSHIP 12 SOUTH, RANGE 64 WEST OF THE 6TH PRINCIPAL MERIDIAN; THENCE ON THE EAST LINE OF SAID SECTION 17, NO0°24'42"W A DISTANCE OF 1,154.37 FEET, TO THE POINT BEING THE POINT OF BEGINNING; THENCE S89°27'42"W A DISTANCE OF 1.79 FEET, TO THE SOUTHEASTERLY CORNER OF LOT 8, THE TRAILS FILING NO. 8 RECORDED UNDER RECEPTION NO. 207712541 IN THE RECORDS OF THE EL PASO COUNTY CLERK AND RECORDER; THENCE ON THE BOUNDARY OF SAID THE TRAILS FILING NO. 8, THE FOLLOWING SIXTEEN (16) COURSES: 1. N01°32'00"W A DISTANCE OF 563.81 FEET; please add the following items to the plat: 2. N88°28'20"E A DISTANCE OF 125.09 FEET; -Name, address and telephone number of the owner of record located in 3. N01°31'40"W A DISTANCE OF 60.00 FEET; the lower right hand corner, -Names, address, and telephone number of person(s) responsible for 4. N01°32'00"W A DISTANCE OF 445.29 FEET; preparing the plat (e.g., licensed surveyor, licensed engineer or designer of the plat) located in the lower right hand corner (if applicable) 5. S89°31'51"E A DISTANCE OF 304.75 FEET; -Right-of-way widths 6. N04°24'58"E A DISTANCE OF 601.43 FEET; 7. N00°28'09"E A DISTANCE OF 200.00 FEET; 8. N19°41'13"W A DISTANCE OF 634.23 FEET; 9. N00°28'09"E A DISTANCE OF 102.93 FEET; 10. N69°12'04"E A DISTANCE OF 486.05 FEET; 11. N20°47'56"W A DISTANCE OF 134.68 FEET, TO A POINT OF CURVE; 12. ON THE ARC OF A CURVE TO THE RIGHT, HAVING A RADIUS OF 530.00 FEET, A CENTRAL ANGLE OF 09°05'54" AND AN ARC LENGTH OF 84.16 FEET, TO A POINT OF NON-TANGENT; 13. S78°21'46"W A DISTANCE OF 388.55 FEET; 14. NO0°28'09"E A DISTANCE OF 636.09 FEET; 15. S89°32'00"E A DISTANCE OF 230.48 FEET; 16. NOO°28'00"E A DISTANCE OF 555.14 FEET, TO A POINT ON THE SOUTHERLY RIGHT-OF-WAY LINE OF LATIGO BOULEVARD; THENCE ON SAID SOUTHERLY RIGHT-OF-WAY LINE, N89°48'42"E A DISTANCE OF 917.63 FEET; THENCE DEPARTING SAID SOUTHERLY RIGHT-OF-WAY LINE, THE FOLLOWING FIFTEEN (15) COURSES: S09°07'03"W A DISTANCE OF 576.97 FEET, TO A POINT OF NON-TANGENT CURVE; ON THE ARC OF A CURVE TO THE LEFT WHOSE CENTER BEARS S09°07'03"W, HAVING A RADIUS OF 420.00 FEET, A CENTRAL ANGLE OF 08°39'03" AND AN ARC LENGTH OF 63.41 FEET, TO A POINT OF TANGENT; N89°32'00"W A DISTANCE OF 68.00 FEET; S00°28'00"W A DISTANCE OF 423.36 FEET; N87°37'41"E A DISTANCE OF 68.09 FEET; S20°16'04"W A DISTANCE OF 143.48 FEET; S17°24'33"E A DISTANCE OF 809.98 FEET; S87°35'59"E A DISTANCE OF 123.23 FEET; S02°24'01"W A DISTANCE OF 437.00 FEET; S87°35'59"E A DISTANCE OF 31.60 FEET; S02°24'01"W A DISTANCE OF 218.11 FEET; S13°09'53"W A DISTANCE OF 853.92 FEET; S13°09'11"W A DISTANCE OF 977.68 FEET; N69°28'15"W A DISTANCE OF 791.84 FEET; S89°27'42"W A DISTANCE OF 398.27 FEET, TO THE POINT OF BEGINNING. CONTAINING A CALCULATED AREA OF 4,428,810 SQUARE FEET OR 101.6715 ACRES. **DEDICATION:** THE ABOVE OWNER HAS CAUSED SAID TRACT OF LAND TO BE PLATTED INTO 37 LOTS AND EASEMENTS AS SHOWN ON THIS

PLAT. THE UNDERSIGNED DOES HEREBY DEDICATE, GRANT AND CONVEY TO EL PASO COUNTY THOSE PUBLIC EASEMENTS AS SHOWN ON THIS PLAT; AND FURTHER RESTRICTS THE USE OF ALL PUBLIC EASEMENTS TO EL PASO COUNTY AND/OR ITS ASSIGNS, PROVIDED HOWEVER, THAT THE SOLE RIGHT AND AUTHORITY TO VACATE, RELEASE OR QUIT-CLAIM ALL OR ANY SUCH PUBLIC EASEMENTS SHALL REMAIN EXCLUSIVELY VEST IN EL PASO COUNTY. ALL PUBLIC STREETS ARE HEREBY DEDICATED TO EL PASO COUNTY FOR PUBLIC USE. THIS TRACT OF LAND AS HEREIN PLATTED SHALL BE KNOWN AS "THE TRAILS FILING NO. 9" IN EL PASO COUNTY, COLORADO.

EASEMENTS:

ALL EASEMENTS THAT ARE DEDICATED HEREON FOR PUBLIC UTILITY PURPOSES RELATED TO GAS AND ELECTRIC SHALL BE SUBJECT TO THOSE TERMS AND CONDITIONS AS SPECIFIED IN THE INSTRUMENT RECORDED AT RECEPTION NUMBER 212112548 OF THE RECORDS OF EL PASO COUNTY, COLORADO. ALL OTHER EASEMENTS OR INTERESTS OF RECORD AFFECTING ANY OF THE PLATTED PROPERTY DEPICTED HEREON SHALL NOT BE AFFECTED AND SHALL REMAIN IN FULL FORCE AND AFFECT.

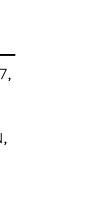

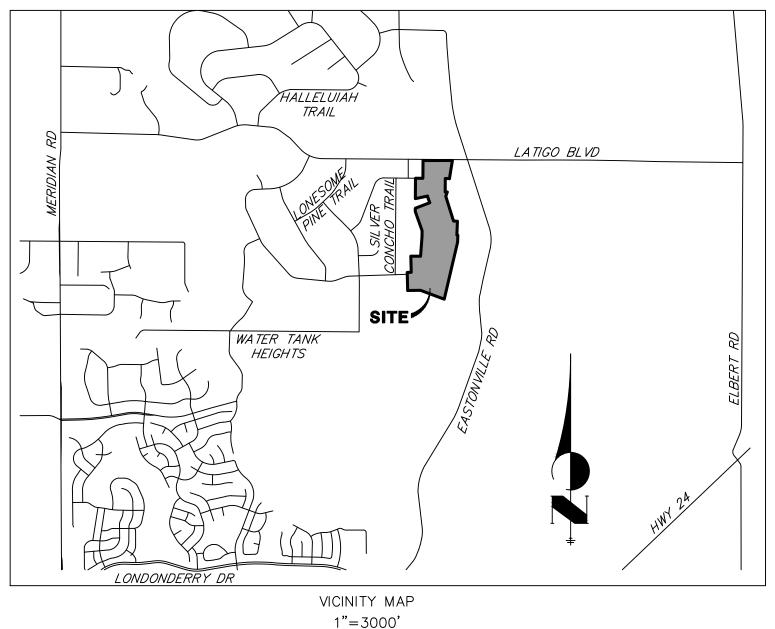

THE	AFORE	EMENTIONE), FALCO	ON LATIGO,	LLC, A	COLORADO	LIMITED	LIABILITY	COMPANY	HAS
EXEC	UTED	THIS INSTR	RUMENT	THIS	DAY	OF		9		
20										

IP 12 SOUTH, RANGE 64 WEST OF THE 6TH PRINCIPAL MERI	DIAN, update all signature blocks
COUNTY OF EL PASO, STATE OF COLORADO	
-	Surveyors Certificate
	I surveyor's name, a duly registered Professional Land Surveyor in the State of Colorado, do hereby certify that this plat truly and correctly represents the results of a survey made on date of survey, by me or under my direct supervision and that all monuments exist as shown IN THE STATE OF COLORADO, HEREBY STATES AND
	hereon; that mathematical closure errors are less than 1:10,000; and that said plat has been prepared in full compliance with all applicable laws of the State of Colorado dealing THAT THE REQUIREMENTS OF TITLE 38 OF THE
HALLELUIAH	Paso County Land Development Code.
TRAIL (ATION DUID	I attest the above on this day of, 20
LATIGO BLVD	Surveyor's Name, (Signature) Date Colorado registered PLS #
HOME TRY AND A L	
	JARROD ADAMS, PROFESSIONAL LAND SURVEYOR COLORADO NO. 38252 FOR AND ON BEHALF OF JR ENGINEERING, LLC
	TOR AND OR DENALE OF ON ENGINEERING, LEG
WATER TANK	NOTICE:
HEIGHTS HEIGHTS	ACCORDING TO COLORADO LAW, YOU MUST COMMENCE ANY LEGAL ACTION BASED UPON ANY DEFECT IN THIS SURVEY WITHIN THREE YEARS AFTER YOU FIRST DISCOVER SUCH DEFECT. IN NO EVENT, MAY ANY ACTION BASED UPON ANY DEFECT IN THIS SURVEY BE COMMENCED MORE THAN TEN YEARS FROM THE DATE OF THE CERTIFICATION SHOWN HEREON.
	SERVER DE SERVERTOED MORE HAAR TER TEARS FROM THE DATE OF THE GERTHTOATION SHOWN HEREON.
	PCD DIRECTOR CERTIFICATE:
	THIS PLAT FOR "THE TRAILS FILING NO. 9" WAS APPROVED FOR FILING BY THE EL PASO COUNTY PLANNING AND COMMUNITY DEVELOPMENT DEPARTMENT DIRECTOR ON THIS DAY OF, 202, SUBJECT TO ANY NOTES OR This plat for (name of subdivision or plat) was approved for filing by the El Paso County, Colorado Planning and Community Development Department Director on the day of
	Planning and Community Development Department Director on the day of, 20, subject to any notes or conditions specified hereon.
LONDONDERRY DR	Planning and Community Development Director
VICINITY MAP 1"=3000'	
OWNERS CERTIFICATE:	
THE UNDERSIGNED, BEING ALL THE OWNERS, MORTGAGEES, BENEFICIARIES OF DEEDS OF TRUST AND HOLDER OF OTHER INTERESTS IN THE LAND DESCRIBED HEREIN, HAVE LAID OUT, SUBDIVIDED, AND PLATTED SAID LANDS INTO LOTS, STREETS, AND	CHAIR, PLANNING AND COMMUNITY DATE DEVELOPMENT DEPARTMENT
EASEMENTS AS SHOWN HEREON UNDER THE NAME AND SUBDIVISION OF THE TRAILS FILING NO. 9. ALL PUBLIC IMPROVEMENTS SO PLATTED ARE HEREBY DEDICATED TO THE PUBLIC USE AND SAID OWNER DOES HEREBY COVENANT AND AGREE THAT THE	
PUBLIC IMPROVEMENTS WILL BE CONSTRUCTED TO EL PASO COUNTY STANDARDS AND THAT PROPER DRAINAGE AND EROSION CONTROL FOR SAME WILL BE PROVIDED AT SAID OWNER'S EXPENSE, ALL TO THE SATISFACTION OF THE BOARD OF COUNTY COMMISSIONERS OF EL PASO COUNTY, COLORADO. UPON ACCEPTANCE BY RESOLUTION, ALL PUBLIC IMPROVEMENTS SO	Board of County Commissioners Certificate This plat for (name of subdivision or plat) was approved for filing by the El Paso County, Colorado
DEDICATED WILL BECOME MATTER OF MAINTENANCE BY EL PASO COUNTY, COLORADO. THE UTILITY EASEMENTS SHOWN HEREON ARE HEREBY DEDICATED FOR PUBLIC UTILITIES AND COMMUNICATION SYSTEMS AND OTHER PURPOSES AS SHOWN HEREON. THE	Board of County Commissioners on the day of, 200_, subject to any notes specified hereon and any conditions included in the resolution of approval. The dedications of land to JECT_TO_ANY_NOTES_SPECIFIED_HEREON_AND
ENTITIES RESPONSIBLE FOR PROVIDING THE SERVICES FOR WHICH THE EASEMENTS ARE ESTABLISHED ARE HEREBY GRANTED THE PERPETUAL RIGHT OF INGRESS AND EGRESS FROM AND TO ADJACENT PROPERTIES FOR INSTALLATION, MAINTENANCE, AND REPLACEMENT OF UTILITY LINES AND RELATED FACILITIES.	thereon will not become the maintenance responsibility of El Paso County until preliminary acceptance of the public improvements in accordance with the requirements of the Land Development ORDANCE WITH THE REQUIREMENTS OF THE
	Code and Engineering Criteria Manual, and the Subdivision Improvements Agreement.
THE AFOREMENTIONED, FALCON LATIGO, LLC, A COLORADO LIMITED LIABILITY COMPANY HAS EXECUTED THIS INSTRUMENT THIS DAY OF,	President, Board of County Commissioners Date
20, A.D.	
BY:	PRESIDENT, BOARD OF COUNTY COMMISSIONERS DATE
PRINTED NAME:	TRESIDENT, DUALD OF COUNTE CONNINISSIONERS DATE
AS: OF FALCON LATIGO, LLC	CLERK AND RECORDER
STATE OF COLORADO	STATE C Clerk and Recorder
COUNTY OF EL PASO) THE FOREGOING INSTRUMENT WAS ACKNOWLEDGED BEFORE ME THIS DAY OF, 20,	COUNTY STATE OF COLORADO COUNTY OF EL PASO
A.D. BY:	I HEREB' I hereby certify that this instrument was filed in my office on CORD IN MY OFFICE this day of
AS: OF FALCON LATIGO, LLC	AT Reception Number of the records of, 20, A.D. El Paso County OF THE RECORDS OF EL PASO
WITNESS MY HAND AND OFFICIAL SEAL:	COUNTY, El Paso County Clerk and Recorder
MY COMMISSION EXPIRES:	BY:
OWNERS CERTIFICATE	DEPUTY
THE AFOREMENTIONED, BRJM, LLC, A COLORADO LIMITED LIABILITY COMPANY HAS EXECUTED THIS INSTRUMENT THIS DAY OF, 202, A.D.	
BY:	FEES: SUMMARY:
PRINTED NAME:	DRAINAGE FEE:
	BRIDGE FEE: TOTAL 101.6715 ACRES 100.00%
AS: OF 8335 VOLLMER ROAD, LLC STATE OF COLORADO)	SCHOOL FEE:
) SS COUNTY OF EL PASO)	PARK FEE:
THE FORGOING INSTRUMENT WAS ACKNOWLEDGED BEFORE ME THIS DAY OF	JOB NO. 25175.01 September 9, 2021
, 202, A.D. BY: AS: OF SR LAND, LLC	SHEET 1 OF 6
WITNESS MY HAND AND OFFICIAL SEAL: MY COMMISSION EXPIRES:	$\bigcirc J \cdot R ENGINEERING$




Add "PCD File No. SF-21-037"

Centennial 303-740-9393 • Colorado Springs 719-593-2593 Fort Collins 970–491–9888 • www.jrengineering.com


	NERAL NOTES:				_	
Ι.	PER C.R.S. 38–51–106, "ALL LIN ONE METER EQUALS 39.37/12 U. STANDARDS AND TECHNOLOGY."	IEAL UNITS DEPICTED ON THIS LAND .S. SURVEY FEET, EXACTLY ACCORDII	SURVEY PLAT ARE U NG TO THE NATIONAL	I.S. SURVEY FEET. INSTITUTE OF	TOWNSI	י 12 SOUT COI
2.	ALL REFERENCES HEREON TO BO FILED IN THE RECORDS OF EL PA	OOKS, PAGES, MAPS AND RECEPTION ASO COUNTY, COLORADO.	NUMBERS ARE PUBLI	C DOCUMENTS	please fill in missing	
3.	THE 6TH PRINCIPAL MERIDIAN, BE CAP STAMPED "LS 24964 2000"	SOUTH LINE OF SECTION 17, TOWNS EING MONUMENTED AT THE SOUTHEA FLUSH WITH THE GROUND AND AT 955 1996"0.35'BELOW GROUND, BE	ST CORNER BY A 3- THE SOUTHWEST CORN	E 64 WEST OF 1/4" ALUMINUM NER BY A 2–1/2"	information	
1.		GNATED F.E.M.A. FLOODPLAIN, AS DE Y, COLORADO, PANEL NUMBER 08041				
5.	WATER SERVICES SHALL BE SUPP	PLIED BY				PON
5.	SEWER SERVICES SHALL BE SUPF	PLIED BY				
7. 3.		JPPLIED BY MOUNTAIN VIEW ELECTRIC BE SUPPLIED BY				IRISH HUNTER TRAI
9.	FIRE PROTECTION BY THE BLACK	FOREST FIRE PROTECTION DISTRICT.				
10.	ALL STRUCTURAL FOUNDATIONS S CURRENTLY LICENSED IN THE ST	SHALL BE LOCATED AND DESIGNED E ATE OF COLORADO.	BY A PROFESSIONAL E	ENGINEER,		
11.	OR FINAL PLAT FOR THIS SUBDIV DEVELOPMENT DEPARTMENT; TRA	BEEN SUBMITTED IN ASSOCIATION WI /ISION AND ARE ON FILE AT THE CO NSPORTATION IMPACT STUDY; DRAIN REPORT; NATURAL HAZARDS REPOR	UNTY PLANNING AND AGE REPORT; WATER	COMMUNITY RESOURCES		
12.	THROUGH THEIR PROPERTY. PUBL MAINTAINED BY THE INDIVIDUAL L	SPONSIBLE FOR MAINTAINING PROPER LIC DRAINAGE EASEMENTS AS SPECIF LOT OWNERS UNLESS OTHERWISE IND AT COULD IMPEDE THE FLOW OF RUN	ICALLY NOTED ON TH	IE PLAT SHALL BE , FENCES,		
13.	UTILITY AND DRAINAGE EASEMEN THEREFORE A 20 FOOT PUBLIC U PLATTED WITH A 20 FOOT PUBLIC HEREBY PLATTED WITH A 20 FOO	ALL SIDE LOT LINES ARE PLATTED ON T, EXCEPT WHEN THE SIDE YARD IS JTILITY AND DRAINAGE EASEMENT. AI C UTILITY AND DRAINAGE EASEMENT DT PUBLIC UTILITY AND DRAINAGE EA C OF EASEMENTS IS HEREBY VEST IN	ADJACENT TO A PUB L FRONT LOT LINES AND ALL REAR LOT ASEMENT. THE SOLE F	LIC STREET AND ARE HEREBY LINES ARE RESPONSIBILITY		
14.	PERMIT REQUIREMENTS, AND OTH BUT NOT LIMITED TO, THE COLOR	FEDERAL AND STATE LAWS, REGULA IER AGENCY REQUIREMENTS, IF ANY, RADO PARKS AND WILDLIFE, COLORAE AND THE U.S. FISH AND WILDLIFE SE IT RELATES TO LISTED SPECIES.	OF APPLICABLE AGEN OO DEPARTMENT OF T	NCIES, INCLUDING, TRANSPORTATION,		 "THE TRAILS FILING NO REC. NO. 20771254
15.	THE ADDRESSES EXHIBITED ON T LEGAL DESCRIPTION AND ARE SU	HIS PLAT ARE FOR INFORMATIONAL F JBJECT TO CHANGE.	PURPOSES ONLY. THE	ARE NOT THE		
16.	NO DRIVEWAY SHALL BE ESTABLI COUNTY.	ISHED UNLESS AN ACCESS PERMIT H	AS BEEN GRANTED B	Y EL PASO		/ /
17.	CONTRACT, NOR SHALL BUILDING AND COMMON DEVELOPMENT IMPE ACCEPTED IN ACCORDANCE WITH APPLICANT/OWNER AND EL PASO THE OFFICE OF THE CLERK AND OTHER COLLATERAL IS PROVIDED ACCORDANCE WITH THE EL PASO ANY SUCH ALTERNATIVE COLLATE IF PERMITTED BY THE SUBDIVISIO DEVELOPMENT DIRECTOR AND ME	SHALL BE SOLD, CONVEYED, OR TRAN PERMITS BE ISSUED, UNTIL AND U ROVEMENTS HAVE BEEN CONSTRUCTE THE SUBDIVISION IMPROVEMENTS AG COUNTY AS RECORDED UNDER REC RECORDER OF EL PASO COUNTY, CO TO MAKE PROVISION FOR THE COME COUNTY LAND DEVELOPMENT CODE ERAL MUST BE APPROVED BY THE B ON IMPROVEMENTS AGREEMENT, BY T ET THE POLICY AND PROCEDURE REC COUNTY OF ANY LOTS FOR SALE, C	NLESS EITHER THE RE D AND COMPLETED A REEMENT BETWEEN T EPTION NUMBER LORADO OR, IN THE PLETION OF SAID IMPF AND ENGINEERING CF OARD OF COUNTY CO HE PLANNING AND CO QUIREMENTS OF EL PA	EQUIRED PUBLIC ND PRELIMINARILY HE IN ALTERNATIVE, ROVEMENTS IN RITERIA MANUAL. MMISSIONERS OR, MMUNITY ASO COUNTY		
	IF PERMITTED BY THE SUBDIVISIO DEVELOPMENT DIRECTOR UPON E COMPLETION AND PRELIMINARY A IMPROVEMENTS REQUIRED TO BE IMPROVEMENTS AGREEMENT. THE	REMOVED OR RESCINDED BY THE BO ON IMPROVEMENTS AGREEMENT, BY T ITHER APPROVAL OF AN ALTERNATIV ACCEPTANCE BY THE EL PASO BOARI CONSTRUCTED AND COMPLETED IN A PARTIAL RELEASE OF LOTS FOR SAU NCE WITH ANY PLANNED PARTIAL REL EEMENT.	HE PLANNING AND CO E FORM OF COLLATER O OF COUNTY COMMIS ACCORDANCE WITH SA LE, CONVEYANCE OR	OMMUNITY RAL OR SSIONERS OF ALL ND SUBDIVISION TRANSFER MAY	fill in missing	
18.		EMOVES, ALTERS OR DEFACES ANY F ACCESSORY, COMMITS A CLASS TWO				
19.		DIVISION IS INCLUDED IN	METROPOL	ITAN DISTRICT.		
20.	AND DRAINAGE FACILITIES UNTIL	TROPOLITAN DISTRICT WILL BE RESPO PRELIMINARY ACCEPTANCE OF THE F E LAND DEVELOPMENT CODE, THE EN EEMENT.	PUBLIC IMPROVEMENTS	S IN ACÇÓRDANCE		
21.		DIVISION IS SUBJECT TO A DECLARAT			OREGON WAGOI	V TRAIL (60' R.O.W.)
22.		IN ACCORDANCE WITH ALL EL PASO				
23.	AND ASSIGNEES THAT SUBDIVIDED TRAFFIC IMPACT FEES IN ACCORE RESOLUTION (RESOLUTION NO. 19 BUILDING PERMIT SUBMITTALS. TH DOCUMENTED ON ALL SALES DOC FIND THE FEE OBLIGATION BEFOR PAID AT BUILDING PERMIT. THE S	BEHALF OF HIM/HERSELF AND ANY E R AND/OR SAID SUCCESSORS AND A DANCE WITH THE EL PASO COUNTY F 9-471), OR ANY AMENDMENTS THERE HE FEE OBLIGATIONS, IF NOT PAID A CUMENTS AND ON PLAT NOTES TO E RE SALE OF THE PROPERTY. TRANSP SUBDIVIDER AGREES TO THE INCLUSIO IPROVEMENT DISTRICT NO. 2 AS REC	ASSIGNS SHALL BE RE ROAD IMPACT FEE PR TO, AT OR PRIOR TO T FINAL PLAT RECORE NSURE THAT A TITLE ORTATION IMPACT FEE ON OF THE TRAILS FIL	EQUIRED TO PAY OGRAM THE TIME OF DING, SHALL BE SEARCH WOULD ES ARE TO BE LING NO. 9 IN TO		* LOT 9 * LOT 10
24.	 There shall be no direct res	SIDENTIAL LOT ACCESS TO LATIGO BO	DULEVARD.			SE
	please add mitigation methods from soils and geo. report	SW COR. SEC. 17, T12S, R64W, 6TH F			add "or Eastonville Road" as indicated on previously approved preliminary plan	
	add a note to the plat stating that septic systems cannot be located within drainage areas and show area on plat as no build (referencing comment on page 6 of Wastewater	- RECOVERED 2-1/2 STAMPED "LS 2595 0.35' BELOW GROU	55 <i>1996"</i>	BASIS OF BEARINGS S. LINE, SEC 17, T12S, R64W, 6TH P.M. N89*25'55"W 5267.83'(M		

THE TRAILS FILING NO. 9 VEST HALF OF SECTION 16 AND A PORTION OF THE SOUTHEAST QUARTER OF SECTION 17, OWNSIP 12 SOUTH, RANGE 64 WEST OF THE 6TH PRINCIPAL MERIDIAN, **COUNTY OF EL PASO, STATE OF COLORADO** ase fill in missing rmation _____ <u>LA TIGO BOULEVARD</u> N89°48'42"E 917.63' (120' R.O.W.) N89*****48'42"E 917.63' PONCA CANYON TRAIL (60' R.O.W.) 37 2 3 1 SHEET 3 S89'32'00"E 230.48' IRISH HUNTER TRAIL (60' R.O.W.) **IRISH HUNTER TRAIL** ∆=8'39'03" -R=420.00' L=63.41' 36 LOT 23 N89*32'00"W 68.00**'** 5 N87'37'41"E N00°28'09"E_ 68.09' 636.09' _____ 35 LOT 22 S20**°**16'04"W ∆=9°05'54" 143.48' R=530.00'-0578°21'46"W 388.5. L=84.16' * TRACT C 7 N6912'04"E 486.05 N20*47'56"W 134.68' SHEET 4 N00°28'09"E 34 102.93**'** 8 LOT 20 THÉ TRAILS FILING NO. 8 33 REC. NO. 207712541 S87'35'59"E LOT 1 32 TRA | * LOT 2 * 31 10 11 _S87*35'59"E 31.60' LOT 3 30 MANCHEGO TRAIL N00°28'09"E__ 200.00' _\$02*****24'01"W 12 218.11' LOT 4* 29 ___ · · ___ · LOT 5* 28 13 __+___ ____ · · · ____ · · · ____ ω^{*} S89•31'51"E_{_} _____ · · ____ · · ____ · 304.75**'** 14 missing 27 rmation ∖*| 15 25 26 16 N01°31'40"W _60.00**'**⊤ N88*28'20"E FORIE 125.09' 17 OREGON WAGON TRAIL (60' R.O.W.) 22 18 TRAIL, * 23 * LOT 9 LOT 8 20 24 SHEET 4 | | * LOT 10_{*}| ···—··—·· 21 0.25' BELOW -GROUND 20 19 - · i -----S89°27'42"W 398.27' S89'27'42"W_ 1.79' N69'28'15"W 791.84' POINT OF BEGINNING or Eastonville d" as indicated on ously approved minary plan SE COR. SEC. 17, T12S, R64W, 6TH P.M. RECOVERED 3-1/4" ALUMINUM CAP STAMPED "LS 24964 2000"

FLUSH WITH GROUND

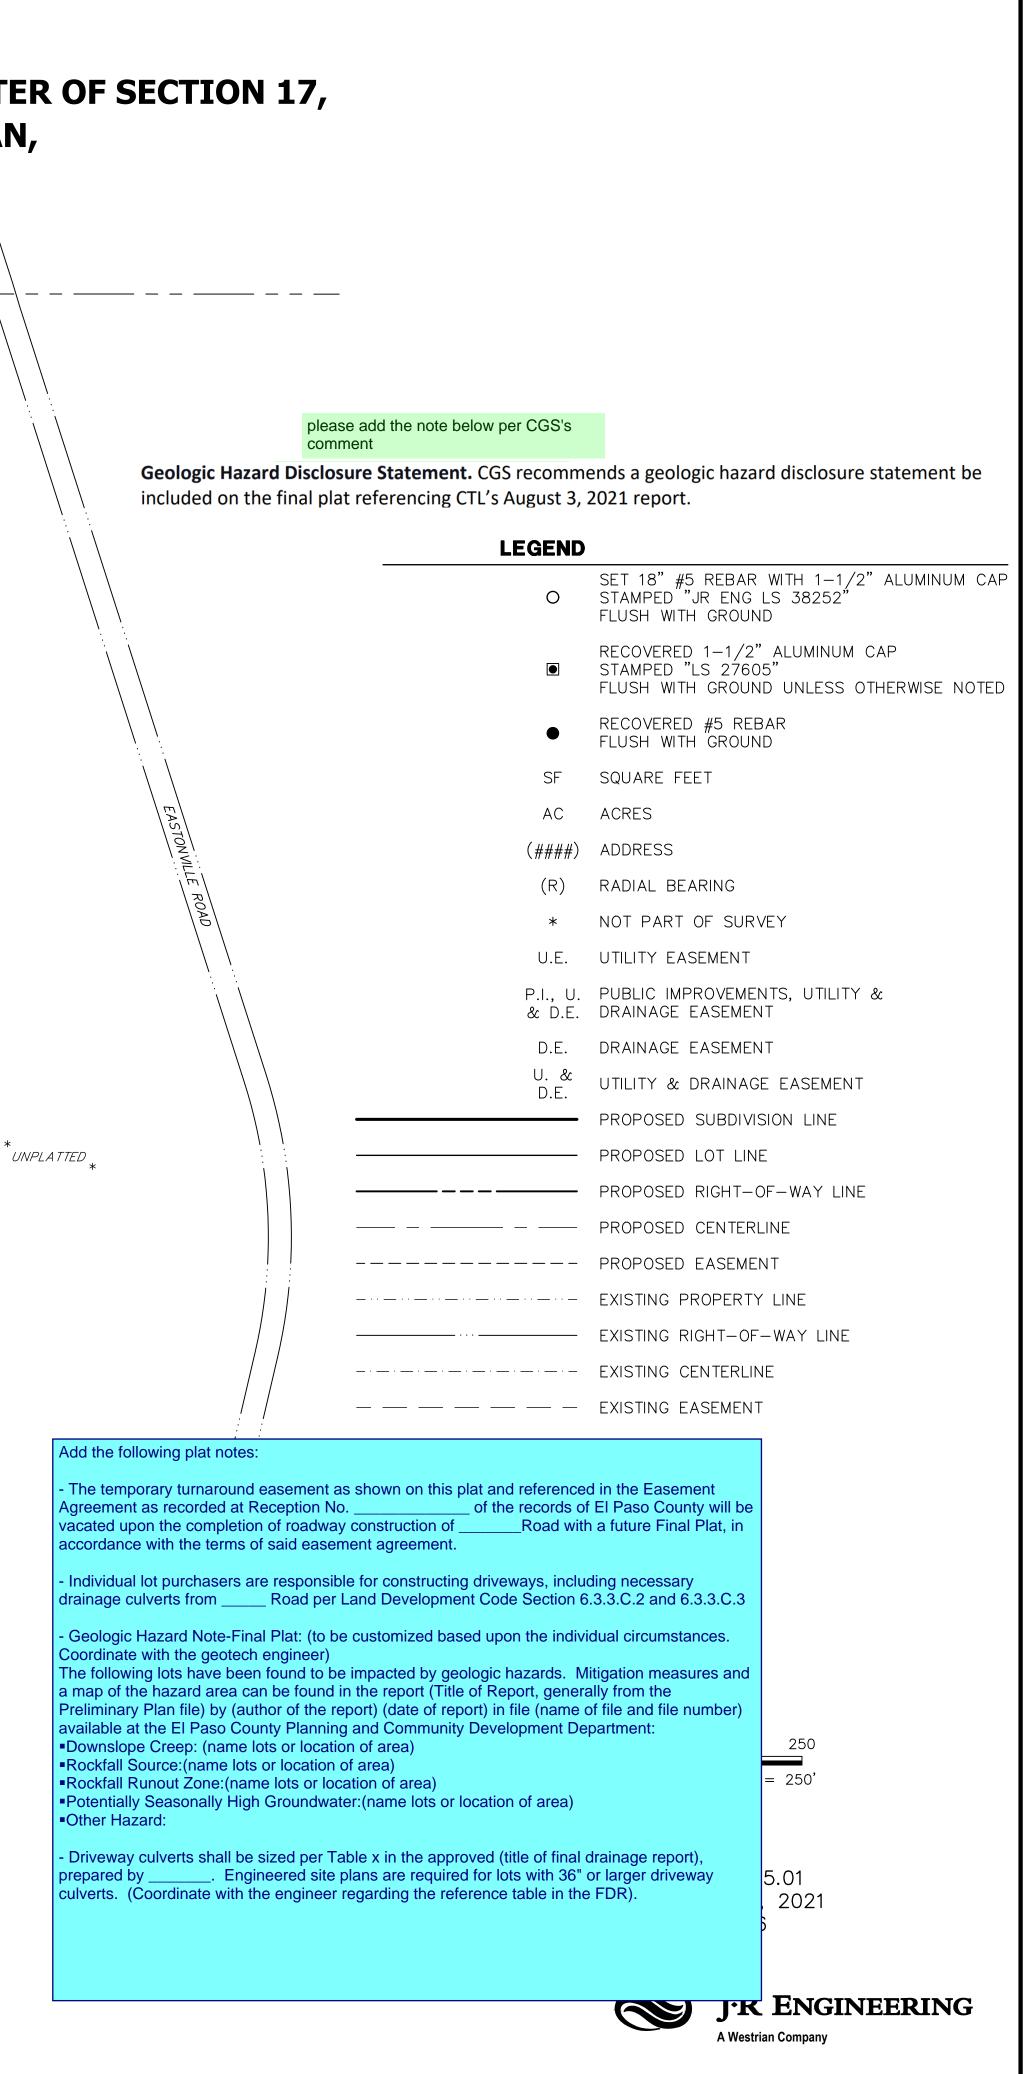

Centennial 303-740-9393 • Colorado Springs 719-593-2593 Fort Collins 970–491–9888 • www.jrengineering.com

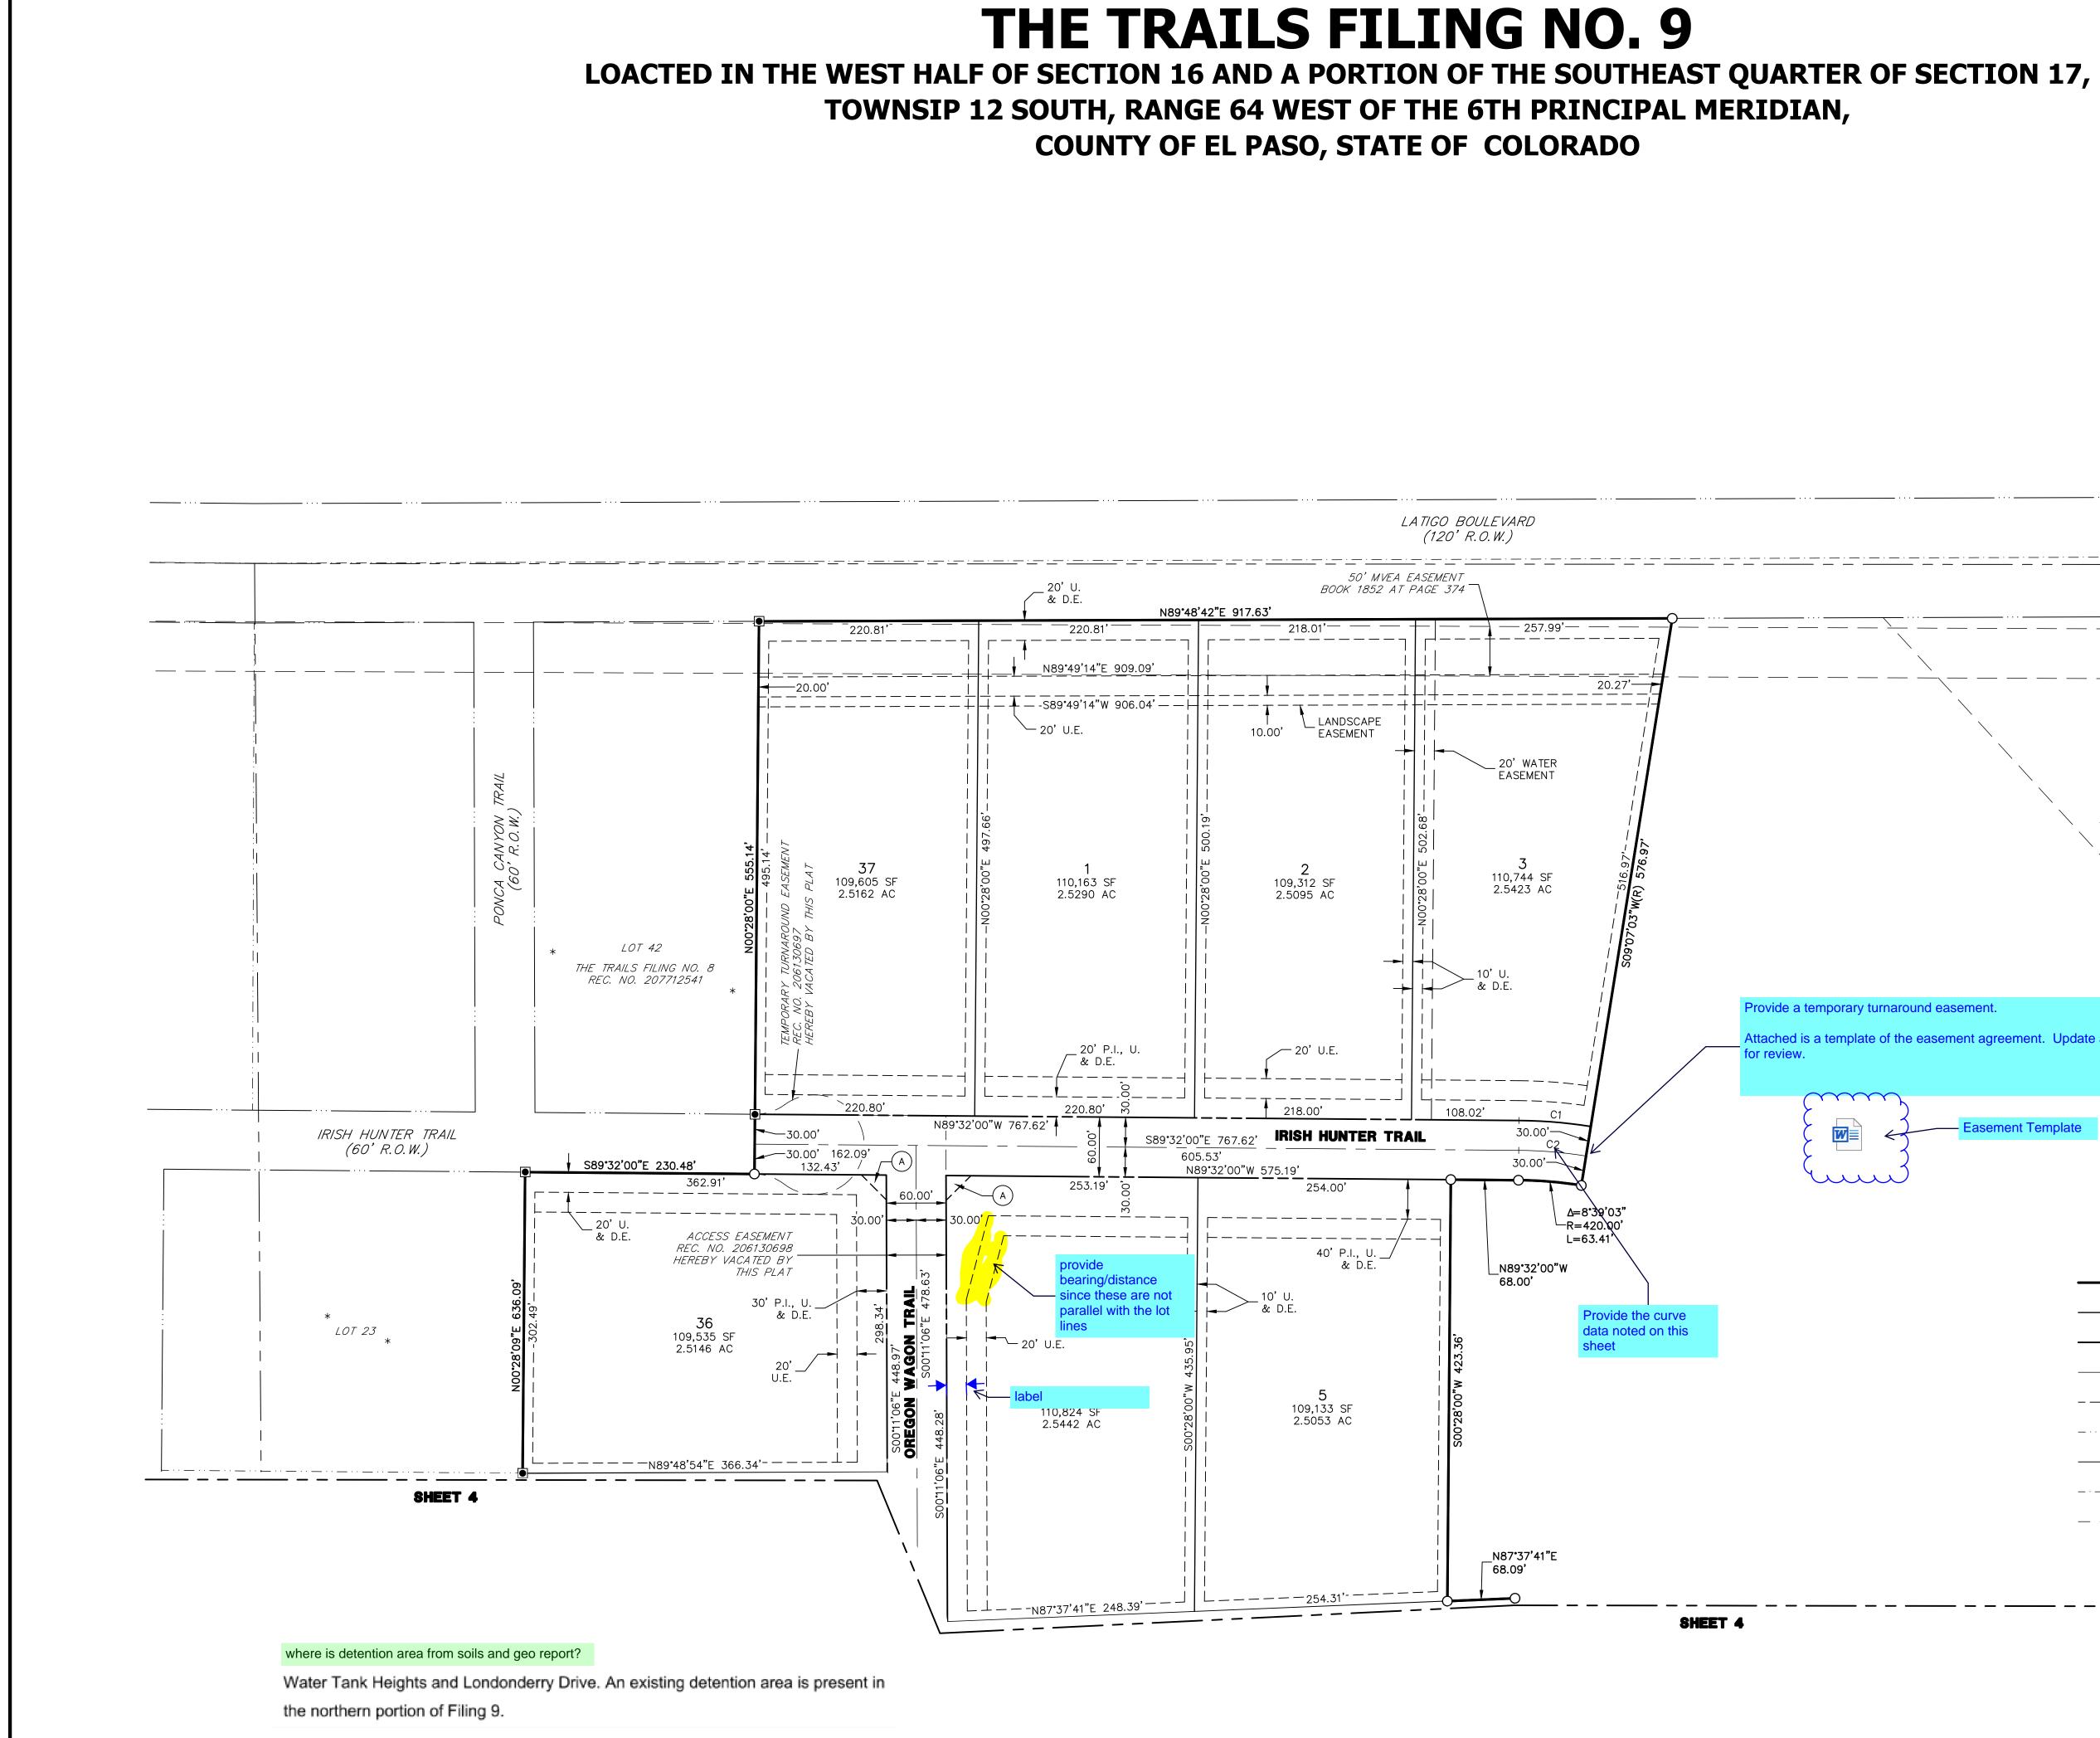

25.00**'** SITE VISIBILITY AND PUBLIC IMPROVEMENT EASEMENT (TYP.) ORIGINAL SCALE: 1" = 80' LEGEND SET 18" #5 REBAR WITH 1-1/2" ALUMINUM CAP STAMPED["]"JR ENG LS 38252" 0 FLUSH WITH GROUND RECOVERED 1-1/2" ALUMINUM CAP STAMPED "LS 27605" FLUSH WITH GROUND UNLESS OTHERWISE NOTED RECOVERED #5 REBAR FLUSH WITH "GROUND SF SQUARE FEET Provide a temporary turnaround easement. AC ACRES Attached is a template of the easement agreement. Update and submit (####) ADDRESS (R) RADIAL BEARING \sim * NOT PART OF SURVEY W Easement Template U.E. UTILITY EASEMENT P.I., U. PUBLIC IMPROVEMENTS, UTILITY & J & D.E. DRAINAGE EASEMENT D.E. DRAINAGE EASEMENT U. & UTILITY & DRAINAGE EASEMENT D.E. - PROPOSED SUBDIVISION LINE - PROPOSED LOT LINE - PROPOSED RIGHT-OF-WAY LINE ------ PROPOSED CENTERLINE ---- PROPOSED EASEMENT ----- EXISTING PROPERTY LINE - EXISTING RIGHT-OF-WAY LINE ----- EXISTING CENTERLINE


- - EXISTING EASEMENT

JOB NO. 25175.01 SEPTEMBER 9, 2021 SHEET 3 OF 6




J·R ENGINEERING A Westrian Company

Centennial 303-740-9393 • Colorado Springs 719-593-2593 Fort Collins 970-491-9888 • www.jrengineering.com

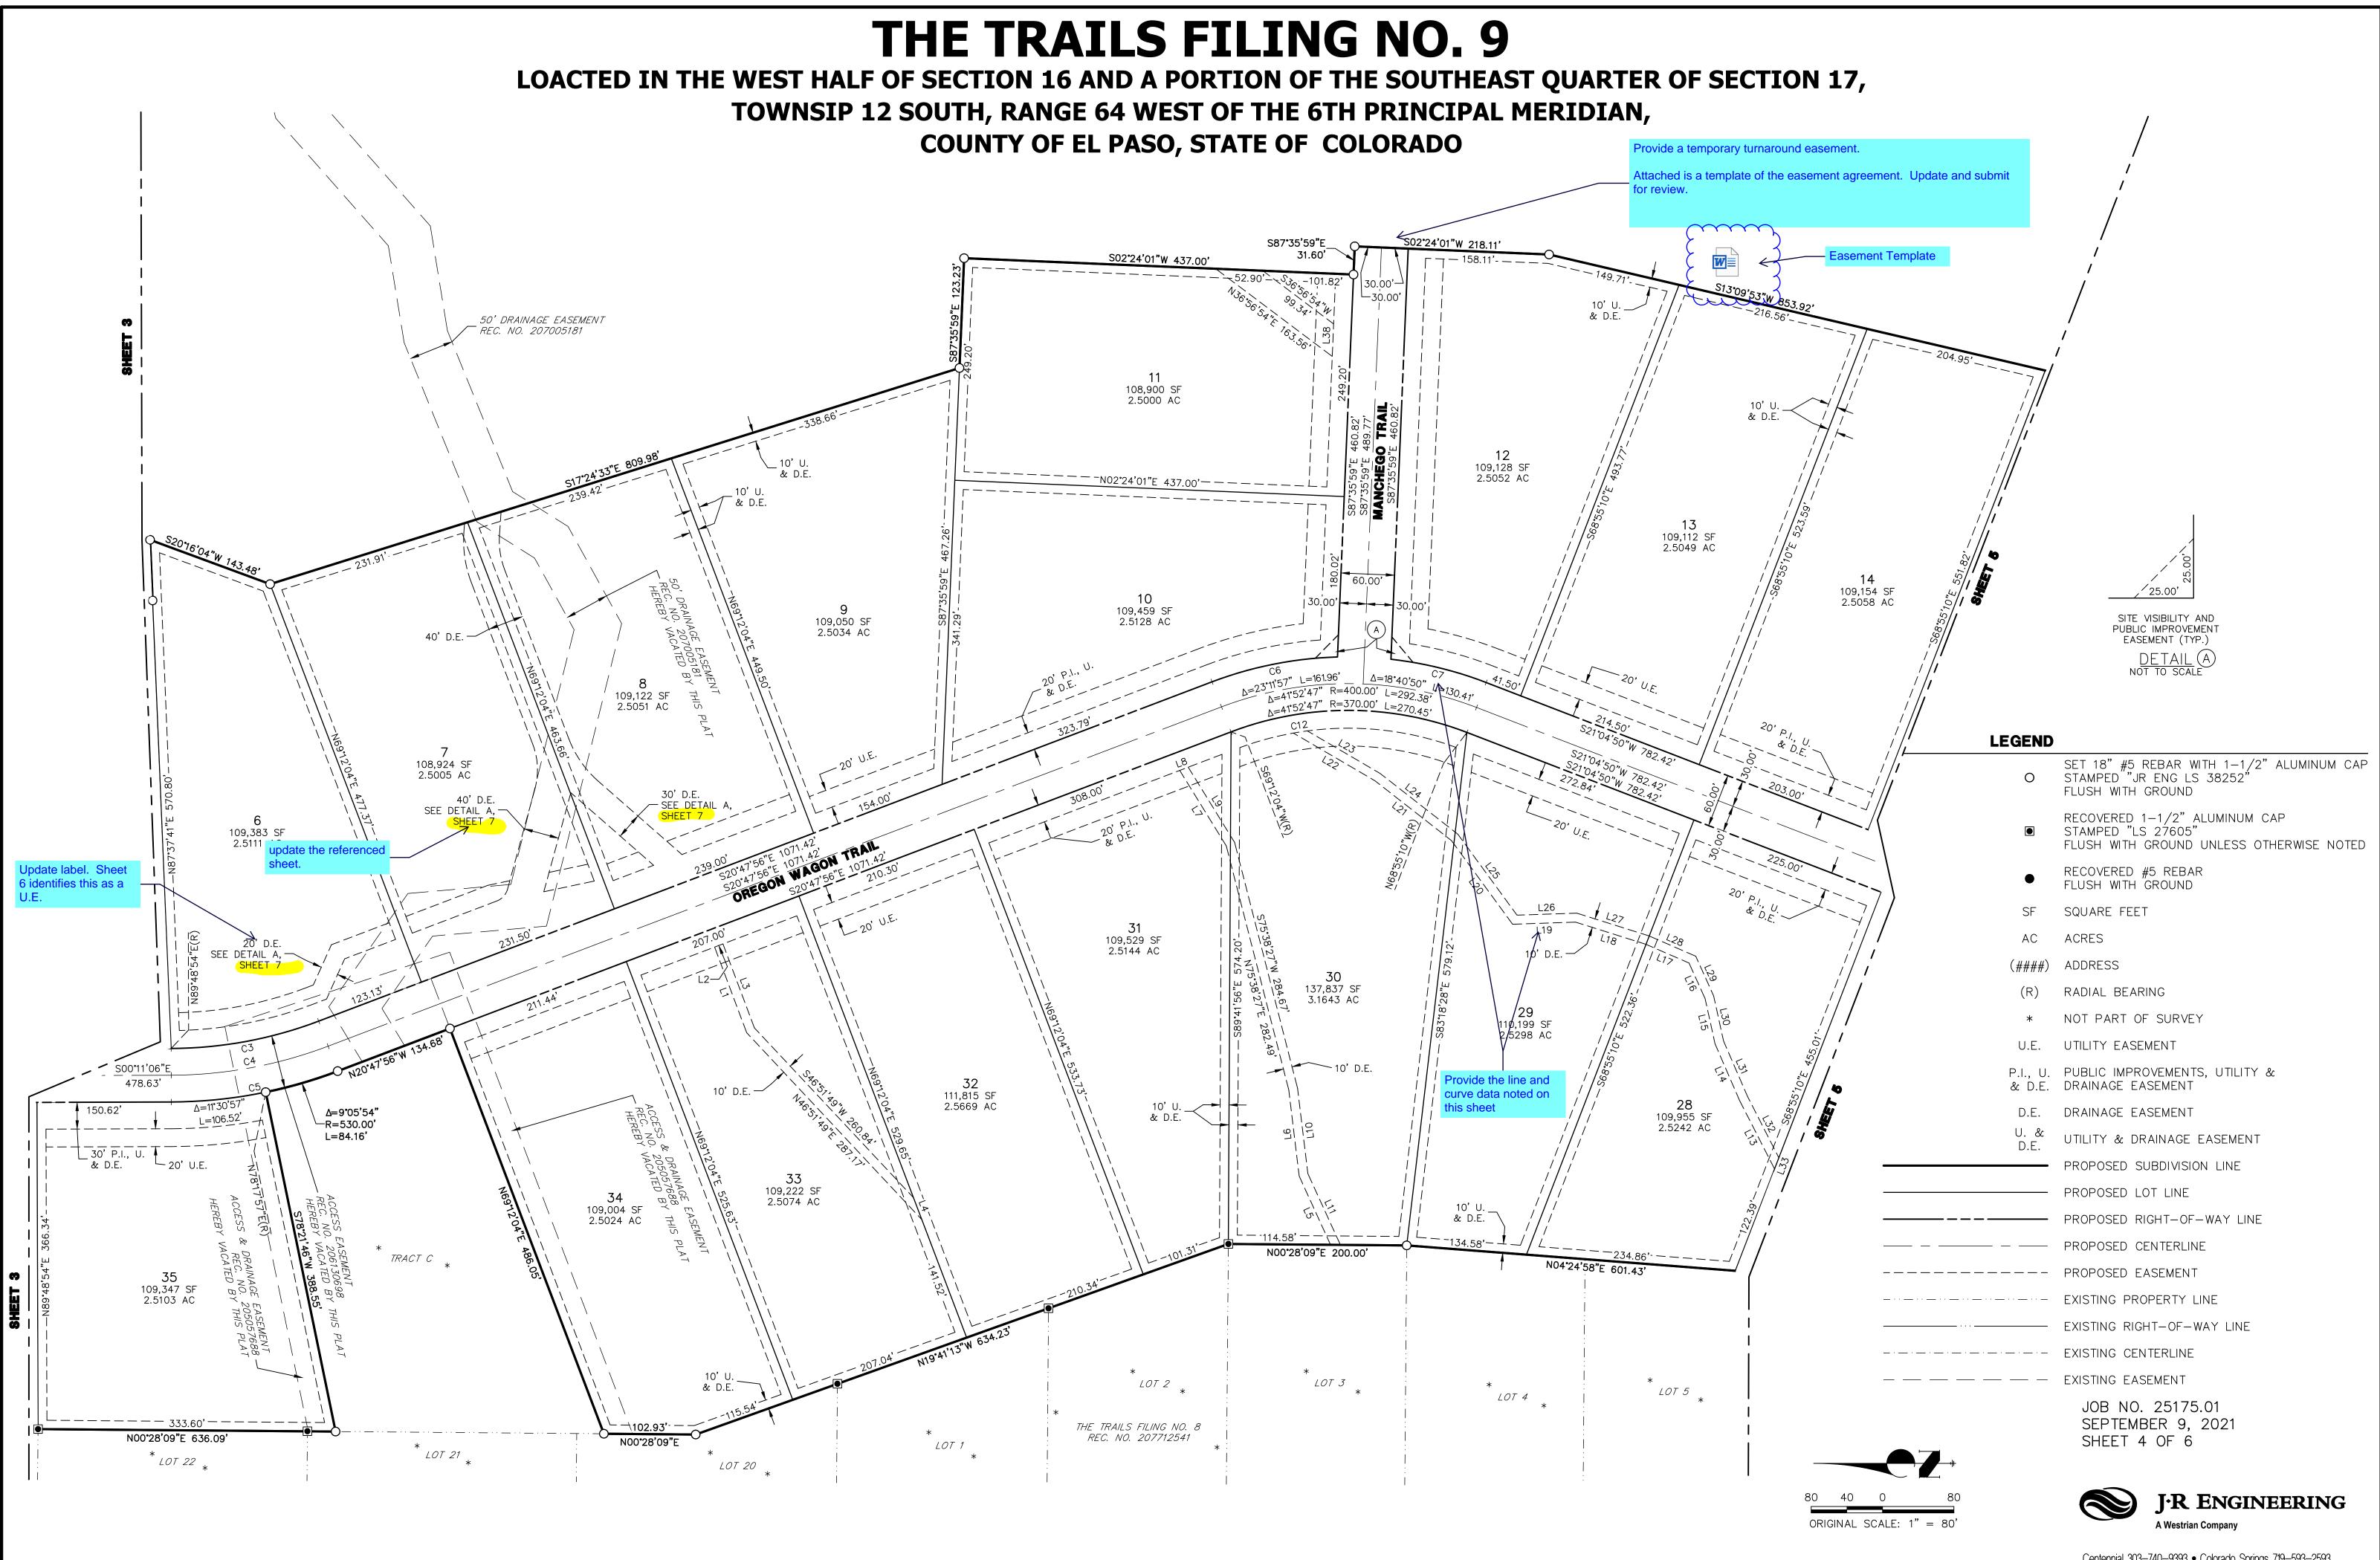

Centennial 303-740-9393 • Colorado Springs 719-593-2593 Fort Collins 970-491-9888 • www.jrengineering.com

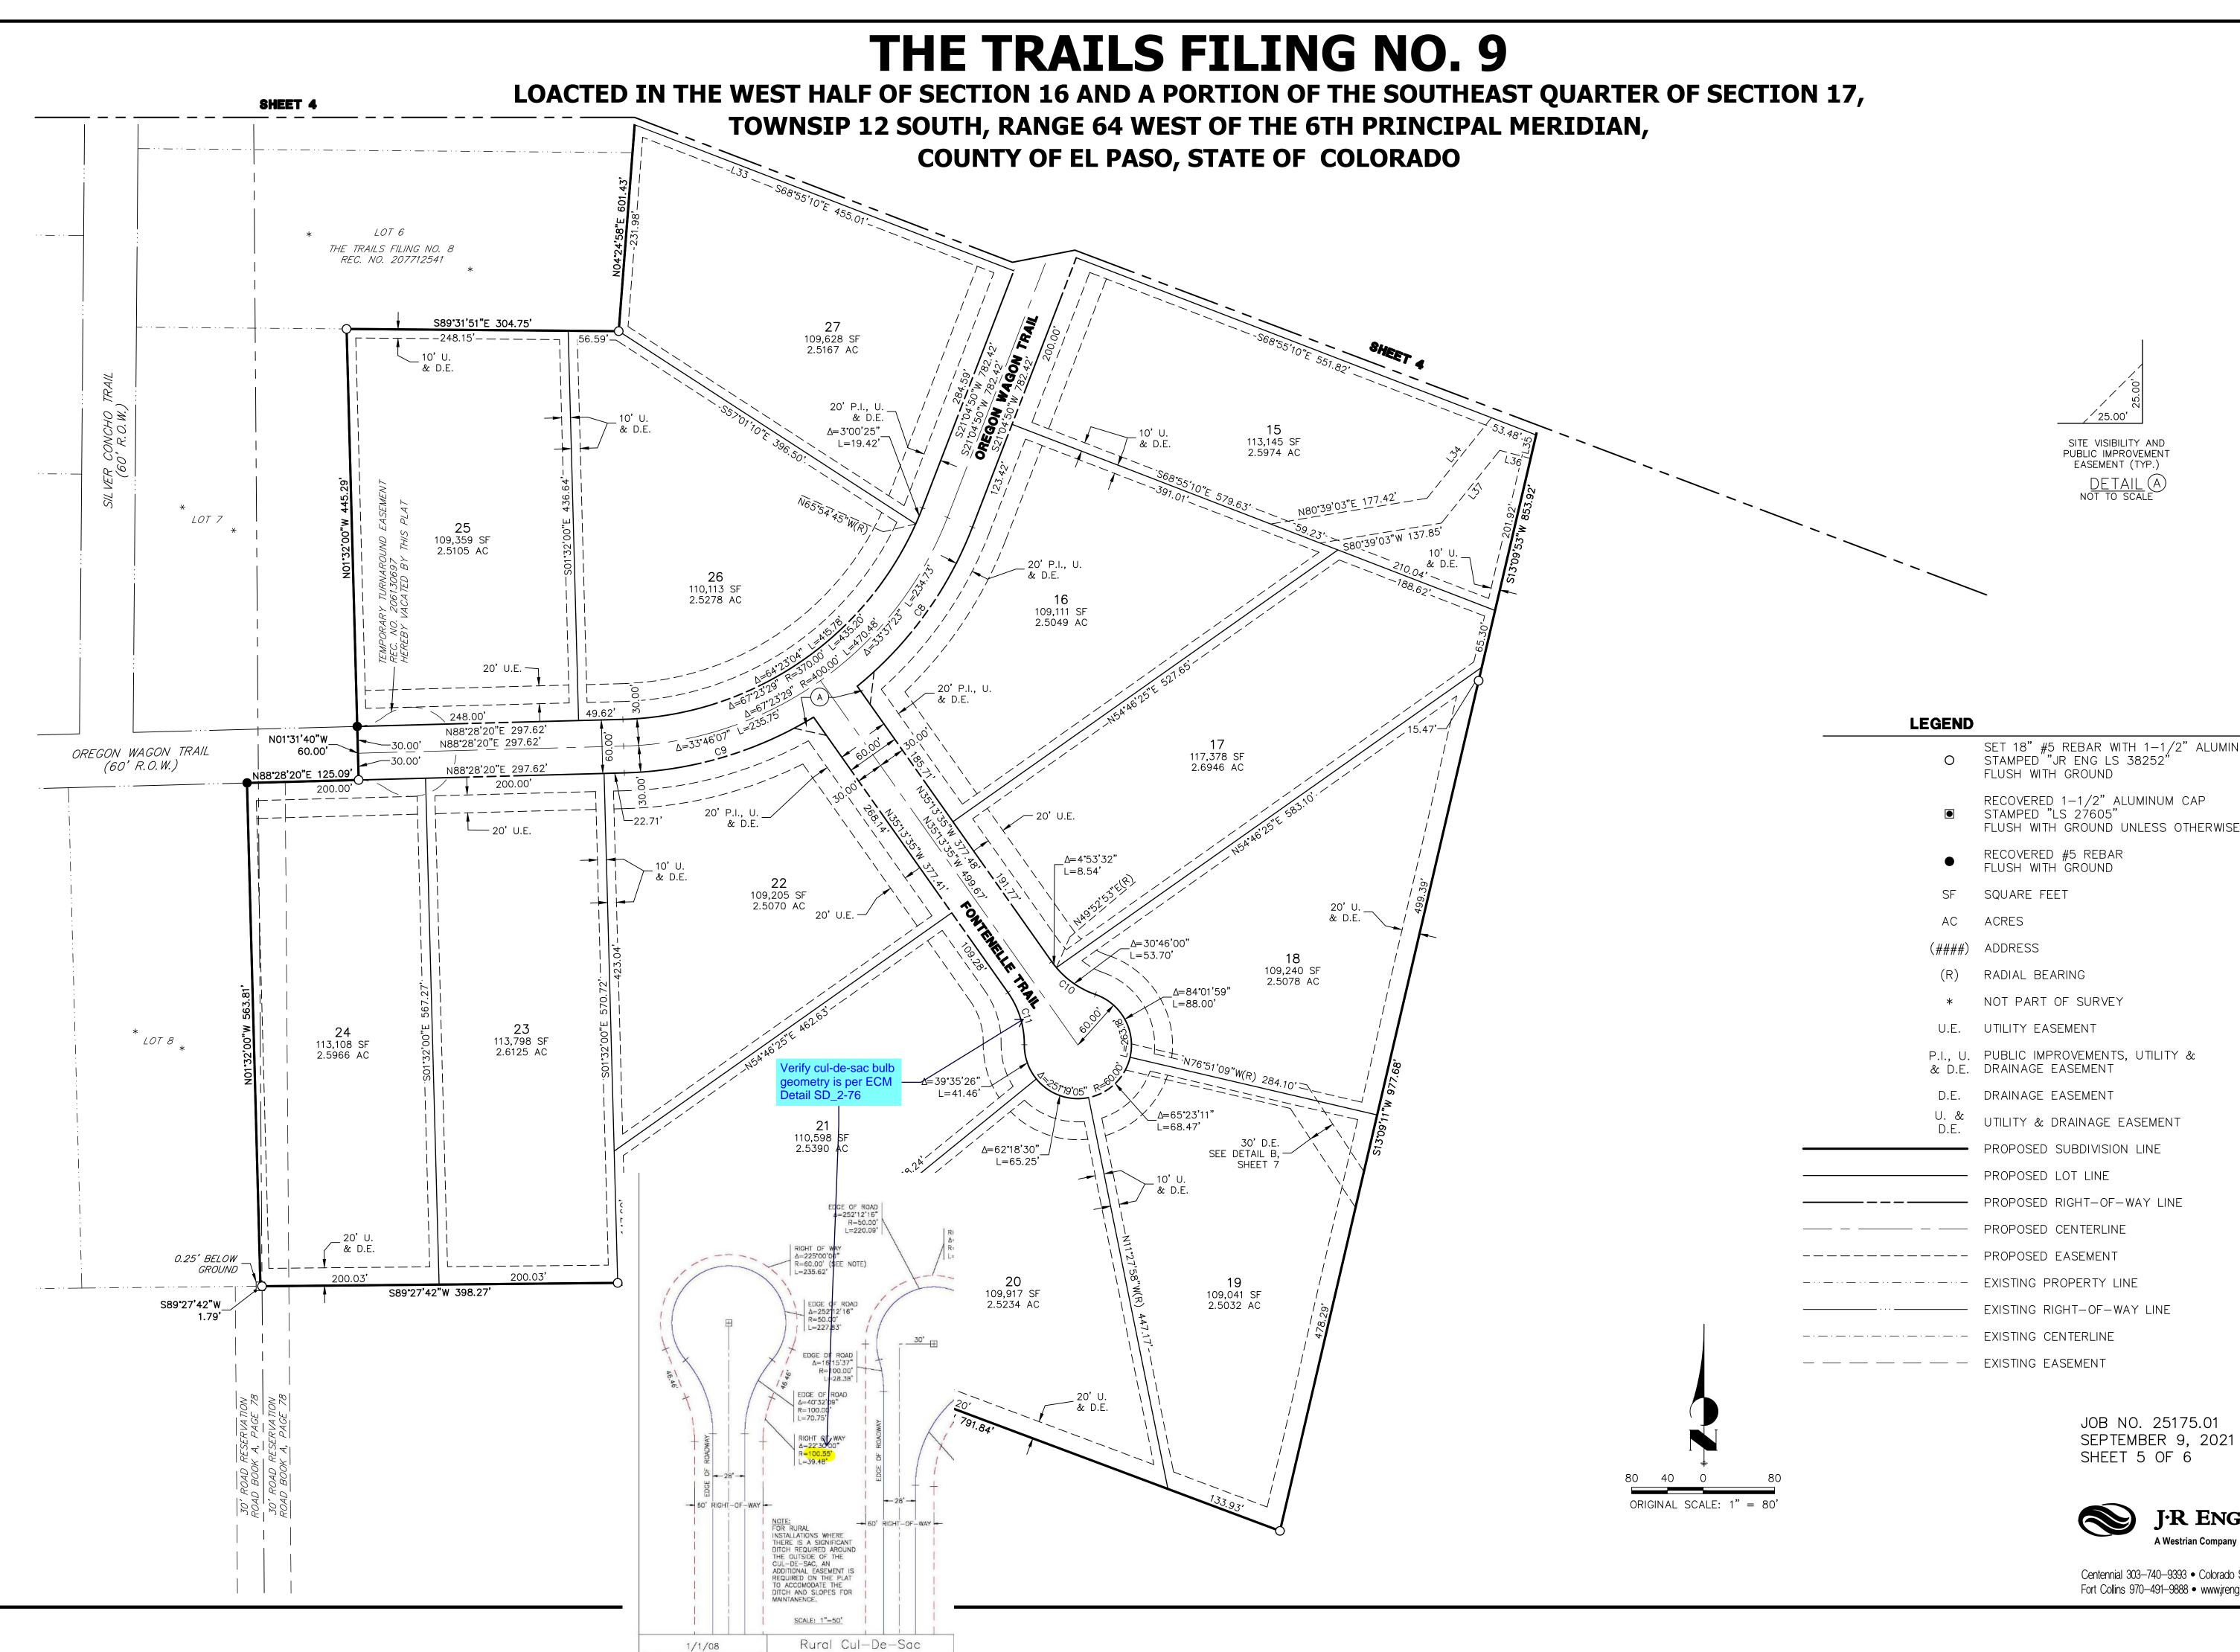


1/1/08

- SET 18" #5 REBAR WITH 1-1/2" ALUMINUM CAP STAMPED "JR ENG LS 38252" FLUSH WITH GROUND
- FLUSH WITH GROUND UNLESS OTHERWISE NOTED

J·R ENGINEERING

Centennial 303-740-9393 • Colorado Springs 719-593-2593 Fort Collins 970-491-9888 • www.jrengineering.com

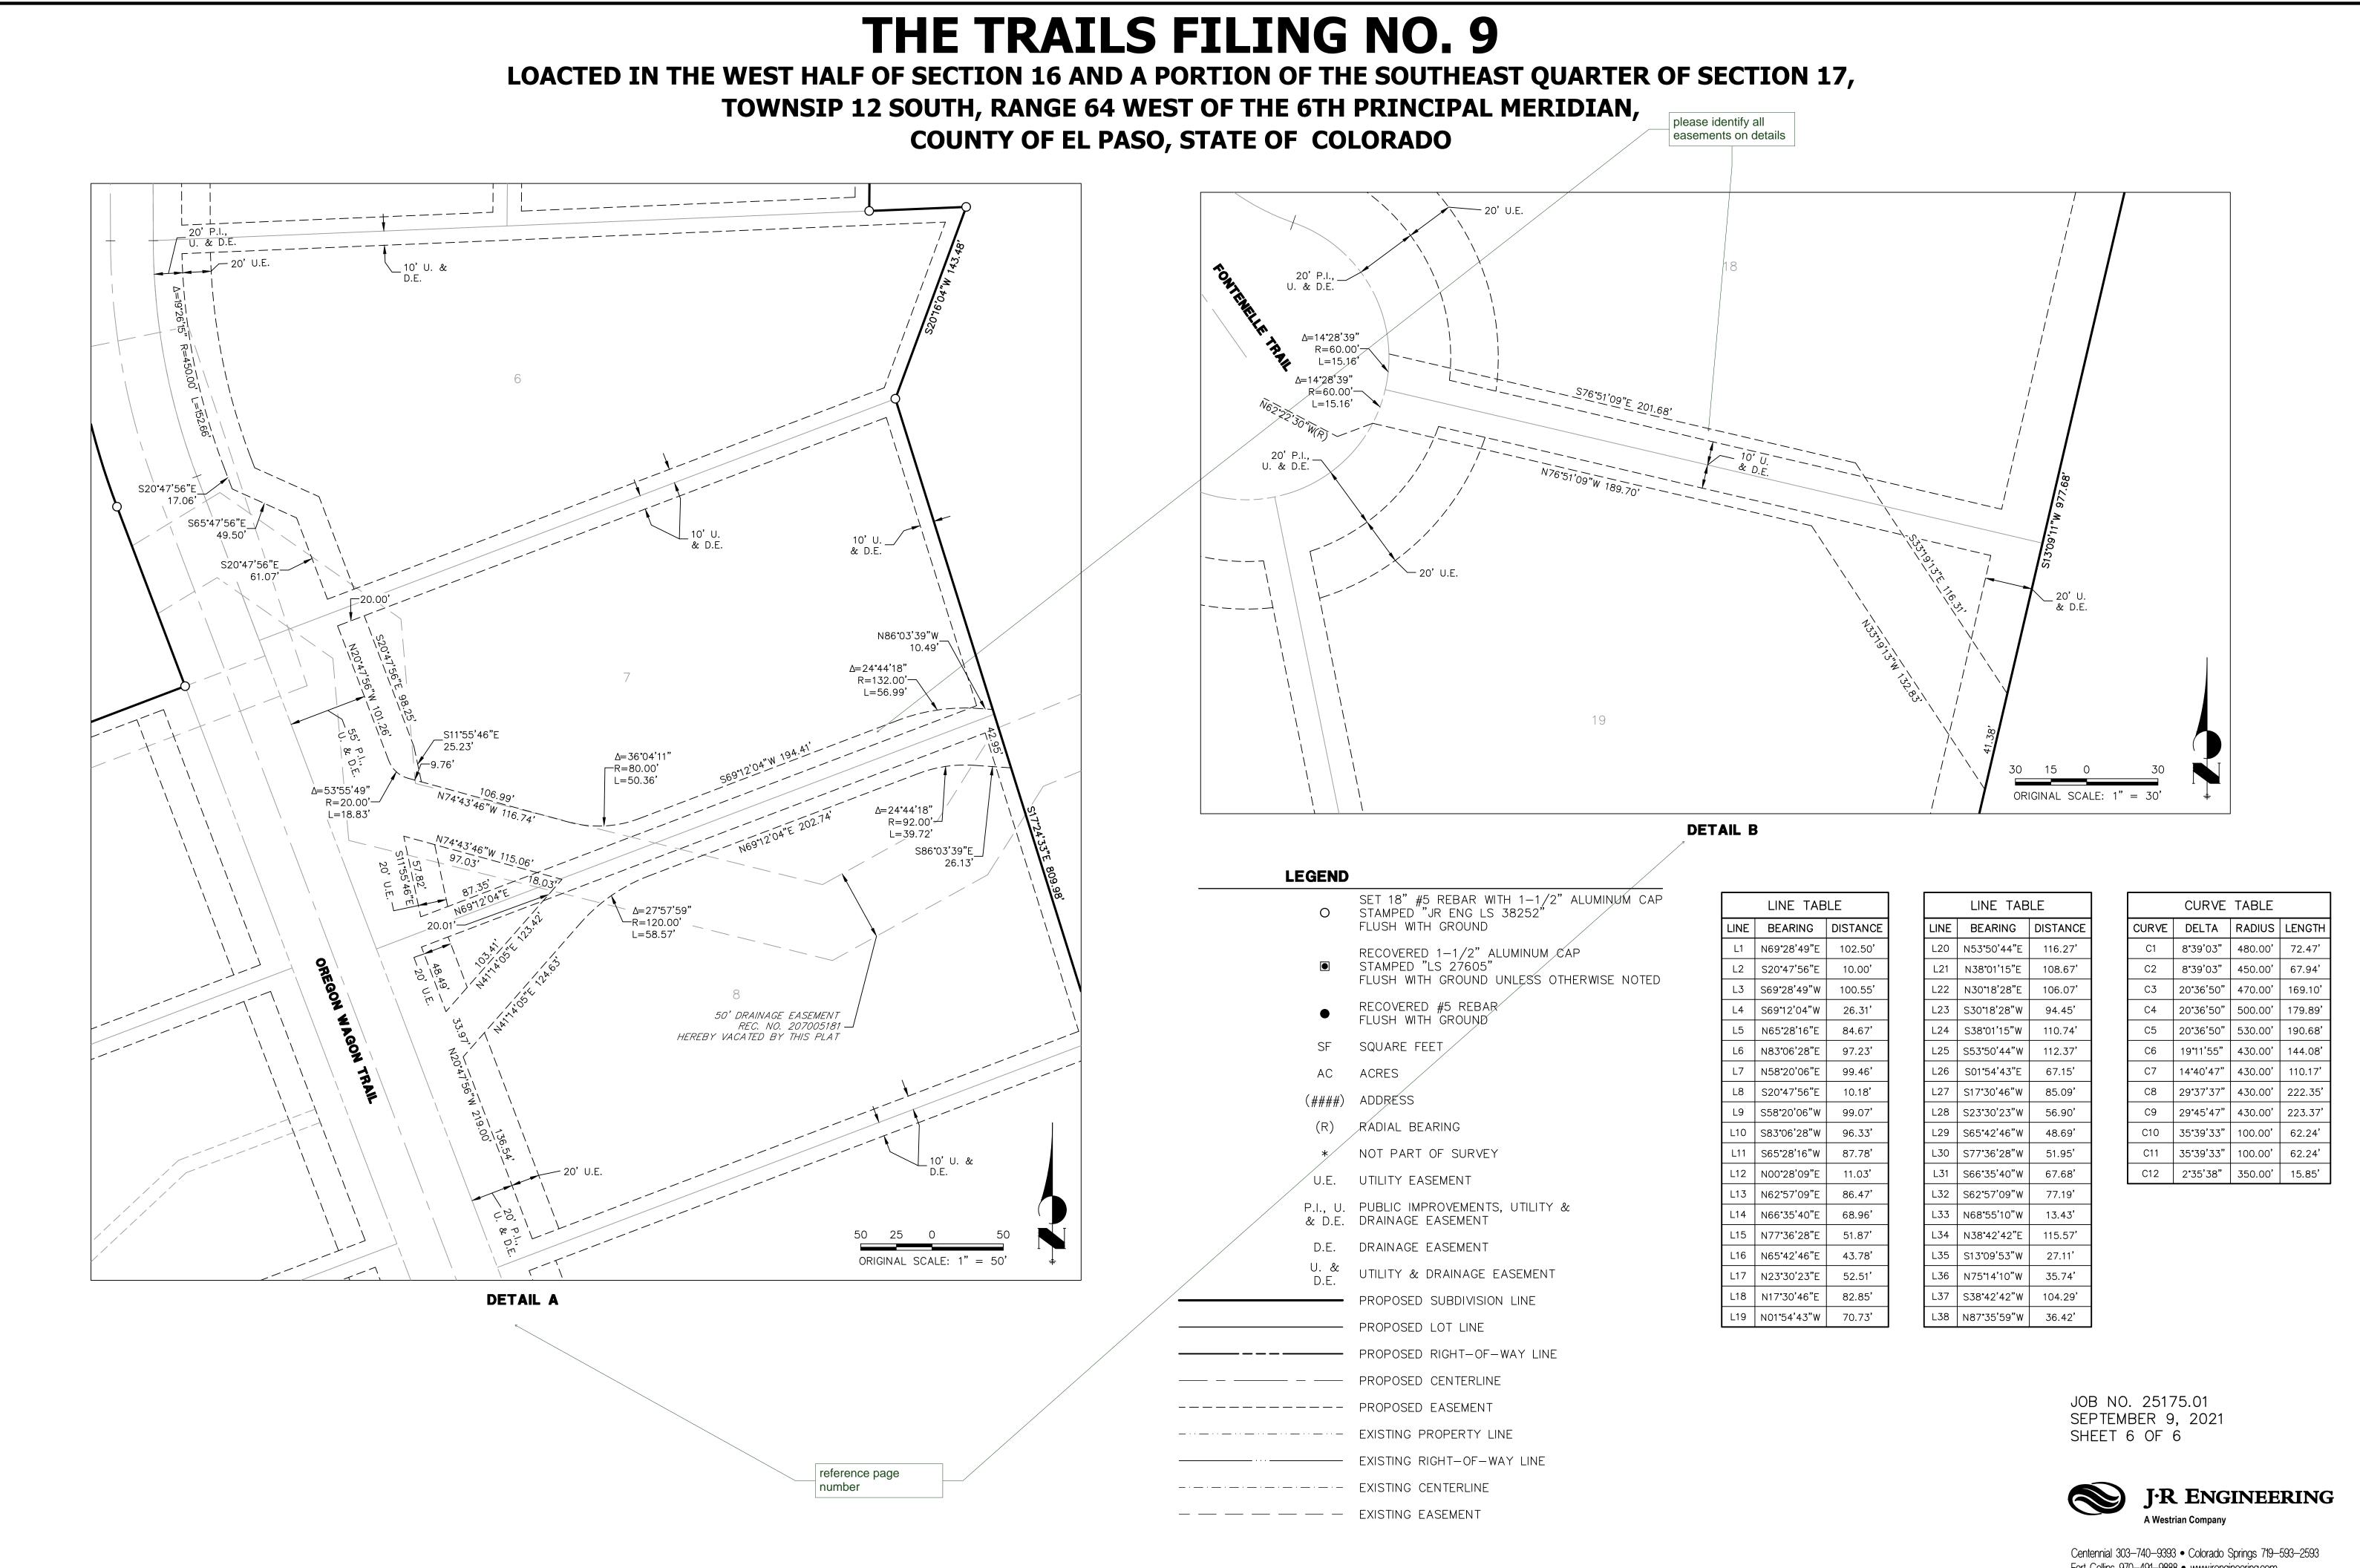

LEGEND	
Ο	SET 18" #5 REBAR WITH 1-1/2" ALUMINUM CAP STAMPED "JR ENG LS 38252" FLUSH WITH GROUND
	RECOVERED 1-1/2" ALUMINUM CAP STAMPED "LS 27605" FLUSH WITH GROUND UNLESS OTHERWISE NOTED
•	RECOVERED #5 REBAR FLUSH WITH GROUND
SF	SQUARE FEET
AC	ACRES
(####)	ADDRESS
(R)	RADIAL BEARING
*	NOT PART OF SURVEY
U.E.	UTILITY EASEMENT
P.I., U. & D.E.	PUBLIC IMPROVEMENTS, UTILITY & DRAINAGE EASEMENT
D.E.	DRAINAGE EASEMENT
U. & D.E.	UTILITY & DRAINAGE EASEMENT
	PROPOSED SUBDIVISION LINE
	PROPOSED LOT LINE
	PROPOSED RIGHT-OF-WAY LINE
	PROPOSED CENTERLINE
	PROPOSED EASEMENT
	EXISTING PROPERTY LINE
	EXISTING RIGHT-OF-WAY LINE
_ · · · ·	EXISTING CENTERLINE
	EXISTING EASEMENT

LINE TABLE				
LINE	BEARING	DISTANCE		
L1	N69°28'49"E	102.50'		
L2	S20°47'56"E	10.00'		
L3	S69°28'49"W	100.55'		
L4	S69°12'04"W	26.31'		
L5	N65°28'16"E	84.67'		
L6	N83°06'28"E	97.23'		
L7	N58°20'06"E	99.46'		
L8	S20°47'56"E	10.18'		
L9	S58°20'06"W	99.07'		
L10	S83°06'28"W	96.33'		
L11	S65°28'16"W	87.78'		
L12	N00°28'09"E	11.03'		
L13	N62 ° 57'09"E	86.47'		
L14	N66°35'40"E	68.96'		
L15	N77 ° 36'28"E	51.87'		
L16	N65°42'46"E	43.78'		
L17	N23°30'23"E	52.51'		
L18	N17°30'46"E	82.85'		
L19	N01°54'43"W	70.73'		

LINE TABLE				
LINE	BEARING	DISTANCE		
L20	N53 ° 50'44"E	116.27'		
L21	N38°01'15"E	108.67 '		
L22	N30°18'28"E	106.07 '		
L23	S30°18'28"W	94.45'		
L24	S38°01'15"W	110.74'		
L25	S53°50'44"W	112.37'		
L26	S01°54'43"E	67.15 '		
L27	S17°30'46"W	85.09'		
L28	S23°30'23"W	56.90'		
L29	S65°42'46"W	48.69'		
L30	S77°36'28"W	51.95'		
L31	S66°35'40"W	67.68'		
L32	S62°57'09"W	77.19'		
L33	N68 ° 55'10"W	13.43'		
L34	N38°42'42"E	115.57'		
L35	S13°09'53"W	27.11'		
L36	N75°14'10"W	35.74'		
L37	S38°42'42"W	104.29'		
L38	N87°35'59"W	36.42'		

	CURVE TABLE				
CURVE	DELTA	RADIUS	LENGTH		
C1	8 ° 39'03"	480.00'	72.47'		
C2	8 ° 39'03"	450.00'	67.94'		
С3	20 ° 36'50"	470.00'	169.10'		
C4	20°36'50"	500.00'	179.89'		
C5	20 ° 36'50"	530.00'	190.68'		
C6	19 ° 11'55"	430.00'	144.08'		
C7	14°40'47"	430.00'	110.17'		
C8	29 ° 37'37"	430.00'	222.35'		
C9	29°45'47"	430.00'	223.37'		
C10	35 ° 39'33"	100.00'	62.24'		
C11	35°39'33"	100.00'	62.24'		
C12	2 ° 35'38"	350.00'	15.85'		

Centennial 303–740–9393 • Colorado Springs 719–593–2593 Fort Collins 970–491–9888 • www.jrengineering.com