

Preliminary and Final DRAINAGE PLAN AND REPORT

ROCKY TOP MOTEL AND CAMPGROUND

10090 W Highway 24

A portion of the NW ¼, Section 9, Township 13 South, Range 68 West
EL PASO COUNTY

June 14, 2019

Updated
August 16, 2021

Revised
January 4, 2022

Revised
April 13, 2022

Prepared for

G & D Enterprises
10090 West Highway 24
Green Mountain Falls, CO 80819

County File No.: PPR2140

Oliver E. Watts, Consulting Engineer, Inc.
Colorado Springs, Colorado

OLIVER E. WATTS, PE-LS
OLIVER E. WATTS, CONSULTING ENGINEER, INC.
CIVIL ENGINEERING AND SURVEYING
614 ELKTON DRIVE
COLORADO SPRINGS, COLORADO 80907
(719) 593-0173
fax (719) 265-9660
olliewatts@aol.com
Celebrating over 43 years in business

April 13, 2022

El Paso County Planning and Community Development
2880 International Circle
Colorado Springs, CO 80910

ATTN: *Jennifer Irvine, P.E.*

Previous comment:
Please revise as
there is currently an
interim County
Engineer, Joshua
Palmer, P.E.
Review 4: unresolved

SUBJECT: Drainage Plan and Report
Rocky Top Motel and Campground

Transmitted herewith for your review and approval is the drainage plan and report for The Rocky Top Motel and Campground in El Paso County. This report is prepared and a result of Craig Dossey's letter of May 2, 2019 regarding an alleged violation of County grading regulations. It has been revised per the 10-7-21 County Review and our subsequent meetings. This report will accompany the submittal of other land use applications. Please contact me if I may provide any further information.

Oliver E. Watts, Consulting Engineer, Inc.

BY: _____
Oliver E. Watts, President

Encl:

Drainage Report 6 pages
Runoff Computations, 3 pages
UD Computations, 5 pages
FEMA Panel No. 08041C0952 G
SCS Soils Map
Backup Information, 4 sheets
Drainage Plan, Dwg 19-5341-02

1. ENGINEER'S STATEMENT:

The attached drainage plan and report were prepared under my direction and supervision and are correct to the best of my knowledge and belief. Said drainage report has been prepared according to the criteria established by the County for drainage reports and said report is in conformity with the applicable master plan of the drainage basin. I accept responsibility for any liability caused by any negligent acts, errors or omissions on my part in preparing this report.

Oliver E. Watts, Consulting Engineer, Inc.

Oliver E. Watts Colo. PE-LS No. 9853

2. OWNERS / DEVELOPER'S STATEMENT:

I the owner / developer have read and will comply with all of the requirements specified in this drainage report and plan.

G & D Enterprises, Corp.

By: _____

Daniel P. Nieman, owner
10090 West Highway 24
Green Mountain Falls, CO 80819
684-9044


3. EL PASO COUNTY:

Filed in accordance with the requirements of the El Paso Land Development Code, Drainage Criteria Manual Volumes 1 and 2, and the Engineering Criteria Manual, as amended.

Jennifer Irvine, P.E.
County Engineer / ECM Administrator

date

Conditions:

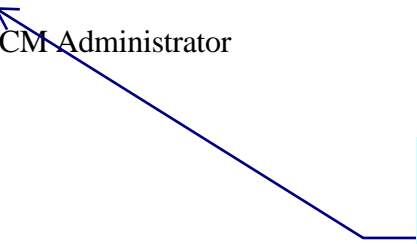

Previous comment:
Please revise to Joshua Palmer, P.E.
Interim County Engineer/ECM
Administrator
Review 4: Unresolved.

Unresolved comment from Reviews #2 & #3: discuss total proposed soil disturbance for this project. That is part of the "description." Until this discussion is added, it is unclear whether or not an ESQCP and SWMP is required.

Update for Review #4: the descriptions added to Page 3 of the PBMP Applicability Form would be a good start. At those to this Drainage Report.

4. LOCATION AND DESCRIPTION:

The Rocky Top Motel and Campground is located in a portion of the NW ¼, Section 9, Township 13 South, Range 68 West, of the 6th P.M., in El Paso County. The address, located at 10090 West Highway 24, is adjacent to Green Mountain Falls, on the north side of Highway 24 as shown in detail on the enclosed drainage plan. This facility has been in use at this location since 1947 as a motel and since 1950 as a camp ground. A use application for RV storage has been recently submitted to the County for this additional use. A detailed site survey is submitted as part of the enclosed drainage plan to delineate current conditions.

The County issued a notice of violation dated May 2, 2019, in reply to neighborhood itemizing items that needed to be completed to reply to violations of grading in excess and the un-permitted use as RV storage. The County is considering road construction several years to be included in the disturbed area.

Review 3 comment: As indicated on the previous review comment, please revise your FIRM# per your attached FIRM Map (08041C0467G)
Review 4: unresolved.

The grading reported by the neighbors mostly involved repair and maintenance. The owner has had to contend with erosion from stormwater runoff. This had lead to grading of, to repair said erosion, especially along Lucky 4 Road to the west of the site. This is a private road that is not maintained by the County.

5. FLOOD PLAIN STATEMENT:

This subdivision is not within the limits of a flood plain or flood hazard area, according to FEMA map panel number 08041C0952 G, dated December 7, 2018, a copy of which is enclosed for reference. Note that the site is in Zone X on said Firmette

review 3: zone D per the FIRM map.
Please revise
Review 4: Unresolved

6. METHOD AND CRITERIA:

The method used for all computations is that specified in the City-County Drainage Criteria Manual, using the rational method for areas of the size of the development. All computations are enclosed for reference and review.

The soils in the subdivision have been mapped by the local USDA/SCS office, and a soils map and is enclosed for reference, indication that all soils in this area are of hydrologic group "A". The soils in this area are largely usable as gravel surfacing and are Infiltration is a maximum and runoff is held to a minimum

Review 3 comment: Please elaborate on your historic conditions description. How many sub-basins are there? are they the same as the proposed? etc. Also provide a historic conditions drainage map.

7. DESCRIPTION OF RUNOFF:

A. Historic Drainage:

Computations are enclosed to show the historic drainage existing facilities (pre-1947). The drainage pattern has to development over the years.

Review 4: Unresolved. Please address comment above.

B. Drainage Inflows:

As shown on the enclosed drainage plan one small area (Basin O-1) will drain into the property near the northwest corner, creating 0.15 cfs / 1.1 cfs (5-year / 100-year runoffs) from a small vacant grassed site. This runoff is in the undeveloped historic state.

C. On Site Runoff:

On site runoff has existed in the current state for many years. Improvements include the motel area and improvements, including paving, to the road system. Other improvements include regrading the area for use as campground. **Runoff reduction** is employed along this drainage path and a sand filter basin is provided at the subdivision boundary. **Runoff reduction** work sheet is enclosed analyzing the proposed efforts to minimize these effects. Two proposed sand filter basins are proposed at the outfall points of the development for this purpose. The proposed grading is represented on the enclosed drainage plan and the grading plan that accompanies the total submittal. The work is minimal and necessary erosion BMP's are proposed.

The above mentioned inflow will combine with runoff from Basin A for a total of 4.0 cfs / 10.6 cfs at a point along the entrance. **Runoff reduction** is employed along this drainage path and a sand filter basin is provided at the subdivision boundary. **Runoff reduction** work sheet is enclosed analyzing the proposed efforts to minimize these effects. Two proposed sand filter basins are proposed at the outfall points of the development for this purpose. The proposed grading is represented on the enclosed drainage plan and the grading plan that accompanies the total submittal. The work is minimal and necessary erosion BMP's are proposed.

Runoff reduction is employed along this drainage path and a sand filter basin is provided at the subdivision boundary. **Runoff reduction** work sheet is enclosed analyzing the proposed efforts to minimize these effects. Two proposed sand filter basins are proposed at the outfall points of the development for this purpose. The proposed grading is represented on the enclosed drainage plan and the grading plan that accompanies the total submittal. The work is minimal and necessary erosion BMP's are proposed.

Basin C is the Southwesterly third of the site, containing graveled campground sites, tent sites, and a gravel road. The 0.38 acre RV storage site has been abandoned and reclaimed. The total runoff at the historic outfall point into Highway 24 is 3.2 cfs / 9.1 cfs, compared with the historic value of 0.748 cfs / 5.7 cfs. A few culverts exist within the site and below the outfall point, all of which have the computed capacity to safely accommodate this total runoff. Highway 24 culverts have proved historically adequate and will remain so as far as this development is concerned. A sand filter basin is provided at the subdivision boundary.

8. WATER QUALITY REQUIREMENTS:

The total historic and proposed development work on the site is largely mitigated by the existing Type A soils of the area. **Runoff reduction** work sheet is enclosed analyzing the proposed efforts to minimize these effects. Two proposed sand filter basins are proposed at the outfall points of the development for this purpose. The proposed grading is represented on the enclosed drainage plan and the grading plan that accompanies the total submittal. The work is minimal and necessary erosion BMP's are proposed.

Is RR even necessary now that 2 SFBs are providing WQ treatment?

Please clarify that these SFBs are only for WQ treatment and not detention, if that is the case. Otherwise had a discussion and calcs related to detention.

Review 1 comment: Please indicate what the downstream facilities are and provide analysis.
Review 2: Unresolved. Please address the above comment and identify the suitable outfall (ECM 3.2.4) location. Please be specific.
Review 3: Unresolved. Please address the above. Provide analysis/calcs. Detention may be needed.
Review 4: Unresolved.

Unresolved comment from Review #3:
So if there is a suitable outfall such that detention is not required, describe that the SFBs are only designed for WQCV. But if Detention is required (once PCD comments above have been addressed), you will need to increase the size of the Sand Filter and provide both the UD-Detention worksheet and SDI Form.

Unresolved comment from Reviews #2 and 3:
This statement is still unclear. Suggested revision: "except in areas where structures or paving/gravel will be added."

Is this difference with or without the SFBs?
Please describe how they effect the outfall flows.

Review 3: Please also identify the retaining wall/block walls constructed on the west side and campground area and some of the reasoning behind it (to revert the Lucky Rd runoff back to historic conditions as stated previously?)
Review 4: Unresolved

I do not see any calculations analyzing the capacity of downstream drainage facilities. Please provide.

9. COST ESTIMATE:

All facilities are private.

Item No.	Description	Quantity	Unit Cost	Cost
1	West Sand Filter Basin	1 ea	LS	\$ 1600.00
2	East Sand Filter Basin	1 ea	LS	2500.00
3	24" CMP Storm Sewer	80 LF	30.00	2400.00
Subtotal Construction Cost				\$ 6500.00
Engineering		10%		650.00
Total Estimated Cost				\$ 7150.00

10. SUMMARY

The motel and campground have existed at this address since 1947 and 1950 respectively. The proposed facilities will mitigate the effects of historic development as well as proposed improvements. There will be no adverse effects on downstream or surrounding properties.

The drainage analysis has been prepared in accordance with the current El Paso County Drainage Criteria Manual. Supporting information and calculations are included in this report.

MAJOR BASIN	SUB BASIN	AREA		BASIN		Tc MIN	I		SOIL GRP	DEV. TYPE	C		FLOW		RETURN PERIOD		
		PLANIM READ	ACRES	LENGTH	HEIGHT								qp	qp			
FOUNTAIN CR	O-1	COGO	0.66	100	4	20			A	MDW	0.08	0.35			5	100	
				+200	6	+1											
						21	2.9	4.8					0.15	1.1	5	100	
	+A	COGO	3.12	+420	34	+1.2			A	MDW	0.08	0.35	15%				
				V=5.7						GRAVEL	0.50	0.70	85%				
										MIX	0.437	0.648					
	TOTAL	COGO	3.78			22.2	2.8	4.7	A	MIX	0.375	0.596	4.0	10.6	5	100	
	+B	COGO	3.13	+360	34	+1.0			A	ROOF	0.73	0.81	2%				
				V=6.1						GRAVEL	0.50	0.70	20%				
										MDW	0.08	0.35	70%				
										MIX	0.215	0.478					
	TOTAL	COGO	6.91			23.2	2.7	4.6	A	MIX	0.302	0.542	5.6	17.2	5	100	
	C	COGO	2.97	100	2	14.7			A	GRAVEL	0.50	0.70	60%				
			V=5.4	+640	46	+2.0				MDW	0.08	0.35	40%				
						16.7	3.3	5.5	A	MIX	0.332	0.560	3.2	9.1	5	100	
HYDROLOGICAL COMPUTATION – BASIC DATA								OLIVER E. WATTS, CONSULTING ENGINEER, INC. 614 ELKTON DRIVE COLORADO SPRINGS, CO 80907								PAGE 1 OF 3	
PROJ: ROCKY TOP MOTEL & CAMPGROUND BY: O.E. WATTS																	
RATIONAL METHOD DATE: 6-14-19, 8-16-21																	

MAJOR BASIN	SUB BASIN	AREA		BASIN		T _c MIN	I in./hr.		SOIL GRP	DEV. TYPE	C		FLOW		RETURN PERIOD -years-	
		PLANIM READ	ACRES	LENGTH -FT.-	HEIGHT -FT.-								5-ry	100-yr		
													qp -CFS-	qp -CFS-		
HISTORIC	O-1	COGO	0.66	100	4	20			A	MDW	0.08	0.35			5	100
				+200	6	+1										
						21	2.9	4.8					0.15	1.1	5	100
	+A	COGO	3.13	+420	34	+1.2										
	TOTAL		3.748			22.2	2.8	4.7	A	MDW	0.08	0.35	0.85	6.2	5	100
	+B	COGO	3.13	+360	34	+1.0										
	TOTAL		6.91			23.2	2.7	4.6	A	MDW	0.08	0.35	1.49	11.1	5	100
	C	COGO	2.97	100	2	14.7										
				+640	46	+2.0										
						16.7	3.3	5.5	A	MDW	0.08	0.35	0.78	5.7	5	100
HYDROLOGICAL COMPUTATION – BASIC DATA PROJ: ROCKY TOP MOTEL & CAMPGROUND BY: O.E. WATTS RATIONAL METHOD DATE: April 14, 2022							OLIVER E. WATTS, CONSULTING ENGINEER, INC. 614 ELKTON DRIVE COLORADO SPRINGS, CO 80907								PAGE 2 OF 3	

STREET AND STORM SEWER CALCULATIONS

STREET	LOCATION	DISTANCE	ELEVATION & SLOPE	TOTAL RUNOFF	STREET FLOW / CAPACITY	PIPE FLOW	TYPE PIPE, CATCH BASIN & SLOPE %
PRIVATE	B OUTFALL			5.6/172		17.2	24" CMP hi=0.62' S=0.60% MIN
	C OUTFALL			3.7/9.1		9.1	24" CMP hi=0.24' S=0.20% MIN.
STREET AND STORM SEWER CALCULATIONS PROJECT: ROCKY TOP MOTEL & CAMPGROUND BY: O.E. WATTS				OLIVER E. WATTS, CONSULTING ENGINEER, INC. 614 ELKTON DRIVE COLORADO SPRINGS, CO 80907			Page:3 Of Pages:3
DATE: 6-14-19, 8-16-21							

All RPA areas will need to be within a no build/drainage easement and discussed in the maintenance agreement and O&M manual. Also make sure to show RPA limits on GEC Plans (not just FDR) so our SW inspectors and the QSM know that these areas are to remain pervious and vegetated post-construction.

Sheet 1 of 1

Total Area (ft ²)	15,118
Total Impervious Area (ft ²)	7,096
WQCV (ft ³)	296
WQCV Reduction (ft ³)	296
WQCV Reduction (%)	100%
Untreated WQCV (ft ³)	0

Also complete the MHFD UD-Detention worksheet to show change from existing to proposed flows and to calculate the orifice hole dimensions in the outlet. Currently shown on plans as 7/8" but no calcs provided to support that.

Design Procedure Form: Sand Filter (SF)

UD-BMP (Version 3.07, March 2018)

Sheet 1 of 2

Designer: **O.E. WATTS**

Company: **Oliver E. Watts, CE**

Date: **April 14, 2022**

Project: **Rocky Top Motel and Campground**

Location: **Basin C PLD Pond**

Unresolved from Review #3: To be consistent with plans, revise text: "Basin C, West SFB"

1. Basin Storage Volume

- A) Effective Imperviousness of Tributary Area, I_a
(100% if all paved and roofed areas upstream of sand filter)
- B) Tributary Area's Imperviousness Ratio ($i = I_a/100$)
- C) Water Quality Capture Volume (WQCV) Based on 12-hour Drain Time
 $WQCV = 0.8 * (0.91 * i^3 - 1.19 * i^2 + 0.78 * i)$
- D) Contributing Watershed Area (including sand filter area)
- E) Water Quality Capture Volume (WQCV) Design Volume
 $V_{WQCV} = WQCV / 12 * \text{Area}$
- F) For Watersheds Outside of the Denver Region, Depth of Average Runoff Producing Storm
- G) For Watersheds Outside of the Denver Region, Water Quality Capture Volume (WQCV) Design Volume
- H) User Input of Water Quality Capture Volume (WQCV) Design Volume
(Only if a different WQCV Design Volume is desired)

$I_a =$ %

$i =$

WQCV = watershed inches

Area = sq ft

$V_{WQCV} =$

$d_b =$ in

$V_{WQCV \text{ OTHER}} =$ cu ft

$V_{WQCV \text{ USER}} =$

Review 3: please provide calculation as to how the impervious % was determined.
Review 4: Unresolved

discuss in drainage report text what storm this value is for and source of data.

2. Basin Geometry

- A) WQCV Depth
- B) Sand Filter Side Slopes (Horizontal distance per unit vertical, 4:1 or flatter preferred). Use "0" if sand filter has vertical walls.
- C) Minimum Filter Area (Flat Surface Area)
- D) Actual Filter Area
- E) Volume Provided

$D_{WQCV} =$ ft

$Z =$ ft / ft

$A_{Min} =$ sq ft

$A_{Actual} =$

$V_T =$

Unresolved comment from Review #3: Input these values based on the size of the sand filter shown on the plans.

3. Filter Material

Choose One

☐ 18" CDOT Class B or C Filter Material

☒ Other (Explain):

TYPE A SOIL

4. Underdrain System

- A) Are underdrains provided?
- B) Underdrain system orifice diameter for 12 hour drain time
 - i) Distance From Lowest Elevation of the Storage Volume to the Center of the Orifice
 - ii) Volume to Drain in 12 Hours
 - iii) Orifice Diameter, 3/8" Minimum

Choose One

☐ YES

☐ NO

$y =$

$Vol_{12} =$

$D_o =$

select "Yes"

Unresolved comment from Review #3: complete this section

Design Procedure Form: Sand Filter (SF)

Sheet 2 of 2

Designer: O.E. WATTS

Company: Oliver E. Watts, CE

Date: April 14, 2022

Project: Rocky Top Motel and Campground

Location: Basin C PLD Pond

5. Impermeable Geomembrane Liner and Geotextile Separator Fabric

A) Is an impermeable liner provided due to proximity of structures or groundwater contamination?

Choose One

☐ YES ☐ NO

Unresolved comment from
Review #3:
complete this section

6. Inlet / Outlet Works

A) Describe the type of energy dissipation at inlet points and means of conveying flows in excess of the WQCV through the outlet

Notes:

Also complete the MHFD UD-Detention worksheet to show change from existing to proposed flows and to calculate the orifice hole dimensions in the outlet. Currently shown on plans as 7/8" but no calcs provided to support that.

Design Procedure Form: Sand Filter (SF)

UD-BMP (Version 3.07, March 2018)

Sheet 1 of 2

Designer: **O.E. WATTS**

Company: **Oliver E. Watts, CE**

Date: **April 14, 2022**

Project: **Rocky Top Motel and Campground**

Location: **BASINS O-1 THRU B PLD POND**

To be consistent with plans: add text: "East SFB" and delete "PLD POND"

1. Basin Storage Volume

- A) Effective Imperviousness of Tributary Area, I_a
(100% if all paved and roofed areas upstream of sand filter)
- B) Tributary Area's Imperviousness Ratio ($i = I_a/100$)
- C) Water Quality Capture Volume (WQCV) Based on 12-hour Drain Time
 $WQCV = 0.8 * (0.91 * i^3 - 1.19 * i^2 + 0.78 * i)$
- D) Contributing Watershed Area (including sand filter area)
- E) Water Quality Capture Volume (WQCV) Design Volume
 $V_{WQCV} = WQCV / 12 * \text{Area}$
- F) For Watersheds Outside of the Denver Region, Depth of Average Runoff Producing Storm
- G) For Watersheds Outside of the Denver Region, Water Quality Capture Volume (WQCV) Design Volume
- H) User Input of Water Quality Capture Volume (WQCV) Design Volume
(Only if a different WQCV Design Volume is desired)

$I_a =$ %

$i =$

WQCV = watershed inches

Area = sq ft

$V_{WQCV} =$

$d_b =$ in

$V_{WQCV \text{ OTHER}} =$ cu ft

$V_{WQCV \text{ USER}} =$

Review 3: please provide calculation as to how the impervious % was determined.
Review 4: Unresolved

discuss in drainage report text what storm this value is for and source of data.

2. Basin Geometry

- A) WQCV Depth
- B) Sand Filter Side Slopes (Horizontal distance per unit vertical, 4:1 or flatter preferred). Use "0" if sand filter has vertical walls.
- C) Minimum Filter Area (Flat Surface Area)
- D) Actual Filter Area
- E) Volume Provided

$D_{WQCV} =$ ft

$Z =$ ft / ft

$A_{Min} =$ sq ft

$A_{Actual} =$

$V_T =$

Unresolved comment from Review #3: Input these values based on the size of the sand filter shown on the plans.

3. Filter Material

- Choose One
- ☐ 18" CDOT Class B or C Filter Material
 - ☒ Other (Explain):
TYPE A SOIL

4. Underdrain System

- A) Are underdrains provided?
- B) Underdrain system orifice diameter for 12 hour drain time
 - i) Distance From Lowest Elevation of the Storage Volume to the Center of the Orifice
 - ii) Volume to Drain in 12 Hours
 - iii) Orifice Diameter, 3/8" Minimum

Choose One

- ☐ YES
- ☐ NO

$y =$

$Vol_{12} =$

$D_o =$

select "Yes"

Unresolved comment from Review #3: complete this section

Design Procedure Form: Sand Filter (SF)

Sheet 2 of 2

Designer: O.E. WATTS

Company: Oliver E. Watts, CE

Date: April 14, 2022

Project: Rocky Top Motel and Campground

Location: BASINS O-1 THRU B PLD POND

5. Impermeable Geomembrane Liner and Geotextile Separator Fabric

A) Is an impermeable liner provided due to proximity of structures or groundwater contamination?

Choose One

☐ YES ☐ NO

Unresolved comment from
Review #3:
complete this section

6. Inlet / Outlet Works

A) Describe the type of energy dissipation at inlet points and means of conveying flows in excess of the WQCV through the outlet

Notes:

National Flood Hazard Layer FIRMette



38°56'20.49"N



Legend

SEE FIS REPORT FOR DETAILED LEGEND AND INDEX MAP FOR FIRM PANEL LAYOUT

SPECIAL FLOOD HAZARD AREAS		Without Base Flood Elevation (BFE) Zone A, V, AS9
		With BFE or Depth Zone AE, AO, AH, VE, AR
		Regulatory Floodway
OTHER AREAS OF FLOOD HAZARD		0.2% Annual Chance Flood Hazard, Area of 1% annual chance flood with average depth less than one foot or with drainage areas of less than one square mile Zone J
		Future Conditions 1% Annual Chance Flood Hazard Zone X
		Area with Reduced Flood Risk due to Levee. See Notes. Zone X
		Area with Flood Risk due to Levee Zone D
OTHER AREAS		NO SCREEN Area of Minimal Flood Hazard Zone X
		Effective LOMRs
		Area of Undetermined Flood Hazard Zone
GENERAL STRUCTURES		Channel, Culvert, or Storm Sewer
		Levee, Dike, or Floodwall
OTHER FEATURES		20.2 Cross Sections with 1% Annual Chance Water Surface Elevation
		17.5
		Coastal Transect
		Base Flood Elevation Line (BFE)
		Limit of Study
		Jurisdiction Boundary
		Coastal Transect Baseline
MAP PANELS		Digital Data Available
		No Digital Data Available
		Unmapped



The pin displayed on the map is an approximate point selected by the user and does not represent an authoritative property location.

This map complies with FEMA's standards for the use of digital flood maps if it is not void as described below. The basemap shown complies with FEMA's basemap accuracy standards

The flood hazard information is derived directly from the authoritative NFHL web services provided by FEMA. This map was exported on 6/14/2019 at 10:34:12 AM and does not reflect changes or amendments subsequent to this date and time. The NFHL and effective information may change or become superseded by new data over time.


This map image is void if the one or more of the following map elements do not appear: basemap imagery, flood zone labels, legend, scale bar, map creation date, community identifiers, FIRM panel number, and FIRM effective date. Map images for unmapped and unmodernized areas cannot be used for regulatory purposes.

USGS The National Map: Orthoimagery. Data refreshed April, 2019.

105°05'81"W

38°55'52.50"N

0 250 500 1 000 1 500 2 000 Feet 1:6,000

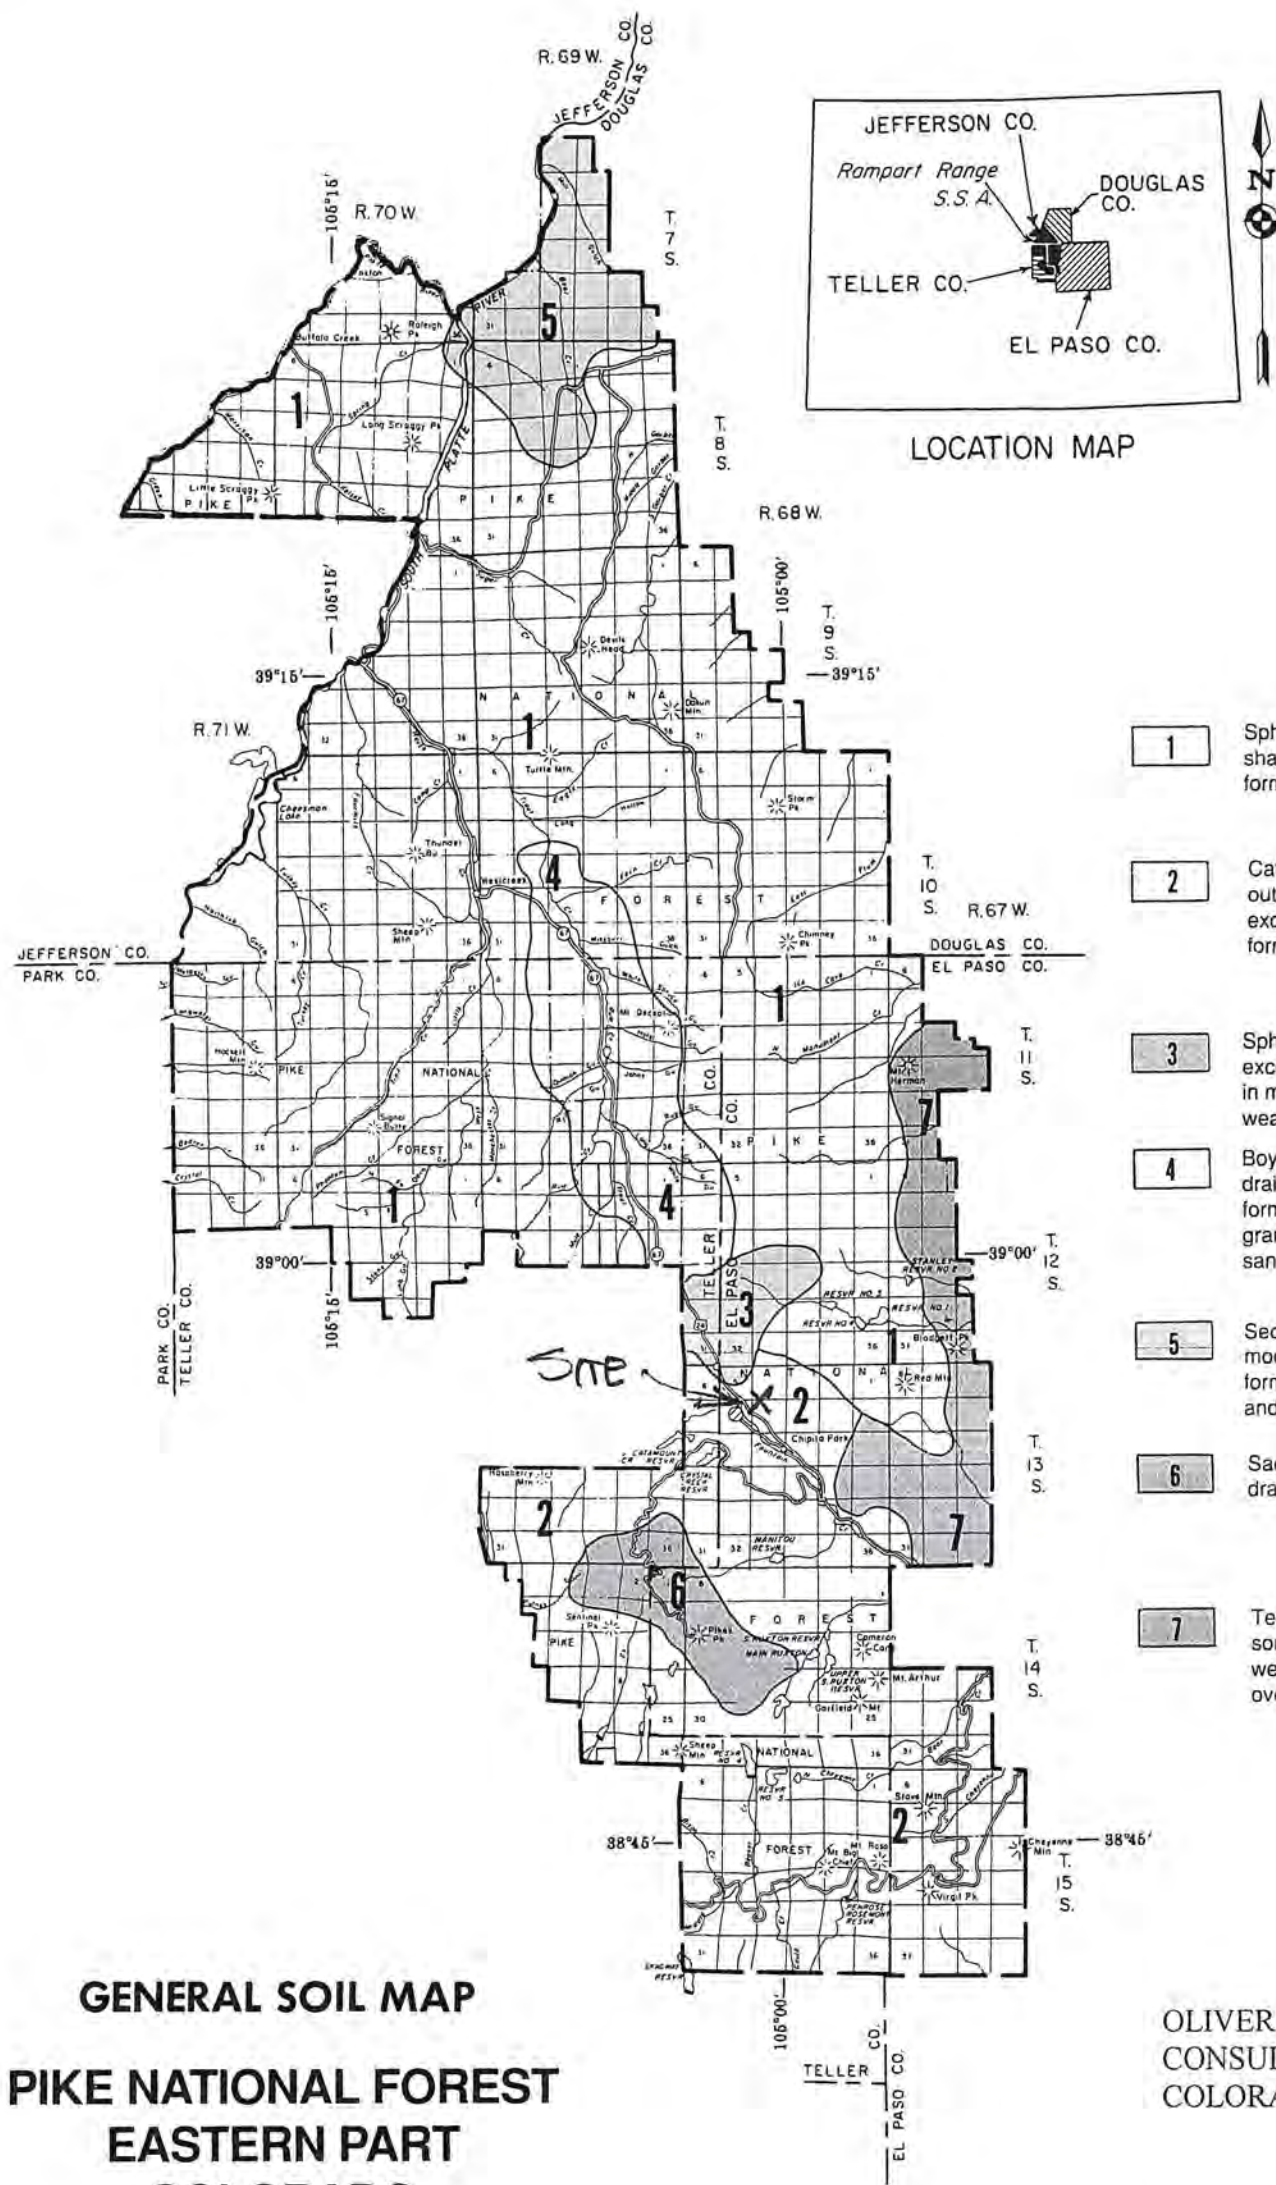

U.S. DEPARTMENT OF AGRICULTURE
 FOREST SERVICE
 SOIL CONSERVATION SERVICE
 COLORADO AGRICULTURAL EXPERIMENT STATION

$$t_c = t_i + t_t \quad (\text{Eq. 6-7})$$

Where:

t_c = time of concentration (min)

t_i = overland (initial) flow time (min)

t_t = travel time in the ditch, channel, gutter, storm sewer, etc. (min)

3.2.1 Overland (Initial) Flow Time

The overland flow time, t_i , may be calculated using Equation 6-8.

$$t_i = \frac{0.395(1.1 - C_s)\sqrt{L}}{S^{0.33}} \quad (\text{Eq. 6-8})$$

Where:

t_i = overland (initial) flow time (min)

C_s = runoff coefficient for 5-year frequency (see Table 6-6)

L = length of overland flow (300 ft maximum for non-urban land uses, 100 ft maximum for urban land uses)

S = average basin slope (ft/ft)

Note that in some urban watersheds, the overland flow time may be very small because flows quickly concentrate and channelize.

3.2.2 Travel Time

For catchments with overland and channelized flow, the time of concentration needs to be considered in combination with the travel time, t_t , which is calculated using the hydraulic properties of the swale, ditch, or channel. For preliminary work, the overland travel time, t_t , can be estimated with the help of Figure 6-25 or Equation 6-9 (Guo 1999).

$$V = C_v S_w^{0.5} \quad (\text{Eq. 6-9})$$

Where:

V = velocity (ft/s)

C_v = conveyance coefficient (from Table 6-7)

S_w = watercourse slope (ft/ft)

Table 6-6. Runoff Coefficients for Rational Method
(Source: UDFCD 2001)

Land Use or Surface Characteristics	Percent Impervious	Runoff Coefficients											
		2-year		5-year		10-year		25-year		50-year		100-year	
		HSG A&B	HSG C&D	HSG A&B	HSG C&D	HSG A&B	HSG C&D	HSG A&B	HSG C&D	HSG A&B	HSG C&D	HSG A&B	HSG C&D
Business													
Commercial Areas	95	0.79	0.80	0.81	0.82	0.83	0.84	0.85	0.87	0.87	0.88	0.88	0.89
Neighborhood Areas	70	0.45	0.49	0.49	0.53	0.53	0.57	0.58	0.62	0.60	0.65	0.62	0.68
Residential													
1/8 Acre or less	65	0.41	0.45	0.45	0.49	0.49	0.54	0.54	0.59	0.57	0.62	0.59	0.65
1/4 Acre	40	0.23	0.28	0.30	0.35	0.36	0.42	0.42	0.50	0.46	0.54	0.50	0.58
1/3 Acre	30	0.18	0.22	0.25	0.30	0.32	0.38	0.39	0.47	0.43	0.52	0.47	0.57
1/2 Acre	25	0.15	0.20	0.22	0.28	0.30	0.36	0.37	0.46	0.41	0.51	0.46	0.56
1 Acre	20	0.12	0.17	0.20	0.26	0.27	0.34	0.35	0.44	0.40	0.50	0.44	0.55
Industrial													
Light Areas	80	0.57	0.60	0.59	0.63	0.63	0.66	0.66	0.70	0.68	0.72	0.70	0.74
Heavy Areas	90	0.71	0.73	0.73	0.75	0.75	0.77	0.78	0.80	0.80	0.82	0.81	0.83
Parks and Cemeteries													
Parks and Cemeteries	7	0.05	0.09	0.12	0.19	0.20	0.29	0.30	0.40	0.34	0.46	0.39	0.52
Playgrounds	13	0.07	0.13	0.16	0.23	0.24	0.31	0.32	0.42	0.37	0.48	0.41	0.54
Railroad Yard Areas	40	0.23	0.28	0.30	0.35	0.36	0.42	0.42	0.50	0.46	0.54	0.50	0.58
Undeveloped Areas													
Historic Flow Analysis-- Greenbelts, Agriculture	2	0.03	0.05	0.09	0.16	0.17	0.26	0.26	0.38	0.31	0.45	0.36	0.51
Pasture/Meadow	0	0.02	0.04	0.08	0.15	0.15	0.25	0.25	0.37	0.30	0.44	0.35	0.50
Forest	0	0.02	0.04	0.08	0.15	0.15	0.25	0.25	0.37	0.30	0.44	0.35	0.50
Exposed Rock	100	0.89	0.89	0.90	0.90	0.92	0.92	0.94	0.94	0.95	0.95	0.96	0.96
Offsite Flow Analysis (when landuse is undefined)	45	0.26	0.31	0.32	0.37	0.38	0.44	0.44	0.51	0.48	0.55	0.51	0.59
Streets													
Paved	100	0.89	0.89	0.90	0.90	0.92	0.92	0.94	0.94	0.95	0.95	0.96	0.96
Gravel	80	0.57	0.60	0.59	0.63	0.63	0.66	0.66	0.70	0.68	0.72	0.70	0.74
Drive and Walks													
Drive and Walks	100	0.89	0.89	0.90	0.90	0.92	0.92	0.94	0.94	0.95	0.95	0.96	0.96
Roofs	90	0.71	0.73	0.73	0.75	0.75	0.77	0.78	0.80	0.80	0.82	0.81	0.83
Lawns	0	0.02	0.04	0.08	0.15	0.15	0.25	0.25	0.37	0.30	0.44	0.35	0.50

3.2 Time of Concentration

One of the basic assumptions underlying the Rational Method is that runoff is a function of the average rainfall rate during the time required for water to flow from the hydraulically most remote part of the drainage area under consideration to the design point. However, in practice, the time of concentration can be an empirical value that results in reasonable and acceptable peak flow calculations.

For urban areas, the time of concentration (t_c) consists of an initial time or overland flow time (t_i) plus the travel time (t_t) in the storm sewer, paved gutter, roadside drainage ditch, or drainage channel. For non-urban areas, the time of concentration consists of an overland flow time (t_i) plus the time of travel in a concentrated form, such as a swale or drainageway. The travel portion (t_t) of the time of concentration can be estimated from the hydraulic properties of the storm sewer, gutter, swale, ditch, or drainageway. Initial time, on the other hand, will vary with surface slope, depression storage, surface cover, antecedent rainfall, and infiltration capacity of the soil, as well as distance of surface flow. The time of concentration is represented by Equation 6-7 for both urban and non-urban areas.

Table 6-7. Conveyance Coefficient, C_v

Type of Land Surface	C_v
Heavy meadow	2.5
Tillage/field	5
Riprap (not buried)*	6.5
Short pasture and lawns	7
Nearly bare ground	10
Grassed waterway	15
Paved areas and shallow paved swales	20

*For buried riprap, select C_v value based on type of vegetative cover.

The travel time is calculated by dividing the flow distance (in feet) by the velocity calculated using Equation 6-9 and converting units to minutes.

The time of concentration (t_c) is then the sum of the overland flow time (t_i) and the travel time (t_t) per Equation 6-7.

3.2.3 First Design Point Time of Concentration in Urban Catchments

Using this procedure, the time of concentration at the first design point (typically the first inlet in the system) in an urbanized catchment should not exceed the time of concentration calculated using Equation 6-10. The first design point is defined as the point where runoff first enters the storm sewer system.

$$t_c = \frac{L}{180} + 10 \quad (\text{Eq. 6-10})$$

Where:

t_c = maximum time of concentration at the first design point in an urban watershed (min)

L = waterway length (ft)

Equation 6-10 was developed using the rainfall-runoff data collected in the Denver region and, in essence, represents regional “calibration” of the Rational Method. Normally, Equation 6-10 will result in a lesser time of concentration at the first design point and will govern in an urbanized watershed. For subsequent design points, the time of concentration is calculated by accumulating the travel times in downstream drainageway reaches.


3.2.4 Minimum Time of Concentration

If the calculations result in a t_c of less than 10 minutes for undeveloped conditions, it is recommended that a minimum value of 10 minutes be used. The minimum t_c for urbanized areas is 5 minutes.

3.2.5 Post-Development Time of Concentration

As Equation 6-8 indicates, the time of concentration is a function of the 5-year runoff coefficient for a drainage basin. Typically, higher levels of imperviousness (higher 5-year runoff coefficients) correspond to shorter times of concentration, and lower levels of imperviousness correspond to longer times of

Figure 6-5. Colorado Springs Rainfall Intensity Duration Frequency

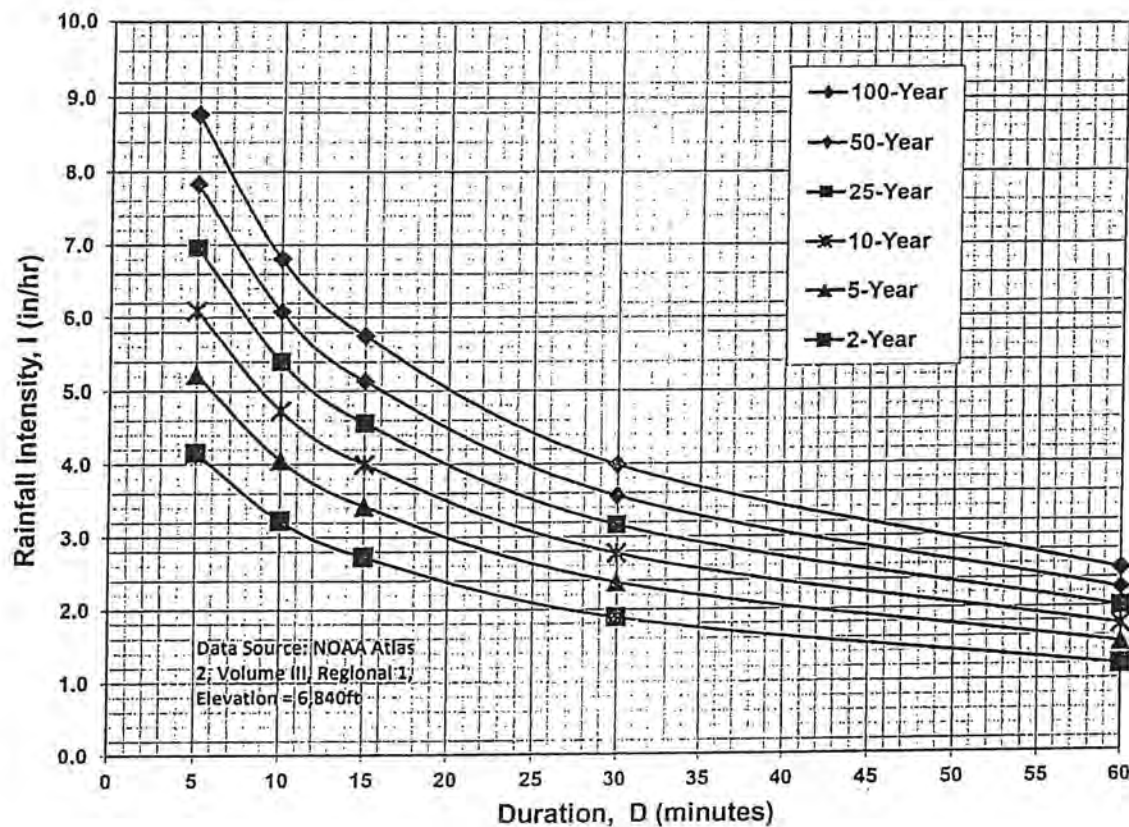

IDF Equations

$$I_{100} = -2.52 \ln(D) + 12.735$$

$$I_{50} = -2.25 \ln(D) + 11.375$$




$$I_{25} = -2.00 \ln(D) + 10.111$$

$$I_{10} = -1.75 \ln(D) + 8.847$$

$$I_5 = -1.50 \ln(D) + 7.583$$

$$I_2 = -1.19 \ln(D) + 6.035$$

Note: Values calculated by equations may not precisely duplicate values read from figure.

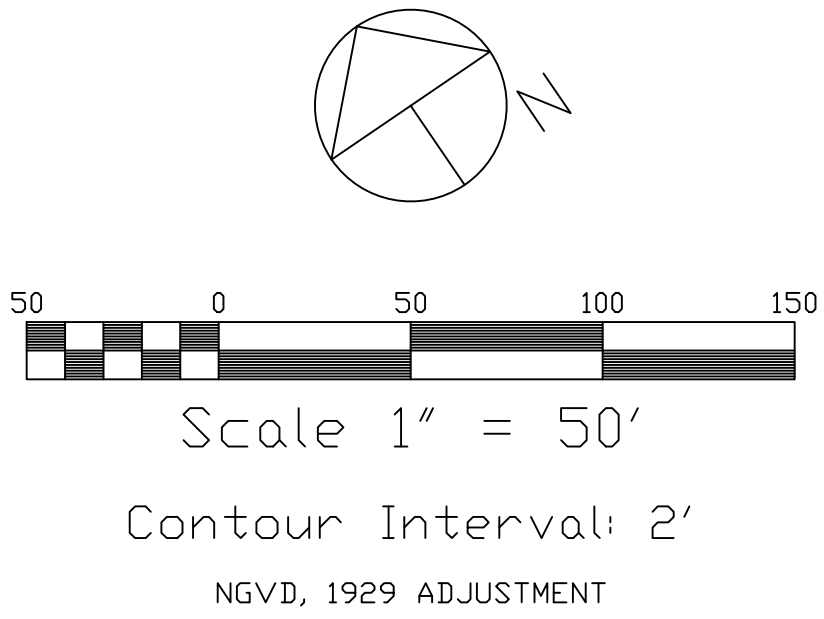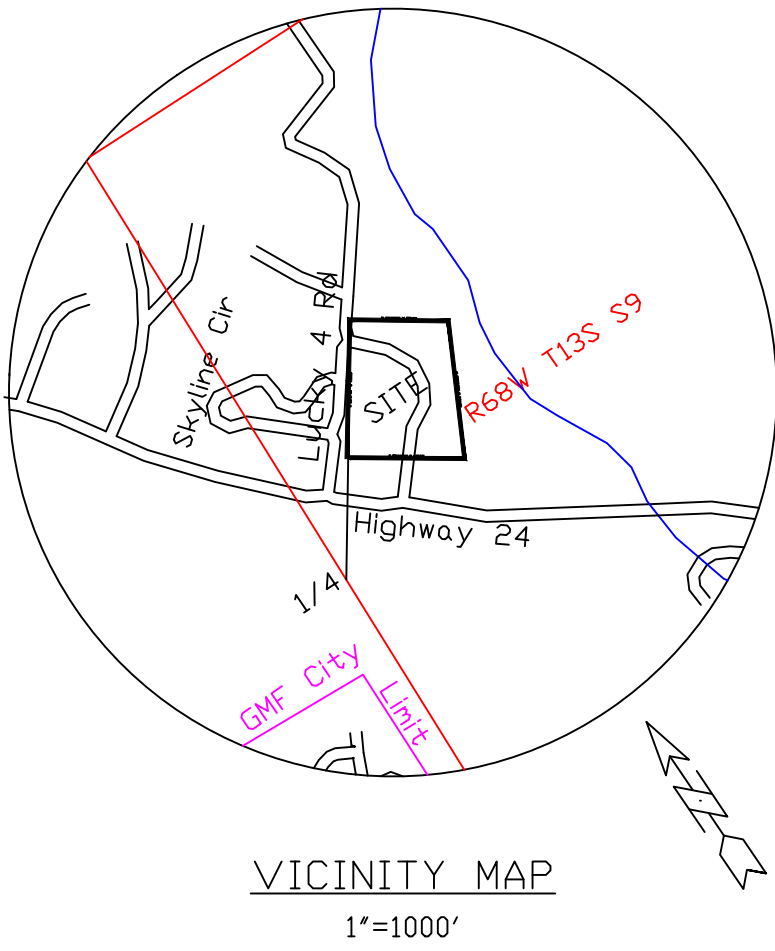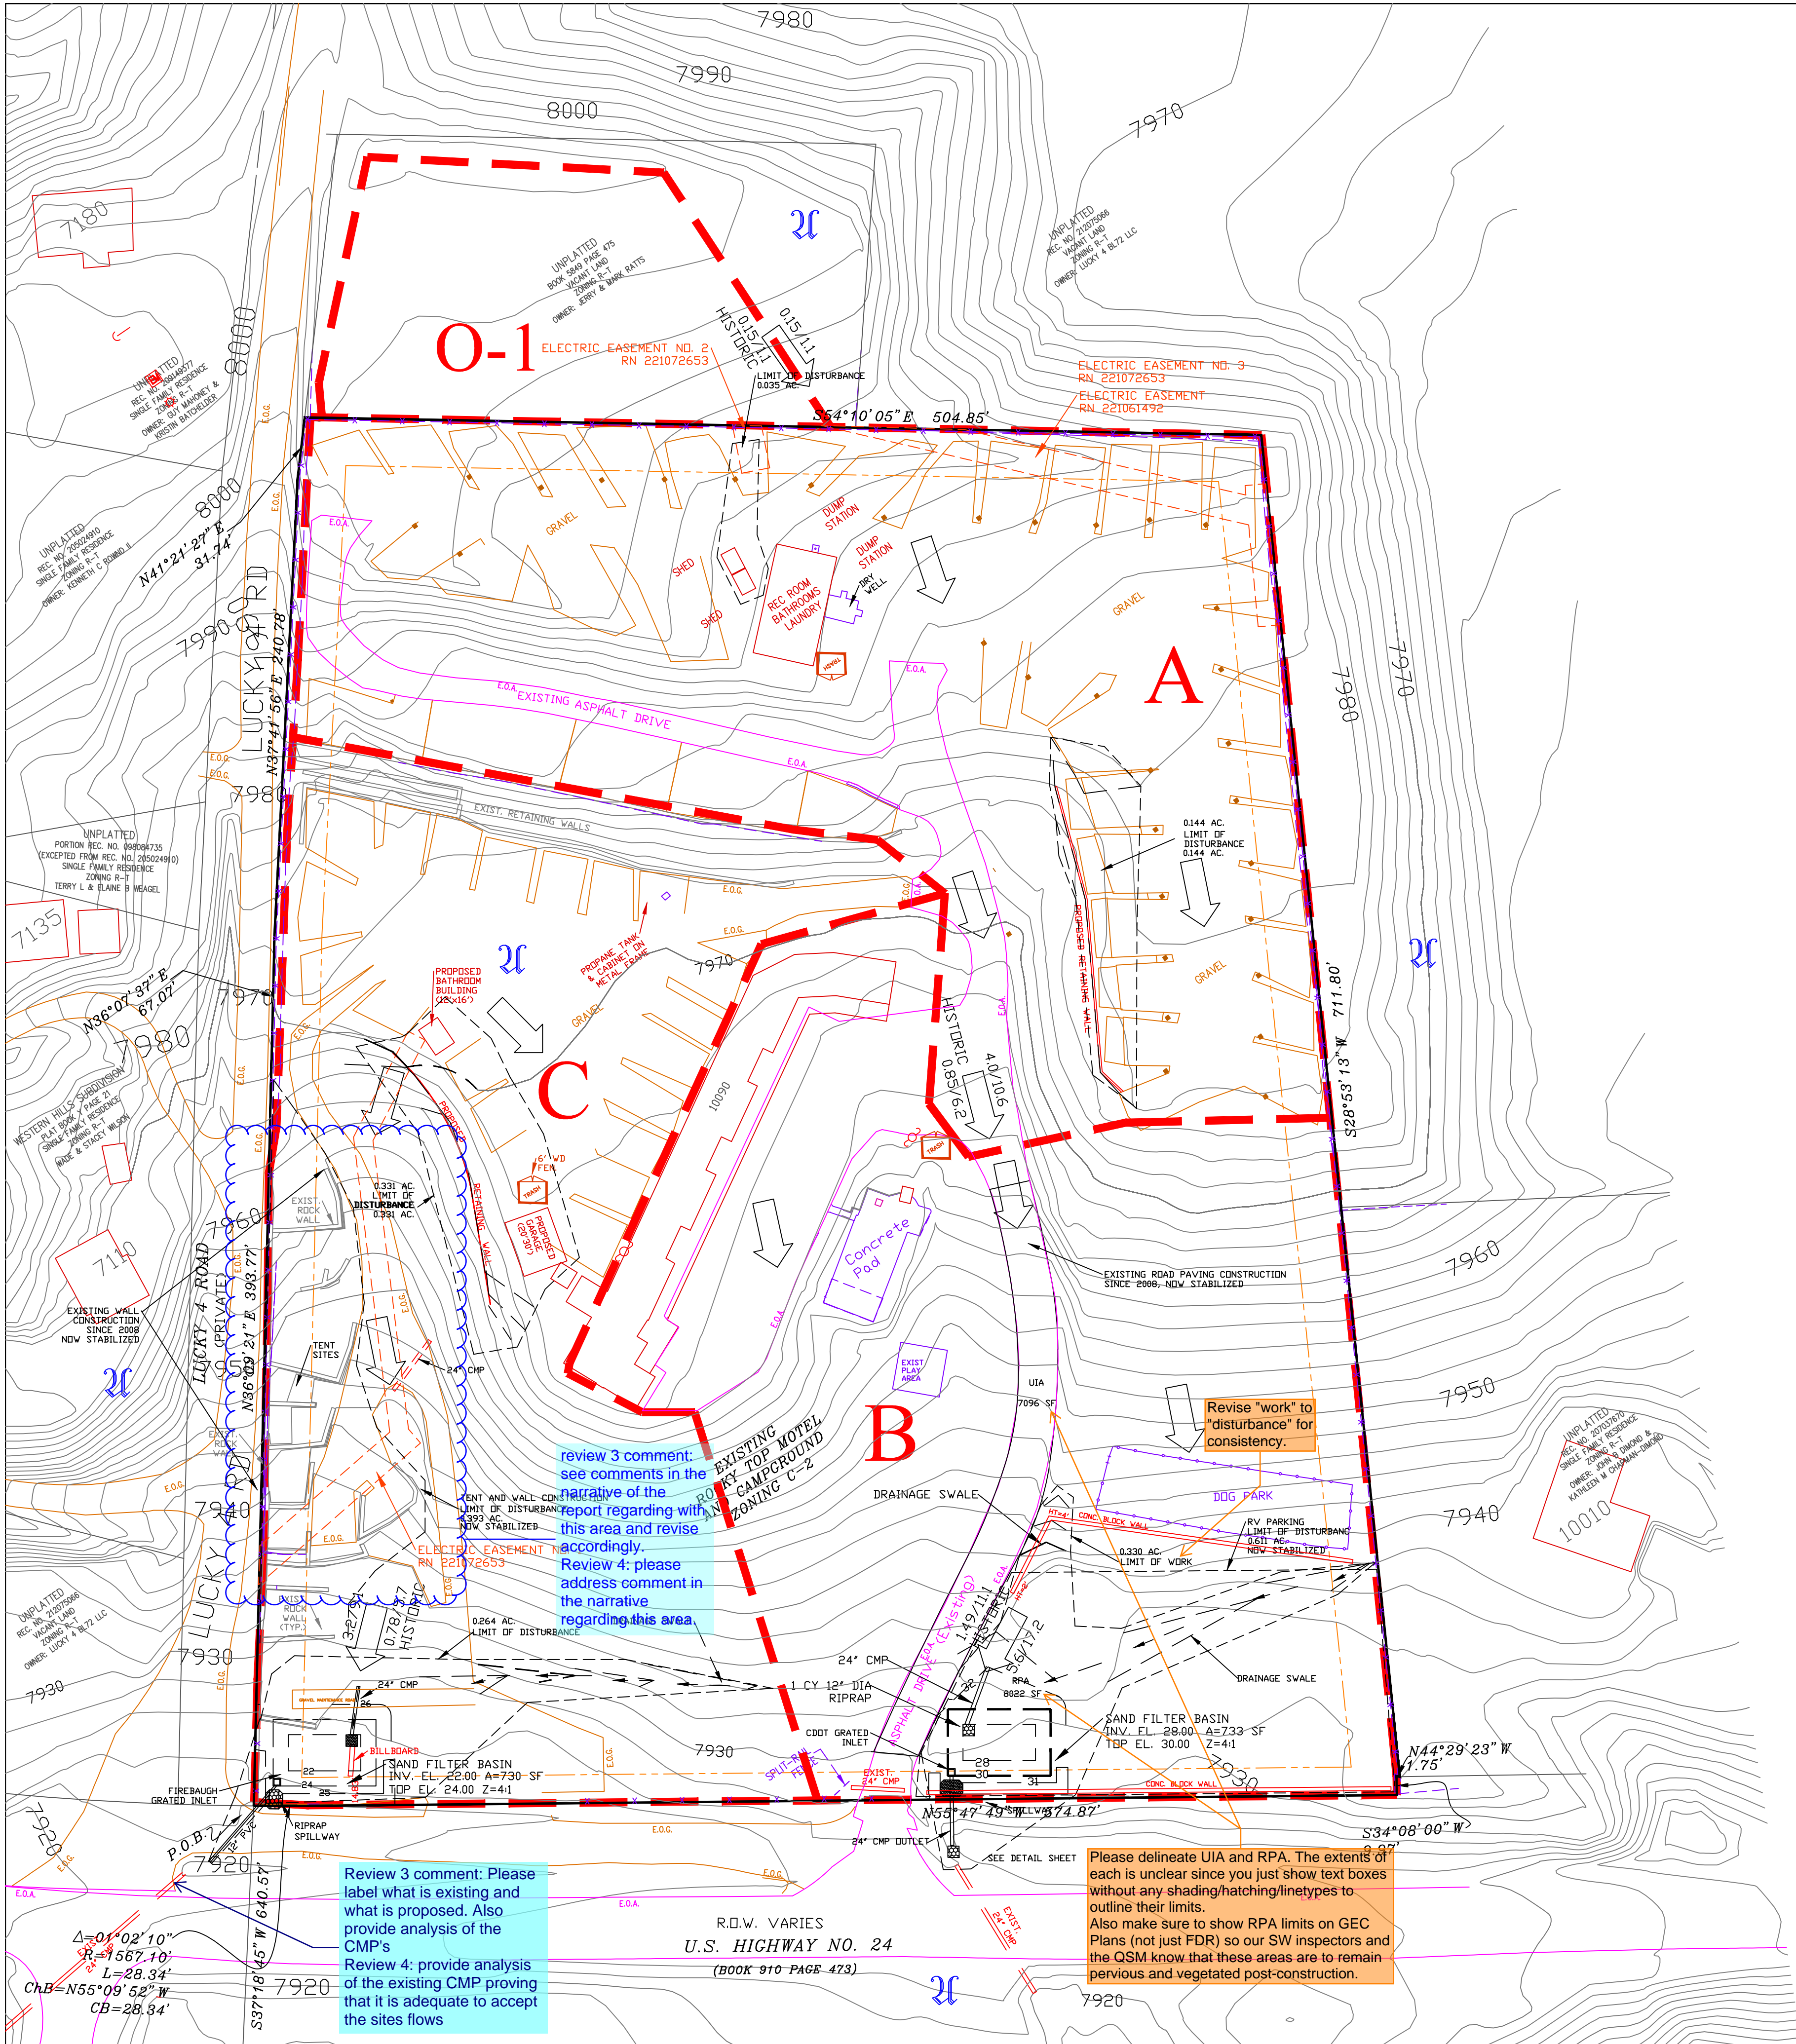

CONTOUR LEGEND:

—	ORIGINAL CONTOURS:
—	2'
—	10'
—	FINISH CONTOURS:
—	2'
—	1'
—	5'
---	LIMIT OF DISTURBANCE 1.597 ACRES

LEGEND:


10.5/20.4	RUNOFF IN CFS 5-YEAR/100-YEAR
A	LIMIT OF DRAINAGE BASIN AND DESIGNATION
---	EXISTING STORM SEWER AS LABELED
---	PROPOSED STORM SEWER AS LABELED
B	LIMIT OF SOILS TYPE AND GROUP

DRAINAGE BASIN SUMMARY

BASIN	DEVELOPED		HISTORIC	
	5-YEAR	100-YEAR	5-YEAR	100-YEAR
O-1	0.15	1.1	0.15	1.1
O-1 + A	4.0	10.6	0.85	6.2
O-1 + A + B	5.6	17.2	1.49	11.1
C	3.2	9.1	0.78	5.7

Other notes to address in report text and/or as callouts on this drainage map and in GEC Plans for runoff reduction:

- RPA vegetation should be turf grass (from seed or sod)
- Turf grass vegetation should have a uniform density of at least 80%.
- Show suitability of topsoil of RPA and steps for proper preparation of RPA soil per recommendations in MHFD detail T-0.
- Irrigation (temp or permanent) is necessary to establish sufficient vegetation and not just weeds.

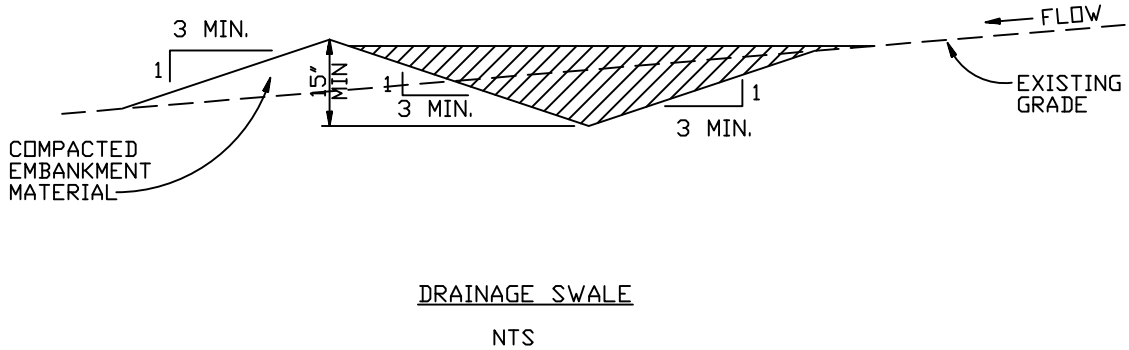

DRAWN BY: D.E. WATTS
DATE: 6-13-19
DWG. NO.: 19-5341-02
TOPOGRAPHY BY: CITY FMS 6-12-19
SURVEY INFORMATION BY: RAMPART JOB NO. 18384

APPROVED BY:
PROJ. NO.
DWG.

REVISIONS 8-16-21 UPDATED DEW
12-30-21 REVISED PER COUNTY REVIEW COMMENTS DEW
4-13-22 REVISED PER COUNTY REVIEW COMMENTS DEW
8-22-22 REVISED PER COUNTY REVIEW COMMENTS DEW

OLIVER E. WATTS
CONSULTING ENGINEER
COLORADO SPRINGS




PROJECT
ROCKY TOP MOTEL & CAMPGROUND
PART NW1/4 SECTION 9, T.13S., R.68W., 6TH P.M.
EL PASO COUNTY

SHT. NAME

DRAINAGE PLAN

SHT. NO.
1
OF
1



See comments on duplicate sheet submitted with GEC Plans

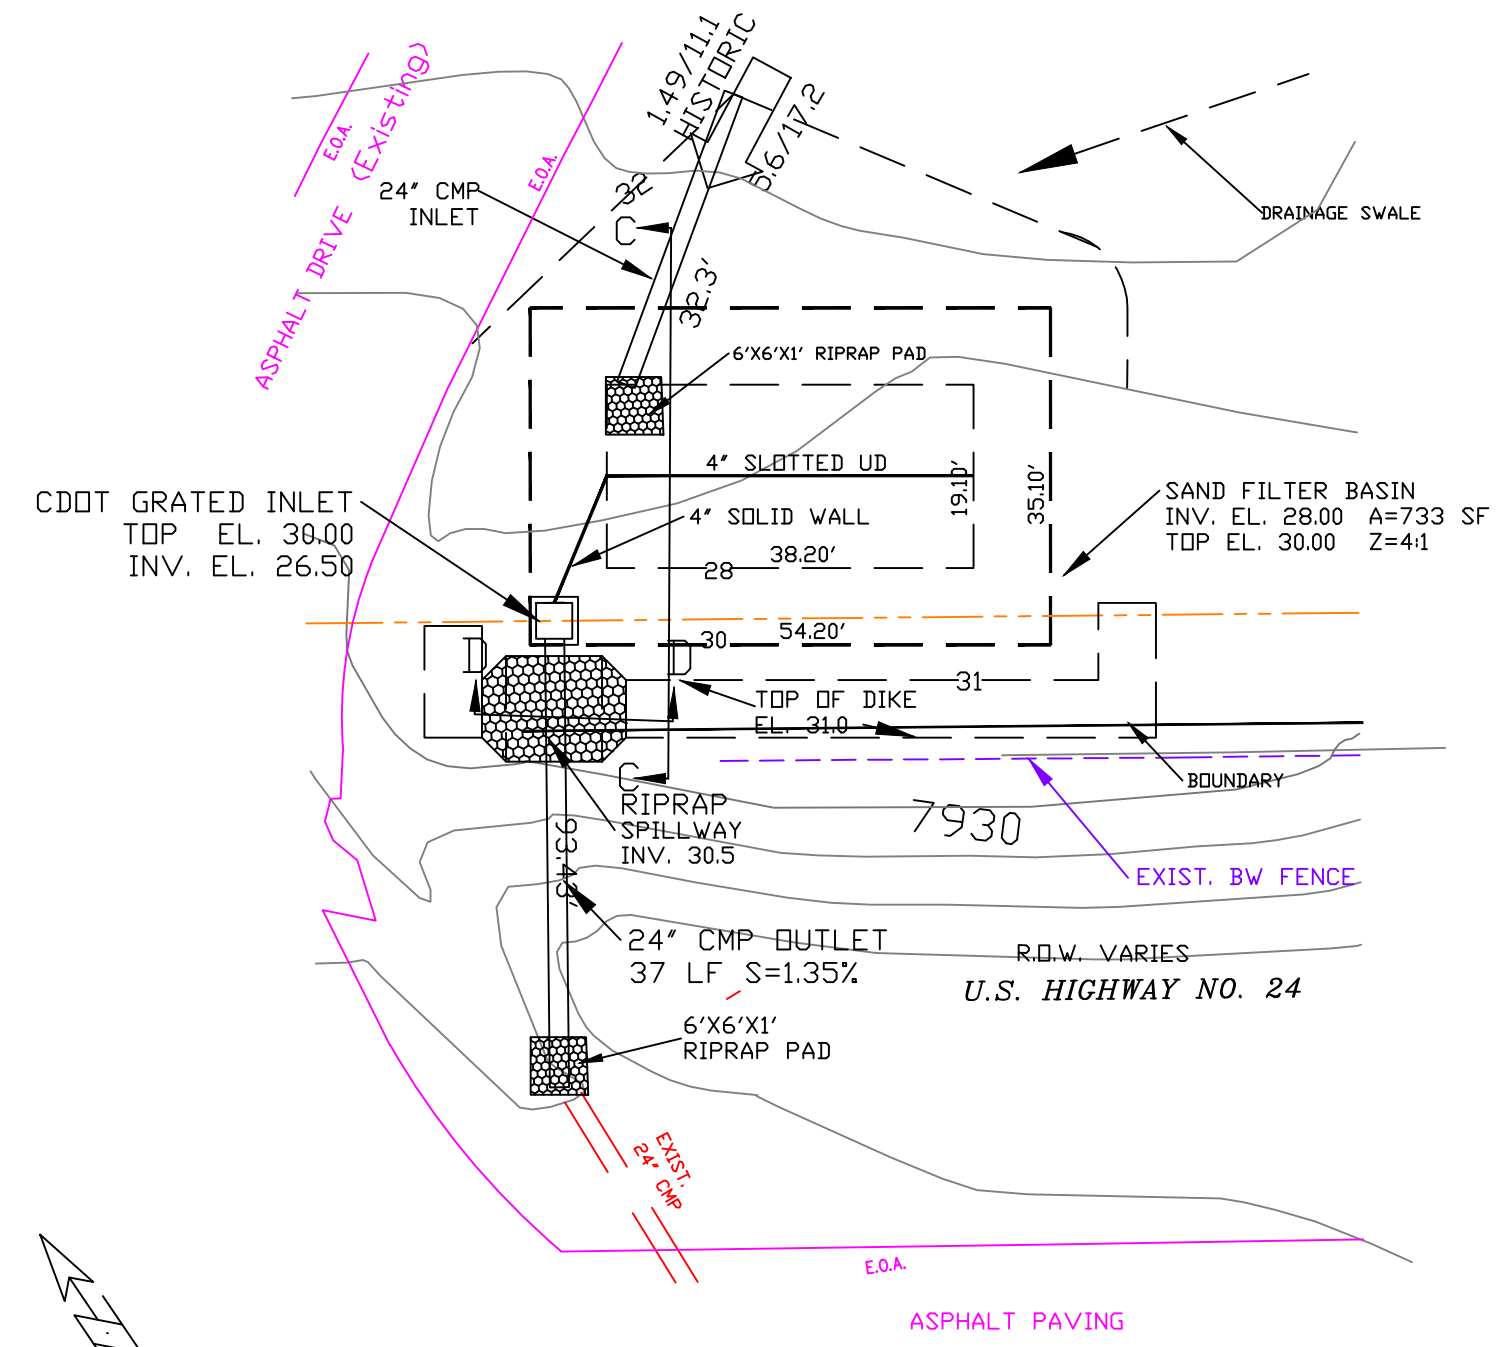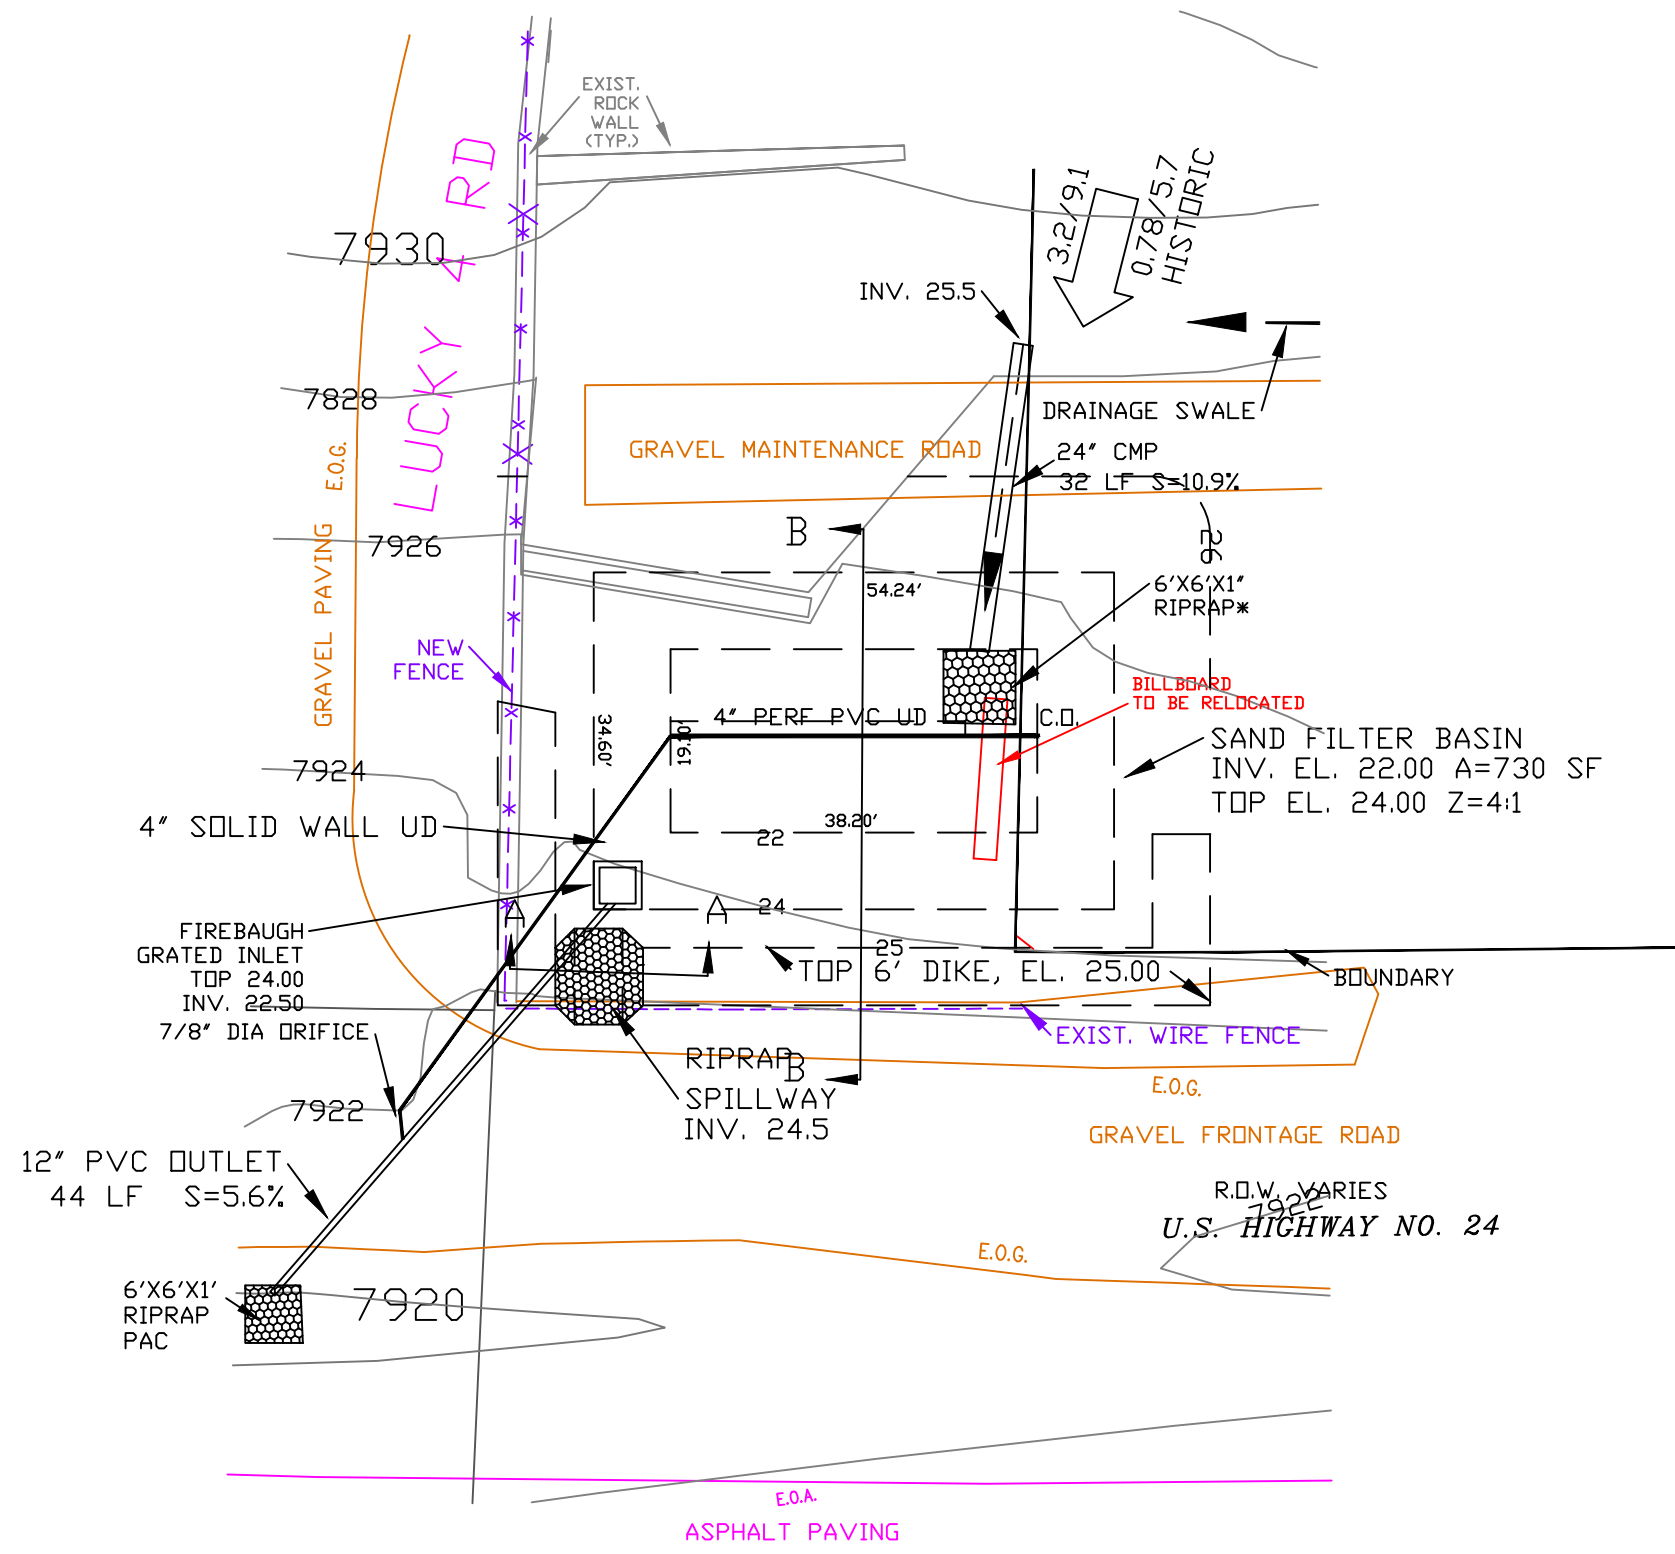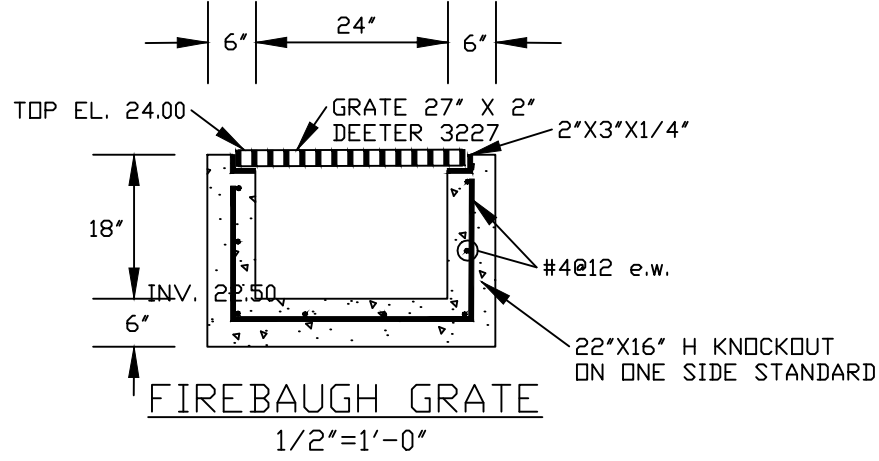


WEST SFB DETAILS

 $1'' = 20$


EAST SFB DETAILS

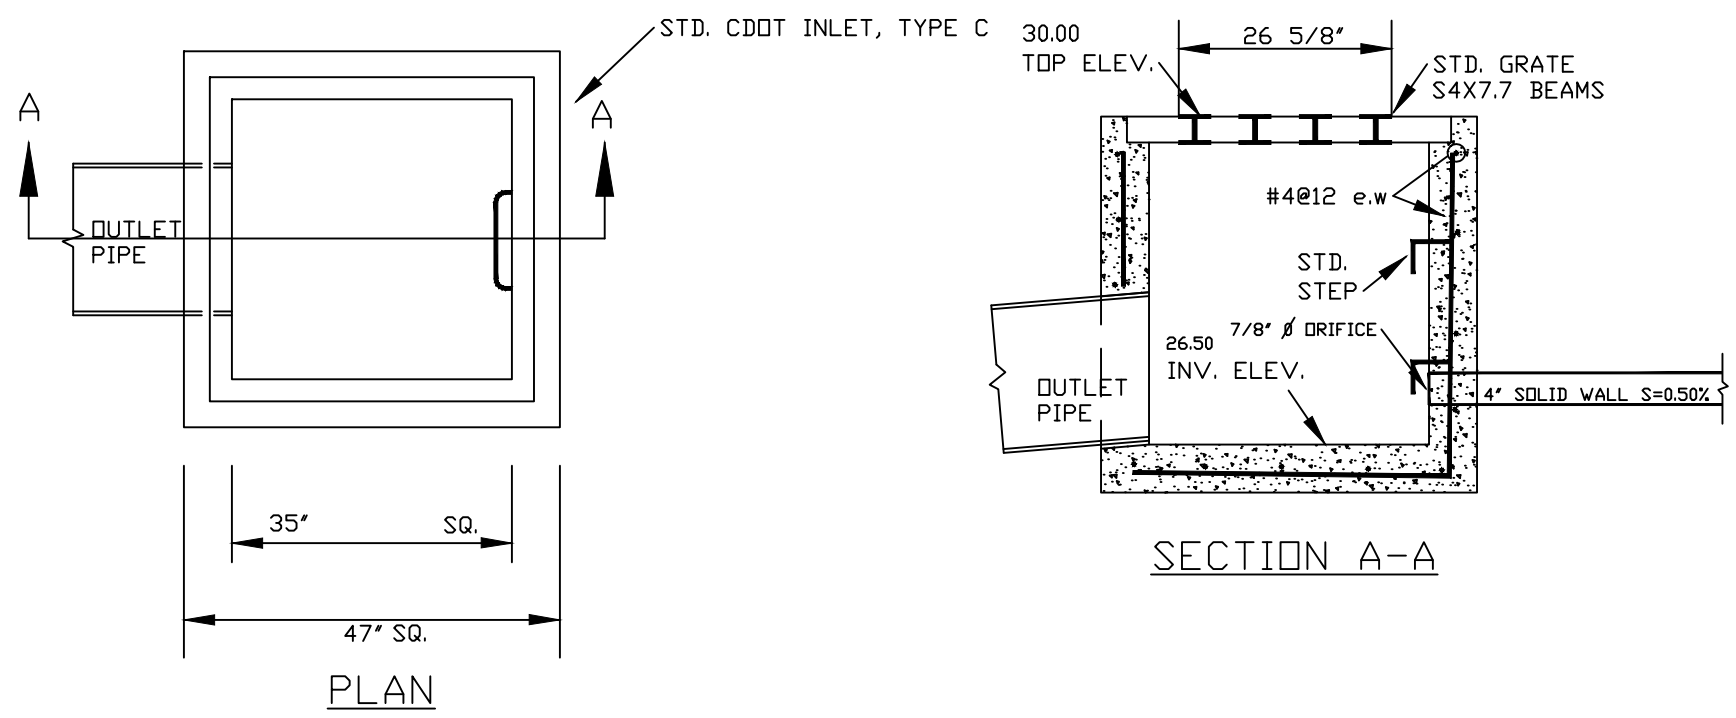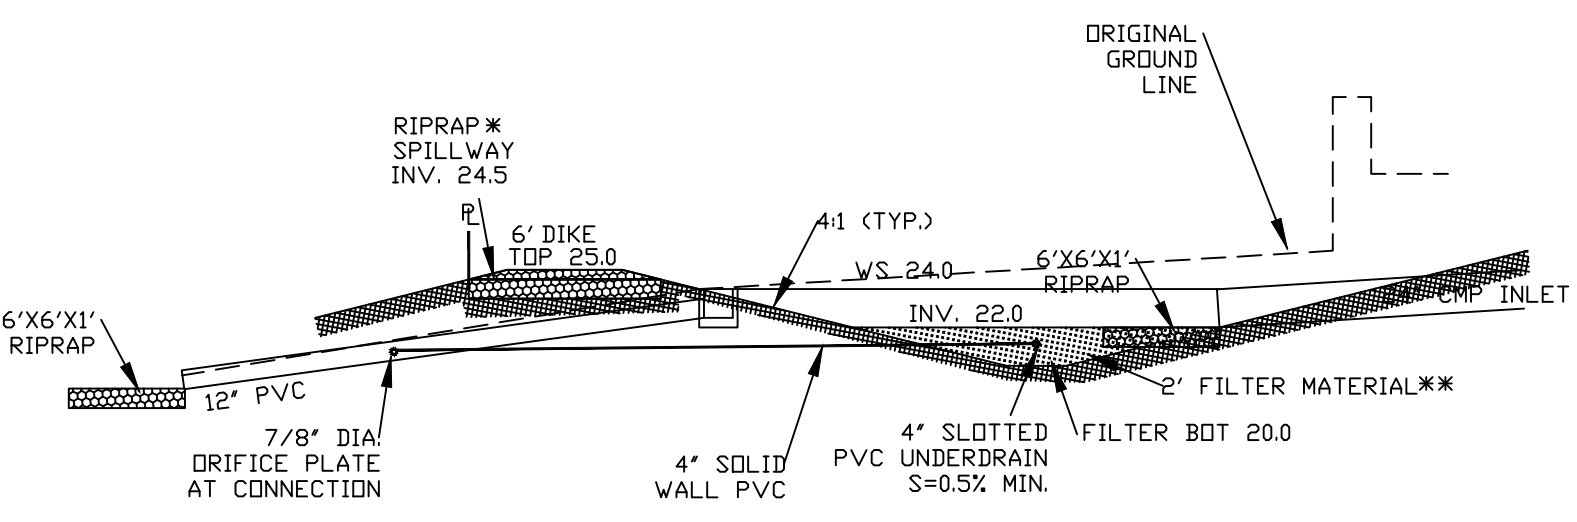 $1''=2$ CDOT INLET
$$1/2'' = 1' - 0$$


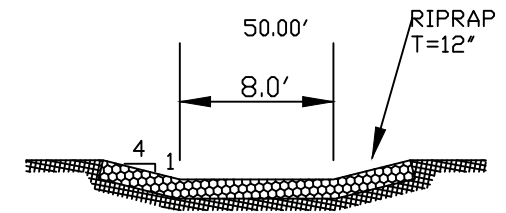
SECTION B-E
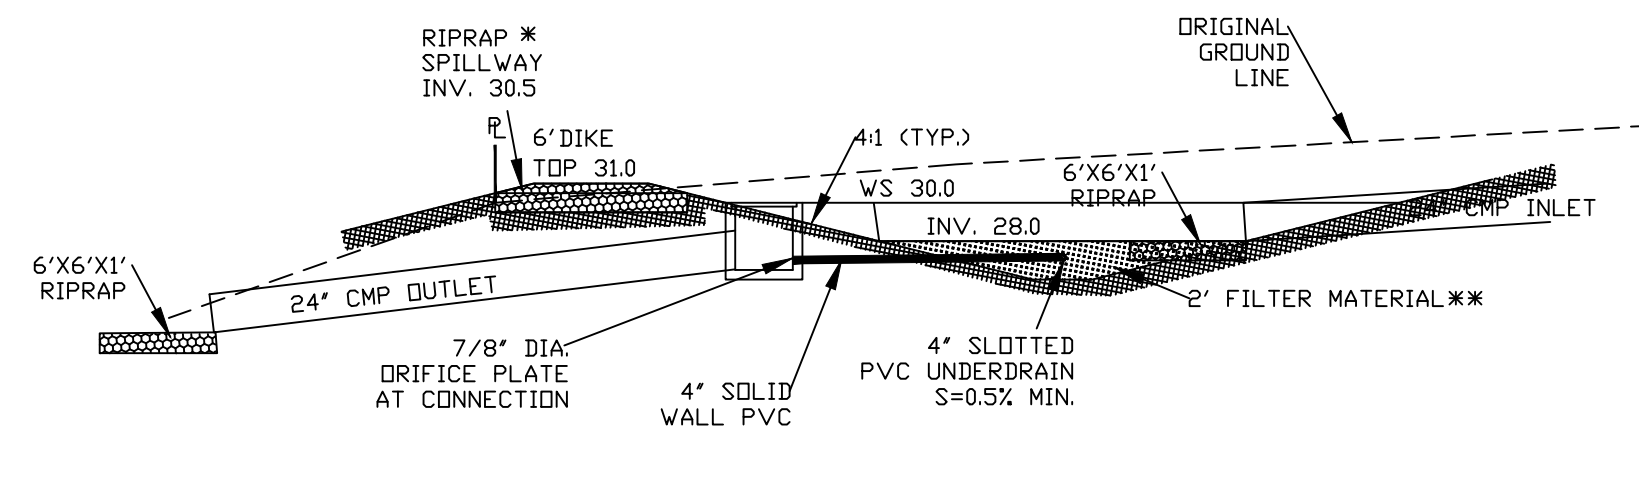
$$1' = 1$$


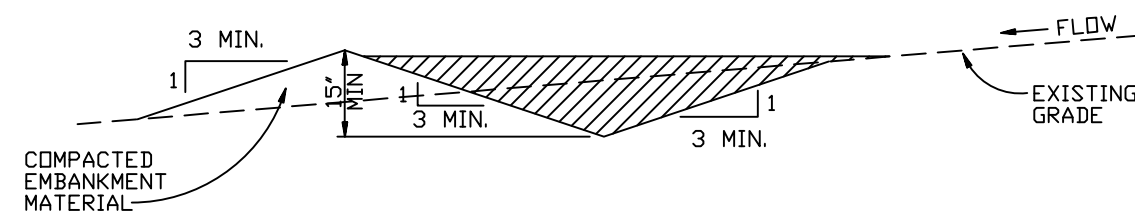
SECTION C-C
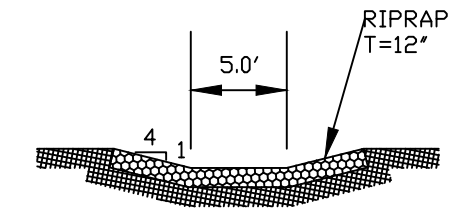
$$1' = 1$$


SECTION A-A SPILLWAY

 $1' = 1$ 

SECTION D-D SPILLWAY

 $1' = 10$ 

DRAINAGE SWALL
NTS

NTS

*RIPRAP IS TO BE TYPE 'L'
OR 'VL', MIXED WITH 35%
NATIVE SOIL BY WEIGHT,
COVERED WITH 4" MIN TOPSOIL


** FILTER MATERIAL IS TO BE
 85% SAND, ASTM C-33
 15" PEAT MIX
 RESEED PER MHFD TABLE B-6 MIX
 FOR DRYLAND GRASSES

Prepared by the office of:
 Oliver E. Watts, Consulting Engineer, Inc.
 614 Elkton Drive
 Colorado Springs, CO 80907
 (719) 593-0173
 Ollewatts@aol.com
 Celebrating 42 years in Business

DRAWN BY: D.E. WATTS DATE: DWG. NO.: TOPOGRAPHY BY: CITY FINS 6-18-19 SURVEY INFORMATION BY: RAMPART JOB NO. 18384	APPROVED BY: PROJ. NO.: DWG.:	REVISIONS 8-16-21 UPDATED DEW 12-31-21 REVISED PER COUNTY REVIEW COMMENTS DEW 8-22-22 REVISED PER COUNTY REVIEW COMMENTS DEW	OLIVER E. WATTS CONSULTING ENGINEER COLORADO SPRINGS	PROJECT ROCKY TOP MOTEL & CAMPGROUND PART NW1/4 SECTION 9, T.13S., R.68W., 6TH P.M. EL PASO COUNTY	SHT. NAME <h1>DRAINAGE PLAN</h1>	SHT. NO. OF
--	-------------------------------------	--	--	---	-------------------------------------	----------------


Drainage Report - Final_V3.pdf Markup Summary

Daniel Torres (11)

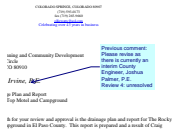


Subject: Callout
Page Label: 2
Author: Daniel Torres
Date: 12/8/2022 12:18:57 PM
Status:
Color: ■
Layer:
Space:

Previous comment: Please revise as there is currently an interim County Engineer, Joshua Palmer, P.E.
Review 4: unresolved

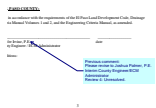


Subject: Callout
Page Label: 3
Author: Daniel Torres
Date: 12/8/2022 12:19:57 PM
Status:
Color: ■
Layer:
Space:

Previous comment:
Please revise to Joshua Palmer, P.E.
Interim County Engineer/ECM Administrator
Review 4: Unresolved.

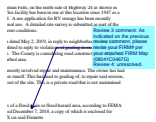


Subject: Callout
Page Label: 4
Author: Daniel Torres
Date: 12/8/2022 12:20:45 PM
Status:
Color: ■
Layer:
Space:

Review 3 comment: As indicated on the previous review comment, please revise your FIRM# per your attached FIRM Map (08041C0467G)
Review 4: unresolved.

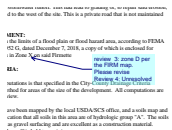

Subject: Callout
Page Label: 4
Author: Daniel Torres
Date: 12/8/2022 12:25:17 PM
Status:
Color: ■
Layer:
Space:

review 3: zone D per the FIRM map. Please revise
Review 4: Unresolved

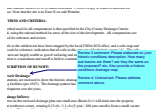

Subject: Callout
Page Label: 4
Author: Daniel Torres
Date: 12/8/2022 12:26:01 PM
Status:
Color: ■
Layer:
Space:


Review 3 comment: Please elaborate on your historic conditions description. How many sub-basins are there? are they the same as the proposed? etc. Also provide a historic conditions drainage map.

Review 4: Unresolved. Please address comment above.




Subject: Callout
Page Label: 5
Author: Daniel Torres
Date: 12/8/2022 12:31:54 PM
Status:
Color: ■
Layer:
Space:

Review 1 comment: Please indicate what the downstream facilities are and provide analysis.
Review 2: Unresolved. Please address the above comment and identify the suitable outfall (ECM 3.2.4) location. Please be specific.
Review 3: Unresolved. Please address the above. Provide analysis/calcs. Detention may be needed.
Review 4: Unresolved.

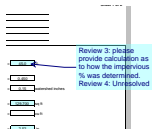


Subject: Callout
Page Label: 11
Author: Daniel Torres
Date: 12/8/2022 12:33:24 PM
Status:
Color: ■
Layer:
Space:

Review 3: please provide calculation as to how the impervious % was determined.
Review 4: Unresolved

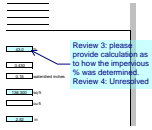

Subject: Callout
Page Label: 13
Author: Daniel Torres
Date: 12/8/2022 12:33:44 PM
Status:
Color: ■
Layer:
Space:

Review 3: please provide calculation as to how the impervious % was determined.
Review 4: Unresolved

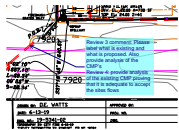


Subject: Callout
Page Label: 21
Author: Daniel Torres
Date: 12/8/2022 12:42:46 PM
Status:
Color: ■
Layer:
Space:

Review 3 comment: Please label what is existing and what is proposed. Also provide analysis of the CMP's
Review 4: provide analysis of the existing CMP proving that it is adequate to accept the sites flows



Subject: Callout
Page Label: 5
Author: Daniel Torres
Date: 12/8/2022 12:45:05 PM
Status:
Color: ■
Layer:
Space:


Review 3: Please also identify the retaining wall/block walls constructed on the west side and campground area and some of the reasoning behind it (to revert the Lucky Rd runoff back to historic conditions as stated previously?)
Review 4: Unresolved

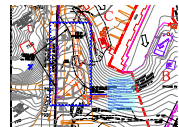

Subject: Cloud+
Page Label: 21
Author: Daniel Torres
Date: 12/8/2022 2:10:40 PM
Status:
Color: ■
Layer:
Space:

review 3 comment: see comments in the narrative of the report regarding with this area and revise accordingly.
Review 4: please address comment in the narrative regarding this area.

Glenn Reese - EPC Stormwater (32)

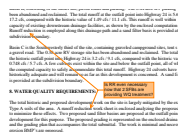

Subject: SW - Textbox with Arrow
Page Label: 5
Author: Glenn Reese - EPC Stormwater
Date: 12/6/2022 1:24:46 PM
Status:
Color: ■
Layer:
Space:

Is RR even necessary now that 2 SFBs are providing WQ treatment?

and sites graded into the natural terrain was. This will combine with runoff from up. The 0.44 acre RV parking site has all point into Highway 24 is 5.6 cfs / cfs. This runoff is well within the n by the enclosed computations.

1 sand filter basin is provided at the

2 do not use any calculations analyzing the capacity of downstream drainage facilities. Plans are prepared.

3 worked compartments sites, tree sites, and

4 lones and reclaimed. The total runoff at

5 compared with the historic value of

6 slow the outfall point, all of which have


7 off. Highway 24 culverts have proved

8 ment is concerned. A sand filter basin

Subject: SW - Textbox with Arrow
Page Label: 5
Author: Glenn Reese - EPC Stormwater
Date: 12/6/2022 1:27:42 PM
Status:
Color: ■
Layer:
Space:

I do not see any calculations analyzing the capacity of downstream drainage facilities. Please provide.


with runoff from Basins A for a total of 4.0 cfs / 10.6 cfs. Iscotic runoff for this area is 0.85 cfs / 6.2 cfs. This basin traveled campground sites graded into the natural terrain per boundary areas. This will combine with runoff from roads and parking. The 0.44 acre RV parking site has runoff at the outfall point into Highway 24 is 5.6 cfs / 14.9 cfs / 11.1 cfs. This runoff is well within the facilities, as shown by the enclosed computations. A stream path and a sand filter basis is provided at the

Subject: SW - Highlight
Page Label: 5
Author: Glenn Reese - EPC Stormwater
Date: 12/6/2022 1:27:47 PM
Status:
Color: 
Layer:
Space:

as shown by the enclosed computations.

KEY REQUIREMENTS:

a. A runoff reduction work

Subject: SW - Highlight
Page Label: 5
Author: Glenn Reese - EPC Stormwater
Date: 12/6/2022 1:27:52 PM
Status:
Color: 
Layer:
Space:

runoff reduction

KEY REQUIREMENTS:

proposed development work on the site is largely mitigated by the construction of a runoff reduction water sheet is enclosed analyzing the project. Two proposed sand filter basins are proposed at the outfall to the river. The proposed grading is represented on the enclosed plan and section drawings. The work is minimal and is expected to be completed within the next 12 months.

Please clarify that these SFBs are only for WQ treatment and not detention. If it is the case, Otherwise had a discussion and calls related to detention.

Subject: SW - Textbox with Arrow
Page Label: 5
Author: Glenn Reese - EPC Stormwater
Date: 12/6/2022 1:28:25 PM
Status:
Color: ■
Layer:
Space:

Please clarify that these SFBs are only for WQ treatment and not detention, if that is the case. Otherwise had a discussion and calcs related to detention.

[illegible]

Subject: SW - Textbox with Arrow
Page Label: 5
Author: Glenn Reese - EPC Stormwater
Date: 12/6/2022 1:29:05 PM
Status:
Color: ■
Layer:
Space:

Unresolved comment from Review #3:
So if there is a suitable outfall such that detention is not required, describe that the SFBs are only designed for WQCV. But if Detention is required (once PCD comments above have been addressed), you will need to increase the size of the Sand Filter and provide both the UD-Detention worksheet and SDI Form.


Subject: SW - Textbox with Arrow
Page Label: 21
Author: Glenn Reese - EPC Stormwater
Date: 12/6/2022 1:32:15 PM
Status:
Color: ■
Layer:
Space:

Revise "work" to "disturbance" for consistency.




Subject: SW - Textbox with Arrow
Page Label: 10
Author: Glenn Reese - EPC Stormwater
Date: 12/6/2022 1:35:34 PM
Status:
Color: ■
Layer:
Space:

Unresolved comment from Review #3:
Provide a figure showing all proposed UIA and RPA areas to be utilized for runoff reduction. Area ID "E" is not labeled/shown on Drainage Map or GEC Plan.
All RPA areas will need to be within a no build/drainage easement and discussed in the maintenance agreement and O&M manual. Also make sure to show RPA limits on GEC Plans (not just FDR) so our SW inspectors and the QSM know that these areas are to remain pervious and vegetated post-construction.

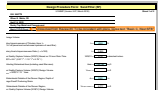


Subject: SW - Textbox
Page Label: 11
Author: Glenn Reese - EPC Stormwater
Date: 12/6/2022 1:37:13 PM
Status:
Color: ■
Layer:
Space:

Unresolved from Review #3: To be consistent with plans, revise text: "Basin C, West SFB"

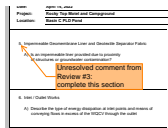


Subject: SW - Textbox with Arrow
Page Label: 12
Author: Glenn Reese - EPC Stormwater
Date: 12/6/2022 1:41:13 PM
Status:
Color: ■
Layer:
Space:

Unresolved comment from Review #3:
complete this section

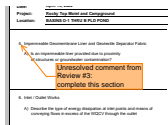


Subject: SW - Textbox with Arrow
Page Label: 14
Author: Glenn Reese - EPC Stormwater
Date: 12/6/2022 1:41:25 PM
Status:
Color: ■
Layer:
Space:

Unresolved comment from Review #3:
complete this section

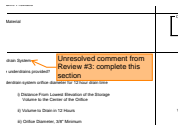

Subject: SW - Textbox with Arrow
Page Label: 11
Author: Glenn Reese - EPC Stormwater
Date: 12/6/2022 1:41:28 PM
Status:
Color: ■
Layer:
Space:

Unresolved comment from Review #3: complete this section

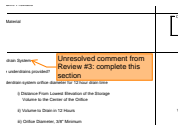


Subject: SW - Textbox with Arrow
Page Label: 13
Author: Glenn Reese - EPC Stormwater
Date: 12/6/2022 1:41:33 PM
Status:
Color: ■
Layer:
Space:

Unresolved comment from Review #3: complete this section




Subject: SW - Textbox
Page Label: 13
Author: Glenn Reese - EPC Stormwater
Date: 12/6/2022 1:42:04 PM
Status:
Color: ■
Layer:
Space:

To be consistent with plans: add text: "East SFB" and delete "PLD POND"

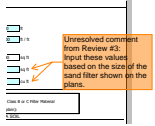

Subject: SW - Textbox with Arrow
Page Label: 11
Author: Glenn Reese - EPC Stormwater
Date: 12/6/2022 1:42:56 PM
Status:
Color: ■
Layer:
Space:

Unresolved comment from Review #3:
Input these values based on the size of the sand filter shown on the plans.

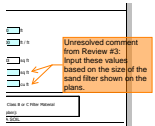


Subject: SW - Textbox with Arrow
Page Label: 13
Author: Glenn Reese - EPC Stormwater
Date: 12/6/2022 1:42:58 PM
Status:
Color: ■
Layer:
Space:

Unresolved comment from Review #3:
Input these values based on the size of the sand filter shown on the plans.



Subject: SW - Textbox
Page Label: 22
Author: Glenn Reese - EPC Stormwater
Date: 12/6/2022 1:47:04 PM
Status:
Color: ■
Layer:
Space:

See comments on duplicate sheet submitted with GEC Plans

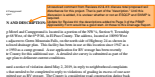


Subject: SW - Textbox with Arrow
Page Label: 4
Author: Glenn Reese - EPC Stormwater
Date: 12/6/2022 11:58:09 AM
Status:
Color: ■
Layer:
Space:

Unresolved comment from Reviews #2 & #3:
discuss total proposed soil disturbance for this project. That is part of the "description." Until this discussion is added, it is unclear whether or not an ESQCP and SWMP is required.
Update for Review #4: the descriptions added to Page 3 of the PBMP Applicability Form would be a good start. At those to this Drainage Report.



Subject: SW - Highlight
Page Label: 5
Author: Glenn Reese - EPC Stormwater
Date: 12/6/2022 11:59:43 AM
Status:
Color: ■
Layer:
Space:

unless
structures are involved

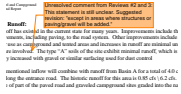

Subject: SW - Textbox with Arrow
Page Label: 5
Author: Glenn Reese - EPC Stormwater
Date: 12/6/2022 12:00:02 PM
Status:
Color:
Layer:
Space:


Unresolved comment from Reviews #2 and 3:
This statement is still unclear. Suggested revision:
"except in areas where structures or paving/gravel
will be added."

been abandoned and n
17.2 cfs, compared wi
capacity of existing dc
Runoff reduction is en
subdivision boundary.

Basin C is the Southw

Subject: SW - Highlight
Page Label: 5
Author: Glenn Reese - EPC Stormwater
Date: 12/6/2022 12:04:56 PM
Status:
Color:
Layer:
Space:

Runoff reduction

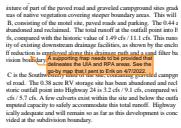

Subject: SW - Textbox with Arrow
Page Label: 5
Author: Glenn Reese - EPC Stormwater
Date: 12/6/2022 12:07:54 PM
Status:
Color:
Layer:
Space:

A supporting map needs to be provided that
delineates the UIA and RPA areas. See the go-by
map that I sent to Erik on 4/7/2022.



Subject: SW - Highlight
Page Label: 5
Author: Glenn Reese - EPC Stormwater
Date: 12/6/2022 12:08:35 PM
Status:
Color:
Layer:
Space:

5.6 cfs /
17.2 cfs, compared with the historic value of 1.49
cfs / 11.1 cf




Subject: SW - Textbox with Arrow
Page Label: 5
Author: Glenn Reese - EPC Stormwater
Date: 12/6/2022 12:09:02 PM
Status:
Color:
Layer:
Space:

Is this difference with or without the SFBs? Please
describe how they effect the outfall flows.




Subject: SW - Textbox
Page Label: 13
Author: Glenn Reese - EPC Stormwater
Date: 12/6/2022 12:11:39 PM
Status:
Color:
Layer:
Space:

Also complete the MHFD UD-Detention worksheet
to show change from existing to proposed flows
and to calculate the orifice hole dimensions in the
outlet. Currently shown on plans as 7/8" but no
calcs provided to support that.

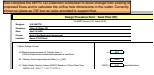


Subject: SW - Textbox
Page Label: 11
Author: Glenn Reese - EPC Stormwater
Date: 12/6/2022 12:11:44 PM
Status:
Color: ■
Layer:
Space:

Also complete the MHFD UD-Detention worksheet to show change from existing to proposed flows and to calculate the orifice hole dimensions in the outlet. Currently shown on plans as 7/8" but no calcs provided to support that.

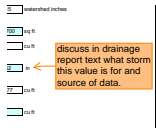


Subject: SW - Textbox with Arrow
Page Label: 11
Author: Glenn Reese - EPC Stormwater
Date: 12/6/2022 12:14:45 PM
Status:
Color: ■
Layer:
Space:

discuss in drainage report text what storm this value is for and source of data.

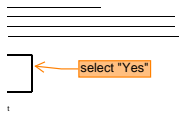


Subject: SW - Textbox with Arrow
Page Label: 11
Author: Glenn Reese - EPC Stormwater
Date: 12/6/2022 12:17:00 PM
Status:
Color: ■
Layer:
Space:

select "Yes"

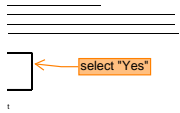

Subject: SW - Textbox with Arrow
Page Label: 13
Author: Glenn Reese - EPC Stormwater
Date: 12/6/2022 12:17:46 PM
Status:
Color: ■
Layer:
Space:

select "Yes"

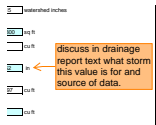


Subject: SW - Textbox with Arrow
Page Label: 13
Author: Glenn Reese - EPC Stormwater
Date: 12/6/2022 12:17:46 PM
Status:
Color: ■
Layer:
Space:

discuss in drainage report text what storm this value is for and source of data.



Subject: SW - Textbox with Arrow
Page Label: 21
Author: Glenn Reese - EPC Stormwater
Date: 12/6/2022 2:00:09 PM
Status:
Color: ■
Layer:
Space:

Please delineate UIA and RPA. The extents of each is unclear since you just show text boxes without any shading/hatching/linetypes to outline their limits.
Also make sure to show RPA limits on GEC Plans (not just FDR) so our SW inspectors and the QSM know that these areas are to remain pervious and vegetated post-construction.

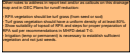

Subject: SW - Textbox

Page Label: 21

Author: Glenn Reese - EPC Stormwater

Date: 12/6/2022 3:25:20 PM

Status:

Color: ■

Layer:

Space:

Other notes to address in report text and/or as callouts on this drainage map and in GEC Plans for runoff reduction:

- RPA vegetation should be turf grass (from seed or sod)
- Turf grass vegetation should have a uniform density of at least 80%.
- Show suitability of topsoil of RPA and steps for proper preparation of RPA soil per recommendations in MHFD detail T-0.
- Irrigation (temp or permanent) is necessary to establish sufficient vegetation and not just weeds.