


Letter of Intent

Owner/Applicant Information:

Richmond American Homes
4350 S. Monaco Street Denver, CO 80237
Office: 720.977.3881
Cell: 303.889.9145
Fax: 303.488.4843

Site Location, Size and Zoning:

Site Location:

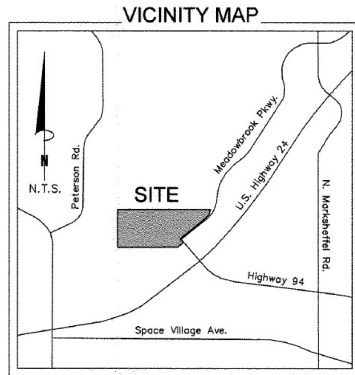

Size and Zoning:

This Site is approximately 32 acres and the current zoning of the parcel is RS 5000. Per the El Paso Development Code in Section 5.4.2, Table 5-4, the setbacks are as follows:

Front (to garage): 25'
Front (to living): 25'
Side (interior): 5'
Side (corner): 15'
Rear: 25'

General Description:

Richmond American Homes "RAH" is submitting an application to request a variance of the current setback and coverage ratio for Meadowbrook Crossing Filing 1 and the Filing 2. RAH's is requesting a 20% relief for both the setback and coverage ratio on the lots that RAH's currently owns. The requested adjustment of setbacks outlined above to consist of as follows:

Front (to garage): 25.0' to 20.0'
Front (to living): 25.0' to 20.0'
Side (interior): 5'
Side (corner): 15'
Rear: 25.0' to 20.0'


The lots are outlined in red and green are currently owned by Richmond American Homes. There are a total of 114 single family dwellings that are split between two builders. Richmond American Homes is requesting the relief on 57 Lots of the 114 total Lots in the Meadowbrook Crossing subdivision. Please reference the red and green polygons on the map below to understand which lots in each filing that Richmond American Homes is requesting the relief for.




The lots that RAH's filing the variance application for setback reduction and coverage ratio are located within two legal filings. Please reference the maps below to further delineate the lots for each filing.

Filing 1:

Lot Coverage Ratio Variance Map

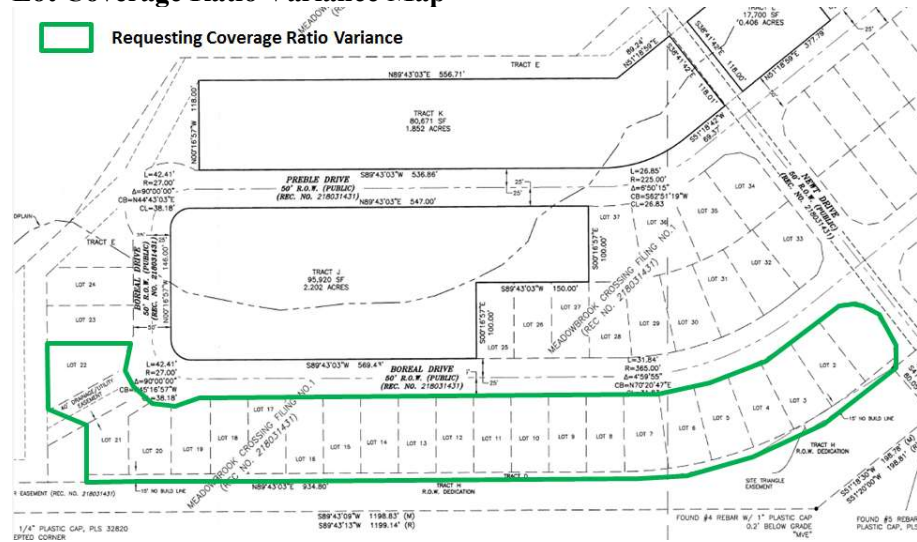


Lot Setback Variance Map

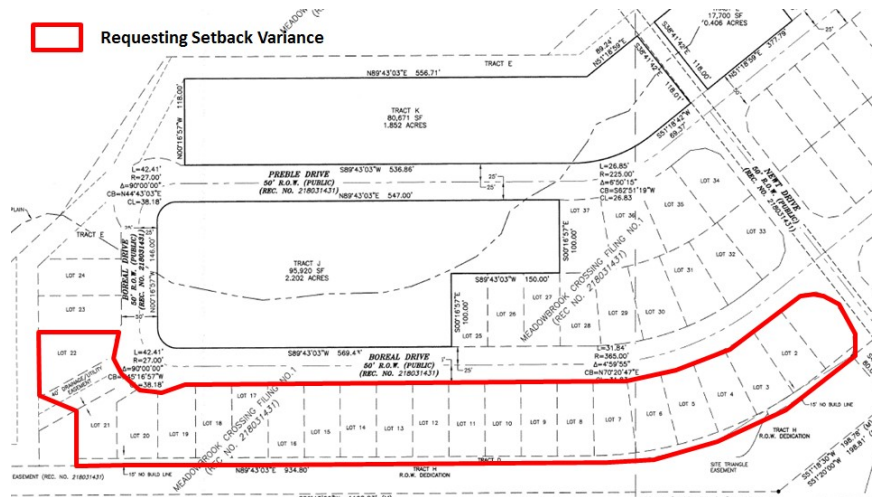


Filing 2:

Lot Coverage Ratio Variance Map

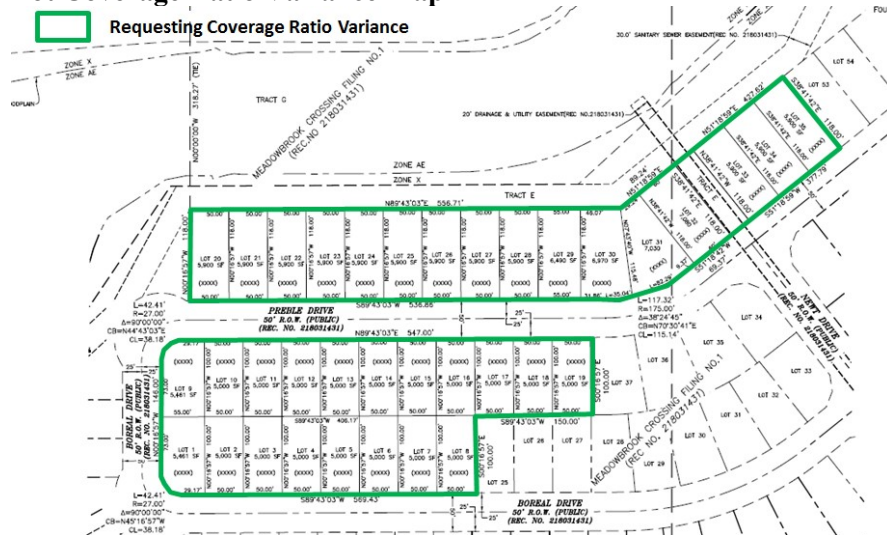

Lot Setback Variance Map

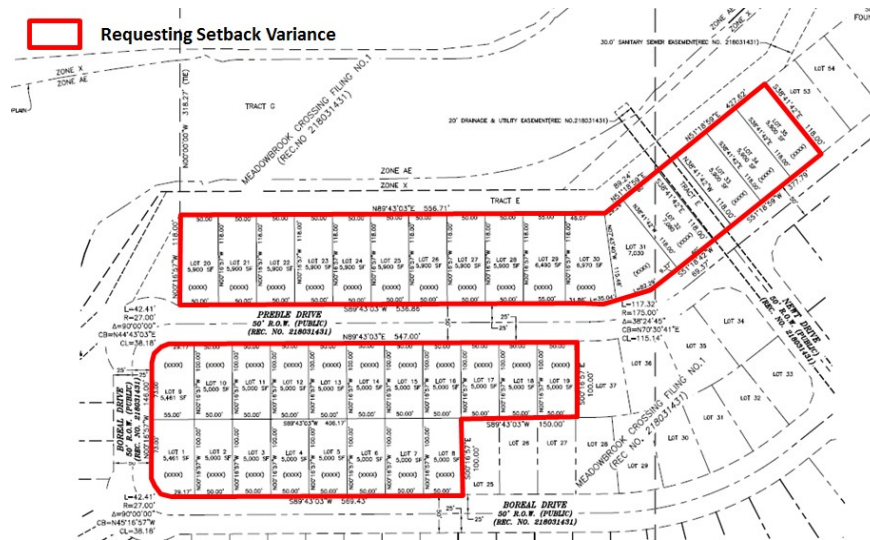

Request and Justification:

Richmond American Homes (RAH) has encountered some lot fit issues with our proposed product in our new subdivision Meadowbrook Crossing. We purchased our lots and are having lot fit issues. More specifically fitting our ranch product on all of the lots. RAH's is interested in filing a variance application under your mechanism of Administrative Relief as outlined in section 5.5.1 of the Land Development Code. The variance that RAH's is seeking is a 20% reduction in setback and coverage requirements for all the lots at Meadowbrook that are owned by RAH's as outlined above for both Filing 1 and 2.

The new Setback outlined is as follows for each lot:

- Front (to garage): 20.0'
- Front (to living): 20.0'
- Rear: 20.0'

You can consolidate this to just Front (to structure).

The adjustment of Coverage Ratio is as follows for each plan:

R or T	Plan	Elevation	SF-PATIO	MIN LOT SQFT	WITH VAR	SF-NO PAT	MIN SF	WITH VAR
R	R901.1	ABCDE	2,528	5,618	4,494	2,383	5,296	4,236
R	R901.1	F	2,885	6,411	5,129	2,740	6,089	4,871
R	R902.1	ABC	2,702	6,004	4,804	2,557	5,682	4,546
R	R902.1	DE	2,890	6,422	5,138	2,745	6,100	4,880
T	R903.1	ABC	2,068	4,596	3,676	1,813	4,029	3,223
T	R904.1	ABCDE	2,329	5,176	4,140	2,044	4,542	3,634
T	R915.1	ABCD	2,241	4,980	3,984	1,956	4,347	3,477
R	R921.1	ABCD	2,903	6,451	5,161	2,848	6,329	5,063
R	R921.1	EF	3,003	6,673	5,339	2,948	6,551	5,241

If this variance or relief is not granted this would limit the subdivision to one model that we would be able to construct in the community. That will create a monotony issue that will be very detrimental to the appeal of the community as well as be a detriment to the overall public good. We would only be able to construct two story homes and unfortunately that is not an affordable product to the prospective buyers in this market.

Criteria for Administrative Relief:

1. A replat would be detrimental to the community and the project for a number of reasons. First and foremost, RAH has already sold homes within the community and cannot cancel the contracts. Secondly, the project location is constrained and the ability to increase lot size is not a practical solution without impacting the streets and the overall intent of the community. As a reminder the community has already finished horizontal development.
2. Granting the variance would reduce/eliminate monotony and allow RAH's to create a visual appealing community that will be better for residents and the County.
3. RAH's doesn't believe that by granting this variance it will have negative impact on surrounding land owners. We are/will be the majority of the surrounding owners and there is commercial use to the south of the project.
4. Granting the variance will not increase density as prescribed in the plat but rather provide more variation of product type and offering.

Existing and Proposed facilities and Improvements:

Currently all the subdivision improvements have been completed and in the future there will new homes built on the finished lots.


Letter of Intent

Owner/Applicant Information:

Richmond American Homes
4350 S. Monaco Street Denver, CO 80237
Office: 720.977.3881
Cell: 303.889.9145
Fax: 303.488.4843

Site Location, Size and Zoning:

Site Location:

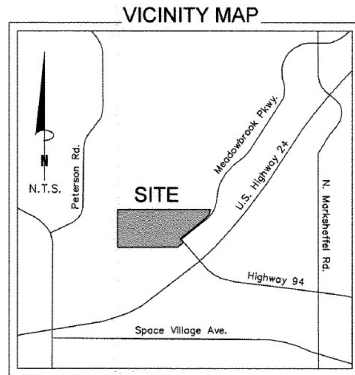

Size and Zoning:

This Site is approximately 32 acres and the current zoning of the parcel is RS 5000. Per the El Paso Development Code in Section 5.4.2, Table 5-4, the setbacks are as follows:

Front (to garage): 25'
Front (to living): 25'
Side (interior): 5'
Side (corner): 15'
Rear: 25'


This is not a variance
it is administrative
relief.

General Description:

Richmond American Homes "RAH" is submitting an application to request a variance of the current setback and coverage ratio for Meadowbrook Crossing Filing 1 and the Filing 2. RAH's is requesting a 20% relief for both the setback and coverage ratio on the lots that RAH's currently owns. The requested adjustment of setbacks outlined above to consist of as follows:


Front (to garage): 25.0' to 20.0'
Front (to living): 25.0' to 20.0'
Side (interior): 5'
Side (corner): 15'
Rear: 25.0' to 20.0'

The lots are outlined in red and green are currently owned by Richmond American Homes. There are a total of 114 single family dwellings that are split between two builders. Richmond American Homes is requesting the relief on 57 Lots of the 114 total Lots in the Meadowbrook Crossing subdivision. Please reference the red and green polygons on the map below to understand which lots in each filing that Richmond American Homes is requesting the relief for.

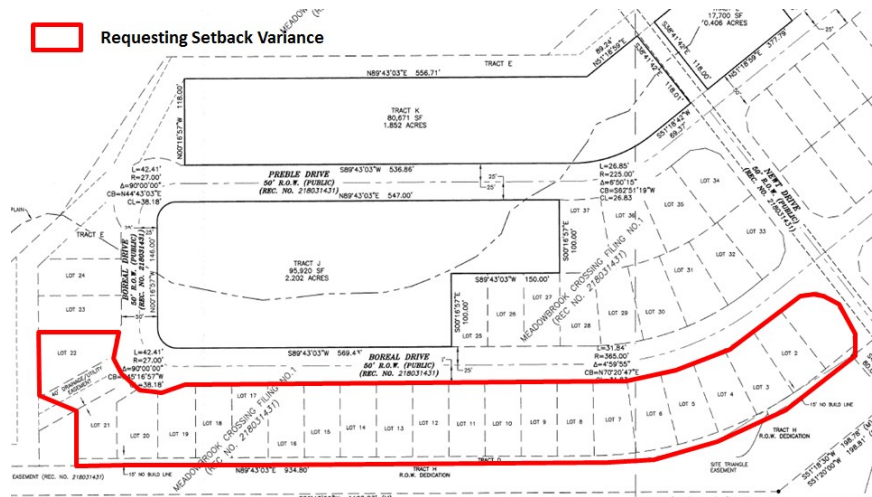


Filing 2:

Lot Coverage Ratio Variance Map

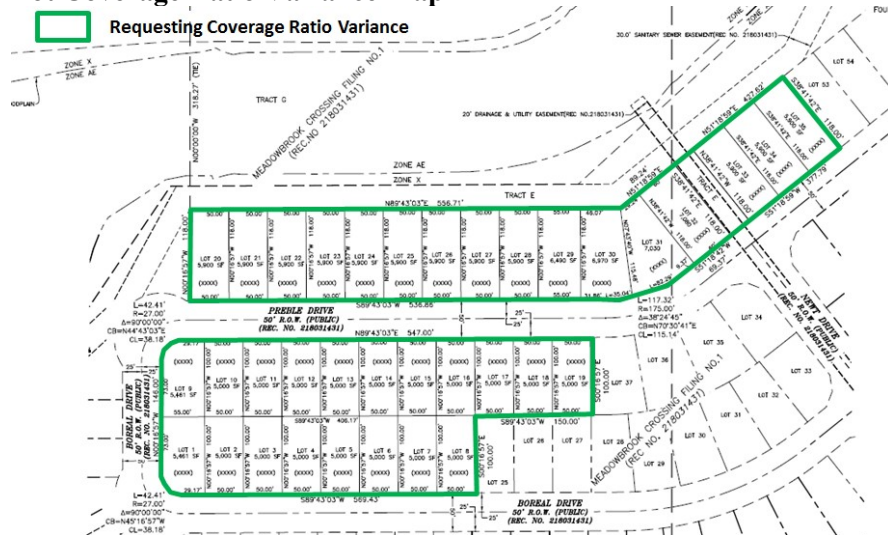

Lot Setback Variance Map

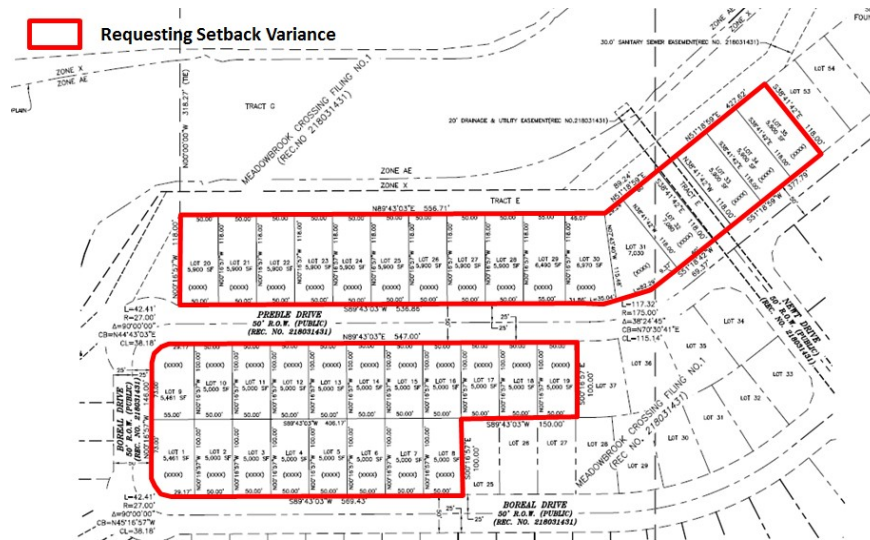

Request and Justification:

Richmond American Homes (RAH) has encountered some lot fit issues with our proposed product in our new subdivision Meadowbrook Crossing. We purchased our lots and are having lot fit issues. More specifically fitting our ranch product on all of the lots. RAH's is interested in filing a variance application under your mechanism of Administrative Relief as outlined in section 5.5.1 of the Land Development Code. The variance that RAH's is seeking is a 20% reduction in setback and coverage requirements for all the lots at Meadowbrook that are owned by RAH's as outlined above for both Filing 1 and 2.

The new Setback outlined is as follows for each lot:

- Front (to garage): 20.0'
- Front (to living): 20.0'
- Rear: 20.0'

The adjustment of Coverage Ratio is as follows for each plan:

R or T	Plan	Elevation	SF-PATIO	MIN LOT SQFT	WITH VAR	SF-NO PAT	MIN SF	WITH VAR
R	R901.1	ABCDE	2,528	5,618	4,494	2,383	5,296	4,236
R	R901.1	F	2,885	6,411	5,129	2,740	6,089	4,871
R	R902.1	ABC	2,702	6,004	4,804	2,557	5,682	4,546
R	R902.1	DE	2,890	6,422	5,138	2,745	6,100	4,880
T	R903.1	ABC	2,068	4,596	3,676	1,813	4,029	3,223
T	R904.1	ABCDE	2,329	5,176	4,140	2,044	4,542	3,634
T	R915.1	ABCD	2,241	4,980	3,984	1,956	4,347	3,477
R	R921.1	ABCD	2,903	6,451	5,161	2,848	6,329	5,063
R	R921.1	EF	3,003	6,673	5,339	2,948	6,551	5,241

If this variance or relief is not granted this would limit the subdivision to one model that we would be able to construct in the community. That will create a monotony issue that will be very detrimental to the appeal of the community as well as be a detriment to the overall public good. We would only be able to construct two story homes and unfortunately that is not an affordable product to the prospective buyers in this market.

Criteria for Administrative Relief:

1. A replat would be detrimental to the community and the project for a number of reasons. First and foremost, RAH has already sold homes within the community and cannot cancel the contracts. Secondly, the project location is constrained and the ability to increase lot size is not a practical solution without impacting the streets and the overall intent of the community. As a reminder the community has already finished horizontal development.
2. Granting the variance would reduce/eliminate monotony and allow RAH's to create a visual appealing community that will be better for residents and the County.
3. RAH's doesn't believe that by granting this variance it will have negative impact on surrounding land owners. We are/will be the majority of the surrounding owners and there is commercial use to the south of the project.
4. Granting the variance will not increase density as prescribed in the plat but rather provide more variation of product type and offering.

Existing and Proposed facilities and Improvements:

Currently all the subdivision improvements have been completed and in the future there will new homes built on the finished lots.

Is there any reason why there are two letters uploaded in this part? please upload only one letter of intent.

Markup Summary

dsdkendall (3)

as follows:

This is not a variance
it is administrative
relief.

ion to request a variance of the current
1 and the Filing 2. RAH's is requesting a

Subject: Callout
Page Label: 6
Lock: Unlocked
Author: dsdkendall
Date: 12/12/2018 10:04:27 AM
Color: ■

This is not a variance it is administrative relief.

n Hanes (RAH) has encountered some lot fit issues with our proposed product in our
adventure Crossing. We purchased our lots and are having lot fit issues. More
we reach product on all of the lots. RAH's is interested in filing a variance application
use of Administrative Relief as outlined in section 5.5.1 of the Land Development
that RAH's is seeking is a 20% reduction in setback and coverage requirements for all
work that are owned by RAH's as outlined above for both Filing 1 and 2.

attest to as follows for each lot:

ages: 20.0'
age: 20.0'

You can consolidate
this to just Front (to
structure).

Coverage Ratio is as follows for each lot:

Lot	Area	Front	Side	Back	Front	Side	Back
LOT 1	1.000	0.000	0.000	0.000	0.000	0.000	0.000
LOT 2	1.000	0.000	0.000	0.000	0.000	0.000	0.000
LOT 3	1.000	0.000	0.000	0.000	0.000	0.000	0.000
LOT 4	1.000	0.000	0.000	0.000	0.000	0.000	0.000
LOT 5	1.000	0.000	0.000	0.000	0.000	0.000	0.000
LOT 6	1.000	0.000	0.000	0.000	0.000	0.000	0.000
LOT 7	1.000	0.000	0.000	0.000	0.000	0.000	0.000
LOT 8	1.000	0.000	0.000	0.000	0.000	0.000	0.000
LOT 9	1.000	0.000	0.000	0.000	0.000	0.000	0.000
LOT 10	1.000	0.000	0.000	0.000	0.000	0.000	0.000

Subject: Callout
Page Label: 4
Lock: Unlocked
Author: dsdkendall
Date: 12/12/2018 10:59:09 AM
Color: ■

You can consolidate this to just Front (to structure).

admission improvements have been completed and in the future there will
of lots.

Is there any reason why there are two
letters uploaded in this part? please upload
only one letter of intent.

Subject: Text Box
Page Label: 10
Lock: Unlocked
Author: dsdkendall
Date: 12/12/2018 11:00:39 AM
Color: ■

Is there any reason why there are two letters uploaded in this part? please upload only one letter of intent.