


Site Plan Drawing

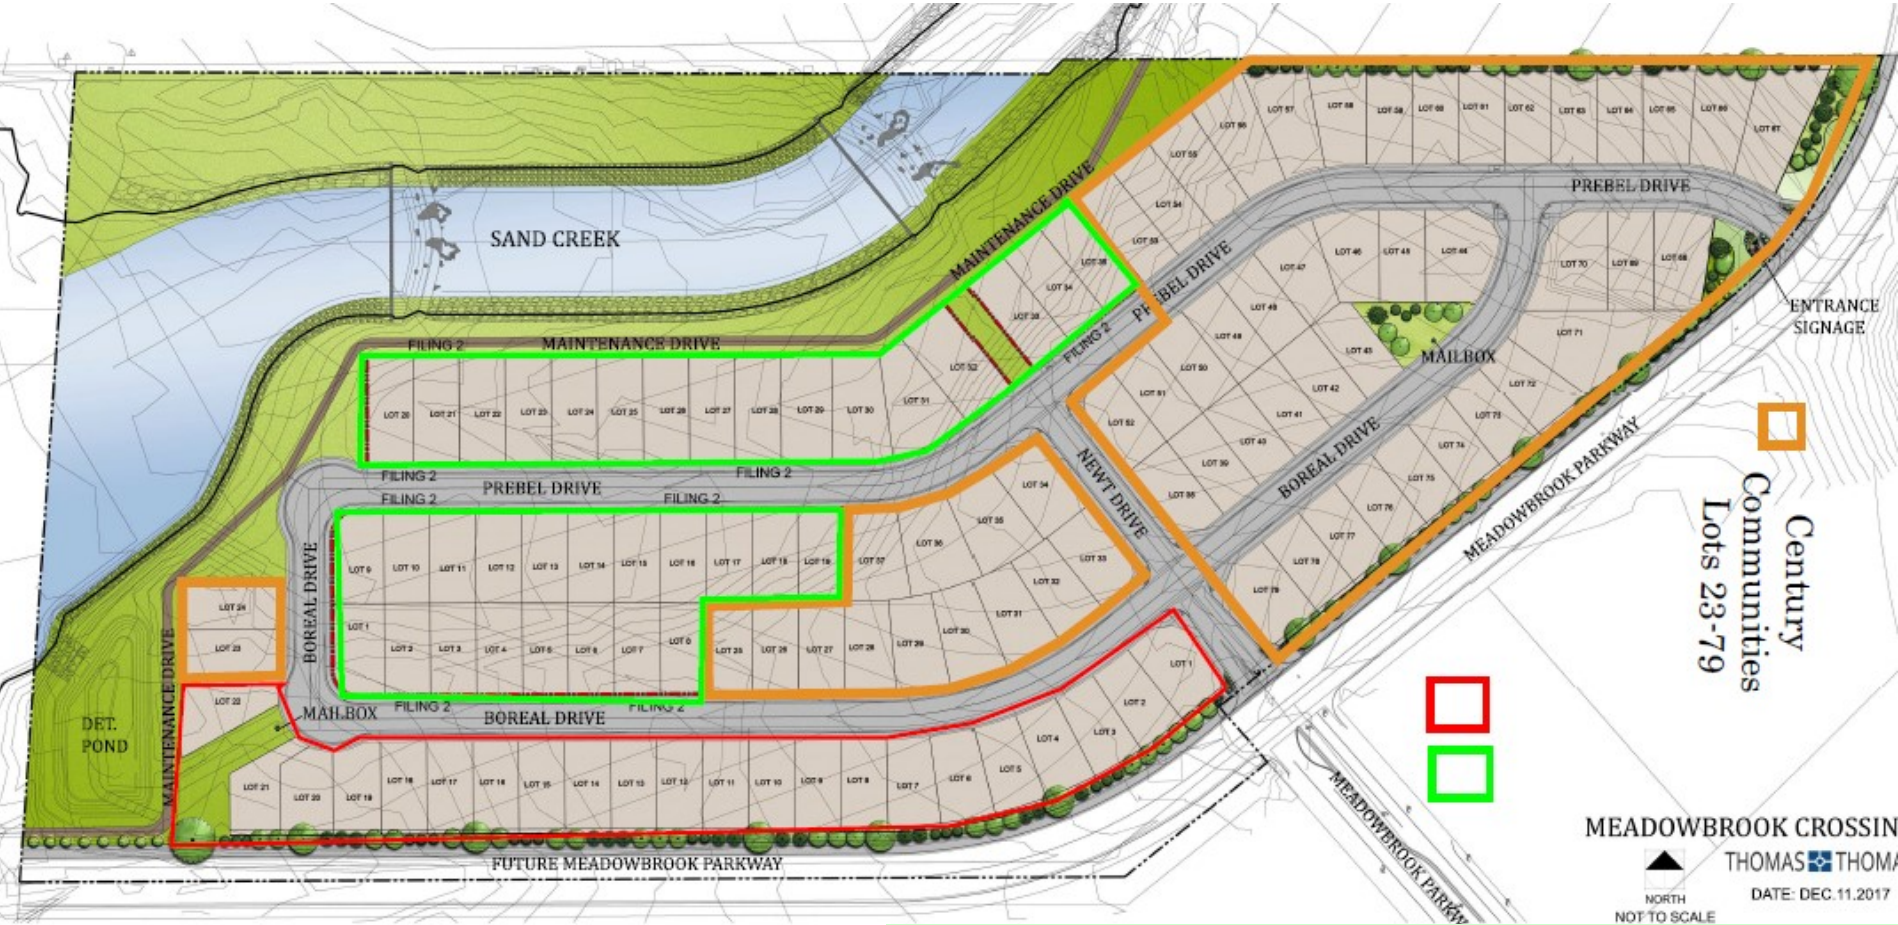

This should reflect what setbacks are being proposed on which lots, and how much lot coverage should be.

Markup Summary

dsdkendall (1)



Subject: Text Box
Page Label: 1
Lock: Unlocked
Author: dsdkendall
Date: 10/25/2018 8:41:51 AM
Color: ■

This should reflect what setbacks are being proposed on which lots, and how much lot coverage should be.