

NOTE: LANE WIDTHS ARE IN
ACCORDANCE WITH DEVIATION
APPROVED AS PART OF PUD


MAYBERRY, COLORADO SPRINGS - FILING NO. 1

TYPICAL ROAD SECTIONS

	No.	REVISION	BY	DATE
E	EPC COMMENTS		JPS	1/15/19
F	EPC COMMENTS		JPS	9/12/19
G	EPC COMMENTS		JPS	1/31/20
H	EPC COMMENTS		JPS	4/17/20
I	EPC COMMENTS		JPS	9/18/20

7"=5'	DRAWN:	RMD
APPROVED FOR CONSTRUCTION	DESIGNED:	JPS
	CHECKED:	JPS
5/05	LAST MODIFIED:	9/18/20
00001	MODIFIED BY:	BJJ

TY2



JPS
ENGINEERING


19 E. Willamette Ave.
Colorado Springs, CO
80903

PH: 719-477-9429
FAX: 719-471-0766
www.jpsengr.com




**CALL UTILITY NOTIFICATION
CENTER OF COLORADO
1-800-922-1987**
CALL 2-BUSINESS DAYS IN ADVANCE
BEFORE YOU DIG, GRADE, OR EXCAVATE
FOR THE MARKING OF UNDERGROUND
MEMBER UTILITIES.

C:\Users\Owner\Dropbox\jpsprojects\090001.EllcottTC\dwg\Civil\F1\TY2.dwg Sep 18, 2020 - 2:08pm

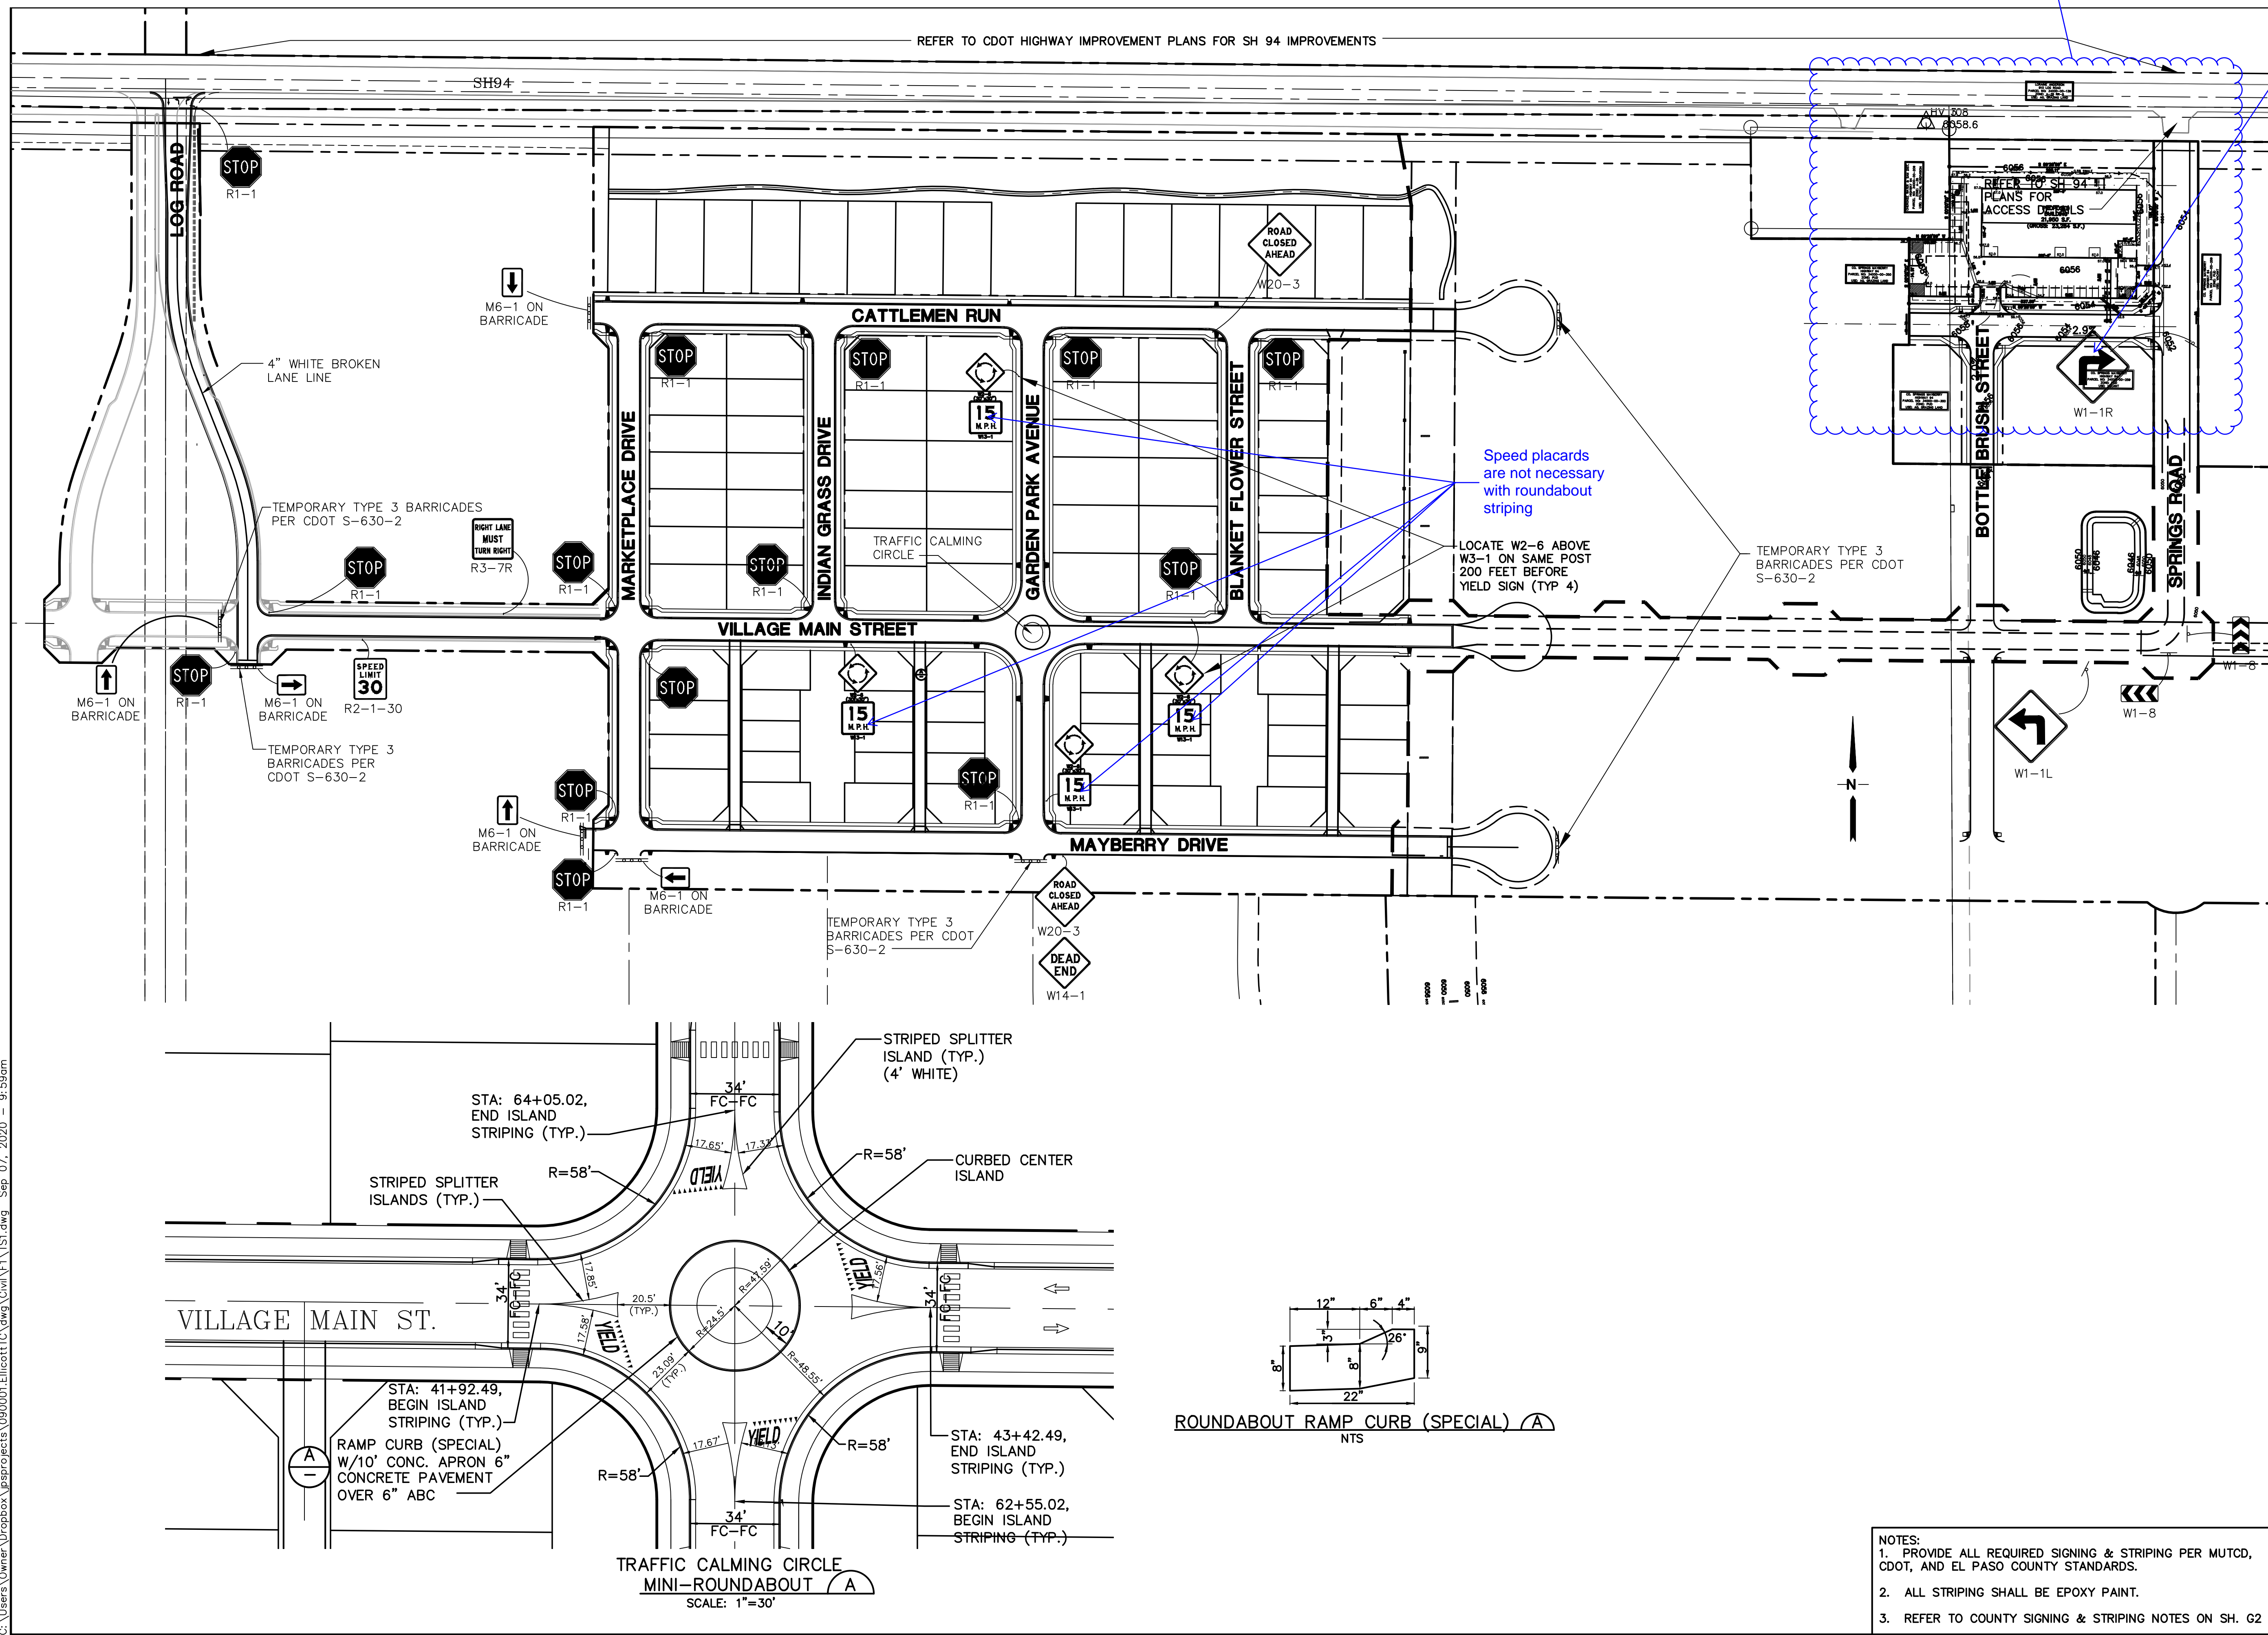

please label timing
of installation for
this sign

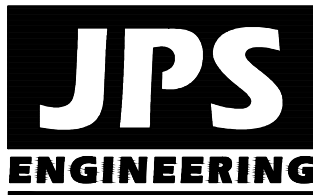

19 E. Willamette Ave.
Colorado Springs, CO
80903

PH: 719-477-9429
FAX: 719-471-0766
www.jpsengr.com



CALL UTILITY NOTIFICATION
CENTER OF COLORADO
-800-922-1987
CALL 2-BUSINESS DAYS IN ADVANCE
BEFORE YOU DIG, GRADE, OR EXCAVATE
FOR THE MARKING OF UNDERGROUND
MEMBER UTILITIES.

No.	REVISION	BY	DATE
D	2018 SUBMITTAL	JPS	8/22/18
E	EPC COMMENTS	JPS	1/15/19
F	EPC COMMENTS	JPS	9/12/19
G	EPC COMMENTS	JPS	1/31/20
H	EPC COMMENTS	JPS	9/07/20

MAYBERRY, COLORADO SPRINGS - FILING NO. 1

SIGNING & STRIPING PLAN

HORZ. SCALE:	NTS	DRAWN:	RMD
VERT. SCALE:	N/A	DESIGNED:	JPS
SURVEYED:	UP&E	CHECKED:	JPS
CREATED:	12/03/00	LAST MODIFIED:	9/07/20
PROJECT NO:	090001	MODIFIED BY:	BJJ

TS1

- NOTES:
1. PROVIDE ALL REQUIRED SIGNING & STRIPING PER MUTCD, CDOT, AND EL PASO COUNTY STANDARDS.
 2. ALL STRIPING SHALL BE EPOXY PAINT.
 3. REFER TO COUNTY SIGNING & STRIPING NOTES ON SH. G2