

LUMINAIRE SCHEDULE						
SYMBOL	QTY	LABEL	WATTS	LUMENS	LLF	CATALOG
●	4	T3	57	6425	0.900	GALN-SA1C-730-U-T3
●	4	T3-HSS	57	4757	0.900	GALN-SA1C-730-U-T3-HSS
●	10	T4	57	6483	0.900	GALN-SA1C-730-U-T4W
●	1	T5	57	6761	0.900	GALN-SA1C-730-U-5NG

CALCULATION SUMMARY						
LABEL	UNITS	AVG	MAX	MIN	AVG/MIN	MAX/MIN
PROPERTY LINE	Fc	0.04	0.1	0.0	N.A.	N.A.
SITE	Fc	0.06	2.4	0.0	N.A.	N.A.
DRIVE WAY	Fc	0.66	2.1	0.1	6.60	21.00

JEREMY J. EIDE  
REG. NO. 213096085

**PHOTOMETRIC SITE PLAN**  
SCALE: 1" = 50'-0"


**GENERAL PHOTOMETRY NOTES**

- A. THESE PHOTOMETRIC CALCULATIONS ARE BASED ON MANUFACTURER'S IES FILES AND 0.92 LIGHT DEPRECIATION FACTOR.
- B. ACTUAL ILLUMINANCE LEVELS MAY DIFFER FROM THE FOOTCANDLE LEVELS SHOWN DUE TO VARIABLE FIELD CONDITIONS, SUCH AS NEARBY EXISTING LUMINAIRES, LUMINAIRE DIRT DEPRECIATION, LANDSCAPING, AND FUTURE DEVELOPMENTS.
- C. THIS PLAN IS BASED ON THE INFORMATION AVAILABLE. THE LUMINAIRE LOCATIONS SHOWN MUST BE COORDINATED WITH EXISTING OR FUTURE FIELD CONDITIONS.
- D. ALL LUMINAIRES SHALL BE ON FROM DUSK TO DAWN.

Provide information box with:  
Owner name, telephone number and email address

**William Guman & Associates, Ltd.**  
URBAN PLANNING | COMMUNITY DESIGN | LANDSCAPE ARCHITECTURE  
731 North Weber Street  
Colorado Springs, CO 80903  
(719) 633-9700  
www.GumanLtd.com  
bill@guman.net

THIS DRAWING IS AN INSTRUMENT OF SERVICE AND SUCH REMAINS THE EXCLUSIVE PROPERTY OF WILLIAM GUMAN & ASSOCIATES, LTD. NO PART OF THIS DRAWING IS TO BE REPRODUCED OR TRANSMITTED IN ANY FORM OR BY ANY MEANS, ELECTRONIC OR MECHANICAL, INCLUDING PHOTOCOPYING, RECORDING, OR BY ANY INFORMATION STORAGE AND RETRIEVAL SYSTEM, WITHOUT THE WRITTEN PERMISSION OF WILLIAM GUMAN & ASSOCIATES, LTD. UNAUTHORIZED USE OF THIS DRAWING WITHOUT THE WRITTEN PERMISSION OF WILLIAM GUMAN & ASSOCIATES, LTD. IS PROHIBITED.

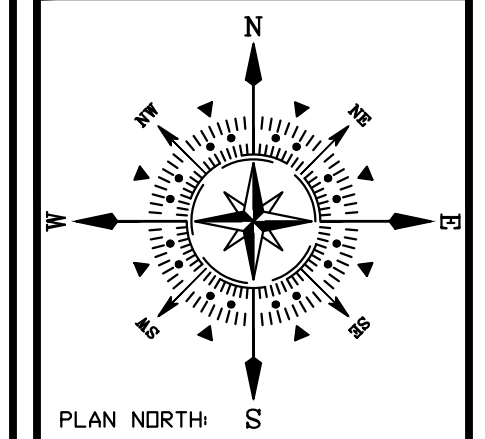

PROJECT NAME: VOLLMER ROAD RV AND BOAT STORAGE  
PROJECT ADDRESS: 8765 VOLLMER ROAD  
COLORADO SPRINGS, CO 80908  
PROJECT DESCRIPTION: DEVELOPMENTAL SITE PLAN

DATE: 07/08/2022  
DESIGNED: RSM  
CHECKED: MPP



DATE	BY	DESCRIPTION
07/08/22		PHOTOMETRY PLAN

NOTES:

PLAN SCALE: 1" = 50' (OR AS NOTED ON PLAN)

SHEET TITLE:  
**PHOTOMETRIC SITE PLAN**

SHEET NO.

**DP1**

1 OF 2 SHEETS  
FILE NO.

**PLANT**  
ENGINEERING CONSULTANTS  
320 W FILLMORE SUITE 100 COLORADO SPRINGS CO 80907  
719 473 7077  
www.planteci.com




# Lighting Plan\_V1.pdf Markup Summary

---

8/24/2022 9:37:47 AM (1)

---

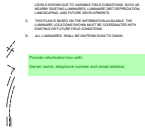

**Subject:** Text Box  
**Page Label:** [1] DP1 PHOTOMETRIC SITE PLAN  
**Author:** Linda.Nguyen  
**Date:** 8/24/2022 9:37:47 AM  
**Status:**  
**Color:** ■  
**Layer:**  
**Space:**

Provide information box with:

Owner name, telephone number and email address