

LANDSCAPE SETBACKS (or Double Frontage Lot Streetscapes)						
Street Name or Zone Boundary (elev.)	Street or Zone Boundary Classification	Setback Width (ft.) Req./Prov.	Prop. Line Dimension	Driveway Width	Req. Landscape Dimension (927.54'-24')	
VOLLMER ROAD	NON-ARTERIAL ADJ. TO RESIDENTIAL	15' / 15'	927.54	24'	903.54'	
Tree/Foot Req./Prov.	No. of Trees Req./Prov.	Evergreen Trees Req.(33%) / Prov.	Ornamental Grass Substitutes Required / Provided	Shrub Substitutes Required / Provided	Percent Ground Plane Req. / Provided	
1 / 15'	61 / 61	21 / 21	n/a	n/a	75% / 78%	

INTERNAL LANDSCAPING (POND)			
Net Site Area (SF) (less public R.O.W.)	Percent Min. Internal Area (%)	Internal Area (SF) Required / Provided	Internal Trees (1/500 SF) Required / Provided
181,645 SF (4.17 ac)	5%	9,082/17,424 (9%)	18 / 0'
Shrub Substitutes Required / Provided	Ornamental Grass Substitutes Required / Provided	Internal Plant Abbr. Denoted on Plan	Percent Ground Plane Veg. Req. / Provided
n/a	n/a		75%/75%


LANDSCAPE SETBACKS (Adjacent to Residential)			
Property Line	Adjacent Zoning	Buffer Depth Required	Length of Buffer
East	RS-5000	15'	523'
No. of Trees Req./Prov. (1/25 linear feet)	Evergreen Trees Req.(33%) / Prov.	Opaque Fence Required/Prov.**	
21 / 21	7 / 7	yes	

\* We are requesting relief from the PCD director regarding the internal tree requirement. There is no water source to provide establishment and necessary irrigation to sustain landscaping within the site. The site is a storage facility, not an RV park so no relief provided by tree canopy would be of benefit.

\*\* There is an existing 6' tall vinyl opaque fence a few feet east, and parallel to, our east property line providing visual buffer between our I-2 use and the neighboring RS-5000 residential. There is a proposed chain link fence on our side of the property located approximately 2 feet from and running parallel to the existing fence. The gap is to provide for maintenance.


**NOTE : ALL NEWLY INSTALLED LANDSCAPE MATERIAL WILL BE HAND WATERED UNTIL ITS ESTABLISHMENT. NO WATER EXISTS ON-SITE.**

### VICINITY MAP

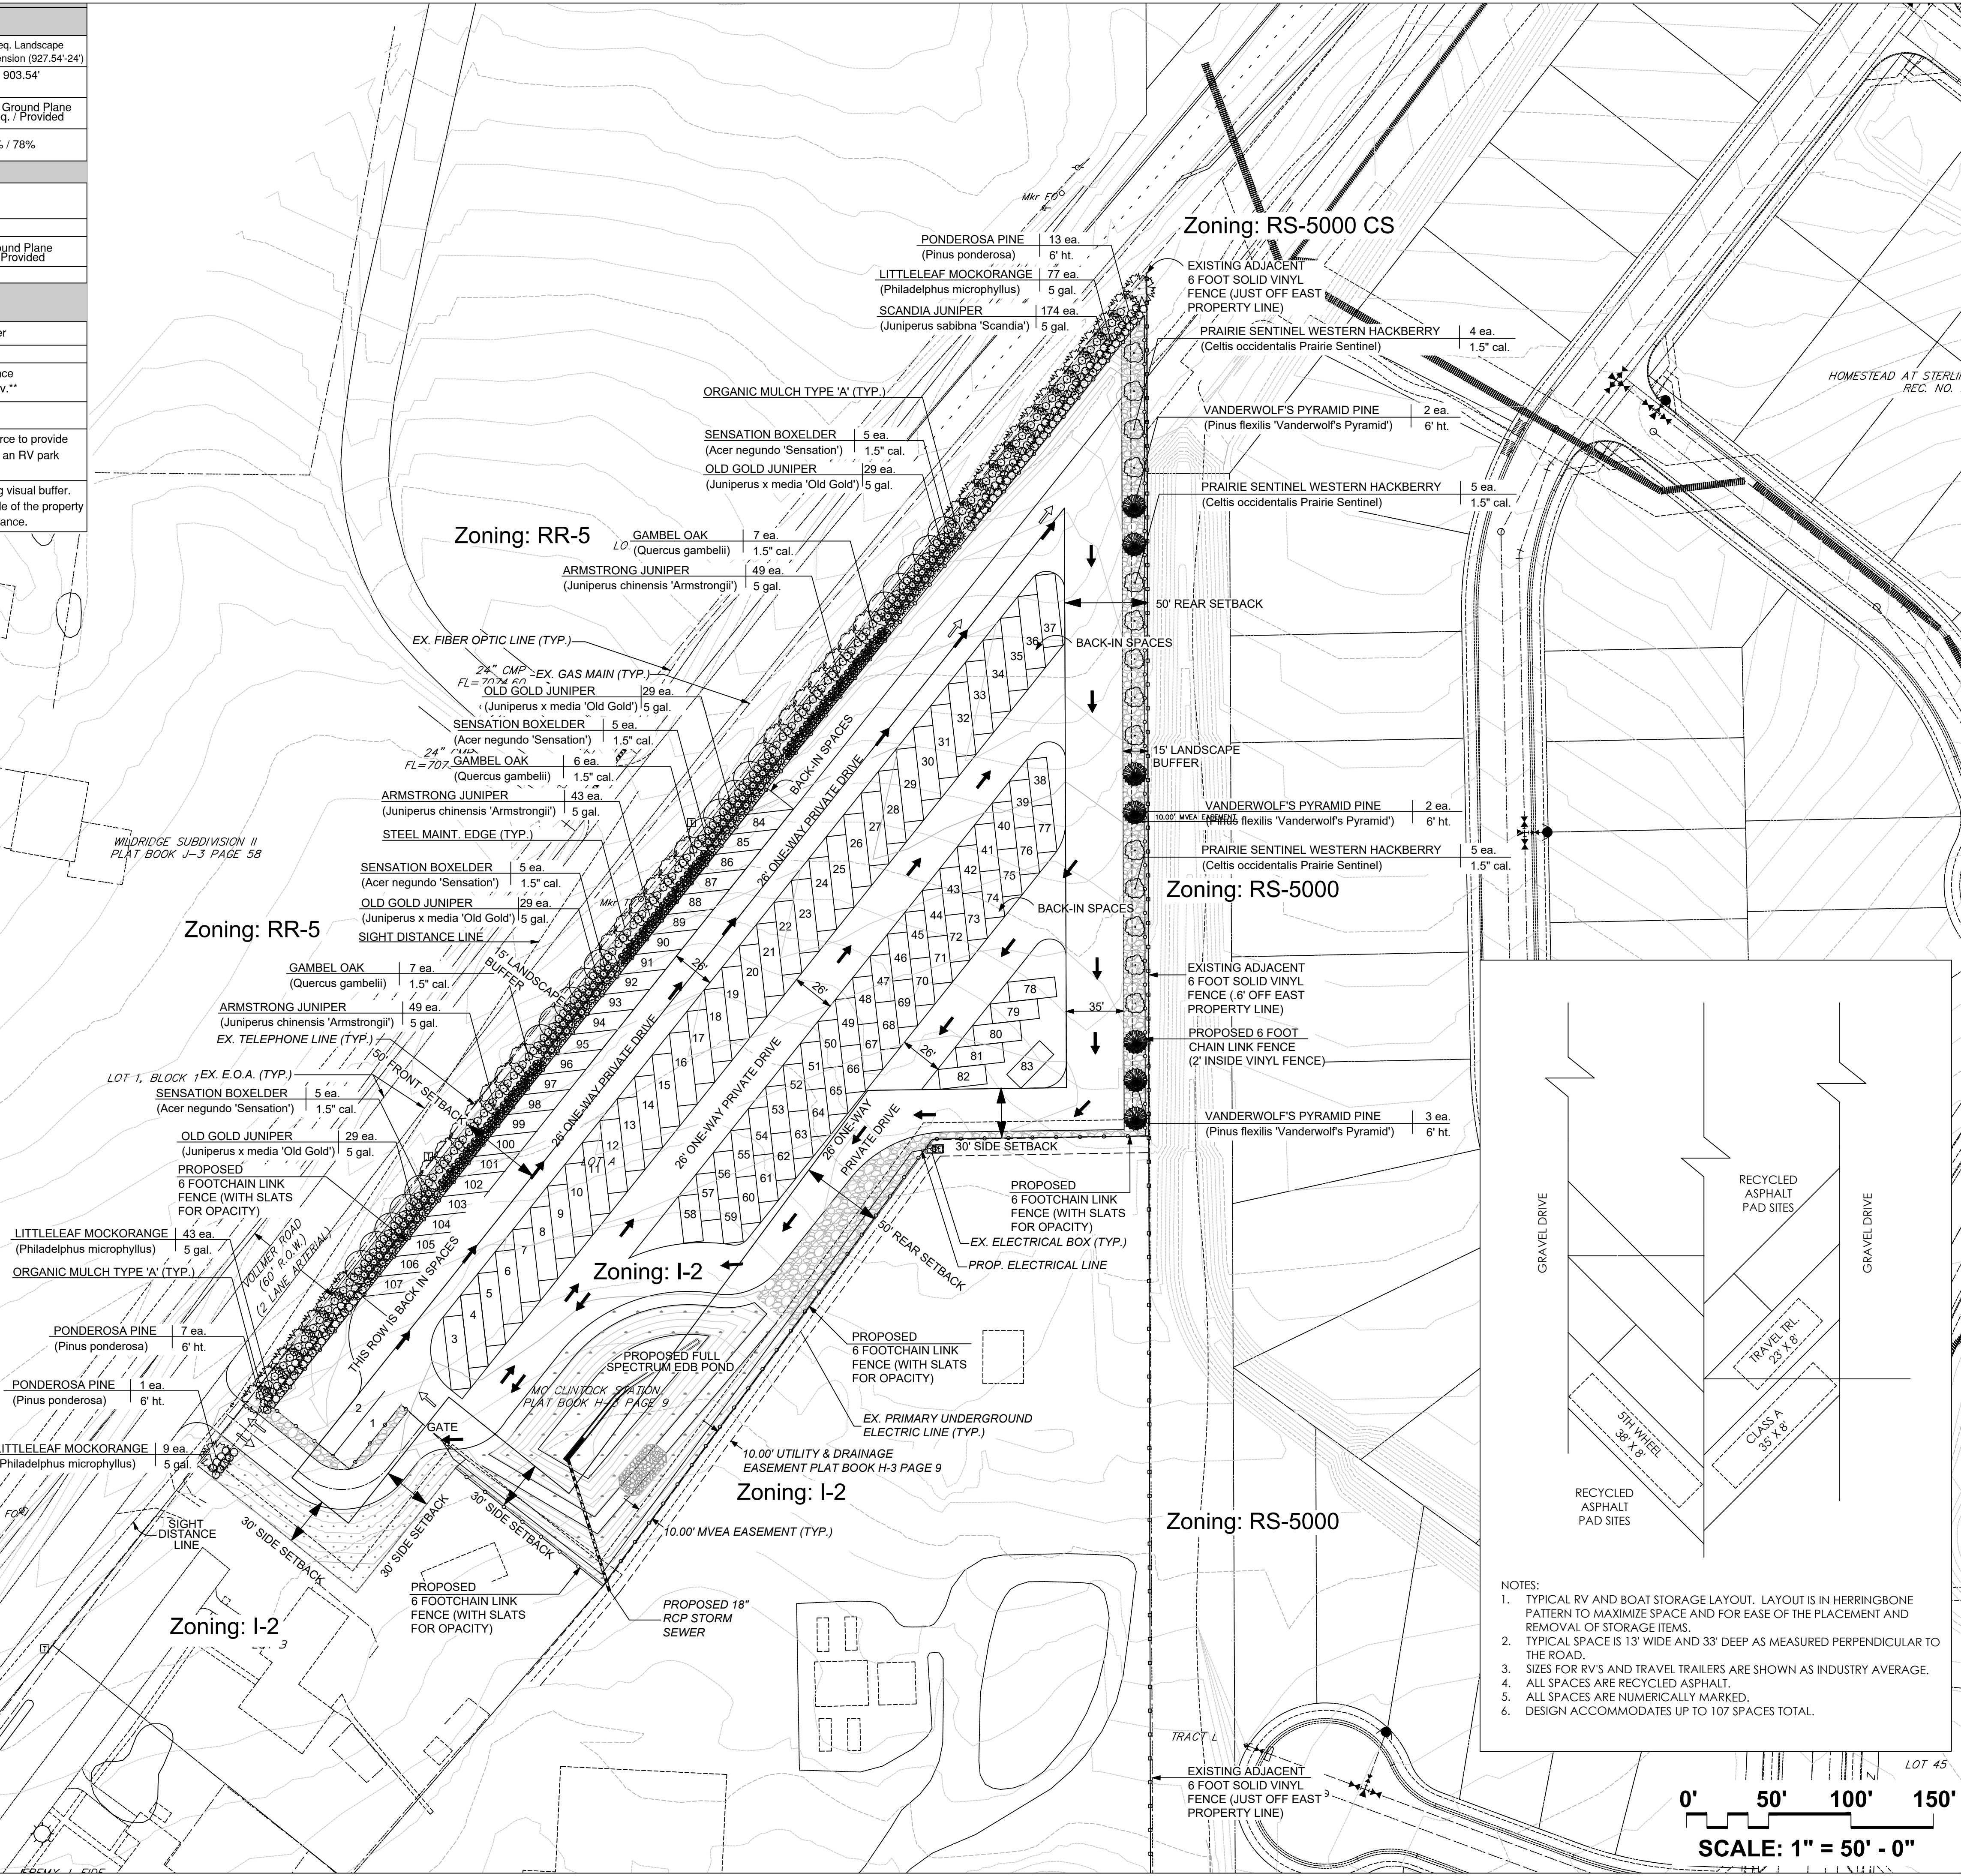

**William Guman & Associates, Ltd.**  
 LANDSCAPE ARCHITECTURE  
 731 North Weber Street  
 Colorado Springs, CO 80903  
 (719) 633-9700  
 www.GumanLtd.com  
 bill@guman.net

THIS DRAWING IS AN INSTRUMENT OF SERVICE AND AS SUCH REMAINS THE EXCLUSIVE PROPERTY OF WILLIAM GUMAN & ASSOCIATES, LTD. NO PART OF THIS DRAWING OR ANY INFORMATION HEREON IS TO BE REPRODUCED OR TRANSMITTED IN ANY FORM OR BY ANY MEANS, ELECTRONIC OR MECHANICAL, WITHOUT THE WRITTEN PERMISSION OF WILLIAM GUMAN & ASSOCIATES, LTD. ANY REPRODUCTION OR TRANSMISSION OF THIS DRAWING WITHOUT THE WRITTEN PERMISSION OF WILLIAM GUMAN & ASSOCIATES, LTD. IS PROHIBITED.

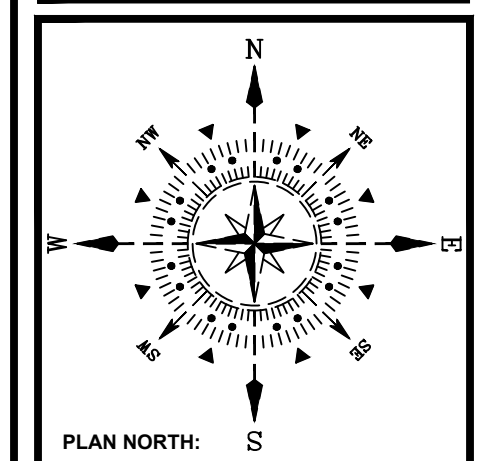

**VOLLMER ROAD RV AND BOAT STORAGE**  
 SCOTT BELLKNAP scott.bellknap@yahoo.com  
 PROJECT ADDRESS: 8815 VOLLMER ROAD  
 COLORADO SPRINGS, CO 80908  
 LANDSCAPE PLAN

DATE:	DESIGNED:	CHECKED:
07/14/2022	Est Morgan es3@guman.net (719) 633-9700	Bill Guman bill@guman.net (719) 633-9700

REVISIONS:	DATE:	BY:	DESCRIPTION:
R1	10/28/2022	GEM	1) RESPOND TO INITIAL COUNTY COMMENTS


PLAN SCALE: 1" = 50' (OR AS NOTED ON PLAN)

SHEET TITLE:  
**LANDSCAPE PLAN**

SHEET NO.  
**1**  
1 of 2 SHEETS

FILE NO.  
PPR-2245

- NOTES:
- TYPICAL RV AND BOAT STORAGE LAYOUT. LAYOUT IS IN HERRINGBONE PATTERN TO MAXIMIZE SPACE AND FOR EASE OF THE PLACEMENT AND REMOVAL OF STORAGE ITEMS.
  - TYPICAL SPACE IS 13' WIDE AND 33' DEEP AS MEASURED PERPENDICULAR TO THE ROAD.
  - SIZES FOR RV'S AND TRAVEL TRAILERS ARE SHOWN AS INDUSTRY AVERAGE.
  - ALL SPACES ARE RECYCLED ASPHALT.
  - ALL SPACES ARE NUMERICALLY MARKED.
  - DESIGN ACCOMMODATES UP TO 107 SPACES TOTAL.

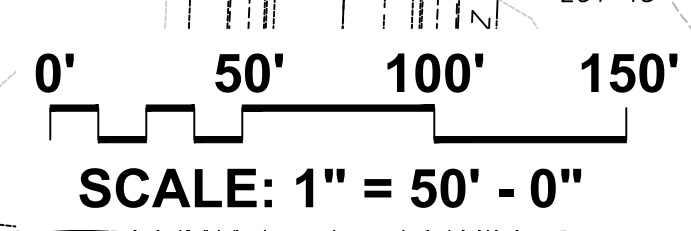

**LANDSCAPE SCHEDULE (Outlying Areas):**  
Planting Schedule:

QTY.	SYM.	KEY	DROUGHT TOLERANT DEER RESISTANT	BOTANICAL/COMMON NAME	MATURE HT./WD.	PLANTING SIZE	NOTES
20	(BJ)	[Symbol]	[Symbol]	HENNATIUM BUCKLEBER (Aster hennatiifolius)	30-35' 4-6'	1.5' cal.	B&B Nursery Crown. Size to meet or exceed AAN. min. size
21	(PP)	[Symbol]	[Symbol]	PONDEROSA PINE (Pinus ponderosa)	10-20' 10-20'	6' H.	B&B Nursery Crown. Size to meet or exceed AAN. min. size
20	(SO)	[Symbol]	[Symbol]	GAMBEL OAK (Quercus gambelii)	8-22' 8-12'	1.5' cal.	B&B Nursery Crown. Size to meet or exceed AAN. min. size
14	(HA)	[Symbol]	[Symbol]	PRAIRIE SENTINEL WESTERN HUCKBERRY (Celtis occidentalis Prairie Sentinel)	15-45' 15-17'	1.5' cal.	B&B Nursery Crown. Size to meet or exceed AAN. min. size
7	(VA)	[Symbol]	[Symbol]	VANDEWALD'S PRINCEBERRY (Prunella vanwaldfii)	18-20' 15-20'	6' H.	B&B Nursery Crown. Size to meet or exceed AAN. min. size

QTY.	SYM.	KEY	DROUGHT TOLERANT DEER RESISTANT	BOTANICAL/COMMON NAME	MATURE HT./WD.	PLANTING SIZE	NOTES
116	(OG)	[Symbol]	[Symbol]	OLD GOLD JUNIPER (Juniperus x media Old Gold)	3-4' 4-6'	5 gal.	Container Crown. Size to meet or exceed AAN. min. size
129	(MO)	[Symbol]	[Symbol]	LITTLELEAF MOCKORANGE (Forsythia minor)	4-6' 4-6'	5 gal.	Container Crown. Size to meet or exceed AAN. min. size
141	(AJ)	[Symbol]	[Symbol]	ARMSTRONG JUNIPER (Juniperus chinensis Armstrong)	3-4' 3-4'	5 gal.	Container Crown. Size to meet or exceed AAN. min. size
174	(SA)	[Symbol]	[Symbol]	SCANDIA JUNIPER (Juniperus sabina Scandia)	18-24' 4-6'	5 gal.	Container Crown. Size to meet or exceed AAN. min. size

**GRASSES, PERENNIALS, GROUNDCOVERS**


QTY.	SYM.	KEY	DROUGHT TOLERANT DEER RESISTANT	BOTANICAL/COMMON NAME	MATURE HT./WD.	PLANTING SIZE	NOTES

**SYMBOL KEY:**


SYMBOL	DESCRIPTION/REMARKS
[Line symbol]	STEEL MAINTENANCE EDGE; 3/16" x 4" ROLL TOP STEEL, GREEN COLOR
[No symbol]	IDAHO CEDAR WOOD MULCH: UNIFORMLY PLACED TO A 4" DEPTH AROUND ALL TREE ROOT BALLS IN TURF AREAS ONLY [Equal to that supplied by Pioneer Sand and Gravel, Colorado Springs, CO]
[Pattern symbol]	ORGANIC MULCH TYPE 'A': 'DECO SHRED' BARK MULCH, PLACED TO A UNIFORM 3" DEPTH ON FABRIC UNDERLAYMENT [Equal to that supplied by Pioneer Sand and Gravel, Colorado Springs, CO]
[Pattern symbol]	NEW SOD: FESCUE/ HTN KENTUCKY BLUEGRASS 4-WAY BLEND ON PREPARED SOIL.
[Pattern symbol]	AGGREGATE 'A': 1-1/2" SIZE WHOLE WASHED WHITE RIVER ROCK PLACED TO A UNIFORM DEPTH OF 3" ON FABRIC UNDERLAYMENT. [Equal to that supplied by Pioneer Sand and Gravel, Colorado Springs, CO] TOTAL AREA = 12,094 SQUARE FEET
[Pattern symbol]	SEEDED TURF (El Paso County Conservation District All Purpose Mix for Upland, Transition and Permanent Control Measure Areas): [20% BIG BLUESTEM, 10% BLUE GRAMA, 10% GREEN NEEDLEGRASS, 20% WESTERN WHEATGRASS, 10% SIDEGRASS GRAMA, 10% SWITCHGRASS, 10% PRAIRIE SAND REED, 10% YELLOW INDIAN GRASS] Seed rate (lbs PLS/acre) : 19.3 irrigated broadcast or irrigated hydroseeded. TOTAL AREA = 17,424 SQUARE FEET
[Pattern symbol]	SEEDED TURF (El Paso County All Purpose Low Grow Mix for Upland and Transition Areas): [25% BUFFALOGRASS, 20% BLUE GRAMA, 20% SIDEGRASS GRAMA, 5% GREEN NEEDLEGRASS, 20% WESTERN WHEATGRASS, 10% SAND DROPSSEED] Seed rate (lbs PLS/acre) : 42 irrigated broadcast or irrigated hydroseeded. TOTAL AREA = 4,683 SQUARE FEET
[Symbol]	PLANTED BOULDERS: Equal to Siloam quarried boulders (Canon City, CO), avg. 3' width, set in grade w/ 18-24" ht. exposed above grade (Per Detail).

**LANDSCAPE NOTES:**

- REFER TO SPECIFICATION SECTION 32-94-00: LANDSCAPE ACCESSORIES FOR REQUIRED INSTALLATION AND WORKMANSHIP STANDARDS FOR NEW LANDSCAPING. IN THE EVENT OF A CONFLICT THE REQUIREMENTS THE MOST STRINGENT INTERPRETATION WILL PREVAIL.
- DRAWINGS ARE DIAGRAMMATIC. PRECISE PLACEMENT OF LANDSCAPE ACCESSORIES MAY NOT BE POSSIBLE AS INDICATED. CONSULT PROJECT LANDSCAPE ARCHITECT PRIOR TO MAKING RANDOM FIELD CHANGES WHICH MAY ALTER DESIGN INTENT.
- QUANTITIES ARE PROVIDED FOR REFERENCE ONLY. VERIFY ALL QUANTITIES PRIOR TO SUBMITTING COST PROPOSAL. IN THE EVENT OF A CONFLICT BETWEEN SCHEDULED, IMPLIED OR EXPRESSED QUANTITIES WHICH CAN BE DETERMINED GRAPHICALLY FROM THE DRAWINGS WILL PREVAIL IN ANY CASE.
- THE CONTRACTOR IS RESPONSIBLE FOR INSPECTION AND VERIFICATION OF ALL FIELD CONDITIONS AND RESOLVING CONFLICTS PERTAINING TO DIMENSIONS, LAYOUT, ETC., WHICH MAY AFFECT THE LANDSCAPE INSTALLATION. MOBILIZING SHALL BE CONSTRUED AS ACCEPTANCE OF CONDITIONS.
- COORDINATE ALL WORK INDICATED ON THESE DRAWINGS WITH WORK OF OTHER TRADES.
- THE PROJECT LANDSCAPE ARCHITECT RESERVES THE RIGHT TO CONSIDER AND APPROVE ALTERNATE INSTALLATIONS AT ANY TIME WHICH IN THE LANDSCAPE ARCHITECT'S OPINION MAXIMIZES THE CONSTRUCTION BUDGET AND MAINTAINS DESIGN INTENT.
- PROVIDE A 3 FOOT CLEAR SPACE AROUND THE CIRCUMFERENCE AROUND ALL FIRE HYDRANTS AND LIGHTING STANDARDS.
- CONTRACTOR TO UTILIZE STOCKPILED TOPSOIL FROM GRADING OPERATION AS MAY BE AVAILABLE. IF THE AMOUNT OF TOPSOIL NEEDED TO COMPLETE FINAL GRADING IS NOT AVAILABLE, THE CONTRACTOR SHALL IMPORT THE AMOUNT OF SOIL NEEDED.
- CONTRACTOR SHALL ENSURE THAT PROPER IRRIGATION VIA THE IRRIGATION SYSTEM IS CAPABLE OF EXTENDING AMOUNTS OF WATER REQUIRED TO ESTABLISH AND SUSTAIN PLANT GROWTH AT THE TIME OF INSTALLATION.
- ALL LANDSCAPE AND IRRIGATION MAINTENANCE SHALL BE COMMENCED BY THE OWNER UPON COMPLETION AND FINAL ACCEPTANCE OF ALL LANDSCAPE AND IRRIGATION SYSTEM INSTALLATIONS.
- SOIL AMENDMENT AND FINAL GRADING FOR ALL SOD AND SEEDED TURF AREAS TO BE PROVIDED IN ACCORDANCE WITH SPECIFICATIONS.
- AN AUTOMATIC UNDERGROUND IRRIGATION SYSTEM IS TO BE PROVIDED AND INSTALLED IN ACCORDANCE WITH THE IRRIGATION SYSTEM DRAWING AND SPECIFICATIONS:
  - A. IN LANDSCAPE SETBACK AREAS ALONG ROAD FRONTAGES; IN-LINE DRIP EMITTER RINGS FOR ALL TREES.
  - B. NEW SEEDED TURF INTERIOR LANDSCAPE AREAS; 20' ROTOR SPRINKLERS AND POP-UP SPRAY SPRINKLERS.
  - C. NEW SEEDED TURF AREAS; 30' ROTOR SPRINKLERS AND POP-UP SPRAY SPRINKLERS SHRUBS AND TREES; IN-LINE DRIP EMITTER RINGS FOR ALL TREES, EMITTERS FOR ALL SHRUBS.
- 4"x14 GAUGE GALVANIZED STEEL MAINTENANCE EDGING TO BE INSTALLED TO SEPARATE ALL ORGANIC AND AGGREGATE MULCHES FROM ADJACENT SOD AND SEEDED TURF AREAS. PIN EDGING WITH 1/2" STEEL EDGING PINS AT 24" SPACING.
- ALL PLANT MATERIAL TO BE INSTALLED PER DETAILS AND SPECIFICATIONS. GUY AND STAKE ALL DECIDUOUS AND EVERGREEN TREES PER DETAILS. PROVIDE SHREDDED MULCH RINGS IN RETENTION BASINS AROUND ALL TREES PLANTED IN SOD AND SEEDED AREAS (MULCH RINGS ARE NOT REQUIRED FOR TREES PLANTED IN AGGREGATE MULCH AREAS).
- PLANT QUANTITIES AND SIZES INDICATED ARE THE MINIMUM TO SATISFY LANDSCAPE CODE REQUIREMENTS; NO SUBSTITUTIONS ARE PERMITTED WITHOUT PRIOR APPROVAL OF THE MUNICIPAL REVIEWING AGENCY.

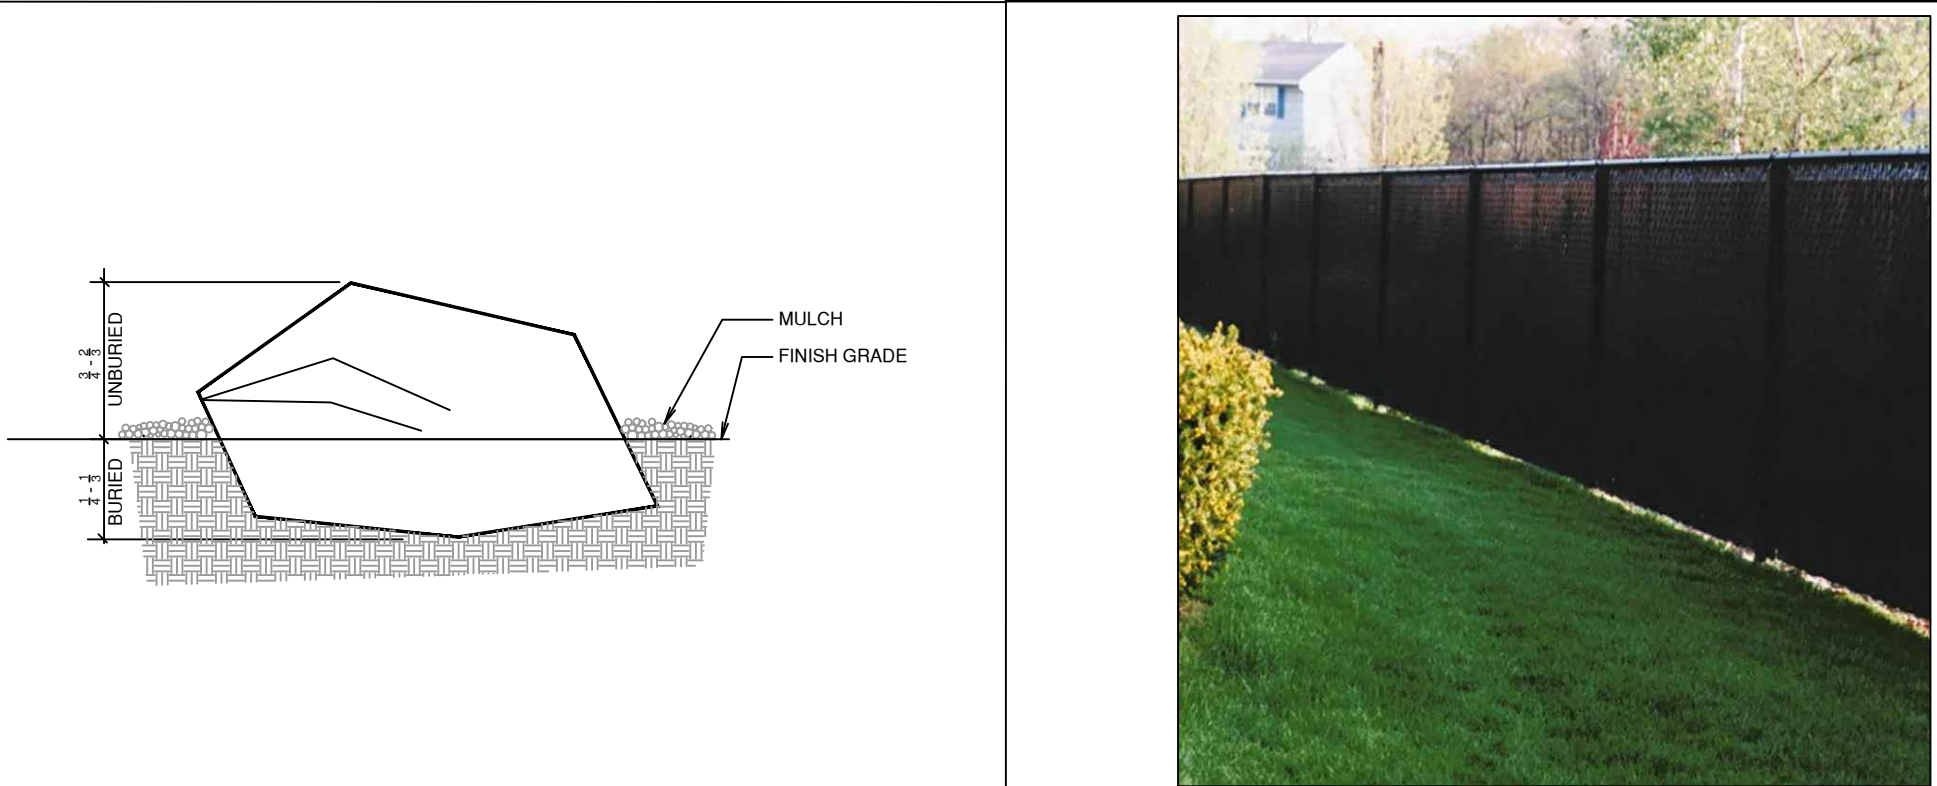

**A PLANTED BOULDER**  
NOT TO SCALE

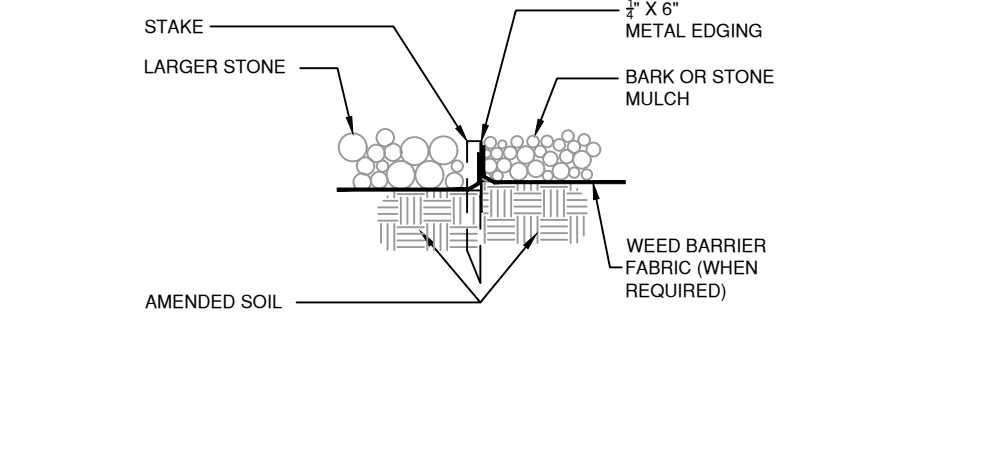


**B STEEL MAINTENANCE EDGE**  
NOT TO SCALE




**F CHAIN LINK FENCE WITH SLATS**  
NOT TO SCALE




**G CHAIN LINK FENCE WITH SLATS CONNECTION DETAIL**  
NOT TO SCALE

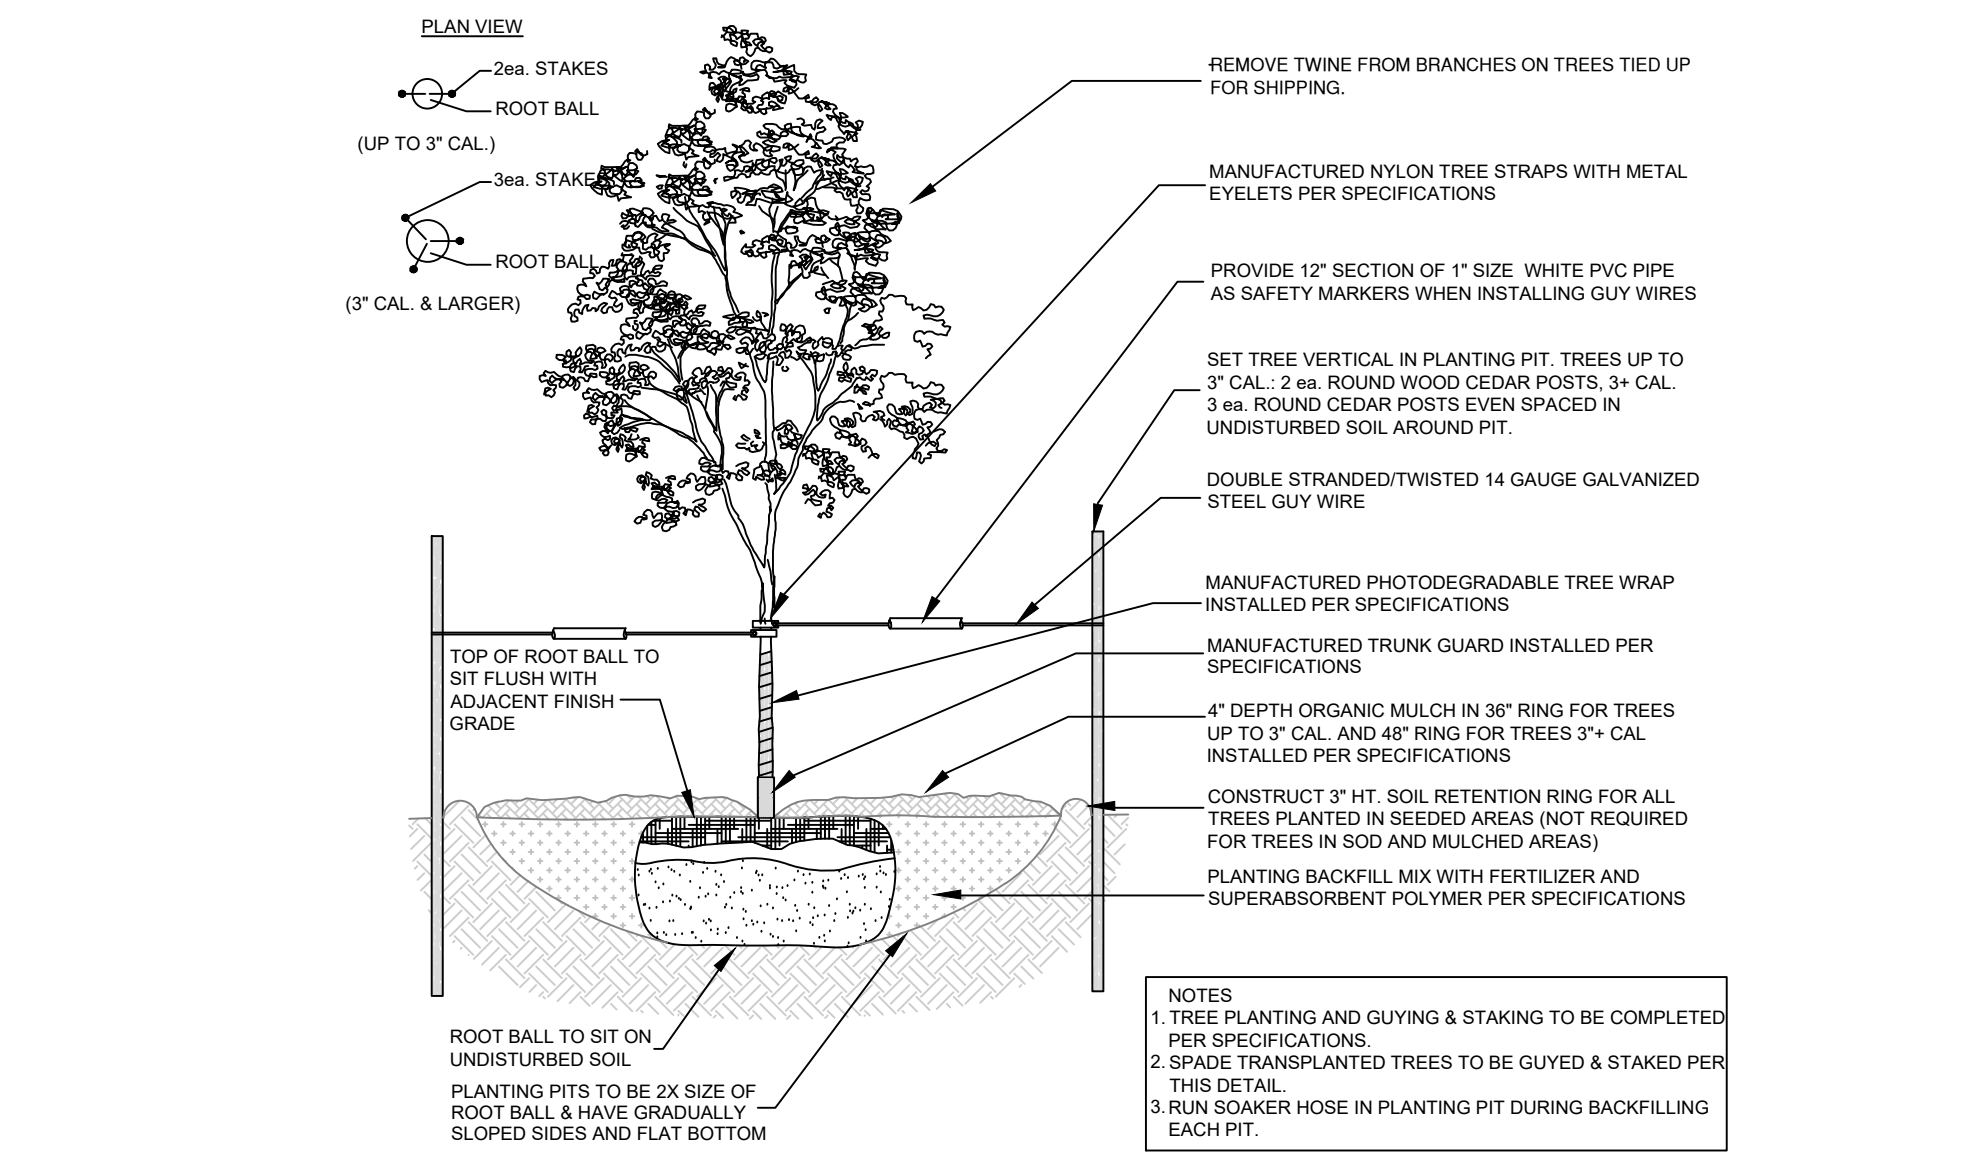

**C DECIDUOUS TREE PLANTING DETAIL**  
NOT TO SCALE

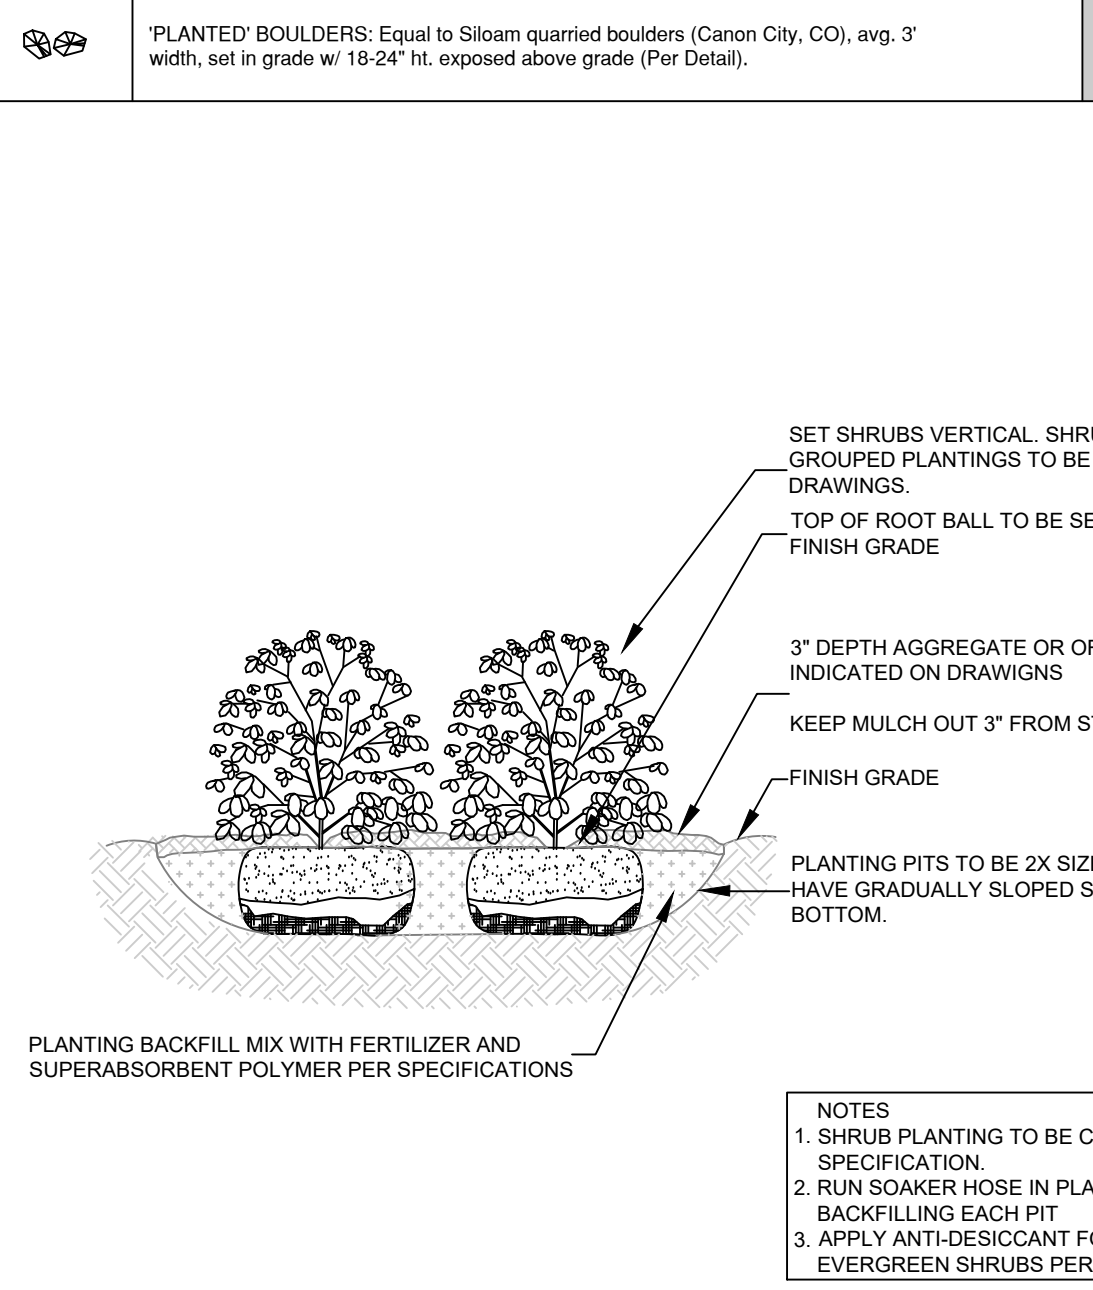

**D SHRUB PLANTING DETAIL**  
NOT TO SCALE

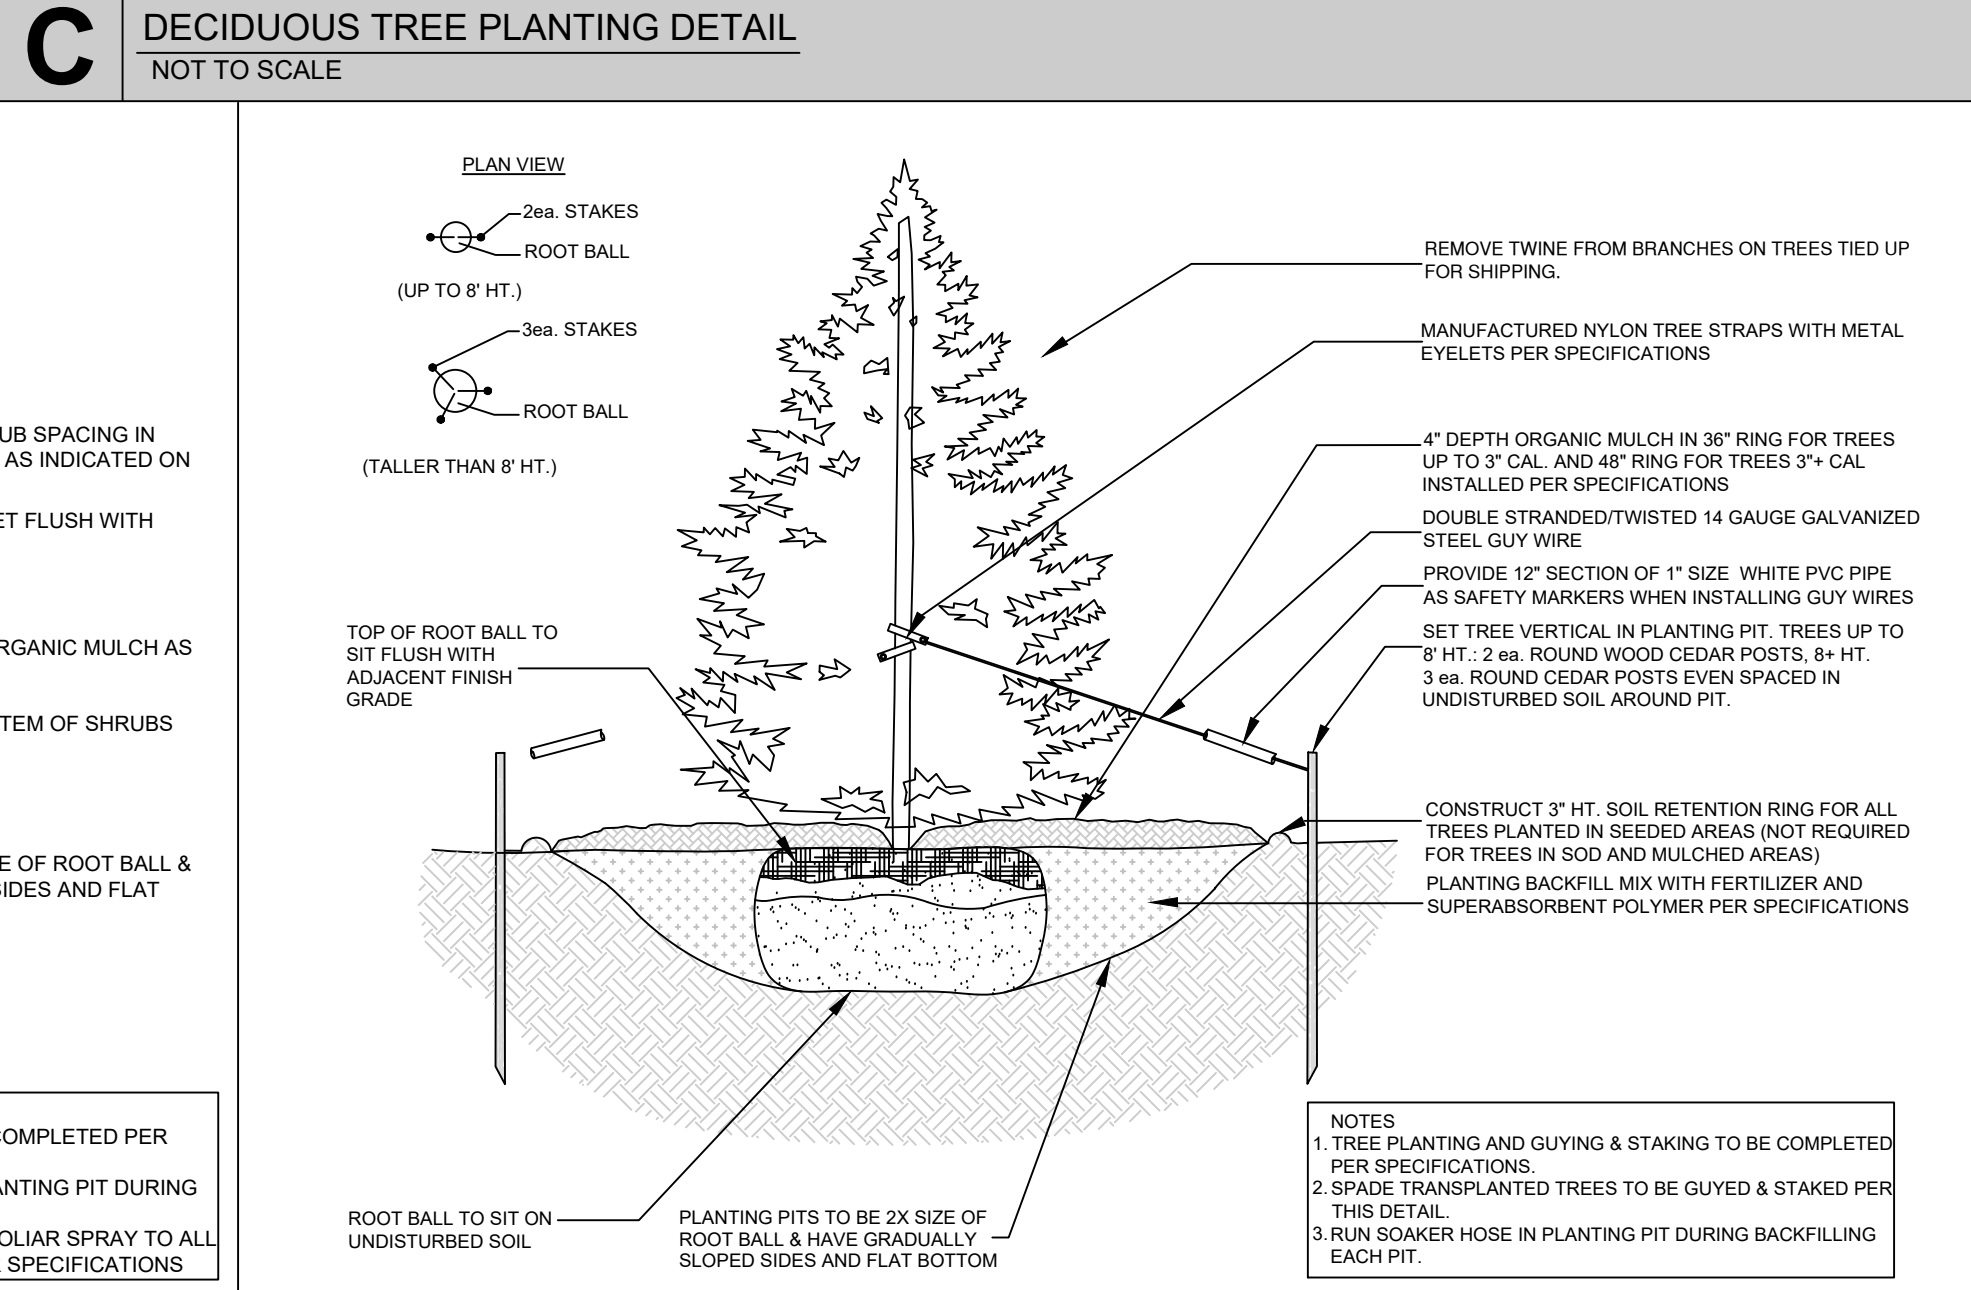

**E EVERGREEN TREE PLANTING DETAIL**  
NOT TO SCALE


Provide owner name, contact information to match sheet 1

Update to Landscape Plan

Update to match sheet 1

**William Guman & Associates, Ltd.**  
LANDSCAPE ARCHITECTURE  
731 North Weber Street  
Colorado Springs, CO 80903  
(719) 633-9700  
www.gumanltd.com  
bill@gumanltd.com

THIS DRAWING IS AN INSTRUMENT OF SERVICE AND SUCH REMAINS THE EXCLUSIVE PROPERTY OF WILLIAM GUMAN & ASSOCIATES, LTD. NO PART OF THIS DRAWING OR INSTRUMENT IS TO BE REPRODUCED OR TRANSMITTED IN ANY FORM OR BY ANY MEANS, ELECTRONIC OR MECHANICAL, INCLUDING PHOTOCOPYING, RECORDING, OR BY ANY INFORMATION STORAGE AND RETRIEVAL SYSTEM, WITHOUT THE WRITTEN PERMISSION OF WILLIAM GUMAN & ASSOCIATES, LTD. ANY REPRODUCTION OR TRANSMISSION WITHOUT THE WRITTEN PERMISSION OF WILLIAM GUMAN & ASSOCIATES, LTD. IS PROHIBITED. ANY UNAUTHORIZED USE OF THIS DRAWING WITHOUT THE WRITTEN PERMISSION OF WILLIAM GUMAN & ASSOCIATES, LTD. IS PROHIBITED.

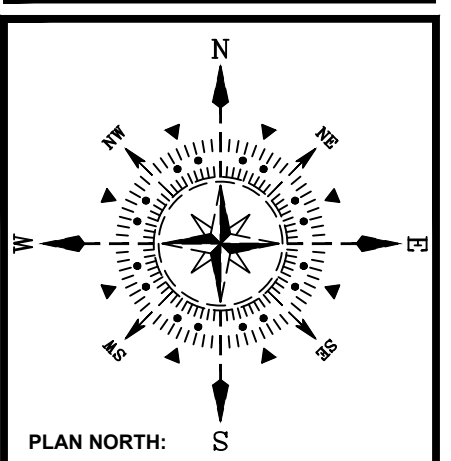

PROJECT NAME: **VOLLMER ROAD RV AND BOAT STORAGE**  
PROJECT ADDRESS: **8815 VOLLMER ROAD, COLORADO SPRINGS, CO 80908**  
PROJECT DESCRIPTION: **SITE PLAN**

DATE:	07/14/2022
DESIGNED:	WFG
CHECKED:	GEM

REVISIONS:	DATE:	BY:	DESCRIPTION:
R1	10/28/2022	GEM	1) RESPOND TO INITIAL COUNTY COMMENTS


PLAN SCALE: \_\_\_\_\_  
SHEET TITLE: **LANDSCAPE DETAILS**  
SHEET NO. **2**  
2 OF 2 SHEETS  
FILE NO. **PPR-2245**

# Landscape Plan Drawings\_V2.pdf Markup Summary

---

11/21/2022 4:19:01 PM (1)

---

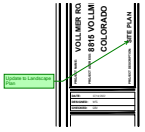


**Subject:** Callout  
**Page Label:** [2] Vollmer Road RV and Boat Storage LS\_IR alt Update to Landscape Plan  
9-LS2  
**Author:** Linda.Nguyen  
**Date:** 11/21/2022 4:19:01 PM  
**Status:**  
**Color:** ■  
**Layer:**  
**Space:**

---

11/21/2022 4:20:10 PM (1)

---

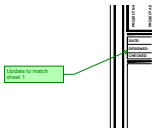


**Subject:** Callout  
**Page Label:** [2] Vollmer Road RV and Boat Storage LS\_IR alt Update to match sheet 1  
9-LS2  
**Author:** Linda.Nguyen  
**Date:** 11/21/2022 4:20:10 PM  
**Status:**  
**Color:** ■  
**Layer:**  
**Space:**

---

11/21/2022 4:20:14 PM (1)

---

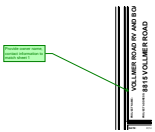

**Subject:** Callout  
**Page Label:** [2] Vollmer Road RV and Boat Storage LS\_IR alt Provide owner name, contact information to match sheet 1  
9-LS2  
**Author:** Linda.Nguyen  
**Date:** 11/21/2022 4:20:14 PM  
**Status:**  
**Color:** ■  
**Layer:**  
**Space:**