

of this review for the noise

Constitution Ave within 150 feet


tures of officers signing for a corporation shall be

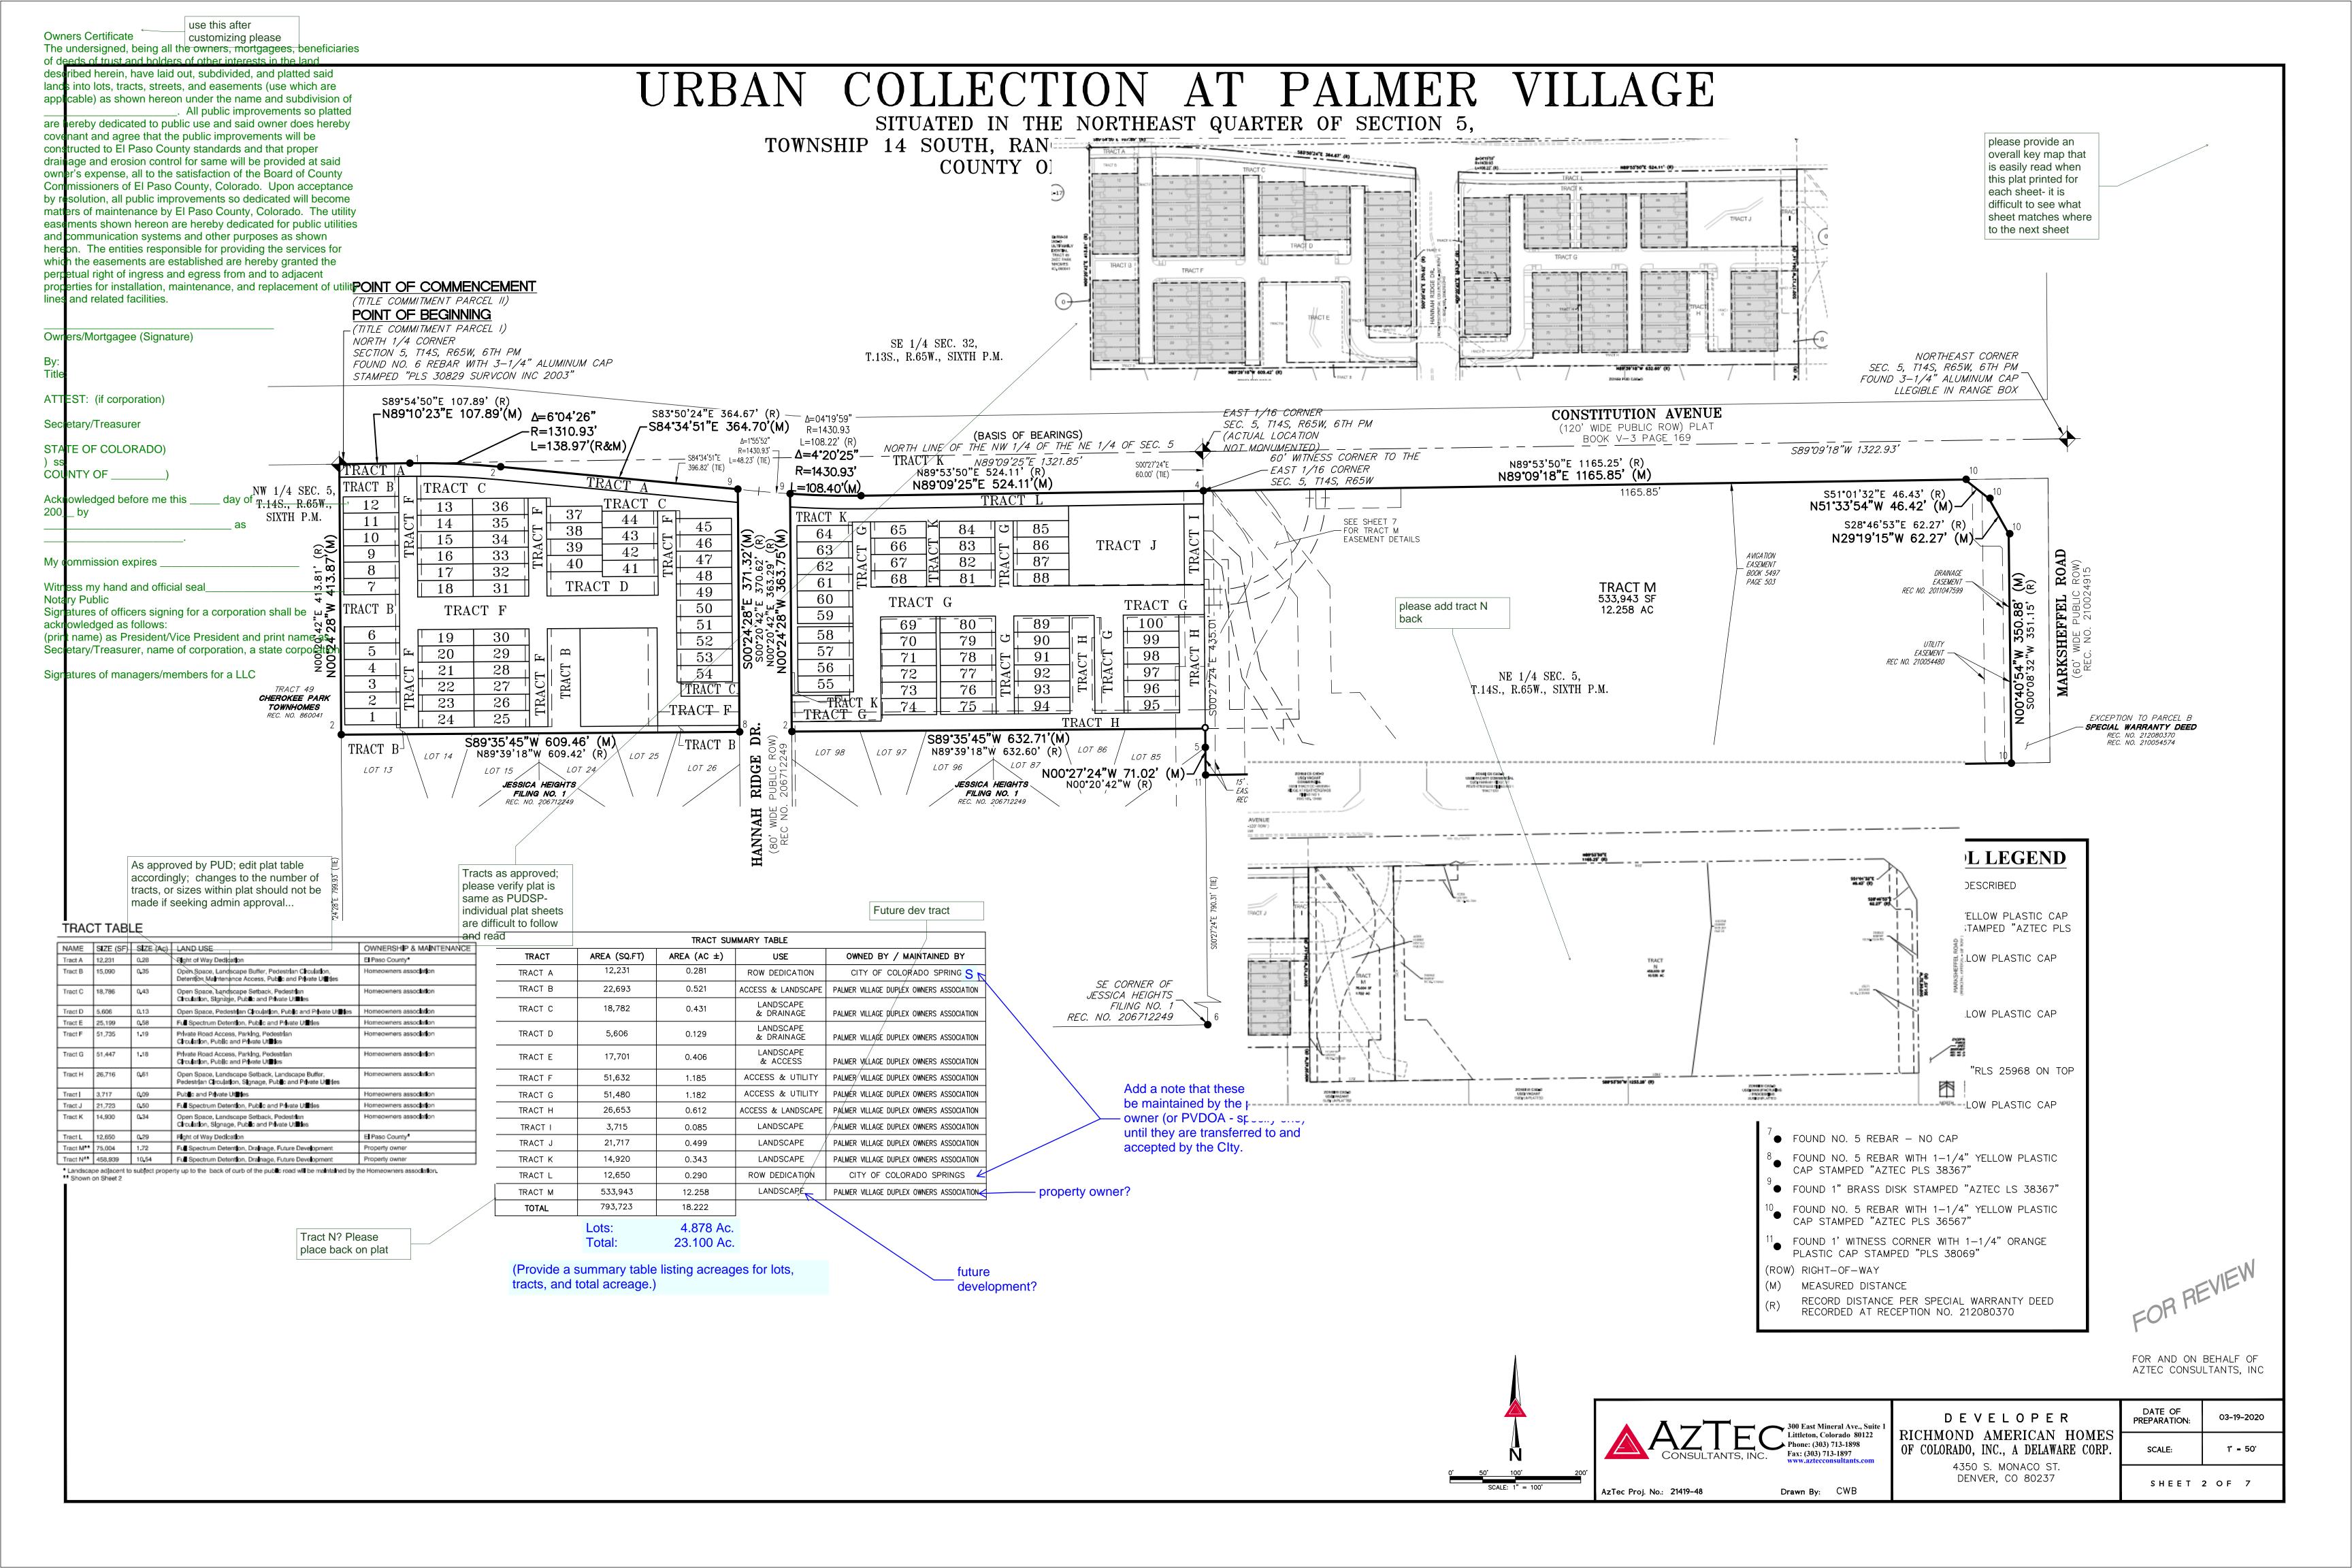


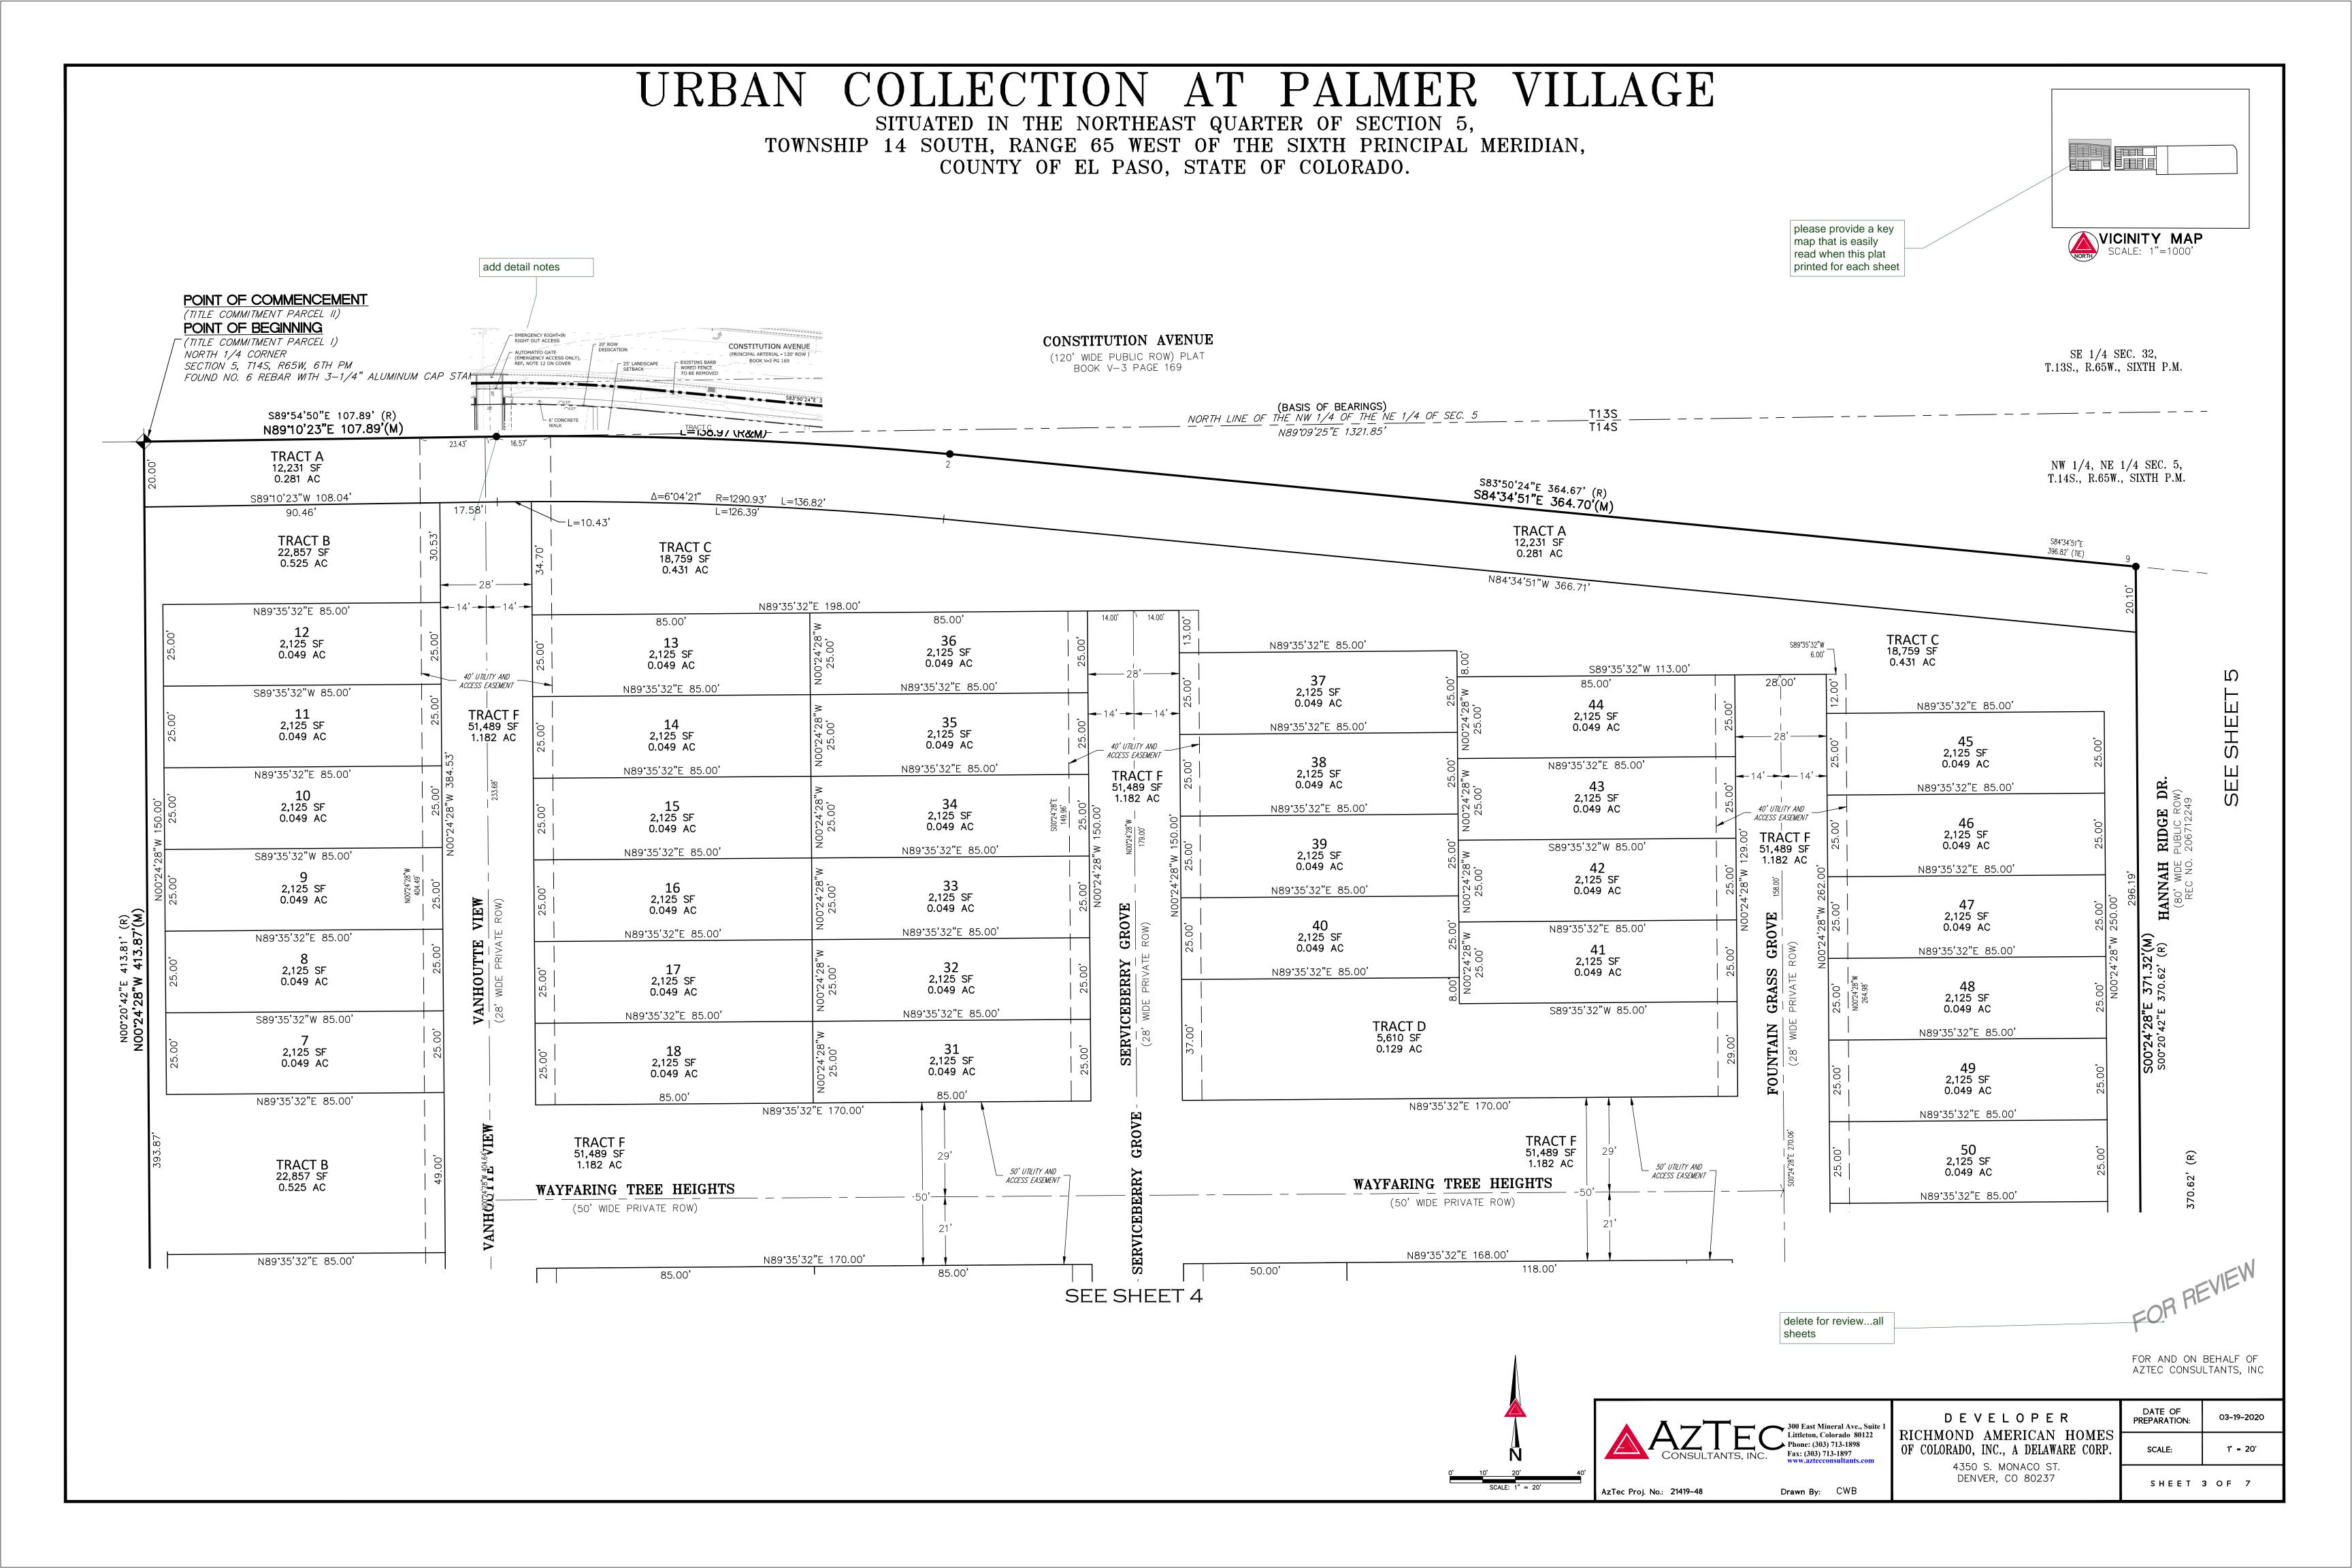


URBAN COLLECTION AT PALMER VILLAGE


SITUATED IN THE NORTHEAST QUARTER OF SECTION 5, TOWNSHIP 14 SOUTH, RANGE 65 WEST OF THE SIXTH PRINCIPAL MERIDIAN, COUNTY OF EL PASO, STATE OF COLORADO.

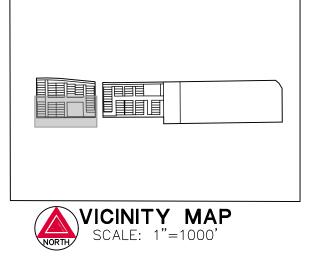

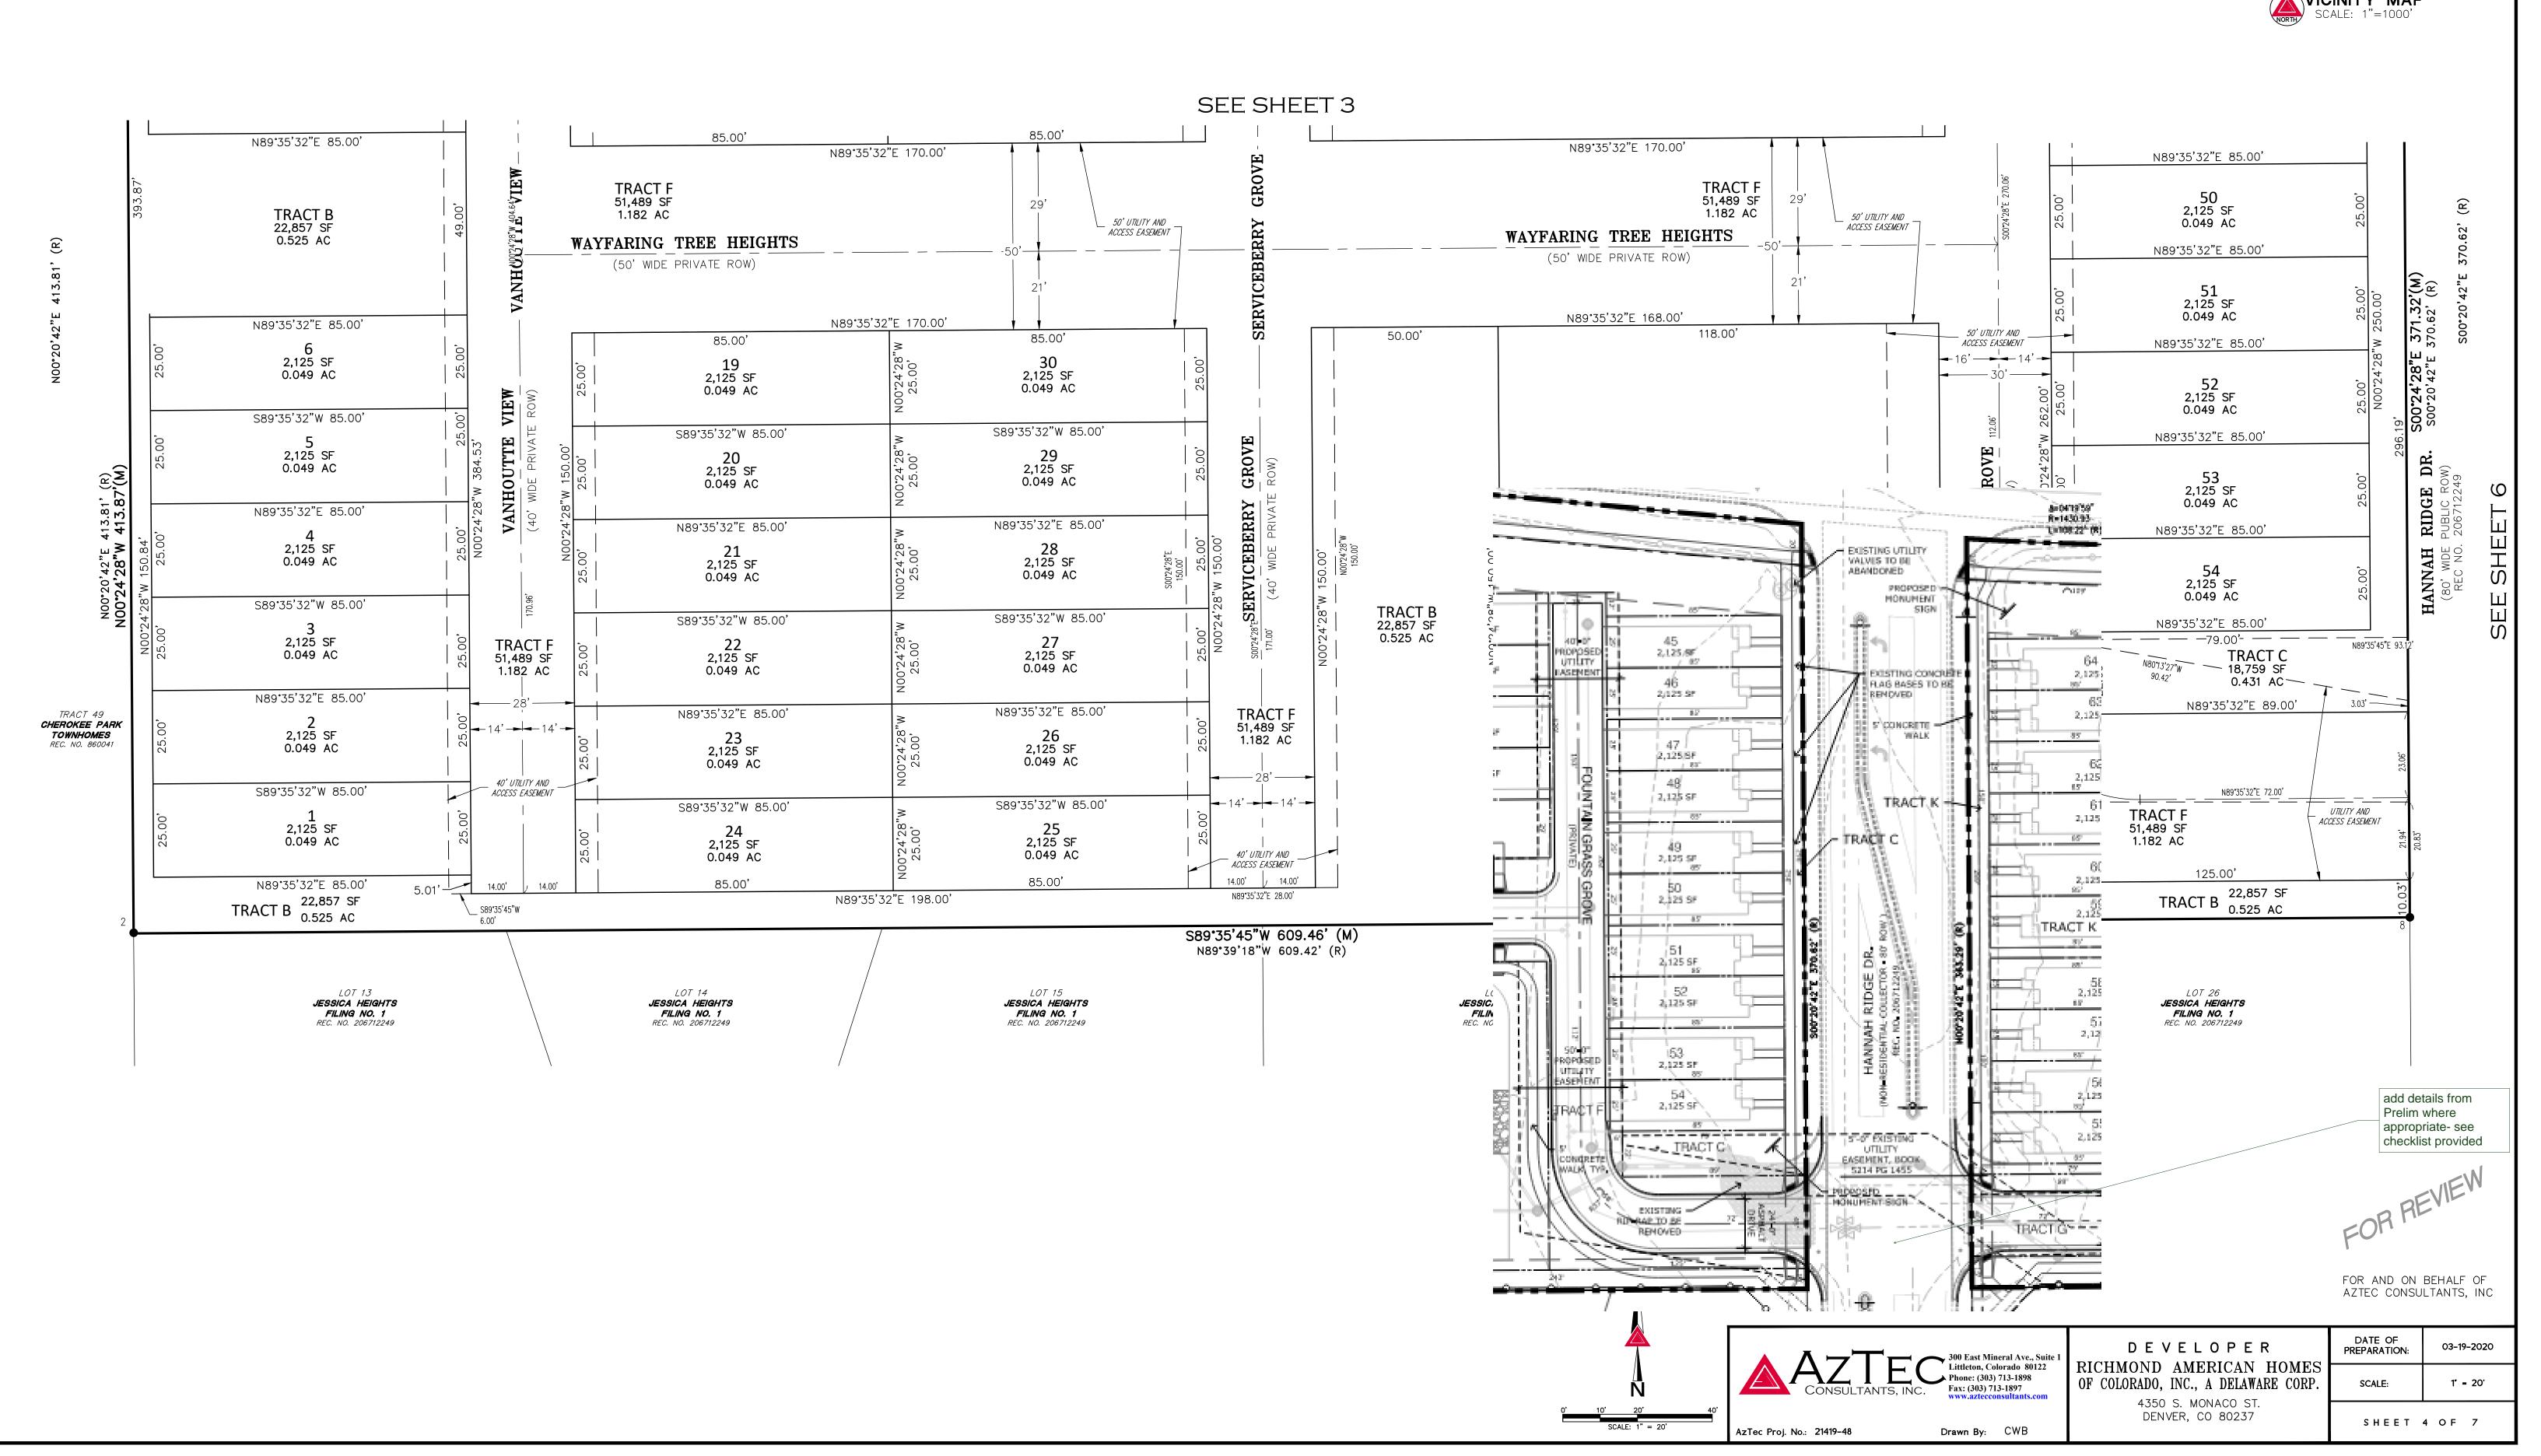

URBAN COLLECTION AT SITUATED IN THE NORTHEAST QUARTER OF SECTION 5, TOWNSHIP 14 SOUTH, RANGE 65 WEST OF THE SIXTH PRINCIPAL MERIDIAN, COUNTY OF EL PASO, STATE OF COLORADO. VICINITY MAP SCALE: 1"=1000" CONSTITUTION AVENUE SE 1/4 SEC. 32, (120' WIDE PUBLIC ROW) PLAT T.13S., R.65W., SIXTH P.M. BOOK V-3 PAGE 169 (BASIS OF BEARINGS) (BASIS OF BEARINGS). NORTH LINE OF THE NW 1/4 OF MARTINELINE OF THE C.NW 1/4 OF THE NE 1/4 OF SEC. 5 EAST 1/16 CORNER SEC. 5, T14S, R65W, 6TH PM (ACTUAL LOCATION NOT MONUMENTED) N89°09'25"E 1321.85' NW 1/4, NE 1/4 SEC. 5, T.14S., R.65W., SIXTH P.M. CONSTITUTION AVENUE (120' WIDE PUBLIC ROW) PLAT BOOK V—3 PAGE 169 ∆=1°55'52" ___ R=1430.93' L=48.23' (TIE) ∆=04°19'59" 60' WITNESS CORNER TO THE POINT OF BEGINNING R=1430.93 NE 1/ EAST 1/16 CORN SEC. 5, T14S, R6 (TITLE COMMITMENT PARCEL II) L=108.22' (R) T.14S., R.65 Δ=4°20'25" N89°53'50"E 524.11' (R) N89°09'25"E 524.11'(M) R=1430.93' L=108.40'(M)TRACT L 12,650 SF 0.290 AC N89°09'25"E 524.02' 30.00' $\Delta = 4^{\circ}17'04''$ R=1450.93' L=108.50' 176.42 317.60' TRACT K 14,929 SF 0.343 AC N89°35'32"E 198.00' N89°35'32"E 113.00' 14.00' 14.00' 6.00' 85.00' 85.00' 85.00' 14.00' 85 2,125 SF 84 2,125 SF TRACT G S89°35'32"W 85.00' 65 2,125 SF 51,460 SF 51,460 SF 1.181 AC 64 2,125 SF 0.049 AC 0.049 AC 1.181 AC 0.049 AC 0.049 AC S89°35'32"W 85.00' TRACT I 3,716 SF 0.085 AC TRACT J 21,723 SF 0.499 AC 86 2,125 SF 83 2,125 SF 66 2,125 SF S89°35'32"W 85.00' 0.049 AC 0.049 AC 0.049 AC 2,125 SF 0.049 AC N89°35'32"E 85.00' N89°35'32"E 85.00' N89°35'32"E 85.00' 82 2,125 SF S89°35'32"W 85.00' 2,125 SF 2,125 SF 30' RESERVATION 62 2,125 SF 0.049 AC 0.049 AC 0.049 AC BOOK 2058 PAGE 257 40' UTILITY AND 363.29° **363.7**° 0.049 AC ACCESS EASEMENT 40' UTILITY AND S89°35'32"W 85.00' ACCESS EASEMENT S89°35'32"W 85.00' S89°35'32"W 85.00' S89°35'32"W 85.00' 2,125 SF 2,125 SF 2,125 SF 0.049 AC 0.049 AC 0.049 AC 2,125 SF S89°35'32"W _ 176.52'___ 0.049 AC N89°35'32"E 291.52' N89°35'32"E 190.00' S89°35'32"W 85.00' BLUE AVENA VIEW N89°35'32"E BLUE AVENA VIEW 2,125 SF TRACT G 167.65 (50' WIDE PRIVATE ROW) BLUE AVENA VIEW 218.00' 50' UTILITY AND (50' WIDE PRIVATE ROW) 0.049 AC 50' UTILITY AND 51,460 SF 50' UTILITY AND ACCESS EASEMENT ACCESS EASEMENT TRACT G 51,460 SF ACCESS EASEMENT 45.5' 1.181 AC 45.5' 26.5 S89°35'32"W 85.00' 1.181 AC 26.5' N89°35'32"E 123.91' N89°35'29"E 176.00' N89°35'32"E 123.15' ____ 38.91' ____ N89°35'32"E SEE SHEET 6 FOR AND ON BEHALF OF AZTEC CONSULTANTS, INC DATE OF PREPARATION: DEVELOPER 03-19-2020 300 East Mineral Ave., Suite Littleton, Colorado 80122 RICHMOND AMERICAN HOMES ▶ Phone: (303) 713-1898 OF COLORADO, INC., A DELAWARE CORP. 1' = 20" Fax: (303) 713-1897 4350 S. MONACO ST. DENVER, CO 80237 SHEET 5 OF 7 AzTec Proj. No.: 21419-48 Drawn By: CWB

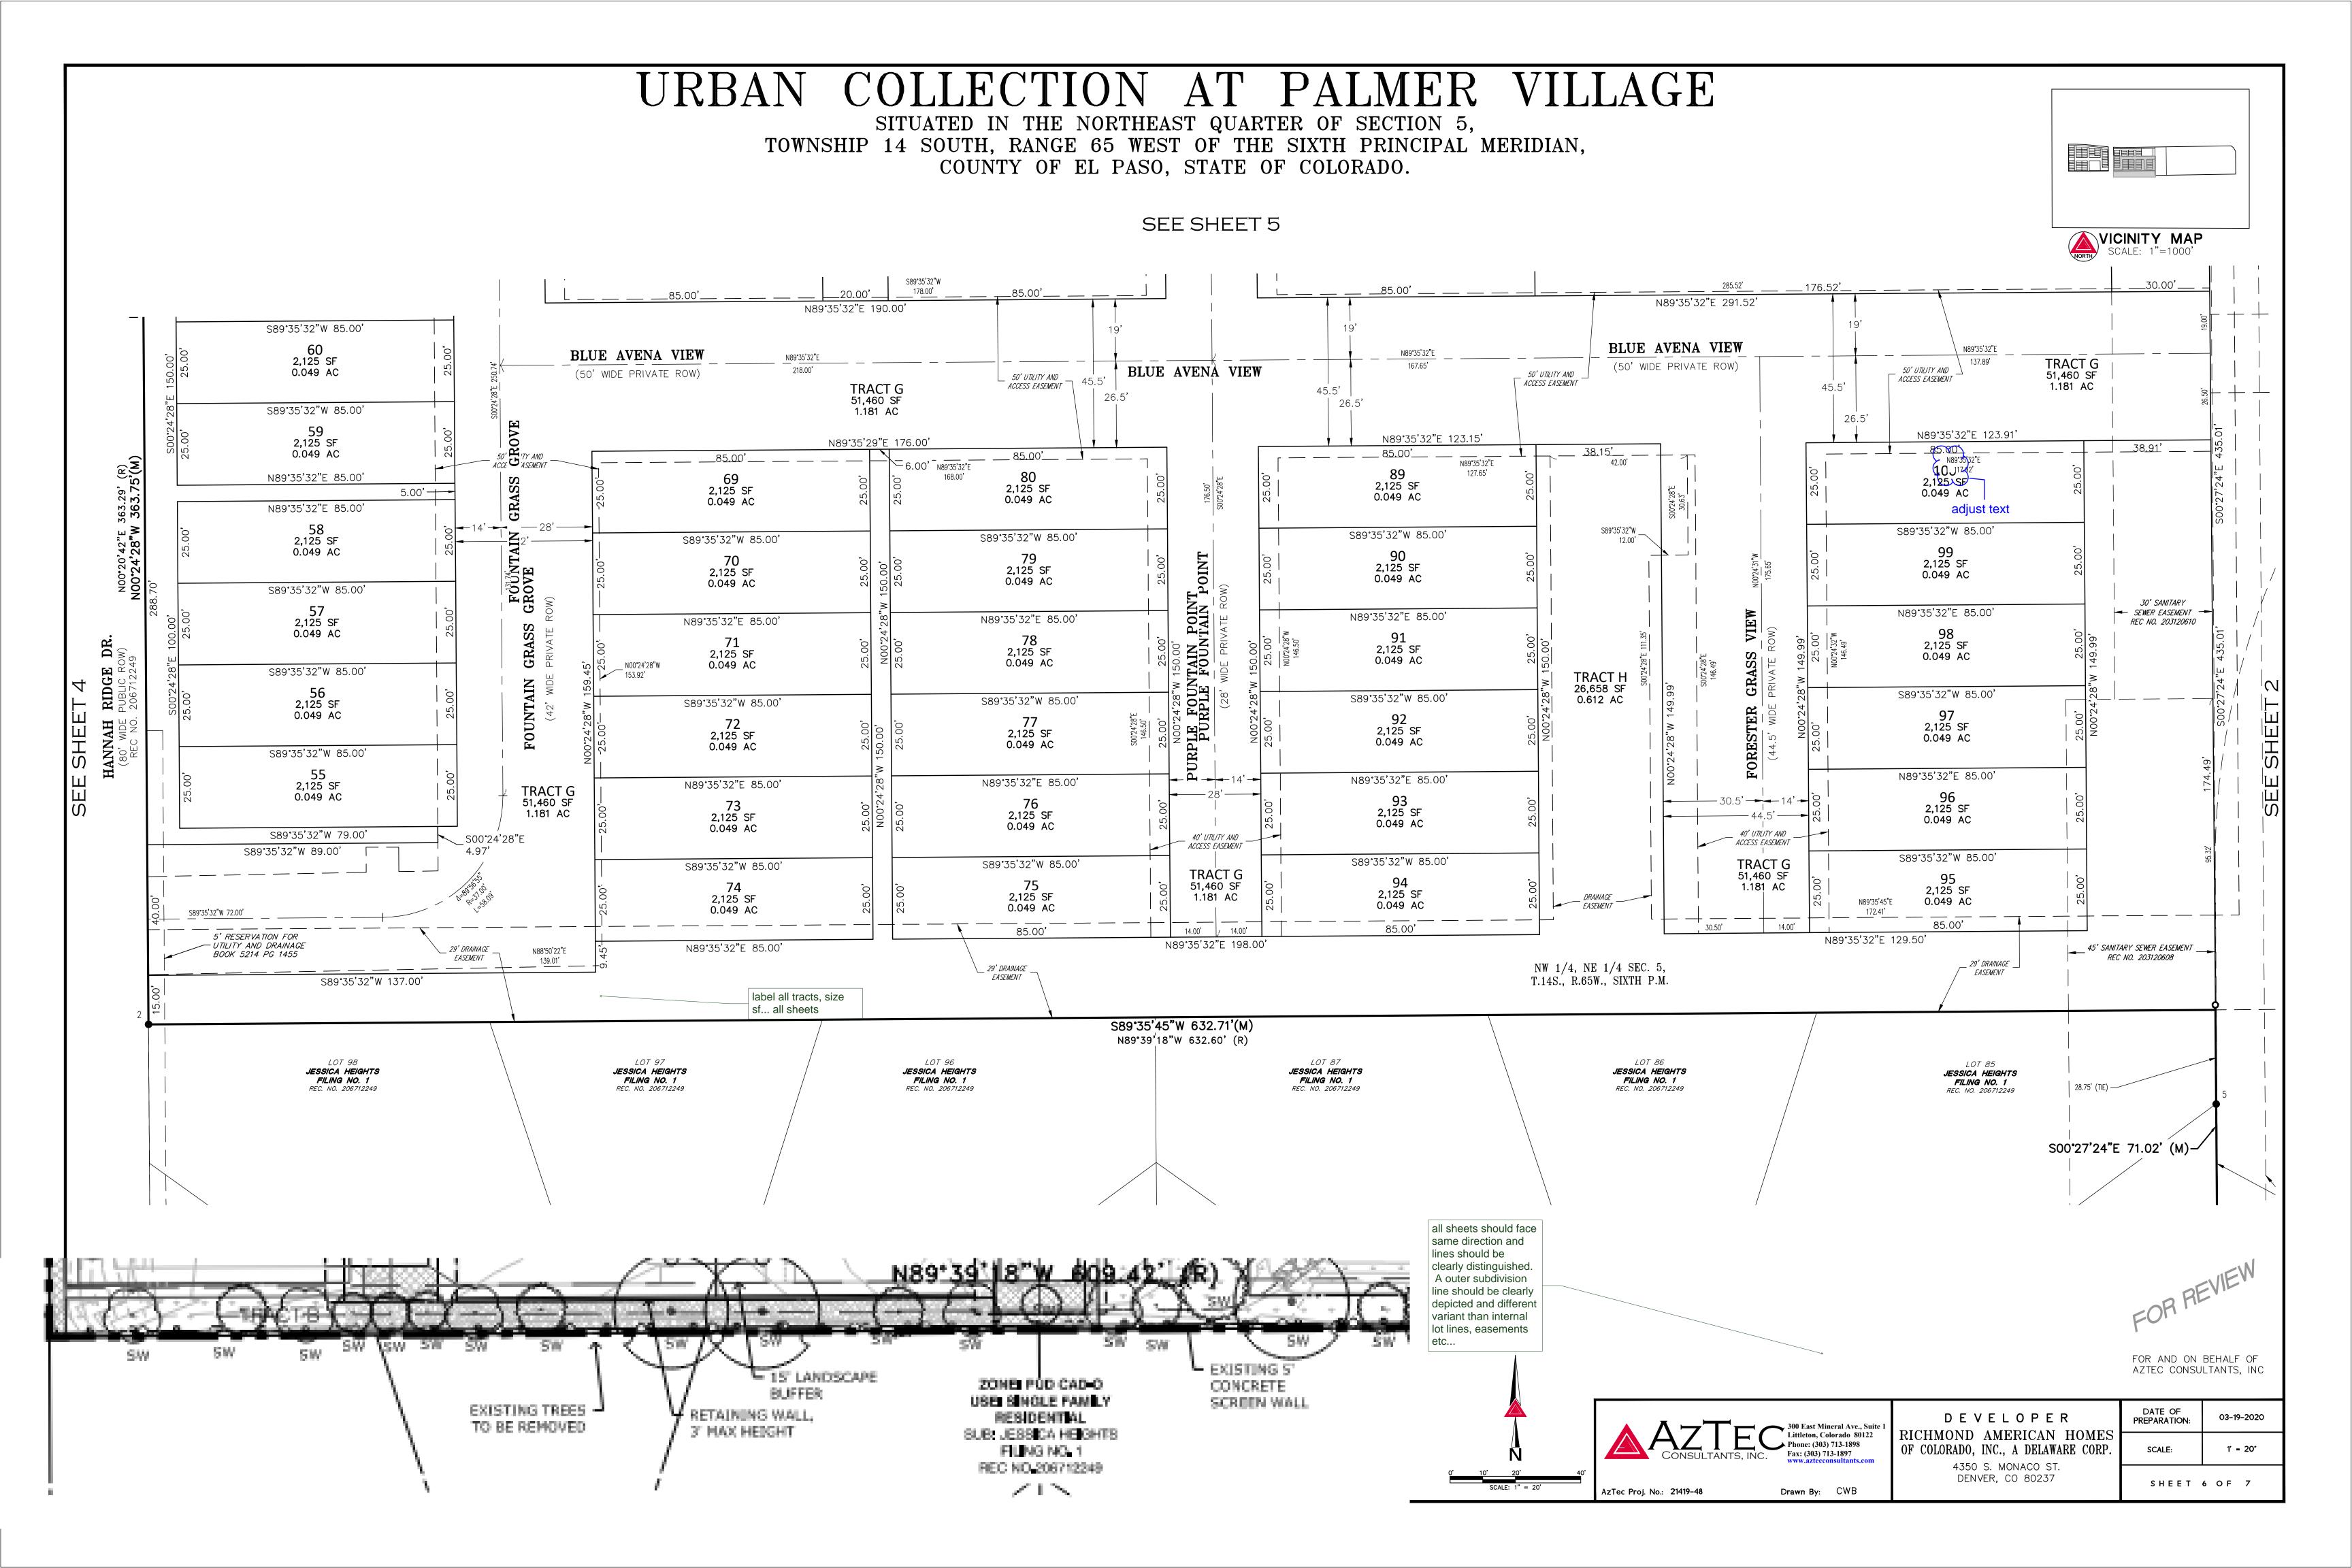

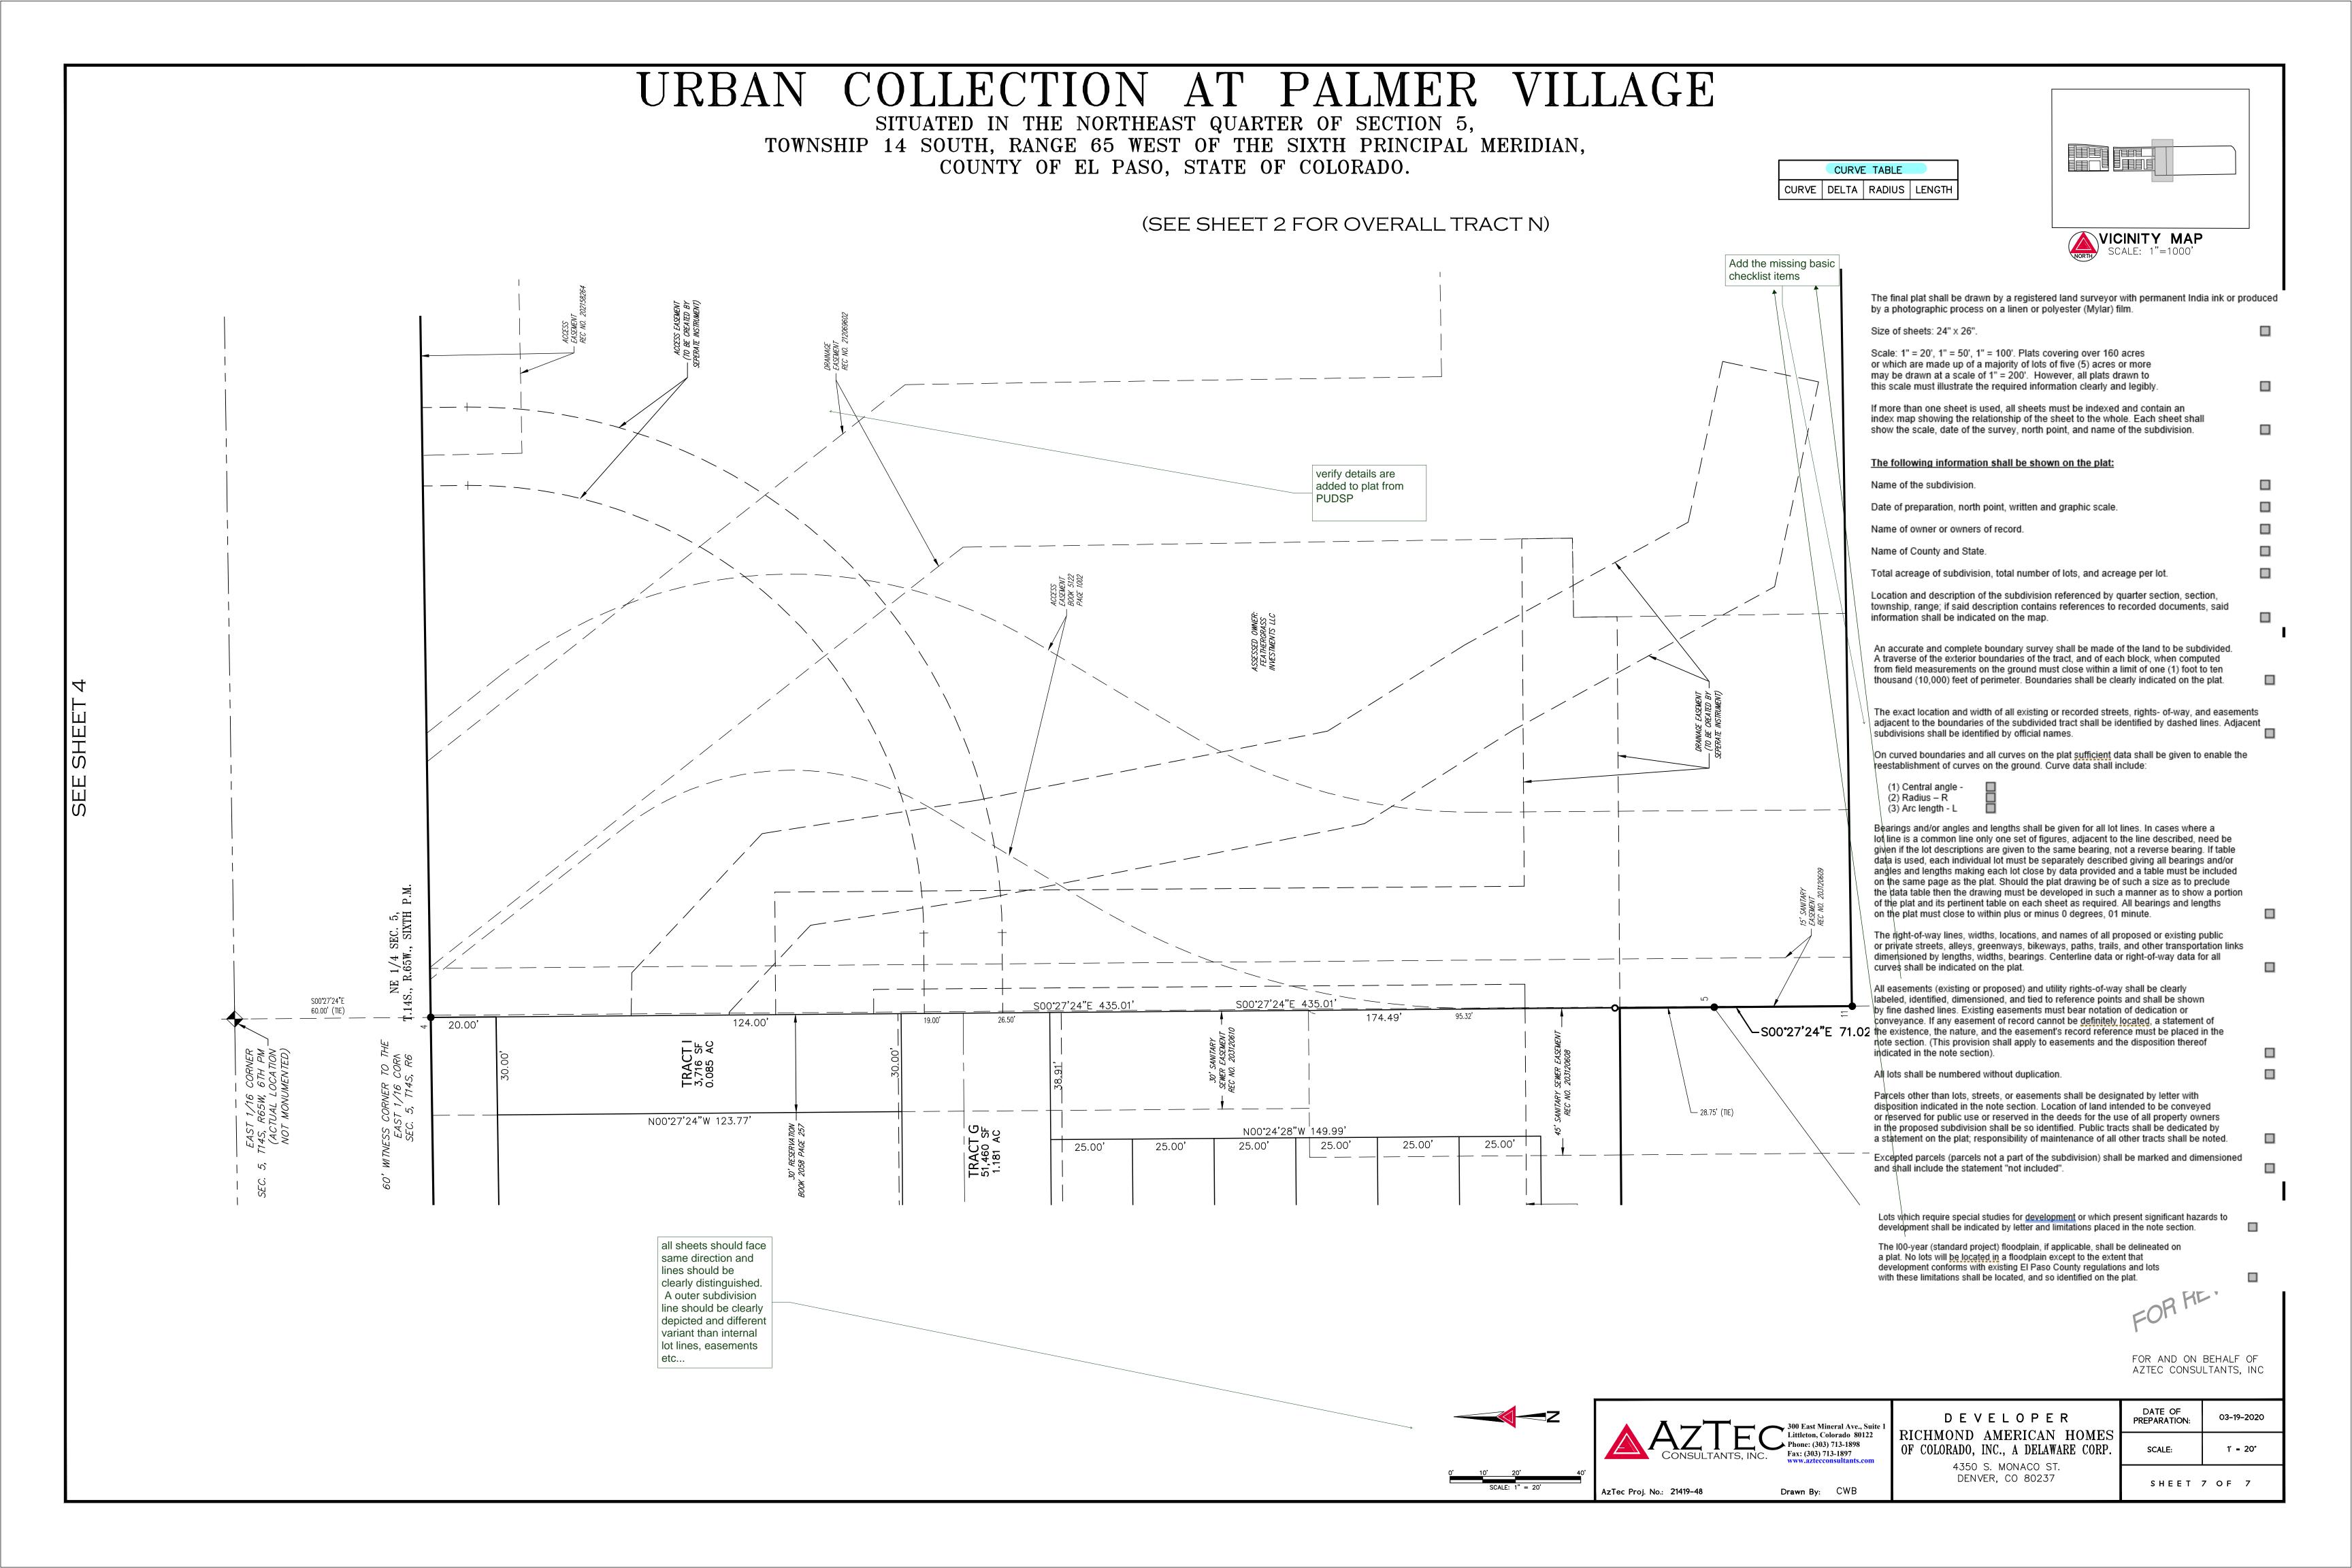

Final Plat Drawings V1 redlines.pdf Markup Summary 1-5-2021

dsdparsons (66)



Subject: Image

Page Label: [1] 2020-03-05 - Constitution & Hannah PLAT-S1

Author: dsdparsons

Date: 1/5/2021 10:37:02 AM

Status: Color: Layer: Space:

VILLAGE

Page Label: [1] 2020-03-05 - Constitution & Hannah PLAT-S1 ADD NOTE to plat:

Author: dsdparsons

Date: 1/5/2021 10:38:12 AM

Status: Color: Layer: Space:



Subject: Callout

corner of this review for the noise

Ave within 150 feet

Author: dsdparsons

Date: 1/5/2021 10:50:29 AM

Status: Color: Layer: Space:



Page Label: [1] 2020-03-05 - Constitution & Hannah PLAT-S1 use specific mitigation note provided upper right

Author: dsdparsons

Date: 1/5/2021 10:51:36 AM

Status: Color: Layer: Space:



Page Label: [1] 2020-03-05 - Constitution & Hannah PLAT-S1 verify (& add) all lots are correct along Constitution

Author: dsdparsons

Date: 1/5/2021 10:52:47 AM

Status: Color: Layer: Space:

E BOARD OF COUNTY COMMISSIONERS, EL PASD COUNTY, D JUNE 9, 2010 UNDER RECEPTION NO. 210054574.

EST LINE OF SAID NORTHEAST ONE-QUARTER OF SECTION 5, 6C LY OF CONSTITUTION AVENUE AND THE POINT OF BEGINNING OF

Subject: Callout

Page Label: [1] 2020-03-05 - Constitution & Hannah PLAT-S1 verify lot numbers didnt change

Date: 1/5/2021 10:53:07 AM

NAME OF TAXABLE PARTY.

Subject: Callout

Page Label: [1] 2020-03-05 - Constitution & Hannah PLAT-S1 i dont think that duplex is in title of plat (HOA)

Author: dsdparsons Date: 1/5/2021 10:54:07 AM

Status: Color: Layer:

Space:

Subject: Reports on File

Page Label: [1] 2020-03-05 - Constitution & Hannah PLAT-S1

Author: dsdparsons

Date: 1/5/2021 11:01:56 AM

Status: Color: Layer: Space:

Note Regarding Reports on File:

The following reports have been submitted in association with the Preliminary Plan or Final Plat for this subdivision and are on file at the County Planning and Community Development Department: Transportation Impact Study; Drainage Report; Water Resources Report; Wastewater Disposal Report; Geology and Soils Report; Fire Protection Report; Wildfire Hazard Report: Natural Features Report: (other: modify

based upon specific reports)

Subject: Stormwater Drainage

Page Label: [1] 2020-03-05 - Constitution & Hannah PLAT-S1

Author: dsdparsons Date: 1/5/2021 11:02:11 AM

Status: Color: Layer: Space:

Note Regarding Stormwater Drainage:

All property owners are responsible for maintaining proper storm water drainage in and through their property. Public drainage easements as specifically noted on the plat shall be maintained by the individual lot owners unless otherwise indicated. Structures, fences, materials or landscaping that could impede the flow of runoff shall not be placed in drainage easements.

Subject: Access

Page Label: [1] 2020-03-05 - Constitution & Hannah PLAT-S1

Author: dsdparsons

Date: 1/5/2021 11:02:33 AM

Status: Color: Layer: Space:

Access:

No driveway shall be established unless an access permit has been granted by El Paso County.

T 85 AND LOTS 86, 87, 96, 97, AND 98 OF SAID JE: STERLY RIGHT OF WAY LINE OF HANNAH RIDGE DRIVE

Subject: Mailboxes

Page Label: [1] 2020-03-05 - Constitution & Hannah PLAT-S1

Author: dsdparsons Date: 1/5/2021 11:02:57 AM

Status: Color: Layer: Space:

Mailboxes:

Mailboxes shall be installed in accordance with all El Paso County and United States Postal Service

regulations.

Subject: Private Road

Page Label: [1] 2020-03-05 - Constitution & Hannah PLAT-S1

Author: dsdparsons Date: 1/5/2021 11:03:24 AM

Status: Color: Layer: Space:

Private Roads:

The private roads as shown on this plat will not be maintained by El Paso County until and unless the streets are constructed in conformance with EI Paso County standards in effect at the date of the request for dedication and maintenance.

3F L0T 2	8 OF SAD JESSICA HEIGHTS FILING NO. 1;
	OF SAD JESSICA HEIGHTS FILING NO. 1 TO THE
ARTER O	
	by the Board of Directors, El Paso County
	Public Improvement District and
	recorded in the records of the El Paso
	County Clerk and Recorder at Reception
	Number, the parcels within the
STH P.M.	platted boundaries of (subdivision) are
	included within the boundaries of the El
I 5, ASS.	Paso County Public Improvement District _
HERLY LE	and as such is subject to applicable road
HE RECO	impact fees and mill levy.

Subject: PID

Page Label: [1] 2020-03-05 - Constitution & Hannah PLAT-S1

Author: dsdparsons

Date: 1/5/2021 11:05:40 AM

Status: Color: ■ Layer: Space: Pursuant to Resolution _____, approved by the Board of Directors, El Paso County Public Improvement District __ and recorded in the records of the El Paso County Clerk and Recorder at Reception Number _____, the parcels within the platted boundaries of (subdivision) are included within the boundaries of the El Paso County Public Improvement District _ and as such is subject to applicable road impact fees and mill levy.

Missions on a commercial soft of the 7 and 10 and 1

Subject: Road Impact

Page Label: [1] 2020-03-05 - Constitution & Hannah PLAT-S1

Author: dsdparsons

Date: 1/5/2021 11:05:47 AM

Status: Color: Layer: Space: The Subdivider(s) agrees on behalf of him/herself and any developer or builder successors and assignees that Subdivider and/or said successors and assigns shall be required to pay traffic impact fees in accordance with the El Paso County Road Impact Fee Program Resolution (Resolution No. 16-454), or any amendments thereto, at or prior to the time of building permit submittals. The fee obligation, if not paid at final plat recording, shall be documented on all sales documents and on plat notes to ensure that a title search would find the fee obligation before sale of the property.

10 TO THE PRICE AND COMPAN, AND CO OF STATE, A SEC OF STATE, A SEC OF STATE OF STATE

Subject: Covenants

Page Label: [1] 2020-03-05 - Constitution & Hannah PLAT-S1

Author: dsdparsons

Date: 1/5/2021 11:06:10 AM

Status: Color: ■ Layer: Space: When the Property is Subject to Existing or Proposed Covenants:

All property within this subdivision is subject to a Declaration of Covenants as recorded at

Reception No. _____, of the records of

the El Paso County Clerk and Recorder.



Subject: Airport Overlay

Page Label: [1] 2020-03-05 - Constitution & Hannah PLAT-S1

Author: dsdparsons

Date: 1/5/2021 11:06:23 AM

Status: Color: Layer: Space: Where the Property is Located in the Airport Overlay Zone

NOTICE OF POTENTIAL AIRCRAFT OVERFLIGHT AND NOISE IMPACT

ASSOCIATED WITH AIRPORT: This serves as notice of potential aircraft overflight and noise impacts on this property due to its close proximity to an airport, which is being disclosed to all prospective purchasers considering the use of this property for residential and other purposes. This property is subject to the overflight and associated noise of arriving and departing aircraft during the course of normal airport operations. (Use when this plat is to provide the notice)

All property within this subdivision is subject to a Notice of Potential Aircraft Overflight and Noise Impact recorded at Reception No.

__, of the records of the El Paso

County Clerk and Recorder. (Use when the Notice has previously been recorded)

All property within this subdivision is subject to an Avigation Easement as recorded at Reception No.

, of the records of the El Paso

County Clerk and Recorder. (Use only when the property is subject to an existing avigation easement as reflected in the title policy)



Subject: Callout

Page Label: [1] 2020-03-05 - Constitution & Hannah PLAT-S1

Author: dsdparsons

Date: 1/5/2021 11:07:46 AM

Status: Color: Layer: Space:

Use standard notes templates and customize for this plat.



Subject: Callout

Author: dsdparsons

Date: 1/5/2021 11:08:25 AM

Status: Color: Layer: Space:

Page Label: [1] 2020-03-05 - Constitution & Hannah PLAT-S1 add names of all utility providers, water, wastewater, electric, gas...



Subject: Callout

Page Label: [3] 2020-03-05 - Constitution & Hannah PLAT-S3 delete for review...all sheets

Author: dsdparsons

Date: 1/5/2021 11:09:11 AM

Status: Color: Layer: Space:



Subject: Easement&Tract Maintenance

Page Label: [1] 2020-03-05 - Constitution & Hannah PLAT-S1

Author: dsdparsons

Date: 1/5/2021 11:11:15 AM

Status: Color: Layer: Space:

Tract _____ shall be utilized as _ (park, neighborhood park, school site, fire station, drainage tract, etc). Ownership and maintenance of Tract shall be vested to (name the entity: El Paso County, Special District, Homeowners Association, etc.) (Where multiple tracts are included in a single PUD plan or plat, the use of a tract table is encouraged.) Lot ____ (or Tract ____) (or entire property) of this property is subject to a Private Detention Basin/Stormwater Quality BMP Maintenance Agreement and Easement as recorded at Reception No. of the records of El Paso County. The HOA (or Owner or District) is responsible for maintenance of the subject

Easement and Tract Maintenance:

drainage facilities.

subdivision approval,

Watershed Dam Note (To be used when the subdivision affects or located in areas which are inundated by the high water line of a watershed dam, or downstream in the impacted area.) No improvements shall be placed within the high water line of the reservoir or in the spillway or spillway channel. If development activities associated with this subdivision result in required modifications, repairs, enlargements to, or replacement of, any dam, spillway, spillway channel, or other water detention facility located within, or associated with, this development, developer, the homeowners' association, and/or the dam owner shall be responsible or liable for such modifications, repairs, enlargements, or replacement and the costs thereof. However, El Paso County shall not be responsible or liable for such modifications, repairs, enlargements, or replacement and the costs thereof by virtue of this



Subject: Easements

Page Label: [1] 2020-03-05 - Constitution & Hannah PLAT-S1

Author: dsdparsons

Date: 1/5/2021 11:11:38 AM

Status: Color: Layer: Space:

Easements:

Unless otherwise indicated, all side, front, and rear lot lines are hereby platted on either side with a 10 foot (use 5 feet for lots smaller than 2.5 acres) public utility and drainage easement unless otherwise indicated. All exterior subdivision boundaries are hereby platted with a 20 foot (use 7 feet for lots smaller than 2.5 acres) public utility and drainage easement. The sole responsibility for maintenance of these easements is hereby vested with the individual property owners.

Subject: Callout

Page Label: [1] 2020-03-05 - Constitution & Hannah PLAT-S1

delete chairman this is an admin plat

Author: dsdparsons

Date: 1/5/2021 11:12:24 AM

Status: Color: Layer: Space:

Subject: Callout

Page Label: [1] 2020-03-05 - Constitution & Hannah PLAT-S1 Add Assessor if Traffic Fee PID is proposed; verify

Author: dsdparsons Date: 1/5/2021 11:13:09 AM

Status:

Color: Layer: Space:

Subject: PCD Director

Author: dsdparsons Date: 1/5/2021 11:13:23 AM

Status: Color: Layer: Space:

Page Label: [1] 2020-03-05 - Constitution & Hannah PLAT-S1 This plat for (name of subdivision or plat) was approved for filing by the El Paso County, Colorado Planning and Community Development Department Director on the _ day of , 20__, subject to any notes or conditions specified hereon.

PID application has been submitted to Lori Seago

Planning and Community Development Director



Subject: Surveyor Certification

Page Label: [1] 2020-03-05 - Constitution & Hannah PLAT-S1

Author: dsdparsons

Date: 1/5/2021 11:14:14 AM

Status: Color: ■ Layer: Space:

Surveyors Certificate

I surveyor's name, a duly registered Professional Land Surveyor in the State of Colorado, do hereby certify that this plat truly and correctly represents the results of a survey made on date of survey, by me or under my direct supervision and that all monuments exist as shown hereon; that mathematical closure errors are less than 1:10,000; and that said plat has been prepared in full compliance with all applicable laws of the State of Colorado dealing with monuments, subdivision, or surveying of land and all applicable provisions of the El Paso County Land Development Code.

I attest the above on this, 20	day of
Surveyor's Name, (Signature) Date Colorado registered PLS #	



Subject: Callout

Page Label: [1] 2020-03-05 - Constitution & Hannah PLAT-S1 delete all pages

Author: dsdparsons **Date:** 1/5/2021 11:14:34 AM

Status: Color: ■ Layer: Space:



Subject: Callout

Page Label: [1] 2020-03-05 - Constitution & Hannah PLAT-S1 file number_

Author: dsdparsons

Date: 1/5/2021 11:15:04 AM

Status:

Status: Color: Layer: Space:



Subject: Image

Page Label: [1] 2020-03-05 - Constitution & Hannah PLAT-S1

Author: dsdparsons

Date: 1/5/2021 11:17:55 AM

Status: Color: Layer: Space:



Subject: Environmental

Page Label: [1] 2020-03-05 - Constitution & Hannah PLAT-S1

Author: dsdparsons

Date: 1/5/2021 11:20:53 AM

Status: Color: ■ Layer: Space:

Environmental:

Developer shall comply with federal and state laws, regulations, ordinances, review and permit requirements, and other agency requirements, if any, of applicable agencies including, but not limited to, the Colorado Division of Wildlife, Colorado Department of Transportation, U.S. Army Corps of Engineers and the U.S. Fish and Wildlife Service regarding the Endangered Species Act, particularly as it relates to the listed species (e.g., Preble's Meadow Jumping Mouse).

Subject: Address Addresses: Page Label: [1] 2020-03-05 - Constitution & Hannah PLAT-S1 The addresses exhibited on this plat are for Author: dsdparsons This prat are for They are not P.M. W subject to TILE SE informational purposes only. They are not the legal ITY FAGILIES, AND IMPROVEMENTS SHALL NOT ENCROACH ADE OF THE EARTH ON ANY EASEMENT WITHOUT THE WRIT Date: 1/5/2021 11:21:01 AM description and are subject to change. Status: ON SHALL BE AT THE APPLICANT'S EXPENSE, AND IF REQ. Y ALL FRISTING LITHITIES ON THIS PROPERTY THAT DO NO Color: Layer: Space: Subject: Limited Access Page Label: [1] 2020-03-05 - Constitution & Hannah PLAT-S1 Access Limitation: There shall be no direct lot access to Author: dsdparsons Road. Date: 1/5/2021 11:21:20 AM Status: Color: Layer: Space: **Subject:** Callout please review a plat SF-20-11 or SF 20-17 in Page Label: [1] 2020-03-05 - Constitution & Hannah PLAT-S1 EDARP for examples- of approved plats in El Paso Author: dsdparsons URBAN COLL County Date: 1/5/2021 11:24:36 AM Status: Color: Layer: Space: Subject: Callout Page Label: [1] 2020-03-05 - Constitution & Hannah PLAT-S1 Add NOTE: The land within the plat is zoned PUD as identified within PCD file number Author: dsdparsons PUDSP-19-11. The PUD Development Plan, Date: 1/5/2021 11:30:25 AM guidelines and landscape plan are recorded at Status: Reception No. Color: Layer: Space: Subject: Callout Page Label: [2] 2020-03-05 - Constitution & Hannah PLAT-S2 Future dev tract Author: dsdparsons Date: 1/5/2021 11:31:53 AM Status: Color: Layer: Space: Subject: Image Page Label: [2] 2020-03-05 - Constitution & Hannah PLAT-S2 Author: dsdparsons Date: 1/5/2021 11:33:06 AM



Subject: Callout

Page Label: [2] 2020-03-05 - Constitution & Hannah PLAT-S2 Tract N? Please place back on plat

Author: dsdparsons

Date: 1/5/2021 11:34:22 AM

Status: Color: Layer: Space:



Subject: Callout

Author: dsdparsons

Date: 1/5/2021 11:36:36 AM

Status: Color: Layer: Space:

Page Label: [2] 2020-03-05 - Constitution & Hannah PLAT-S2 As approved by PUD; edit plat table accordingly; changes to the number of tracts, or sizes within plat should not be made if seeking admin

approval...



Subject: Image

Page Label: [2] 2020-03-05 - Constitution & Hannah PLAT-S2

Author: dsdparsons

Date: 1/5/2021 11:37:30 AM

Status: Color: Layer: Space:



Subject: Callout

Page Label: [2] 2020-03-05 - Constitution & Hannah PLAT-S2 please add tract N back

Author: dsdparsons

Date: 1/5/2021 11:37:54 AM

Status: Color: Layer: Space:



Subject: Image

Page Label: [2] 2020-03-05 - Constitution & Hannah PLAT-S2

Author: dsdparsons Date: 1/5/2021 11:38:26 AM

Status: Color: Layer: Space:



Subject: Callout

Page Label: [3] 2020-03-05 - Constitution & Hannah PLAT-S3 add detail notes

Author: dsdparsons Date: 1/5/2021 11:40:15 AM

Subject: Image

Page Label: [3] 2020-03-05 - Constitution & Hannah PLAT-S3

Author: dsdparsons

Date: 1/5/2021 11:40:51 AM

Status: Color: Layer: Space:

Subject: Callout

Page Label: [7] 2020-03-05 - Constitution & Hannah PLAT-S7 verify details are added to plat from PUDSP

Author: dsdparsons

Date: 1/5/2021 11:43:41 AM

Status: Color: Layer: Space:



Subject: Image

Page Label: [7] 2020-03-05 - Constitution & Hannah PLAT-S7

Author: dsdparsons

Date: 1/5/2021 11:49:32 AM

Status: Color: Laver: Space:



Subject: Image

Page Label: [7] 2020-03-05 - Constitution & Hannah PLAT-S7

Author: dsdparsons

Date: 1/5/2021 11:50:03 AM

Status: Color: Layer: Space:



Subject: Image

Page Label: [7] 2020-03-05 - Constitution & Hannah PLAT-S7

Author: dsdparsons

Date: 1/5/2021 11:50:33 AM

Status: Color: Layer: Space:



Subject: Callout

Page Label: [7] 2020-03-05 - Constitution & Hannah PLAT-S7 Add the missing basic checklist items

Author: dsdparsons

Date: 1/5/2021 11:51:07 AM



Subject: Arrow

Page Label: [7] 2020-03-05 - Constitution & Hannah PLAT-S7

Author: dsdparsons

Date: 1/5/2021 11:51:21 AM

Status: Color: Layer: Space:



Subject: Arrow

Page Label: [7] 2020-03-05 - Constitution & Hannah PLAT-S7

Author: dsdparsons

Date: 1/5/2021 11:51:39 AM

Status: Color: Layer: Space:



Subject: Image

Page Label: [4] 2020-03-05 - Constitution & Hannah PLAT-S4

Author: dsdparsons

Date: 1/5/2021 11:54:21 AM

Status: Color: Layer: Space:



Subject: Callout

Page Label: [4] 2020-03-05 - Constitution & Hannah PLAT-S4 add details from Prelim where appropriate- see checklist provided

Author: dsdparsons

Date: 1/5/2021 11:55:04 AM

Status: Color: Layer: Space:



Subject: Callout

Author: dsdparsons

Date: 1/5/2021 11:56:48 AM

Status: Color: Layer: Space:

Page Label: [7] 2020-03-05 - Constitution & Hannah PLAT-S7 all sheets should face same direction and lines should be clearly distinguished. A outer subdivision line should be clearly depicted and different variant than internal lot lines, easements

etc...



Subject: Callout

Page Label: [6] 2020-03-05 - Constitution & Hannah PLAT-S6 label all tracts, size sf... all sheets

Author: dsdparsons

Date: 1/5/2021 11:58:18 AM



Subject: Callout

Page Label: [6] 2020-03-05 - Constitution & Hannah PLAT-S6

Author: dsdparsons

Date: 1/5/2021 12:01:49 PM

Status: Color: Layer: Space:

all sheets should face same direction and lines should be clearly distinguished. A outer subdivision line should be clearly depicted and different variant than internal lot lines, easements

etc...



Subject: Image

Page Label: [6] 2020-03-05 - Constitution & Hannah PLAT-S6

Author: dsdparsons

Date: 1/5/2021 12:02:50 PM

Status: Color: Layer: Space:



Subject: Callout

Author: dsdparsons

Date: 1/5/2021 12:04:23 PM

Status: Color: Layer: Space:





Subject: Callout

Author: dsdparsons

Date: 1/5/2021 12:05:16 PM

Status: Color: Layer: Space:

Page Label: [2] 2020-03-05 - Constitution & Hannah PLAT-S2 please provide an overall key map that is easily read when this plat printed for each sheet- it is difficult to see what sheet matches where to the

next sheet



Subject: Callout

Page Label: [2] 2020-03-05 - Constitution & Hannah PLAT-S2

Author: dsdparsons

Date: 1/5/2021 12:06:19 PM

Status: Color: Layer: Space:

Tracts as approved; please verify plat is same as PUDSP- individual plat sheets are difficult to follow

and read



Subject: Subdivision Improvements

Page Label: [1] 2020-03-05 - Constitution & Hannah PLAT-S1

Author: dsdparsons

Date: 1/5/2021 12:07:52 PM

Status: Color: ■ Layer: Space: Public and Common Subdivision Improvements: No lot or interest therein, shall be sold, conveyed, or transferred whether by deed or by contract, nor shall building permits be issued, until and unless either the required public and common development improvements have been constructed and completed and preliminarily accepted in accordance with the Subdivision Improvements Agreement between the applicant/owner and El Paso County as recorded under Reception Number the Office of the Clerk and Recorder of El Paso County, Colorado or, in the alternative, other collateral is provided to make provision for the completion of said improvements in accordance with the El Paso County Land Development Code and Engineering Criteria Manual. Any such alternative collateral must be approved by the Board of County Commissioners or, if permitted by the Subdivision Improvements Agreement, by the Planning and Community Development Department Director and meet the policy and procedure requirements of El Paso County prior to the release by the County of any lots for sale, conveyance or transfer.

This plat restriction may be removed or rescinded by the Board of County Commissioners or, if permitted by the Subdivision Improvements Agreement, by the Planning and Community Development Department Director upon either approval of an alternative form of collateral or completion and preliminary acceptance by the El Paso Board of County Commissioners of all improvements required to be constructed and completed in accordance with said Subdivision Improvements Agreement. The partial release of lots for sale, conveyance or transfer may only be granted in accordance with any planned partial release of lots authorized by the Subdivision Improvements Agreement.



Subject: Callout

Page Label: [1] 2020-03-05 - Constitution & Hannah PLAT-S1

Author: dsdparsons

Date: 1/5/2021 12:09:30 PM

Status:
Color: Layer:
Space:

is this the name on the Assessors for ownership? They need to match

Subject: Image

Page Label: [1] 2020-03-05 - Constitution & Hannah PLAT-S1

Author: dsdparsons

Date: 1/5/2021 12:11:40 PM

Subject: Callout

Page Label: [1] 2020-03-05 - Constitution & Hannah PLAT-S1 Author: dsdparsons

owner current and proposed in LOI an application

Date: 1/5/2021 12:12:31 PM

Status: Color: Layer: Space:



Subject: Callout

Page Label: [1] 2020-03-05 - Constitution & Hannah PLAT-S1 internal private roads, tracts will not be owned or

maintained by County

Author: dsdparsons Date: 1/5/2021 12:13:23 PM



Subject: Text Box

Page Label: [1] 2020-03-05 - Constitution & Hannah PLAT-S1

Author: dsdparsons

Date: 1/5/2021 12:14:25 PM

Status: Color: Layer: Space:

Owners Certificate

The undersigned, being all the owners, mortgagees, beneficiaries of deeds of trust and holders of other interests in the land described herein, have laid out, subdivided, and platted said lands into lots, tracts, streets, and easements (use which are applicable) as shown hereon under the name and subdivision of

. All public improvements so platted are hereby dedicated to public use and said owner does hereby covenant and agree that the public improvements will be constructed to El Paso County standards and that proper drainage and erosion control for same will be provided at said owner's expense, all to the satisfaction of the Board of County Commissioners of El Paso County, Colorado. Upon acceptance by resolution, all public improvements so dedicated will become matters of maintenance by El Paso County, Colorado. The utility easements shown hereon are hereby dedicated for public utilities and communication systems and other purposes as shown hereon. The entities responsible for providing the services for which the easements are established are hereby granted the perpetual right of ingress and egress from and to adjacent properties for installation, maintenance, and replacement of utility lines and related facilities.

Owners/Mortgagee (Signature)
By: Title:
ATTEST: (if corporation)
Secretary/Treasurer
STATE OF COLORADO)
) ss. COUNTY OF)
Acknowledged before me this day of, 200 by as
·
My commission expires
Witness my hand and official seal
Notary Public
Signatures of officers signing for a corporation
shall be acknowledged as follows:
(print name) as President/Vice President and print

Signatures of managers/members for a LLC

name as Secretary/Treasurer, name of corporation, a state corporation.

URLAND TO THE PROPERTY OF THE

Subject: Text Box

Page Label: [2] 2020-03-05 - Constitution & Hannah PLAT-S2

Author: dsdparsons

Date: 1/5/2021 12:16:47 PM

Status: Color: Layer: Space:

Owners Certificate

The undersigned, being all the owners, mortgagees, beneficiaries of deeds of trust and holders of other interests in the land described herein, have laid out, subdivided, and platted said lands into lots, tracts, streets, and easements (use which are applicable) as shown hereon under the name and subdivision of

. All public improvements so platted are hereby dedicated to public use and said owner does hereby covenant and agree that the public improvements will be constructed to El Paso County standards and that proper drainage and erosion control for same will be provided at said owner's expense, all to the satisfaction of the Board of County Commissioners of El Paso County, Colorado. Upon acceptance by resolution, all public improvements so dedicated will become matters of maintenance by El Paso County, Colorado. The utility easements shown hereon are hereby dedicated for public utilities and communication systems and other purposes as shown hereon. The entities responsible for providing the services for which the easements are established are hereby granted the perpetual right of ingress and egress from and to adjacent properties for installation, maintenance, and replacement of utility lines and related facilities.

Owners/Mortgagee (Signature)	_
By: Title:	
ATTEST: (if corporation)	
Secretary/Treasurer	
STATE OF COLORADO) ss. COUNTY OF)	
Acknowledged before me this day of, 200 by as	
My commission expires	
Witness my hand and official seal	
Notary Public	
Signatures of officers signing for a corporation	
shall be acknowledged as follows:	rin
print name) as President/Vice President and p	1111)

Signatures of managers/members for a LLC

name as Secretary/Treasurer, name of corporation, a state corporation.

Subject: Callout Page Label: [2] 2020-03-05 - Constitution & Hannah PLAT-S2 use this after customizing please Author: dsdparsons use this after customizing please Date: 1/5/2021 12:17:09 PM Status: Color: Layer: Space: dsdrice (27) Subject: Cloud+ N89'35'32"E 123.91' Page Label: [6] 2020-03-05 - Constitution & Hannah PLAT-S6 adjust text 85.00 N893532E 1.0 J1742' 2,125.SF 0.049 AC Author: dsdrice Date: 12/28/2020 3:30:06 PM adjust text S89'35'32"W 85.00' Status: Color: Layer: Space: AN HUML'S Subject: Page Label: [1] 2020-03-05 - Constitution & Hannah PLAT-S1 Author: dsdrice , 2020. Date: 12/28/2020 3:34:37 PM Status: Color: Layer: Space: Page Label: [1] 2020-03-05 - Constitution & Hannah PLAT-S1 2020, B' Author: dsdrice Date: 12/28/2020 3:34:42 PM Status: Color: Layer: Space: Subject: Page Label: [1] 2020-03-05 - Constitution & Hannah PLAT-S1 Author: dsdrice Date: 12/28/2020 3:35:44 PM Status:

, 2020.

, 2020.

Color: Layer: Space:

Subject:

Page Label: [1] 2020-03-05 - Constitution & Hannah PLAT-S1

Author: dsdrice

Date: 12/28/2020 3:35:47 PM

Subject: Page Label: [1] 2020-03-05 - Constitution & Hannah PLAT-S1 Author: dsdrice 2020 A.D Date: 12/28/2020 3:35:51 PM Status: Color: Layer: Space: Subject: Text Box Page Label: [1] 2020-03-05 - Constitution & Hannah PLAT-S1 Add parks, school, drainage and bridge fee lines Add parks, school, drainage and bridge fee lines Author: dsdrice Date: 12/28/2020 3:36:48 PM Status: Color: Layer: Space: Subject: Callout Page Label: [1] 2020-03-05 - Constitution & Hannah PLAT-S1 Planning and Community Development Author: dsdrice Date: 12/28/2020 3:38:05 PM Status: Color: Layer: Space: Subject: Page Label: [1] 2020-03-05 - Constitution & Hannah PLAT-S1 Author: dsdrice Date: 12/28/2020 3:38:26 PM Status: Color: Layer: Space: Subject: Callout Page Label: [1] 2020-03-05 - Constitution & Hannah PLAT-S1 Was this by a different surveyor? Author: dsdrice Date: 12/28/2020 3:58:15 PM MATER OF SECTION & TORNSHIP 14 SOUTH, RANGE 65 WEST OF THE 6TH SE SHASED ON THE NORTH LINE OF SAID MORTHWAST QUARTER OF SECTION S. Status: Color: Layer: Space: Subject: Text Box Page Label: [2] 2020-03-05 - Constitution & Hannah PLAT-S2 S Author: dsdrice Date: 12/28/2020 4:02:02 PM Status: Color: Layer: Space:

Subject: Text Box

Page Label: [2] 2020-03-05 - Constitution & Hannah PLAT-S2 Lots:

4.878 Ac. 23.100 Ac.

Author: dsdrice

Date: 12/28/2020 4:05:08 PM

Status: Color: Layer: Space:



Subject: Text Box

Author: dsdrice

Page Label: [2] 2020-03-05 - Constitution & Hannah PLAT-S2 (Provide a summary table listing acreages for lots,

tracts, and total acreage.)

Agreement

drawing.

Date: 12/28/2020 4:05:24 PM

Status: Color: Layer: Space:

Subject: Snapshot

Page Label: [1] 2020-03-05 - Constitution & Hannah PLAT-S1

Author: dsdrice

Date: 12/28/2020 4:18:54 PM

Status: Color: Layer: Space:



CURVE TABLE RVE DELTA RADIUS LENGTH

RIBED IN WING THREE

Subject: Text Box

Page Label: [1] 2020-03-05 - Constitution & Hannah PLAT-S1 Add standard note referencing the PDB/BMP

Author: dsdrice

Date: 12/28/2020 4:21:31 PM

Status: Color: Layer: Space:

Subject: Callout

Page Label: [1] 2020-03-05 - Constitution & Hannah PLAT-S1 Describe the monuments. This does not match the

Author: dsdrice

Date: 12/28/2020 4:54:49 PM

Status: Color: Layer: Space:

Subject:

Page Label: [7] 2020-03-05 - Constitution & Hannah PLAT-S7

Author: dsdrice

Date: 12/29/2020 10:52:20 AM

JARIES AND DIMENSIO Subject: ER DOES HEREBY WILL BE PROVIDED A ADO, AND UPON , COLORADO. THIS TR

Page Label: [1] 2020-03-05 - Constitution & Hannah PLAT-S1

Author: dsdrice

Date: 12/29/2020 10:53:46 AM

Status: Color: Layer: Space:

Page Label: [1] 2020-03-05 - Constitution & Hannah PLAT-S1

Author: dsdrice

Date: 12/29/2020 10:53:52 AM

Status: Color: Layer: Space:

) FEES HAVE BEEN PAID AND ALL REQUIRED

Subject: Callout

Page Label: [1] 2020-03-05 - Constitution & Hannah PLAT-S1 delete highlighted text

Author: dsdrice

Date: 12/29/2020 10:54:24 AM

Status: Color: Laver: Space:



Subject: Callout

"these"? Page Label: [1] 2020-03-05 - Constitution & Hannah PLAT-S1

Author: dsdrice

Date: 12/29/2020 10:55:11 AM

Status: Color: Layer: Space:

Subject: Callout

Page Label: [1] 2020-03-05 - Constitution & Hannah PLAT-S1 D

Author: dsdrice

Date: 12/29/2020 10:56:34 AM

Status: Color: Layer: Space:



Subject: Cloud+

Page Label: [1] 2020-03-05 - Constitution & Hannah PLAT-S1 not standard/duplicative of note #15

Author: dsdrice

Date: 12/29/2020 10:58:08 AM

ARE DEDICATED HEREON FOR PUBLIC UTILITY PURPOSES SHALL NABOUT RECORDED AT RECEPTION NUMBER 21212548 OF THE FISTS OF RECORD AFFECTING ANY OF THE PLATTED PROPERTY DE AND EFFECT.

Subject: Callout

Page Label: [1] 2020-03-05 - Constitution & Hannah PLAT-S1 Standard drainage easements not found. See

Author: dsdrice

Date: 12/29/2020 10:59:07 AM

Status: Color: Layer: Space:

comment letter.

Subject: Callout

Page Label: [2] 2020-03-05 - Constitution & Hannah PLAT-S2 property owner?

Author: dsdrice

Date: 12/29/2020 12:13:52 PM

Status: Color: Layer: Space:



Subject: Callout

Page Label: [2] 2020-03-05 - Constitution & Hannah PLAT-S2 future development?

Author: dsdrice

Date: 12/29/2020 12:14:25 PM

Status: Color: Layer: Space:



Subject: Callout

Author: dsdrice

Date: 12/29/2020 12:17:40 PM

Status: Color: Layer: Space:

Page Label: [2] 2020-03-05 - Constitution & Hannah PLAT-S2 Add a note that these 2 tracts will be maintained by the property owner (or PVDOA - specify one) until they are transferred to and accepted by the Clty.