
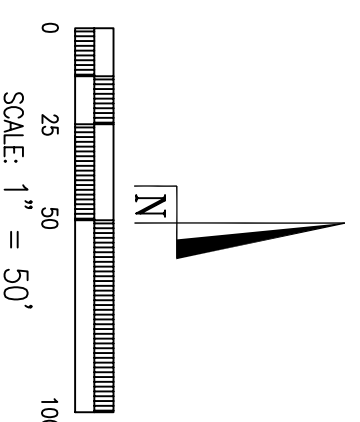


THE GLEN AT WIDEFIELD SUBDIVISION FILING NO. 7A

A replat of lots 50 through 55, 93 and 94, The Glen at Widefield Subdivision No. 7
 Located in a portion of the Northwest One-quarter (NW1/4) of Section 27
 Township 15 South (T15S), Range 65 West (R65W) of the 6TH P.M.
 County of El Paso, State of Colorado

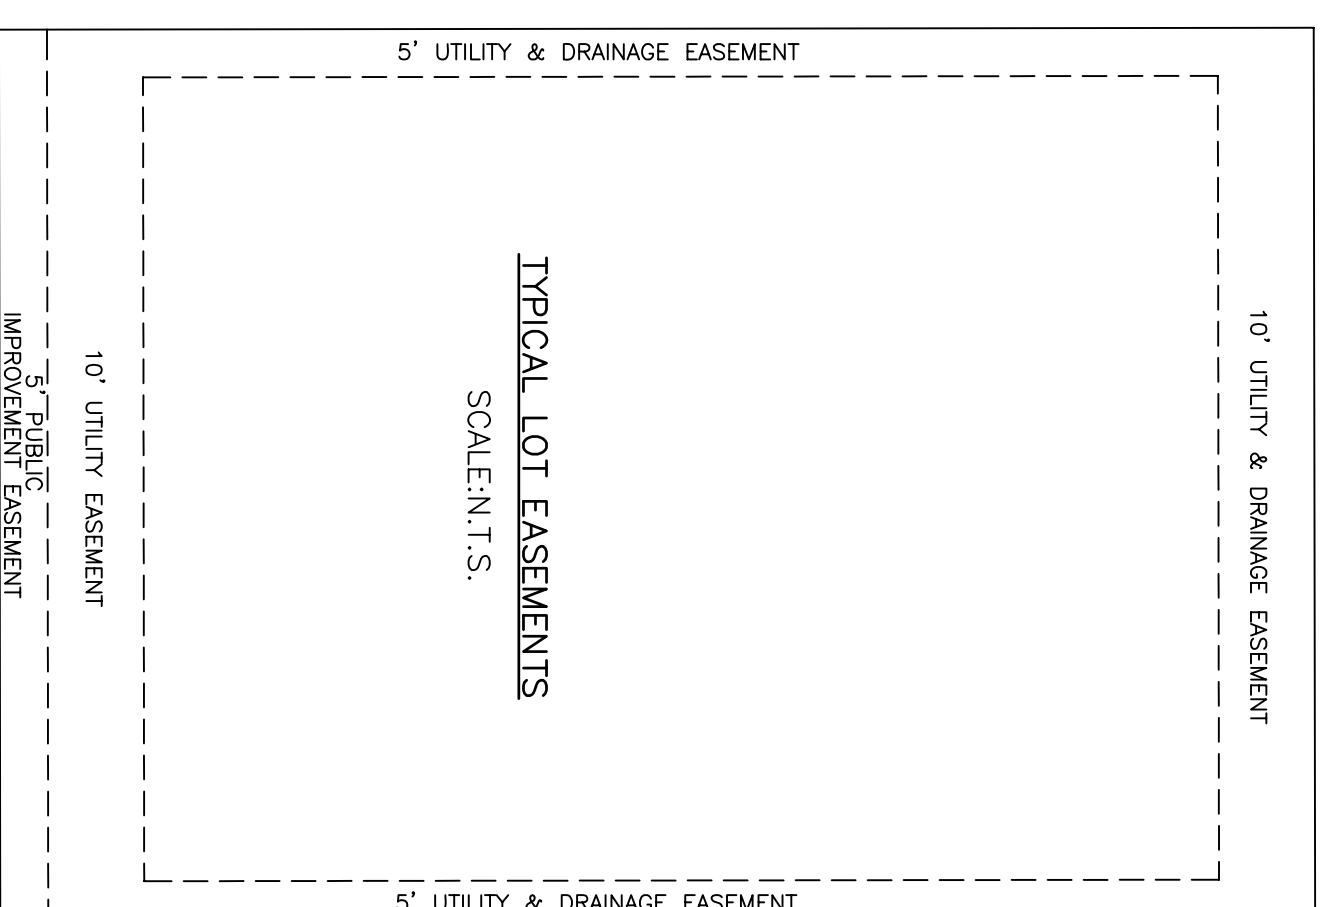


PINNACLE LAND SURVEYING COMPANY, INC.
 121 COUNTY ROAD 5, DIVIDE, CO 687-7360

NOTICE: ACCORDING TO COLORADO LAW YOU MUST COMMENCE ANY LEGAL ACTION BASED UPON ANY DEFECT IN THIS SURVEY WITHIN THREE YEARS FROM THE DATE OF THE CERTIFICATION SHOWN HEREON. THIS ACTION IS BASED UPON ANY DEFECT IN THIS SURVEY BEING COMMENCED MORE THAN TEN YEARS FROM THE DATE OF THE CERTIFICATION SHOWN HEREON.

THE GLEN AT WIDEFIELD SUBDIVISION FILING NO. 7A
 DRAWN BY: JMW
 CHECKED BY: JMT
 DATE: 07/11/18
 JOB NO.: 18001000
 DWG.: 18001000P.DWG
 SHEET 2 OF 2


Markup Summary

dsdgrimm (2)

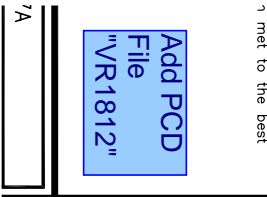

1 met to the best
Subject: Engineer
Page Label: 1
Author: dsdgrimm
Date: 8/14/2018 10:19:40 AM
Color: ■


Add PCD File "VR1812"

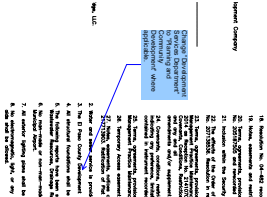

Subject: Engineer
Page Label: 1
Author: dsdgrimm
Date: 8/14/2018 10:20:01 AM
Color: ■

Change "Development Services Department" to "Planning and Community Development" where applicable.

dsdkendall (2)

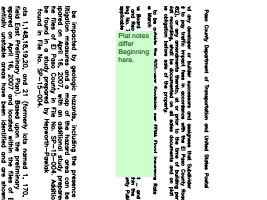

Subject: Text Box
Page Label: 1
Author: dsdkendall
Date: 8/14/2018 4:06:05 PM
Color: ■

Plat notes differ Beginning here.



Subject: Callout
Page Label: 1
Author: dsdkendall
Date: 8/14/2018 4:06:31 PM
Color: ■

Change to Planning and Community Development