



THE GLEN AT WIDEFIELD SUBDIVISION FILING NO. 7A

A replat of lots 52 through 55, 93 and 94, The Glen at Widefield Subdivision No. 7
 Located in a portion of the Northwest One-quarter (NW1/4) of Section 27
 Township 15 South (T15S), Range 65 West (R65W) of the 6TH P.M.
 County of El Paso, State of Colorado

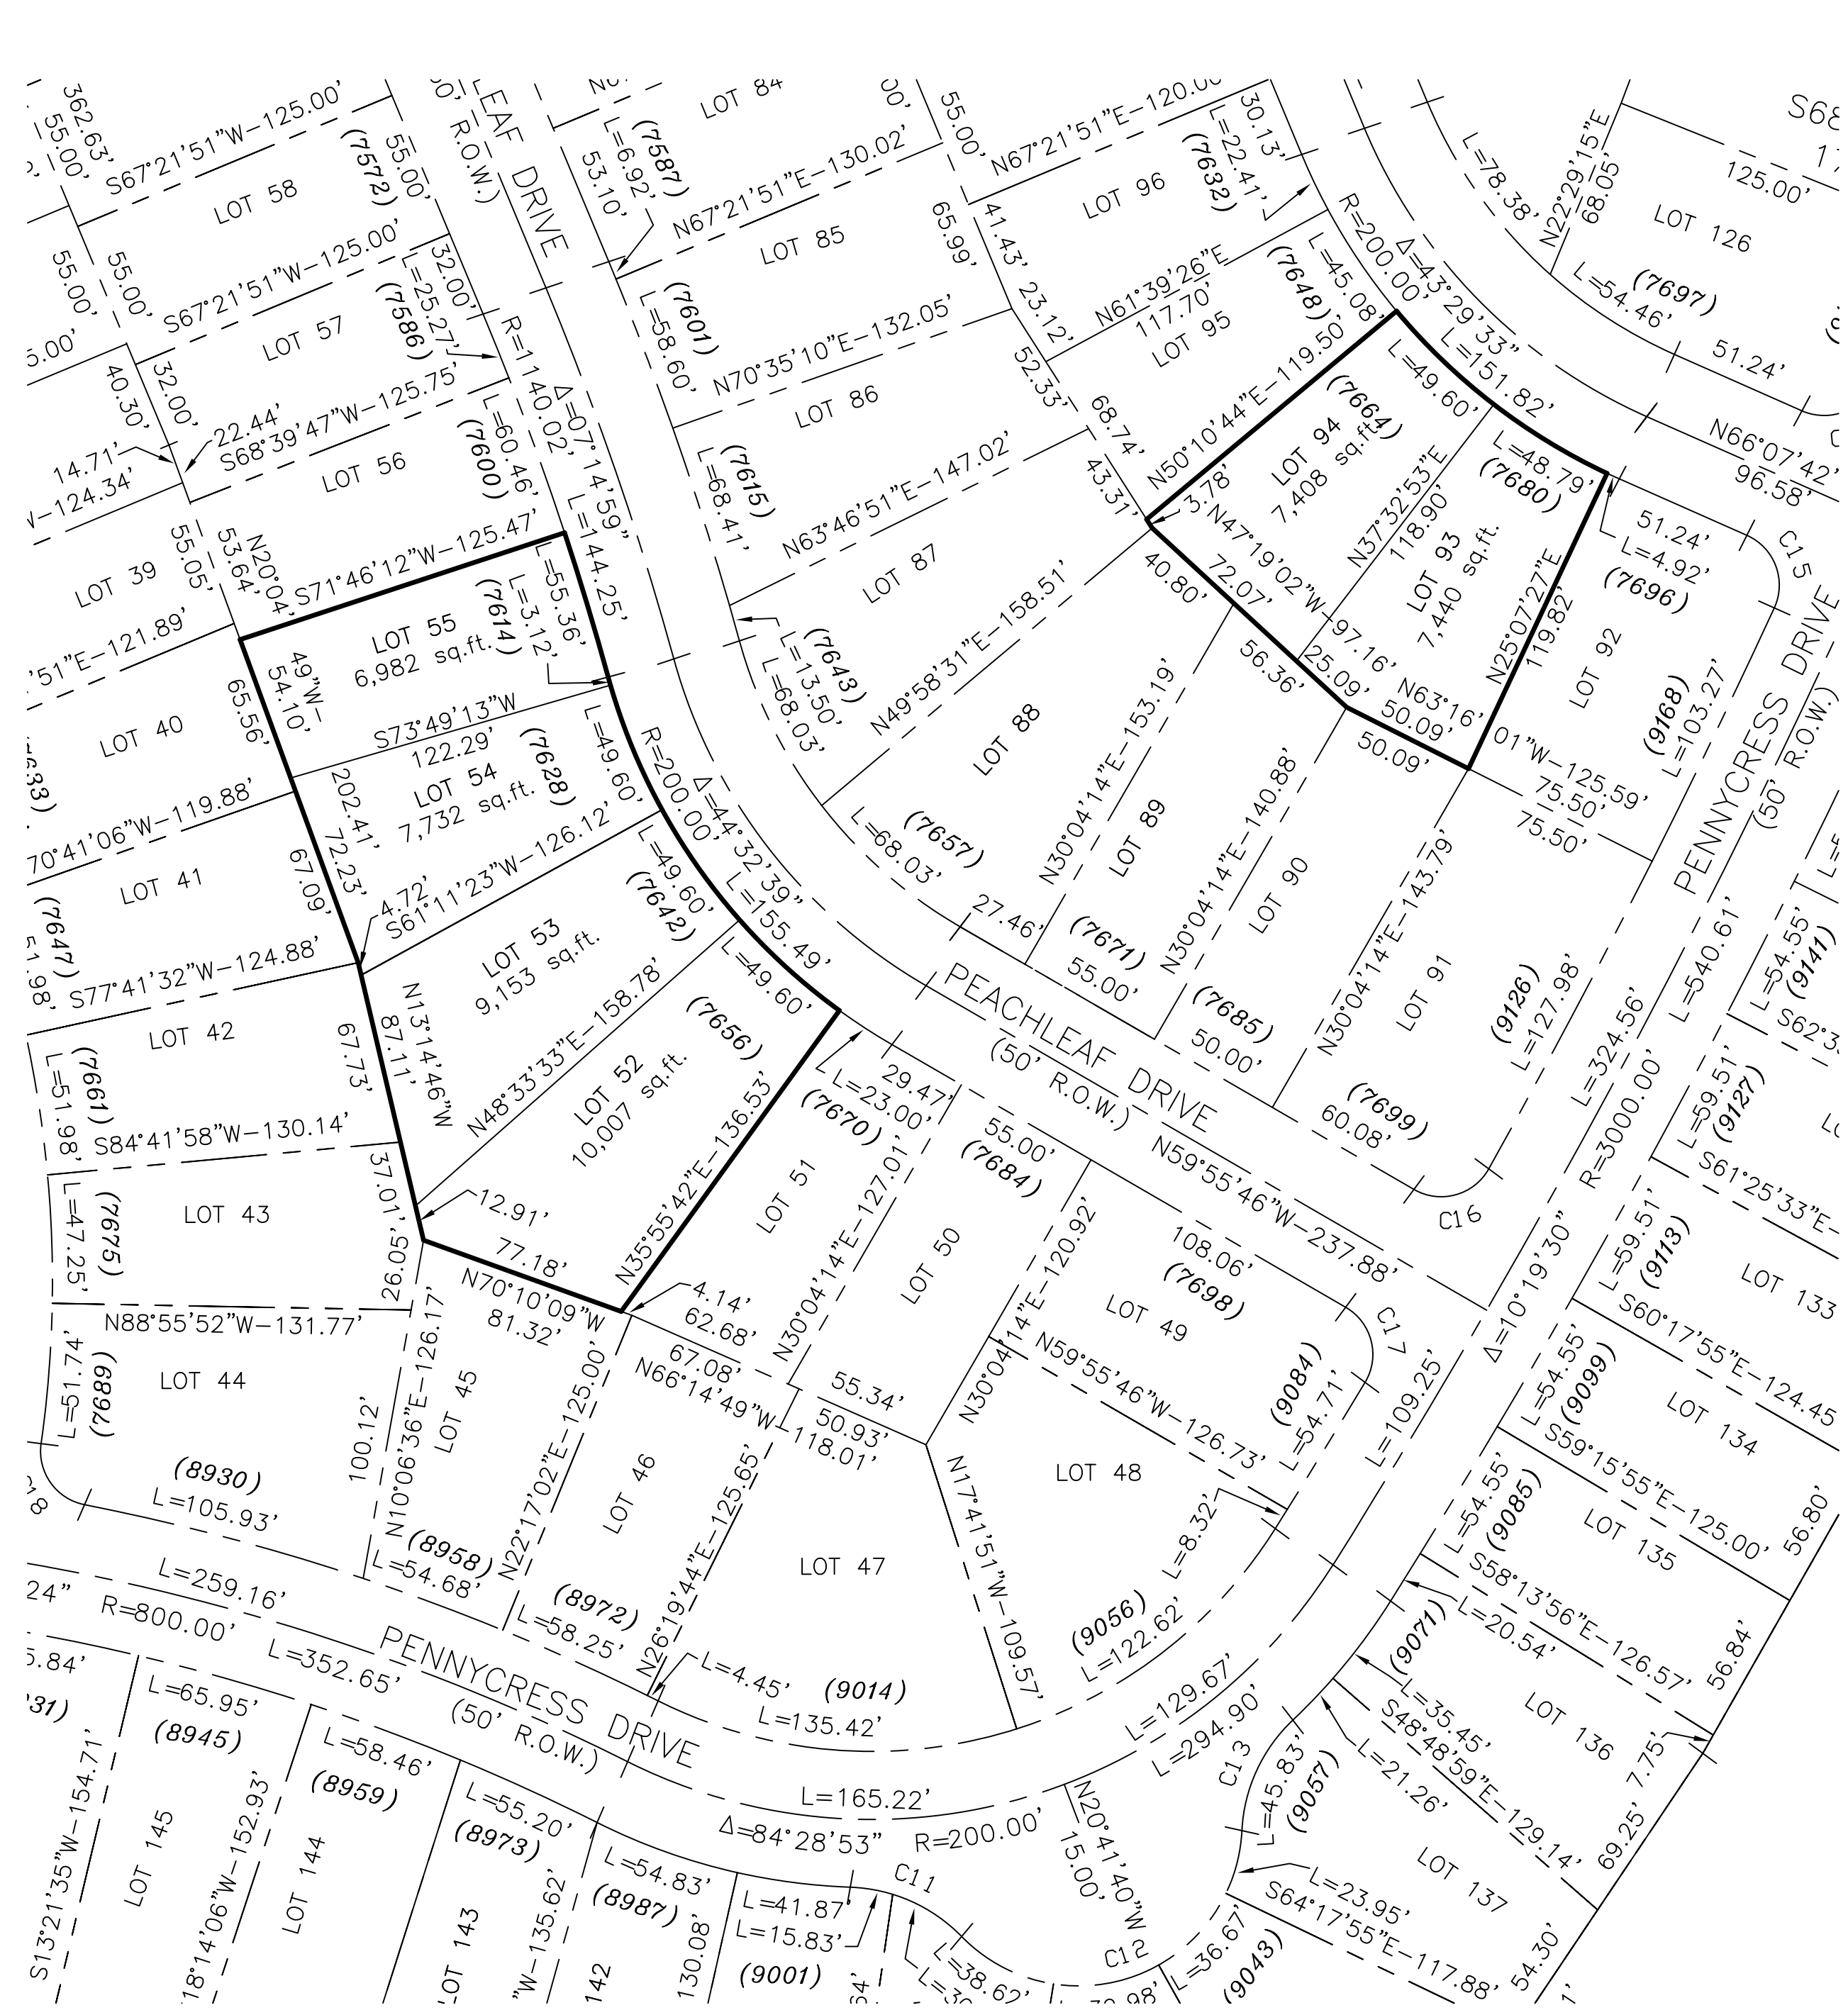


AS PLATTED

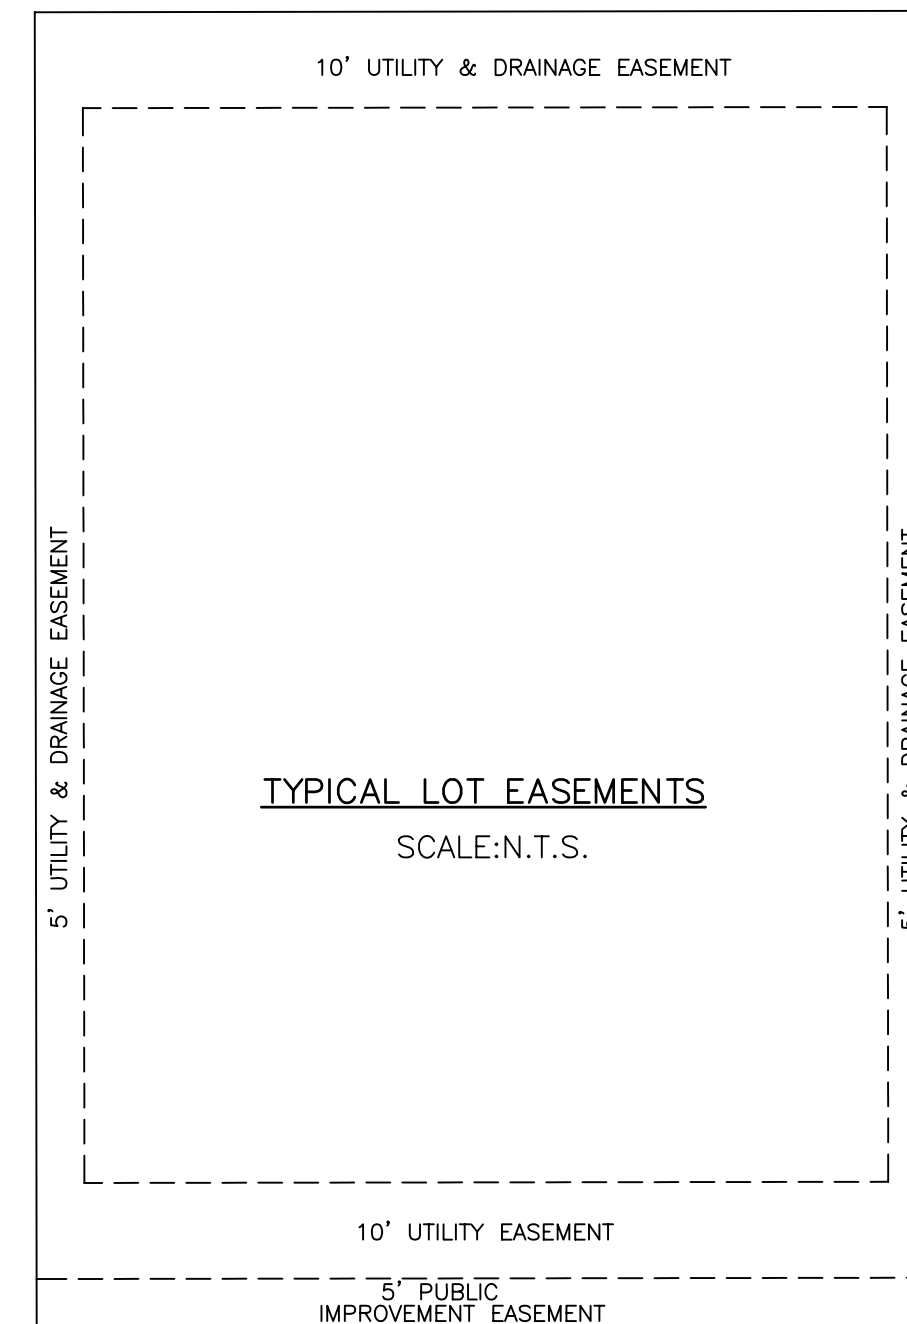


LEGEND

- BOUNDARY LINE
- LOT LINE
- CENTERLINE
- ADJACENT LOT LINE
- (0000) ADDRESS

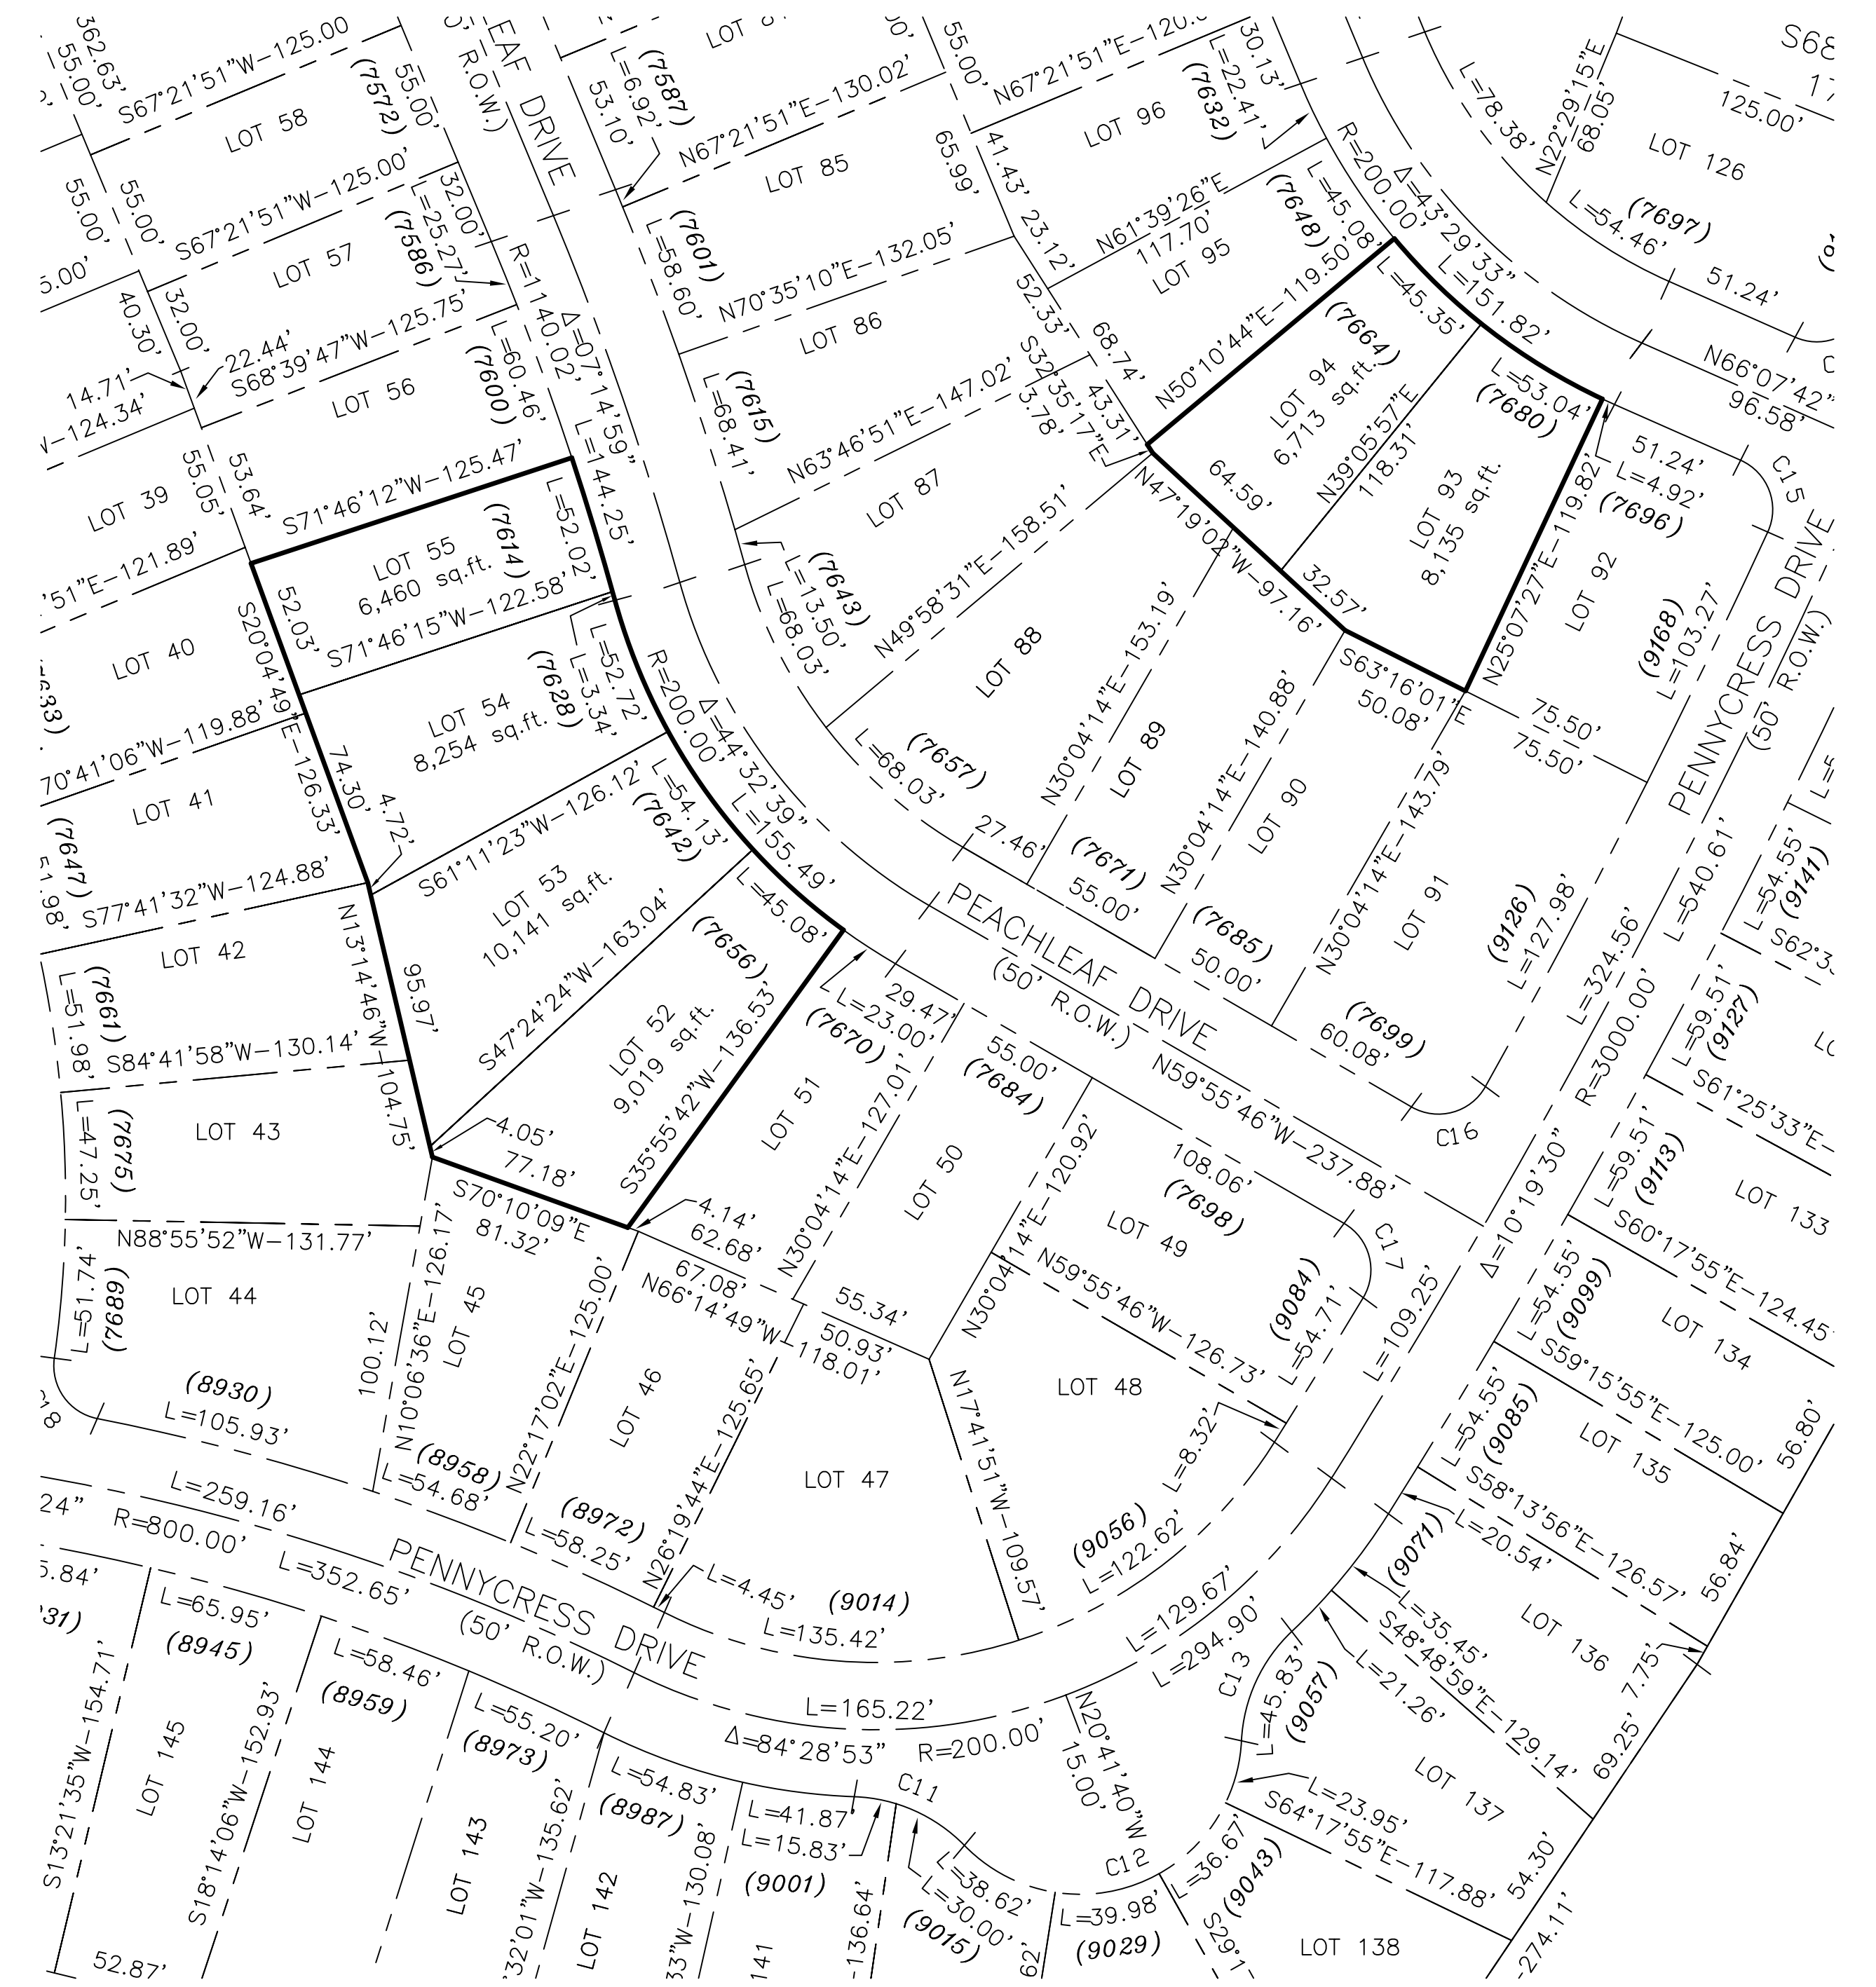


AS REPLATTED

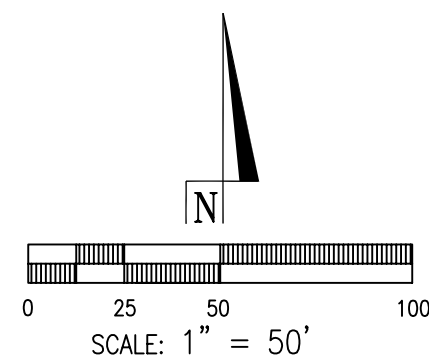

PCD FILE NO. VR1812


Markup Summary

dskkendall (2)

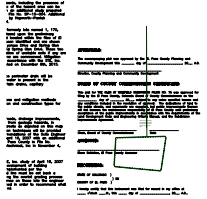

Subject: Cloud+
Page Label: 1
Lock: Unlocked
Author: dskkendall
Date: 2/15/2019 11:22:00 AM
Color: ■

This isn't necessary, the Board of County Commissioners will not be signing this plat.

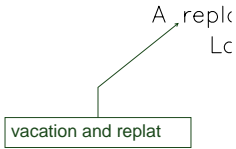

Subject: Callout
Page Label: 1
Lock: Unlocked
Author: dskkendall
Date: 2/15/2019 11:34:48 AM
Color: ■

vacation and replat