

Please add scale and north arrow.

SITE LOCATION




Woodmen Road

Meridian Road


HWY 24

Meadow Lake Sporthorses

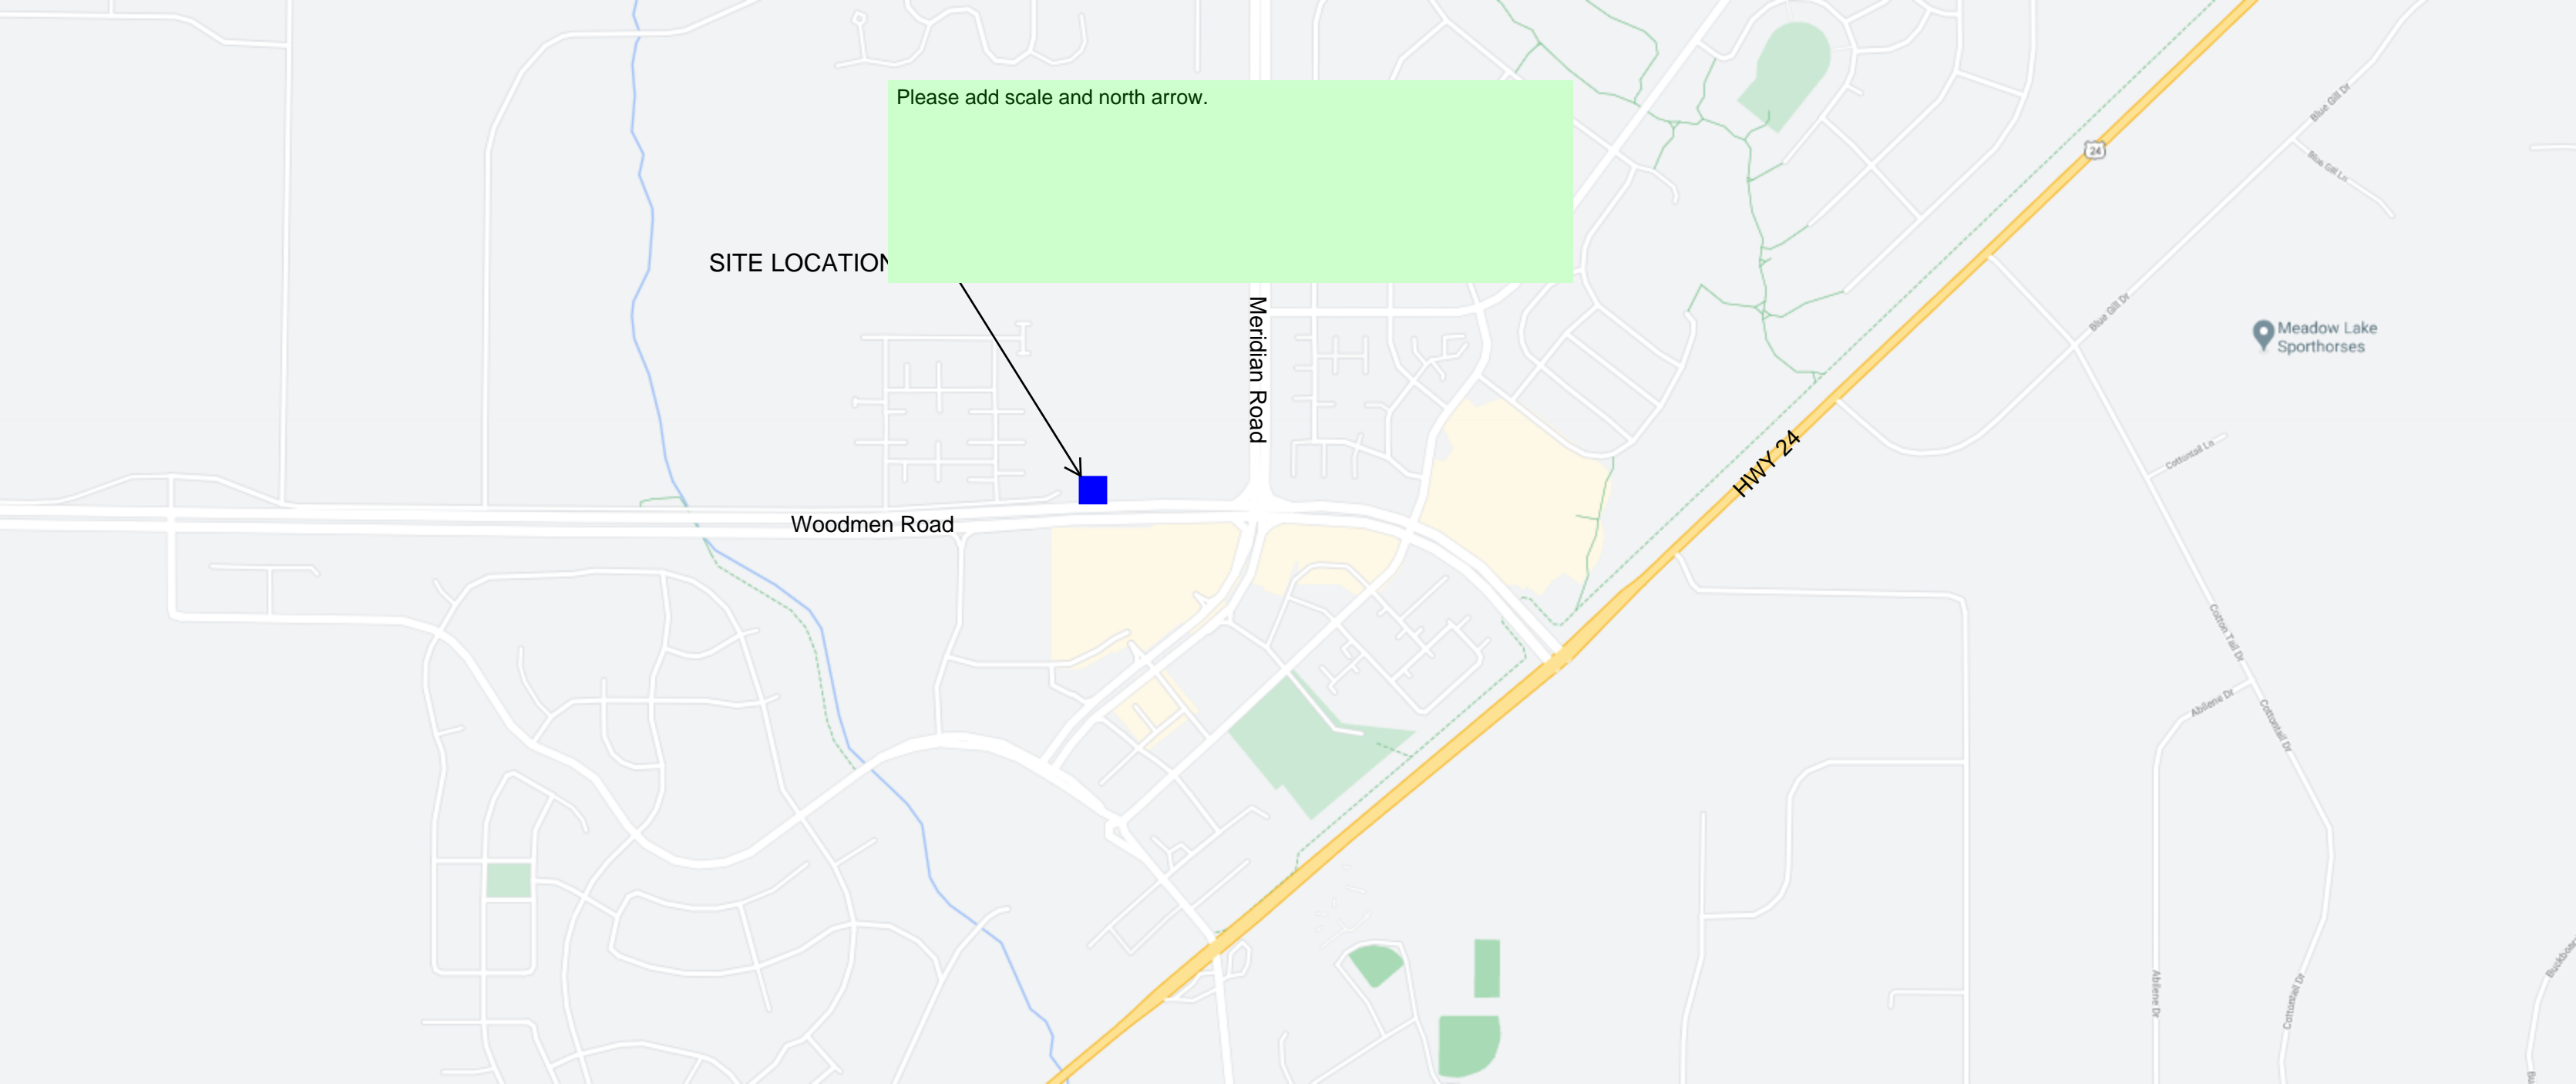

Vicinity Map_V1.pdf Markup Summary

Sophie Kiepe (1)

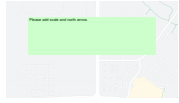

Subject: Stormwater Drainage

Page Label: 1

Author: Sophie Kiepe

Date: 4/2/2021 3:49:43 PM

Status:

Color: ■

Layer:

Space:

Please add scale and north arrow.