


Script area square footage: 29.946SF

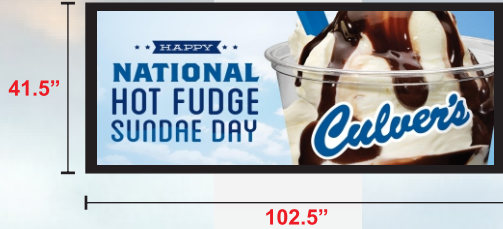

EMC square footage: 29.54SF

24'

Maximum allowable square footage for free standing sign is 40 square feet, per Section 6.2.10(D)2(b) of the Land Development Code. Please revise the design of sign to comply with the above cited requirements or submit a Master Sign Plan for review of the sign.



Total proposed square footage: 59.486



(719) 520-5167 FAX (719) 520-5902

Copyright © 2009

This drawing is provided for the purpose of illustrating the proposed project. Unauthorized use, copying, scanning or sharing is strictly prohibited and protected by law.

Electrical hookup by others.  
Electrical requirements: 120V (or as indicated)  
All landscaping by others

This conceptual illustration is designed to provide a view of how the sign might look in it's chosen location. Due to variables in digital photography, architectural renderings and unforeseen structural obstacles, the ratio of the finished sign to the area it is installed in may appear slightly different from the illustration. Colors shown are representative of the actual color code chosen. Variables in monitors, printers, inks and paper will alter how these colors appear on the drawing. Please refer to the actual color codes prior to approval.

Customer Information

Business Name: Culver's  
Project Name: freestanding sign  
Location Address: 7220 N. Meridian Rd.

Customer Approval

Name and Title \_\_\_\_\_  
Authorization \_\_\_\_\_ Date \_\_\_\_\_



# Sign Plan\_v1.pdf Markup Summary

---

Cloud+ (1)

---



**Subject:** Cloud+  
**Page Label:** 1  
**Author:** John Green  
**Date:** 11/12/2020 9:18:35 AM  
**Status:**  
**Color:** ■  
**Layer:**  
**Space:**

Maximum allowable square footage for free standing sign is 40 square feet, per Section 6.2.10(D)2(b) of the Land Development Code. Please revise the design of sign to comply with the above cited requirements or submit a Master Sign Plan for review of the sign.