



#	Date	Issue / Description	Init.
01	2021.08.13	FIRST SUBMITTAL	

Project No: HRG 1.20  
 Drawn By: JK  
 Checked By: JFR/PB  
 Date: 2021.08.13

LANDSCAPE OVERVIEW PLAN

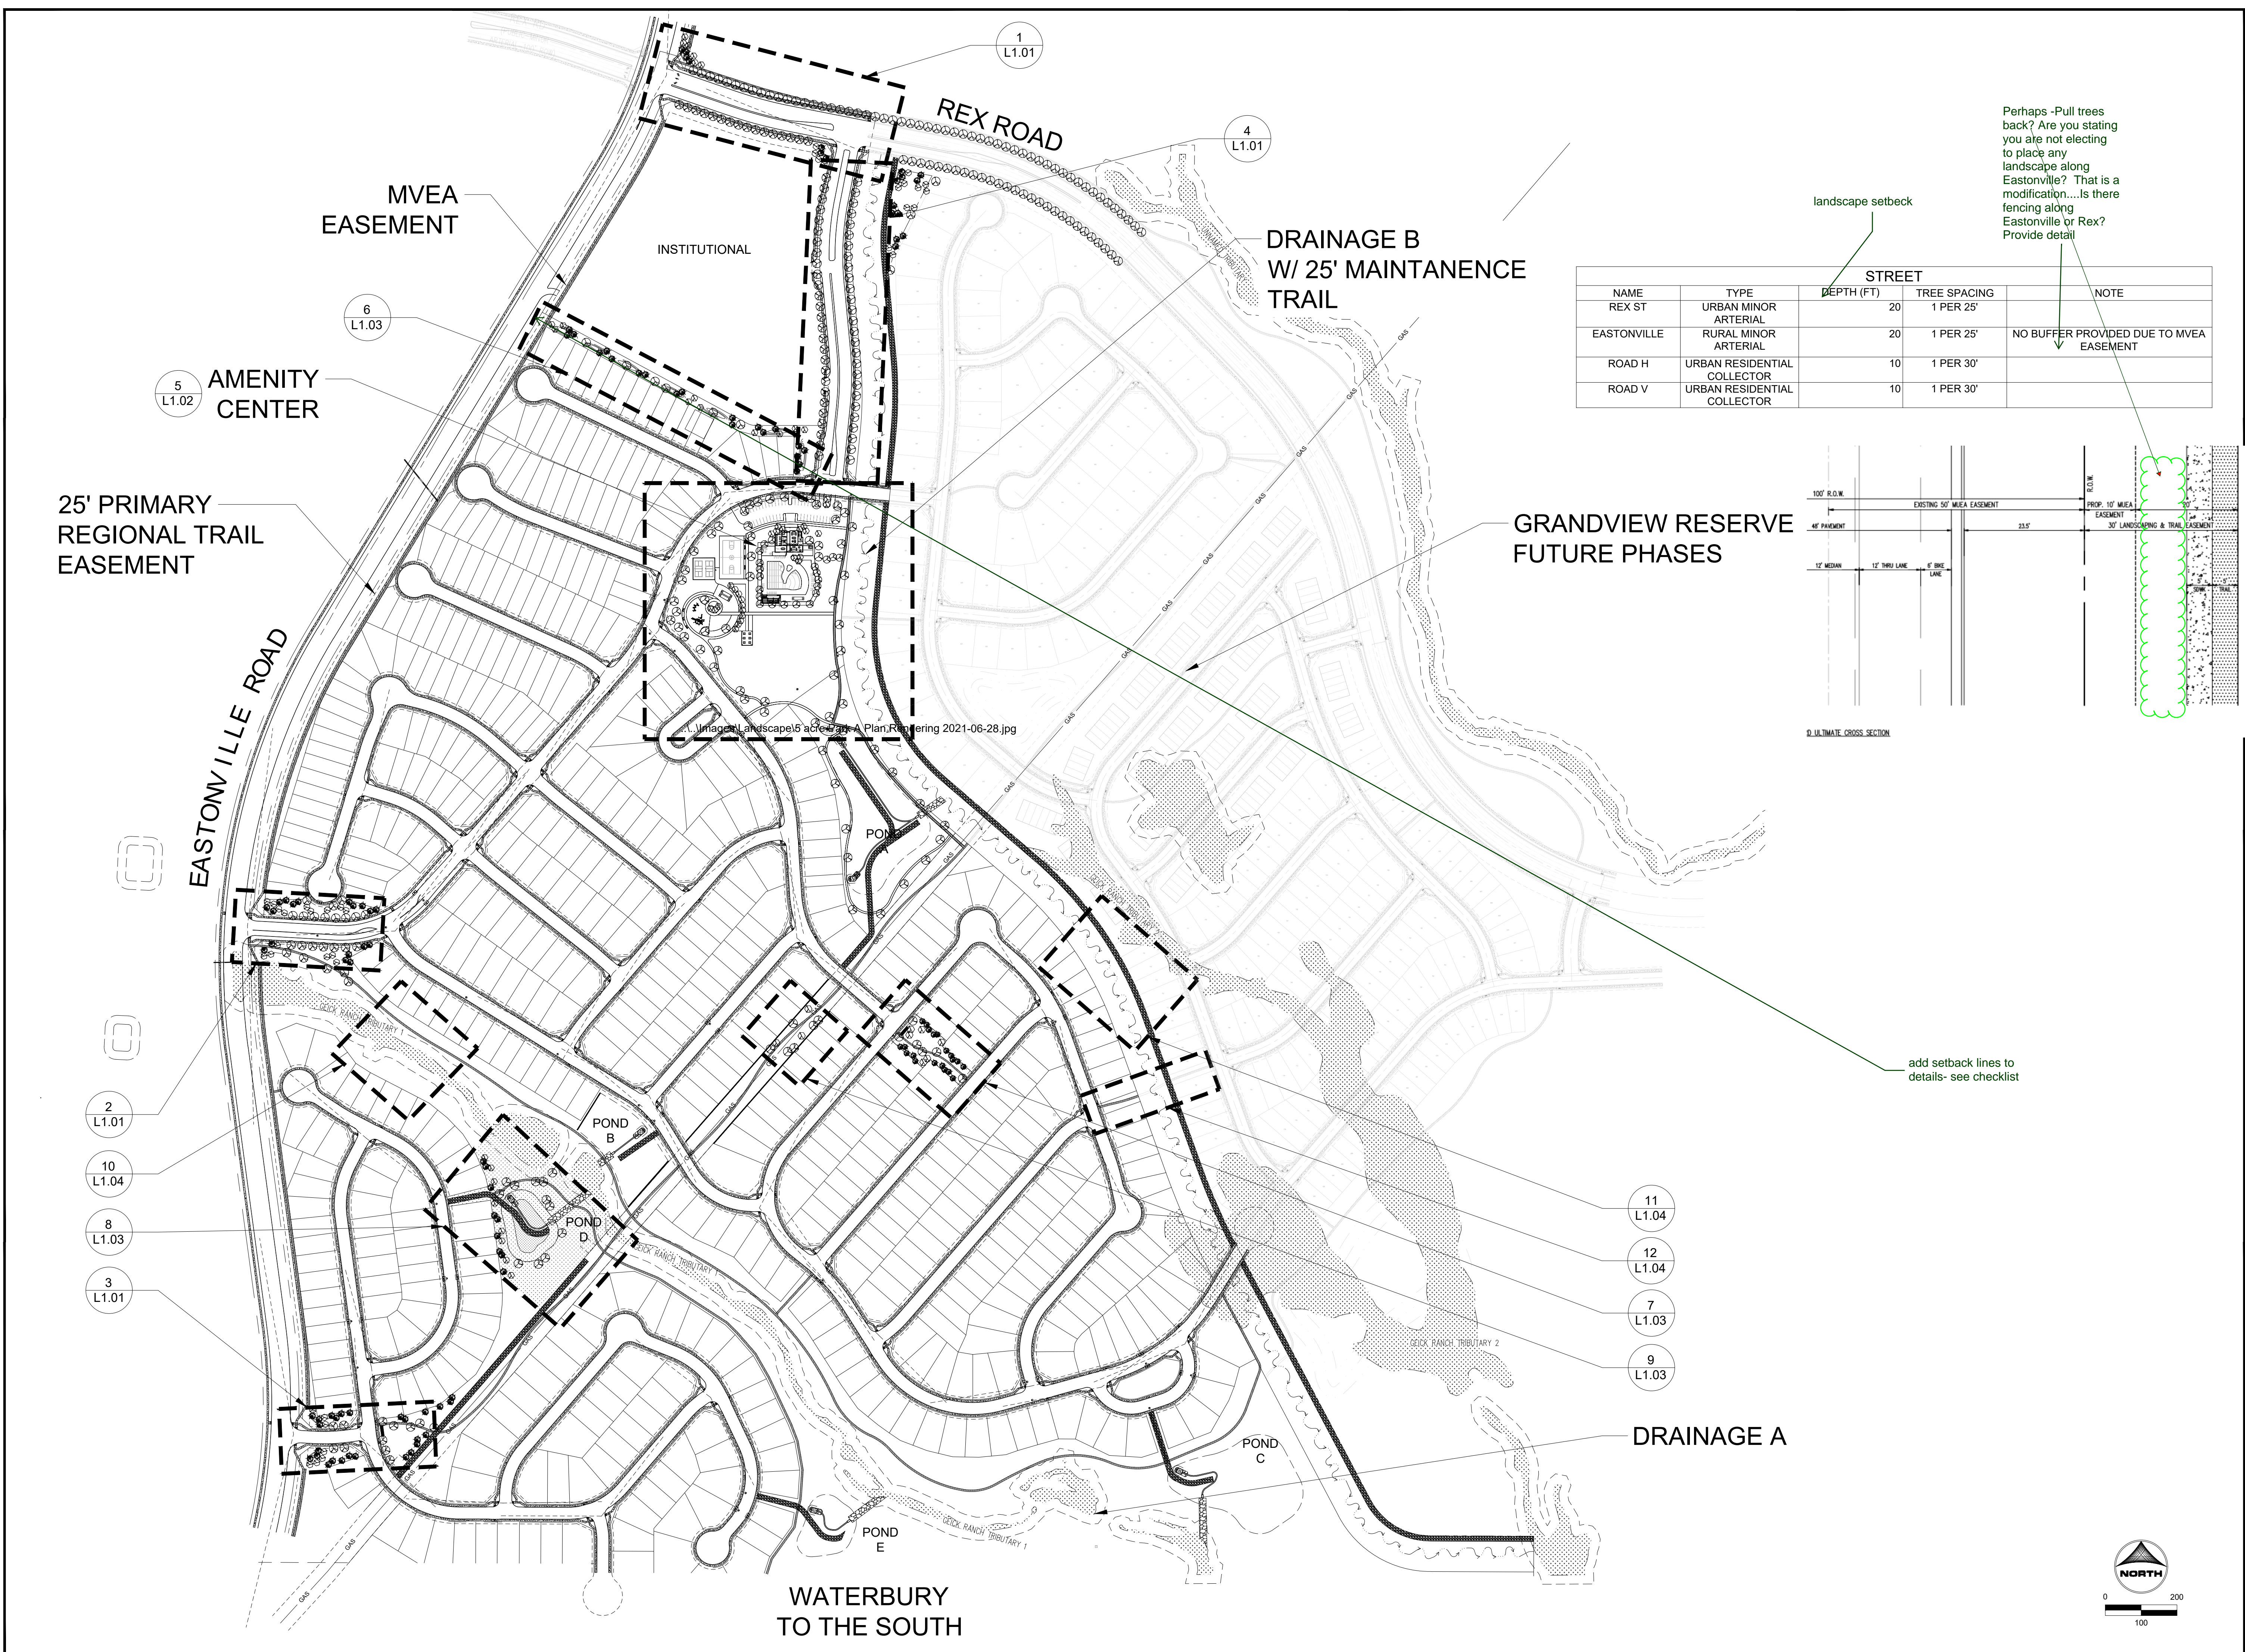


STREET				
NAME	TYPE	DEPTH (FT)	TREE SPACING	NOTE
REX ST	URBAN MINOR ARTERIAL	20	1 PER 25'	
EASTONVILLE	RURAL MINOR ARTERIAL	20	1 PER 25'	NO BUFFER PROVIDED DUE TO MVEA EASEMENT
ROAD H	URBAN RESIDENTIAL COLLECTOR	10	1 PER 30'	
ROAD V	URBAN RESIDENTIAL COLLECTOR	10	1 PER 30'	

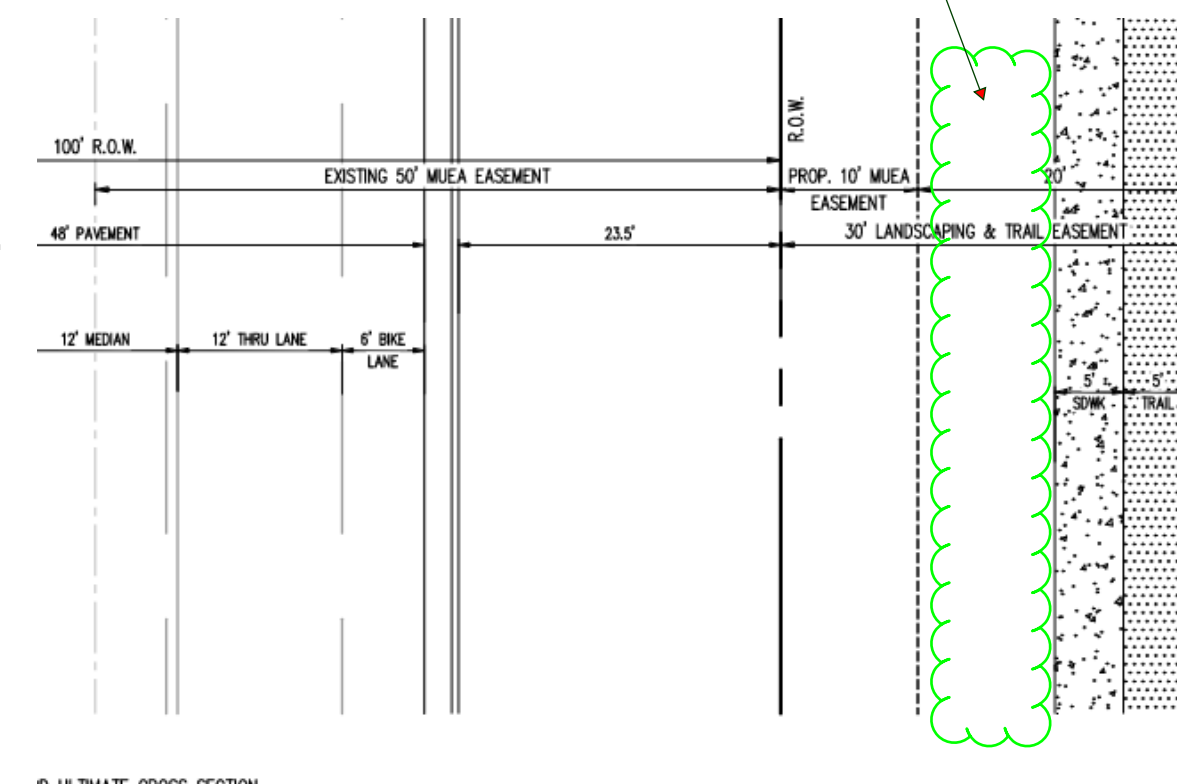

Perhaps -Pull trees back? Are you stating you are not electing to place any landscape along Eastonville? That is a modification...Is there fencing along Eastonville or Rex? Provide detail

add setback lines to details- see checklist

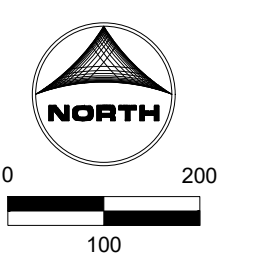

WATERBURY TO THE SOUTH

\\img01\landscape\6 acres\A Plan\Rendering 2021-06-28.jpg

**COPYRIGHT**  
 THESE PLANS ARE AN INSTRUMENT OF SERVICE AND ARE THE PROPERTY OF GALLOWAY, AND MAY NOT BE DUPLICATED, DISCLOSED, OR REPRODUCED WITHOUT THE WRITTEN CONSENT OF GALLOWAY. COPYRIGHTS AND INFRINGEMENTS WILL BE ENFORCED AND PROSECUTED.



HR GREEN - COLORADO SPRINGS  
 7222 COMMERCE CENTER DR., SUITE 220  
 COLORADO SPRINGS CO 80919  
 PHONE: 719.622.6222  
 FAX: 844.273.1057

PUD PRELIMINARY PLAN  
 GRANDVIEW RESERVE FILING 1

EASTONVILLE RD  
 EL PASO COUNTY, PEYTON, CO 80831




#	Date	Issue / Description	Init.
01	2021.08.13	FIRST SUBMITTAL	

Project No: HRG 1.20  
 Drawn By: JK  
 Checked By: JFR/PB  
 Date: 2021.08.13

DETAILED LANDSCAPE PLAN

**L1.1**  
 Sheet 14 of 17

if there is an entry sign or subdivision sign provide the dimensions and detail so its a part of the specific PUD zoning or the structure will have to meet setbacks /height/ and sign code; add sight distance triangles - verify sight distance is not obstructed..Jeff Rice can help you calculate if you need clarification of the ECM.

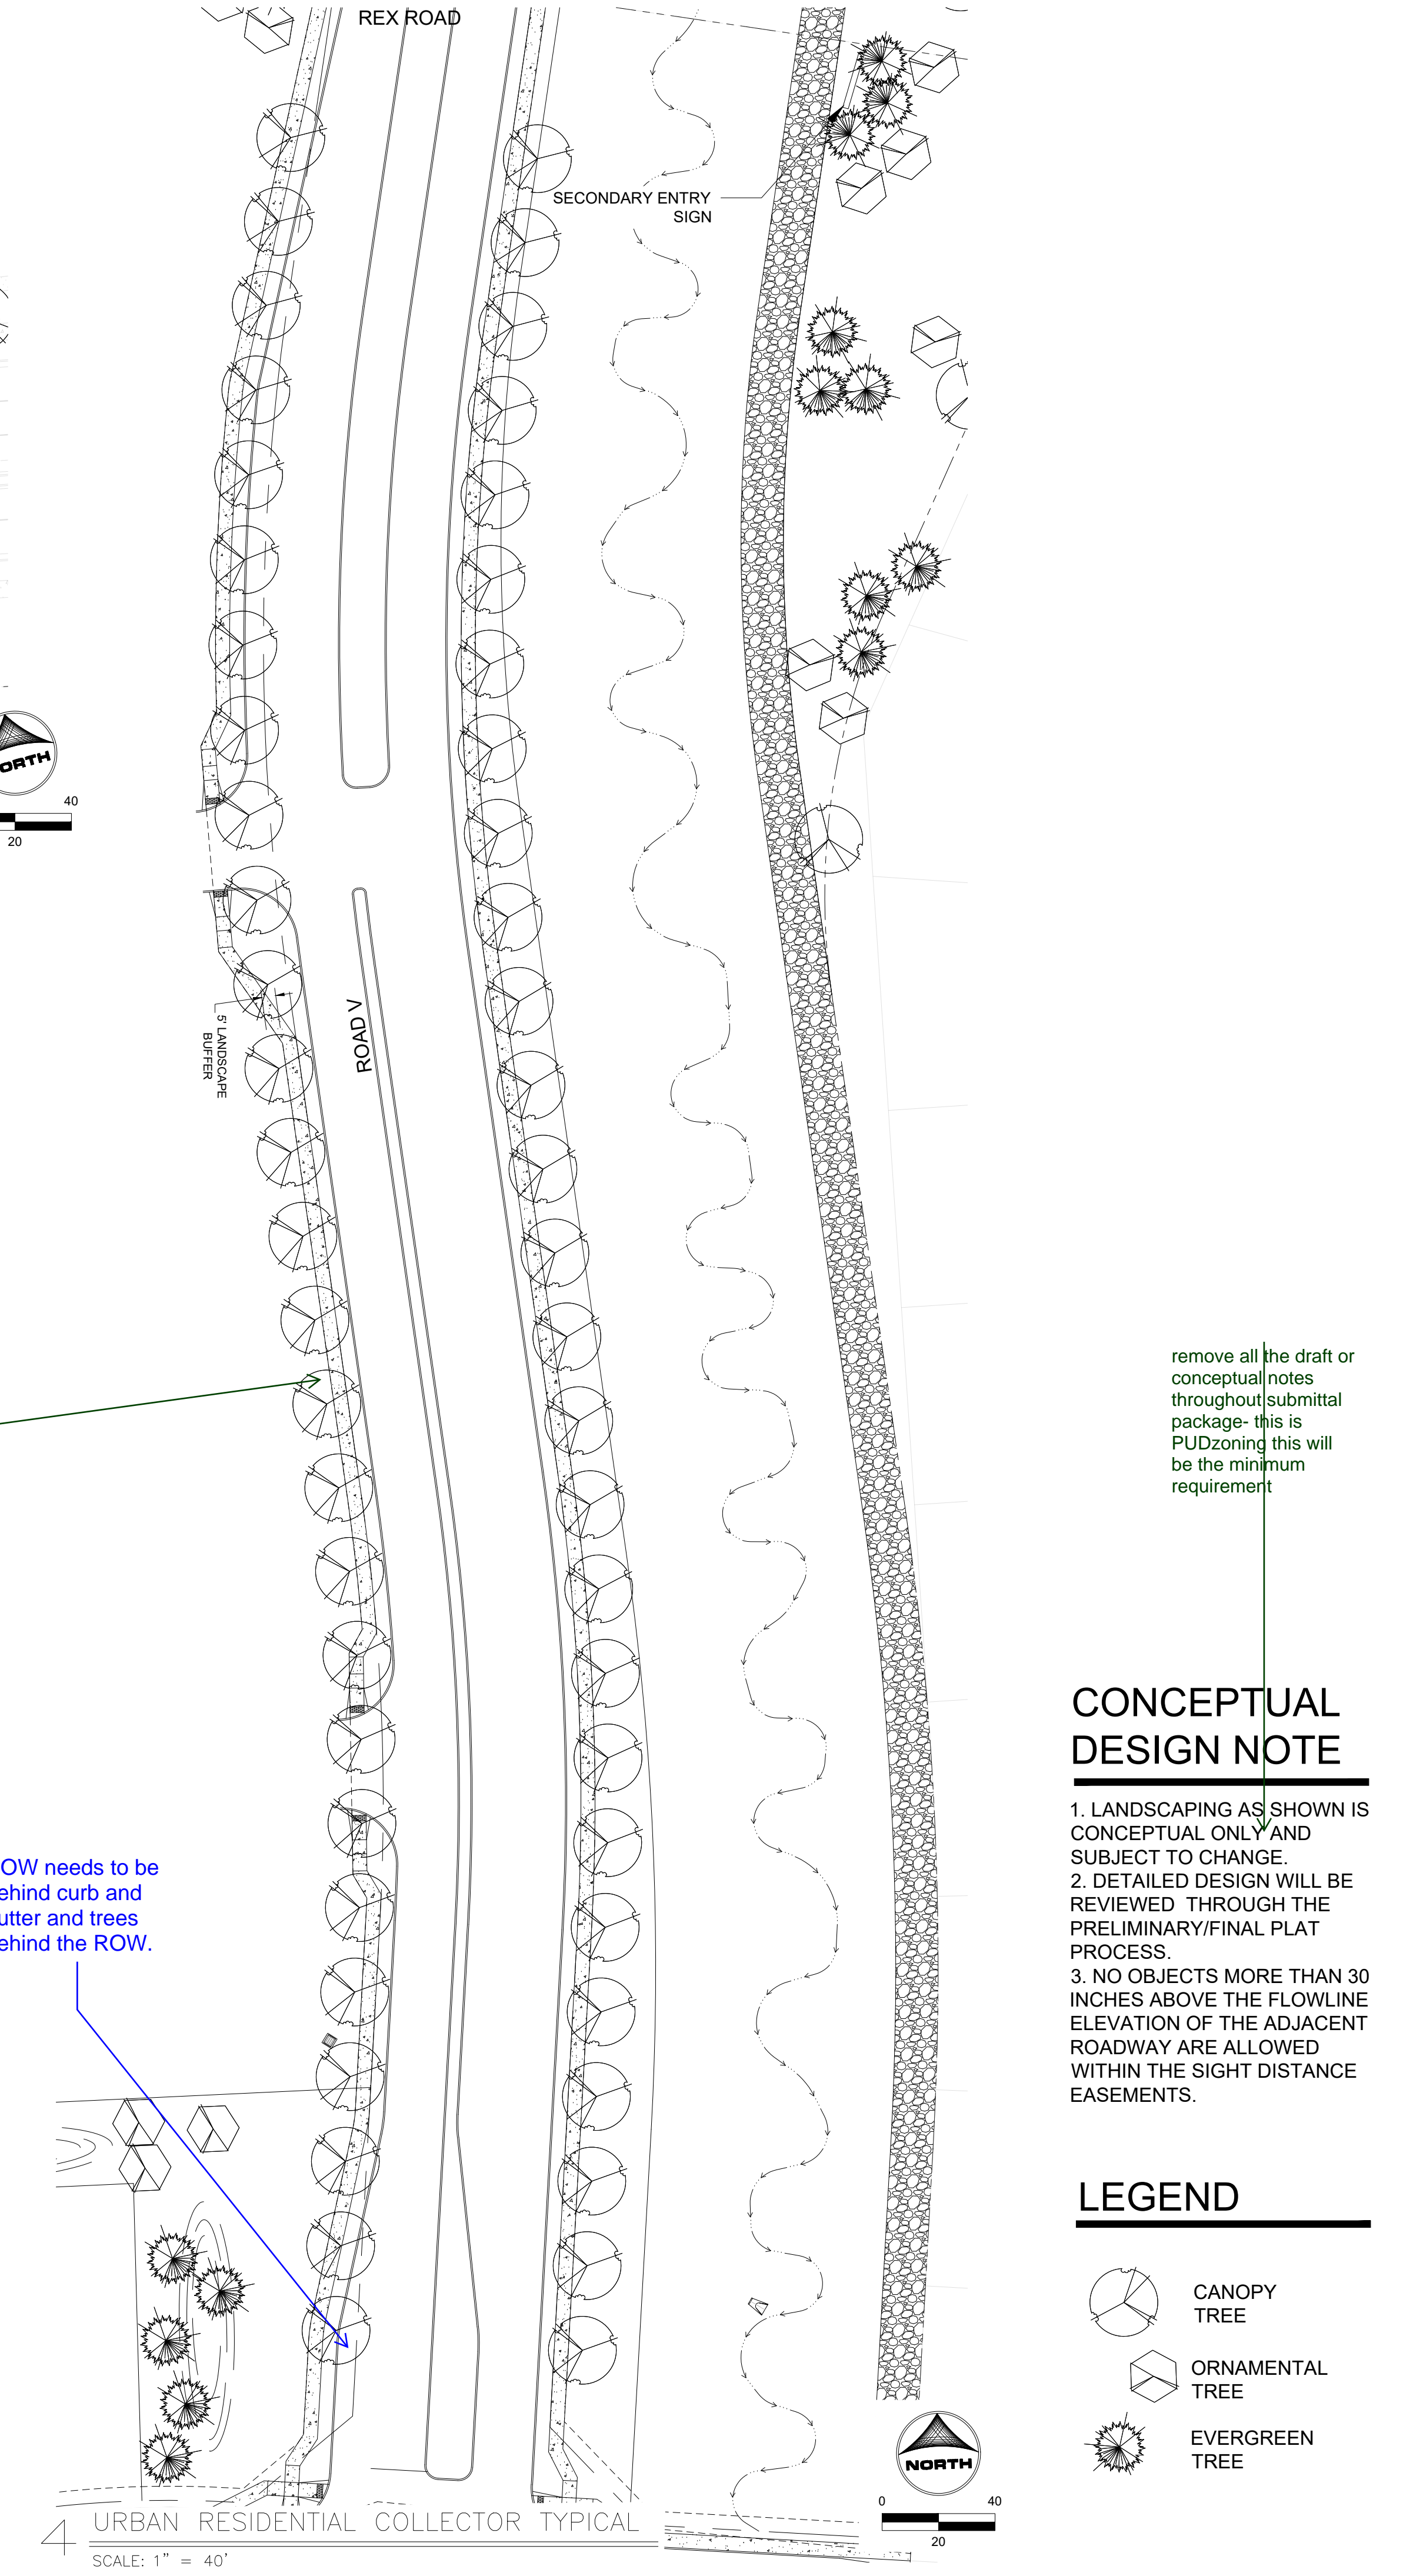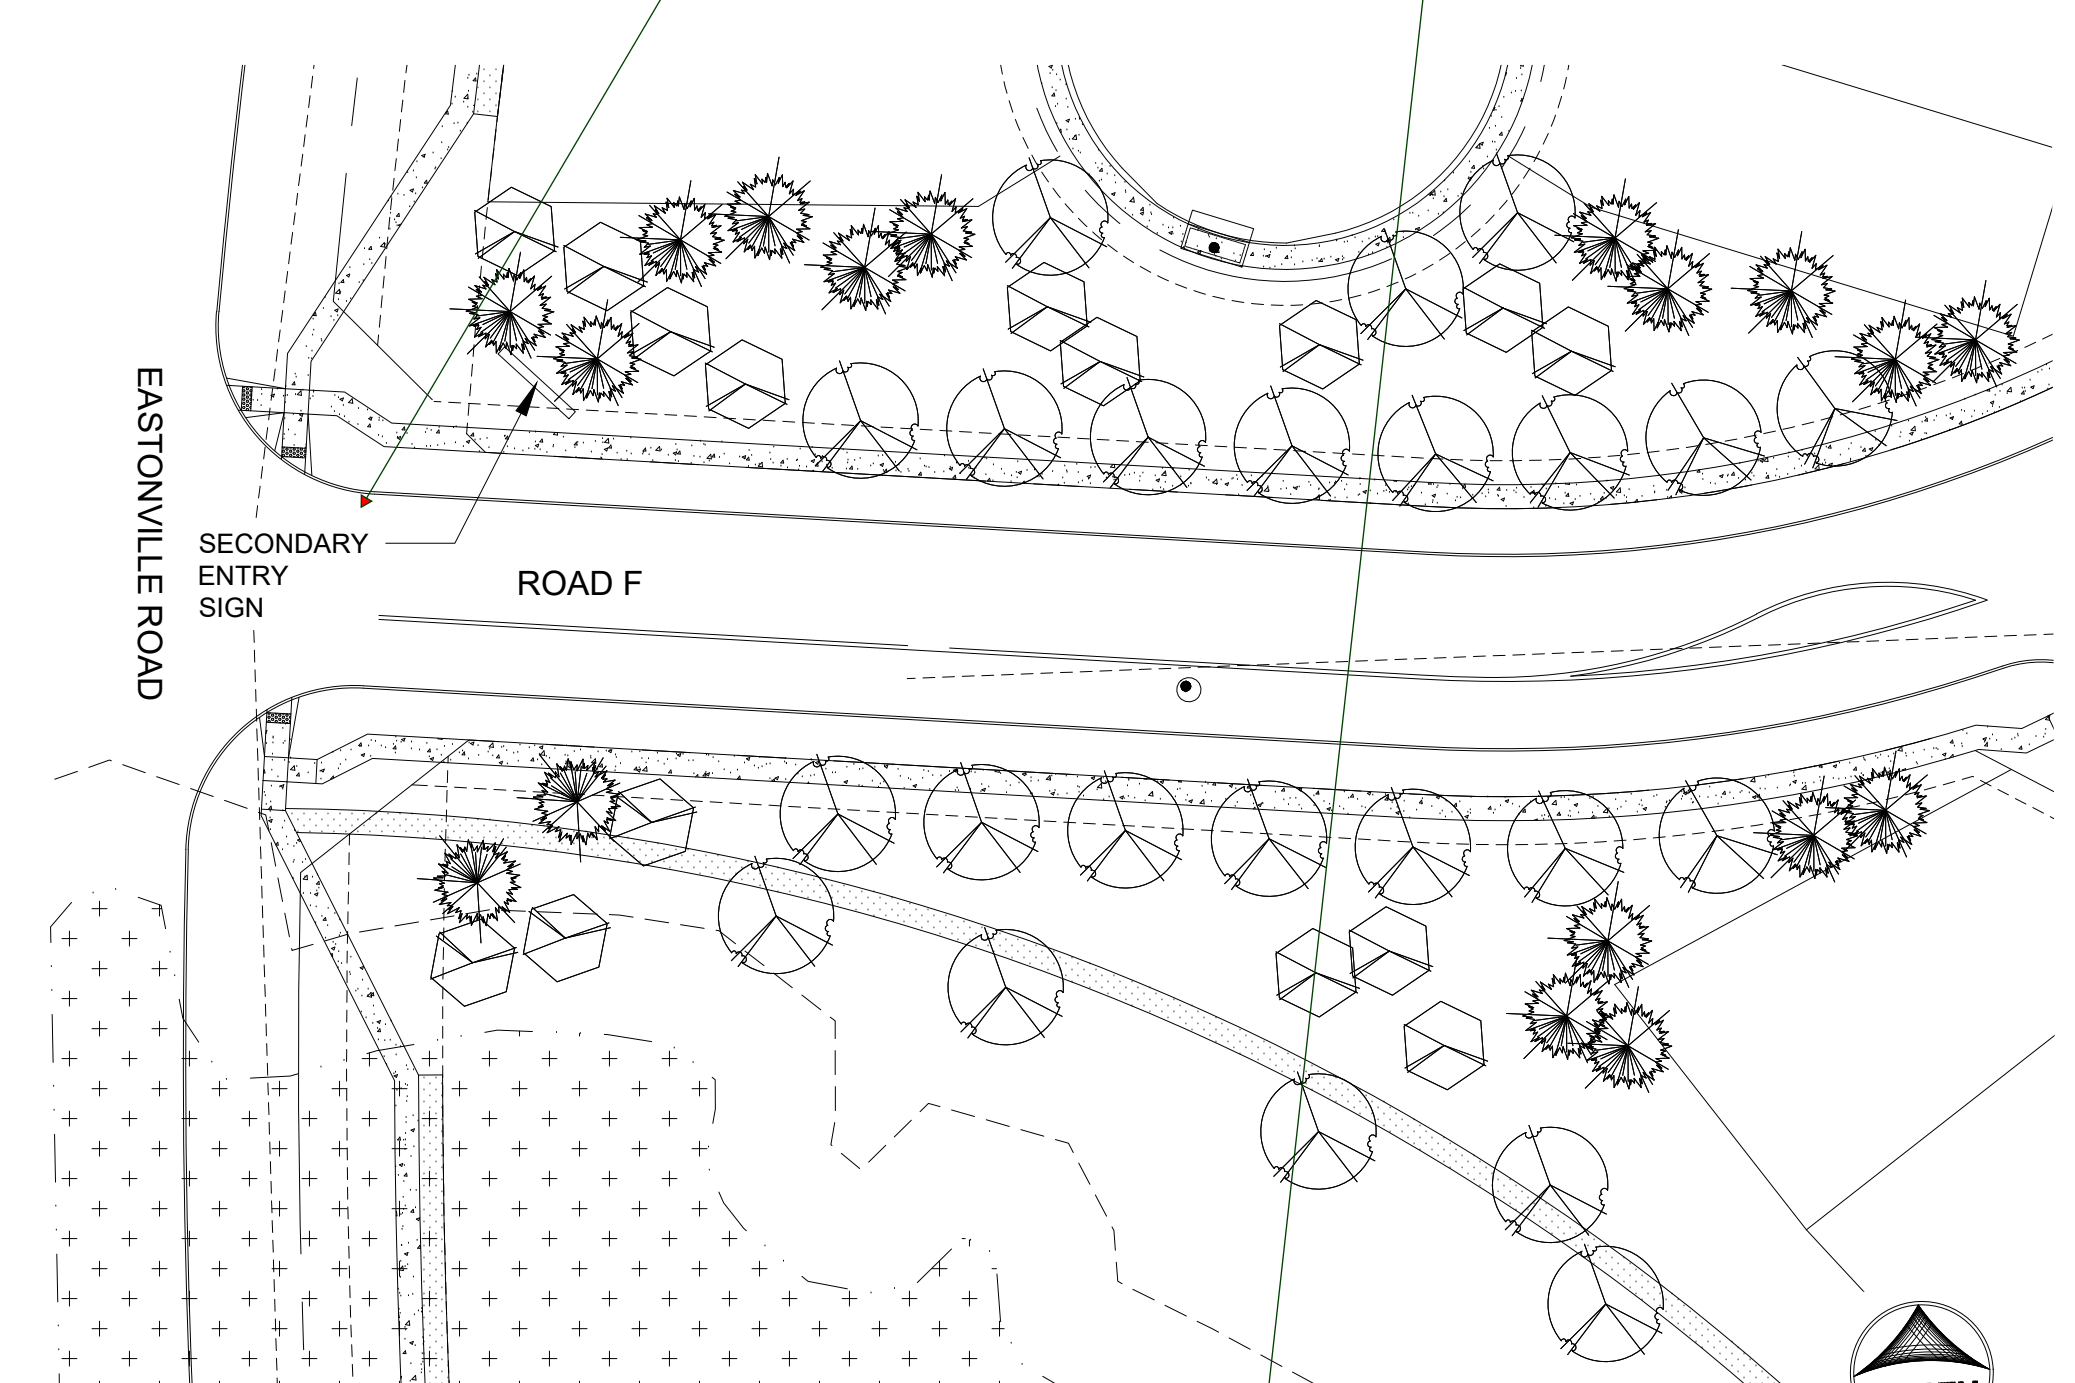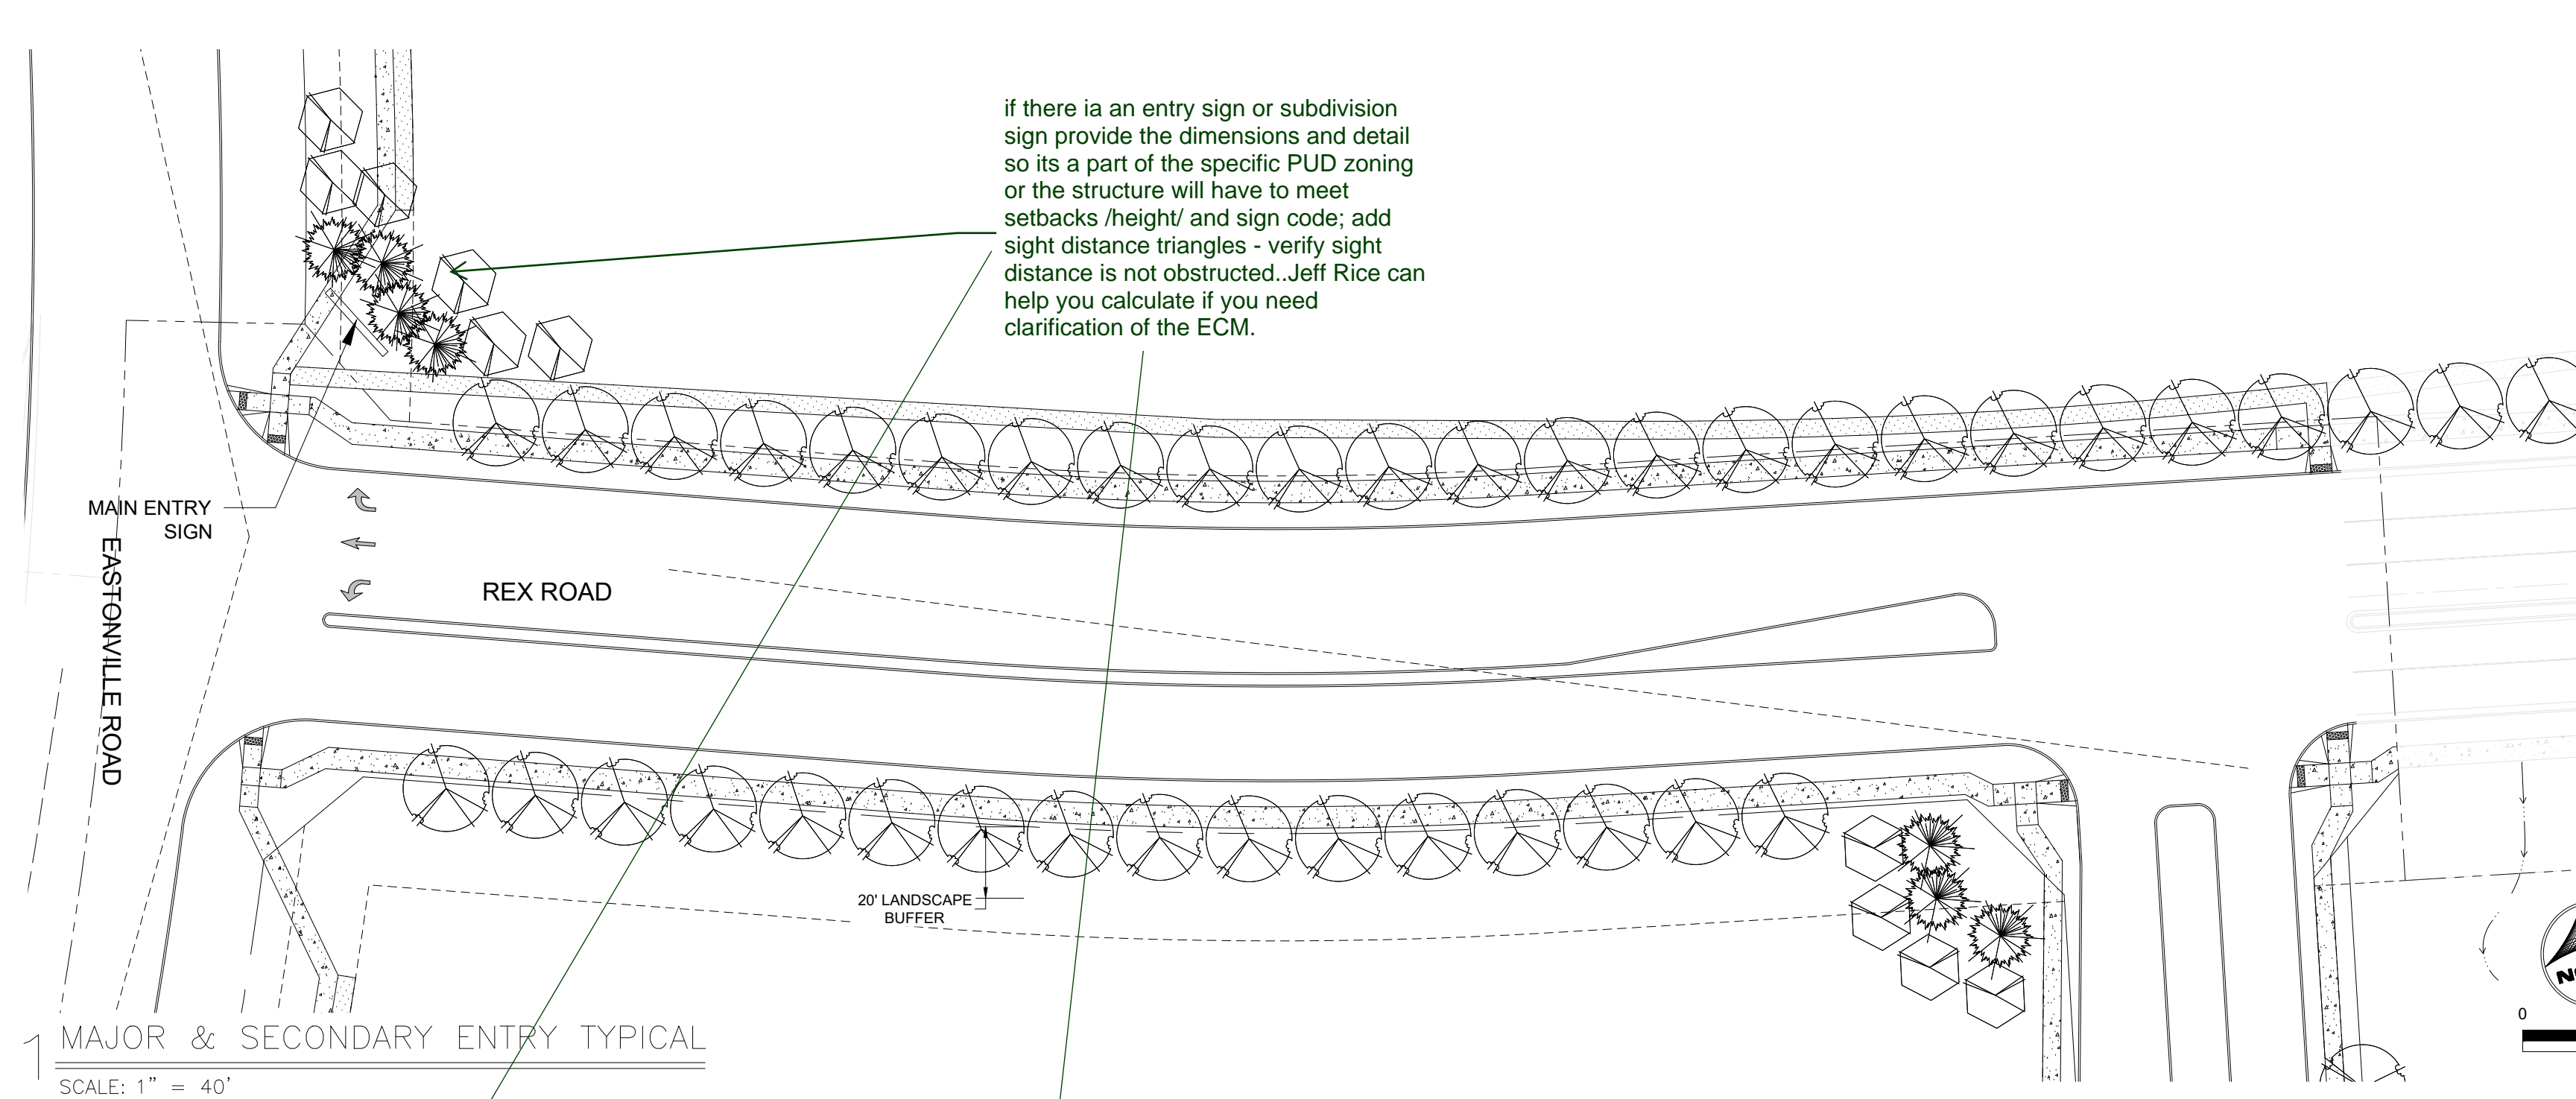

see lanscape plan checklist - Look at PUDSP212 Skyline at Lorson Ranch or PUDSP216 Ridge at Lorson Ranch as a good example

label the setback, row lines, sidewalks trails, ; easements etc

remove all the draft or conceptual notes throughout submittal package- this is PUD zoning this will be the minimum requirement


ROW needs to be behind curb and gutter and trees behind the ROW.

**CONCEPTUAL DESIGN NOTE**

1. LANDSCAPING AS SHOWN IS CONCEPTUAL ONLY AND SUBJECT TO CHANGE.
2. DETAILED DESIGN WILL BE REVIEWED THROUGH THE PRELIMINARY/FINAL PLAT PROCESS.
3. NO OBJECTS MORE THAN 30 INCHES ABOVE THE FLOWLINE ELEVATION OF THE ADJACENT ROADWAY ARE ALLOWED WITHIN THE SIGHT DISTANCE EASEMENTS.

**LEGEND**

- CANOPY TREE
- ORNAMENTAL TREE
- EVERGREEN TREE

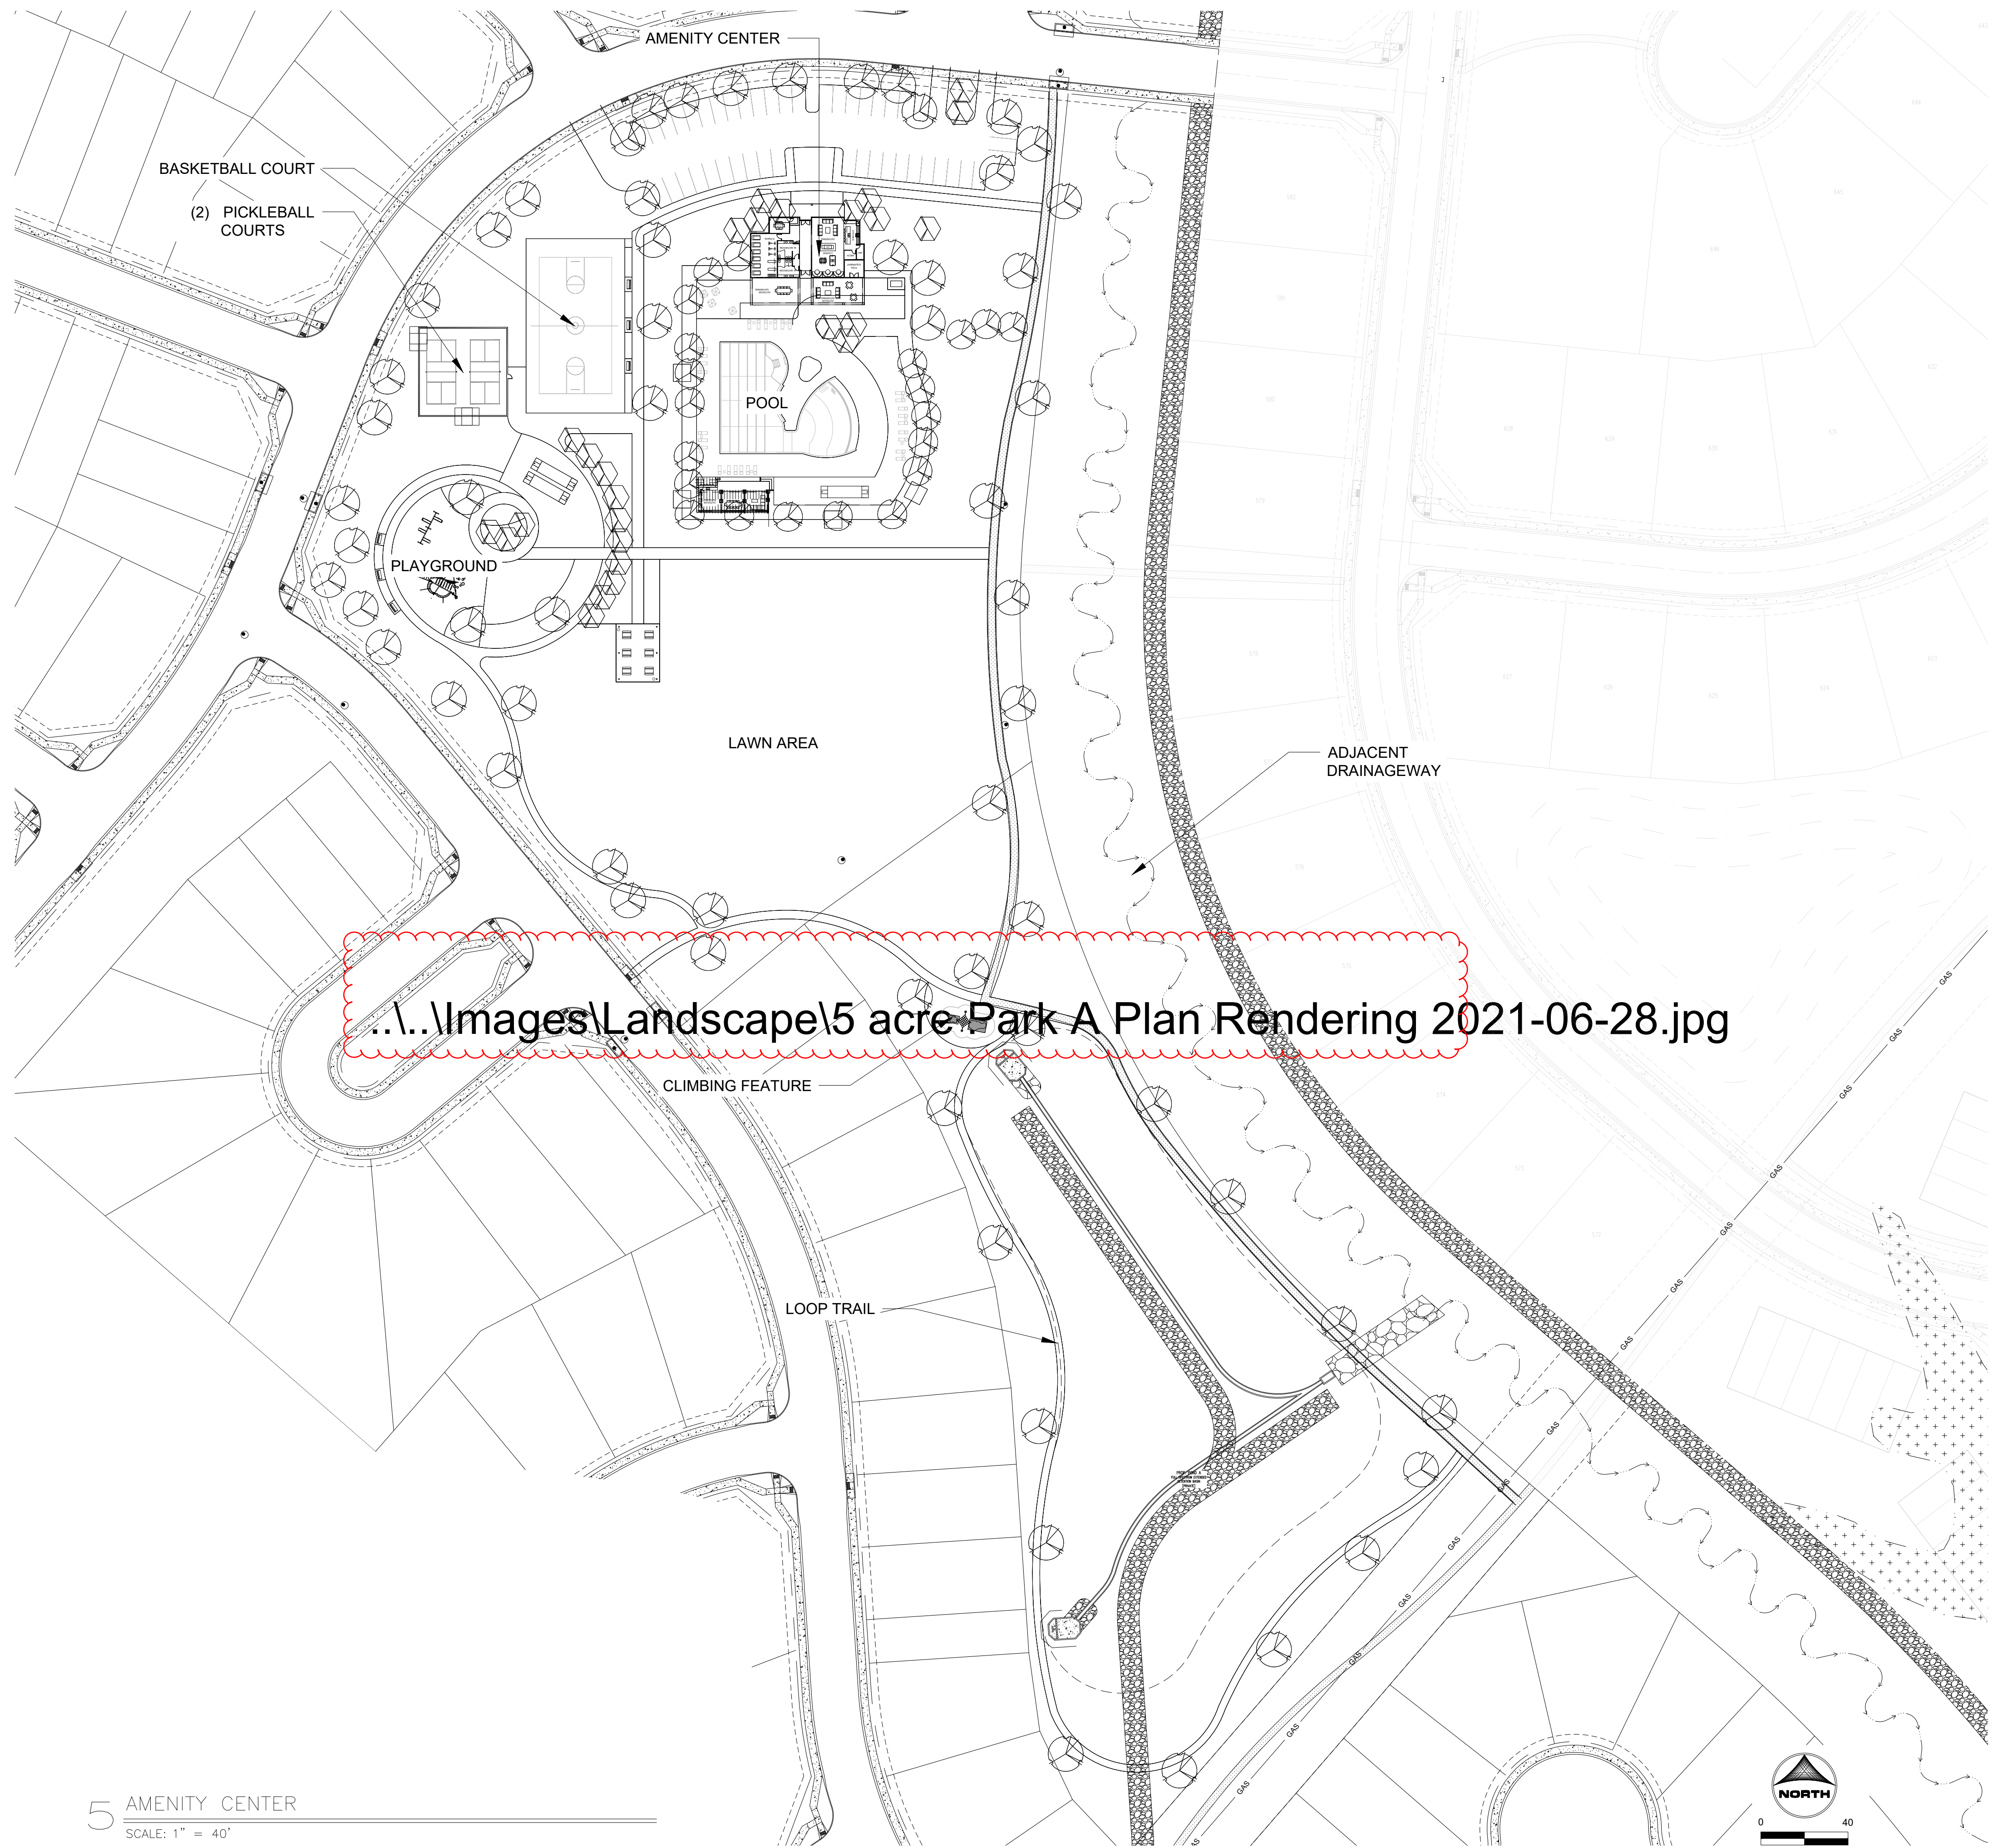

..\..\Images\Landscape\5 acre Park A Plan Rendering 2021-06-28.jpg

5 AMENITY CENTER  
SCALE: 1" = 40'

**CONCEPTUAL DESIGN NOTE**

1. LANDSCAPING AS SHOWN IS CONCEPTUAL ONLY AND SUBJECT TO CHANGE.
2. DETAILED DESIGN WILL BE REVIEWED THROUGH THE PRELIMINARY/FINAL PLAT PROCESS.
3. NO OBJECTS MORE THAN 30 INCHES ABOVE THE FLOWLINE ELEVATION OF THE ADJACENT ROADWAY ARE ALLOWED WITHIN THE SIGHT DISTANCE EASEMENTS.


**LEGEND**

- CANOPY TREE
- ORNAMENTAL TREE
- EVERGREEN TREE


#	Date	Issue / Description	Init.
01	2021.08.13	FIRST SUBMITTAL	

Project No: HRG 1.20  
Drawn By: JK  
Checked By: JFR/PB  
Date: 2021.08.13


DETAILED LANDSCAPE PLAN

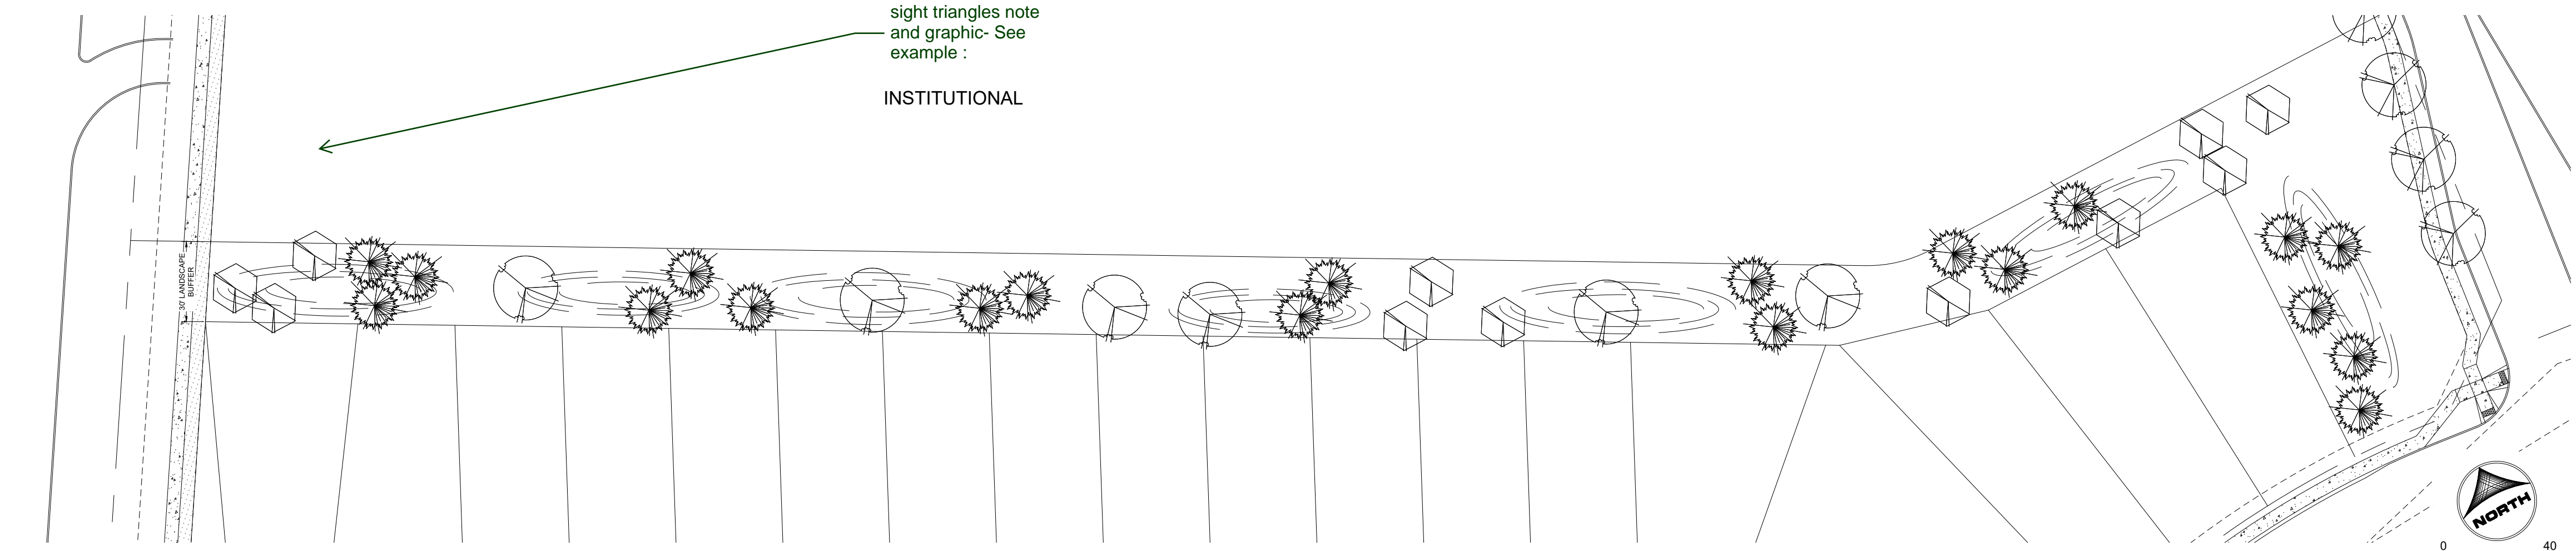


6 RESIDENTIAL / NON-RESIDENTIAL BUFFER TYPICAL  
SCALE: 1" = 40'

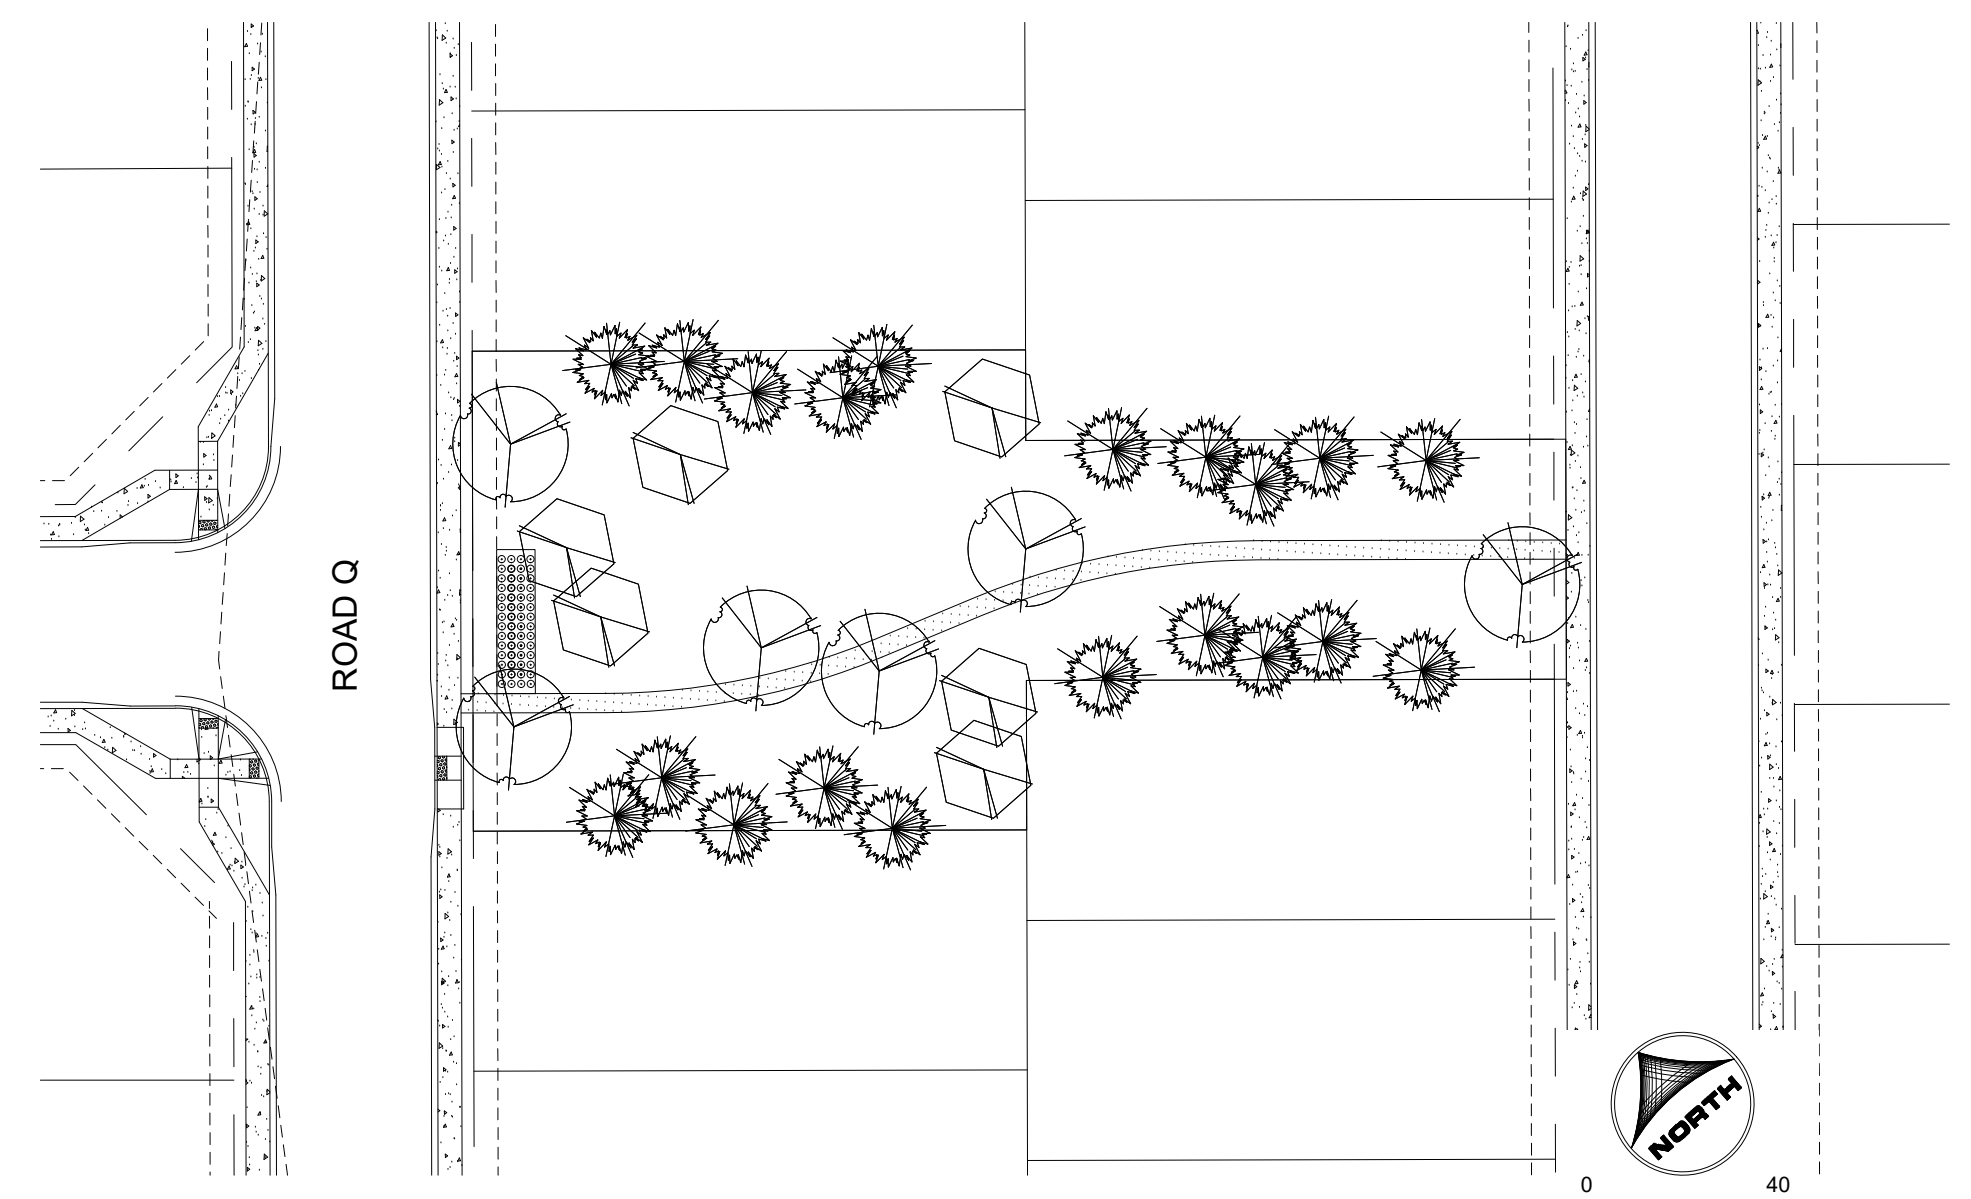


7 POCKET PARK TYPICAL  
SCALE: 1" = 40'

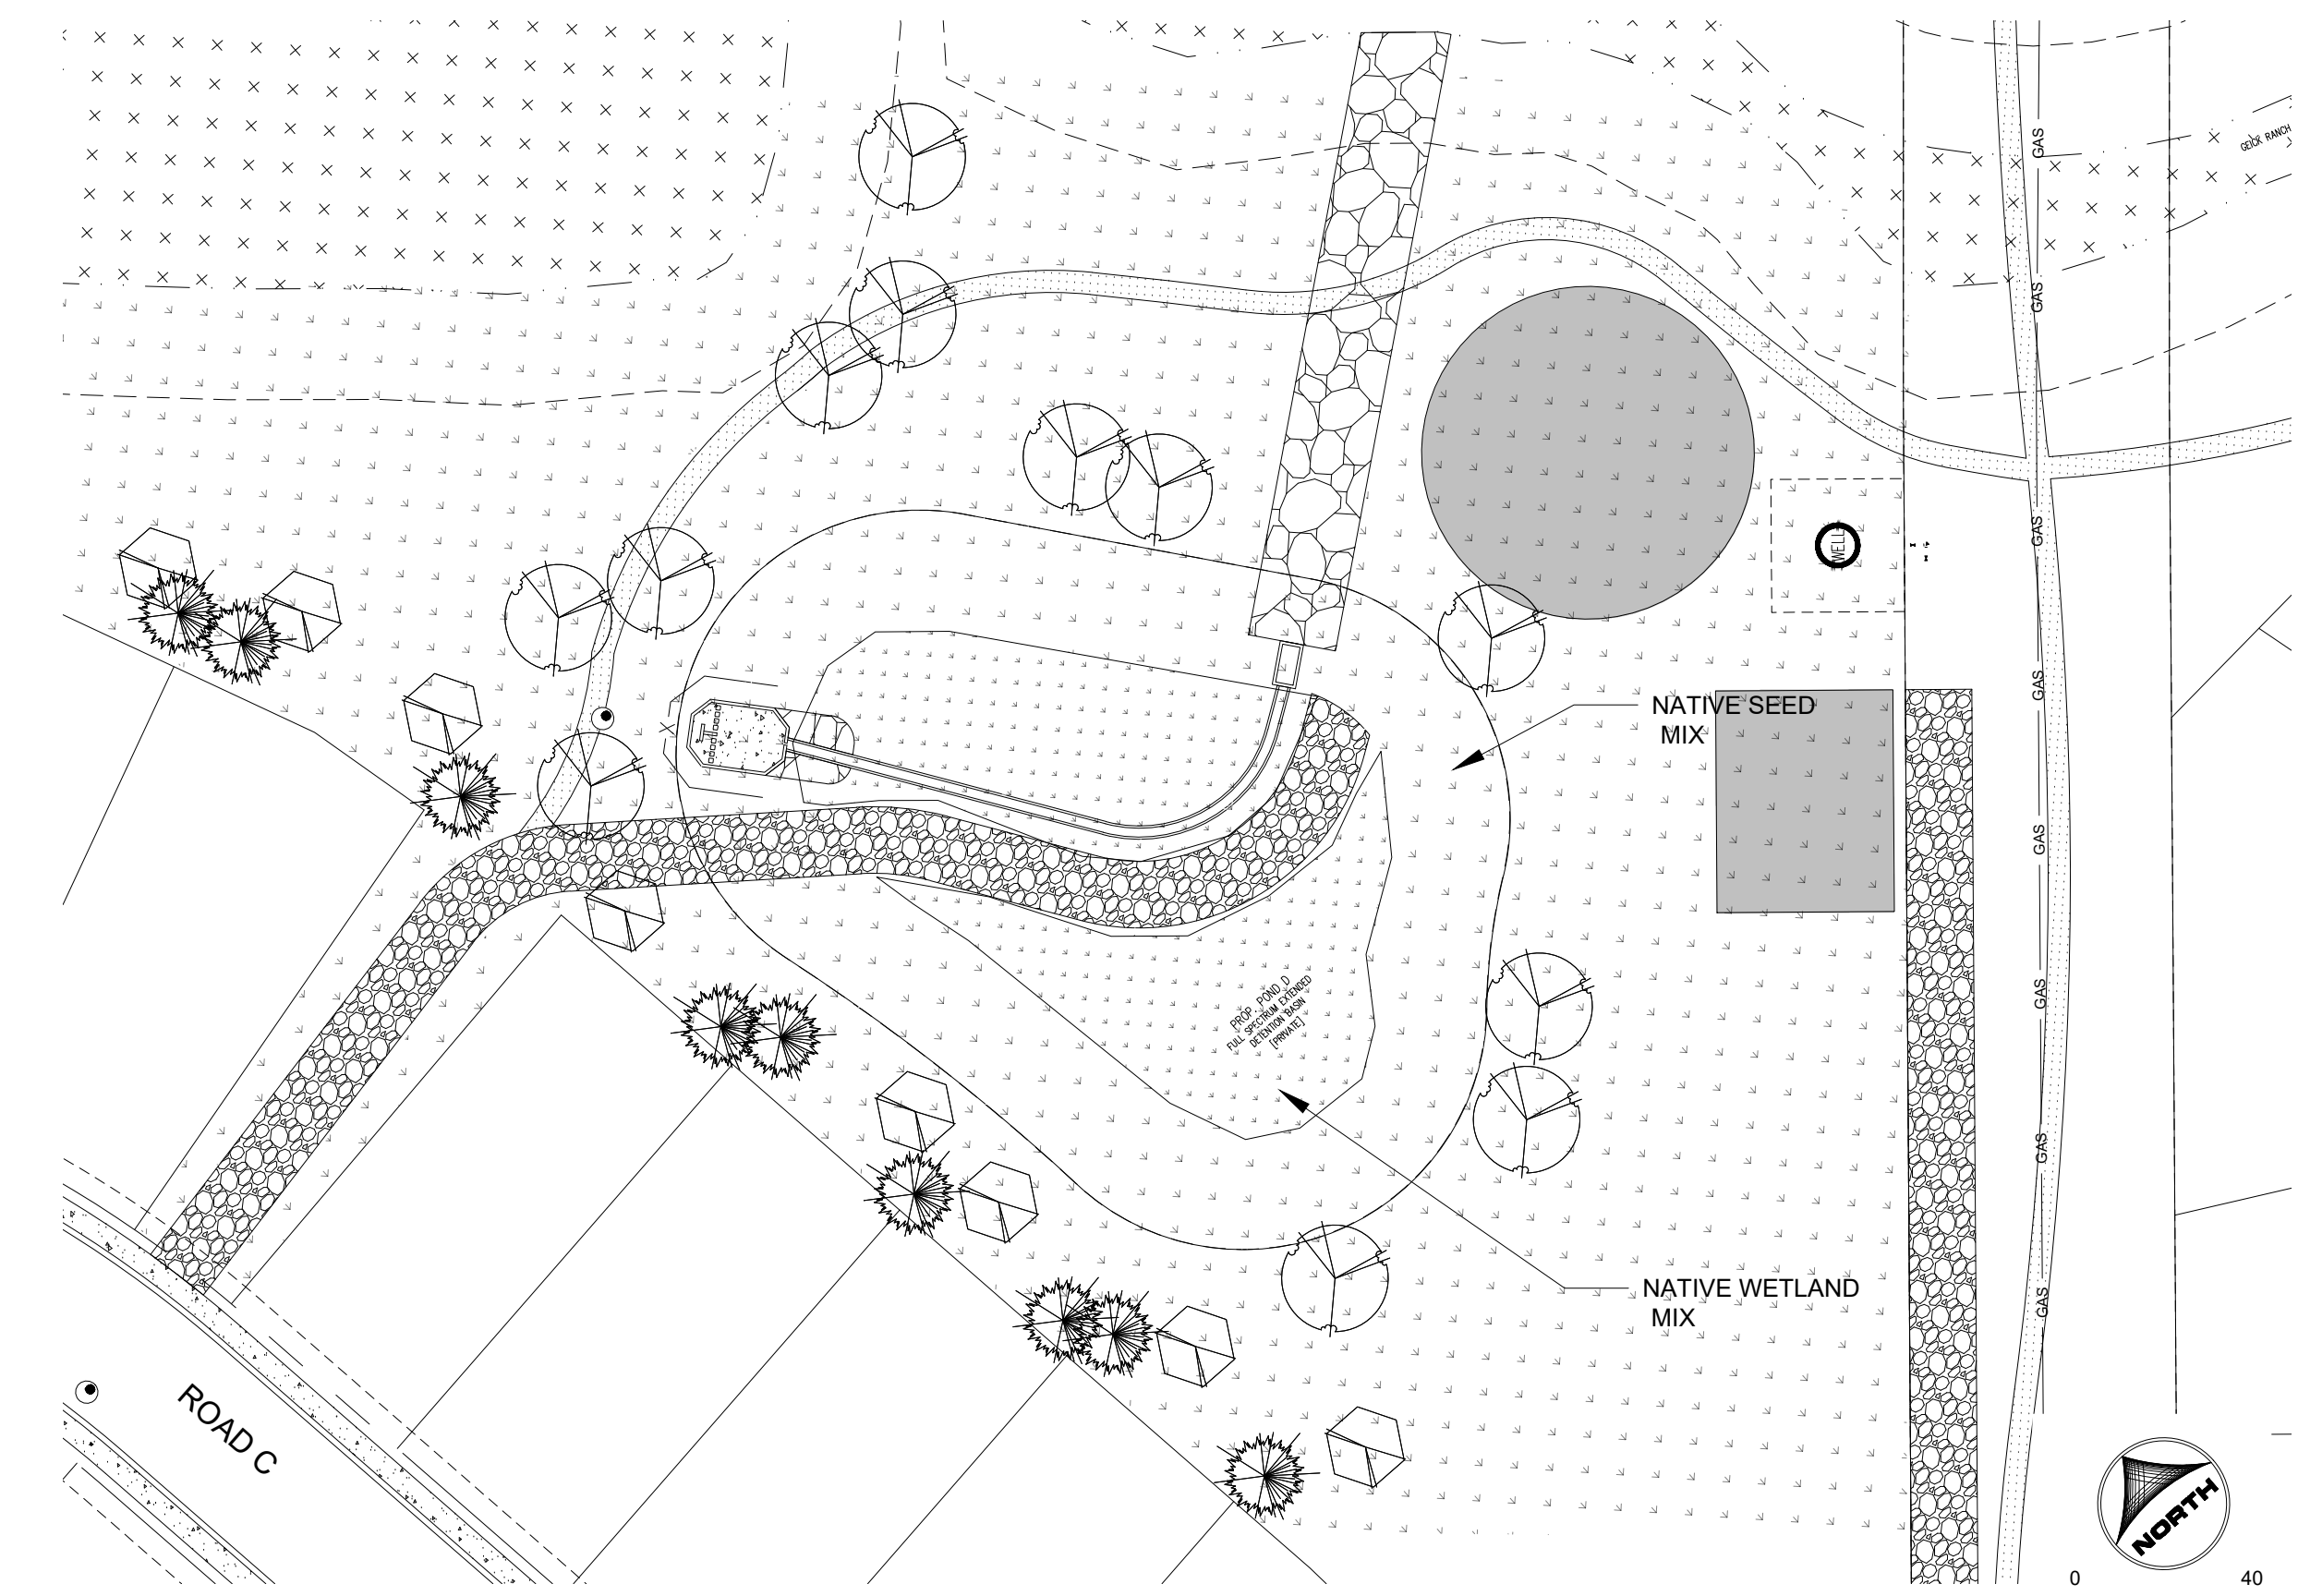

8 DETENTION BASIN TYPICAL  
SCALE: 1" = 40'

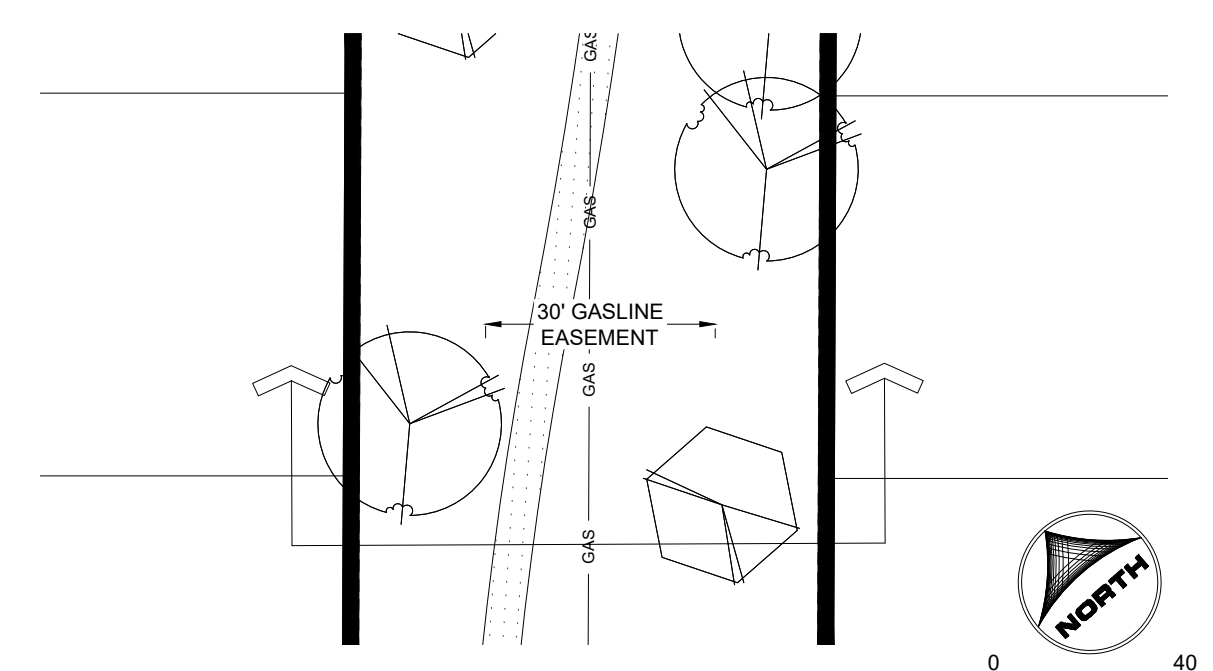

9 TRAIL SECTION TYPICAL  
SCALE: 1" = 40'

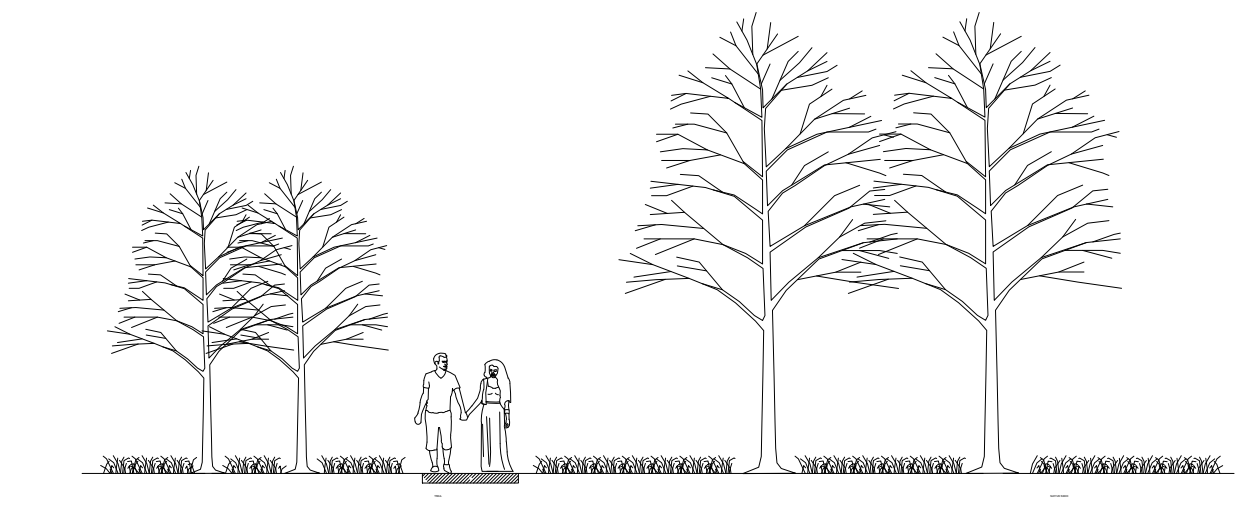

9 TRAIL SECTION SECTION  
SCALE: 1" = 10'

### CONCEPTUAL DESIGN NOTE

1. LANDSCAPING AS SHOWN IS CONCEPTUAL ONLY AND SUBJECT TO CHANGE.
2. DETAILED DESIGN WILL BE REVIEWED THROUGH THE PRELIMINARY/FINAL PLAT PROCESS.
3. NO OBJECTS MORE THAN 30 INCHES ABOVE THE FLOWLINE ELEVATION OF THE ADJACENT ROADWAY ARE ALLOWED WITHIN THE SIGHT DISTANCE EASEMENTS.

### LEGEND

- CANOPY TREE
- ORNAMENTAL TREE
- EVERGREEN TREE

#	Date	Issue / Description	Init.
01	2021.08.13	FIRST SUBMITTAL	

Project No:	HRG 1.20
Drawn By:	JK
Checked By:	JFR/PB
Date:	2021.08.13

DETAILED LANDSCAPE PLAN

**COPYRIGHT**  
THESE PLANS ARE AN INSTRUMENT OF SERVICE AND ARE THE PROPERTY OF GALLOWAY, AND MAY NOT BE DUPLICATED, DISCLOSED, OR REPRODUCED WITHOUT THE WRITTEN CONSENT OF GALLOWAY. COPYRIGHTS AND INFRINGEMENTS WILL BE ENFORCED AND PROSECUTED.



HR GREEN - COLORADO SPRINGS  
7222 COMMERCE CENTER DR. SUITE 220  
COLORADO SPRINGS CO 80919  
PHONE: 719.622.6222  
FAX: 844.273.1057








PUD PRELIMINARY PLAN  
GRANDVIEW RESERVE FILING 1

EASTONVILLE RD  
EL PASO COUNTY, PEYTON, CO 80831

#	Date	Issue / Description	Init.
01	2021.08.13	FIRST SUBMITTAL	
1			
2			
3			
Project No: HRG 1.20  
Drawn By: JK  
Checked By: JFR/PB  
Date: 2021.08.13

DETAILED LANDSCAPE PLAN

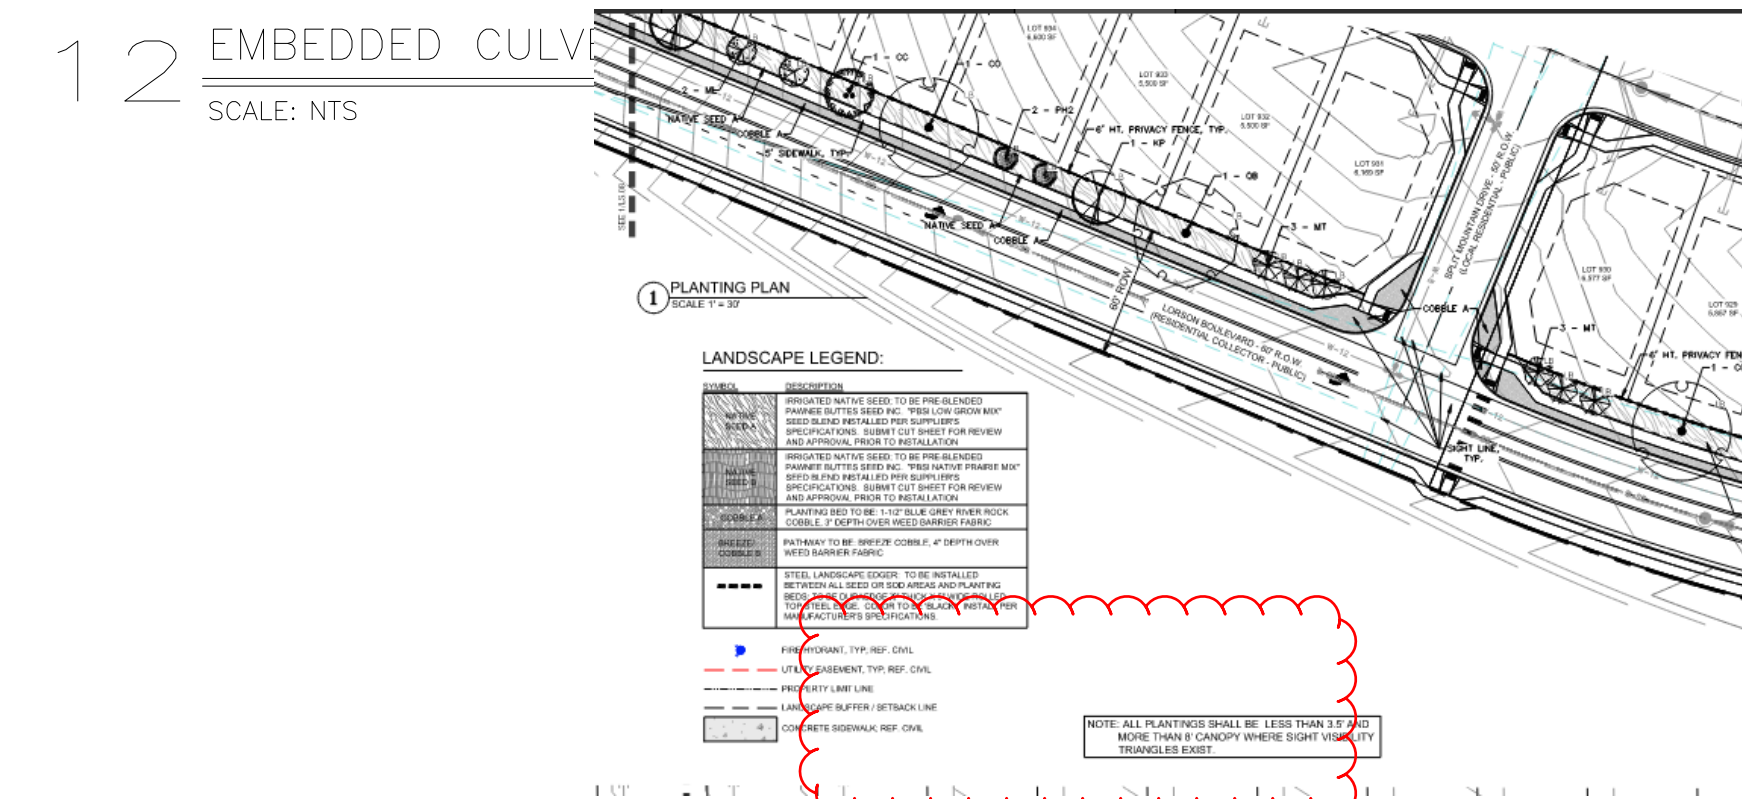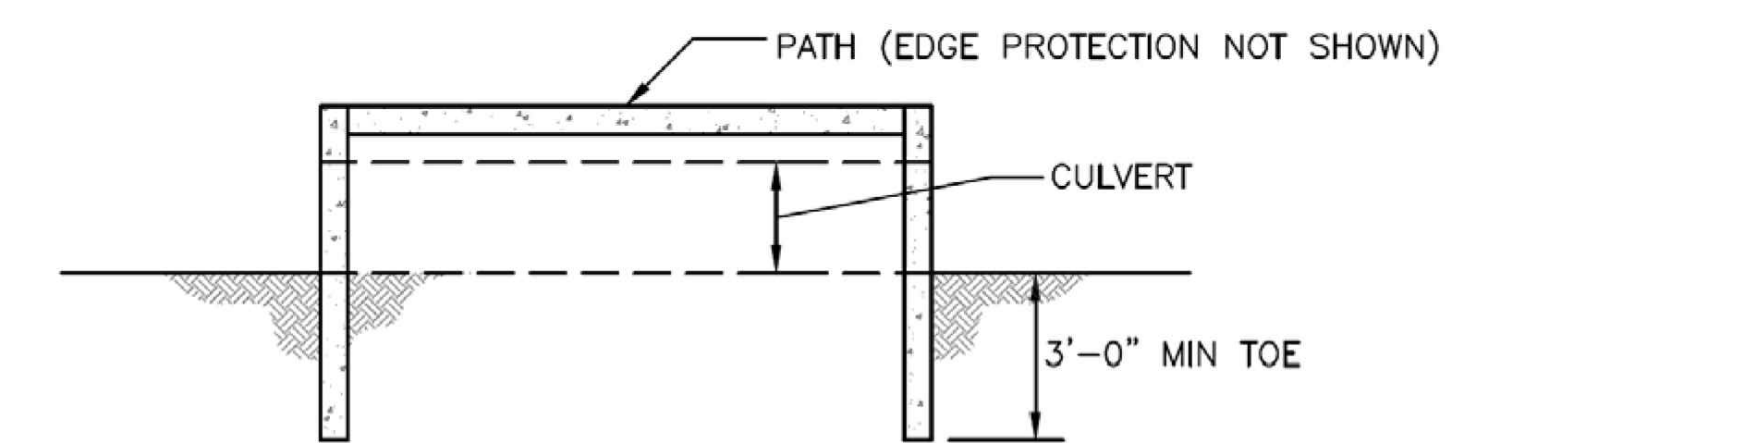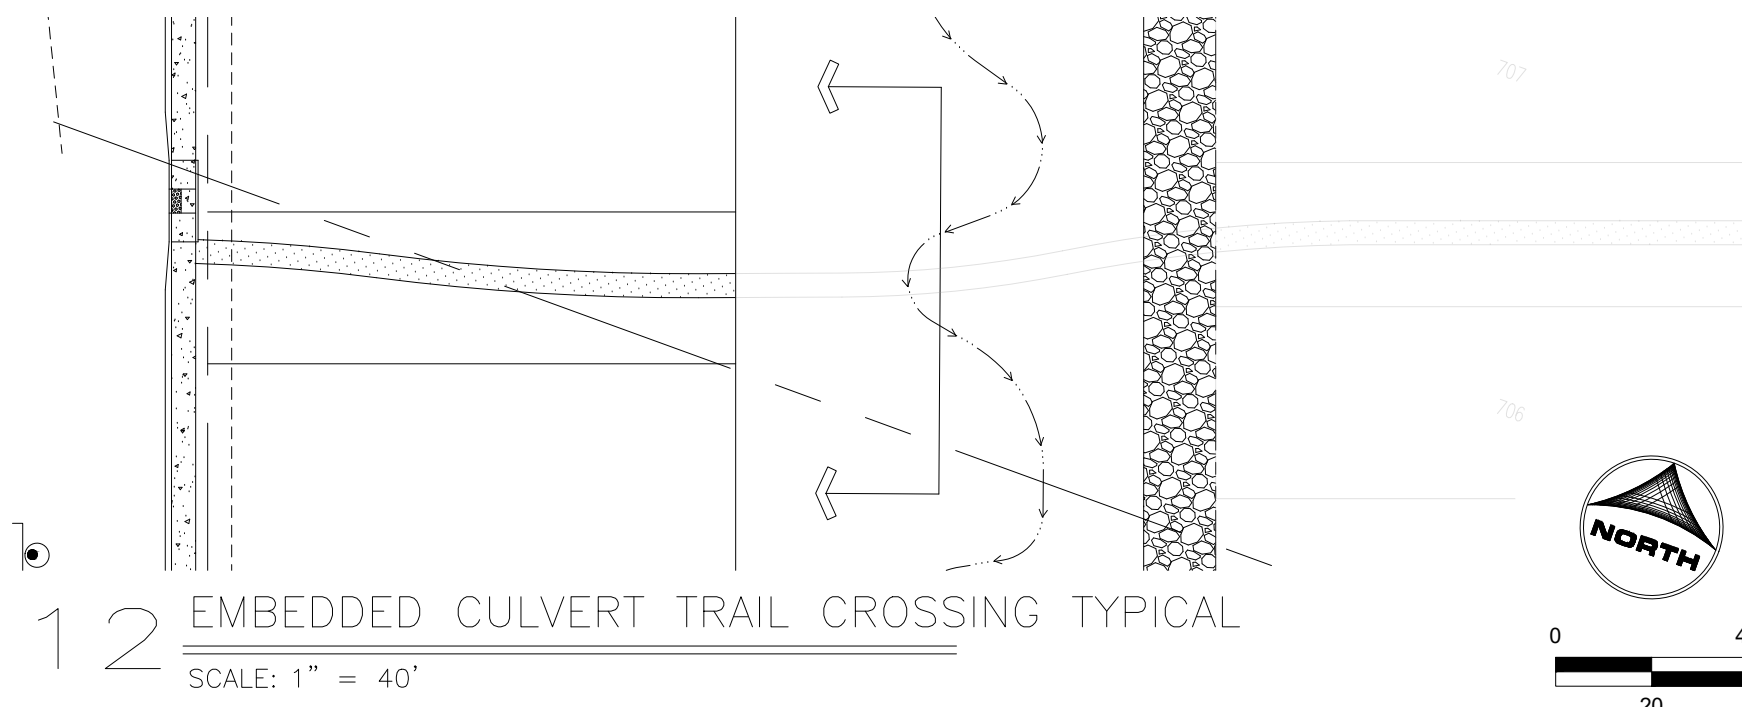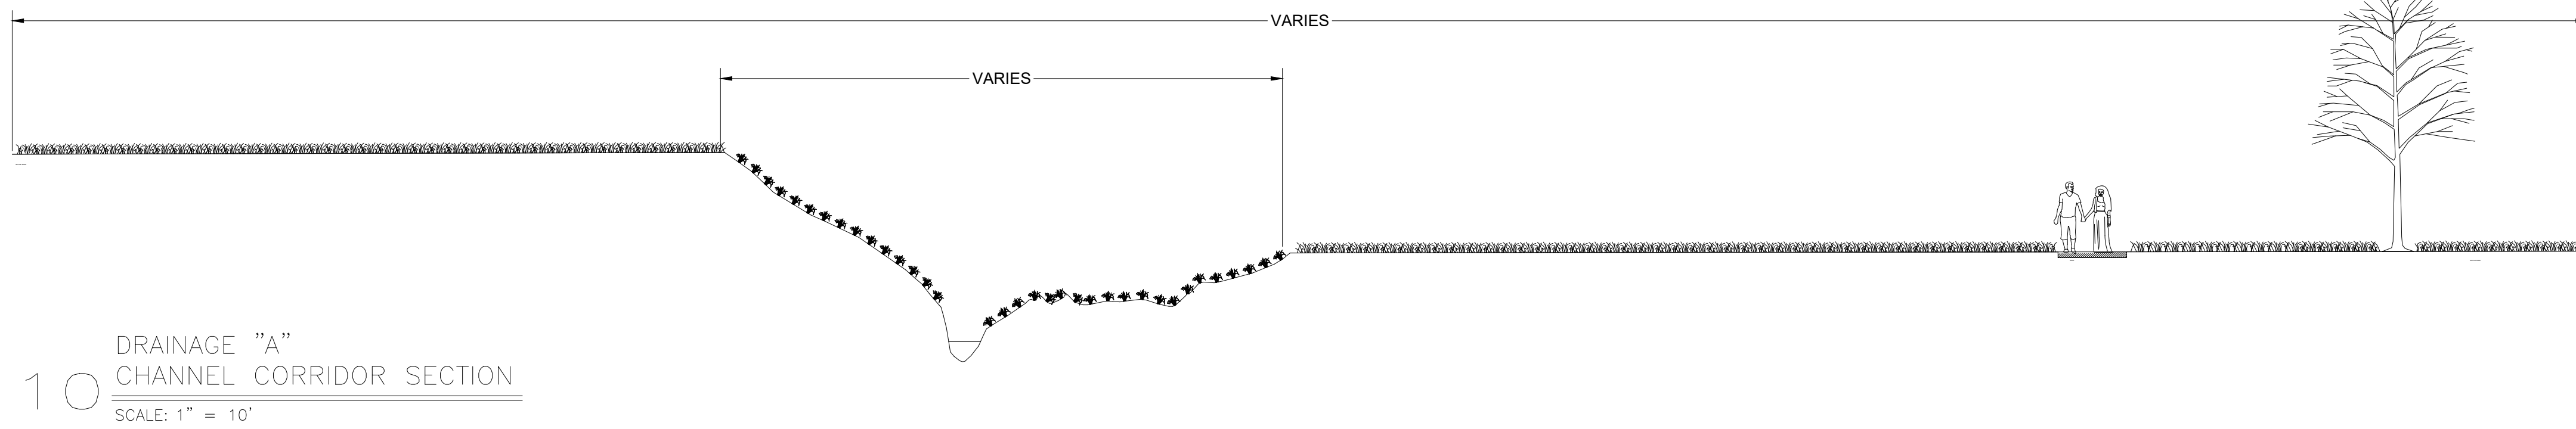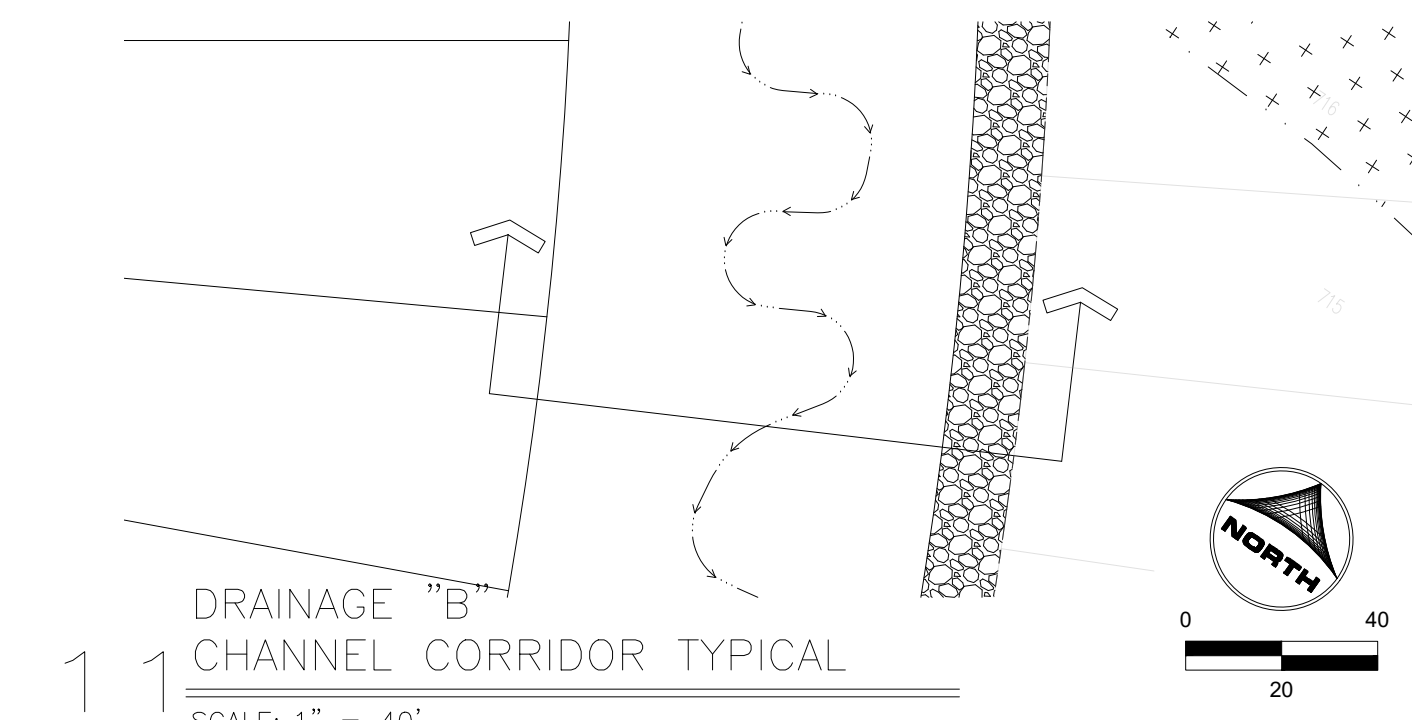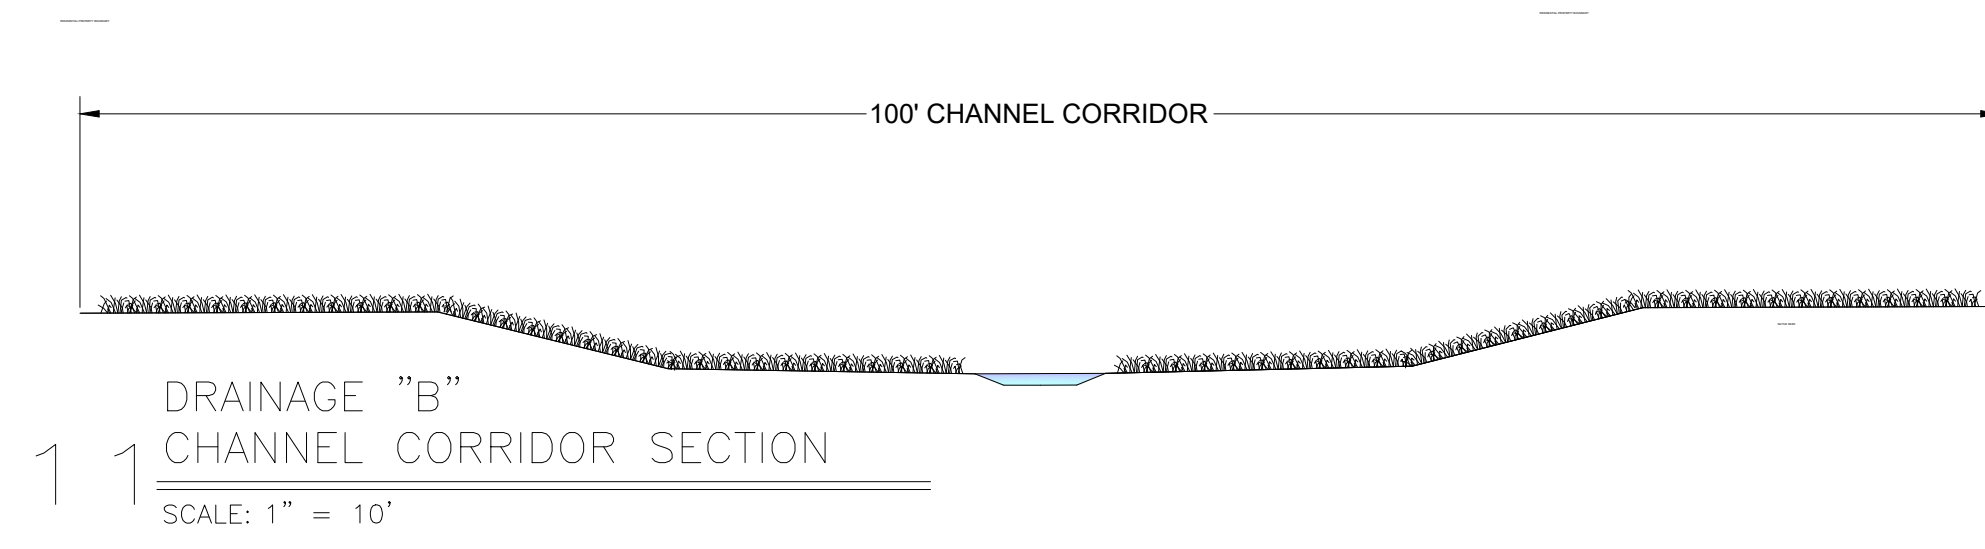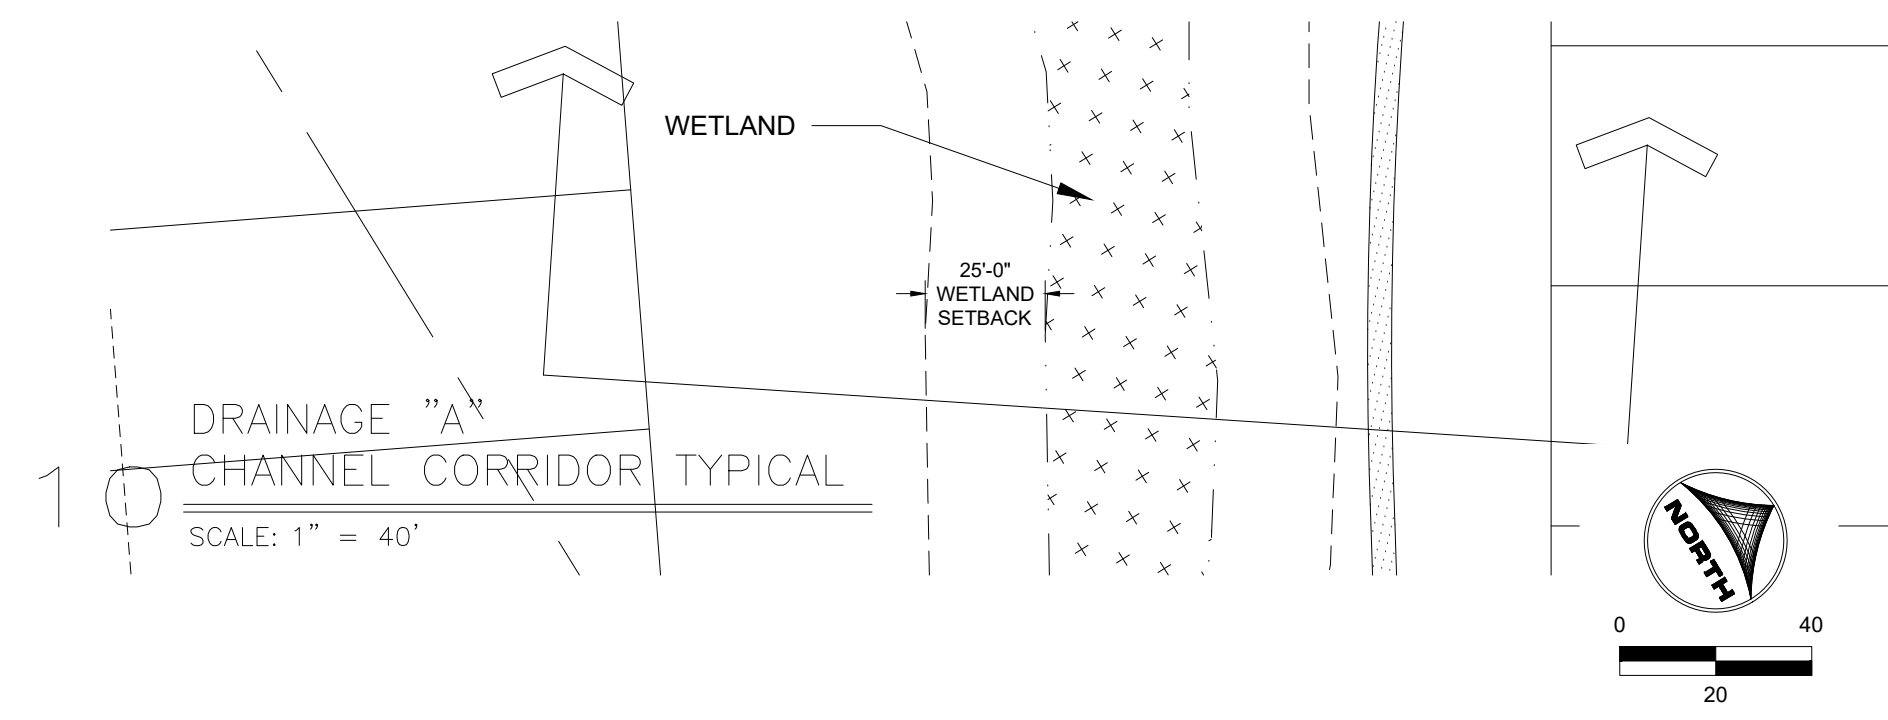

### PLANT LIST

KEY	HEIGHT	WIDTH	SIZE	COND
<b>DECIDUOUS TREES</b>				
AG	20'	15'	2"	B&B
CO	45'	45'	2.5"	B&B
TA	50'	40'	2.5"	B&B
UF	40'	30'	2"	B&B
<b>EVERGREEN TREES</b>				
JS	15'	8'	#7 GAL	CONT
PF	25'	15'	6"	B&B
PN	50'	25'	8"	B&B
PP	30'	12'	6"	B&B
<b>ORNAMENTAL TREES</b>				
MP	20'	20'	2"	B&B
PM	25'	20'	2"	B&B
RP	40'	30'	2.5"	B&B
<b>SHRUBS</b>				
BT	2'	3'	5 GAL	CONT
BG	4'	4'	5 GAL	CONT
CS	5'	6'	5 GAL	CONT
EA	5'	5'	5 GAL	CONT
EK	4'	4'	5 GAL	CONT
JH	1'	8'	5 GAL	CONT
MR	1.5'	3'	5 GAL	CONT
RS	4'	4'	5 GAL	CONT
PC	6'	6'	5 GAL	CONT
RA	4'	3'	5 GAL	CONT
SJ	4'	4'	5 GAL	CONT
SM	5'	5'	5 GAL	CONT
<b>GRASSES</b>				
CA	5'	2'	1 GAL	CONT
HS	2'	1.5'	1 GAL	CONT
PV	4'	1.5'	1 GAL	CONT
<b>PERENNIALS</b>				
AA	1'	1.5'	1 GAL	CONT
AC	2'	2'	1 GAL	CONT
HD	1'	1'	1 GAL	CONT
HB	1.5'	1.5'	1 GAL	CONT
HR	2'	3'	1 GAL	CONT
LS	2.5'	2'	1 GAL	CONT
LA	2'	2'	1 GAL	CONT
PB	3'	1.5'	1 GAL	CONT
SS	1.5'	1.5'	1 GAL	CONT
SA	2'	1.5'	1 GAL	CONT

provide the table depicting the road name and the required tree amount/amount provided (any shrub substitutes); zone boundary, (if you show the interior landscaping on the interior commercial lots, those lots will be set.). Perhaps just show exterior lot boundary for the non-residential lots, and add note each nonresidential lot shall meet chapter 6 of Code for landscape, parking, screening, fencing and lighting purposes.

### SEEDING SPECIFICATIONS

PAWNEE BUTTES SEED INC.

#### NATIVE SEEDING

##### PBSI LOW GROW NATIVE SEED MIX

25%	ARIZONA FESCUE
25%	SANDBERG BLUEGRASS
25%	ROCKY MOUNTAIN FESCUE
25%	BIG BLUEGRASS (SHERMAN)

SEEDING RATE: 5LBS/1,000 SQ. FT.

#### DETENTION SEEDING

##### PBSI DETENTION/WETLAND SEED MIX

45%	REED CANARY GRASS
25%	IMPROVED MEADOW BROME
25%	GARRISON CREEPING FOXTAIL (COATED)
5%	CLIMAX, TIMOTHY

SEEDING RATE: 10LBS/ACRE

## CONCEPTUAL DESIGN NOTE

- LANDSCAPING AS SHOWN IS CONCEPTUAL ONLY AND SUBJECT TO CHANGE.
- DETAILED DESIGN WILL BE REVIEWED THROUGH THE PRELIMINARY/FINAL PLAT PROCESS.
- NO OBJECTS MORE THAN 30 INCHES ABOVE THE FLOWLINE ELEVATION OF THE ADJACENT ROADWAY ARE ALLOWED WITHIN THE SIGHT DISTANCE EASEMENTS.

## LEGEND

- CANOPY TREE
- ORNAMENTAL TREE
- EVERGREEN TREE

#### DEVELOPMENT PLAN DATA:

LANDSCAPE SETBACKS:	WEST	EAST	NORTH	SOUTH		
STREET NAME OR ZONE BOUNDARY:	GRAYLING DR.	WALLEYE DR.	WALLEYE DR.	LORSON BLVD.	FONTAINE BLVD.	FONTAINE BLVD.
ZONE/DISTRICT BOUNDARY:	NO	NO	NO	NO	NO	NO
STREET CLASSIFICATION:	COLLECTOR	COLLECTOR	COLLECTOR	COLLECTOR	ARTERIAL	ARTERIAL
SETBACK DEPTH REQUIRED/PROVIDED:	10' / 10'	10' / 10'	10' / 10'	25' / 25'	25' / 25'	25' / 25'
LINEAR FOOTAGE:	536'	493'	3,139'	2,040'	1,493'	1,493'
TREE FEET REQUIRED:	1 / 30	1 / 30	1 / 30	1 / 30	1 / 20	1 / 20
NUMBER OF TREES REQUIRED/PROVIDED:	18 / 18	17 / 20	105 / 105	68 / 69	75 / 75	75 / 75
SHRUB SUBSTITUTES REQUIRED/PROVIDED:	0 / 0	0 / 0	0 / 0	0 / 0	0 / 0	0 / 0
ORNAMENTAL GRASS SUBSTITUTES REQ./PROV.	0 / 0	0 / 0	0 / 0	0 / 0	0 / 0	0 / 0
PLANT ABBREVIATION DENOTED ON PLAN:	GD	WW	WD	LB	NF	SF
% GROUND PLANE VEG. REQUIRED/PROVIDED:	75% / 75%	75% / 75%	75% / 75%	75% / 75%	75% / 75%	75% / 75%

\* TREES FOR POCKET PARKS LABELED: PP

please see landscape plan checklist and the missing items...