



Existing Coverage VS DO Upgrade

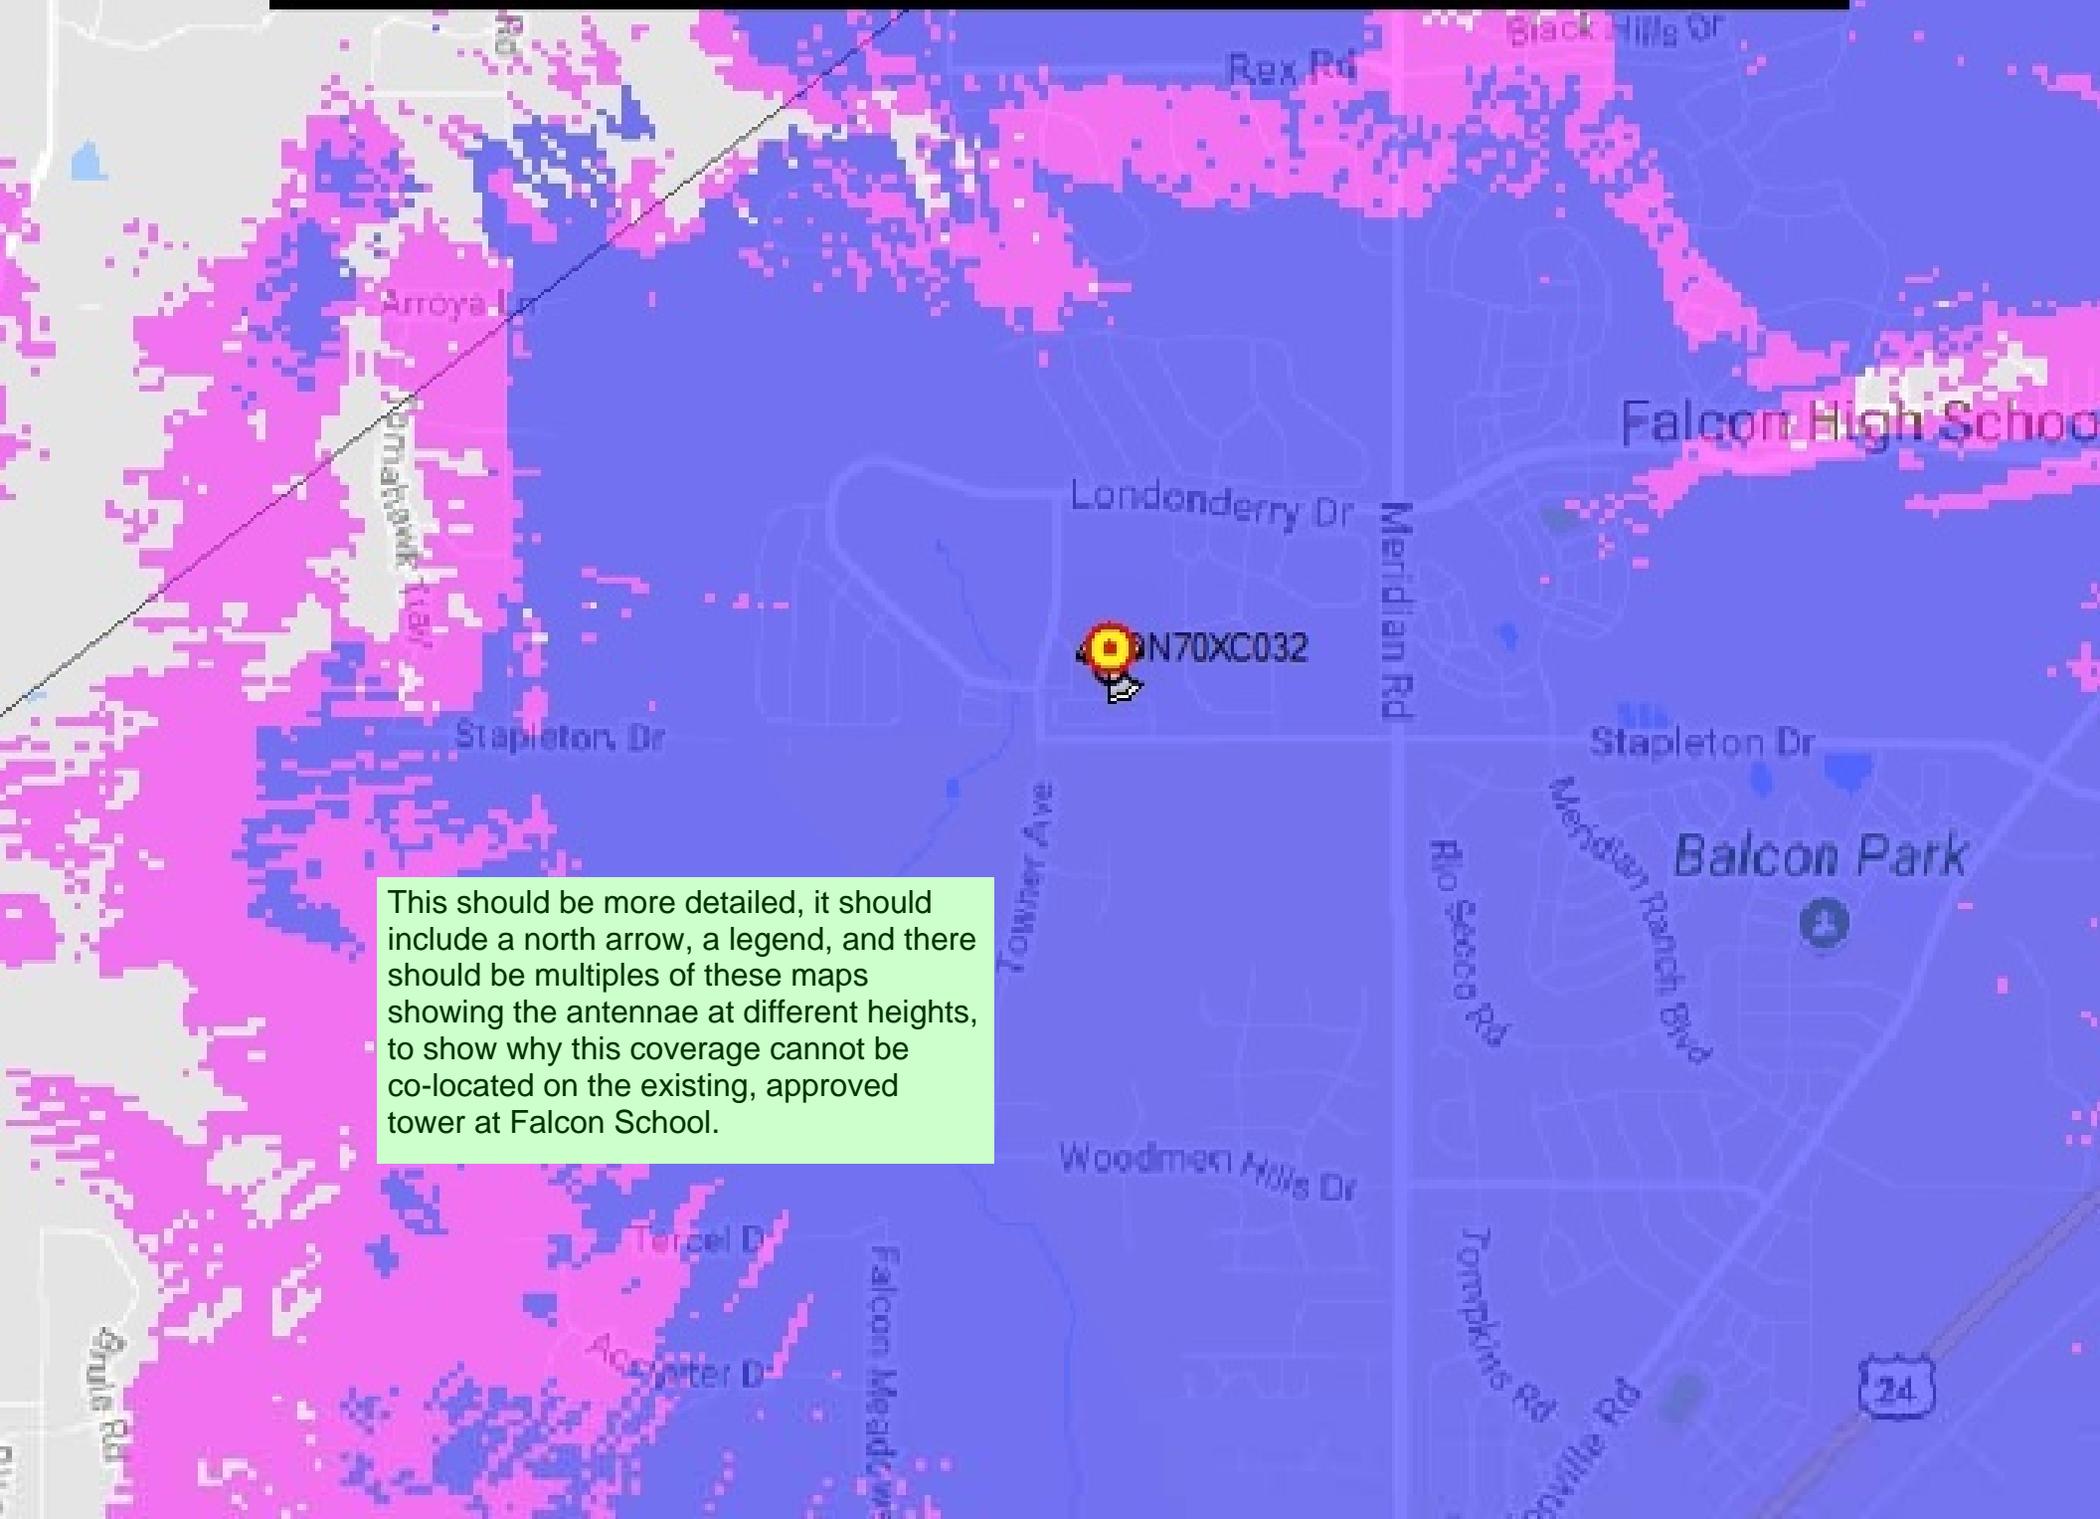

This should be more detailed, it should include a north arrow, a legend, and there should be multiples of these maps showing the antennae at different heights, to show why this coverage cannot be co-located on the existing, approved tower at Falcon School.

Markup Summary

dskendall (1)

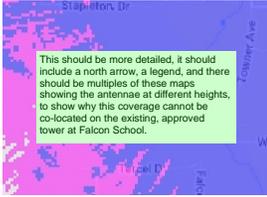

Subject: Text Box
Page Label: 1
Author: dskendall
Date: 7/30/2018 3:11:21 PM
Color: ■

This should be more detailed, it should include a north arrow, a legend, and there should be multiples of these maps showing the antennae at different heights, to show why this coverage cannot be co-located on the existing, approved tower at Falcon School.