






1 FRONT ELEVATION SCALE: 1/8" = 1'-0"

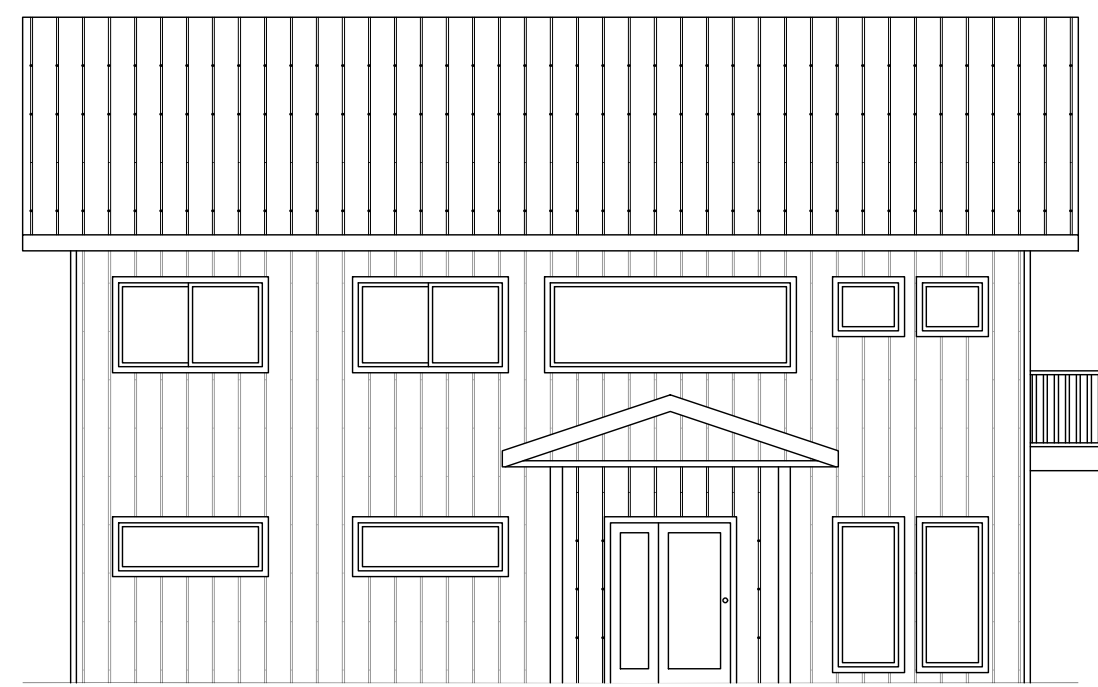


2 RIGHT ELEVATION SCALE: 1/8" = 1'-0"

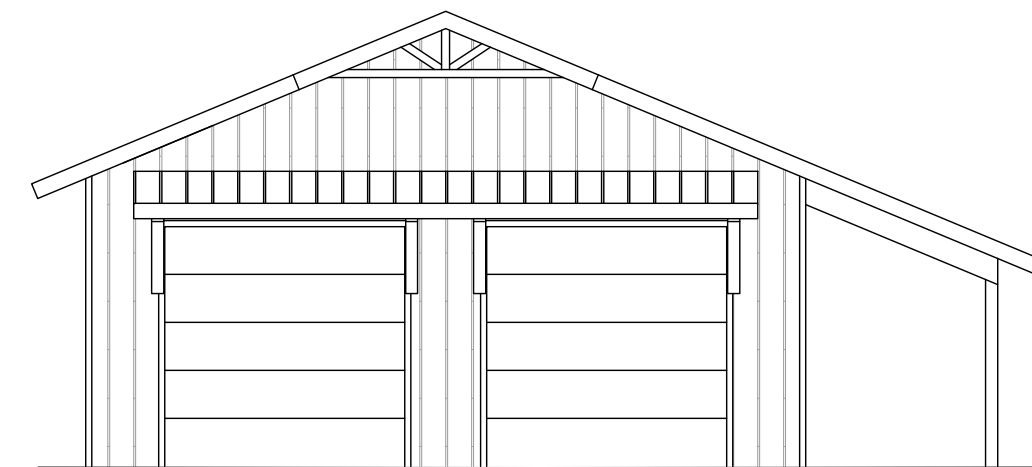


1 FRONT ELEVATION SCALE: 1/8" = 1'-0"

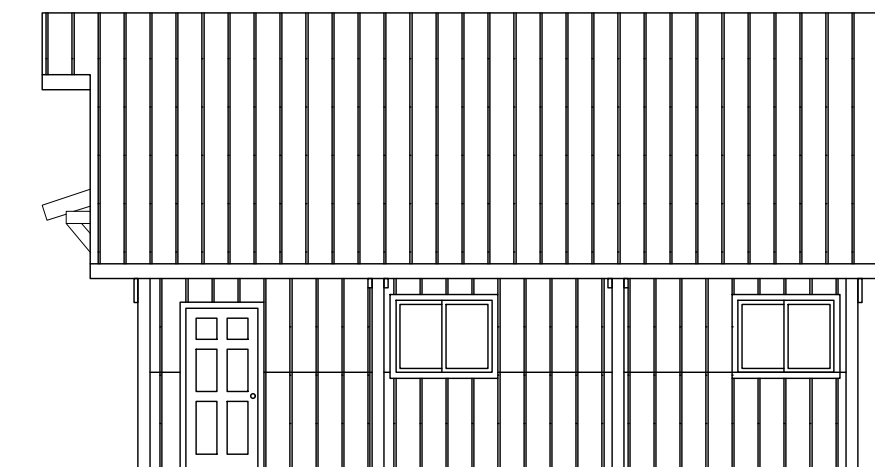


2 RIGHT ELEVATION SCALE: 1/8" = 1'-0"

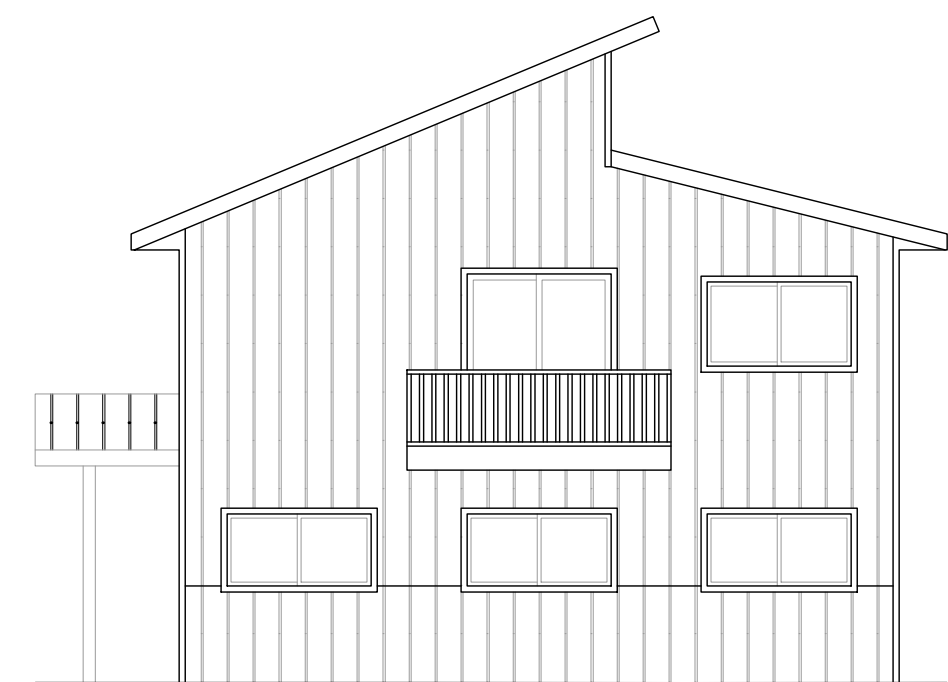


3 BACK ELEVATION SCALE: 1/8" = 1'-0"

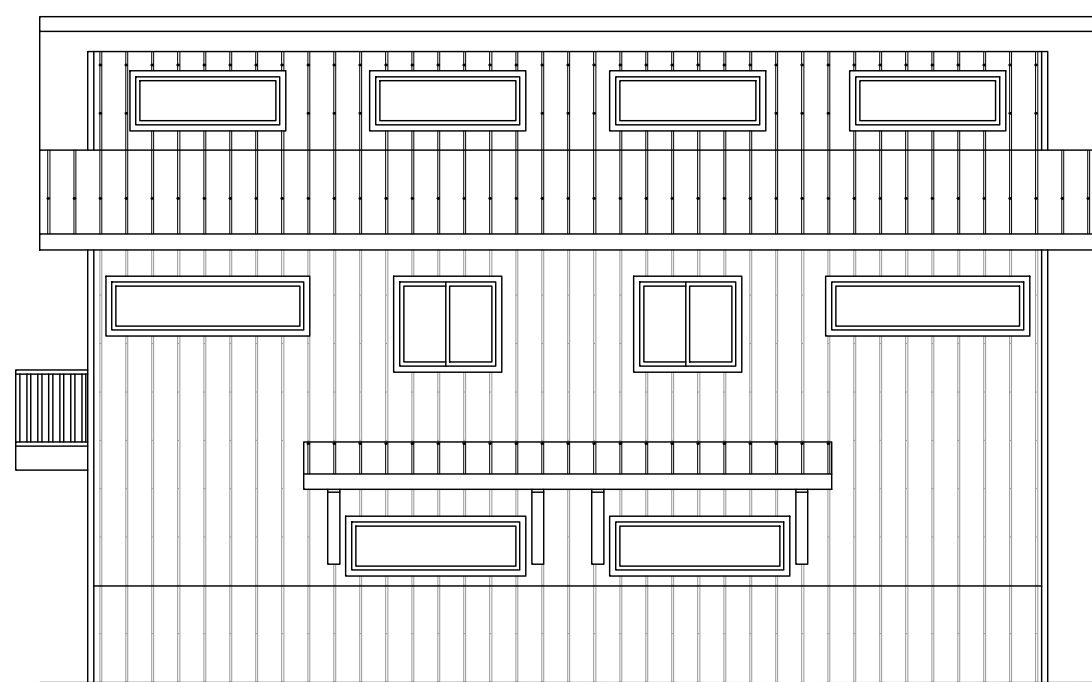

4 LEFT ELEVATION SCALE: 1/8" = 1'-0"

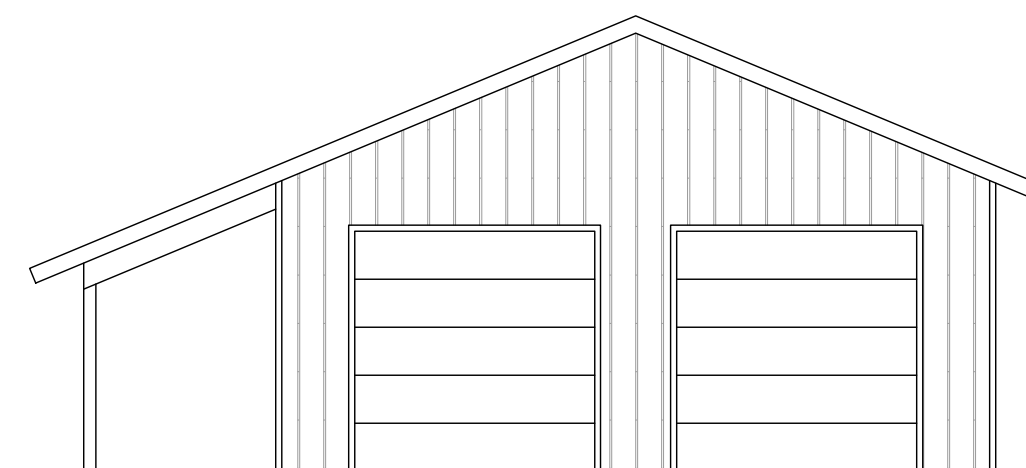

3 BACK ELEVATION SCALE: 1/8" = 1'-0"

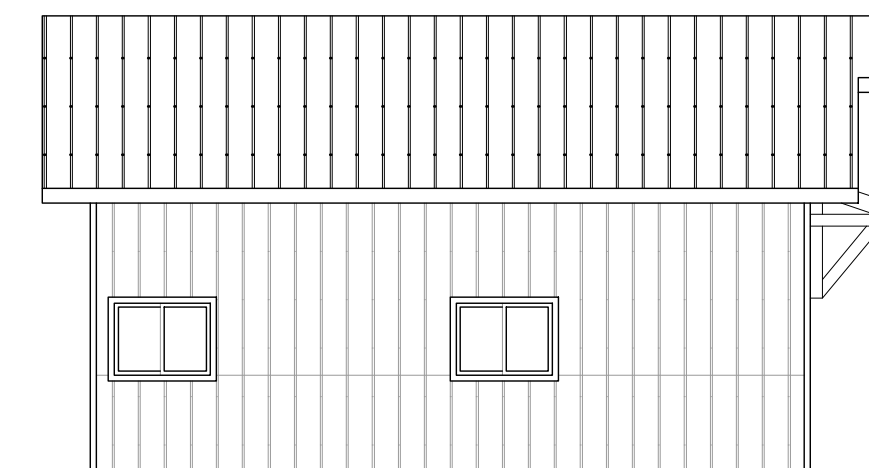


4 LEFT ELEVATION SCALE: 1/8" = 1'-0"


MONUMENT MINI STORAGE OFFICE

DISPLAY ZILLAH OFFICE #1


Floor plans not shown. Include dimensions

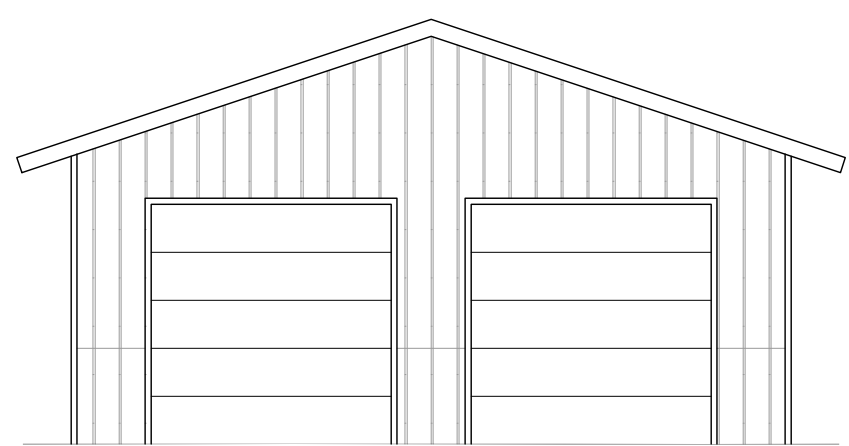


1 FRONT ELEVATION SCALE: 1/8" = 1'-0"

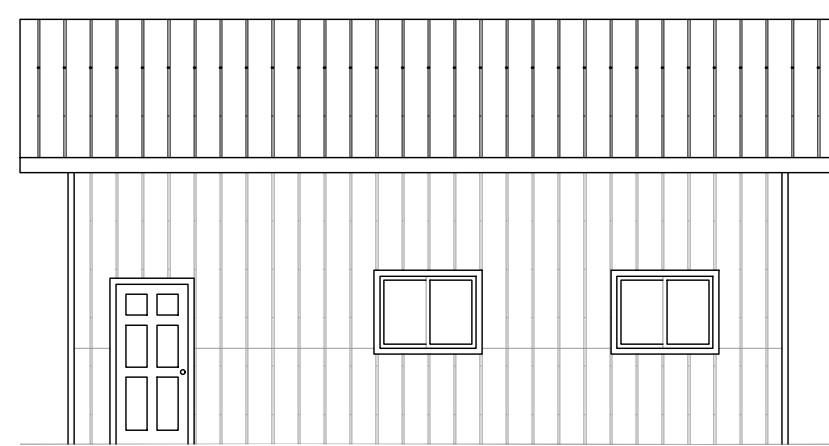

2 RIGHT ELEVATION SCALE: 1/8" = 1'-0"

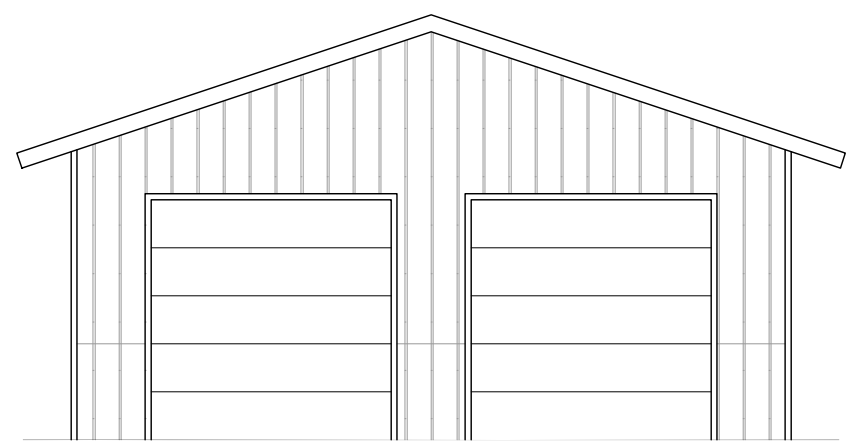

3 BACK ELEVATION SCALE: 1/8" = 1'-0"

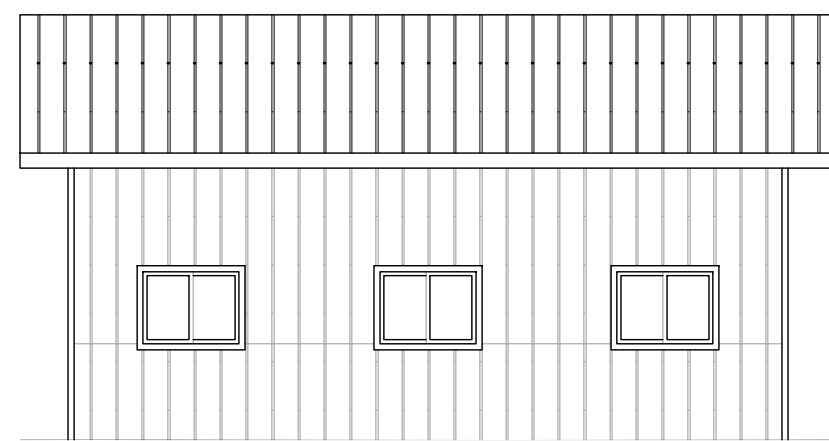

4 LEFT ELEVATION SCALE: 1/8" = 1'-0"

DISPLAY ZILLAH OFFICE #2

REV. NO.	DESCRIPTION	DATE
<<<<<<<<<<		

SITE DEVELOPMENT PLAN
MONUMENT STEEL STRUCTURES
 BUILDING ELEVATIONS AND FLOOR PLANS
 18910 BASE CAMP ROAD
 MONUMENT, COLORADO

PROJ NO. SSA
ENG :
CHKD:
DATE 04/15/2019


SHEET NUMBER
BD 1

6 OF 8




P:\Steel Structures - Monument, CO\B3 - Design\Revise\11-24a-Development Plans (SSP)\Arch DWG\Elevs_41102019_3-26-19_RK.aprison.11


BUILDING 1

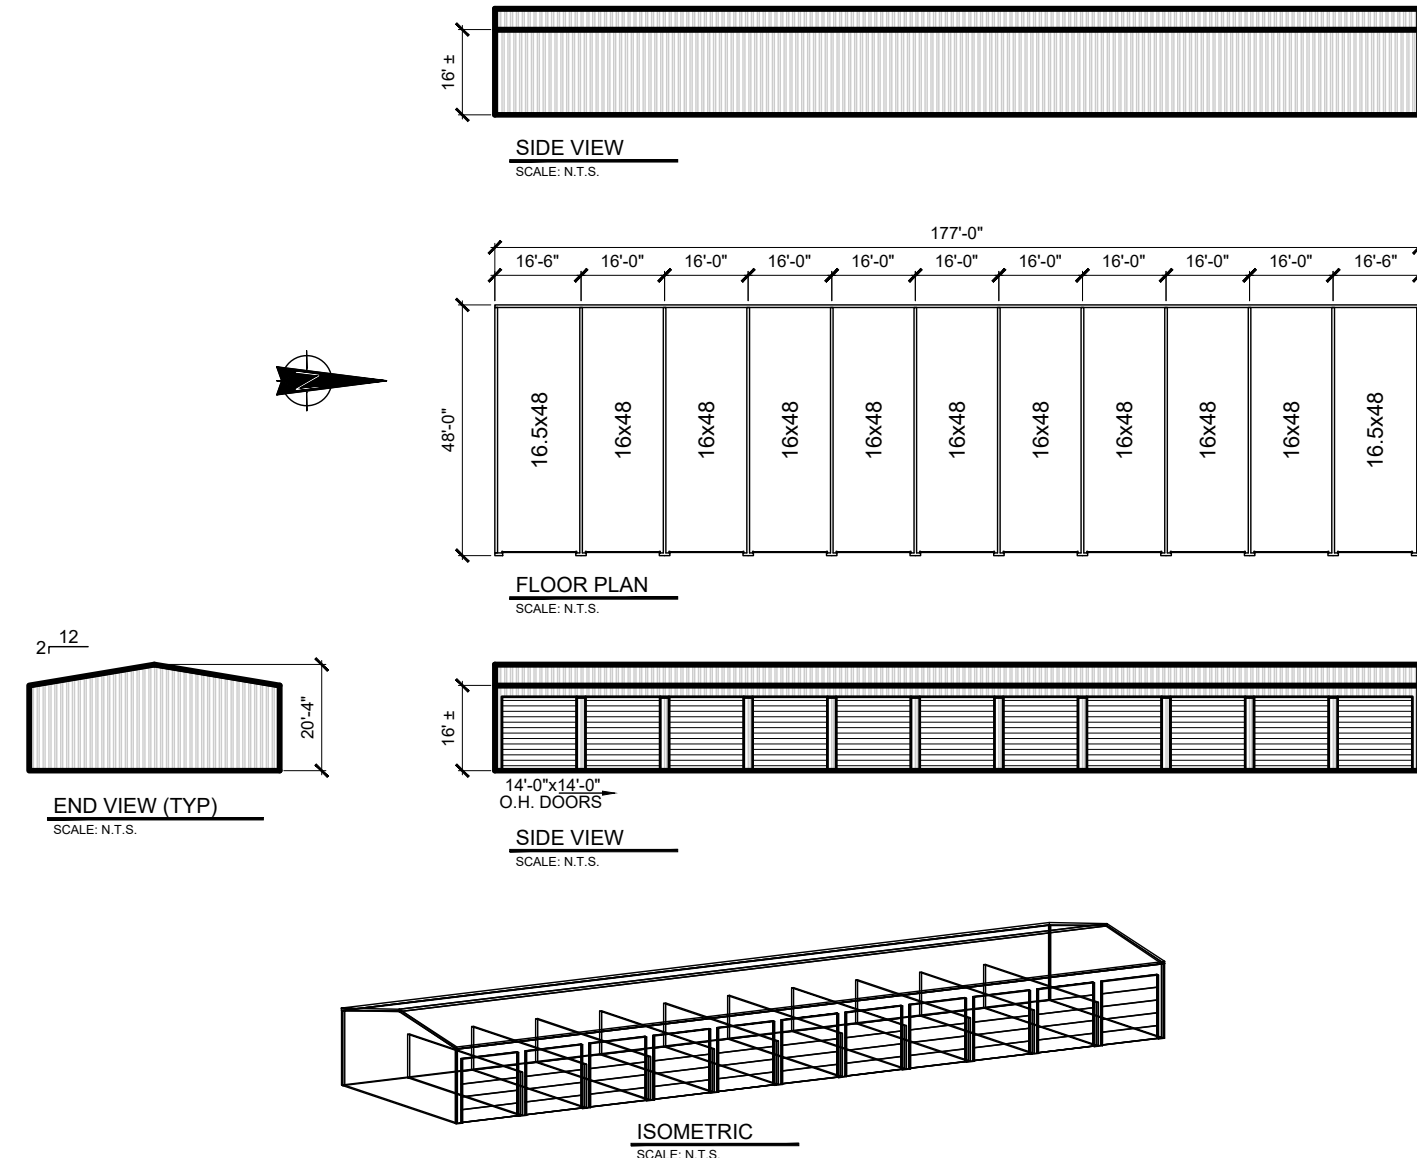


BUILDING 3

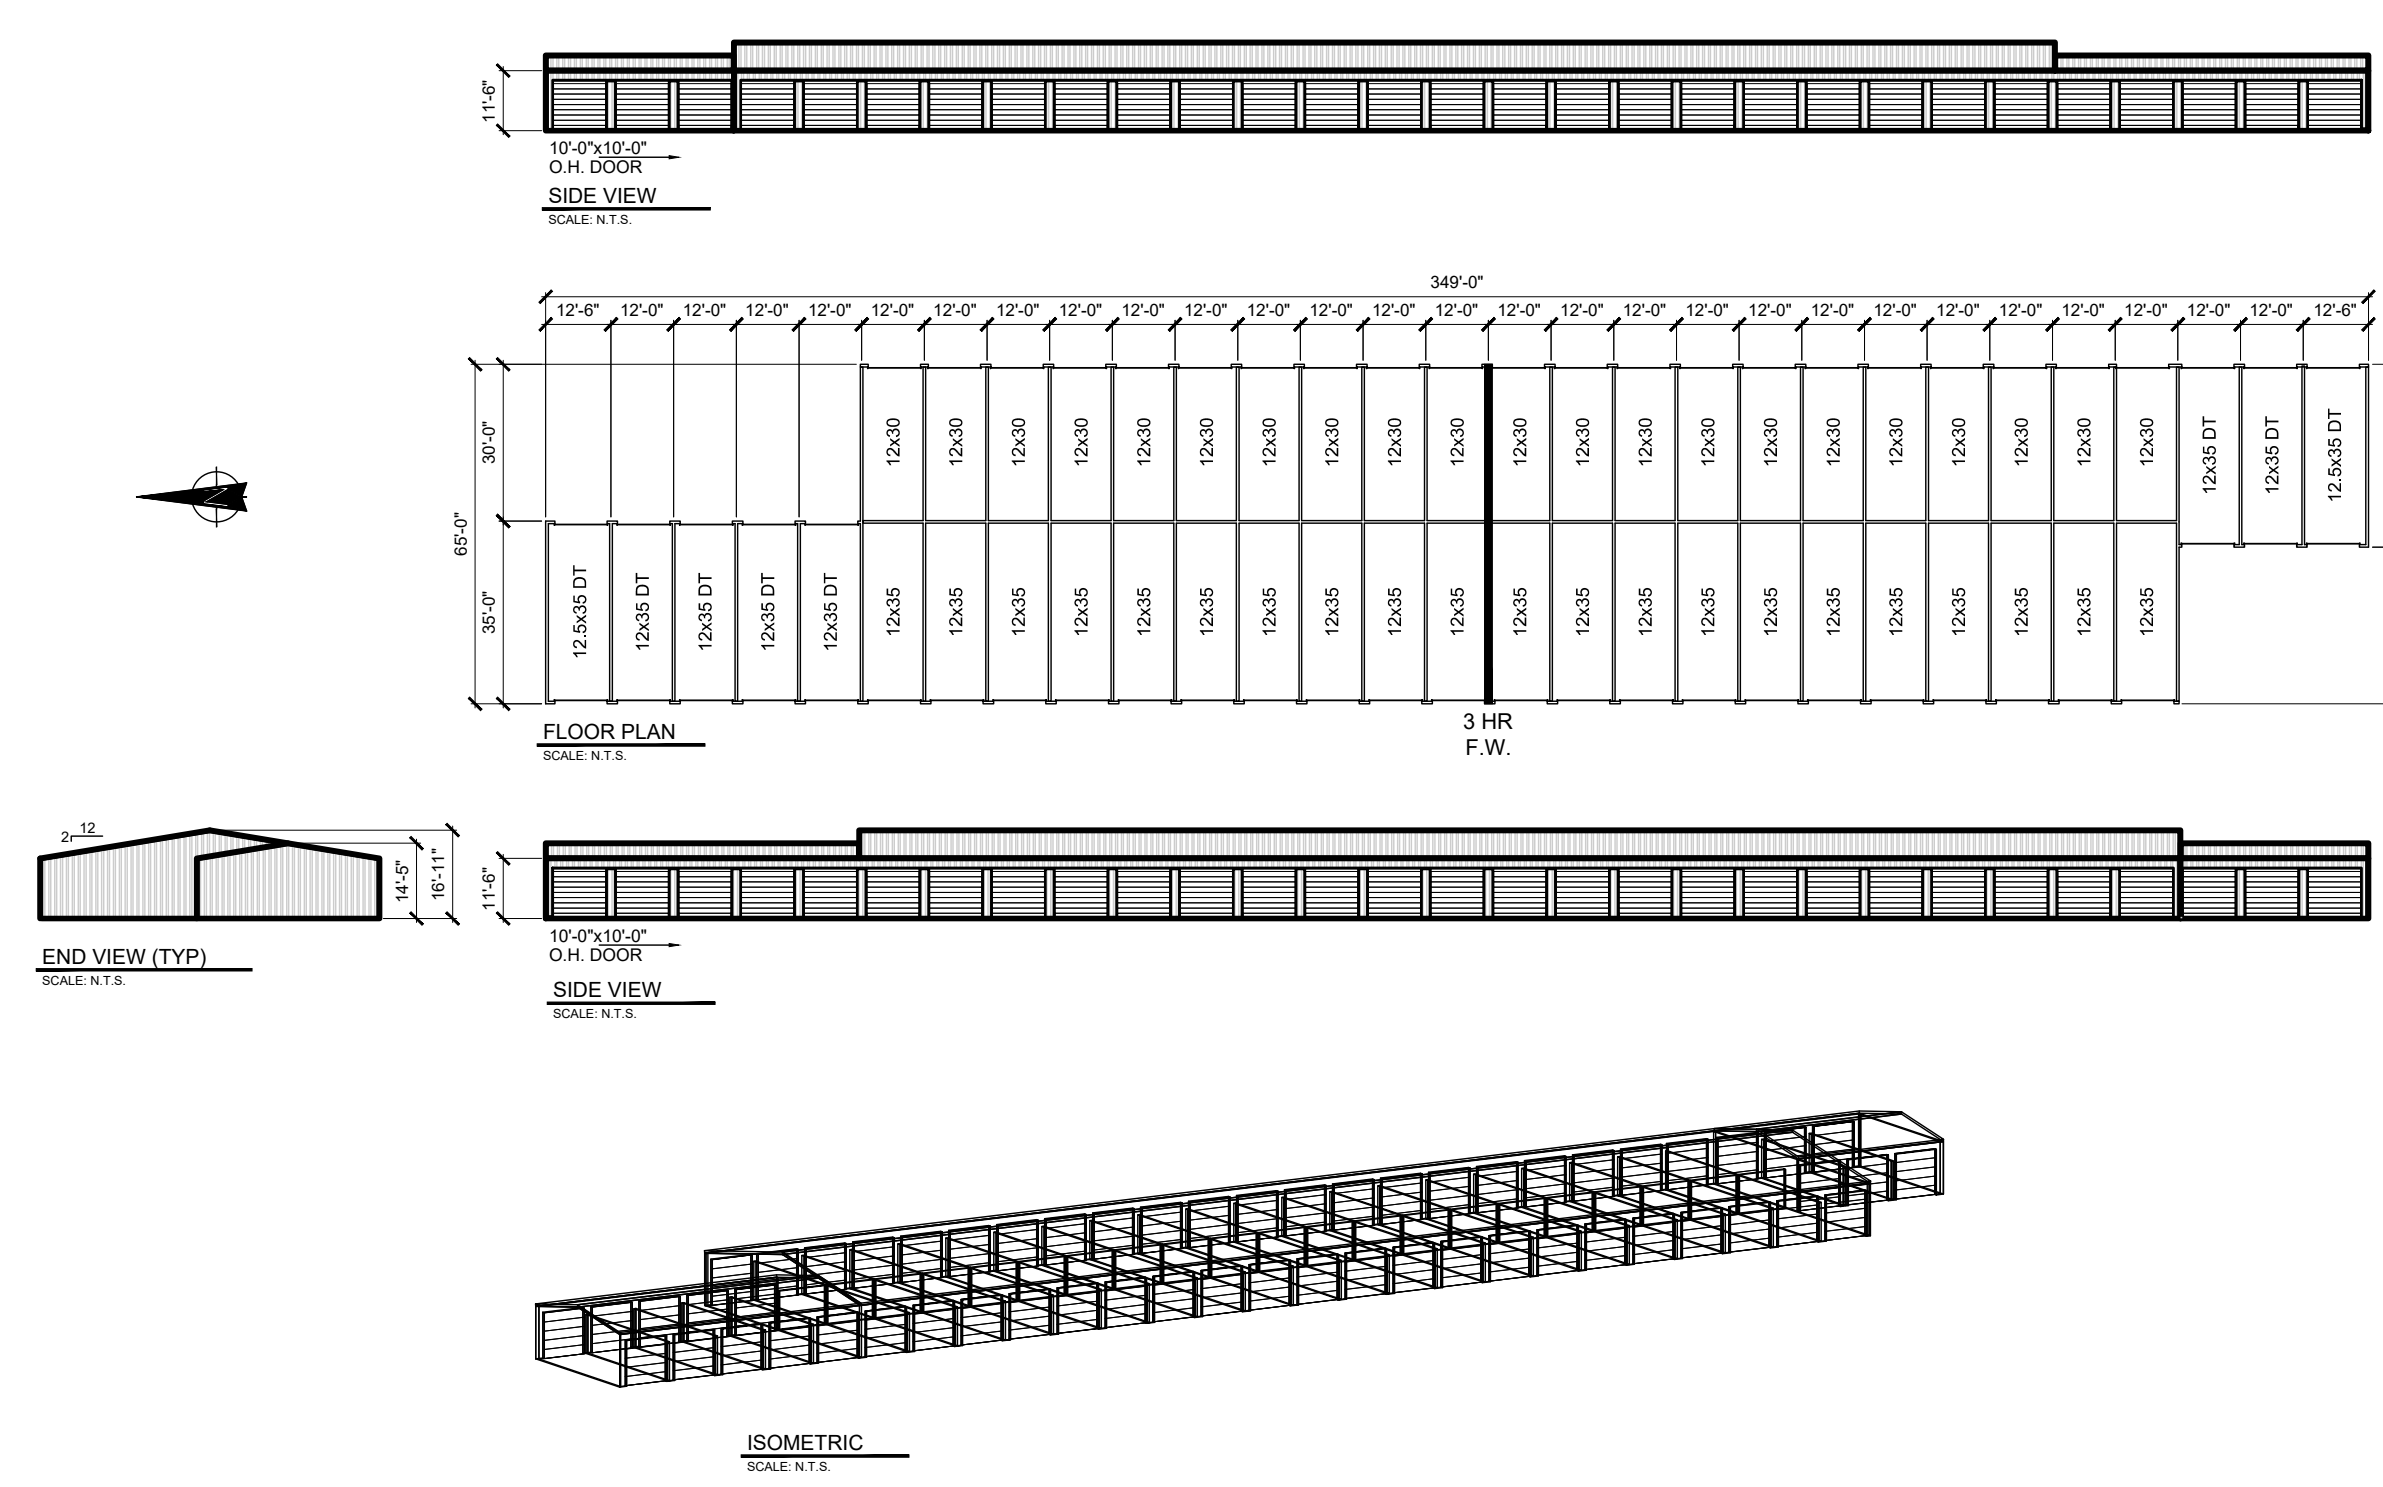

BUILDING 2

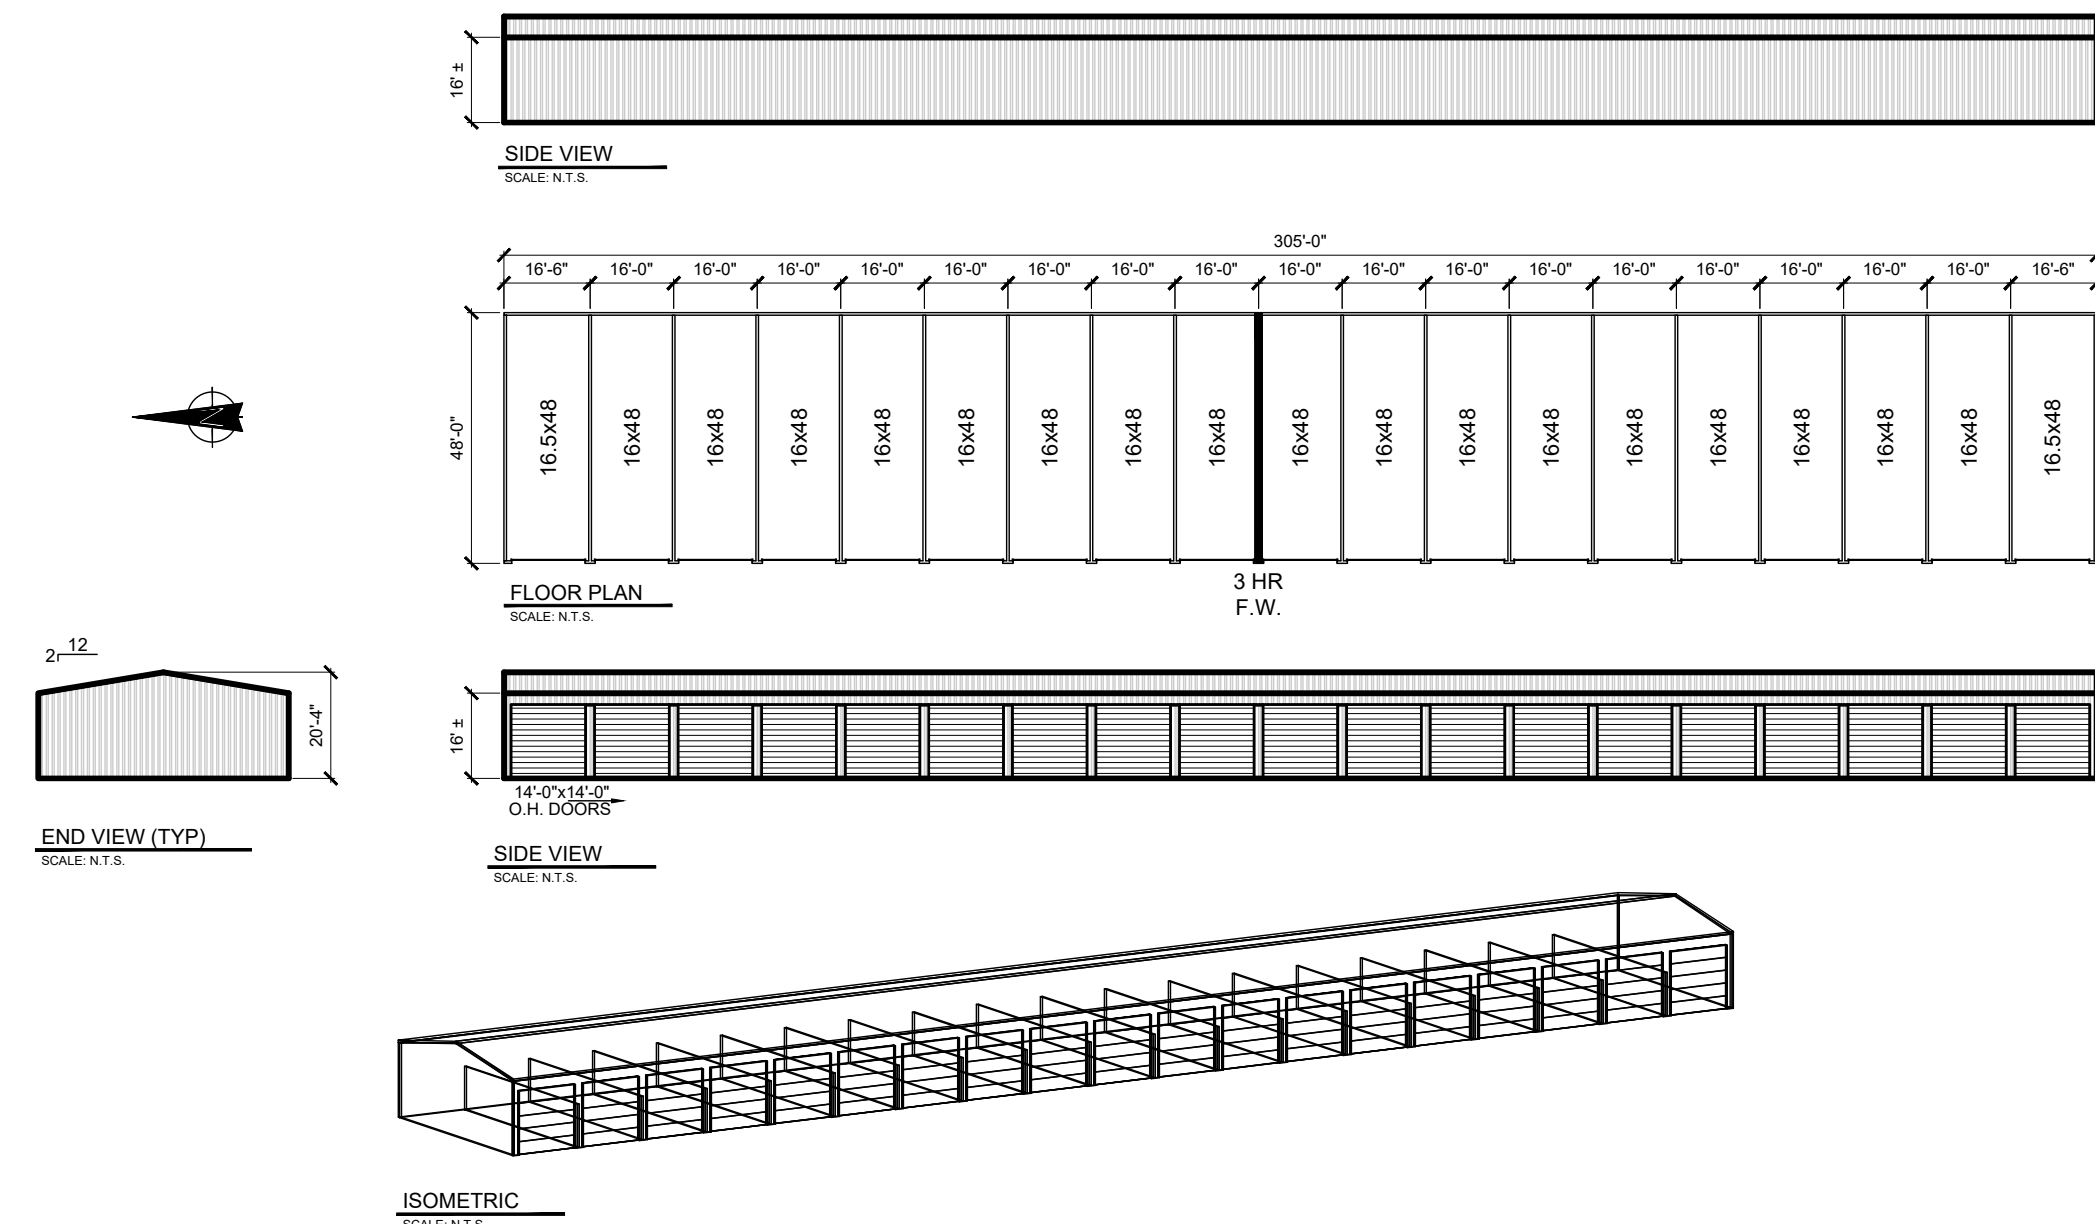

BUILDING 4

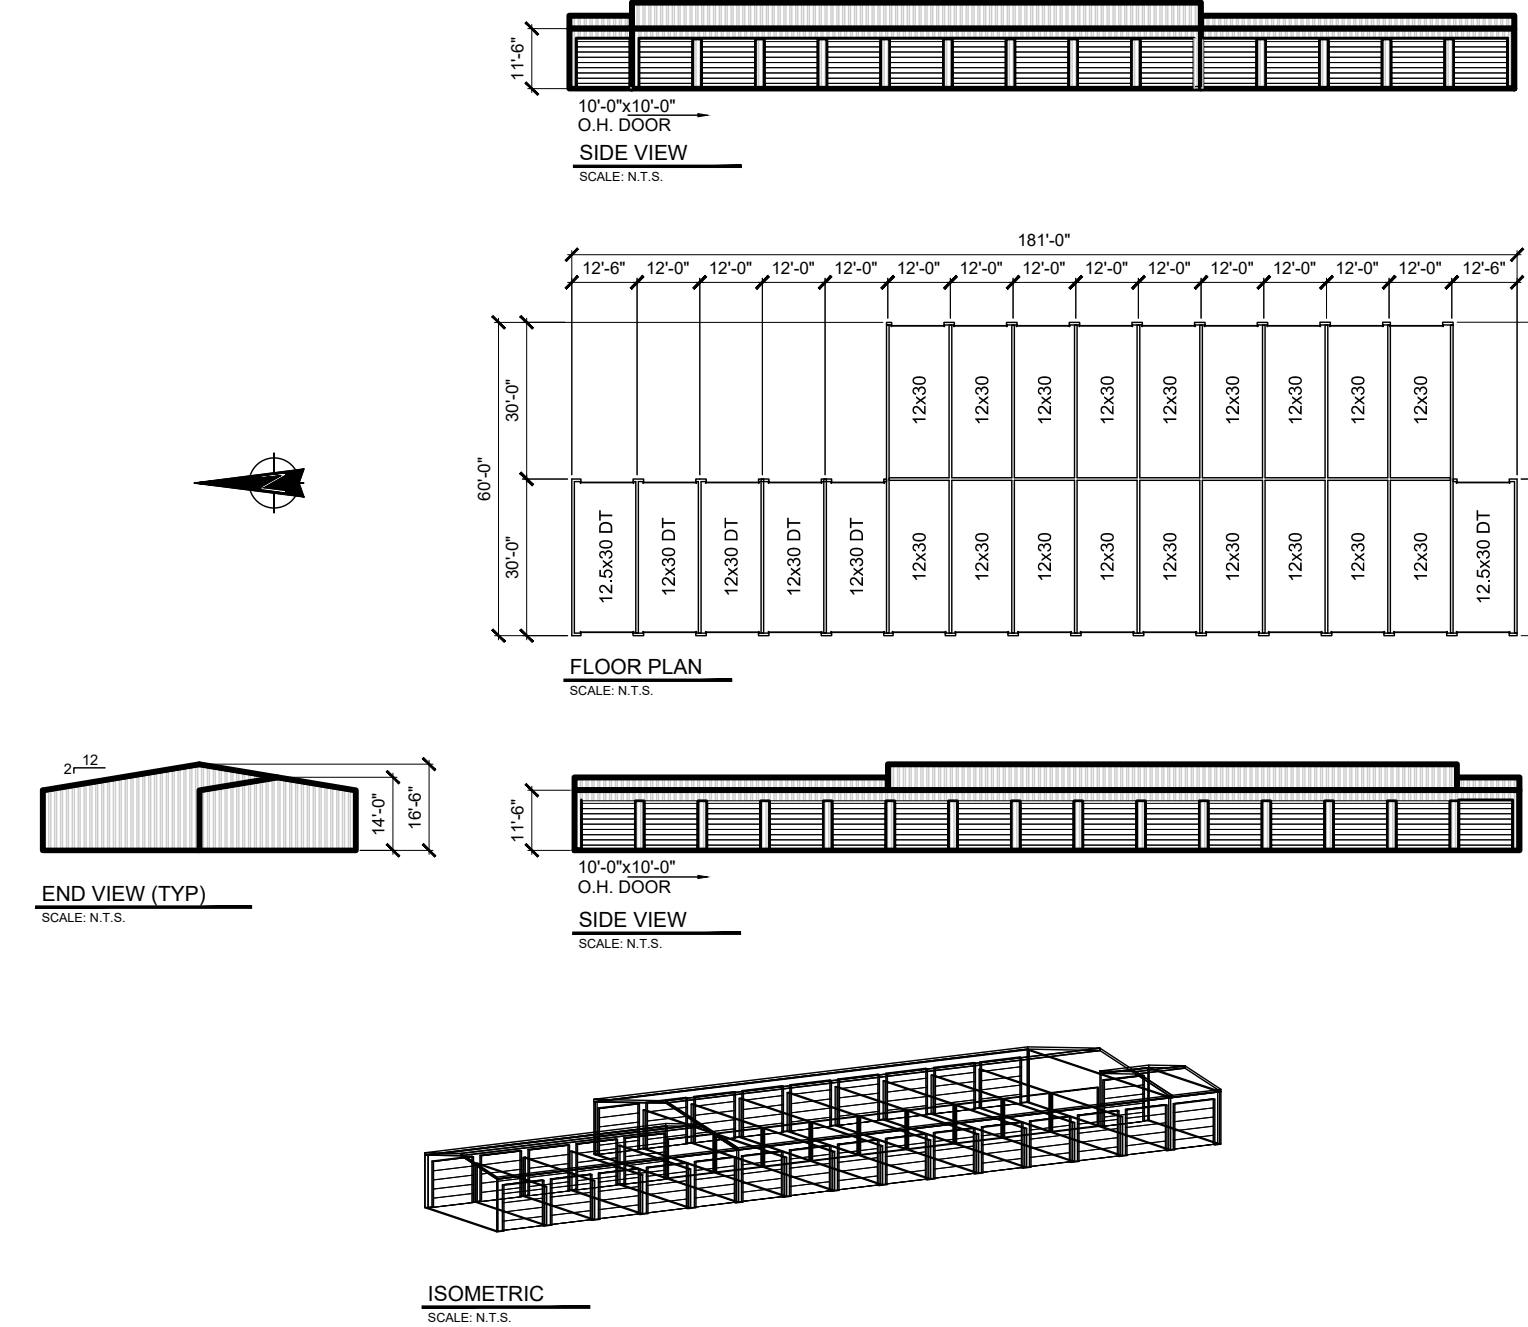

REV. NO.	DESCRIPTION	DATE

SITE DEVELOPMENT PLAN
MONUMENT STEEL STRUCTURES
 BUILDING ELEVATIONS AND FLOOR PLANS
 18910 BASE CAMP ROAD
 MONUMENT, COLORADO

PROJ. NO. SSA
 ENG. :
 CHKD. :
 DATE: 04/15/2019

SHEET NUMBER
BD 2

STRUCTURAL SYSTEMS
 PHONE: (509) 535-0917 FAX: (509) 535-2481
 or (888) 611-4057 or (877) 277-8871



P:\Steel Structures - Monument, CO\03 - Develop\03\03-01-2019 3:28:25 PM - eplan.dwg, 1:1

Floor Plans_v1-redline.pdf Markup Summary

Floor plans not shown. Include dimensions (1)

Floor plans not shown. Include dimensions

Subject: Text Box
Page Label: 1
Lock: Unlocked
Author: dsdkendall
Date: 5/24/2019 2:08:34 PM
Status:
Color: ■
Layer:
Space:

Floor plans not shown. Include dimensions