

SITE S-145 (AR)

SITE ADDITION TO CRYSTAL PARK SUBDIVISION NO. 2, A PORTION OF THE NORTHWEST ONE-QUARTER OF THE SOUTHWEST ONE-QUARTER (NW1/4, SW1/4) OF SECTION 18, TOWNSHIP 14 SOUTH, RANGE 67 WEST OF THE SIXTH PRINCIPAL MERIDIAN, COUNTY OF EL PASO, STATE OF COLORADO

KNOW ALL MEN BY THESE PRESENTS

THAT CRYSTAL PARK HOMEOWNERS ASSOCIATION, A COLORADO NON-PROFIT CORPORATION, BEING THE OWNERS OF THE FOLLOWING DESCRIBED TRACT OF LAND:

TO WIT

SITE S-145(AR), SITE ADDITION TO CRYSTAL PARK SUBDIVISION NO. 2, AS RECORDED IN PLAT BOOK F-5 AT PAGE 37 UNDER RECEPTION NO. 2393361 OF THE RECORDS OF THE EL PASO COUNTY CLERK AND RECORDER, LOCATED IN THE NORTHWEST QUARTER OF THE SOUTHWEST QUARTER (NW1/4, SW1/4) OF SECTION 18, TOWNSHIP 14 SOUTH, RANGE 67 WEST OF THE 6TH P.M., EL PASO COUNTY, COLORADO, AND BEING MORE PARTICULARLY DESCRIBED AS FOLLOWS:

COMMENCING (P.O.C) AT THE NORTHWEST CORNER OF SAID SECTION 18, AS MONUMENTED BY A 3" BRASS CAP STAMPED "U.S. DEPARTMENT OF THE INTERIOR BUR. OF LAND MANAGEMENT 1975", FROM WHICH THE SOUTHWEST CORNER OF SAID SECTION 18, AS MONUMENTED BY A 3" BRASS CAP STAMPED "U.S. DEPARTMENT OF THE INTERIOR BUR. OF LAND MANAGEMENT 1975" BEARS S 00° 15' 24" W, A DISTANCE OF 5,172.08 FEET AND IS THE BASIS OF BEARINGS USED HEREIN:

THENCE S 09°40' 58" E, A DISTANCE OF 3254.03 FEET TO THE POINT OF BEGINNING (P.O.B) OF THE SITE HEREIN DESCRIBED;

THENCE N 89° 42' 57" E, A DISTANCE OF 195.79 FEET;

THENCE S 17° 27' 16" W, A DISTANCE OF 150.36 FEET;

THENCE S 24° 53' 19" W, A DISTANCE OF 113.21 FEET;

THENCE S 71° 28' 40" W, A DISTANCE OF 55.67 FEET;

THENCE N 03° 14' 26" W, A DISTANCE OF 115.76 FEET;

THENCE N 16° 31' 44" W, A DISTANCE OF 153.62 FEET TO THE POINT OF THE BE

SAID SITE CONTAINS 30,489 SQUARE FEET (0.70 ACRES) OF LAND, MORE OR LI

Please add this note:
Gas and Electric:
The subdivider/developer is responsible for extending utilities to each lot, tract or building site.

Gas and electric service for this subdivision is provided by _____ (Provider name(s)) subject to the District's (Providers) rules, regulations and specifications. (Combined note, which can be broken into separate notes for gas or electric in the case of different providers)

NOTES

SEWAGE TREATMENT IS THE RESPONSIBILITY OF EACH INDIVIDUAL PROPERTY OWNER. ALL SEPTIC SYSTEMS SHALL BE DESIGNED BY A COLORADO REGISTERED ENGINEER AND APPROVED BY THE EL PASO COUNTY HEALTH DEPARTMENT PRIOR TO PERMIT APPROVAL.

THE FOLLOWING REPORTS HAVE BEEN SUBMITTED AND ARE ON FILE WITH EL PASO COUNTY PLANNING AND COMMUNITY DEVELOPMENT DEPARTMENT: WATER RESOURCES, SEWERAGE, SOILS & GEOLOGICAL. WATER RESOURCES WERE EVALUATED DURING FINAL PLAT FOR CRYSTAL PARK SUBDIVISION NO. 2. SOIL & GEOLOGICAL REPORT WILL NOT BE SUBMITTED UNTIL SITE PLAN STAGE.

EXTREME WILDFIRE FIRE POTENTIAL EXISTS FOR PROPERTY WITHIN THIS SUBDIVISION. LIMITATIONS THAT INCREASE FIRE DANGER INCLUDE NO FIRE PROTECTION FROM AN ORGANIZED FIRE PROTECTION DISTRICT, SINGLE ACCESS INTO THE PROPERTY, TOPOGRAPHY AND VEGETATION.

ALL FUTURE DEVELOPMENT OF CRYSTAL PARK SHALL COMPLY WITH THE DEVELOPMENT PLAN AS RECORDED IN BOOK 6321, PAGE 438, AND THE DEVELOPMENT GUIDE AS RECORDED IN BOOK 6321, PAGE 443, OF THE RECORDS OF THE EL PASO COUNTY CLERK AND RECORDER, OR AS OTHERWISE AMENDED BY EL PASO COUNTY FOLLOWING APPROPRIATE PUBLIC HEARING.

DUE TO THE LACK OF HYDROGEOLOGICAL DATA ON THIS SUBDIVISION AND THE PARTICULAR HYDROGEOLOGIC CIRCUMSTANCES OF THIS PROPERTY, THE PURCHASER/OWNER OF ANY LOT BEARS THE RISK THAT A WELL DRILLED AT ANY GIVEN LOCATION ON THE PROPERTY WILL NOT PRODUCE ANY, OR ANY USABLE, QUANTITY OF GROUNDWATER. EXISTING WATER SUPPLIES MAY BE IMPACTED WHEN ADDITIONAL WELLS ARE DRILLED. WATER SUPPLIES MAY ALSO BE AFFECTED BY CLIMATIC CONDITIONS.

ALL INGRESS, EGRESS AND ACCESS THROUGH THIS SUBDIVISION IS BY PRIVATE ROADS THAT ARE NOT MAINTAINED BY EL PASO COUNTY. SUCH INGRESS, EGRESS AND ACCESS WAYS SHALL ALSO SERVE AS PRIVATE DRAINAGE WAYS. ALL ROADS AND DRAINAGE WAYS SHALL BE MAINTAINED BY CRYSTAL PARK COMMUNITY AND THE INDIVIDUAL SITE OWNERS.

ELECTRICAL EASEMENTS - THE OWNERS HEREBY DEDICATE TO THE CITY OF COLORADO SPRINGS DEPARTMENT OF PUBLIC UTILITIES A 30 FOOT WIDE EASEMENT, COMPRISED OF 15 FEET ON EACH SIDE OF ALL EXISTING ELECTRIC IMPROVEMENTS, FOR ELECTRIC TRANSMISSION AND DISTRIBUTION PURPOSES. ALL FUTURE ELECTRIC EASEMENTS SHALL REQUIRE APPROVAL OF THE BOARD OF DIRECTORS OF CRYSTAL PARK, INC.

WASTEWATER TREATMENT EASEMENTS - THE OWNERS HEREBY DEDICATE EASEMENTS FOR ALL EXISTING INDIVIDUAL WASTEWATER TREATMENT SYSTEMS WHICH ARE NOT LOCATED WITHIN A PLATTED SITE. SAID EASEMENTS SHALL EXTEND 25 FEET FROM THE OUTSIDE EDGE OF THE EXISTING SEPTIC TANKS, PIPES, AND DRYWELLS; AND SHALL BE SUBJECT TO THE RESTRICTIONS CONTAINED IN THE CRYSTAL PARK DEVELOPMENT GUIDELINES, COVENANTS, AND BYLAWS.

WATER WELL AND WATER SERVICE LINE EASEMENTS - THE OWNERS HEREBY DEDICATE EASEMENTS FOR ALL EXISTING INDIVIDUAL WATER WELLS AND ALL WATER SERVICE LINE COMPONENTS WHICH ARE NOT LOCATED WITHIN A PLATTED SITE. SAID EASEMENTS SHALL EXTEND 10 FEET FROM THE CENTERLINE OF SAID WATER WELLS AND WATER SERVICE LINES AND SHALL BE SUBJECT TO THE RESTRICTIONS CONTAINED IN THE CRYSTAL PARK DEVELOPMENT GUIDELINES, COVENANTS, AND BYLAWS.

PRIVATE ROAD AND UTILITY EASEMENTS - THE OWNERS HEREBY GRANT UNTO CRYSTAL PARK HOMEOWNERS ASSOCIATION, A COLORADO NONPROFIT CORPORATION (CRYSTAL PARK) THOSE PRIVATE ROAD AND UTILITY EASEMENTS AS SHOWN ON THIS PLAT AND FURTHER RESTRICT THE USE OF SAID EASEMENTS TO CRYSTAL PARK, AND/OR ITS ASSIGNS; PROVIDED HOWEVER, THAT THE SOLE RIGHT AND AUTHORITY TO RELEASE OR QUIT CLAIM ALL OR ANY SUCH EASEMENT SHALL REMAIN EXCLUSIVELY VESTED IN CRYSTAL PARK.

WATER QUALITY, QUANTITY, AND DEPENDABILITY DETERMINED SUFFICIENT WITH SF-93-002 (RESOLUTION NO. 93-337).



THIS SURVEY DOES NOT CONSTITUTE A TITLE SEARCH BY M.V.E., INC. TO DETERMINE OWNERSHIP OR EASEMENTS OF RECORD. FOR ALL INFORMATION REGARDING EASEMENTS, RIGHTS-OF-WAY AND TITLE OF RECORD, M.V.E., INC. RELIED UPON TITLE INSURANCE COMMITMENT NO. _____ AS PREPARED BY STEWART TITLE GUARANTY COMPANY AND DATED 2024 AT SAID TITLE COMMITMENT SHOULD BE USED FOR ALL INFORMATION REGARDING EASEMENTS, RIGHTS-OF-WAY, TITLE AND OTHER MATTERS OF RECORD AFFECTING THE PROPERTY.

DRIVEWAY MAINTENANCE AND SNOW REMOVAL ON AND FROM SITE TO AN EXISTING CRYSTAL PARK ROAD SHALL BE THE RESPONSIBILITY OF THE SITE OWNER.

THE ADDRESS EXHIBITED ON THIS PLAT IS FOR INFORMATIONAL PURPOSES ONLY, IT IS NOT THE LEGAL DESCRIPTION AND IS SUBJECT TO CHANGE.

ALL BEARINGS USED HEREIN ARE BASED ON AN ASSUMED BEARING OF S 88°49'58" E, A DISTANCE OF 5084.53' BETWEEN THE NORTHWEST CORNER OF SECTION 18, T14S, R 67 W OF THE 6TH P.M. AS MONUMENTED BY A 3" BRASS CAP STAMPED "U.S. DEPARTMENT OF THE INTERIOR BUR. OF LAND MANAGEMENT 1975" AND THE NORTHEAST CORNER OF SAID SECTION 18, AS MONUMENTED BY A GRANITE STONE.

ALL LINEAL UNITS DEPICTED ON THE PLAT ARE U.S. SURVEY FEET.

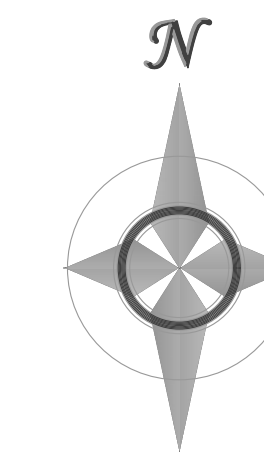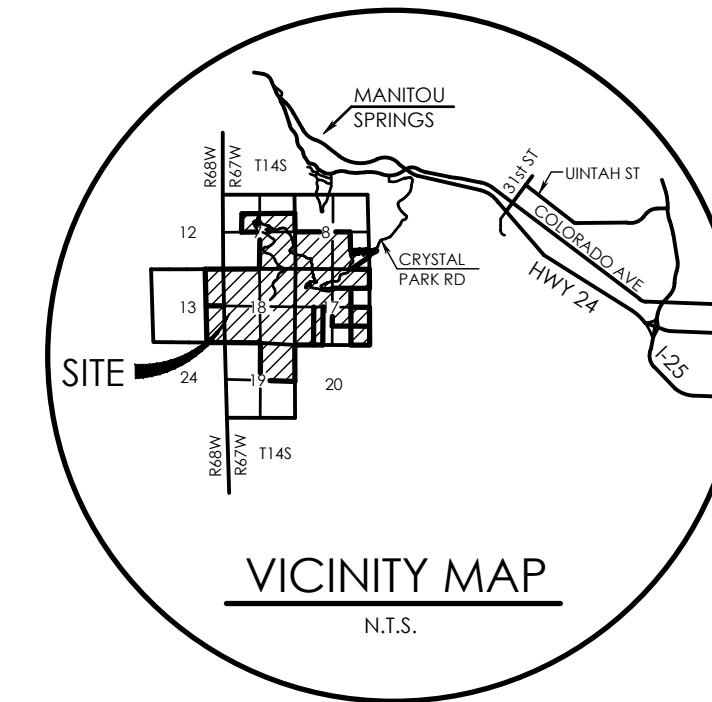

LEGEND

-----	SUBDIVISION BOUNDARY
-----	SECTION LINE
-----	PROJECTED QUARTER SECTION LINE
-----	PROJECTED 1/16TH SECTION LINE
-----	SITE (LOT) BOUNDARY LINE
-----	PREVIOUSLY PLATTED SITE (LOT) LINE
-----	EASEMENT LINE

ABBREVIATIONS

TP	SITE TIE POINT
COR	CORNER
c	CORNER
SEC	SECTION
Sec 8-14-67	SECTION NUMBER-TOWNSHIP SOUTH-RANGE WEST
BLM	BUREAU OF LAND MANAGEMENT
FD	FOUND
AL	ALUMINUM
REB	REBAR
S-95	SITE NUMBER
P.O.B.	POINT OF BEGINNING
P.O.C.	POINT OF COMMENCEMENT

RECORDATION

STATE OF COLORADO
COUNTY OF EL PASO

I HEREBY CERTIFY THAT THIS INSTRUMENT WAS FILED IN MY OFFICE THIS _____ DAY OF _____, 2024, AND IS DULY RECORDED IN A PLAT BOOK UNDER RECEPTION NUMBER _____ OF THE RECORDS OF EL PASO COUNTY, COLORADO.

EL PASO COUNTY CLERK AND RECORDER

RECORDING FEE: _____

SCHOOL: _____

PARK FEE: _____

BRIDGE: _____

DRAINAGE FEE: _____

DEDICATION

THE OWNERS HAVE CAUSED SAID TRACT OF LAND TO BE SURVEYED, AND PLATTED INTO A SITE AS SHOWN ON THE ACCOMPANYING PLAT, WHICH PLAT IS DRAWN TO A FIXED SCALE AS INDICATED THEREON AND ACCURATELY SETS FORTH THE BOUNDARIES AND DIMENSIONS OF SAID TRACT AND THE LOCATION OF SAID SITE, AND WHICH TRACT SO PLATTED SHALL BE KNOWN AS "SITE S-145(AR), SITE ADDITION TO CRYSTAL PARK SUBDIVISION NO. 2", EL PASO COUNTY, COLORADO.

IN WITNESS WHEREOF

THE AFOREMENTIONED DEDICATION STATEMENT IS EXECUTED THIS _____ DAY OF _____, 2024.

CRYSTAL PARK HOME OWNERS ASSOCIATION

BY: _____
WILLIAM GIBBS, PRESIDENT

TEMPE KRIEGER, VICE PRESIDENT

STATE OF COLORADO }
COUNTY OF EL PASO } SS

THE ABOVE AND FOREGOING DEDICATION STATEMENT WAS ACKNOWLEDGED BEFORE ME BY WILLIAM GIBBS, AS PRESIDENT AND TEMPE KRIEGER, AS VICE PRESIDENT OF CRYSTAL PARK HOMEOWNERS ASSOCIATION, THIS _____ DAY OF _____, 2024.

WITNESS MY HAND AND OFFICIAL SEAL.

NOTARY PUBLIC

MY COMMISSION EXPIRES: _____

COUNTY APPROVAL

THIS PLAT FOR SITE S-145(AR), SITE ADDITION TO CRYSTAL PARK SUBDIVISION NO. 2, WAS APPROVED FOR FILING BY THE EL PASO COUNTY, COLORADO PLANNING AND COMMUNITY DEVELOPMENT DEPARTMENT DIRECTOR ON THE _____ DAY OF _____, 2024, SUBJECT TO ANY NOTES OR CONDITIONS SPECIFIED HEREON.

PLANNING AND COMMUNITY DEVELOPMENT DEPARTMENT

SURVEYOR'S STATEMENT

I, ERIC SIMONSON, A DULY REGISTERED PROFESSIONAL LAND SURVEYOR IN THE STATE OF COLORADO, DO HEREBY CERTIFY THAT THIS PLAT TRULY AND CORRECTLY REPRESENTS THE RESULTS OF A SURVEY MADE ON THE DATE OF SURVEY, BY ME OR UNDER MY DIRECT SUPERVISION AND THAT ALL MONUMENTS EXIST AS SHOWN HEREON; THAT MATHEMATICAL CLOSURE ERRORS ARE LESS THAN 1:10,000; AND THAT SAID PLAT HAS BEEN PREPARED IN FULL COMPLIANCE WITH ALL APPLICABLE LAWS OF THE STATE OF COLORADO DEALING WITH MONUMENTS, SUBDIVISION, OR SURVEYING OF LAND AND ALL APPLICABLE PROVISIONS OF THE EL PASO COUNTY LAND DEVELOPMENT CODE.

THIS CERTIFICATION IS NEITHER A WARRANTY OR GUARANTEE, EITHER EXPRESSED OR IMPLIED.

I ATTEST THE ABOVE ON THIS _____ DAY OF _____, 2024.

ERIC SIMONSON, PLS
COLORADO REGISTERED PLS #38560
RAMPART SURVEYS, LLC
WOODLAND PARK, CO 80863
FOR AND ON BEHALF OF M.V.E., INC.

NOTICE

ACCORDING TO COLORADO LAW YOU MUST COMMENCE ANY LEGAL ACTION BASED UPON ANY DEFECT IN THIS SURVEY WITHIN THREE YEARS AFTER YOU FIRST DISCOVER SUCH DEFECT. IN NO EVENT MAY ANY ACTION BASED UPON ANY DEFECT IN THIS SURVEY BE COMMENCED MORE THAN TEN YEARS FROM THE DATE OF THE CERTIFICATIONS SHOWN HEREON." [SECTION 13-80-105 C.R.S.]


SHEET 1 OF 2

		MONUMENT VALLEY ENGINEERS INC. *** ENGINEERS *** SURVEYORS *** 1911 LELARAY ST., COLORADO SPRINGS, COLORADO 80909 (719) 635-5736	
		SITE S-145 (AR)	
SCALE	N/A	DRAWN BY	AM
DATE	01/23/24	CHECKED BY	AM
DWC. NO. 40251001		JOB NO. 40251	

PCD FILE NO. SF243

SITE S-145 (AR)

SITE ADDITION TO CRYSTAL PARK SUBDIVISION NO. 2, A PORTION OF THE NORTHWEST ONE-QUARTER OF THE SOUTHWEST ONE-QUARTER (NW1/4, SW1/4) OF SECTION 18, TOWNSHIP 14 SOUTH, RANGE 67 WEST OF THE SIXTH PRINCIPAL MERIDIAN, COUNTY OF EL PASO, STATE OF COLORADO

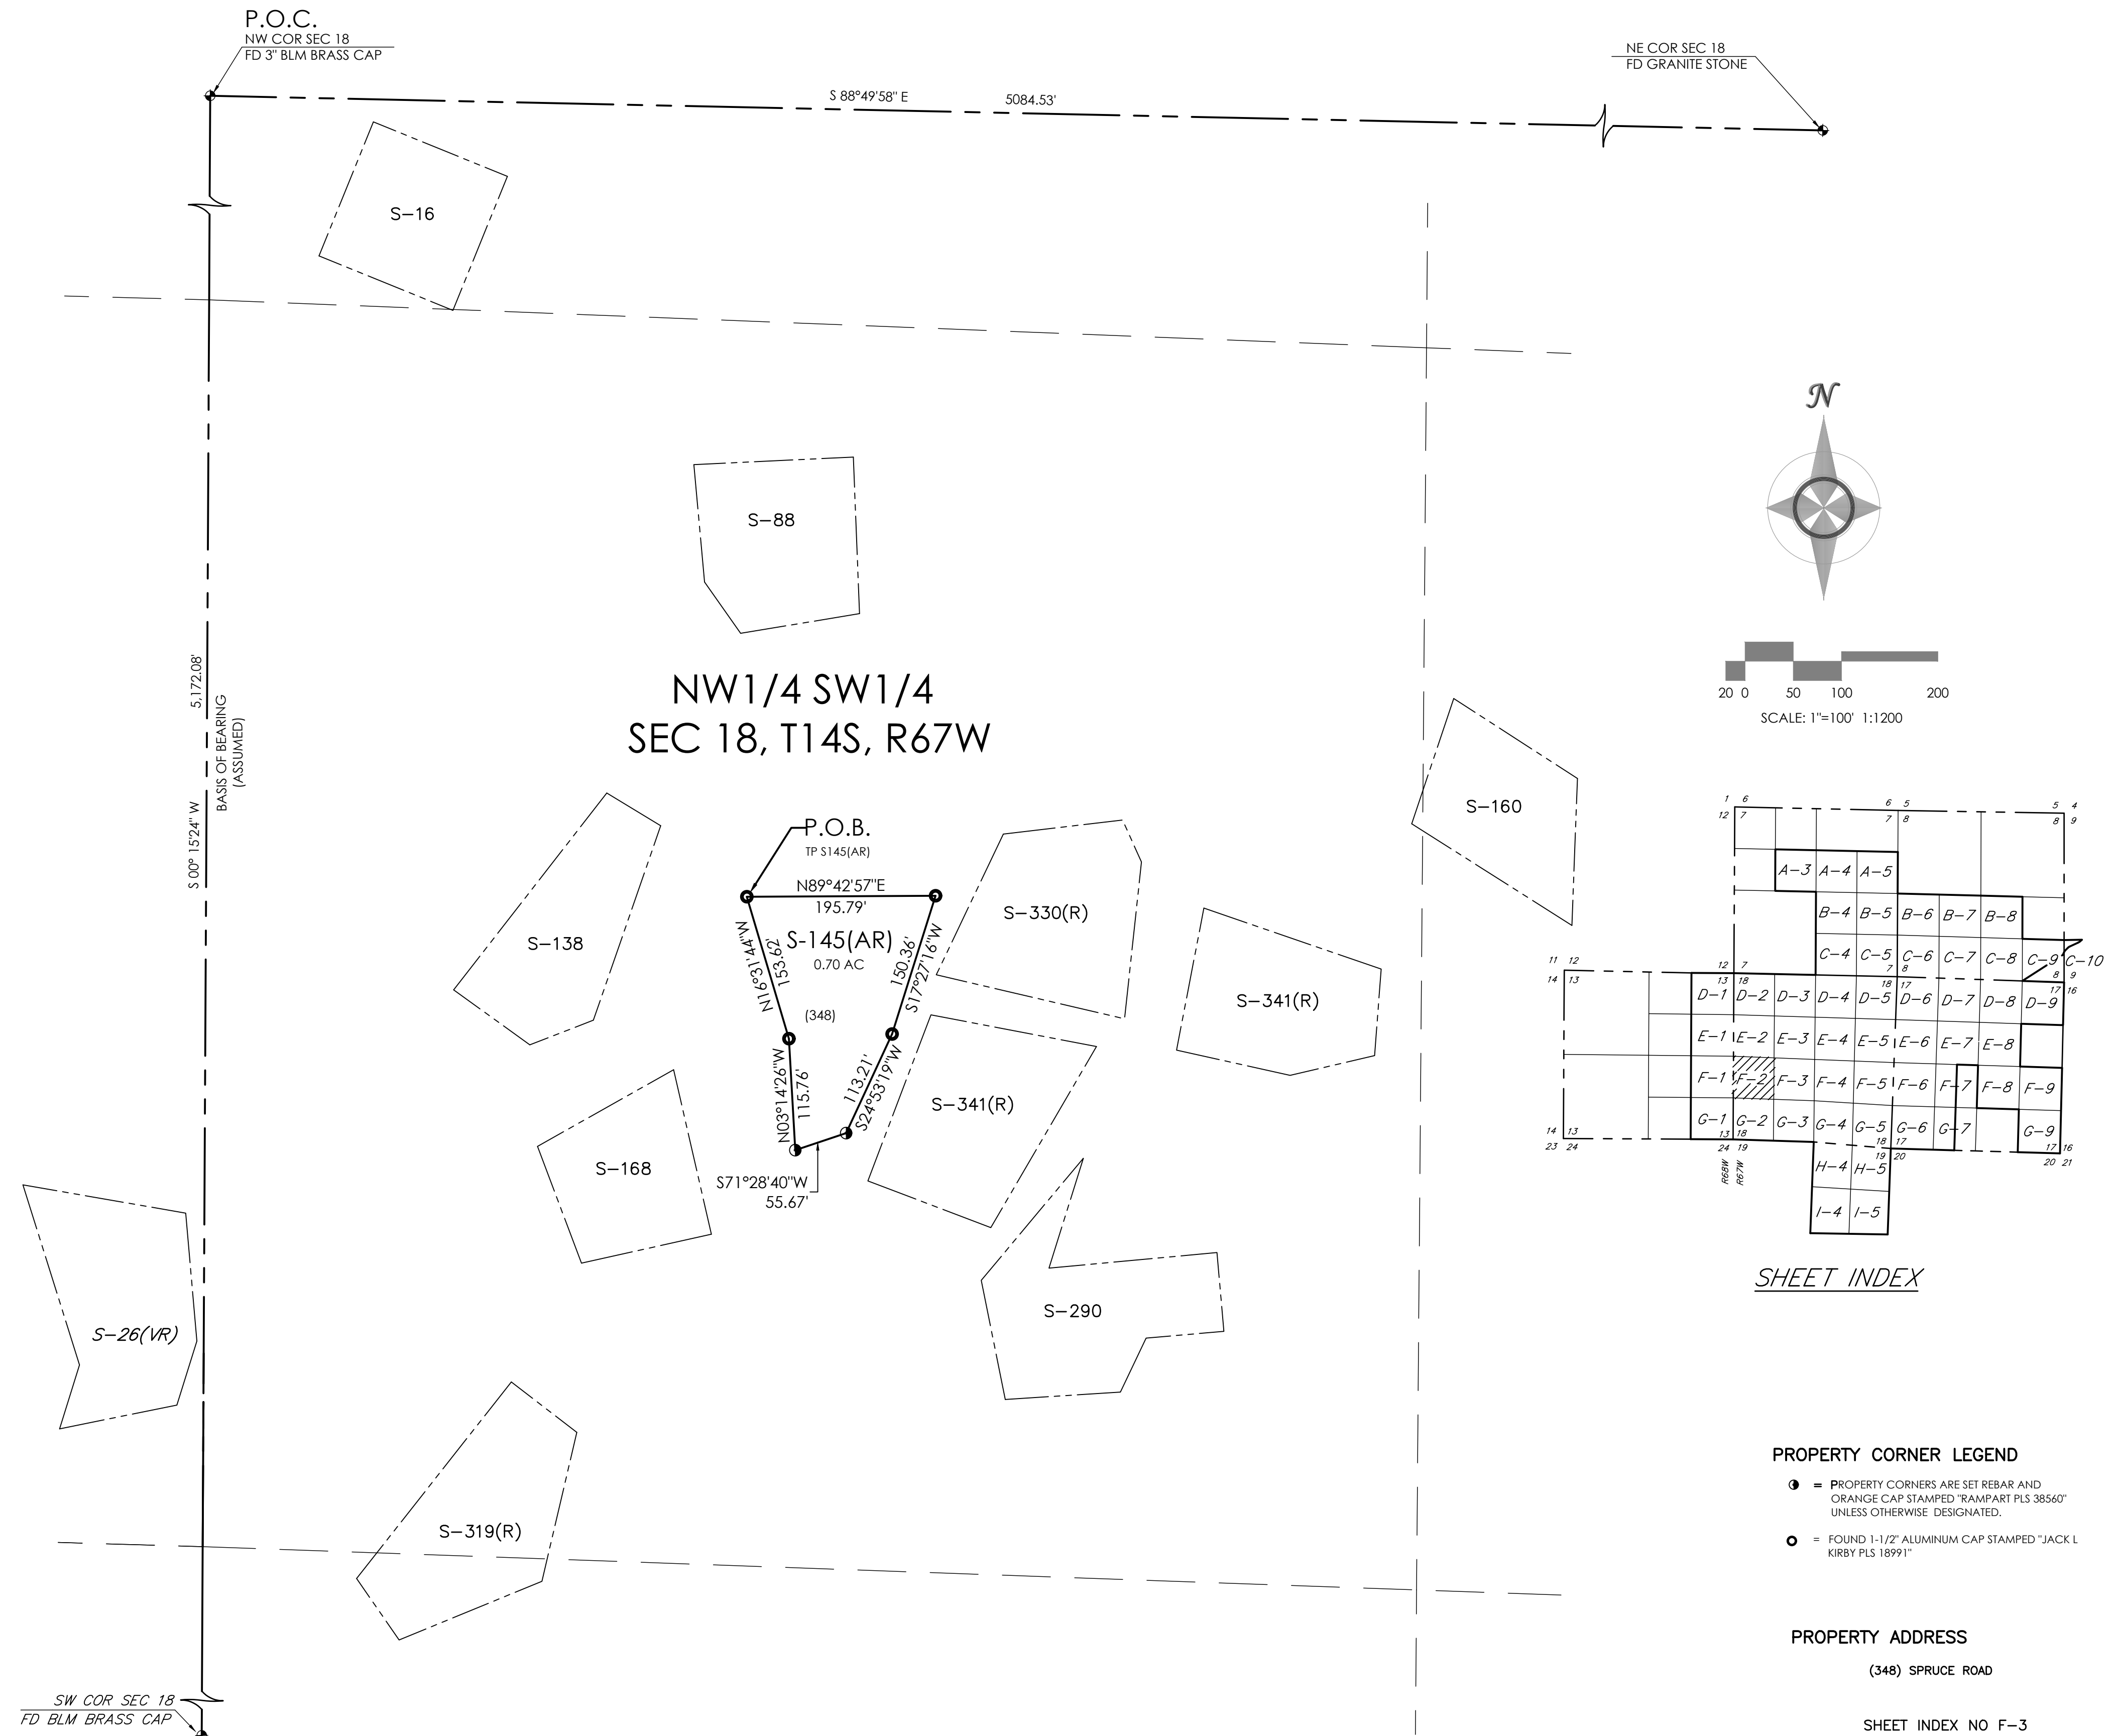

NW1/4 SW1/4
SEC 18, T14S, R67W

SHEET INDEX

- PROPERTY CORNER LEGEND**
- = PROPERTY CORNERS ARE SET REBAR AND ORANGE CAP STAMPED "RAMPART PLS 38560" UNLESS OTHERWISE DESIGNATED.
 - = FOUND 1-1/2" ALUMINUM CAP STAMPED "JACK L KIRBY PLS 18991"

PROPERTY ADDRESS
(348) SPRUCE ROAD

SHEET INDEX NO F-3
SHEET 2 OF 2

TABLE OF SITE LOCATION TIES

TIE POINT	FROM:	TO:	BEARING	DISTANCE
145(AR)	NWc. Sec 18-14-67	145(AR)	S 09° 40' 58" E	3,254.03'

PCD FILE NO. SF243

MONUMENT VALLEY ENGINEERS INC.
ENGINEERS SURVEYORS
1911 LELARAY ST., COLORADO SPRINGS, COLORADO 80909
(719) 635-5736

SITE S-145 (AR)

SCALE 1" = 100' DRAWN BY AM DWG. NO. 40251002
DATE 01/23/24 CHECKED BY JOB NO. 40251