



EL PASO COUNTY PLANNING & COMMUNITY DEVELOPMENT SIGN APPLICATION

SC-18-033

DATE: 6/26/18

Business

Name: KFC/A+W
Address: 7384 McLAUGHLIN RD

Zone: CR
Legal Description: LOT 3 BECKETT AT WOODMEN HILLS FILE NO 1

Type of Sign

Illuminated: YES
Non-Illuminated: _____
Valuation: \$ 28,443

Storefront Length &/or Width: 95' N+S
38' E+W
Proposed Sign Sq. Ft. 177.15

Existing Sign Sq. Ft. 133.41

Total Sign Sq. Ft. 310.56

Contractor Information

Name: YESCO LLC
(Chuck Boncordo)
Address: 11220 E 53rd Ave #300
Denver, CO 80239


Phone: 720-458-7104

Type of License: Sign

Contractor ID# 10853

Vicinity Map

Tax Schedule # 4307202010
Please show major intersections.

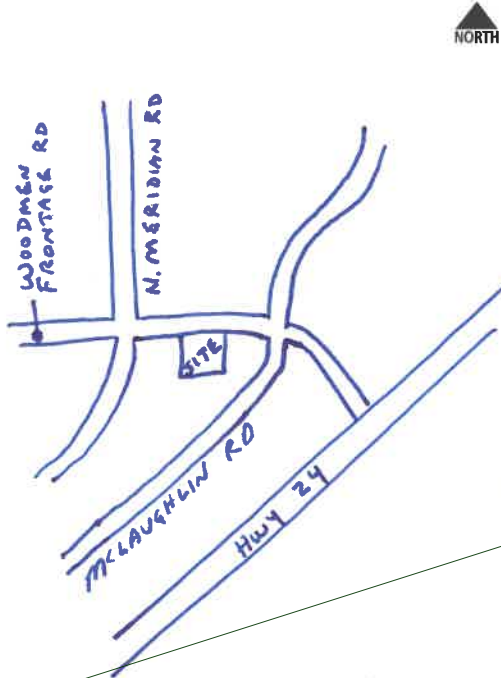


Elevation Drawing

Indicate storefront length & placement of sign.

SEE YESCO DESIGN
ART 14737

Sign Plan

(Please indicate dimensions and sign copy)

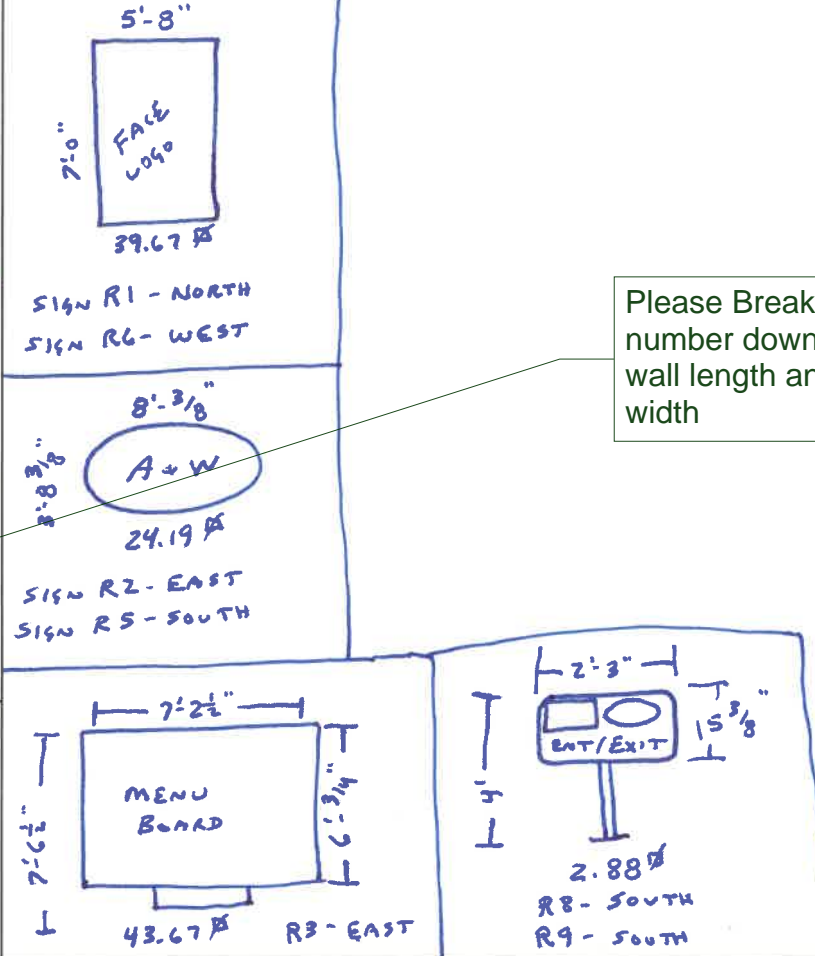

Please Break this number down to each wall length and/or width

For Planning & Community Development Use Only

Approved Date: _____ Resubmittal? Yes _____ No _____
Denied Date: _____
Comments: _____


Markup Summary

Locked (2)

SC-18-033

Subject: Text Box
Page Label: 1
Lock: Locked
Author: dsdsevigny
Date: 6/28/2018 8:23:23 AM
Color: ■

SC-18-033

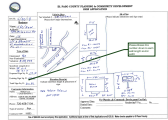

Subject: Callout
Page Label: 1
Lock: Locked
Author: dsdsevigny
Date: 6/28/2018 8:23:24 AM
Color: ■

Please Break this number down to each wall length and/or width