


No north arrow, property lines still need to be labeled.No parking lot landscaping No seeding indicated No Alternative Landscape Design requested. Unless requested in the letter of intent, all standard in Chapter 6 of the LDC are required to be met. please provide a tree count. Consider the next round of comments to be a first round of comments. Please refer to chapter 6 of the LDC to put together a landscape plan.

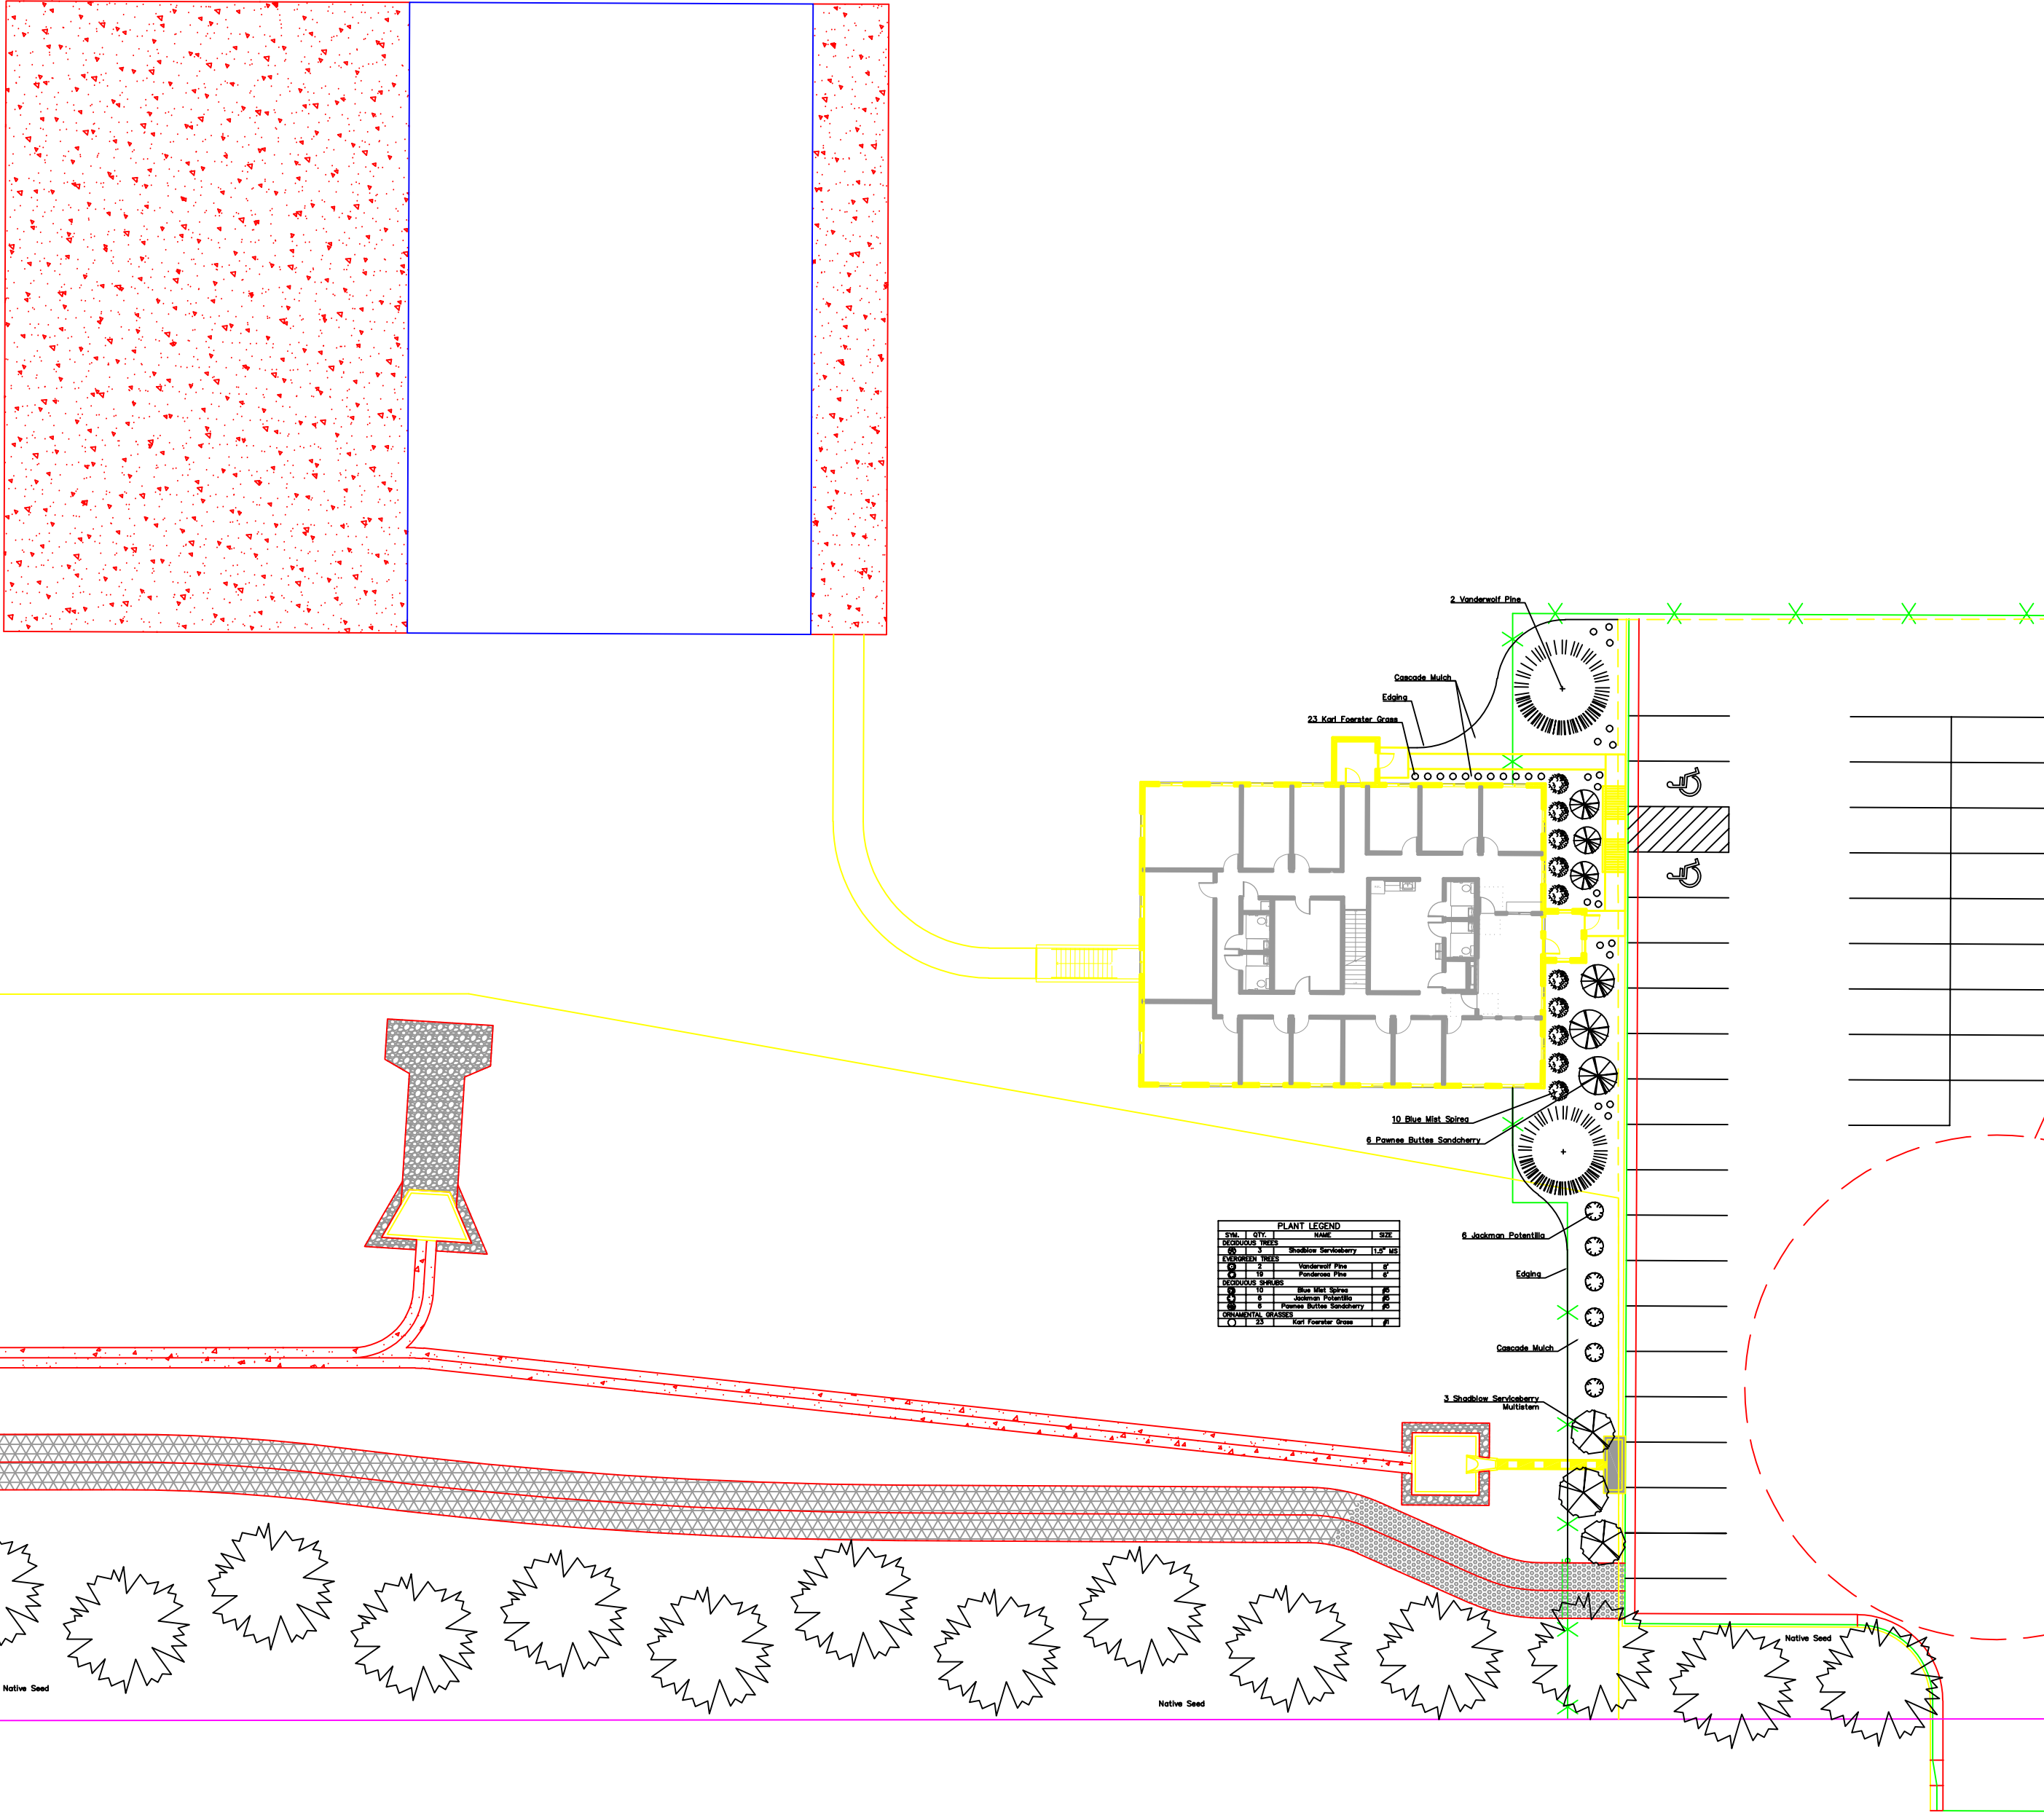

Dwire Earthmoving

Colorado Springs, Colorado 80939

Drawing and the subject matter therein is the property of Timberline Landscaping, Inc. and is not to be copied or disclosed to others without the expressed written permission of Timberline Landscaping, Inc. Any such uses constitutes a purchase of design services from Timberline Landscaping, Inc.

Designed by: Elysa Engle
Date: 1.24.2020
Revised:
Scale: 1" = 10'

8110 Opportunity View
Colorado Springs, CO 80939
(719) 638-1000 fax (719) 638-1010