



SITE DEVELOPMENT PLAN

A PORTION OF THE SOUTHEAST QUARTER OF SECTION 9
TOWNSHIP 15 SOUTH, RANGE 67 WEST OF THE 6TH P.M.
COUNTY OF EL PASO, COLORADO

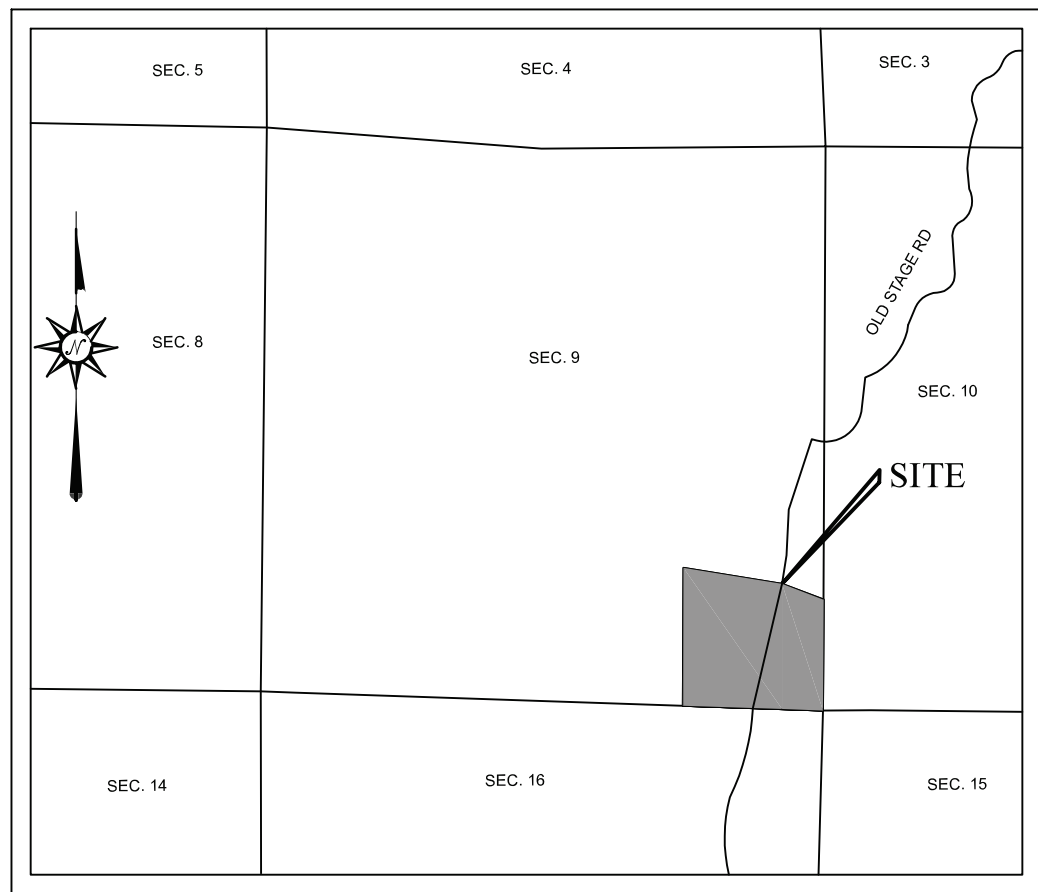

VICINITY MAP
(NOT TO SCALE)

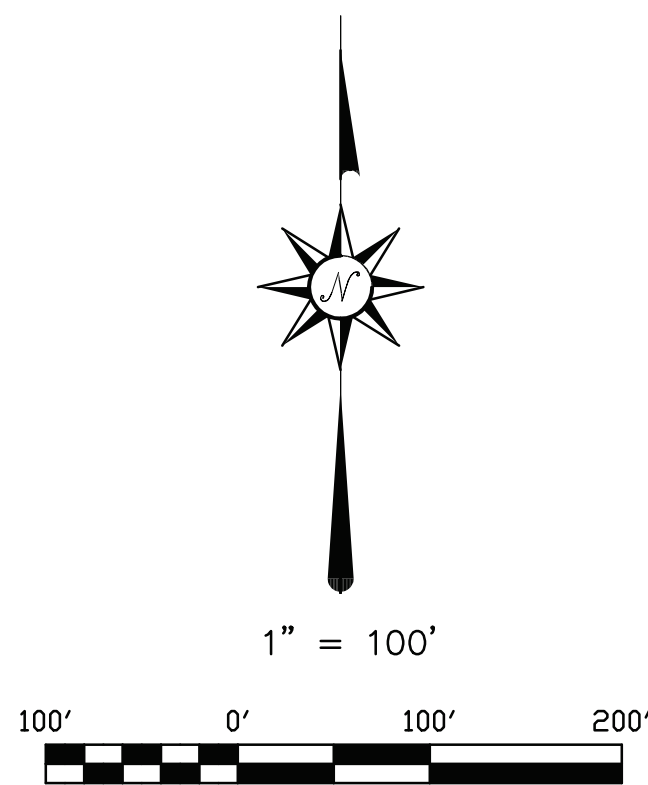

PARCEL DETAILS

Address: 5415 Old Stage Road, Colorado Springs, Colorado

El Paso County Schedule No.: 7500000275

OWNER/APPLICANT INFORMATION

Name: OLD STAGE TRUST
Phone: (808) 445-6671
E-mail: sturdyfoundations@gmail.com

LEGAL DESCRIPTION

PARCEL 1:
Commencing at the Southeast corner of Section 9, Township 15 South, Range 67 West of the Sixth Principal Meridian, County of El Paso, State of Colorado, said point being the POINT OF BEGINNING; thence N88°10'05"W on the South line of the Southeast Quarter of the Southeast Quarter of said Section 9, a distance of 1321.03 feet to the Southwest corner of the Southeast Quarter of the Southeast Quarter of said Section 9; thence N00°14'57"E on the West line of the Southeast Quarter of the Southeast Quarter of said Section 9, a distance of 1319.51 feet to the Northwest Quarter of the Southeast Quarter of the Southeast Quarter of said Section 9; thence S76°40'08"E, a distance of 959.95 feet; thence S54°03'34"E, a distance of 480.04 feet to a point on the East line of the Southeast Quarter of the Southeast Quarter of said Section 9; thence S00°32'32"W on said East line a distance of 858.67 feet to the POINT OF BEGINNING.

PARCEL B:
Non-exclusive 60 foot public access, ingress/egress and public utility easements as shown on that Land Survey Plat recorded September 24, 2003 at Reception No. 203224253. Said easements are referred to thereon as Simon Point, Felicity View, and Old Stage Road.

County of El Paso, State of Colorado.

(Per Warranty Deed 223098359)

SURVEYOR'S NOTES

- NOTICE: According to Colorado law you must commence any legal action based upon any defect in this survey within three years after you first discover such defect. In no event may any action based upon any defect in this survey be commenced more than ten years from the date of the certification shown hereon.
- Any person who knowingly removes, alters or defaces any public land survey monument or land boundary monument or accessory commits a class 2 misdemeanor pursuant to the Colorado Revised Statute 18-4-508.
- The lineal units used in this drawing are U.S. Survey Feet.
- This survey was performed in the field on December 30, 2025.
- The overall subject parcel contains a calculated area of 1,529,932 square feet (35.12 acres) of land, more or less.
- This survey does not constitute a title search by Forth Land Surveying, Inc. to determine ownership or easements of record.
- Bearings are based on a portion of the East line of the Southeast Quarter of Section 9, T15S, R67W of the 6th P.M., monumented on the South end by a 2" aluminum pipe with properly marked 3 1/4" aluminum Bureau of Land Management cap, and on the North end by a No. 5 rebar with 1.5" aluminum cap, PLS 30118, and is assumed to bear S00°32'32"W a measured distance of 858.70 feet.
- Any underground or above ground utilities shown hereon have been located from field survey information. Forth Land Surveying, Inc. does not guarantee said underground utilities to be shown in their exact location and that said underground utilities are shown in their entirety. Forth Land Surveying, Inc. did not physically enter any manholes or inlets to verify size and material. Where additional or more detailed information is required, the client is advised that excavation may be necessary.
- The Federal Emergency Management Agency, Flood Insurance Rate Map No. 08041C0725G, effective date 12/7/2018, indicates this parcel of land to be located in Zone D (Areas with possible but undetermined flood hazards).
- There were 14 regular parking spaces and 2 handicap parking spaces visible at the time of survey.
- There was snow on the ground at the time of survey. While every effort was made to show the visible improvements, Forth Land Surveying, Inc. does not guarantee that the improvements are shown in their entirety.
- Zoning notes: Property is zoned "A1" (Agricultural District).
Building Setbacks:
Front = 25' (street)
Side = 25'
Rear = 25'
Height restrictions: 30'
Off-street parking requirements: N/A

The zoning information above was procured from El Paso County, Colorado Land Development Code, dated August 22, 2024 (as interpreted by the surveyor).

APPROVALS

The accompanying plan was approved by the EL Paso County Planning and Community Development this _____ day of _____, 20____ A.D.

Director, Planning and Community Development

SURVEYOR'S STATEMENT

The undersigned Colorado Registered Professional Land Surveyor does hereby state and declare to Angela Gregg, that the accompanying plan was surveyed and drawn under his direct responsibility and supervision and to the normal standard of practice by surveyors in the State of Colorado and accurately shows the described tract of land therein, that the requirements of Title 38 of the Colorado Revised Statutes, 1973, as amended, have been met to the best of his professional knowledge, belief and opinion.

Cameron Forth
State of Colorado Professional Land Surveyor No. 38390
For and on behalf of Forth Land Surveying, Inc.

SITE INFORMATION

Lot Size: 1,529,932 sq. ft.


Existing Improvements:
Metal Garage: 1,221 sq. ft.
Wood Shed: 106 sq. ft.

Proposed Improvements:
House: 1,523 sq. ft.
Deck/Porch: 1,247 sq. ft.
Garage: 738 sq. ft.

Proposed Impervious Area: 4,835 (0.32%)

Proposed camp sites: 18

PARCEL 2,
OSCAR BYRD PROPERTY
PART OF SE 1/4 OF SECTION 9,
AND SW 1/4 SECTION 10,
TOWNSHIP 15 SOUTH, RANGE 67 WEST

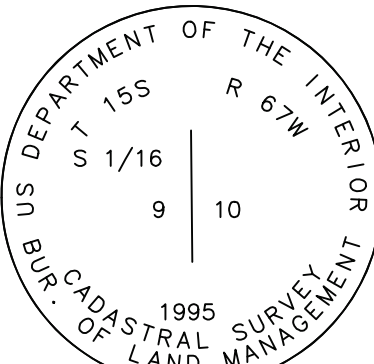


Gates shall be located a minimum of 30 ft from public Right of Way and shall not open outward. The clear opening provided through a gate shall be a minimum of 16 ft in width.

Please note a site development plan will be required prior to establishing the use. This project has been set up in EDARP.

Please specify the extent of development so EPC Stormwater can accurately determine future requirements. At time of site development plan (PPR submittal), stormwater quality will need to be addressed. For land disturbances greater than 1 ac, an ESQCP and PCM are required if no other exclusions apply. This land disturbance would include any land disturbance associated with parking, campsites, buildings, the trail, etc.

At this time include total land disturbances on site plan so it is clear the extent of development.

DETAIL 'A'
(1" = 20')

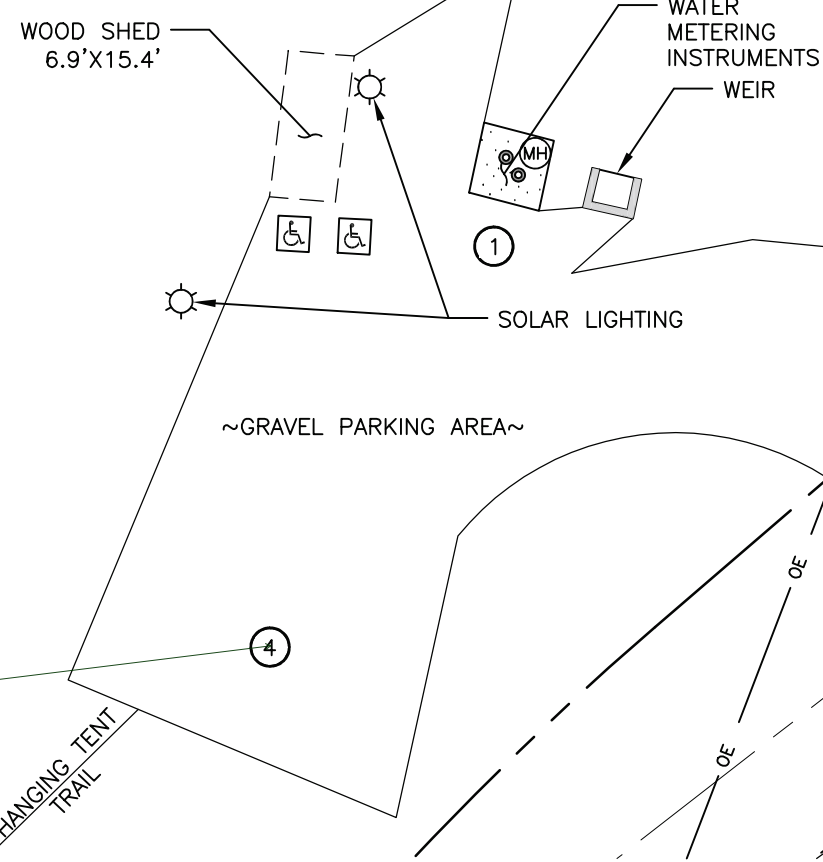

Detail says 4, but plan shows 5

DATE: January 6, 2026				REVISIONS				FORTH LAND SURVEYING, INC.			
No.	Remarks	Date	By	No.	Remarks	Date	By	No.	Remarks	Date	By
1	Corrected the spelling of Aksel	1/9/26	CF	1	Corrected the spelling of Aksel	1/9/26	CF	1	Corrected the spelling of Aksel	1/9/26	CF
2	Revised per comments	3/27/26	CF	2	Revised per comments	3/27/26	CF	2	Revised per comments	3/27/26	CF
3	Revised location of gates	3/30/26	CF	3	Revised location of gates	3/30/26	CF	3	Revised location of gates	3/30/26	CF
Field: TC/KB				Drawn: TC				Checked: CF			
PROJECT No.: 24010				SHEET 1 OF 1							