

STERLING RANCH FILING NO. 2

A PORTION OF THE E1/2 OF THE SE1/4 OF SECTION 32 AND THE S1/2 OF THE SW1/4 OF SECTION 33, TOWNSHIP 12 SOUTH, RANGE 65 WEST, AND THE NW1/4 OF THE NW1/4 OF SECTION 4 AND THE NE1/4 OF THE NE1/4 OF SECTION 5, TOWNSHIP 13 SOUTH, RANGE 65 WEST, BOTH OF THE 6TH PRINCIPAL MERIDIAN, EL PASO COUNTY, STATE OF COLORADO.

BE IT KNOWN BY THESE PRESENTS:

THAT SR LAND, LLC, BEING THE OWNER OF THE FOLLOWING DESCRIBED TRACT OF LAND TO WIT:

LEGAL DESCRIPTION:

A PARCEL OF LAND LOCATED IN A PORTION OF THE E1/2 SE1/4 OF SECTION 32 AND THE S1/2 SW1/4 OF SECTION 33, TOWNSHIP 12 SOUTH, RANGE 65 WEST AND THE NW1/4 OF NW1/4 OF SECTION 4 AND THE NE1/4 OF NE1/4 OF SECTION 5, TOWNSHIP 13 SOUTH, RANGE 65 WEST, BOTH OF THE 6TH PRINCIPAL MERIDIAN, EL PASO COUNTY, STATE OF COLORADO, AND BEING MORE PARTICULARLY DESCRIBED AS FOLLOWS:

BASIS OF BEARINGS: THE SOUTH LINE OF THE SOUTHWEST QUARTER OF SECTION 34, TOWNSHIP 12 SOUTH, RANGE 65 WEST OF THE 6TH P.M. AS MONUMENTED AT THE SOUTHWEST CORNER OF SAID BY A 2-1/2" ALUMINUM CAP STAMPED "LS 11624" AND AT THE SOUTHEAST CORNER OF SAID SOUTHWEST QUARTER BY A 2-1/2" ALUMINUM CAP STAMPED "LS 11624", SAID LINE BEARS N89°14'14"E, A DISTANCE OF 2,722.69 FEET.

COMMENCING AT SAID SOUTHWEST CORNER OF SAID SOUTHWEST QUARTER (SW1/4) OF SAID SECTION 34; THENCE N77°08'03"W, A DISTANCE OF 3,334.61 FEET TO THE SOUTHWESTERLY CORNER OF DINES BOULEVARD AS PLATTED IN STERLING RANCH FILING NO. 1, RECORDED UNDER RECEPTION NO. 218714151 IN THE RECORDS OF THE EL PASO COUNTY CLERK AND RECORDER, SAID POINT BEING THE POINT OF BEGINNING;

THENCE ON THE SOUTHERLY LINE OF SAID DINES BOULEVARD, N76°19'20"E A DISTANCE OF 85.00 FEET;

THENCE DEPARTING SAID SOUTHERLY LINE, S13°40'40"E A DISTANCE OF 80.00 FEET TO A POINT ON THE NORTHERLY LINE OF THAT 20' ELECTRIC EASEMENT RECORDED UNDER RECEPTION NO. 218054783;

THENCE ON SAID NORTHERLY EASEMENT LINE, S76°19'20"W A DISTANCE OF 80.00 FEET;

THENCE S13°40'40"E A DISTANCE OF 20.00 FEET, TO A POINT ON THE SOUTHERLY LINE OF SAID ELECTRIC EASEMENT;

THENCE ON SAID SOUTHERLY LINE, S76°19'20"W A DISTANCE OF 852.10 FEET;

THENCE N13°40'40"W A DISTANCE OF 20.00 FEET, TO A POINT ON THE NORTHERLY LINE OF SAID ELECTRIC EASEMENT;

THENCE ON SAID NORTHERLY LINE, S76°19'20"W A DISTANCE OF 50.00 FEET;

THENCE S13°40'40"E A DISTANCE OF 20.00 FEET, TO A POINT ON THE SOUTHERLY LINE OF SAID ELECTRIC EASEMENT;

THENCE ON SAID SOUTHERLY LINE, THE FOLLOWING FIVE (5) COURSES:

- S76°19'20"W A DISTANCE OF 386.99 FEET, TO A POINT OF CURVE;
- ON THE ARC OF A CURVE TO THE LEFT, HAVING A RADIUS OF 940.00 FEET, A CENTRAL ANGLE OF 23°53'20" AND AN ARC LENGTH OF 391.92 FEET, TO A POINT OF NON-TANGENT;
- S41°03'23"W A DISTANCE OF 60.19 FEET, TO A POINT OF NON-TANGENT CURVE;
- ON THE ARC OF A CURVE TO THE LEFT WHOSE CENTER BEARS S41°12'17"E, HAVING A RADIUS OF 930.00 FEET, A CENTRAL ANGLE OF 08°26'12" AND AN ARC LENGTH OF 136.94 FEET, TO A POINT OF TANGENT;
- S40°21'31"W A DISTANCE OF 402.59 FEET, TO A POINT ON THE EASTERLY LINE OF THAT ACCESS AND UTILITY EASEMENT RECORDED UNDER RECEPTION NO. 214100440;

THENCE ON SAID EASTERLY LINE, S49°38'29"E A DISTANCE OF 16.00 FEET;

THENCE S40°21'31"W A DISTANCE OF 160.00 FEET, TO A POINT ON THE WESTERLY LINE OF SAID ACCESS AND UTILITY EASEMENT;

THENCE ON THE WESTERLY LINE OF THAT ACCESS AND UTILITY EASEMENT RECORDED UNDER RECEPTION NOS 214100440 & 214100441, N49°38'29"W A DISTANCE OF 1459.89 FEET, TO A POINT ON THE EASTERLY RIGHT-OF-WAY LINE OF VOLLMER ROAD;

THENCE ON SAID EASTERLY RIGHT-OF-WAY LINE, N40°24'51"E A DISTANCE OF 1808.03 FEET, TO A POINT ON THE SOUTHERLY LINE OF THAT PROPERTY RECORDED UNDER RECEPTION NO. 217080112 AND SHOWN ON THE AMENDED PLAT BARBARICK SUBDIVISION RECORDED UNDER RECEPTION NO. 217713910;

THENCE ON SAID SOUTHERLY LINE THE FOLLOWING TWO (2) COURSES:

- S51°21'50"E A DISTANCE OF 13.67 FEET, TO A POINT OF CURVE;
- ON THE ARC OF A CURVE TO THE LEFT, HAVING A RADIUS OF 130.00 FEET, A CENTRAL ANGLE OF 38°41'48" AND AN ARC LENGTH OF 87.80 FEET, TO A POINT OF NON-TANGENT ON THE WESTERLY LINE OF SAID AMENDED PLAT BARBARICK SUBDIVISION;

THENCE ON THE WESTERLY AND SOUTHERLY LINES OF SAID AMENDED PLAT BARBARICK SUBDIVISION, THE FOLLOWING TWO (2) COURSES:

- S00°06'01"E A DISTANCE OF 631.46 FEET;
- N89°17'25"E A DISTANCE OF 279.65 FEET;

THENCE DEPARTING SAID AMENDED PLAT BARBARICK SUBDIVISION, THE FOLLOWING COURSES:

- S00°42'35"E A DISTANCE OF 241.35 FEET;
- S02°02'55"W A DISTANCE OF 130.48 FEET;
- S05°37'53"W A DISTANCE OF 90.96 FEET;
- S01°55'19"W A DISTANCE OF 307.22 FEET;
- N73°29'47"E A DISTANCE OF 11.27 FEET;

S16°30'13"E A DISTANCE OF 179.19 FEET, TO A POINT OF NON-TANGENT CURVE ON THE NORTHERLY LINE OF SAID 20' ELECTRIC EASEMENT RECORDED UNDER RECEPTION NO. 218054783;

THENCE ON SAID NORTHERLY LINE, THE FOLLOWING TWO (2) COURSES:

- ON THE ARC OF A CURVE TO THE RIGHT WHOSE CENTER BEARS S33°39'44"E, HAVING A RADIUS OF 1060.00 FEET, A CENTRAL ANGLE OF 19°59'04" AND AN ARC LENGTH OF 369.72 FEET, TO A POINT OF TANGENT;
- N76°19'20"E A DISTANCE OF 381.99 FEET;

THENCE S13°40'40"E A DISTANCE OF 20.00 FEET, TO A POINT ON THE SOUTHERLY LINE OF SAID ELECTRIC EASEMENT;

THENCE ON SAID SOUTHERLY LINE, N76°19'20"E A DISTANCE OF 60.00 FEET;

THENCE N13°40'40"W A DISTANCE OF 20.00 FEET, TO A POINT ON THE NORTHERLY LINE OF SAID ELECTRIC EASEMENT;

THENCE ON SAID NORTHERLY LINE, N76°19'20"E A DISTANCE OF 842.10 FEET, TO A POINT ON THE WESTERLY RIGHT-OF-WAY OF DINES BOULEVARD AS SHOWN ON SAID PLAT OF STERLING RANCH FILING NO. 1;

THENCE ON SAID WESTERLY RIGHT-OF-WAY LINE, S13°40'40"E A DISTANCE OF 20.00 FEET, TO THE POINT OF BEGINNING.

CONTAINING A CALCULATED AREA OF 2,157,908 SQUARE FEET OR 49.5387 ACRES.

ACCEPTANCE CERTIFICATE FOR TRACTS:

THE DEDICATION OF TRACTS A, B, C, D, F, G, H, I, AND J ARE FOR LANDSCAPE PURPOSES, DRAINAGE, PEDESTRIAN ACCESS, OPEN SPACE, AND UTILITIES PURPOSES AND ARE HEREBY ACCEPTED FOR OWNERSHIP AND MAINTENANCE BY STERLING RANCH METROPOLITAN DISTRICT NO. 1.

BY: _____

AS: _____ OF STERLING RANCH METROPOLITAN DISTRICT NO. 1

STATE OF COLORADO)
) SS
COUNTY OF EL PASO)

ACKNOWLEDGED BEFORE ME THIS _____ DAY OF _____, 2020, A.D.

BY: _____

AS: _____ OF STERLING RANCH METROPOLITAN DISTRICT NO. 1

WITNESS MY HAND AND OFFICIAL SEAL:

MY COMMISSION EXPIRES: _____

NOTARY PUBLIC: _____

ACCEPTANCE CERTIFICATE FOR TRACTS:

THE DEDICATION OF TRACT E IS FOR FUTURE RESIDENTIAL DEVELOPMENT PURPOSES AND IS HEREBY ACCEPTED FOR OWNERSHIP AND MAINTENANCE BY SR LAND, LLC.

BY: _____

AS: _____ OF SR LAND, LLC

STATE OF COLORADO)
) SS
COUNTY OF EL PASO)

ACKNOWLEDGED BEFORE ME THIS _____ DAY OF _____, 2020, A.D.

BY: _____

AS: _____ OF SR LAND, LLC

WITNESS MY HAND AND OFFICIAL SEAL:

MY COMMISSION EXPIRES: _____

NOTARY PUBLIC: _____

OWNERS CERTIFICATE/ DEDICATION STATEMENT:

THE ABOVE OWNER HAVE CAUSED SAID TRACT OF LAND TO BE SURVEYED AND PLATTED INTO TRACTS, LOTS, STREETS, AND EASEMENTS AS SHOWN ON THE ACCOMPANYING PLAT, WHICH PLAT IS DRAWN TO A FIXED SCALES AS INDICATED THEREON AND ACCURATELY SETS FORTH THE BOUNDARIES AND DIMENSIONS OF SAID TRACT AND LOCATIONS OF SAID EASEMENTS, AND WHICH TRACT SO PLATTED SHALL BE KNOWN AS STERLING RANCH FILING NO. 2, EL PASO COUNTY, COLORADO.

ALL STREETS HEREBY PLATTED ARE HEREBY DEDICATED TO PUBLIC USE AND SAID OWNER DOES HEREBY PERSONALLY COVENANT AND AGREE THAT ALL PLATTED STREETS WILL BE CONSTRUCTED TO EL PASO COUNTY STANDARDS, AND THAT PROPER DRAINAGE FOR SAME WILL BE PROVIDED AT HIS OWN EXPENSE, ALL TO THE SATISFACTION OF THE BOARD OF COUNTY COMMISSIONERS OF EL PASO COUNTY, COLORADO, AND UPON ACCEPTANCE BY RESOLUTION, ALL STREETS SO DEDICATED WILL BECOME MATTERS OF MAINTENANCE BY EL PASO COUNTY, COLORADO.

THE AFOREMENTIONED, SR LAND, LLC HAS EXECUTED THIS INSTRUMENT THIS _____ DAY OF _____, 2020, A.D.

BY: _____

PRINTED NAME: _____

AS: _____ OF SR LAND, LLC

STATE OF COLORADO)
) SS
COUNTY OF EL PASO)

THE FORGOING INSTRUMENT WAS ACKNOWLEDGED BEFORE ME THIS _____ DAY OF _____, 2020, A.D. BY: _____

AS: _____ OF SR LAND, LLC

WITNESS MY HAND AND OFFICIAL SEAL:

MY COMMISSION EXPIRES: _____ NOTARY PUBLIC

EASEMENTS:


ALL EASEMENTS THAT ARE DEDICATED HEREON FOR PUBLIC UTILITY PURPOSES RELATED TO GAS AND ELECTRIC SHALL BE SUBJECT TO THOSE TERMS AND CONDITIONS AS SPECIFIED IN THE INSTRUMENT RECORDED AT RECEPTION NUMBER 212112548 OF THE RECORDS OF EL PASO COUNTY, COLORADO. ALL OTHER EASEMENTS OR INTERESTS OF RECORD AFFECTING ANY OF THE PLATTED PROPERTY DEPICTED HEREON SHALL NOT BE AFFECTED AND SHALL REMAIN IN FULL FORCE AND EFFECT.

FEES:

DRAINAGE FEE: _____
BRIDGE FEE: _____
SCHOOL FEE: _____
PARK FEE: _____

SUMMARY:


49 LOTS	8.3337 ACRES	16.82%
9 TRACTS	6.8264 ACRES	13.78%
FUTURE DEV. TRACT	19.6541 ACRES	39.68%
RIGHTS-OF-WAY	14.7245 ACRES	29.72%
TOTAL	49.5387 ACRES	100.00%

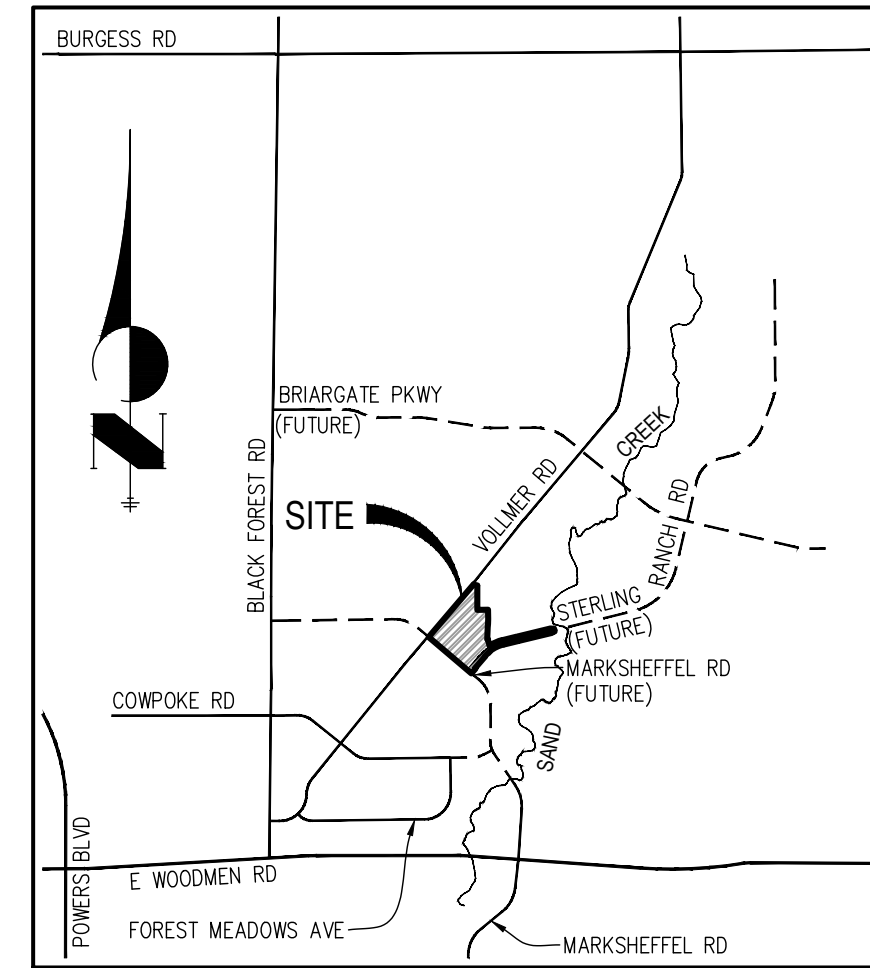

VICINITY MAP
N.T.S.

SURVEYOR'S CERTIFICATE:

THE UNDERSIGNED REGISTERED PROFESSIONAL LAND SURVEYOR LICENSED IN THE STATE OF COLORADO, HEREBY STATES AND DECLARES THAT THE ACCOMPANYING PLAT WAS SURVEYED AND DRAWN UNDER HIS RESPONSIBLE CHARGE AND ACCURATELY SHOWS THE DESCRIBED TRACT OF LAND, AND SUBDIVISION THEREOF, AND THAT THE REQUIREMENTS OF TITLE 38 OF THE COLORADO REVISED STATUTES, 1973, AS AMENDED, HAVE BEEN MET TO THE BEST OF HIS KNOWLEDGE AND BELIEF.

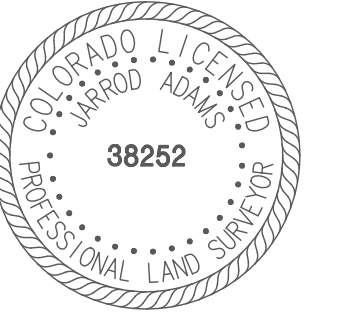

JARROD ADAMS, PROFESSIONAL LAND SURVEYOR
COLORADO NO. 38252
FOR AND ON BEHALF OF JR ENGINEERING, LLC

NOTICE:

ACCORDING TO COLORADO LAW, YOU MUST COMMENCE ANY LEGAL ACTION BASED UPON ANY DEFECT IN THIS SURVEY WITHIN THREE YEARS AFTER YOU FIRST DISCOVER SUCH DEFECT. IN NO EVENT, MAY ANY ACTION BASED UPON ANY DEFECT IN THIS SURVEY BE COMMENCED MORE THAN TEN YEARS FROM THE DATE OF THE CERTIFICATION SHOWN HEREON.

PCD DIRECTOR CERTIFICATE:

THIS PLAT FOR "STERLING RANCH FILING NO. 2" WAS APPROVED FOR FILING BY THE EL PASO COUNTY PLANNING AND COMMUNITY DEVELOPMENT DEPARTMENT DIRECTOR ON THIS _____ DAY OF _____, 2020, SUBJECT TO ANY NOTES OR CONDITIONS SPECIFIED HEREON.

DIRECTOR, PLANNING AND COMMUNITY DEVELOPMENT DEPARTMENT

BOARD OF COUNTY COMMISSIONERS CERTIFICATE:

THIS PLAT FOR "STERLING RANCH FILING NO. 2" WAS APPROVED FOR FILING BY THE EL PASO COUNTY, COLORADO BOARD OF COUNTY COMMISSIONERS ON THIS _____ DAY OF _____, 2020. SUBJECT TO ANY NOTES SPECIFIED HEREON AND ANY CONDITIONS INCLUDED IN THE RESOLUTION OF APPROVAL. THE DEDICATIONS OF LAND TO THE PUBLIC (STREETS AND EASEMENTS) ARE ACCEPTED, BUT PUBLIC IMPROVEMENTS THEREON WILL NOT BECOME MAINTENANCE RESPONSIBILITY OF EL PASO COUNTY UNTIL PRELIMINARY ACCEPTANCE OF THE PUBLIC IMPROVEMENTS IN ACCORDANCE WITH THE REQUIREMENTS OF THE LAND DEVELOPMENT CODE AND ENGINEERING CRITERIA MANUAL AND THE SUBDIVISION IMPROVEMENTS AGREEMENT.

PRESIDENT, BOARD OF COUNTY COMMISSIONERS

CLERK AND RECORDER

STATE OF COLORADO)
) SS
COUNTY OF EL PASO)

I HEREBY CERTIFY THAT THIS INSTRUMENT WAS FILED FOR RECORD IN MY OFFICE

AT _____ O'CLOCK _____ M., THIS _____ DAY OF _____, 20____ A.D.

AND IS DULY RECORDED AT RECEPTION NO. _____ OF THE RECORDS OF EL PASO COUNTY, COLORADO.

CHUCK BROERMAN, RECORDER

BY: _____
DEPUTY

FINAL PLAT
STERLING RANCH FILING NO. 2
JOB NO. 25188.01
01/21/2021
SHEET 1 OF 7



Centennial 303-740-9393 • Colorado Springs 719-593-2593
Fort Collins 970-491-9888 • www.jrengineering.com

FILE NO. SF-20-015

STERLING RANCH FILING NO. 2

**A PORTION OF THE E1/2 OF THE SE1/4 OF SECTION 32 AND THE S1/2 OF THE SW1/4 OF SECTION 33,
TOWNSHIP 12 SOUTH, RANGE 65 WEST, AND THE NW1/4 OF THE NW1/4 OF SECTION 4
AND THE NE1/4 OF THE NE1/4 OF SECTION 5, TOWNSHIP 13 SOUTH, RANGE 65 WEST,
BOTH OF THE 6TH PRINCIPAL MERIDIAN, EL PASO COUNTY, STATE OF COLORADO.**

PLAT NOTES:

1. BASIS OF BEARINGS: BEARINGS ARE BASED ON THE SOUTH LINE OF THE SOUTHWEST QUARTER OF SECTION 34, TOWNSHIP 12 SOUTH, RANGE 65 WEST OF THE 6TH P.M. AS MONUMENTED AT THE SOUTHWEST CORNER OF SAID SOUTHWEST QUARTER BY A 2-1/2" ALUMINUM CAP STAMPED "LS 11624" AND AT THE SOUTHEAST CORNER OF SAID SOUTHWEST QUARTER BY A 2-1/2" ALUMINUM CAP STAMPED "LS 11624", SAID LINE BEARS N89°14'14"E, A DISTANCE OF 2,722.56 FEET.
2. WATER SERVICE SHALL BE SUPPLIED BY STERLING RANCH METROPOLITAN DISTRICT NO. 1.
3. SEWER SERVICE SHALL BE SUPPLIED BY STERLING RANCH METROPOLITAN DISTRICT NO. 1.
4. ELECTRIC SERVICES SHALL BE PROVIDED BY MOUNTAIN VIEW ELECTRIC ASSOCIATION.
5. NATURAL GAS SERVICES SHALL BE PROVIDED BY COLORADO SPRINGS UTILITIES.
6. FIRE PROTECTION BY THE BLACK FOREST FIRE PROTECTION DISTRICT.
7. ALL STRUCTURAL FOUNDATIONS SHALL BE LOCATED AND DESIGNED BY A PROFESSIONAL ENGINEER, CURRENTLY LICENSED IN THE STATE OF COLORADO.
8. THE FOLLOWING REPORTS HAVE BEEN SUBMITTED IN ASSOCIATION WITH THE PRELIMINARY PLAN SP 14-15 OR FINAL PLAT FOR THIS SUBDIVISION AND ARE ON FILE AT THE COUNTY PLANNING AND COMMUNITY DEVELOPMENT DEPARTMENT: TRANSPORTATION IMPACT STUDY; DRAINAGE REPORT; WATER RESOURCES REPORT; WASTEWATER DISPOSAL REPORT; NATURAL HAZARDS REPORT; GEOLOGY AND SOILS REPORT; WETLAND STUDY/ 404 PERMIT.
9. ALL PROPERTY OWNERS ARE RESPONSIBLE FOR MAINTAINING PROPER STORM WATER DRAINAGE IN AND THROUGH THEIR PROPERTY. PUBLIC DRAINAGE EASEMENTS AS SPECIFICALLY NOTED ON THE PLAT SHALL BE MAINTAINED BY THE INDIVIDUAL LOT OWNERS UNLESS OTHERWISE INDICATED. STRUCTURES, FENCES, MATERIALS OR LANDSCAPING THAT COULD IMPED THE FLOW OF RUNOFF SHALL NOT BE PLACED IN DRAINAGE EASEMENTS.
10. UNLESS OTHERWISE INDICATED, ALL SIDE LOT LINES ARE HEREBY PLATTED ON EITHER SIDE WITH A 5 FOOT PUBLIC UTILITY AND DRAINAGE EASEMENT, EXCEPT WHEN THE SIDE YARD IS ADJACENT TO A PUBLIC STREET AND THEREFORE A 10 FOOT PUBLIC IMPROVEMENT, PUBLIC UTILITY AND DRAINAGE EASEMENT. ALL FRONT LOT LINES ARE HEREBY PLATTED WITH A 10 FOOT PUBLIC IMPROVEMENT, PUBLIC UTILITY AND DRAINAGE EASEMENT, AND ALL REAR LOT LINES ARE HEREBY PLATTED WITH A 10 FOOT PUBLIC UTILITY AND DRAINAGE EASEMENT. ALL EXTERIOR SUBDIVISION BOUNDARIES ARE HEREBY PLATTED WITH A 7 FOOT PUBLIC UTILITY AND DRAINAGE EASEMENT. THE SOLE RESPONSIBILITY FOR THE SURFACE MAINTENANCE OF EASEMENTS IS HEREBY VESTED WITH THE INDIVIDUAL PROPERTY OWNERS.
11. DEVELOPER SHALL COMPLY WITH FEDERAL AND STATE LAWS, REGULATIONS, ORDINANCES, REVIEW AND PERMIT REQUIREMENTS, AND OTHER AGENCY REQUIREMENTS, IF ANY, OF APPLICABLE AGENCIES INCLUDING, BUT NOT LIMITED TO, THE COLORADO PARKS AND WILDLIFE, COLORADO DEPARTMENT OF TRANSPORTATION, U.S. ARMY CORP OF ENGINEERS AND THE U.S. FISH AND WILDLIFE SERVICE REGARDING THE ENDANGERED SPECIES ACT, PARTICULARLY AS IT RELATES TO THE LISTED SPECIES.
12. THE ADDRESS EXHIBITED ON THIS PLAT ARE FOR INFORMATIONAL PURPOSES ONLY. THEY ARE NOT THE LEGAL DESCRIPTION AND ARE SUBJECT TO CHANGE.
13. NO DRIVEWAY SHALL BE ESTABLISHED UNLESS AN ACCESS PERMIT HAS BEEN GRANTED BY EL PASO COUNTY.
14. NO LOT OR INTEREST THEREIN, SHALL BE SOLD, CONVEYED, OR TRANSFERRED WHETHER BY DEED OR BY CONTRACT, NOR SHALL BUILDING PERMITS BE ISSUED, UNTIL AND UNLESS EITHER THE REQUIRED PUBLIC AND COMMON DEVELOPMENT IMPROVEMENTS HAVE BEEN CONSTRUCTED AND COMPLETED AND PRELIMINARILY ACCEPTED IN ACCORDANCE WITH THE SUBDIVISION IMPROVEMENTS AGREEMENT BETWEEN THE APPLICANT/ OWNER AND EL PASO COUNTY AS RECORDED UNDER RECEPTION NUMBER 218145998 IN THE OFFICE OF THE CLERK AND RECORDER OF EL PASO COUNTY, COLORADO OR, IN THE ALTERNATIVE, OTHER COLLATERAL IS PROVIDED TO MAKE PROVISION FOR THE COMPLETION OF SAID IMPROVEMENTS IN ACCORDANCE WITH THE EL PASO COUNTY LAND DEVELOPMENT CODE AND ENGINEERING CRITERIA MANUAL. ANY SUCH ALTERNATIVE COLLATERAL MUST BE APPROVED BY THE BOARD OF COUNTY COMMISSIONERS OR, IF PERMITTED BY THE SUBDIVISION IMPROVEMENTS AGREEMENT, BY THE DEVELOPMENT SERVICES DEPARTMENT DIRECTOR AND MEET THE POLICY AND PROCEDURE REQUIREMENTS OF EL PASO COUNTY PRIOR TO THE RELEASE BY THE COUNTY OF ANY LOTS FOR SALE, CONVEYANCE OR TRANSFER.

THIS PLAT RESTRICTION MAY BE REMOVED OR RESCINDED BY THE BOARD OF COUNTY COMMISSIONERS OR, IF PERMITTED BY THE SUBDIVISION IMPROVEMENTS AGREEMENT, BY THE DEVELOPMENT SERVICES DEPARTMENT DIRECTOR UPON EITHER APPROVAL OF AN ALTERNATIVE FORM OF COLLATERAL OR COMPLETION AND PRELIMINARY ACCEPTANCE BY THE EL PASO BOARD OF COUNTY COMMISSIONERS OF ALL IMPROVEMENTS REQUIRED TO BE CONSTRUCTED AND COMPLETED IN ACCORDANCE WITH SAID SUBDIVISION IMPROVEMENTS AGREEMENT. THE PARTIAL RELEASE OF LOTS FOR SALE, CONVEYANCE OR TRANSFER MAY ONLY BE GRANTED IN ACCORDANCE WITH ANY PLANNED PARTIAL RELEASE OF LOTS AUTHORIZED BY THE SUBDIVISION IMPROVEMENTS AGREEMENT.

PLAT NOTES:

15. NO STRUCTURES OR FENCES ARE PERMITTED WITHIN DESIGNATED "FLOODPLAIN" AREAS. (MODIFICATION OF THIS NOTE MAY BE ALLOWED IF THE PLAN APPROVED BY THE FLOODPLAIN ADMINISTRATOR, PROVIDED THIS CREATES NO CONFLICT WITH APPROVED PLANS OR CONDITIONS.)
16. NO PORTION OF THIS SITE IS LOCATED WITHIN A DESIGNATED FEMA FLOODPLAIN AS DETERMINED BY THE FLOOD INSURANCE RATE MAP, COMMUNITY MAP NUMBER 08041C0529G, EFFECTIVE DATE DECEMBER 7, 2018.
17. NOTICE: THIS PROPERTY MAY BE ADVERSELY IMPACTED BY NOISE, DUST, FUMES, AND LIGHT POLLUTION CAUSED BY ADJACENT INDUSTRIAL PROPERTIES AND ACTIVITIES. THE BUYERS SHOULD RESEARCH AND BE AWARE OF THIS POTENTIALITY AND THE RAMIFICATIONS THEREOF.
18. ANY PERSON WHO KNOWINGLY REMOVES, ALTERS OR DEFACES ANY PUBLIC LAND SURVEY MONUMENT OR LAND BOUNDARY MONUMENT OR ACCESSORY, COMMMITS A CLASS TWO (2) MISDEMEANOR PURSUANT TO CRS 18-4-508.
19. NO REPLAT OR RESUBDIVISION OF TRACT E SHALL BE RECORDED UNTIL AND UNLESS THE IMPROVEMENTS DESCRIBED IN EXHIBIT A TO THE SUBDIVISION IMPROVEMENTS AGREEMENT FOR STERLING RANCH FILING NO. 2 HAVE BEEN COMPLETED BY THE SUBDIVIDER AND DISTRICT AND APPROVED BY THE COUNTY AND THE DISTRICT FOR PRELIMINARY ACCEPTANCE PURSUANT TO THE COUNTY'S ENGINEERING CRITERIA MANUAL.
20. ALL PROPERTY WITHIN THIS SUBDIVISION IS INCLUDED IN STERLING RANCH METROPOLITAN DISTRICT NO. 1.
21. THE STERLING RANCH METROPOLITAN DISTRICT NO. 1 WILL BE RESPONSIBLE FOR MAINTENANCE OF THE ROADS AND DRAINAGE FACILITIES UNTIL PRELIMINARY ACCEPTANCE OF THE PUBLIC IMPROVEMENTS IN ACCORDANCE WITH THE REQUIREMENTS OF THE LAND DEVELOPMENT CODE, THE ENGINEERING CRITERIA MANUAL, AND THE SUBDIVISION IMPROVEMENTS AGREEMENT.
22. ALL PROPERTY WITHIN THIS SUBDIVISION IS SUBJECT TO A DECLARATION OF COVENANT AS RECORDED AT RECEPTION NUMBER _____ OF THE RECORDS OF THE EL PASO COUNTY CLERK AND RECORDER.
23. SPECIAL DISTRICT DISCLOSURE: A TITLE 32 SPECIAL DISTRICT ANNUAL REPORT AND DISCLOSURE FORM SATISFACTORY TO THE DEVELOPMENT SERVICES DEPARTMENT SHALL BE RECORDED WITH EACH PLAT.
24. MAILBOXES SHALL BE INSTALLED IN ACCORDANCE WITH ALL EL PASO COUNTY AND UNITED STATES POSTAL SERVICE REGULATION.
25. THE SUBDIVIDER(S) AGREES ON BEHALF OF HIM/HERSELF AND ANY DEVELOPER OR BUILDER SUCCESSORS AND ASSIGNEES THAT SUBDIVIDER AND/OR SAID SUCCESSORS AND ASSIGNS SHALL BE REQUIRED TO PAY TRAFFIC IMPACT FEES IN ACCORDANCE WITH THE EL PASO COUNTY ROAD IMPACT FEE PROGRAM RESOLUTION (RESOLUTION NO. 19-471), OR ANY AMENDMENTS THERETO, AT OR PRIOR TO THE TIME OF BUILDING PERMIT SUBMITTALS. THE FEE OBLIGATION, IF NOT PAID AT FINAL PLAT RECORDING, SHALL BE DOCUMENTED ON ALL SALES DOCUMENTS AND ON PLAT NOTES TO ENSURE THAT A TITLE SEARCH WOULD FIND THE FEE OBLIGATION BEFORE SALE OF THE PROPERTY. TRANSPORTATION IMPACT FEES ARE TO BE PAID AT BUILDING PERMIT. THE SUBDIVIDER AGREES TO THE INCLUSION OF THE STERLING RANCH FILING NO. 2 INTO THE EL PASO COUNTY PUBLIC IMPROVEMENT DISTRICT NO. 2 AS RECORDED AT RECEPTION NO. _____
26. THE FOLLOWING LOTS AND TRACTS HAVE BEEN FOUND TO BE IMPACTED BY GEOLOGIC HAZARDS. MITIGATION MEASURES AND A MAP OF THE HAZARD AREA CAN BE FOUND IN THE GEOLOGIC HAZARD REPORT BY ENTECH DATED FEBRUARY 10, 2020, IN SF-20-15 AVAILABLE AT THE EL PASO PLANNING AND COMMUNITY DEVELOPMENT DEPARTMENT. THE FOLLOWING LOTS AND TRACTS ARE IMPACTED:
SHALLOW GROUNDWATER: TRACTS B, I AND J
POTENTIAL SEASONAL SHALLOW GROUNDWATER: LOTS 15-49 TRACTS B, C, D, E, F, H, I, J
HYDROCOMPACTIVE SOILS: LOTS 1-7, 9-32, 35-42 TRACTS B, C, D, E, F, H, I
IN AREAS OF HIGH GROUNDWATER, ALL FOUNDATIONS SHALL INCORPORATE AN UNDERGROUND DRAINAGE SYSTEM.
27. THERE SHALL BE NO DIRECT RESIDENTIAL LOT ACCESS TO DINES BOULEVARD, VOLLMER ROAD, MARKSHEFFEL ROAD, OR STERLING RANCH ROAD.

CGS states that there is shallow ground water not potential and that there is a likelihood that underdrains will not suffice...Are you prrpsng to limit basements to address CGS concerns or provide more details to the geology report...

TRACT TABLE				
TRACT	SIZE (ACRES)	USE	MAINTENANCE	OWNERSHIP
A	0.3912	LANDSCAPE/PUBLIC IMPROVEMENTS/PUBLIC TRAILS/ PUBLIC UTILITY	SRMD#1	SRMD#1
B	0.5848	LANDSCAPE/PUBLIC IMPROVEMENTS/PUBLIC TRAILS/ PUBLIC UTILITY	SRMD#1	SRMD#1
C	0.8453	LANDSCAPE/PUBLIC IMPROVEMENTS/PUBLIC TRAILS/ PUBLIC UTILITY	SRMD#1	SRMD#1
D	2.1953	LANDSCAPE/PUBLIC IMPROVEMENTS/PUBLIC TRAILS/ PUBLIC UTILITY	SRMD#1	SRMD#1
E	19.6514	FUTURE SINGLE FAMILY LOTS	SR LAND, LLC	SR LAND, LLC
F	1.4822	LANDSCAPE/PUBLIC IMPROVEMENTS/PUBLIC TRAILS/ PUBLIC UTILITY	SRMD#1	SRMD#1
G	0.3866	LANDSCAPE/PUBLIC IMPROVEMENTS/PUBLIC TRAILS/ PUBLIC UTILITY	SRMD#1	SRMD#1
H	0.0625	LANDSCAPE/PUBLIC IMPROVEMENTS/PUBLIC TRAILS/ PUBLIC UTILITY	SRMD#1	SRMD#1
I	0.4998	LANDSCAPE/PUBLIC IMPROVEMENTS/PUBLIC TRAILS/ PUBLIC UTILITY/MAIL KIOSK	SRMD#1	SRMD#1
J	0.3787	LANDSCAPE/PUBLIC IMPROVEMENTS/PUBLIC TRAILS/ PUBLIC UTILITY	SRMD#1	SRMD#1
TOTAL	26.4778			



FINAL PLAT
STERLING RANCH FILING NO. 2
JOB NO. 25188.01
01/21/2021
SHEET 2 OF 7




FILE NO. SF-20-015

Centennial 303-740-9393 • Colorado Springs 719-593-2593
Fort Collins 970-491-9888 • www.jrengineering.com


STERLING RANCH FILING NO. 2

A PORTION OF THE E1/2 OF THE SE1/4 OF SECTION 32 AND THE S1/2 OF THE SW1/4 OF SECTION 33,
TOWNSHIP 12 SOUTH, RANGE 65 WEST, AND THE NW1/4 OF THE NW1/4 OF SECTION 4
AND THE NE1/4 OF THE NE1/4 OF SECTION 5, TOWNSHIP 13 SOUTH, RANGE 65 WEST,
BOTH OF THE 6TH PRINCIPAL MERIDIAN, EL PASO COUNTY, STATE OF COLORADO.

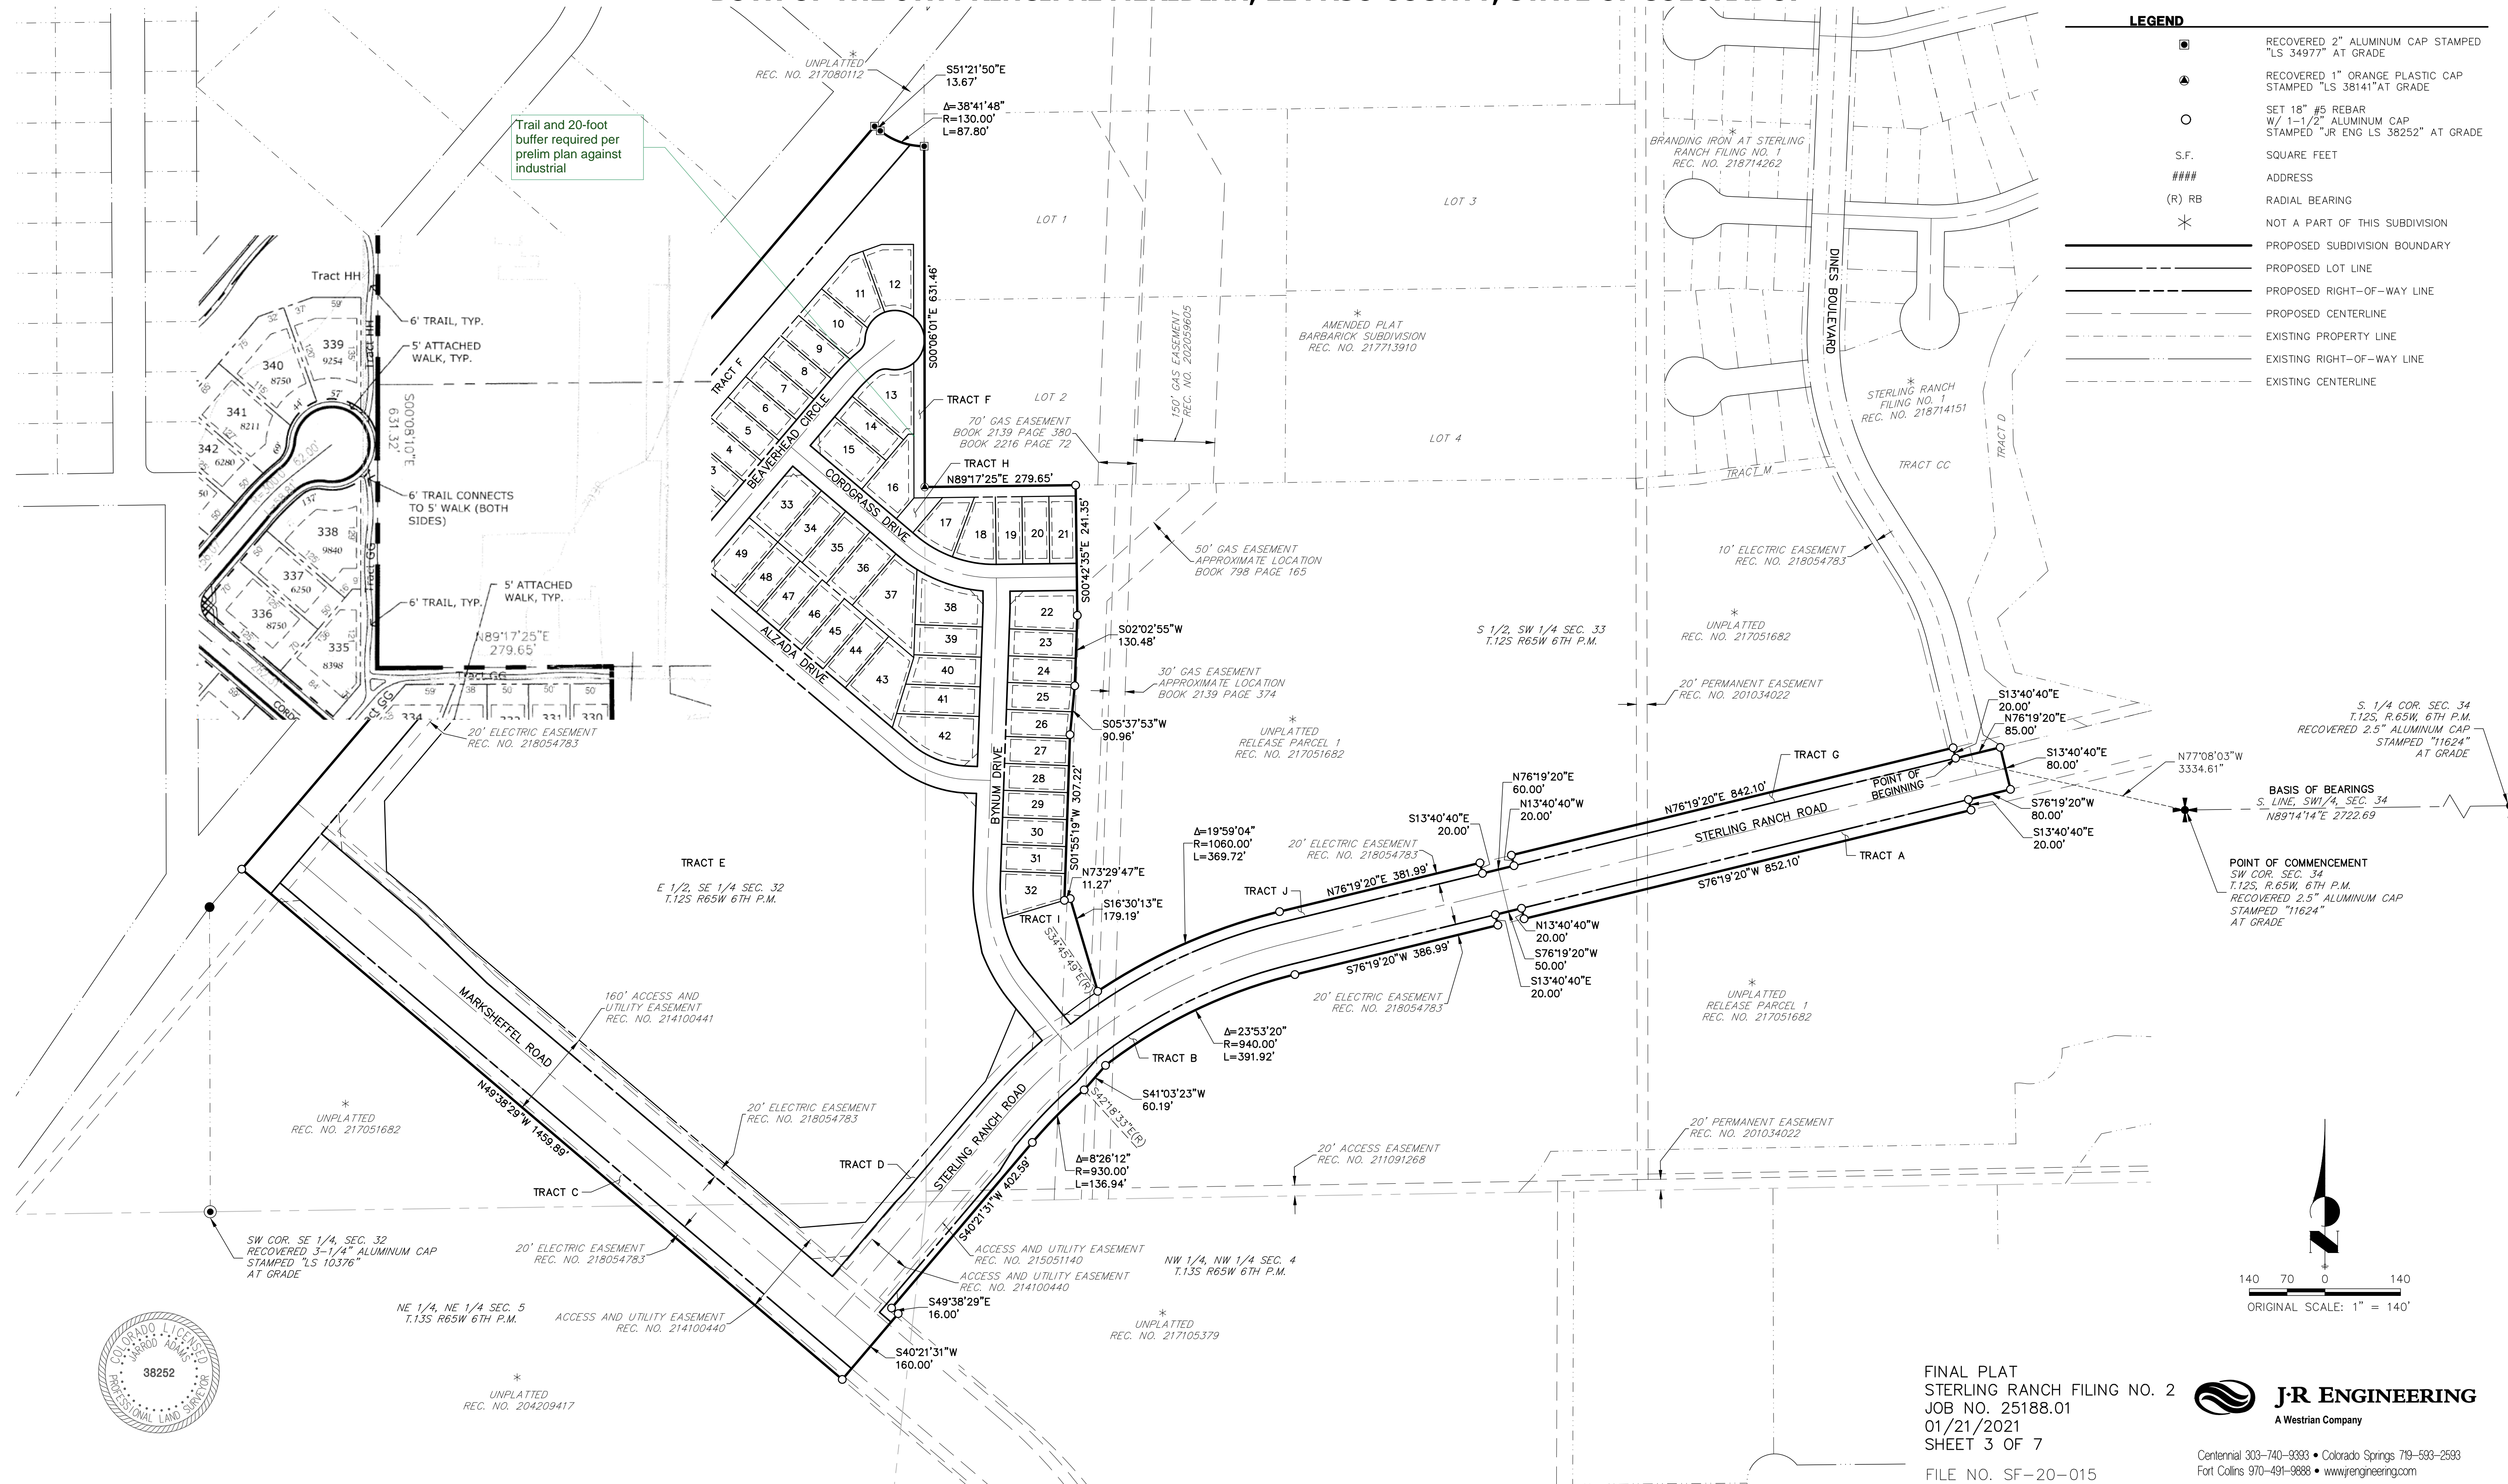

Trail and 20-foot
buffer required per
prelim plan against
industrial

LEGEND	
	RECOVERED 2" ALUMINUM CAP STAMPED "LS 34977" AT GRADE
	RECOVERED 1" ORANGE PLASTIC CAP STAMPED "LS 38141" AT GRADE
	SET 18" #5 REBAR W/ 1-1/2" ALUMINUM CAP STAMPED "JR ENG LS 38252" AT GRADE
S.F.	SQUARE FEET
####	ADDRESS
(R) RB	RADIAL BEARING
*	NOT A PART OF THIS SUBDIVISION
	PROPOSED SUBDIVISION BOUNDARY
	PROPOSED LOT LINE
	PROPOSED RIGHT-OF-WAY LINE
	PROPOSED CENTERLINE
	EXISTING PROPERTY LINE
	EXISTING RIGHT-OF-WAY LINE
	EXISTING CENTERLINE

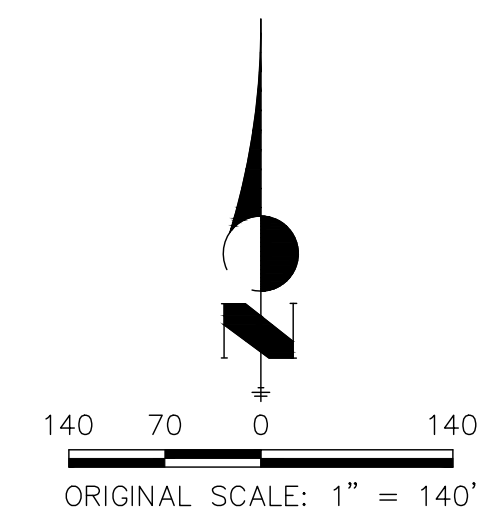


FINAL PLAT
STERLING RANCH FILING NO. 2
JOB NO. 25188.01
01/21/2021
SHEET 3 OF 7
FILE NO. SF-20-015



Centennial 303-740-9393 • Colorado Springs 719-593-2593
Fort Collins 970-491-9888 • www.jrengineering.com

STERLING RANCH FILING NO. 2

A PORTION OF THE E 1/2 OF THE SE 1/4 OF SECTION 32 AND THE S 1/2 OF THE SW 1/4 OF SECTION 33, TOWNSHIP 12 SOUTH, RANGE 65 WEST, AND THE NW 1/4 OF THE NW 1/4 OF SECTION 4 AND THE NE 1/4 OF THE NE 1/4 OF SECTION 5, TOWNSHIP 13 SOUTH, RANGE 65 WEST, BOTH OF THE 6TH PRINCIPAL MERIDIAN, EL PASO COUNTY, STATE OF COLORADO.

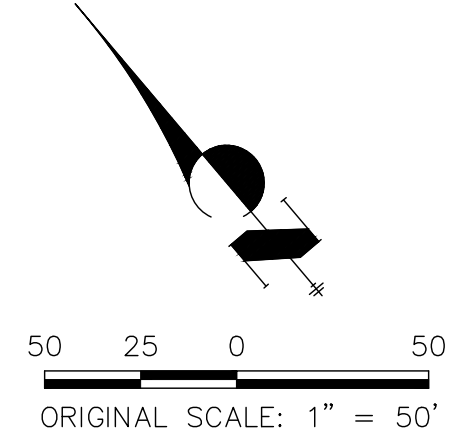


SEE SHEET 5

SEE SHEET 5

LINE	BEARING	DISTANCE
L8	N10°46'35"W	50.25'
L9	N41°03'23"E	60.83'
L10	N02°02'55"E	502.83'
L11	N02°02'55"E	166.44'
L12	N02°02'55"E	502.83'
L17	N02°02'55"E	24.05'

CURVE	DELTA	RADIUS	LENGTH
C9	14°08'26"	325.00'	80.21'
C10	15°41'01"	275.00'	75.28'
C11	18°37'42"	330.00'	107.29'
C12	25°50'31"	225.00'	101.48'
C16	2°20'50"	275.00'	11.27'
C17	13°20'11"	275.00'	64.01'

LINE	BEARING
RB6	N78°42'44"E
RB7	S41°06'50"E
RB8	S37°49'26"E
RB9	S41°17'12"E

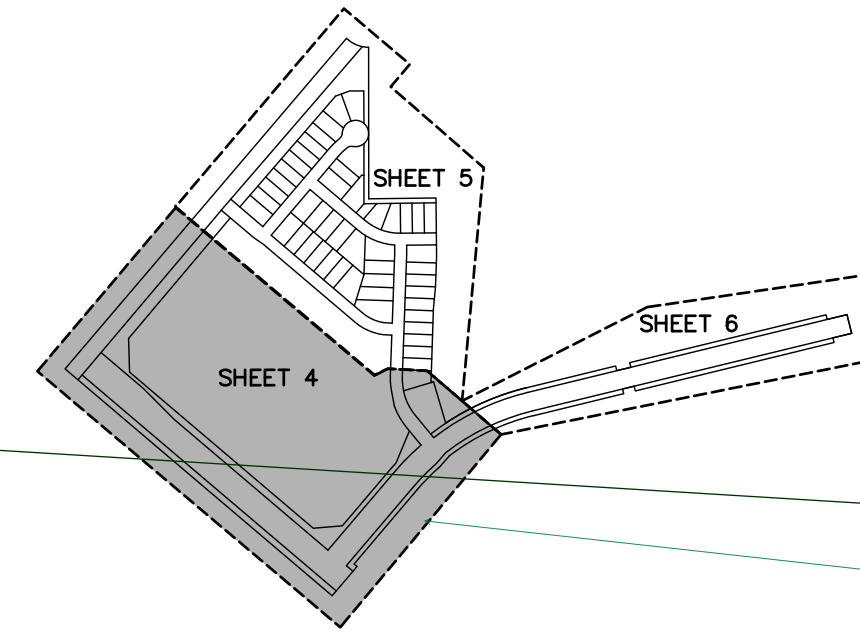


why is all of this detail and repeated legend in the middle of tract you are proposing to create with this plat? That seems really odd and confuses what is actually being platted here....

please do not repeat the details and remove from the tract to be platted

where is the required trail along Marksheffel per Parks? The plat checklist requires these items to be depicted see review 1 comments

? what is this 20 feet referring to what does the dashed line represent

LEGEND	
●	RECOVERED 2" ALUMINUM CAP STAMPED "LS 34977" AT GRADE
▲	RECOVERED 1" ORANGE PLASTIC CAP STAMPED "LS 38141" AT GRADE
○	SET 18" #5 REBAR W/ 1-1/2" ALUMINUM CAP STAMPED "JR ENG LS 38252" AT GRADE
S.F.	SQUARE FEET
####	ADDRESS
(R) RB	RADIAL BEARING
*	NOT A PART OF THIS SUBDIVISION
—	PROPOSED SUBDIVISION BOUNDARY
- - - -	PROPOSED LOT LINE
- - - -	PROPOSED RIGHT-OF-WAY LINE
- - - -	PROPOSED CENTERLINE
- - - -	EXISTING PROPERTY LINE
- - - -	EXISTING RIGHT-OF-WAY LINE
- - - -	EXISTING CENTERLINE

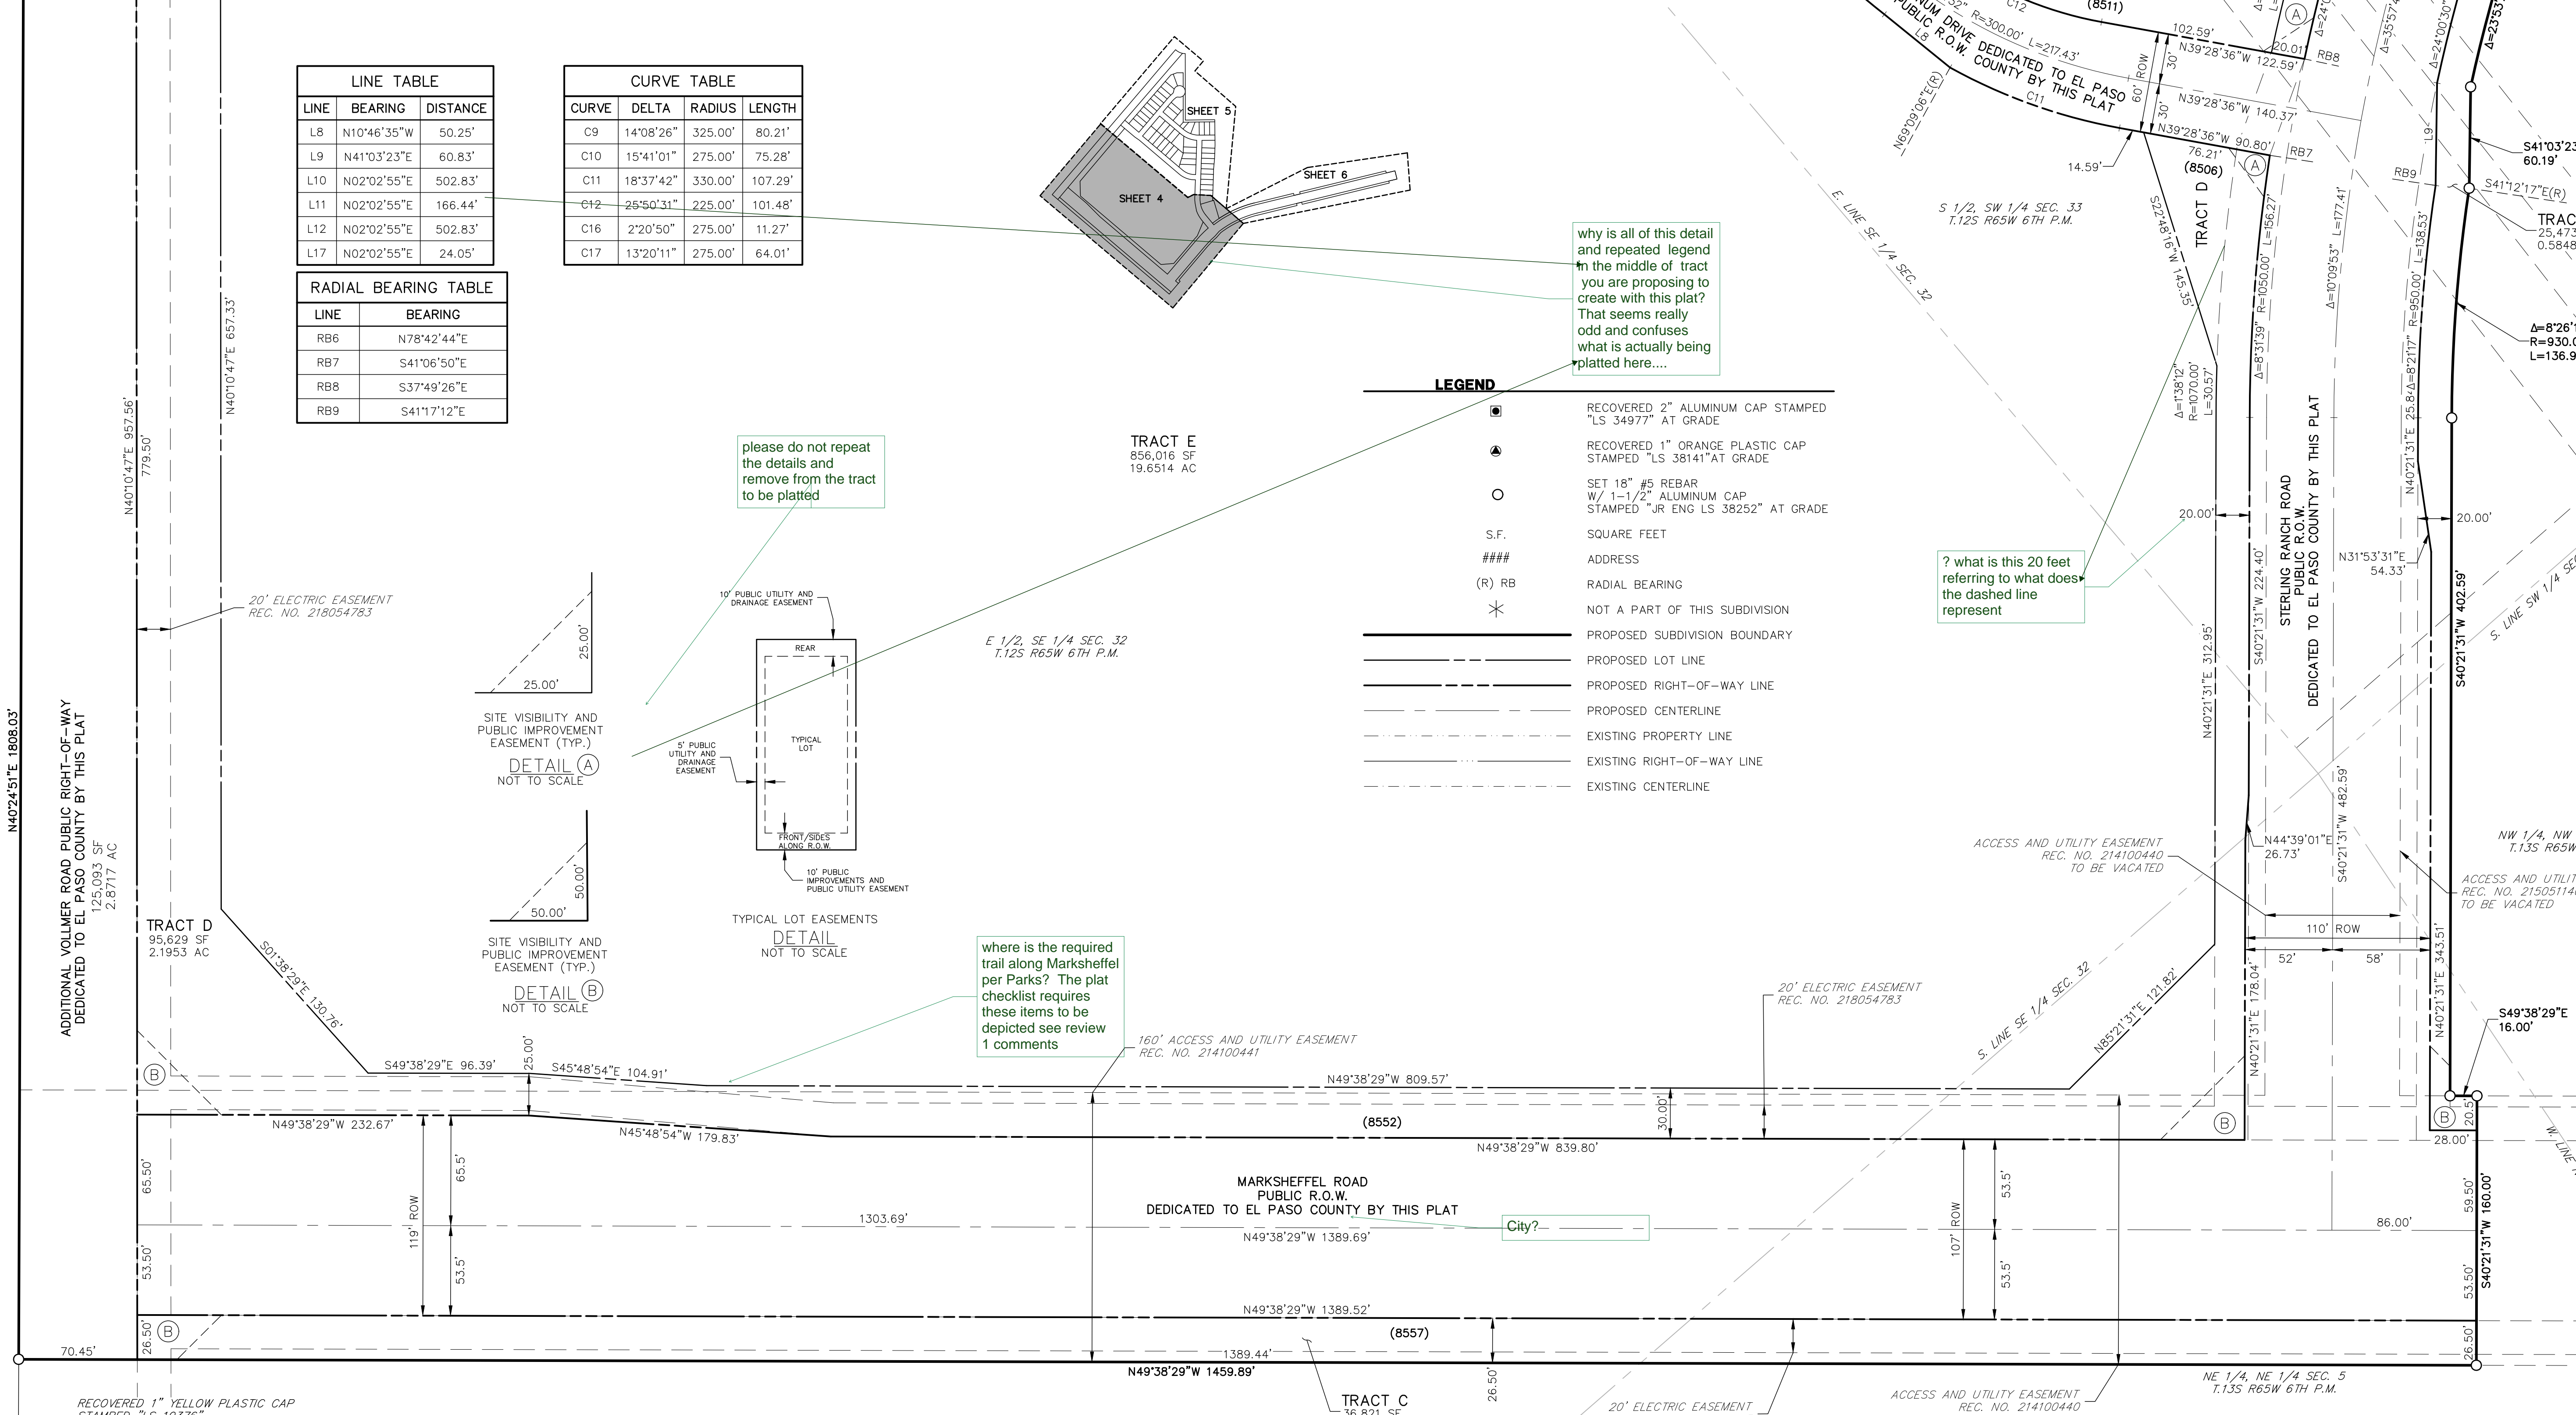

FINAL PLAT
STERLING RANCH FILING NO. 2
JOB NO. 25188.01
01/21/2021
SHEET 4 OF 7
FILE NO. SF-20-015



Centennial 303-740-9393 • Colorado Springs 719-593-2593
Fort Collins 970-491-9888 • www.jrengineering.com

STERLING NO. 2






D THE S1/2 OF THE SW1/4 OF SECTION 33,
W1/4 OF THE NW1/4 OF SECTION 4
NSHIP 13 SOUTH, RANGE 65 WEST,
O COUNTY, STATE OF COLORADO.

LINE TABLE		
LINE	BEARING	DISTANCE
L1	S51°35'24"W	62.00'
L2	N00°33'26"W	41.40'
L3	S87°57'05"E	40.83'
L4	N00°33'26"W	17.48'
L5	N00°33'26"W	16.47'
L6	S87°57'05"E	15.83'
L7	N87°57'05"W	15.83'

CURVE TABLE			
CURVE	DELTA	RADIUS	LENGTH
C1	11°13'53"	300.00'	58.81'
C2	2°36'21"	500.00'	22.74'
C3	10°46'34"	325.00'	61.12'
C4	49°14'04"	30.00'	25.78'
C5	50°19'12"	30.00'	26.35'
C6	10°34'37"	275.00'	50.77'
C7	2°36'21"	475.00'	21.60'
C8	2°36'21"	525.00'	23.88'
C13	6°52'47"	325.00'	39.02'
C14	3°53'46"	325.00'	22.10'
C15	100°29'52"	55.00'	96.47'

RADIAL BEARING TABLE	
LINE	BEARING
RB1	S42°45'42"E
RB2	S65°48'10"E
RB3	S39°39'02"W
RB4	N39°51'05"W
RB5	N31°35'07"E

- LEGEND**
- RECOVERED 2" ALUMINUM CAP STAMPED "LS 34977" AT GRADE
 - ▲ RECOVERED 1" ORANGE PLASTIC CAP STAMPED "LS 38141" AT GRADE
 - SET 18" #5 REBAR W/ 1-1/2" ALUMINUM CAP STAMPED "JR ENG LS 38252" AT GRADE
 - S.F. SQUARE FEET
 - #### ADDRESS
 - (R) RB RADIAL BEARING
 - * NOT A PART OF THIS SUBDIVISION
 - PROPOSED SUBDIVISION BOUNDARY
 - - - PROPOSED LOT LINE
 - - - PROPOSED RIGHT-OF-WAY LINE
 - - - PROPOSED CENTERLINE
 - EXISTING PROPERTY LINE
 - - - EXISTING RIGHT-OF-WAY LINE
 - - - EXISTING CENTERLINE

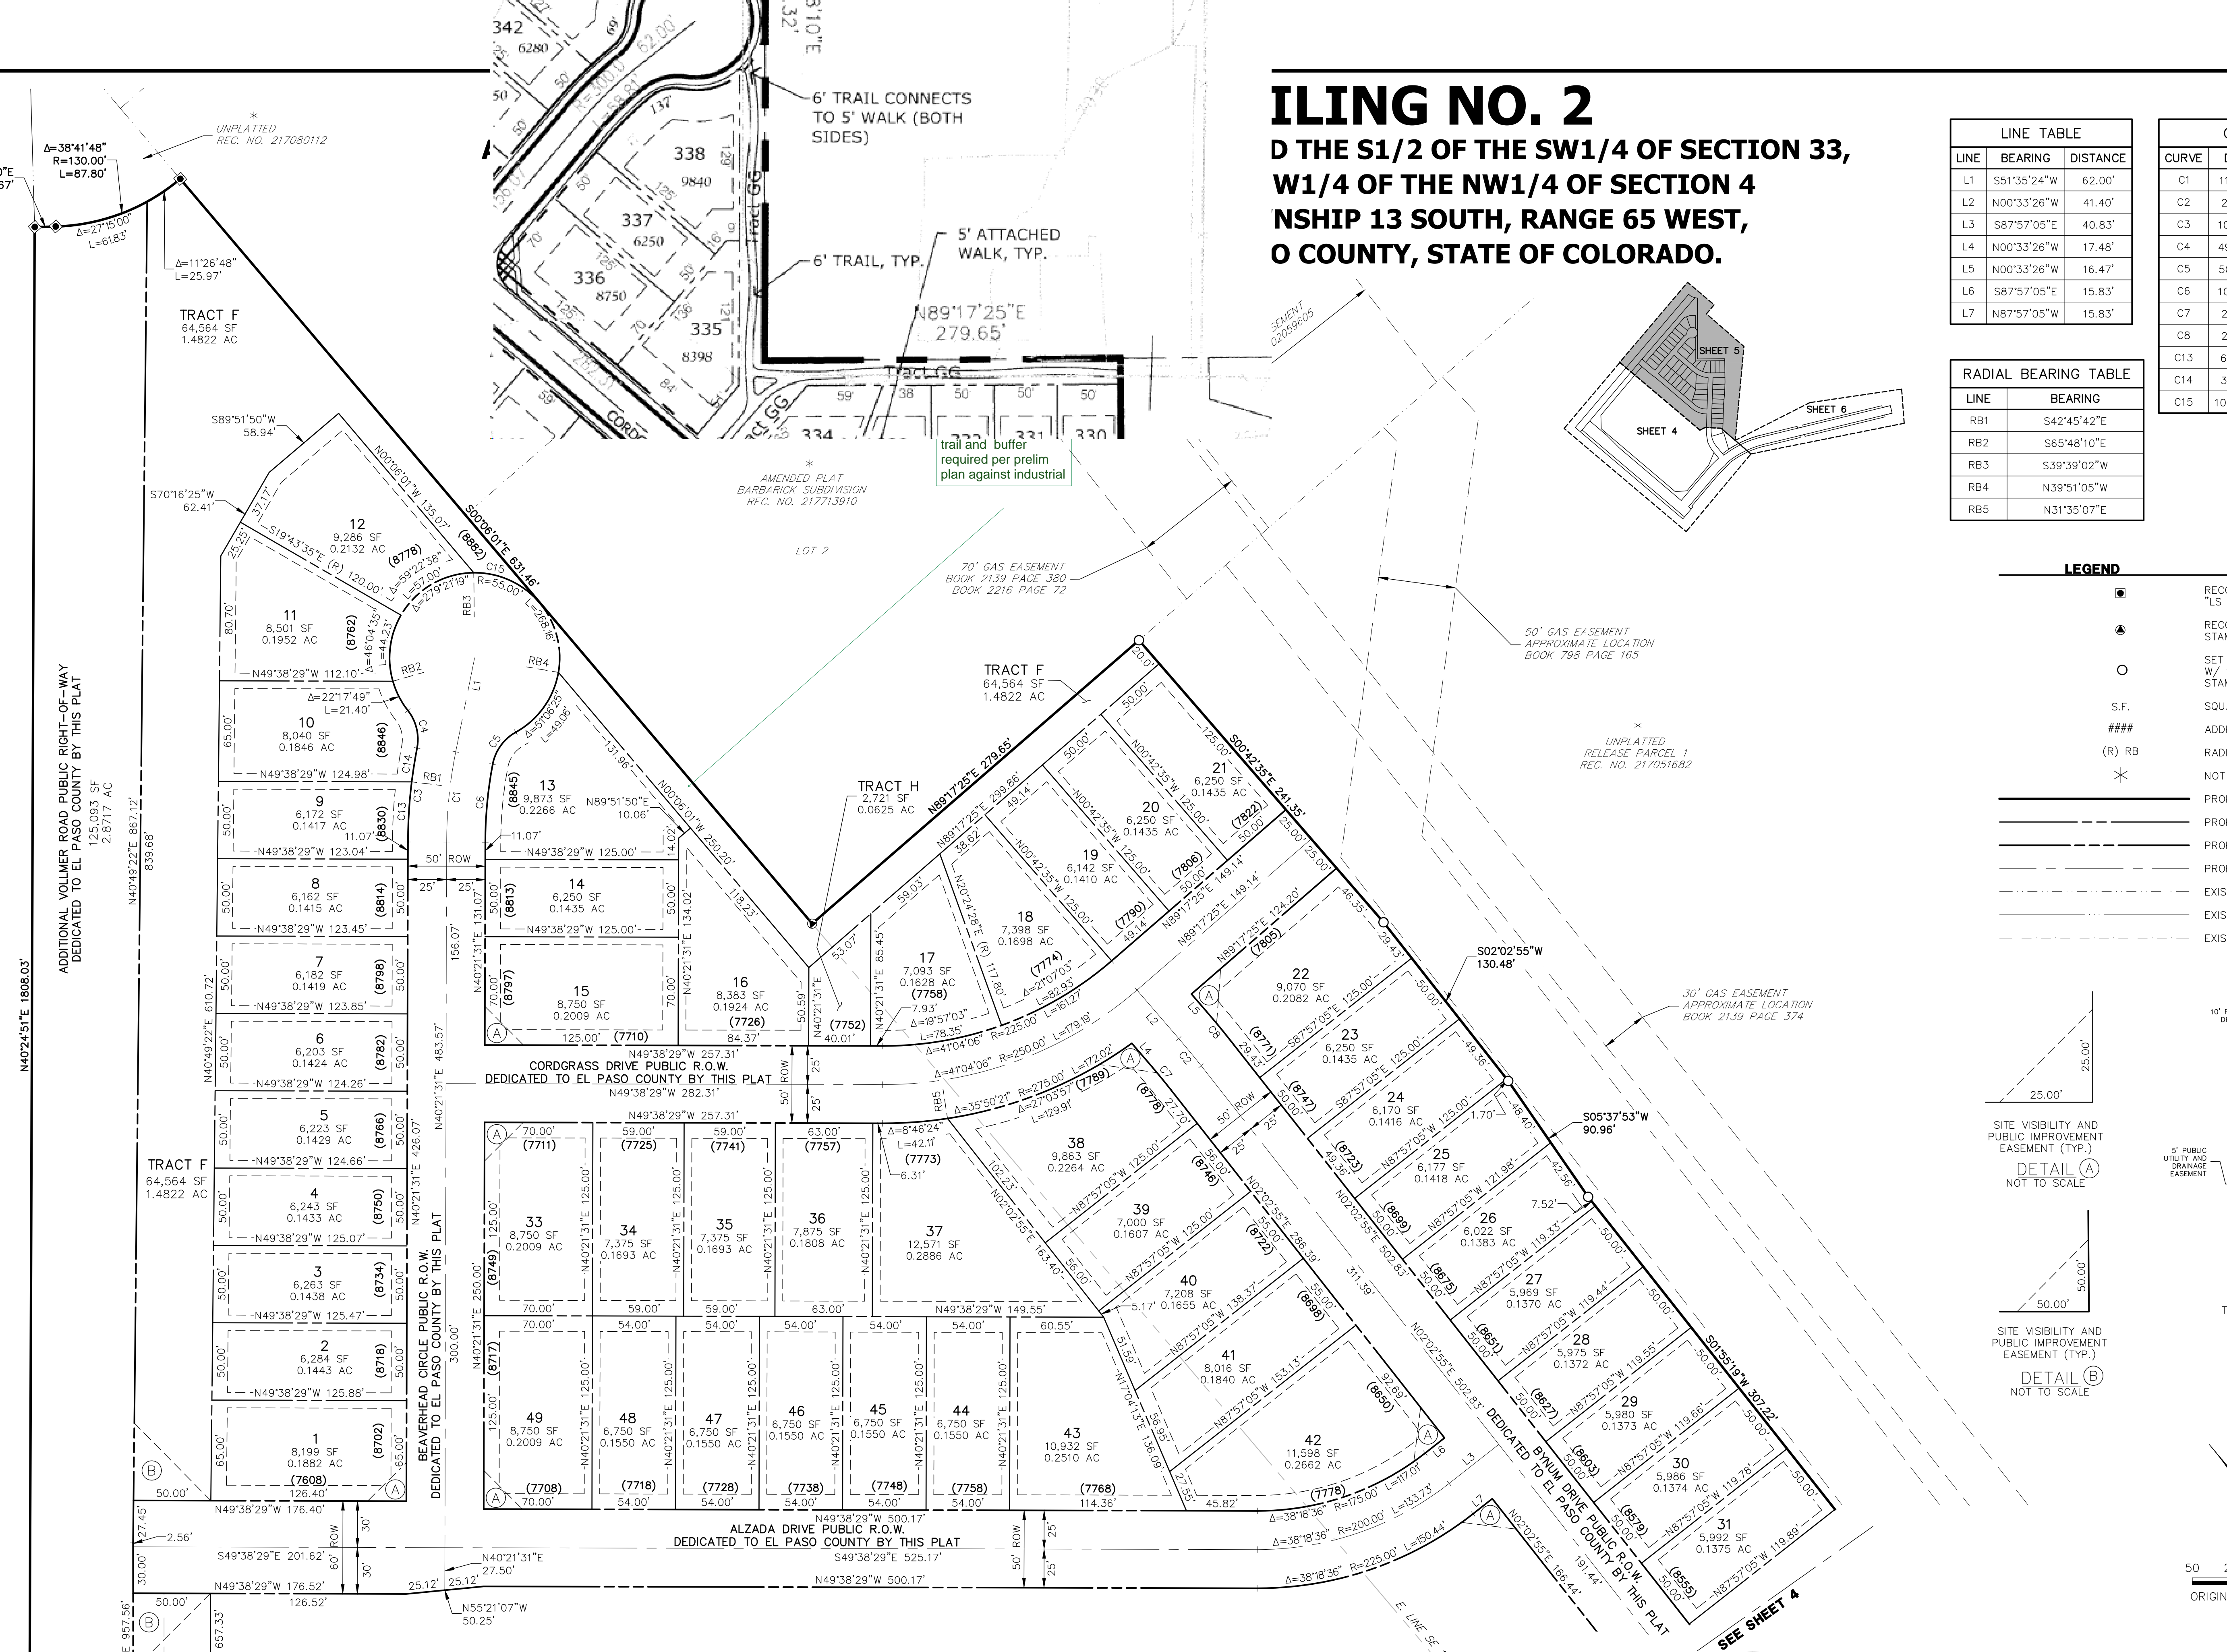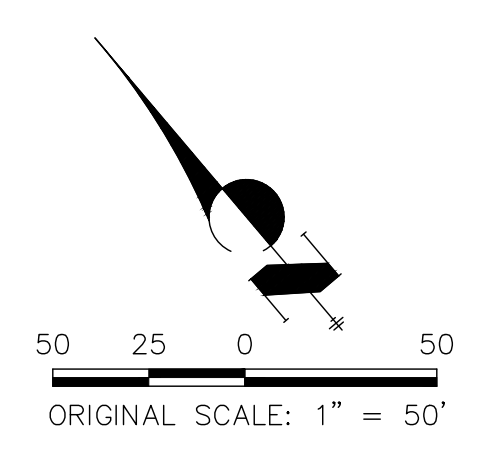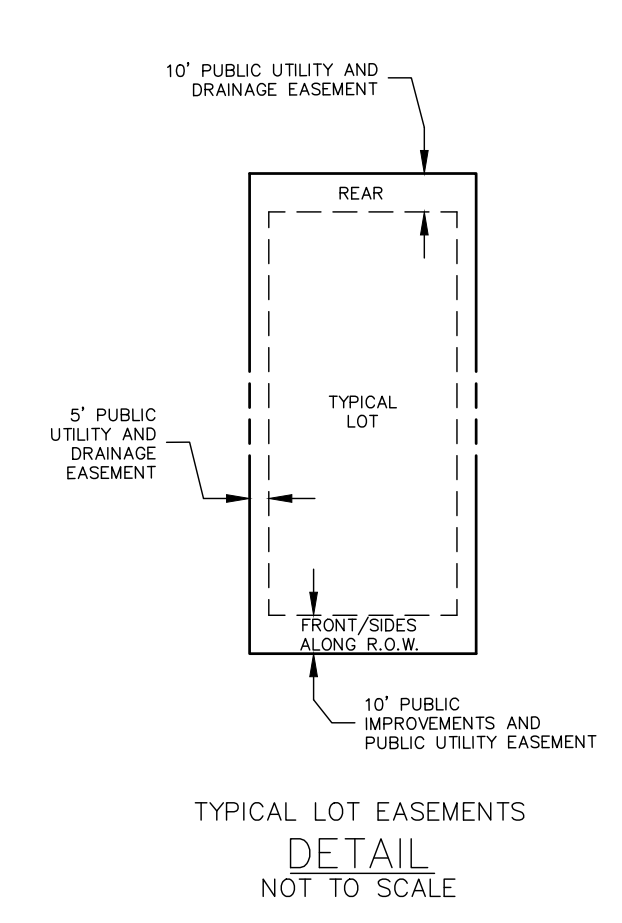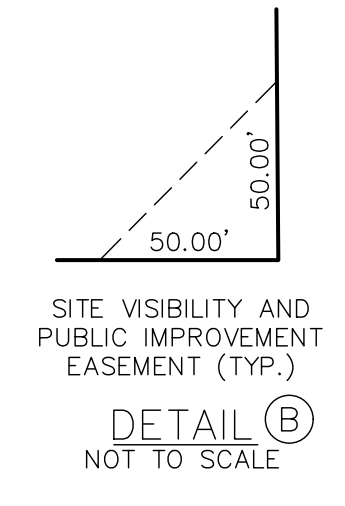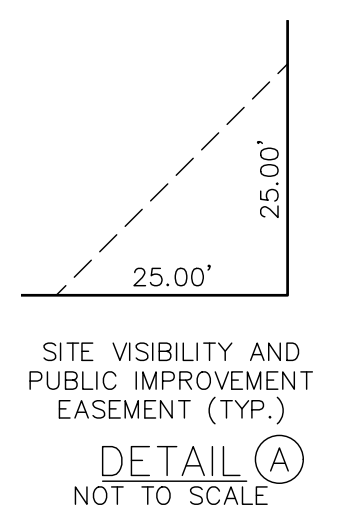

FINAL PLAT
STERLING RANCH FILING NO. 2
JOB NO. 25188.01
01/21/2021
SHEET 5 OF 7
FILE NO. SF-20-015


J-R ENGINEERING
A Westrian Company
Centennial 303-740-9393 • Colorado Springs 719-593-2593
Fort Collins 970-491-9888 • www.jrengineering.com

SEE SHEET 4

SEE SHEET 4

STERLING RANCH FILING NO. 2

A PORTION OF THE E1/2 OF THE SE1/4 OF SECTION 32 AND THE S1/2 OF THE SW1/4 OF SECTION 33,
TOWNSHIP 12 SOUTH, RANGE 65 WEST, AND THE NW1/4 OF THE NW1/4 OF SECTION 4
AND THE NE1/4 OF THE NE1/4 OF SECTION 5, TOWNSHIP 13 SOUTH, RANGE 65 WEST,
BOTH OF THE 6TH PRINCIPAL MERIDIAN, EL PASO COUNTY, STATE OF COLORADO.

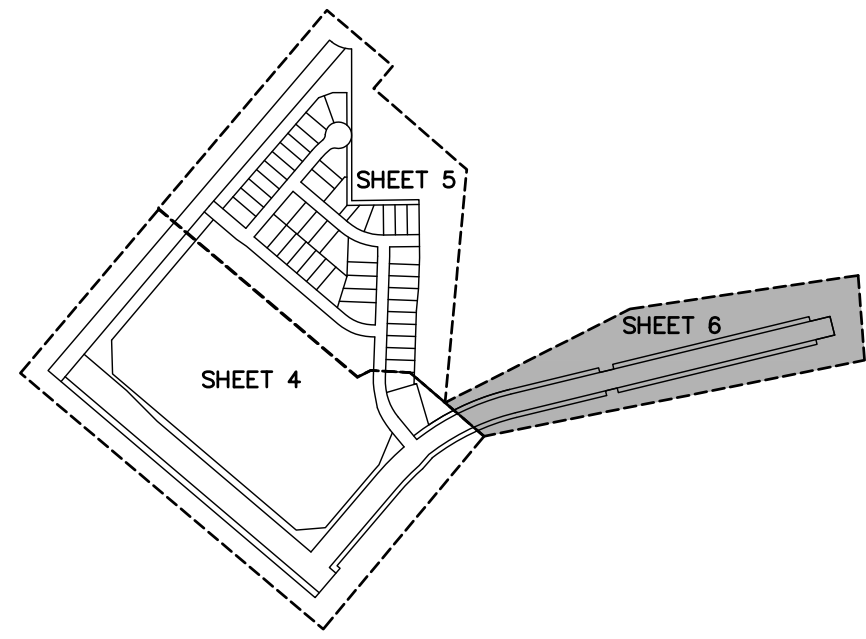


S 1/2, SW 1/4 SEC. 33
T.12S R65W 6TH P.M.

* UNPLATTED
RELEASE PARCEL 1
REC. NO. 217051682

TRACT J
16,496 SF
0.3787 AC

* UNPLATTED
REC. NO. 217051682

SEE RIGHT

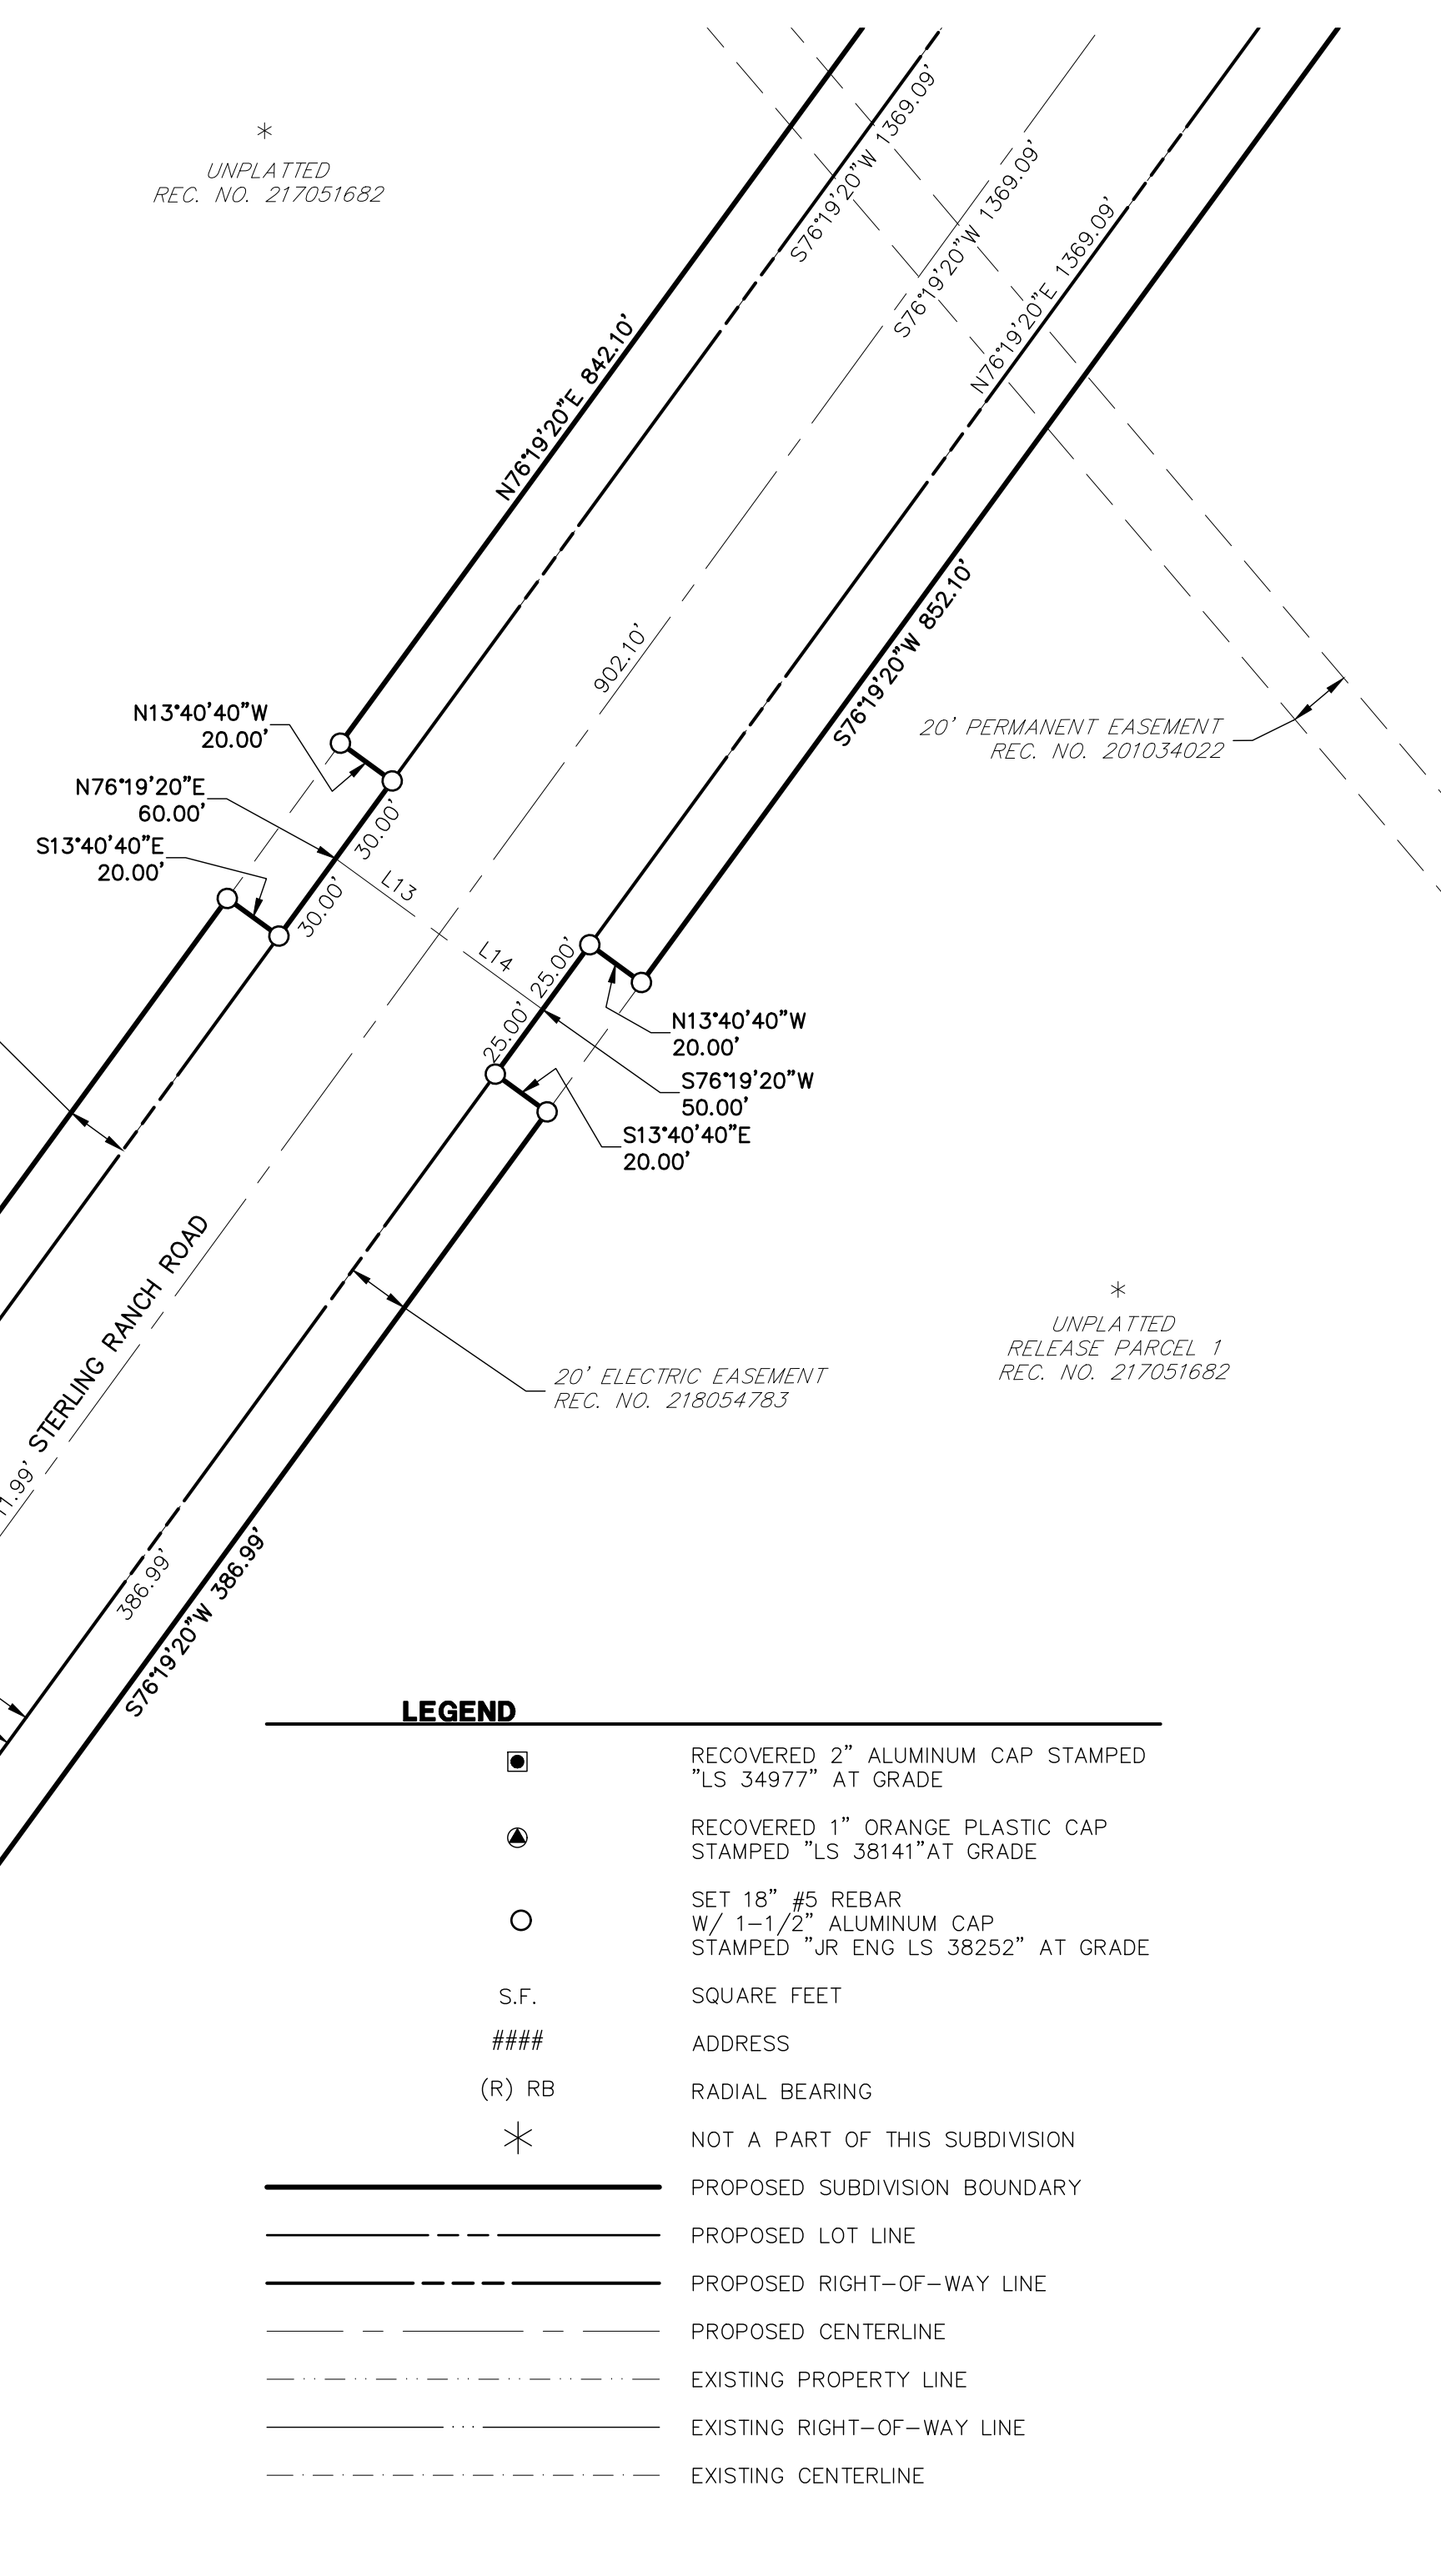

LEGEND

- RECOVERED 2" ALUMINUM CAP STAMPED "LS 34977" AT GRADE
- ▲ RECOVERED 1" ORANGE PLASTIC CAP STAMPED "LS 38141" AT GRADE
- SET 18" #5 REBAR W/ 1-1/2" ALUMINUM CAP STAMPED "JR ENG LS 38252" AT GRADE
- S.F. SQUARE FEET
- #### ADDRESS
- (R) RB RADIAL BEARING
- * NOT A PART OF THIS SUBDIVISION
- PROPOSED SUBDIVISION BOUNDARY
- - - PROPOSED LOT LINE
- - - PROPOSED RIGHT-OF-WAY LINE
- - - PROPOSED CENTERLINE
- - - EXISTING PROPERTY LINE
- - - EXISTING RIGHT-OF-WAY LINE
- - - EXISTING CENTERLINE

SEE SHEET 4

10' ELECTRIC EASEMENT
REC. NO. 218054783

* UNPLATTED
REC. NO. 217051682

S 1/2, SW 1/4 SEC. 33
T.12S R65W 6TH P.M.

20' ELECTRIC EASEMENT
REC. NO. 218054783

TRACT G
16,842 SF
0.3866 AC

* UNPLATTED
STERLING RANCH FILING NO. 1
REC. NO. 218714151






TRACT CC

POINT OF BEGINNING
S13°40'40"E
20.00'

TRACT A
17,042 SF
0.3912 AC

* UNPLATTED
RELEASE PARCEL 1
REC. NO. 217051682

SEE LEFT

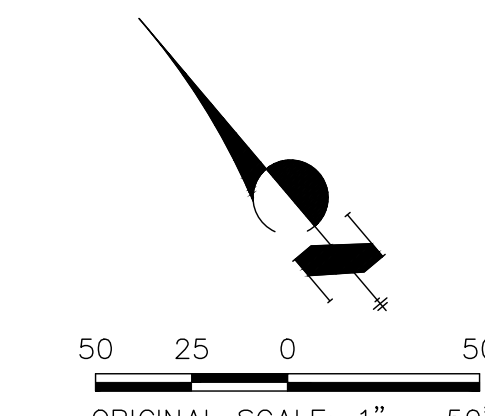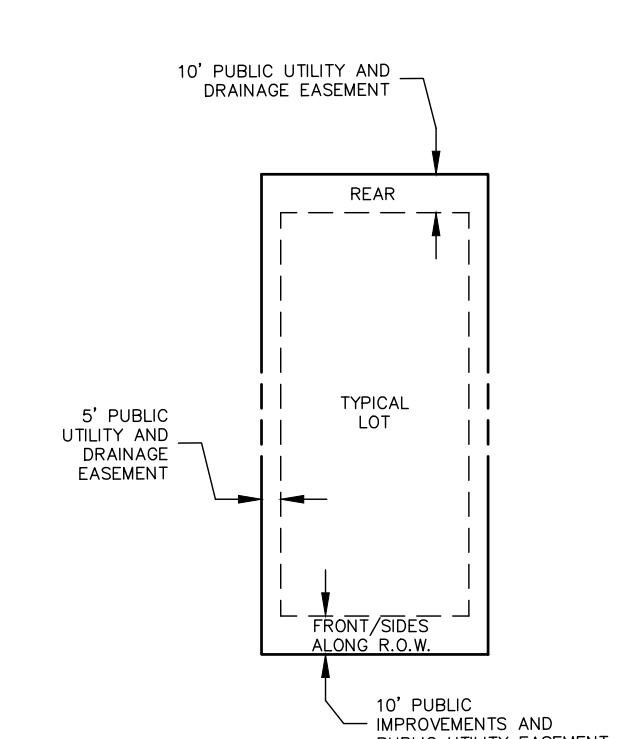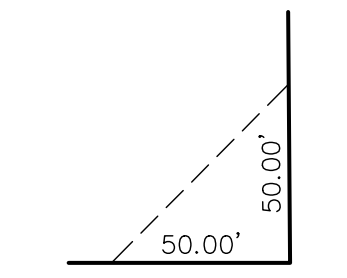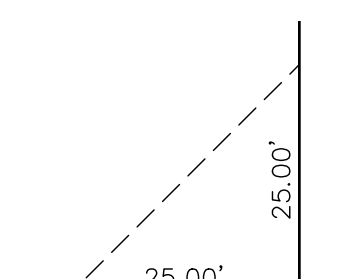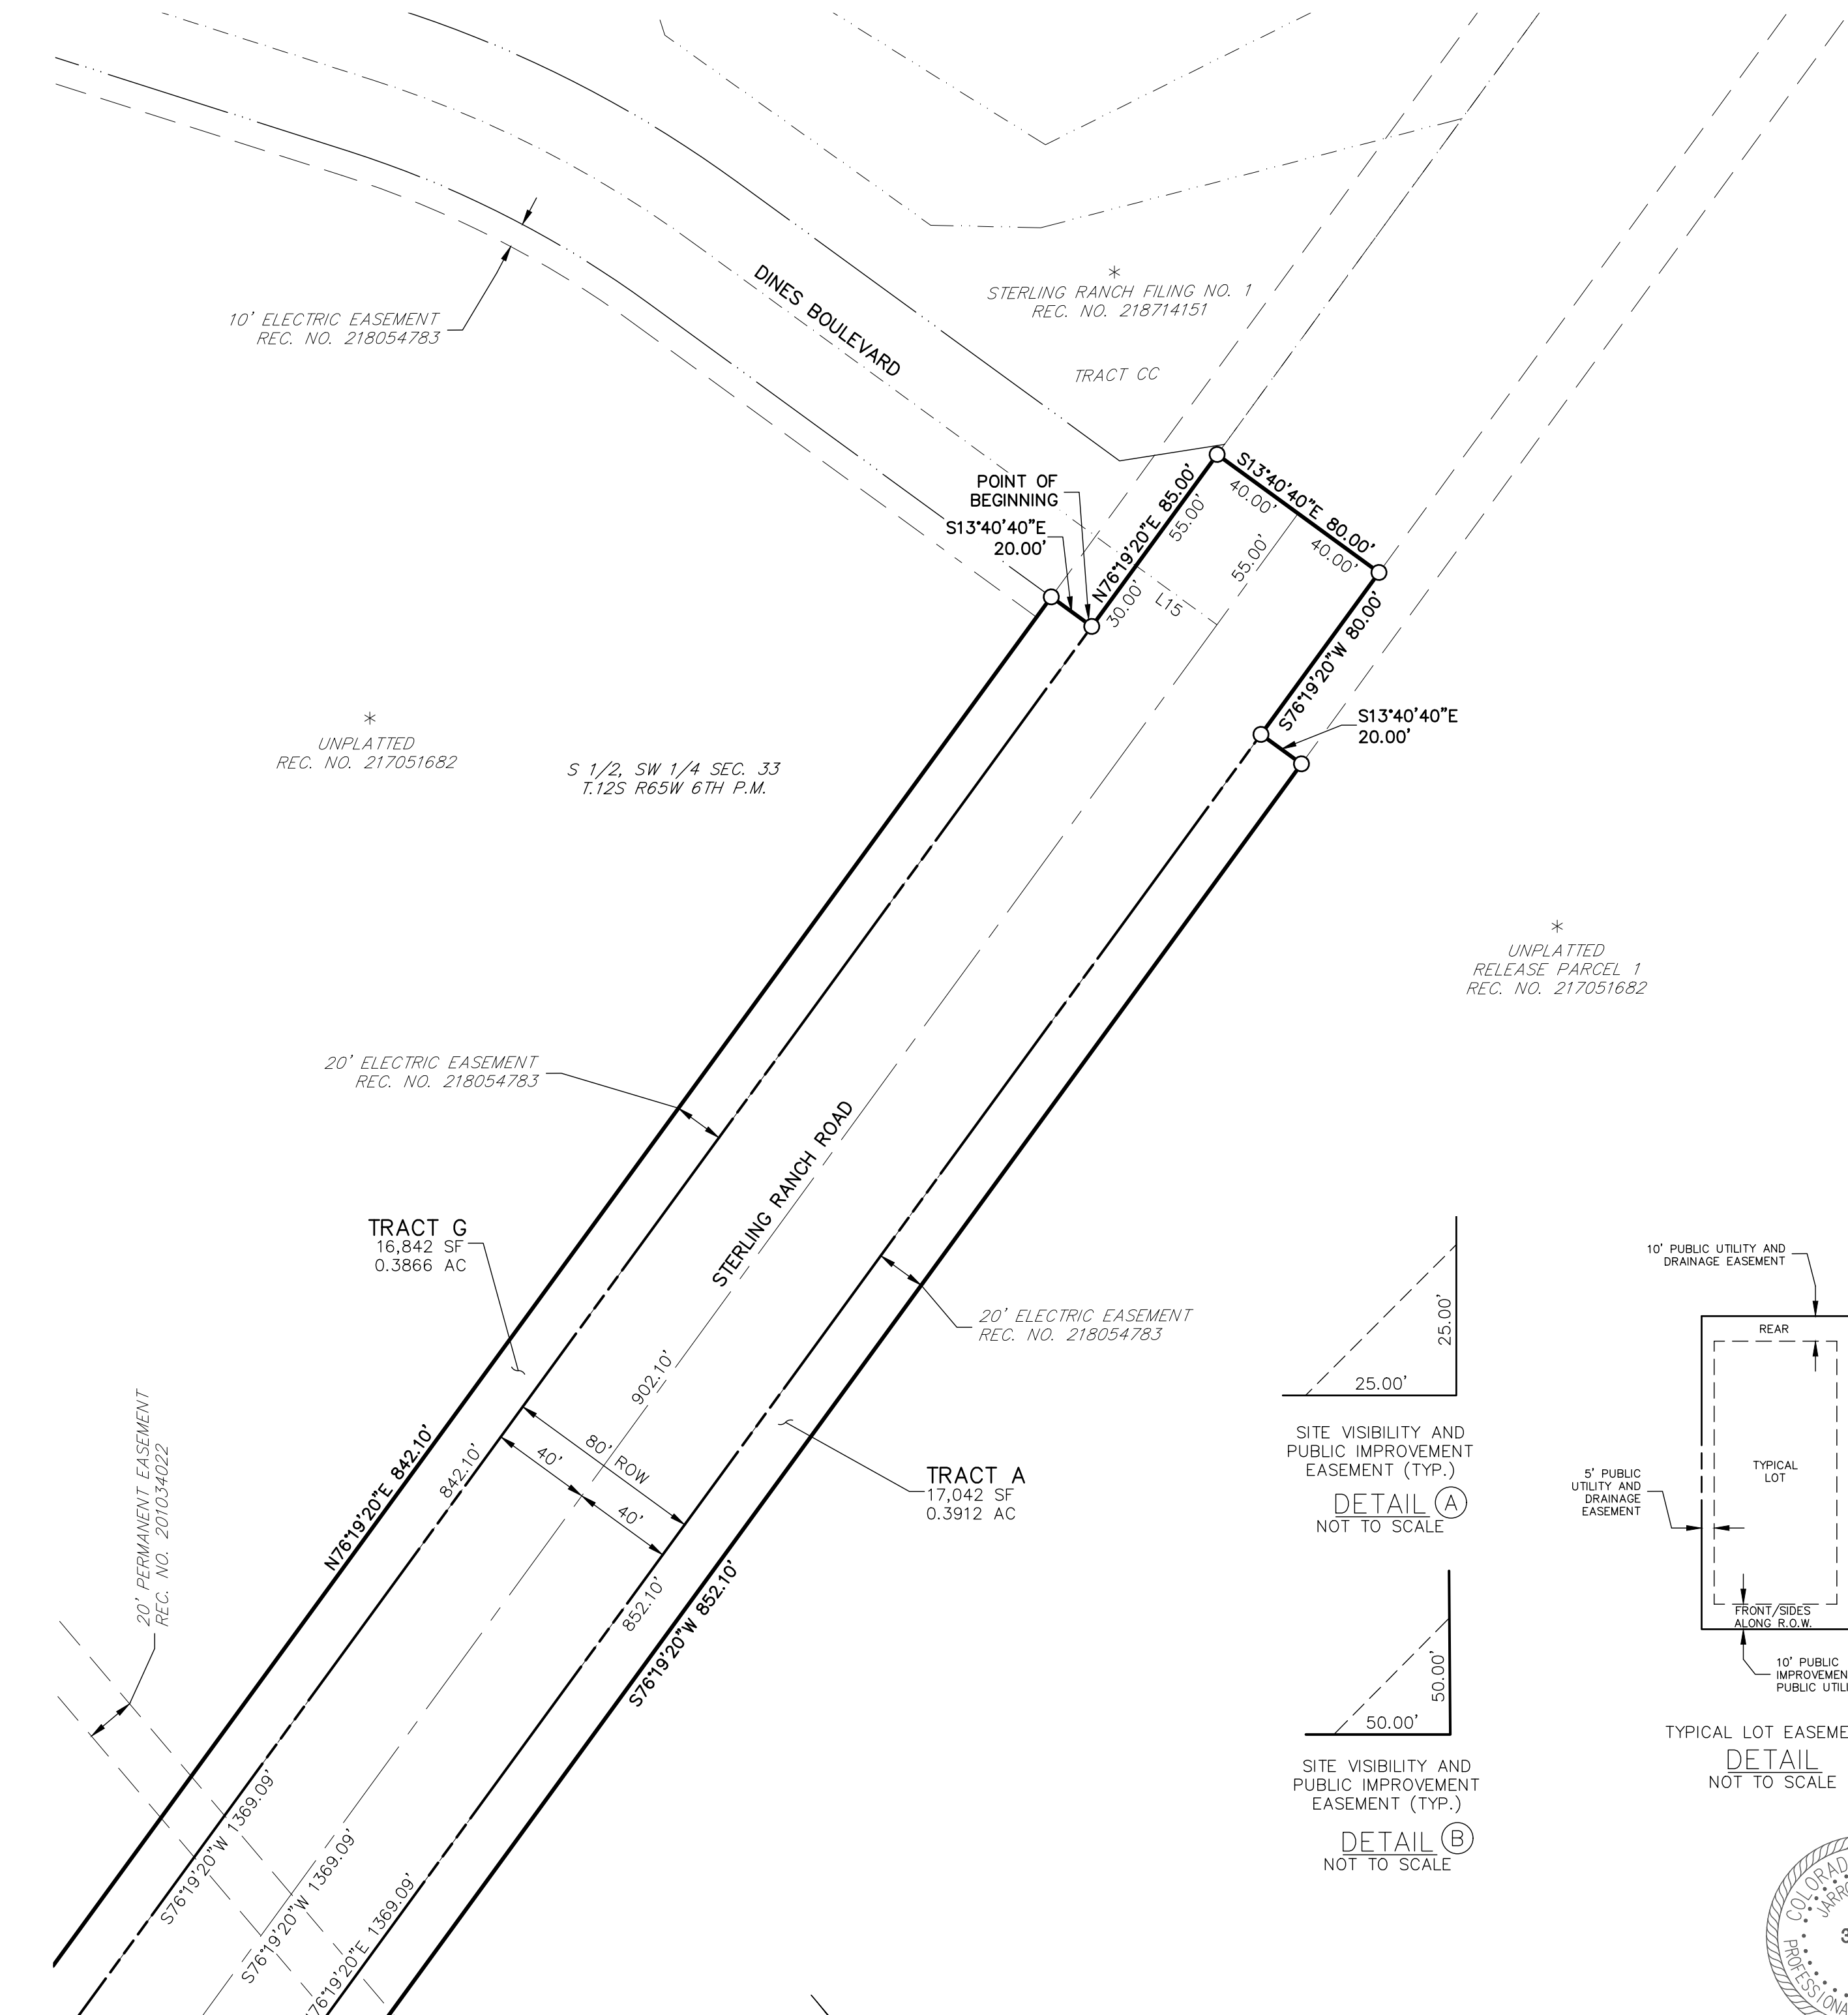

FINAL PLAT
STERLING RANCH FILING NO. 2
JOB NO. 25188.01
01/21/2021
SHEET 6 OF 7


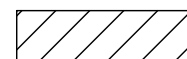



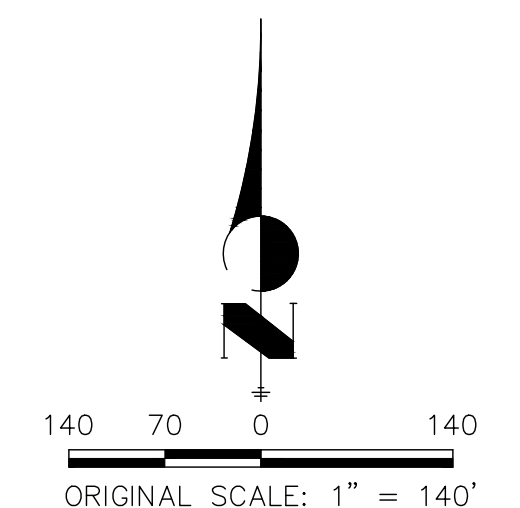
Centennial 303-740-9393 • Colorado Springs 719-593-2593
Fort Collins 970-491-9888 • www.jrengineering.com

FILE NO. SF-20-015

STERLING RANCH FILING NO. 2

A PORTION OF THE E1/2 OF THE SE1/4 OF SECTION 32 AND THE S1/2 OF THE SW1/4 OF SECTION 33,
TOWNSHIP 12 SOUTH, RANGE 65 WEST, AND THE NW1/4 OF THE NW1/4 OF SECTION 4
AND THE NE1/4 OF THE NE1/4 OF SECTION 5, TOWNSHIP 13 SOUTH, RANGE 65 WEST,
BOTH OF THE 6TH PRINCIPAL MERIDIAN, EL PASO COUNTY, STATE OF COLORADO.

LEGEND	
	HYDROCOMPACTION (h)
	POTENTIAL SEASONAL SHALLOW GROUNDWATER (psw)
	SHALLOW GROUNDWATER (sw)




FINAL PLAT
STERLING RANCH FILING NO. 2
JOB NO. 25188.01
01/21/2021
SHEET 7 OF 7
FILE NO. SF-20-015



Centennial 303-740-9393 • Colorado Springs 719-593-2593
Fort Collins 970-491-9888 • www.jrengineering.com


plat V_2 planning only.pdf Markup Summary 3-26-2021

dsdparsons (14)

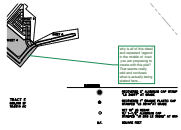


Subject: Callout
Page Label: [4] 2518801FP-SHEET 4
Author: dsdparsons
Date: 3/24/2021 12:45:11 PM
Status:
Color: ■
Layer:
Space:


why is all of this detail and repeated legend in the middle of tract you are proposing to create with this plat? That seems really odd and confuses what is actually being platted here....

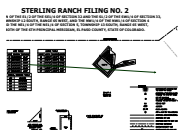

Subject: Arrow
Page Label: [4] 2518801FP-SHEET 4
Author: dsdparsons
Date: 3/24/2021 12:45:33 PM
Status:
Color: ■
Layer:
Space:

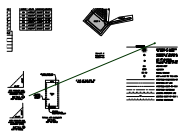


Subject: Arrow
Page Label: [4] 2518801FP-SHEET 4
Author: dsdparsons
Date: 3/24/2021 12:45:39 PM
Status:
Color: ■
Layer:
Space:

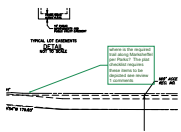


Subject: Callout
Page Label: [4] 2518801FP-SHEET 4
Author: dsdparsons
Date: 3/24/2021 12:48:34 PM
Status:
Color: ■
Layer:
Space:

where is the required trail along Marksheffel per Parks? The plat checklist requires these items to be depicted see review 1 comments

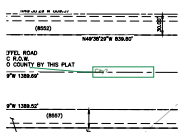


Subject: Callout
Page Label: [4] 2518801FP-SHEET 4
Author: dsdparsons
Date: 3/24/2021 12:49:39 PM
Status:
Color: ■
Layer:
Space:

City?

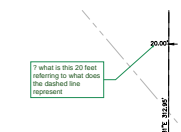

Subject: Callout
Page Label: [4] 2518801FP-SHEET 4
Author: dsdparsons
Date: 3/24/2021 12:52:20 PM
Status:
Color: ■
Layer:
Space:

? what is this 20 feet referring to what does the dashed line represent

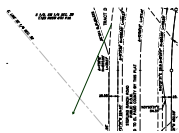

Subject: Arrow
Page Label: [4] 2518801FP-SHEET 4
Author: dsdparsons
Date: 3/24/2021 12:52:31 PM
Status:
Color: ■
Layer:
Space:




Subject: Callout
Page Label: [4] 2518801FP-SHEET 4
Author: dsdparsons
Date: 3/24/2021 12:55:20 PM
Status:
Color: ■
Layer:
Space:

please do not repeat the details and remove from the tract to be platted



Subject: Callout
Page Label: [5] 2518801FP-SHEET 5
Author: dsdparsons
Date: 3/26/2021 2:49:53 PM
Status:
Color: ■
Layer:
Space:

trail and buffer required per prelim plan against industrial

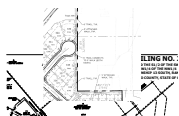

Subject: Image
Page Label: [5] 2518801FP-SHEET 5
Author: dsdparsons
Date: 3/26/2021 2:49:58 PM
Status:
Color: ■
Layer:
Space:



Subject: Image
Page Label: [3] 2518801FP-SHEET 3
Author: dsdparsons
Date: 3/26/2021 2:50:30 PM
Status:
Color: ■
Layer:
Space:




Subject: Image
Page Label: [3] 2518801FP-SHEET 3
Author: dsdparsons
Date: 3/26/2021 2:50:54 PM
Status:
Color: ■
Layer:
Space:



Subject: Callout
Page Label: [3] 2518801FP-SHEET 3
Author: dsdparsons
Date: 3/26/2021 2:51:26 PM
Status:
Color: ■
Layer:
Space:

Trail and 20-foot buffer required per prelim plan against industrial

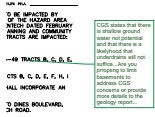

Subject: Callout
Page Label: [2] 2518801FP-SHEET 2
Author: dsdparsons
Date: 3/26/2021 3:32:44 PM
Status:
Color: ■
Layer:
Space:

CGS states that there is shallow ground water not potential and that there is a likelihood that underdrains will not suffice...Are you prropsng to limit basements to address CGS concerns or provide more details to the geology report...