

CREEKSIDE AT LORSON RANCH FILING NO. 1

A PORTION OF THE SW 1/4 SECTION 13, AND OF THE NE 1/4 SECTION 23, AND OF THE NW 1/4 SECTION 24, ALL IN TOWNSHIP 15 SOUTH, RANGE 65 WEST OF THE SIXTH PRINCIPAL MERIDIAN, EL PASO COUNTY, COLORADO

KNOW ALL MEN BY THESE PRESENTS:

THAT LORSON LLC A COLORADO LIMITED LIABILITY COMPANY, AS NOMINEE FOR HEIDI, LLC A COLORADO LIMITED LIABILITY COMPANY, AND LORSON LLC A COLORADO LIMITED LIABILITY COMPANY, AS NOMINEE FOR LORSON CONSERVATION INVEST I, LLLP A COLORADO LIMITED LIABILITY LIMITED PARTNERSHIP, AND LORSON LLC A COLORADO LIMITED LIABILITY COMPANY, AS NOMINEE FOR LORSON NORTH DEVELOPMENT CORP. A COLORADO CORPORATION, AND LORSON LLC A COLORADO LIMITED LIABILITY COMPANY, AS NOMINEE FOR MURRAY FOUNTAIN LLC, A COLORADO LIMITED LIABILITY COMPANY BEING THE OWNERS OF THE FOLLOWING DESCRIBED TRACT OF LAND:

TO WIT:

A PARCEL OF LAND IN THE NORTH HALF OF SECTION 23, T15S, R65W, OF THE 6th P.M., EL PASO COUNTY, COLORADO MORE PARTICULARLY DESCRIBED AS FOLLOWS:

BASIS OF BEARINGS USED IN THIS LEGAL DESCRIPTION IS THE EAST-WEST CENTERLINE OF SECTION 23, BEING MONUMENTED AT THE QUARTER CORNER COMMON TO SECTIONS 23 AND 24 WITH A 3.25 INCH ALUMINUM CAP ON A NO. 6 REBAR STAMPED "T15S R65W, S23 S24, PLS 31161", AND MONUMENTED AT THE QUARTER CORNER COMMON TO SECTIONS 22 AND 23 WITH A NO. 6 REBAR (NO CAP). SAID CENTERLINE IS ASSUMED TO BEAR S89°41'54"W, 5319.46 FEET.

COMMENCING AT THE QUARTER CORNER COMMON TO SECTIONS 22 AND 23; THENCE N89°41'54"E ALONG SAID CENTERLINE 142.46 FEET TO THE SOUTHEAST CORNER OF "CARRIAGE MEADOWS SOUTH AT LORSON RANCH FILING NO. 1" AS PLATTED IN THE EL PASO COUNTY RECORDS UNDER RECEPTION NO. 218714083 AND THE POINT OF BEGINNING;

THENCE ALONG THE EASTERLY LINES OF SAID "CARRIAGE MEADOWS SOUTH AT LORSON RANCH FILING NO. 1" THE FOLLOWING THREE (3) COURSES;

- THENCE N20°36'33"E A DISTANCE OF 560.24 FEET TO A POINT OF CURVE;
- THENCE ALONG THE ARC OF A CURVE TO THE LEFT, SAID CURVE HAVING A RADIUS OF 2169.98 FEET, A CENTRAL ANGLE OF 06°34'13", (THE CHORD OF WHICH BEARS N17°19'28"E, 248.71 FEET), AN ARC DISTANCE OF 248.84 FEET TO A POINT OF TANGENT;
- THENCE N04°02'20"E ALONG SAID TANGENT 295.75 FEET TO THE SOUTHWEST CORNER OF "THE MEADOWS AT LORSON RANCH FILING NO. 4" AS PLATTED IN THE EL PASO COUNTY RECORDS UNDER RECEPTION NO. 215713698;

THENCE ALONG THE SOUTHERLY AND EASTERLY LINES OF SAID "THE MEADOWS AT LORSON RANCH FILING NO. 4" THE FOLLOWING EIGHT (8) COURSES;

- THENCE N89°35'58"E A DISTANCE OF 508.54 FEET TO A POINT OF CURVE;
- THENCE ALONG THE ARC OF A CURVE TO THE LEFT, SAID CURVE HAVING A RADIUS OF 948.17, A CENTRAL ANGLE OF 35°42'15", (THE CHORD OF WHICH BEARS N71°44'51"E, 581.34 FEET), AN ARC DISTANCE OF 590.86 FEET TO A POINT OF TANGENT;
- THENCE N53°53'43"E ALONG SAID TANGENT 488.36 FEET TO A POINT OF CURVE;
- THENCE ALONG THE ARC OF A CURVE TO THE RIGHT, SAID CURVE HAVING A RADIUS OF 1058.48 FEET, A CENTRAL ANGLE OF 36°19'14", (THE CHORD OF WHICH BEARS N72°03'20"E, 659.81 FEET), AN ARC DISTANCE OF 670.99 FEET;
- THENCE N44°35'58"E NON-TANGENT TO THE PREVIOUS COURSE 35.36 FEET;
- THENCE N00°24'02"W A DISTANCE OF 158.34 FEET TO A POINT OF CURVE;
- THENCE ALONG THE ARC OF A CURVE TO THE LEFT, SAID CURVE HAVING A RADIUS OF 566.89 FEET, A CENTRAL ANGLE OF 15°51'49", (THE CHORD OF WHICH BEARS N08°19'56"W, 156.45 FEET), AN ARC DISTANCE OF 156.96 FEET;
- THENCE N73°44'10"E RADIAL TO THE PREVIOUS COURSE 5.00 FEET TO THE WESTERLY RIGHT-OF-WAY LINE OF "OLD GLORY DRIVE" AS RECORDED IN A SPECIAL WARRANTY DEED UNDER RECEPTION NO. 208057388 IN THE EL PASO COUNTY, COLORADO RECORDS;

THENCE ALONG THE WESTERLY, SOUTHERLY AND EASTERLY LINES OF SAID "OLD GLORY DRIVE" THE FOLLOWING FOUR (4) COURSES;

- THENCE ALONG THE ARC OF A CURVE TO THE RIGHT, RADIAL TO THE PREVIOUS COURSE, SAID CURVE HAVING A RADIUS OF 571.99 FEET, A CENTRAL ANGLE OF 15°51'37", (THE CHORD OF WHICH BEARS S08°19'52"E, 157.83 FEET), AN ARC DISTANCE OF 158.33 FEET TO A POINT OF TANGENT
- THENCE S00°24'02"E ALONG SAID TANGENT 183.34 FEET;
- THENCE N89°35'58"E A DISTANCE OF 60.00 FEET;
- THENCE N00°24'02"W A DISTANCE OF 40.17 FEET TO THE SOUTHWEST CORNER OF "ALLEGIAN AT LORSON RANCH" AS PLATTED UNDER RECEPTION NO. 212713204 IN THE EL PASO COUNTY, COLORADO RECORDS;

THENCE ALONG THE SOUTHERLY LINES OF SAID "ALLEGIAN AT LORSON RANCH" THE FOLLOWING TWO (2) COURSES;

- THENCE S45°24'02"E A DISTANCE OF 56.57 FEET;
- THENCE N89°35'58"E A DISTANCE OF 594.34 FEET TO THE SOUTHWEST CORNER OF "THE MEADOWS AT LORSON RANCH FILING NO. 3" AS PLATTED UNDER RECEPTION NO. 213713396 IN THE EL PASO COUNTY, COLORADO RECORDS;

THENCE N89°35'58"E ALONG THE SOUTHERLY LINE THEREOF 85.21 FEET TO THE WESTERLY LINE OF "LORSON RANCH EAST FILING NO. 1" AS PLATTED UNDER RECEPTION NO. 219714288 IN THE EL PASO COUNTY, COLORADO RECORDS;


THENCE ALONG THE WESTERLY AND SOUTHERLY LINES OF SAID "LORSON RANCH EAST FILING NO. 1" THE FOLLOWING SIX (6) COURSES;

- THENCE S00°24'02"E A DISTANCE OF 80.00 FEET;
- THENCE N89°35'58"E A DISTANCE OF 14.76 FEET;
- THENCE S45°24'02"E A DISTANCE OF 14.14 FEET;
- THENCE N89°35'58"E A DISTANCE OF 60.00 FEET;
- THENCE N51°59'14"E A DISTANCE OF 29.49 FEET;
- THENCE N89°35'58"E A DISTANCE OF 693.52 FEET;

- THENCE S21°18'01"W A DISTANCE OF 20.20 FEET;
- THENCE S11°48'57"W A DISTANCE OF 127.89 FEET;
- THENCE S00°29'43"W A DISTANCE OF 173.06 FEET;
- THENCE S11°17'09"W A DISTANCE OF 285.14 FEET;
- THENCE S31°55'05"W A DISTANCE OF 182.34 FEET;
- THENCE S 58°54'51"E A DISTANCE OF 4.71 FEET;
- THENCE S31°05'09"W A DISTANCE OF 90.00 FEET;
- THENCE S76°28'55"W A DISTANCE OF 247.86 FEET;
- THENCE N82°16'06"W A DISTANCE OF 188.62 FEET;
- THENCE S77°50'20"W A DISTANCE OF 405.01 FEET;
- THENCE S60°55'25"W A DISTANCE OF 219.41 FEET;
- THENCE S17°08'25"W A DISTANCE OF 123.42 FEET;
- THENCE S85°20'33"W A DISTANCE OF 169.20 FEET;
- THENCE N65°32'01"W A DISTANCE OF 188.46 FEET;
- THENCE N44°43'03"W A DISTANCE OF 230.04 FEET;
- THENCE N88°34'10"W A DISTANCE OF 160.16 FEET TO A POINT OF CURVE;

- THENCE ALONG THE ARC OF A CURVE TO THE LEFT, SAID CURVE HAVING A RADIUS OF 215.00 FEET, A CENTRAL ANGLE OF 74°59'26", (THE CHORD OF WHICH BEARS S53°56'07"W, 261.74 FEET), AN ARC DISTANCE OF 281.40 FEET TO A POINT OF TANGENT;
- THENCE S16°28'24"W ALONG SAID TANGENT 116.82 FEET;
- THENCE S83°30'09"W A DISTANCE OF 446.06 FEET;
- THENCE N77°01'58"W A DISTANCE OF 350.83 FEET;
- THENCE S28°55'26"W A DISTANCE OF 265.02 FEET;
- THENCE S36°43'29"W A DISTANCE OF 311.41 FEET TO THE EAST-WEST CENTERLINE OF SECTION 23
- THENCE S89°41'54"W ALONG SAID CENTERLINE 749.79 FEET TO THE POINT OF BEGINNING;

SAID PARCEL OF LAND CONTAINS A CALCULATED AREA OF 83.088 ACRES MORE OR LESS.

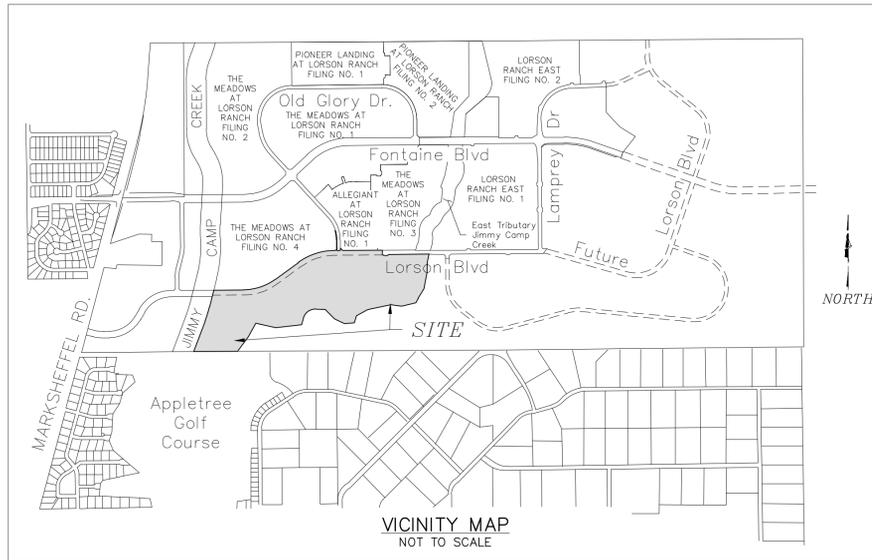

OWNERS CERTIFICATE:

THE UNDERSIGNED, BEING ALL THE OWNERS, MORTGAGEES, BENEFICIARIES OF DEEDS OF TRUST AND HOLDERS OF OTHER INTERESTS IN THE LAND DESCRIBED HEREIN, HAVE LAID OUT, SUBDIVIDED, AND PLATTED SAID LANDS INTO LOTS, TRACTS, PUBLIC STREETS, AND EASEMENTS AS SHOWN HEREON UNDER THE NAME AND SUBDIVISION OF "CREEKSIDE AT LORSON RANCH FILING NO. 1". ALL PUBLIC IMPROVEMENTS SO PLATTED ARE HEREBY DEDICATED TO PUBLIC USE AND SAID OWNER DOES HEREBY COVENANT AND AGREE THAT THE PUBLIC IMPROVEMENTS WILL BE CONSTRUCTED TO EL PASO COUNTY STANDARDS AND THAT PROPER DRAINAGE AND EROSION CONTROL FOR SAME WILL BE PROVIDED AT SAID OWNER'S EXPENSE, ALL TO THE SATISFACTION OF THE BOARD OF COUNTY COMMISSIONERS OF EL PASO COUNTY, COLORADO. UPON ACCEPTANCE BY RESOLUTION, ALL PUBLIC IMPROVEMENTS SO DEDICATED WILL BECOME MATTERS OF MAINTENANCE BY EL PASO COUNTY, COLORADO. THE UTILITY EASEMENTS SHOWN HEREON ARE HEREBY DEDICATED FOR PUBLIC UTILITIES AND COMMUNICATION SYSTEMS AND OTHER PURPOSES AS SHOWN HEREON. THE ENTITIES RESPONSIBLE FOR PROVIDING THE SERVICES FOR WHICH THE EASEMENTS ARE ESTABLISHED ARE HEREBY GRANTED THE PERPETUAL RIGHT OF INGRESS AND EGRESS FROM AND TO ADJACENT PROPERTIES FOR INSTALLATION, MAINTENANCE, AND REPLACEMENT OF UTILITY LINES AND RELATED FACILITIES.

OWNER ADDRESS:
212 N. WAHSATCH AVENUE
SUITE 301
COLORADO SPRINGS, CO 80903
PHONE: (719) 635-3200
FAX: (719) 635-3244

BY: JEFF MARK, AUTHORIZED SIGNING AGENT, FOR:
LORSON LLC A COLORADO LIMITED LIABILITY COMPANY, AS NOMINEE FOR HEIDI, LLC A COLORADO LIMITED LIABILITY COMPANY, AND LORSON LLC A COLORADO LIMITED LIABILITY COMPANY, AS NOMINEE FOR LORSON CONSERVATION INVEST I, LLLP A COLORADO LIMITED LIABILITY LIMITED PARTNERSHIP, AND LORSON LLC A COLORADO LIMITED LIABILITY COMPANY, AS NOMINEE FOR LORSON NORTH DEVELOPMENT CORP. A COLORADO CORPORATION, AND LORSON LLC A COLORADO LIMITED LIABILITY COMPANY, AS NOMINEE FOR MURRAY FOUNTAIN LLC, A COLORADO LIMITED LIABILITY COMPANY

ATTEST: _____
SECRETARY/TREASURER

STATE OF COLORADO }
COUNTY OF EL PASO } ss

ACKNOWLEDGED BEFORE ME THIS _____ DAY OF _____, 2019, A.D. BY
JEFF MARK, AUTHORIZED SIGNING AGENT, LORSON LLC, A COLORADO LIMITED LIABILITY COMPANY.

WITNESS MY HAND AND OFFICIAL SEAL:

MY COMMISSION EXPIRES: _____

NOTARY PUBLIC: _____

EASEMENTS:

UNLESS OTHERWISE SHOWN, ALL SIDE LOT LINES ARE HEREBY PLATTED WITH A FIVE FOOT (5') PUBLIC UTILITY AND DRAINAGE EASEMENT, ALL REAR LOT LINES ARE HEREBY PLATTED WITH A TEN FOOT (10') PUBLIC UTILITY AND DRAINAGE EASEMENT, ALL FRONT LOT LINES AND ALL FRONT TRACT LINES ARE HEREBY PLATTED WITH A TEN FOOT (10') PUBLIC UTILITY AND DRAINAGE EASEMENT. THE SOLE RESPONSIBILITY FOR MAINTENANCE OF ALL HEREIN DESCRIBED EASEMENTS IS VESTED WITH THE INDIVIDUAL PROPERTY OWNERS. A TWENTY FOOT (20') PUBLIC UTILITY EASEMENT IS HEREBY PLATTED ALONG THE SUBDIVISION BOUNDARY LINES. ALL EASEMENTS THAT ARE DEDICATED HEREON FOR PUBLIC UTILITY PURPOSES SHALL BE SUBJECT TO THOSE TERMS AND CONDITIONS AS SPECIFIED IN THE INSTRUMENT RECORDED AT RECEPTION NUMBER 212112548 OF THE RECORDS OF EL PASO COUNTY, COLORADO. ALL OTHER EASEMENTS OR INTERESTS OF RECORD AFFECTING ANY OF THE PLATTED PROPERTY DEPICTED HEREON SHALL NOT BE AFFECTED AND SHALL REMAIN IN FULL FORCE AND EFFECT.

FLOOD PLAIN CERTIFICATION:

A PORTION OF THIS PROPERTY IS LOCATED WITHIN A DESIGNATED FEMA FLOODPLAIN AS DETERMINED BY THE FLOOD INSURANCE RATE MAP (FIRM) PANEL NO. 0804100873 DATED DECEMBER 7, 2019 REVISED TO REFLECT CLOMR CASE NO. 06-08-8425R, EFFECTIVE DATE JANUARY 17, 2007 AND LOMC 14-08-053P, EFFECTIVE DATE JANUARY 28, 2015 HAS BEEN EXAMINED AS IT RELATES TO THE PROPERTY BEING PLATTED. THE REVISED AND AMENDED FLOODPLAIN LIMITS ARE AS SHOWN HEREON.

ACCEPTANCE CERTIFICATE FOR TRACTS:

LORSON RANCH METROPOLITAN DISTRICT

THE DEDICATION OF TRACTS A, B, C, D, E, F, G, AND H FOR THE PURPOSES SPECIFIED IN THE TRACT TABLE ARE HEREBY ACCEPTED FOR OWNERSHIP AND MAINTENANCE BY THE LORSON RANCH METROPOLITAN DISTRICT.
APPROVAL IS GRANTED FOR THIS PLAT OF "CREEKSIDE AT LORSON RANCH FILING NO. 1".

BY: JEFF MARK, DIRECTOR, LORSON RANCH METROPOLITAN DISTRICT NO. 1

STATE OF COLORADO }
COUNTY OF EL PASO } ss

ACKNOWLEDGED BEFORE ME THIS _____ DAY OF _____, 2019, A.D. BY
JEFF MARK, DIRECTOR, LORSON, LLC

WITNESS BY HAND AND OFFICIAL SEAL:

MY COMMISSION EXPIRES: _____

NOTARY PUBLIC: _____

Soil and Geology Conditions:
Geologic Hazard Note-Final Plat: (to be customized based upon the individual circumstances)
The following lots have been found to be impacted by geologic hazards. Mitigation measures and a map of the hazard area can be found in the report (Title of Report, generally from the Preliminary Plan file) by (author of the report) (date of report) in file (name of file and file number) available at the El Paso County Planning and Community Development Department.
•Downslope Creep: (name lots or location of area)
•Rockfall Source: (name lots or location of area)
•Rockfall Runout Zone: (name lots or location of area)
•Potentially Seasonally High Groundwater: (name lots or location of area)
•Other Hazard:
In Areas of High Groundwater:
Due to high groundwater in the area, all foundations shall incorporate an underground drainage system.

QUALITY CONTROL
YOUR DOCS
PLEASE

SURVEYORS CERTIFICATE

I VERNON P. TAYLOR, A DULY REGISTERED PROFESSIONAL LAND SURVEYOR IN THE STATE OF COLORADO, DO HEREBY CERTIFY THAT THIS PLAT TRULY AND CORRECTLY REPRESENTS THE RESULTS OF A SURVEY MADE ON NOVEMBER 02, 2019 BY ME OR UNDER MY DIRECT SUPERVISION AND THAT ALL MONUMENTS EXIST AS SHOWN HEREON; THAT MATHEMATICAL CLOSURE ERRORS ARE LESS THAN 1:10,000; AND THAT SAID PLAT HAS BEEN PREPARED IN FULL COMPLIANCE WITH ALL APPLICABLE LAWS OF THE STATE OF COLORADO DEALING WITH MONUMENTS, SUBDIVISION, OR SURVEYING OF LAND AND ALL APPLICABLE PROVISIONS OF THE EL PASO COUNTY LAND DEVELOPMENT CODE.

I ATTEST THE ABOVE ON THIS _____ DAY OF _____, 2019.

VERNON P. TAYLOR DATE
COLORADO PLS NO. 25966, FOR AND
ON BEHALF OF M&S CIVIL CONSULTANTS, INC
20 BOULDER CRESCENT, SUITE 110
COLORADO SPRINGS, COLORADO 80903

NOTICE:
ACCORDING TO COLORADO LAW, YOU MUST COMMENCE ANY LEGAL ACTION BASED UPON ANY DEFECT IN THIS SURVEY WITHIN THREE YEARS AFTER YOU FIRST DISCOVER SUCH DEFECT. IN NO EVENT, MAY ANY ACTION BASED UPON ANY DEFECT IN THIS SURVEY BE COMMENCED MORE THAN TEN YEARS FROM THE DATE OF THE CERTIFICATION SHOWN HEREON.

BOARD OF COUNTY COMMISSIONERS CERTIFICATE:

THIS PLAT FOR "CREEKSIDE AT LORSON RANCH FILING NO. 1" WAS APPROVED FOR FILING BY THE EL PASO COUNTY, COLORADO BOARD OF COUNTY COMMISSIONERS ON THE _____ DAY OF _____, 2019, A.D., SUBJECT TO ANY NOTES SPECIFIED HEREON AND ANY CONDITIONS INCLUDED IN THE RESOLUTION OF APPROVAL. THE DEDICATIONS OF LAND TO THE PUBLIC INCLUDING STREETS AND EASEMENTS ARE ACCEPTED, BUT PUBLIC IMPROVEMENTS THEREON WILL NOT BECOME THE MAINTENANCE RESPONSIBILITY OF EL PASO COUNTY UNTIL PRELIMINARY ACCEPTANCE OF THE PUBLIC IMPROVEMENTS IN ACCORDANCE WITH THE REQUIREMENTS OF THE LAND DEVELOPMENT CODE AND ENGINEERING CRITERIA MANUAL, AND THE SUBDIVISION IMPROVEMENTS AGREEMENT.

PRESIDENT, BOARD OF COUNTY COMMISSIONERS _____ DATE _____

COUNTY APPROVAL:

APPROVAL IS GRANTED FOR THIS PLAT OF "CREEKSIDE AT LORSON RANCH FILING NO. 1" ON THIS _____ DAY OF _____, 2019, A.D.

EL PASO COUNTY DIRECTOR OF PLANNING AND COMMUNITY DEVELOPMENT

EL PASO COUNTY ASSESSOR

RECORDING:

STATE OF COLORADO }
COUNTY OF EL PASO } ss

I HEREBY CERTIFY THAT THIS INSTRUMENT WAS FILED FOR RECORD AT MY OFFICE AT _____ O'CLOCK _____ M., THIS _____ DAY OF _____, 2019, A.D., AND IS DULY RECORDED UNDER RECEPTION NUMBER _____ OF THE RECORDS OF EL PASO COUNTY, COLORADO.

CHUCK BROERMAN, RECORDER

FEE: _____ BY: _____ DEPUTY

TRACT TABLE			
TRACT	SIZE (ACRES)	OWNERSHIP/ MAINTENANCE	USE
A	34.141	LRMD/LRMD	DRAINAGE/PUBLIC IMPROVEMENT/PUBLIC UTILITY/LANDSCAPING/OPEN SPACE
B	2.102	LRMD/LRMD	DRAINAGE/PUBLIC IMPROVEMENT/PUBLIC UTILITY/LANDSCAPING/OPEN SPACE
C	0.786	LRMD/LRMD	DRAINAGE/PUBLIC IMPROVEMENT/PUBLIC UTILITY/LANDSCAPING/OPEN SPACE
D	0.890	LRMD/LRMD	DRAINAGE/PUBLIC IMPROVEMENT/PUBLIC UTILITY/LANDSCAPING/OPEN SPACE
E	0.170	LRMD/LRMD	DRAINAGE/PUBLIC IMPROVEMENT/PUBLIC UTILITY/LANDSCAPING/OPEN SPACE
F	5.193	LRMD/LRMD	DRAINAGE/PUBLIC IMPROVEMENT/PUBLIC UTILITY/LANDSCAPING/OPEN SPACE
G	0.193	LRMD/LRMD	DRAINAGE/PUBLIC IMPROVEMENT/PUBLIC UTILITY/LANDSCAPING/OPEN SPACE
H	0.039	LRMD/LRMD	DRAINAGE/PUBLIC IMPROVEMENT/PUBLIC UTILITY/LANDSCAPING/OPEN SPACE
TOTAL	43.514	LRMD/LRMD	DRAINAGE/PUBLIC IMPROVEMENT/PUBLIC UTILITY/LANDSCAPING/OPEN SPACE

LRMD = LORSON RANCH METRO DISTRICT

TRACTS DO NOT
MATCH APPROVED
PUDSP

SUMMARY:

235 LOTS	24.815 ACRES	29.87%
8 TRACTS	43.514 ACRES	52.37%
RIGHTS-OF-WAY	14.759 ACRES	17.76%
TOTAL	83.088 ACRES	100.00%

FEES:

DRAINAGE FEE:	\$ 379,061.00
JIMMY CAMP CREEK SURETY FEE:	\$ 150,723.00
BRIDGE FEE:	\$ 17,723.00
SCHOOL FEE:	FEES NOT DUE PER THE SCHOOL LAND AGREEMENT AS RECORDED AT RECEPTION NO. 212042170
PARK FEE:	
URBAN PARK FEE:	

Revise per FDR
comments

FINAL PLAT
CREEKSIDE AT LORSON RANCH
FILING NO. 1
JOB NO. 70-068
DATE PREPARED: 05/15/2019
DATE REVISED:



102 E. PIKES PEAK AVE., 5TH FLOOR
COLORADO SPRINGS, CO 80903
PHONE: 719.955.5465

CREEKSIDE AT LORSON RANCH FILING NO. 1

A PORTION OF THE SW 1/4 SECTION 13, AND OF THE NE 1/4 SECTION 23, AND OF THE NW 1/4 SECTION 24,
ALL IN TOWNSHIP 15 SOUTH, RANGE 65 WEST OF THE SIXTH PRINCIPAL MERIDIAN, EL PASO COUNTY, COLORADO

GENERAL PLAT NOTES:

1. BASIS OF BEARING: THE EAST-WEST CENTERLINE OF SECTION 23, BEING MONUMENTED AT THE QUARTER CORNER COMMON TO SECTIONS 23 AND 24 WITH A 3.25 INCH ALUMINUM CAP ON A NO. 6 REBAR STAMPED "T15 R65W, S23 S24, PLS 31161", AND MONUMENTED AT THE QUARTER CORNER COMMON TO SECTIONS 22 AND 23 WITH A NO. 6 REBAR (NO CAP). SAID CENTERLINE IS ASSUMED TO BEAR S89°41'54"W, 5319.46 FEET. THE UNIT OF MEASUREMENTS IS THE U.S. SURVEY FOOT.
2. THE FLOOD INSURANCE RATE MAP (FIRM) PANEL NO. 08041CO957F AND PANEL NO. 08041CO1000F, BOTH DATED MARCH 17, 1997 REVISED TO REFLECT CLOMR CASE NO. 06-08-8425R, EFFECTIVE DATE JANUARY 17, 2007 AND LOMC 14-08-053P, EFFECTIVE DATE JANUARY 28, 2015 HAS BEEN EXAMINED AS IT RELATES TO THE PROPERTY BEING PLATTED. THE REVISED AND AMENDED FLOODPLAIN RECORDS ARE AS SHOWN HEREON.
3. A COMMITMENT FOR TITLE INSURANCE ISSUED BY UNIFIED TITLE COMPANY, LLC AS AGENT FOR STEWART TITLE GUARANTY COMPANY WITH AN EFFECTIVE DATE OF MAY 7, 2019 AT 7:30AM, FILE NO. 64831 UTC, HAS BEEN EXAMINED AS IT RELATES TO THE PROPERTY BEING PLATTED.
 - i. (TC#9) THE PROPERTY MAY BE SUBJECT TO ANY INTEREST WHICH MAY HAVE BEEN ACQUIRED BY THE PUBLIC REASON OF THE RESOLUTION OF THE BOARD OF COUNTY COMMISSIONERS DATED AND RECORDED OCTOBER 3, 1887 IN ROAD BOOK A AT PAGE 78, WHICH PROVIDED THAT ALL SECTION LINES, TOWNSHIP LINES, AND RANGE LINES ON THE PUBLIC DOMAIN EAST OF THE RANGE LINE DIVIDING RANGE LINES 65 WEST AND 66 WEST DECLARED TO BE PUBLIC HIGHWAYS OF THE WIDTH OF 60 FEET, BEING 30 FEET ON EACH SIDE OF SAID SECTION LINES, TOWNSHIP LINES, OR RANGE LINES. NOTE: RESOLUTION NO. 04-507 REGARDING ROAD ORDER, RECORDED NOVEMBER 24, 2004 AT RECEPTION NO. 204193597 AND DISCLAIMER RECORDED NOVEMBER 24, 2004 AT RECEPTION NO. 204193598.
 - ii. (TC#10) THE PROPERTY MAY BE SUBJECT TO ANY QUESTION, DISPUTE OR ADVERSE CLAIMS AS TO ANY LOSS OR GAIN OF LAND AS A RESULT OF ANY CHANGE IN THE RIVER BED LOCATION BY OTHER THAN NATURAL CAUSES, OR ALTERATION THROUGH ACCRETION, RELICTION, EROSION OR AVULSION OF THE CENTER THREAD, BANK, CHANNEL OR FLOW OF WATERS IN JIMMY CAP CREEK LYING WITHIN SUBJECT LAND; AND ANY QUESTION AS TO THE LOCATION OF SUCH CENTER THREAD, BED BANK OR CHANNEL AS A LEGAL DESCRIPTION MONUMENT OR MARKER FOR PURPOSES OF DESCRIBING OR LOCATING SUBJECT LANDS.

NOTE: THERE ARE NO DOCUMENTS IN THE LAND RECORDS OF THE OFFICE OF THE CLERK AND RECORDER OF EL PASO, ACCURATELY LOCATING PAST OR PRESENT LOCATION(S) OF THE CENTER THREAD, BANK, BED OR CHANNEL OF THE ABOVE JIMMY CAP CREEK OR INDICATING ANY ALTERATIONS OF THE SAME AS FROM TIME TO TIME MAY HAVE OCCURRED.
 - iii. (TC#11) THE PROPERTY MAY BE SUBJECT TO ANY RIGHTS, INTEREST OR EASEMENTS IN FAVOR OF THE RIPARIAN OWNERS, THE STATE OF COLORADO, THE UNITED STATES OF AMERICA, OR THE GENERAL PUBLIC, WHICH EXIST, HAVE EXISTED, OR ARE CLAIMED TO EXIST IN AND OVER THE WATERS AND PRESENT AND PAST BED AND BANKS OF JIMMY CAMP CREEK.
 - iv. (TC#12) THE PROPERTY MAY BE SUBJECT RESERVATION AS CONTAINED IN DEED RECORDED AUGUST 28, 1922 IN BOOK 683 AT PAGE 88.
 - v. (TC#13) THE PROPERTY MAY BE SUBJECT TO TERMS, AGREEMENTS, PROVISIONS, CONDITIONS, OBLIGATIONS AND EASEMENTS AS CONTAINED IN RIGHT OF WAY EASEMENT TO MOUNTAIN VIEW ASSOCIATION, INC., RECORDED MARCH 7, 1983 IN BOOK 3684 AT PAGE 492.
 - vi. (TC#15) THE PROPERTY MAY BE SUBJECT TO TERMS, AGREEMENTS, PROVISIONS, CONDITIONS AND OBLIGATIONS AS CONTAINED IN RESOLUTION NO. 95- 415, GENERAL 109 RECORDED JANUARY 3, 1996 AT RECEPTION NO. 96001104 AND RESOLUTION NO. 96-446, GENERAL -123 RECORDED DECEMBER 20, 1996 AT RECEPTION NO. 96156842.
 - vii. (TC#16) THE PROPERTY MAY BE SUBJECT TO TERMS, AGREEMENTS, PROVISIONS, CONDITIONS AND OBLIGATIONS AS CONTAINED IN RESOLUTION NO. 04- 119 (LORSON RANCH AT JIMMY CAMP SKETCH PLAN APPROVAL) RECORDED APRIL 6, 2011 AT RECEPTION NO. 204055084 AND AMENDMENT RECORDED JANUARY 29, 2014 AT RECEPTION NO. 214007624.
 - viii. (TC#17) THE PROPERTY MAY BE SUBJECT TO TERMS, CONDITIONS, PROVISIONS, AGREEMENTS AND OBLIGATIONS CONTAINED IN THE RESOLUTION NO. 04-366 (CONSOLIDATED SERVICE PLAN FOR LORSON RANCH METROPOLITAN DISTRICT NOS. 1-7) RECORDED ON SEPTEMBER 3, 2004 AT RECEPTION NO. 204150548, AMENDED SERVICE PLAN - RESOLUTION NO. 07-233 RECORDED JULY 17, 2007 AT RECEPTION NO. 207095523.
 - ix. (TC#18) THE PROPERTY MAY BE SUBJECT TO ANY ASSESSMENT OR LIEN OF LORSON RANCH METROPOLITAN DISTRICT NO. 3, AS DISCLOSED BY THE ORDER AND DECREE RECORDED ON DECEMBER 28, 2004 AT RECEPTION NO. 204209874 AND AS AMENDED BY INSTRUMENTS RECORDED APRIL 21, 2005 AT RECEPTION NO. 205056110, RECEPTION NO. 205056116, RECORDED JUNE 17, 2015 AT RECEPTION NO. 215062852, RECORDED MAY 26, 2016 AT RECEPTION NO. 216056939, RECORDED JULY 11, 2017 AT RECEPTION NO. 217080960, RECORDED SEPTEMBER 11, 2017 AT RECEPTION NO. 217109165.
 - x. (TC#19) THE PROPERTY MAY BE SUBJECT TO ANY ASSESSMENT OR LIEN OF LORSON RANCH METROPOLITAN DISTRICT NO. 4, AS DISCLOSED BY THE ORDER AND DECREE RECORDED ON DECEMBER 28, 2004 AT RECEPTION NO. 204209875 AND AS AMENDED BY INSTRUMENTS RECORDED APRIL 21, 2005 AT RECEPTION NO. 205056111, AT RECEPTION NO. 205056117, RECORDED JULY 11, 2017 AT RECEPTION NO. 217080960.
 - xi. (TC#20) THE PROPERTY MAY BE SUBJECT TO TERMS, CONDITIONS, PROVISIONS, AGREEMENTS AND OBLIGATIONS CONTAINED IN THE INCLUSION & SERVICE AGREEMENT BETWEEN WIDEFIELD WATER & SANITATION DISTRICT AND LORSON LLC RECORDED ON MAY 31, 2005 AT RECEPTION NO. 205078708.
 - xii. (TC#21) THE PROPERTY MAY BE SUBJECT TO TERMS, CONDITIONS, PROVISIONS, AGREEMENTS AND OBLIGATIONS CONTAINED IN THE DEVELOPMENT AGREEMENT NO. 1 - LORSON RANCH RECORDED ON AUGUST 19, 2005 AT RECEPTION NO. 205128925. NOTE: RESOLUTION NO. 05-336 TO APPROVE A DEVELOPMENT AGREEMENT RECORDED AUGUST 24, 2005 AT RECEPTION NO. 205131973 AND CORRECTION RESOLUTION RECORDED AUGUST 25, 2005 AT RECEPTION NO. 205132869, RESOLUTION NO. 05-336 RECORDED SEPTEMBER 11, 2007 AT RECEPTION NO. 207118189, RESOLUTION NO. 08-228 RECORDED MAY 20, 2008 AT RECEPTION NO. 208057388, RESOLUTION NO. 09-115 RECORDED APRIL 8, 2009 AT RECEPTION NO. 209035762, RESOLUTION NO. 10- 473 RECORDED NOVEMBER 19, 2010 AT RECEPTION NO. 210117602.
 - xiii. (TC#22) THE PROPERTY MAY BE SUBJECT TO 22. THE EFFECT OF THE LORSON RANCH OVERALL DEVELOPMENT AND PHASING PLAN MAPS RECORDED MARCH 9, 2006 AT RECEPTION NO. 206035127 AND DECEMBER 28, 2006 AT RECEPTION NO. 206187069.
 - xiv. (TC#23) THE PROPERTY MAY BE SUBJECT TO TERMS, AGREEMENTS, PROVISIONS, CONDITIONS AND OBLIGATIONS AS CONTAINED IN RESOLUTION NO. 06- 165 (APPROVAL PRELIM PLAN) RECORDED JUNE 1, 2006 AT RECEPTION NO. 206080469.
 - xv. (TC#24) THE PROPERTY MAY BE SUBJECT TO TERMS, AGREEMENTS, PROVISIONS, CONDITIONS AND OBLIGATIONS AS CONTAINED IN RESOLUTION NO. 06- 164 (REZONE) RECORDED JUNE 12, 2006 AT RECEPTION NO. 206086499.

GENERAL PLAT NOTES: (CONT.)

- xvi. (TC#25) THE PROPERTY MAY BE SUBJECT TO TERMS, CONDITIONS, PROVISIONS, AGREEMENTS AND OBLIGATIONS CONTAINED IN THE DITCH RELOCATION, IMPROVEMENT AND EASEMENT AGREEMENT RECORDED ON AUGUST 8, 2006 AT RECEPTION NO. 206127024. QUIT CLAIM DEEDS FROM FOUNTAIN MUTUAL IRRIGATION COMPANY RECORDED SEPTEMBER 28, 2006 AT RECEPTION NO. 206143884, AT RECEPTION NO. 206143885 AND AT RECEPTION NO. 206143886 PURPORT TO RELINQUISH THE EXISTING EASEMENT TO THE PRESENT PROPERTY OWNERS.
- xvii. (TC#26) THE PROPERTY MAY BE SUBJECT TO TERMS, CONDITIONS, PROVISIONS, AGREEMENTS AND OBLIGATIONS CONTAINED IN THE SANITARY SEWER EASEMENT AGREEMENT RECORDED MAY 14, 2008 AT RECEPTION NO. 2080555334.
- xviii. (TC#27) THE PROPERTY MAY BE SUBJECT TO TERMS, CONDITIONS, PROVISIONS, AGREEMENTS AND OBLIGATIONS CONTAINED IN THE RESOLUTION NO. 05-526 (REZONE) RECORDED ON NOVEMBER 5, 2008 AT RECEPTION NO. 208120452.
- xix. (TC#28) THE PROPERTY MAY BE SUBJECT TO TERMS, CONDITIONS, PROVISIONS, AGREEMENTS AND OBLIGATIONS CONTAINED IN THE WATER AND SANITARY SEWER EASEMENT AGREEMENT RECORDED DECEMBER 9, 2009 AT RECEPTION NO. 209141033. VACATION OF PORTION OF EASEMENT RECORDED DECEMBER 7, 2015 AT RECEPTION NO. 215131277.
- xx. (TC#29) THE PROPERTY MAY BE SUBJECT TO TERMS, CONDITIONS, PROVISIONS, AGREEMENTS AND OBLIGATIONS CONTAINED IN THE WATER AND SANITARY SEWER EASEMENT AGREEMENT RECORDED DECEMBER 9, 2009 AT RECEPTION NO. 209141043. VACATION OF PORTION OF EASEMENT RECORDED FEBRUARY 20, 2013 AT RECEPTION NO. 213022819.
- xxi. (TC#30) THE PROPERTY MAY BE SUBJECT TO TERMS, AGREEMENTS, PROVISIONS, CONDITIONS, OBLIGATIONS AND EASEMENTS AS CONTAINED IN WATER AND SANITARY SEWER EASEMENT AGREEMENT, RECORDED DECEMBER 9, 2009 AT RECEPTION NO. 209141153.
- xxii. (TC#31) THE PROPERTY MAY BE SUBJECT TO TERMS, AGREEMENTS, PROVISIONS, CONDITIONS, OBLIGATIONS AND EASEMENTS AS CONTAINED IN WATER AND SANITARY SEWER EASEMENT AGREEMENT, RECORDED DECEMBER 9, 2009 AT RECEPTION NO. 209141158.
- xxiii. (TC#32) THE PROPERTY MAY BE SUBJECT TO TERMS, AGREEMENTS, PROVISIONS, CONDITIONS, OBLIGATIONS AND EASEMENTS AS CONTAINED IN WATER AND SANITARY SEWER EASEMENT AGREEMENT, RECORDED DECEMBER 9, 2009 AT RECEPTION NO. 209141164.
- xxiv. (TC#33) THE PROPERTY MAY BE SUBJECT TO TERMS, CONDITIONS, PROVISIONS, AGREEMENTS AND OBLIGATIONS CONTAINED IN THE DEVELOPMENT AGREEMENT NO. 2 RECORDED MARCH 22, 2010 AT RECEPTION NO. 210025931 AND RE-RECORDED APRIL 20, 2010 AT RECEPTION NO. 210036301. RESOLUTION NO. 10-94 TO REVISE DEVELOPMENT AGREEMENT NO. 2 RECORDED OCTOBER 12, 2010 AT RECEPTION NO. 210101176.
- xxv. (TC#34) THE PROPERTY MAY BE SUBJECT TO TERMS, CONDITIONS, PROVISIONS, AGREEMENTS AND OBLIGATIONS CONTAINED IN THE RESOLUTION NO. 12-200 RECORDED JUNE 18, 2012 AT RECEPTION NO. 212069857.
- xxvi. (TC#35) THE PROPERTY MAY BE SUBJECT TO TERMS, CONDITIONS, PROVISIONS, AGREEMENTS AND OBLIGATIONS CONTAINED IN THE MINERAL QUITCLAIM DEEDS RECORDED NOVEMBER 16, 2012 AT RECEPTION NO. 212137045, AT RECEPTION NO. 212137046, AT RECEPTION NO. 212137047, AT RECEPTION NO. 212137051, AT RECEPTION NO. 212137058, AT RECEPTION NO. 212137059AND RECORDED DECEMBER 5, 2012 AT RECEPTION NO. 212145159.
- xxvii. (TC#36) THE PROPERTY MAY BE SUBJECT TO TERMS, AGREEMENTS, PROVISIONS, CONDITIONS, OBLIGATIONS AND EASEMENTS AS CONTAINED IN DRAINAGE EASEMENT, RECORDED APRIL 23, 2013 AT RECEPTION NO. 213052476.
- xxviii. (TC#37) THE PROPERTY MAY BE SUBJECT TO ANY ASSESSMENT OR LIEN OF SECURITY FIRE PROTECTION DISTRICT AS DISCLOSED BY THE INSTRUMENT RECORDED JULY 31, 2013 AT RECEPTION NO. 213098578 AND AS AMEND BY INSTRUMENT RECORDED NOVEMBER 20, 2013 AT RECEPTION NO. 213140853.
- xxix. (TC#38) THE PROPERTY MAY BE SUBJECT TO TERMS, AGREEMENTS, PROVISIONS, CONDITIONS AND OBLIGATIONS AS CONTAINED IN RESOLUTION NO. 18- 038 RECORDED JANUARY 24, 2018 AT RECEPTION NO. 218009074 AND LORSON RANCH EAST PUD DEVELOPMENT & PRELIMINARY PLAN RECORDED FEBRUARY 15, 2018 AT RECEPTION NO. 218018251.
- xxx. (TC#39) THE PROPERTY MAY BE SUBJECT TO TERMS, AGREEMENTS, PROVISIONS, CONDITIONS AND OBLIGATIONS AS CONTAINED IN RULES AND REGULATIONS GOVERNING THE ENFORCEMENT OF THE COVENANTS, CONDITIONS AND RESTRICTIONS OF LORSON RANCH, NOT RECORDED, BUT HEREIN KNOWN AS DOCUMENT NO. LORSONMETRO.
- xxxi. (TC#40) THE PROPERTY MAY BE SUBJECT TO TERMS, AGREEMENTS, PROVISIONS, CONDITIONS, OBLIGATIONS AND EASEMENTS AS CONTAINED IN RESOLUTION NO. 19-51, RECORDED FEBRUARY 13, 2019 AT RECEPTION NO. 219015418.
- xxxii. (TC#41) THE PROPERTY MAY BE SUBJECT TO TERMS, AGREEMENTS, PROVISIONS, CONDITIONS, OBLIGATIONS AND EASEMENTS AS CONTAINED IN PUD DEVELOPMENT AND PRELIMINARY PLAN RECORDED FEBRUARY 27, 2019 AT RECEPTION NO. 219020279.
- xxxiii. (TC#42) THE PROPERTY MAY BE SUBJECT TO TERMS, AGREEMENTS, PROVISIONS, CONDITIONS, OBLIGATIONS AND EASEMENTS AS CONTAINED IN DITCH CROSSING AGREEMENT, RECORDED MARCH 6, 2019 AT RECEPTION NO. 219023135.
- xxxiv. (TC#43) THE PROPERTY MAY BE SUBJECT TO TERMS, AGREEMENTS, PROVISIONS, CONDITIONS, OBLIGATIONS AND EASEMENTS AS CONTAINED IN SANITARY SEWER EASEMENT AGREEMENT, RECORDED MARCH 27, 2019 AT RECEPTION NO. 219031048.
4. ALL STRUCTURAL FOUNDATIONS SHALL BE LOCATED AND DESIGNED BY A PROFESSIONAL ENGINEER, CURRENTLY REGISTERED IN THE STATE OF COLORADO.
5. UNDERDRAIN MAINTENANCE SHALL BE THE RESPONSIBILITY OF LORSON RANCH METROPOLITAN DISTRICT NO. 1.
6. THE FOLLOWING REPORTS HAVE BEEN SUBMITTED AND ARE ON FILE AT THE EL PASO COUNTY PLANNING AND COMMUNITY DEVELOPMENT DEPARTMENT: PRELIMINARY PLAN FILE NUMBER PUDSP-16-003, SOILS AND GEOLOGICAL STUDY, DRAINAGE REPORT, WATER RESOURCES REPORT, FIRE PROTECTION REPORT, NATURAL FEATURES REPORT, PERCOLATION TEST RESULTS, EROSION CONTROL REPORT AND TRAFFIC IMPACT ANALYSIS.
7. ALL DEVELOPMENT (WITHIN "LORSON RANCH EAST FILING NO. 2" SHALL COMPLY WITH THE PUD DEVELOPMENT GUIDELINES ON FILE FOR LORSON RANCH EAST PLANNED UNIT DEVELOPMENT GUIDELINES, AS RECORDED AT RECEPTION NO. 218018251, OF THE RECORDS OF THE EL PASO COUNTY CLERK AND RECORDER, OR OTHERWISE AMENDED BY EL PASO COUNTY FOLLOWING APPROPRIATE PUBLIC HEARINGS.
8. NO STRUCTURES WITH PERMANENT FOUNDATIONS OR MATERIAL STORAGE ACTIVITIES ARE PERMITTED WITHIN DESIGNATED DRAINAGE EASEMENTS, FLOODPLAIN, OR PARK AND OPEN SPACE AREAS. FENCES SHALL NOT IMPEDE RUNOFF FROM REACHING DRAINAGE SWALES.

GENERAL PLAT NOTES: (CONT.)

9. THE ADDRESSES EXHIBITED ON THIS PLAT ARE FOR INFORMATIONAL PURPOSES ONLY. THEY ARE NOT THE LEGAL DESCRIPTION AND ARE SUBJECT TO CHANGE.
10. SIGHT TRIANGLE/NO-BUILD AREAS AS SHOWN SHALL BE MAINTAINED AT THE INTERSECTIONS. NO OBSTRUCTION GREATER THAN 18" IN HEIGHT IS ALLOWED IN THESE AREAS.
11. ALL PROPERTY OWNERS ARE RESPONSIBLE FOR MAINTAINING PROPER STORM WATER DRAINAGE IN AND THROUGH THEIR PROPERTY.
12. MAILBOXES SHALL BE INSTALLED IN ACCORDANCE WITH ALL EL PASO COUNTY DEPARTMENT OF PUBLIC WORKS AND UNITED STATES POSTAL SERVICE REGULATIONS.
13. NO LOT OR INTEREST THEREIN, SHALL BE SOLD, CONVEYED OR TRANSFERRED WHETHER BY DEED OR BY CONTRACT, NOR SHALL BUILDING PERMITS BE ISSUED, UNTIL AND UNLESS THE REQUIRED PUBLIC IMPROVEMENTS HAVE BEEN CONSTRUCTED AND COMPLETED IN ACCORDANCE WITH THE SUBDIVISION IMPROVEMENTS AGREEMENT BETWEEN THE APPLICANT AND EL PASO COUNTY AS RECORDED UNDER RECEPTION NO. _____ OF THE RECORDS OF THE EL PASO COUNTY CLERK AND RECORDER, OR IN THE ALTERNATIVE, OTHER COLLATERAL IS PROVIDED WHICH IS SUFFICIENT IN THE JUDGMENT OF THE BOARD OF COUNTY COMMISSIONERS, TO MAKE PROVISION FOR THE COMPLETION OF SAID IMPROVEMENTS.
14. THE DECLARATION OF COVENANTS, CONDITIONS AND RESTRICTIONS FOR "LORSON RANCH EAST FILING NO. 1, HOMEOWNERS ASSOCIATION, INC. IS RECORDED UNDER RECEPTION NO. _____ OF THE RECORDS OF THE EL PASO COUNTY CLERK AND RECORDER.
15. THE PROPERTY IS SUBJECT TO TERMS, AGREEMENTS, PROVISIONS, CONDITIONS, OBLIGATIONS, AND EASEMENTS AS CONTAINED IN PRIVATE DETENTION BASIN/ STORMWATER QUALITY BEST MANAGEMENT PRACTICE MAINTENANCE AGREEMENT AND EASEMENT RECORDED UNDER RECEPTION NO. _____.
16. BUILDING SETBACKS SHALL BE IN ACCORDANCE WITH LORSON RANCH EAST FILING NO. 1, PLANNED UNIT DEVELOPMENT GUIDELINES AND DESIGN GUIDELINES RECORDED AT RECEPTION NO. 218018251.
17. DEVELOPER SHALL COMPLY WITH FEDERAL AND STATE LAWS, REGULATIONS, ORDINANCES, REVIEW AND PERMIT REQUIREMENTS, AND OTHER AGENCY REQUIREMENTS, IF ANY, OF APPLICABLE AGENCIES INCLUDING, BUT NOT LIMITED TO, THE COLORADO DEPARTMENT OF PARKS AND WILDLIFE, COLORADO DEPARTMENT OF TRANSPORTATION, U.S. ARMY CORP. OF ENGINEERS, THE U.S. FISH AND WILDLIFE SERVICE AND/ OR COLORADO DEPARTMENT OF WILDLIFE REGARDING THE ENDANGERED SPECIES ACT, AS IT RELATES TO THE LISTED SPECIES.
18. EL PASO COUNTY PLANNING AND COMMUNITY DEVELOPMENT DEPARTMENT ENGINEERING MUST BE CONTACTED PRIOR TO THE ESTABLISHMENT OF ANY DRIVEWAY.
19. THE PROPERTY IS SUBJECT TO THE FOLLOWING DEVELOPMENT AGREEMENTS:
 - A. DEVELOPMENT AGREEMENT NO. 1 RECEPTION NO. 205128925 AS APPROVED BY RESOLUTION NO. 05-336, RECEPTION NO. 205131973 AS CORRECTED - RECEPTION NO. 205132869.
 - B. DEVELOPMENT AGREEMENT NO. 2 RECEPTION NO.210025931, RE-RECORDED RECEPTION NO. 210036301.
 - C. DEVELOPMENT AGREEMENT NO. 3 APPROVED 12/10/2011, NO RECORDING INFORMATION FOUND.
 - D. DEVELOPMENT AGREEMENT NO. 4, RESOLUTION NO. 12-196, RECEPTION NO. 212090407.
 - E. DEVELOPMENT AGREEMENT NO. 5 RECEPTION NO. 214007624.
 - F. DEVELOPMENT AGREEMENT NO. 6 CONTRACT 2015-091a 3/3/2015
 - G. SCHOOL SITE DEDICATION AGREEMENT RECEPTION NO. 212047863.
20. PURSUANT TO RESOLUTION NO. 12-382, APPROVED BY THE BOARD OF DIRECTORS, EL PASO COUNTY PUBLIC IMPROVEMENT DISTRICT 2 AND RECORDED IN THE RECORDS OF THE EL PASO COUNTY CLERK AND RECORDER AT RECEPTION NUMBER 212136575, THE PARCELS WITHIN THE PLATTED BOUNDARIES OF "LORSON RANCH EAST FILING NO. 2" ARE INCLUDED WITHIN THE BOUNDARIES OF THE EL PASO COUNTY PUBLIC IMPROVEMENT DISTRICT 2 AND AS SUCH IS SUBJECT TO APPLICABLE ROAD IMPACT FEES AND MILL LEVY.

3. A 'Soils and Geology Report for Creekside at Lorson Ranch Filing 1, El Paso County, Colorado' was completed by Rocky Mountain Group (RMG) on August 10, 2018 and revised on October 16, 2018. There are no significant geological hazards; however, the potential for geologic hazards or constraints do exist related to the potential for expansive or hydrocompactive soils. The geologic conditions are considered relatively common to the immediate area and mitigation can be accomplished by implementing common engineering and construction practices.

4. Site specific subsurface soil investigations shall be conducted prior to construction on all lots. In addition to providing anticipated foundation design recommendations, these investigations should also consider lot-specific recommendations relating to the following geologic conditions:

- a. Mitigation for loose and/ or expansive soil conditions (if encountered), and
- b. Potential shallow groundwater conditions and feasibility of underslab drains.

5. At a minimum, separate subsurface perimeter drains should be provided around the below-grade (habitable) portions of each foundation. Additional drainage measures may also be required as determined by the lot-specific subsurface soil investigation and/ or the lot-specific excavation observation performed at the time of construction.

Soil and Geology Conditions:
Geologic Hazard Note-Final Plat: (to be customized based upon the individual circumstances)
The following lots have been found to be impacted by geologic hazards. Mitigation measures and a map of the hazard area can be found in the report (Title of Report, generally from the Preliminary Plan file) by (author of the report) (date of report) in file (name of file and file number) available at the El Paso County Planning and Community Development Department:
•Downslope Creep: (name lots or location of area)
•Rockfall Source: (name lots or location of area)
•Rockfall Runout Zone: (name lots or location of area)
•Potentially Seasonally High Groundwater: (name lots or location of area)
•Other Hazard:
In Areas of High Groundwater:
Due to high groundwater in the area, all foundations shall incorporate an underground drainage system.

CUSTOMIZE this Note Please add Lot nos.

CREEKSIDE AT LORSON RANCH FILING NO. 1
PUD Development - # Preliminary Plan
FILED UNDER THE 2019 REVISED STATUTES OF THE STATE OF COLORADO, EL PASO COUNTY, COLORADO



NO- This is Creekside- Please correct

FINAL PLAT
CREEKSIDE AT LORSON RANCH
FILING NO. 1
JOB NO. 70-068
DATE PREPARED: 05/15/2019
DATE REVISED:




102 E. PIKES PEAK AVE., 5TH FLOOR
COLORADO SPRINGS, CO 80903
PHONE: 719.955.5485

LEGEND:

- SF SQUARE FEET
- (R) RADIAL
- (xxxx) ADDRESS
- CH CHORD
- CH L CHORD LENGTH
- SET ORANGE PLASTIC SURVEYORS CAP ON NO. 4 REBAR, CAP IS STAMPED "M&S CIVIL PLS 25966"
- FOUND ORANGE PLASTIC SURVEYORS CAP ON NO. 5 REBAR, CAP IS STAMPED "PLS 25966"
- FOUND MONUMENT AS NOTED

- BOUNDARY LINE
- PROPERTY LINE
- RIGHT OF WAY LINE
- CENTERLINE
- - - EASEMENT LINE
- - - ADJACENT SUBDIVISION LINE
- - - ADJACENT PROPERTY LINE
- - - EXISTING RIGHT OF WAY LINE
- - - EXISTING CENTERLINE
- - - EXISTING EASEMENT
- - - SECTION/QUARTER SECTION LINE
- - - MATCHLINE


NOT A PART PARCELS INDICATED WITH ASTERISK "*" ARE NOT A PART OF THIS SUBDIVISION

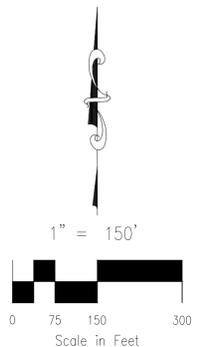


CREEKSIDE AT LORSON RANCH FILING NO. 1

A PORTION OF THE SW 1/4 SECTION 13, AND OF THE NE 1/4 SECTION 23, AND OF THE NW 1/4 SECTION 24, ALL IN TOWNSHIP 15 SOUTH, RANGE 65 WEST OF THE SIXTH PRINCIPAL MERIDIAN, EL PASO COUNTY, COLORADO

CREEKSIDE FILING NO. 1
TOTAL AREA = 3,619,292 S.F.
83.088 AC +/-

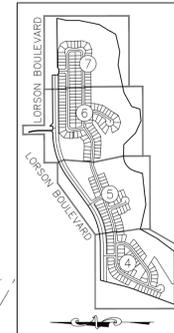

SHEET INDEX
NOT TO SCALE

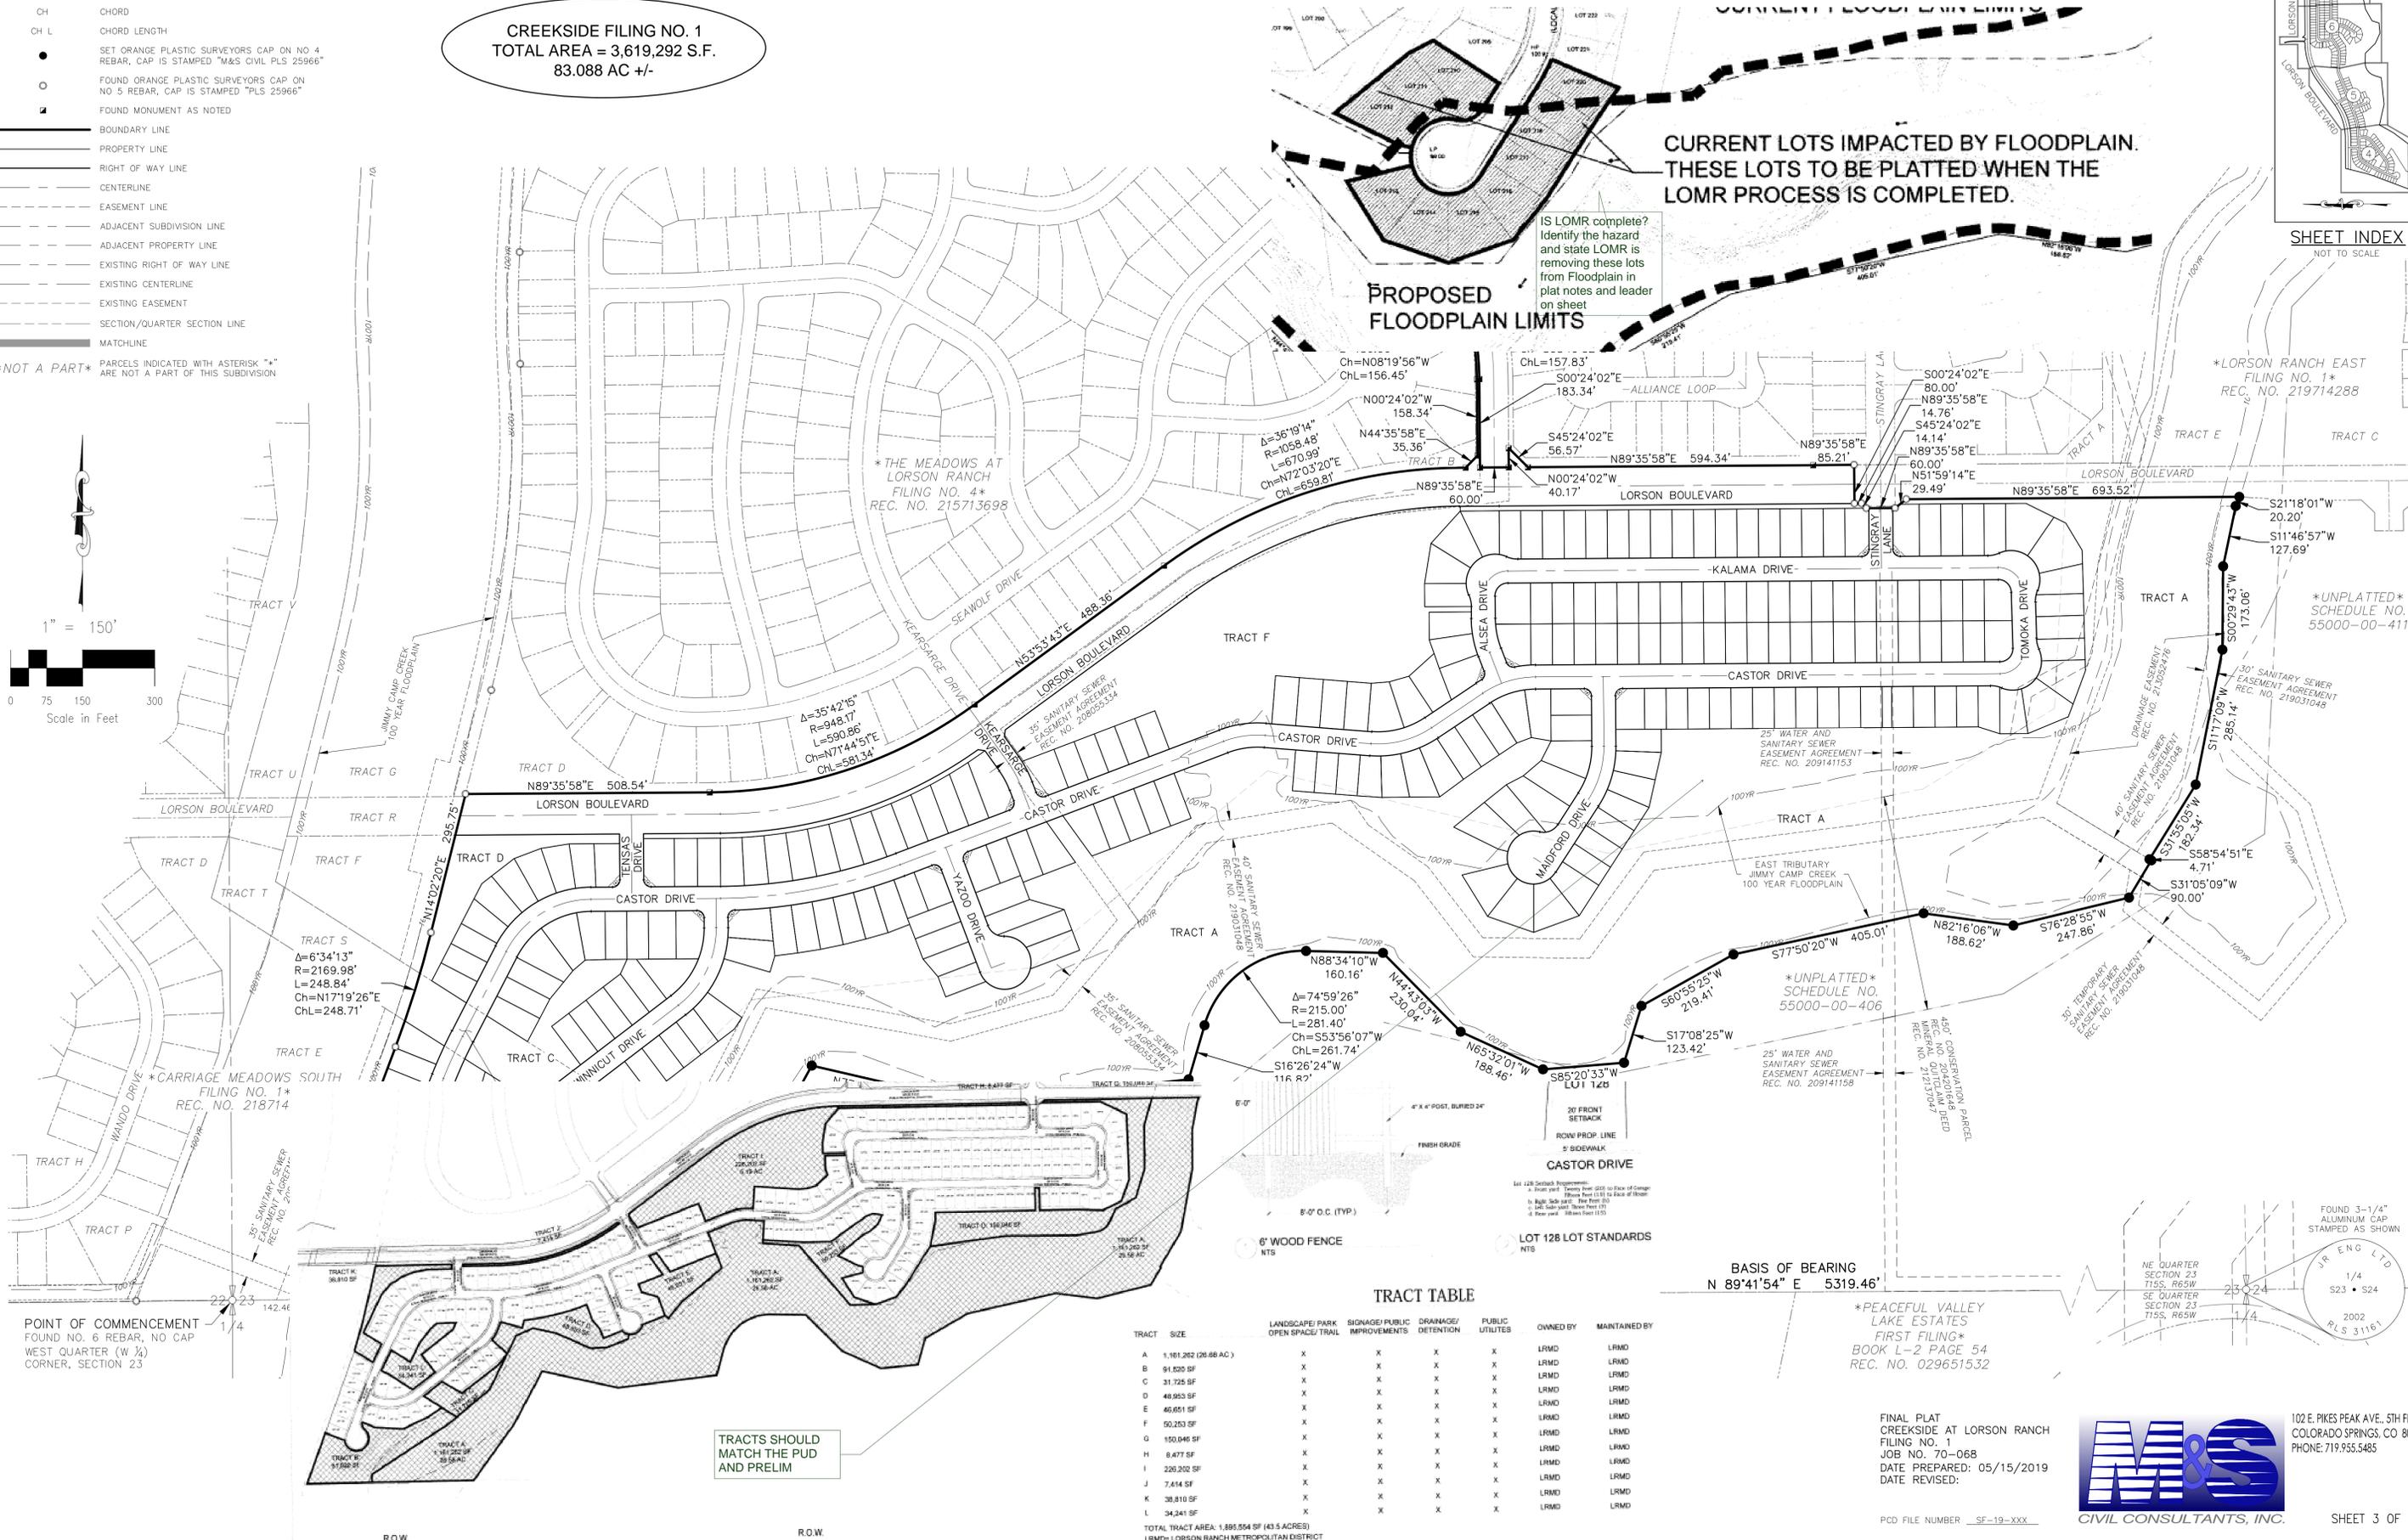

TRACT TABLE

TRACT	SIZE	LANDSCAPE/PARK OPEN SPACE/TRAIL	SIGNAGE/PUBLIC IMPROVEMENTS	DRAINAGE/PUBLIC DETENTION	PUBLIC UTILITIES	OWNED BY	MAINTAINED BY
A	1,161,262 (26.68 AC)	X	X	X	X	LRMD	LRMD
B	91,620 SF	X	X	X	X	LRMD	LRMD
C	31,725 SF	X	X	X	X	LRMD	LRMD
D	48,953 SF	X	X	X	X	LRMD	LRMD
E	46,651 SF	X	X	X	X	LRMD	LRMD
F	50,253 SF	X	X	X	X	LRMD	LRMD
G	150,046 SF	X	X	X	X	LRMD	LRMD
H	6,477 SF	X	X	X	X	LRMD	LRMD
I	225,202 SF	X	X	X	X	LRMD	LRMD
J	7,414 SF	X	X	X	X	LRMD	LRMD
K	38,810 SF	X	X	X	X	LRMD	LRMD
L	34,241 SF	X	X	X	X	LRMD	LRMD

TOTAL TRACT AREA: 1,895,954 SF (43.5 ACRES)
LRMD= LORSON RANCH METROPOLITAN DISTRICT
X DENOTES PERMITTED USE WITHIN DESIGNATED TRACTS

PEACEFUL VALLEY LAKE ESTATES
FIRST FILING*
BOOK L-2 PAGE 54
REC. NO. 029651532

FINAL PLAT
CREEKSIDE AT LORSON RANCH
FILING NO. 1
JOB NO. 70-068
DATE PREPARED: 05/15/2019
DATE REVISED:




102 E. PIKES PEAK AVE., 5TH FLOOR
COLORADO SPRINGS, CO 80903
PHONE: 719.955.5485


File: C:\70068A\Creekside\Creekside at Lorson F1 (Long)\Survey\Plot\70-068 Creekside Final Plat.dwg Plotstamp: 5/15/2019 10:40 AM

CREEKSIDE AT LORSON RANCH FILING NO. 1

A PORTION OF THE SW 1/4 SECTION 13, AND OF THE NE 1/4 SECTION 23, AND OF THE NW 1/4 SECTION 24, ALL IN TOWNSHIP 15 SOUTH, RANGE 65 WEST OF THE SIXTH PRINCIPAL MERIDIAN, EL PASO COUNTY, COLORADO

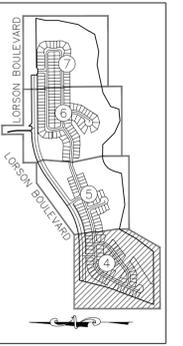

SHEET INDEX
NOT TO SCALE

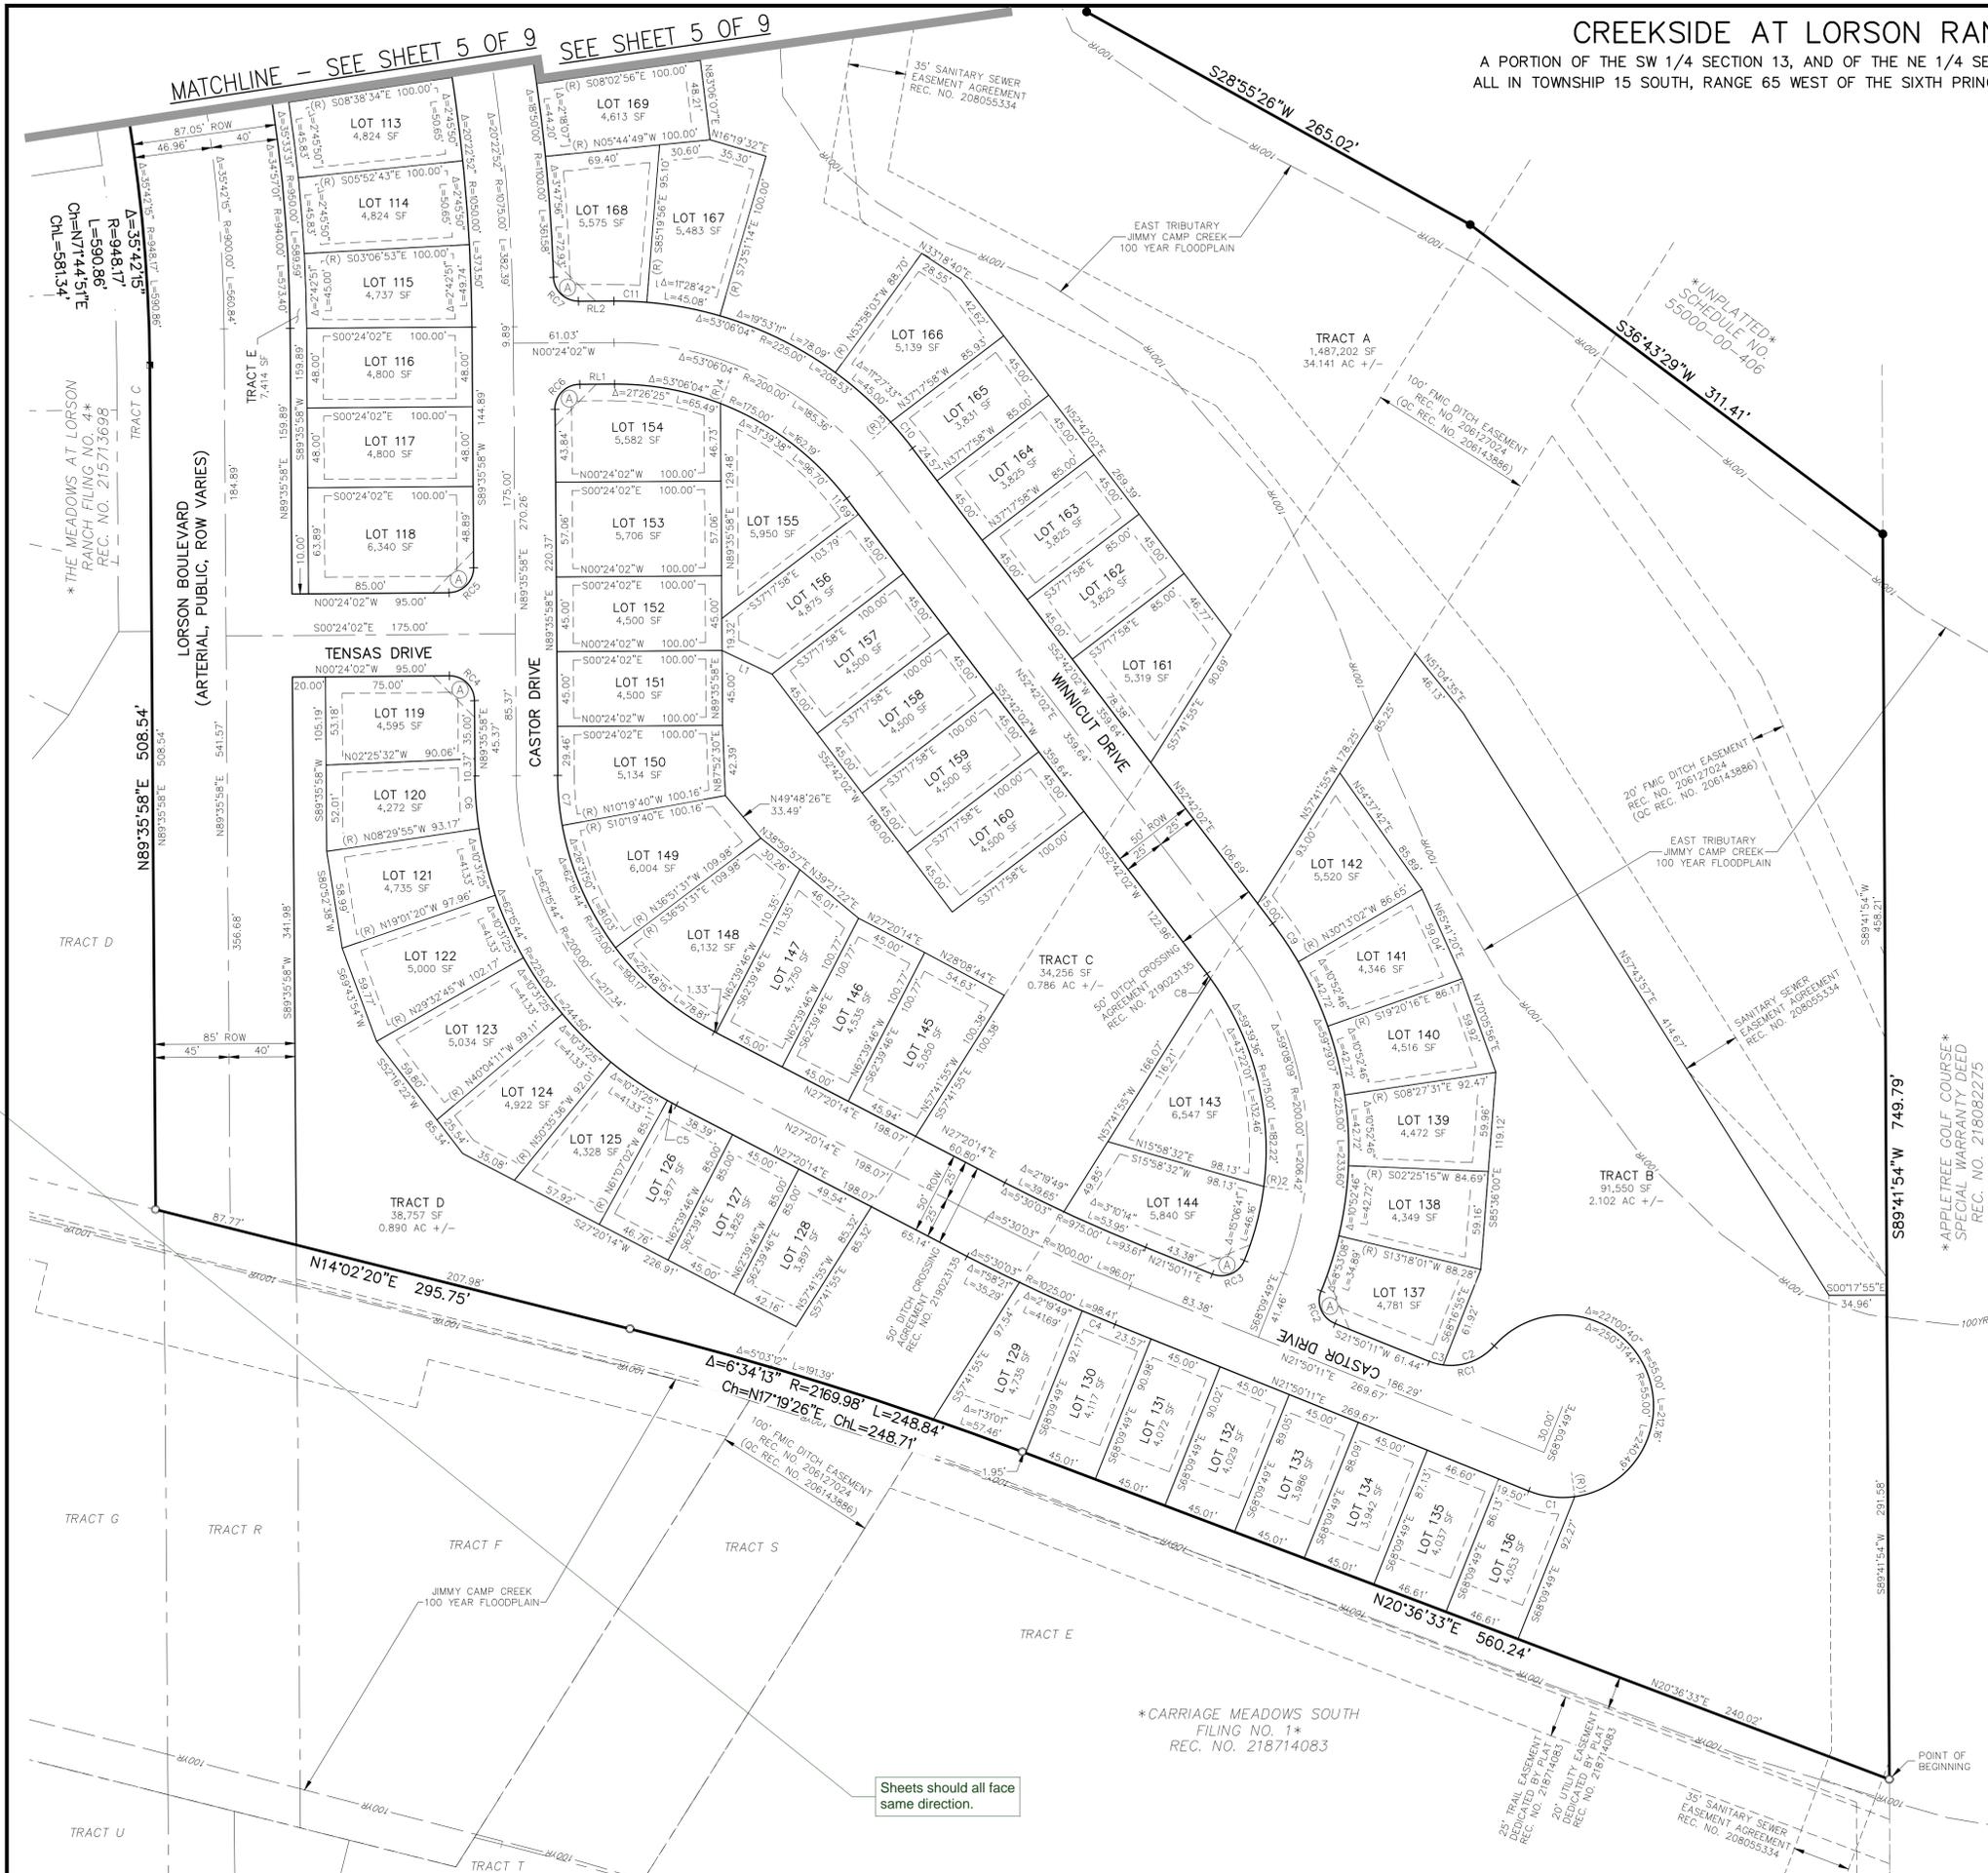

LOT & TRACT LINE TABLE		
LINE #	DISTANCE	BEARING
L1	33.32	S25°12'00"W


RIGHT-OF-WAY LINE TABLE		
LINE #	DISTANCE	BEARING
RL1	21.03	S00°24'02"E
RL2	21.44	S00°24'02"E

LOT & TRACT CURVE TABLE			
CURVE #	RADIUS	DELTA	LENGTH
C1	55.00	29°31'03"	28.33
C2	35.00	56°28'43"	34.50
C3	35.00	14°03'00"	8.58
C4	1025.00	1°11'52"	21.43
C5	225.00	1°32'44"	6.07
C6	225.00	8°05'53"	31.80
C7	175.00	9°55'38"	30.32
C8	175.00	1°10'54"	3.61
C9	225.00	7°04'56"	27.81
C10	225.00	5°12'32"	20.46
C11	225.00	5°04'05"	19.90

RIGHT-OF-WAY CURVE TABLE			
CURVE #	RADIUS	DELTA	LENGTH
RC1	35.00	70°31'44"	43.08
RC2	15.00	90°20'58"	23.65
RC3	15.00	89°28'33"	23.42
RC4	15.00	90°00'00"	23.56
RC5	15.00	90°00'00"	23.56
RC6	15.00	90°00'00"	23.56
RC7	15.00	88°27'09"	23.16

RADIAL BEARING TABLE	
LINE #	BEARING
(R)1	N82°19'08"E
(R)2	S07°14'57"W
(R)3	N42°30'30"W
(R)4	N68°57'36"W

- LEGEND:**
- SF SQUARE FEET
 - (R) RADIAL
 - (xxxx) ADDRESS
 - CH CHORD
 - CH L CHORD LENGTH
 - SET ORANGE PLASTIC SURVEYORS CAP ON NO 4 REBAR, CAP IS STAMPED "M&S CIVIL PLS 25966"
 - FOUND ORANGE PLASTIC SURVEYORS CAP ON NO 5 REBAR, CAP IS STAMPED "PLS 25966"
 - FOUND MONUMENT AS NOTED
 - BOUNDARY LINE
 - PROPERTY LINE
 - RIGHT OF WAY LINE
 - CENTERLINE
 - - - EASEMENT LINE
 - - - ADJACENT SUBDIVISION LINE
 - - - ADJACENT PROPERTY LINE
 - - - EXISTING RIGHT OF WAY LINE
 - - - EXISTING CENTERLINE
 - - - EXISTING EASEMENT
 - - - SECTION/QUARTER SECTION LINE
 - MATCHLINE
- *NOT A PART* PARCELS INDICATED WITH ASTERISK "*" ARE NOT A PART OF THIS SUBDIVISION

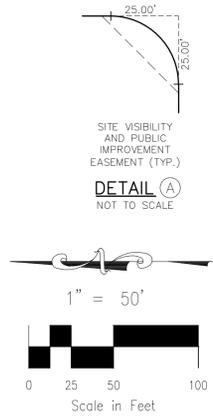

FINAL PLAT
CREEKSIDE AT LORSON RANCH
FILING NO. 1
JOB NO. 70-068
DATE PREPARED: 05/15/2019
DATE REVISED:



102 E. PIKES PEAK AVE., 5TH FLOOR
COLORADO SPRINGS, CO 80903
PHONE: 719.955.5485

File: C:\10068A\Creekside at Lorson Ranch\Final Plat.dwg Plotstamp: 5/15/2019 10:41 AM


Sheets should all face same direction.

CARRIAGE MEADOWS SOUTH FILING NO. 1
REC. NO. 218714083


CREEKSIDE AT LORSON RANCH FILING NO. 1

A PORTION OF THE SW 1/4 SECTION 13, AND OF THE NE 1/4 SECTION 23, AND OF THE NW 1/4 SECTION 24,
ALL IN TOWNSHIP 15 SOUTH, RANGE 65 WEST OF THE SIXTH PRINCIPAL MERIDIAN, EL PASO COUNTY, COLORADO

MATCHLINE - SEE SHEET 6 OF 7

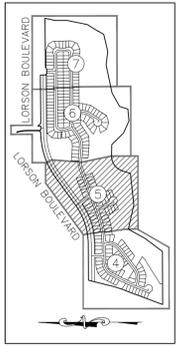

SHEET INDEX
NOT TO SCALE

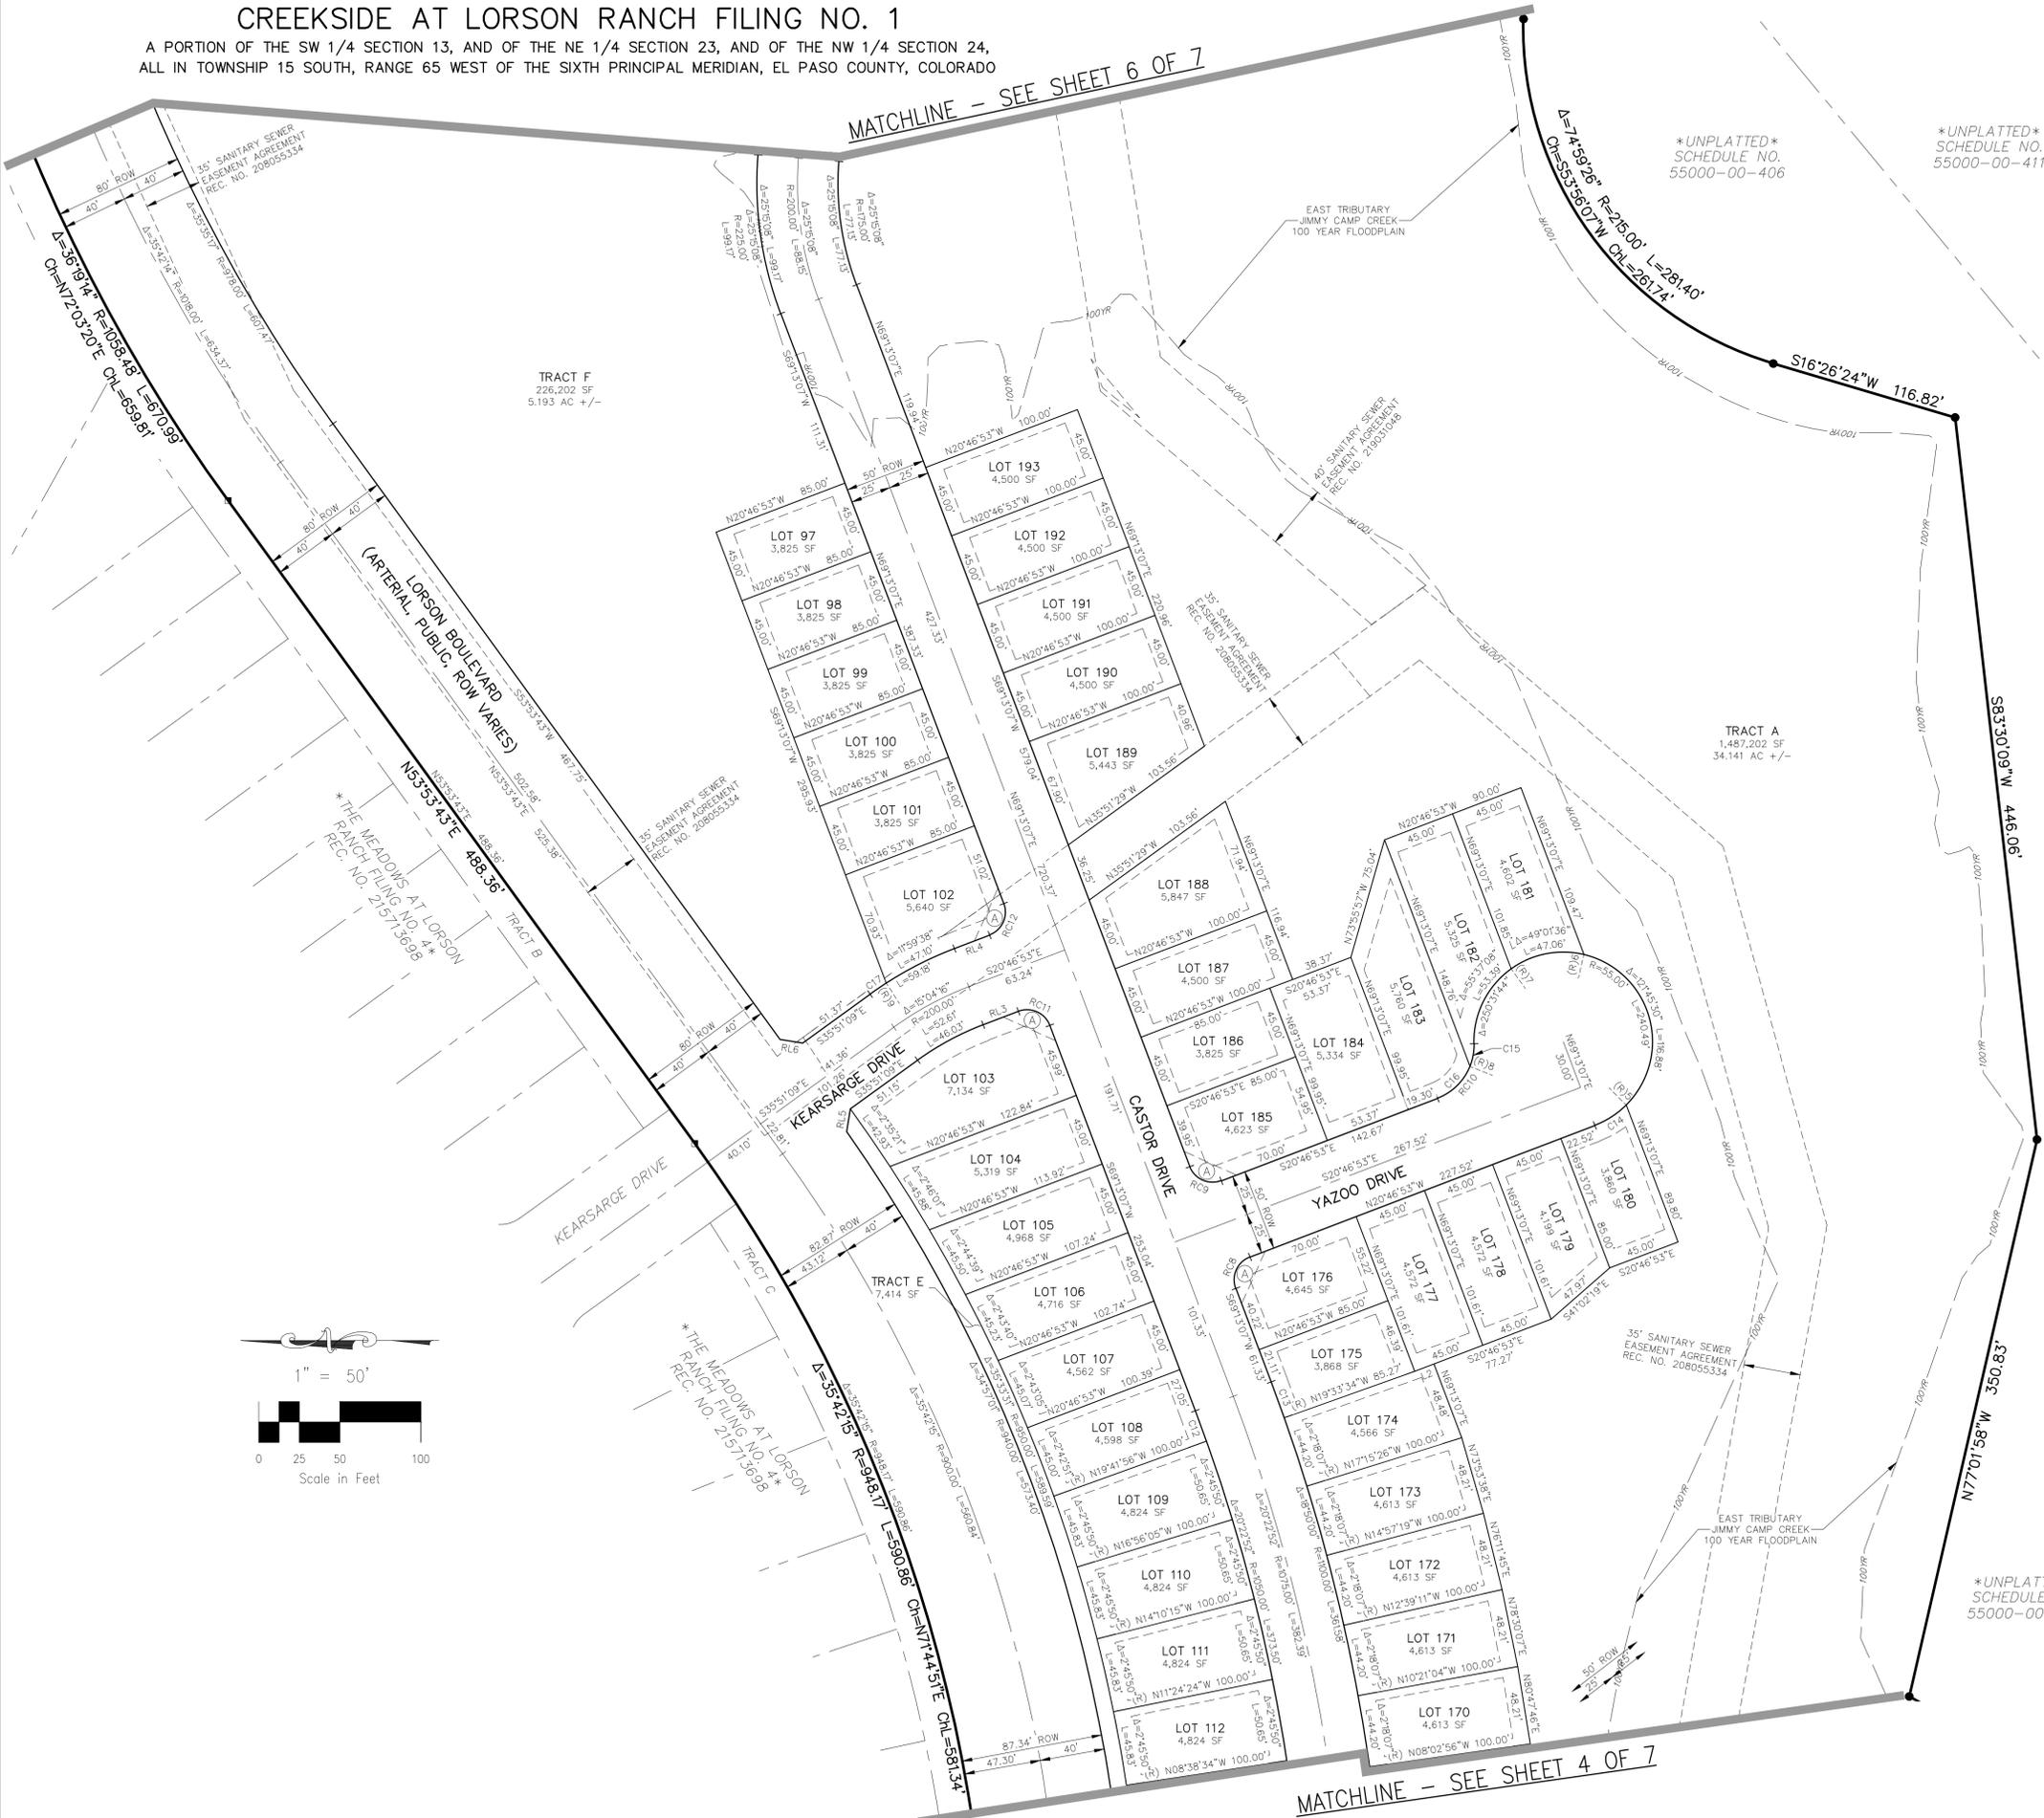



LINE #	BEARING
(R)5	N45°05'38"E
(R)6	N76°39'52"W
(R)7	S54°18'32"W
(R)8	N21°58'06"E
(R)9	S57°13'29"W

LINE #	DISTANCE	BEARING
L2	12.73	S20°46'53"E

LINE #	DISTANCE	BEARING
RL3	23.24	S20°46'53"E
RL4	23.24	S20°46'53"E
RL5	14.17	S80°45'14"E
RL6	14.17	S09°01'16"W

CURVE #	RADIUS	DELTA	LENGTH
C12	1050.00	1°04'57"	19.84
C13	1100.00	1°13'20"	23.46
C14	55.00	24°07'29"	23.16
C15	35.00	23°16'43"	14.22
C16	35.00	47°15'01"	28.86
C17	225.00	3°04'38"	12.08

CURVE #	RADIUS	DELTA	LENGTH
RC8	15.00	90°00'00"	23.56
RC9	15.00	90°00'00"	23.56
RC10	35.00	70°31'44"	43.08
RC11	15.00	90°00'00"	23.56
RC12	15.00	90°00'00"	23.56

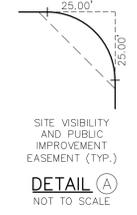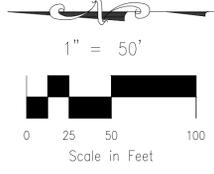

- LEGEND:**
- SF SQUARE FEET
 - (R) RADIAL
 - (xxxx) ADDRESS
 - CH CHORD
 - CH L CHORD LENGTH
 - SET ORANGE PLASTIC SURVEYORS CAP ON NO 4 REBAR, CAP IS STAMPED "M&S CIVIL PLS 25966"
 - FOUND ORANGE PLASTIC SURVEYORS CAP ON NO 5 REBAR, CAP IS STAMPED "PLS 25966"
 - FOUND MONUMENT AS NOTED
 - BOUNDARY LINE
 - PROPERTY LINE
 - RIGHT OF WAY LINE
 - CENTERLINE
 - EASEMENT LINE
 - ADJACENT SUBDIVISION LINE
 - ADJACENT PROPERTY LINE
 - EXISTING RIGHT OF WAY LINE
 - EXISTING CENTERLINE
 - EXISTING EASEMENT
 - SECTION/QUARTER SECTION LINE
 - MATCHLINE
- *NOT A PART* PARCELS INDICATED WITH ASTERISK "*" ARE NOT A PART OF THIS SUBDIVISION

FINAL PLAT
CREEKSIDE AT LORSON RANCH
FILING NO. 1
JOB NO. 70-068
DATE PREPARED: 05/15/2019
DATE REVISED:



102 E. PIKES PEAK AVE., 5TH FLOOR
COLORADO SPRINGS, CO 80903
PHONE: 719.555.5465

File: C:\70068A\CreekSide\CreekSide at Lorson F1\1.dwg Survey\Plot\70-068 CreekSide Final Plat.dwg Plotstamp: 5/15/2019 10:42 AM

CREEKSIDE AT LORSON RANCH FILING NO. 1

A PORTION OF THE SW 1/4 SECTION 13, AND OF THE NE 1/4 SECTION 23, AND OF THE NW 1/4 SECTION 24, ALL IN TOWNSHIP 15 SOUTH, RANGE 65 WEST OF THE SIXTH PRINCIPAL MERIDIAN, EL PASO COUNTY, COLORADO

MATCHLINE - SEE SHEET 7 OF 7

LINE #	DISTANCE	BEARING
L3	11.11	S00°24'02"E
L4	10.00	N00°31'00"W
L5	31.90	S69°50'08"W
L6	20.66	N76°32'28"W


LINE #	DISTANCE	BEARING
RL7	32.20	N21°05'21"W
RL8	32.20	N21°05'21"W
RL9	24.87	N00°24'02"W

CURVE #	RADIUS	DELTA	LENGTH
RC13	225.00	3°06'04"	12.18
RC14	15.00	80°24'21"	21.05
RC15	15.00	80°24'21"	21.05
RC16	225.00	11°05'40"	43.57
RC17	60.00	23°33'23"	24.67
RC18	27.00	90°00'00"	42.41
RC19	60.00	23°33'24"	24.67
RC20	15.00	90°00'00"	23.56
RC21	15.00	90°00'00"	23.56
RC22	35.00	70°31'44"	43.08


CURVE #	RADIUS	DELTA	LENGTH
C18	225.00	5°52'04"	23.04
C19	225.00	0°48'59"	3.21
C20	175.00	1°20'36"	4.10
C21	225.00	1°14'38"	4.88
C22	225.00	7°57'59"	31.28
C23	60.00	23°34'26"	24.69
C24	60.00	34°28'40"	36.11
C25	60.00	14°36'07"	15.29
C26	175.00	3°59'14"	12.18
C27	225.00	2°21'41"	9.27
C28	175.00	7°29'07"	22.86
C29	175.00	11°00'32"	33.62
C30	35.00	49°41'57"	30.36
C31	35.00	20°49'46"	12.72
C32	55.00	27°00'56"	25.93
C33	55.00	18°51'47"	18.11
C34	225.00	2°24'48"	9.48

LINE #	BEARING
(R)10	N85°36'44"E
(R)11	S08°33'15"W
(R)12	S02°45'44"E
(R)13	N07°18'44"W
(R)14	S32°45'18"E


MATCHLINE - SEE SHEET 7 OF 7

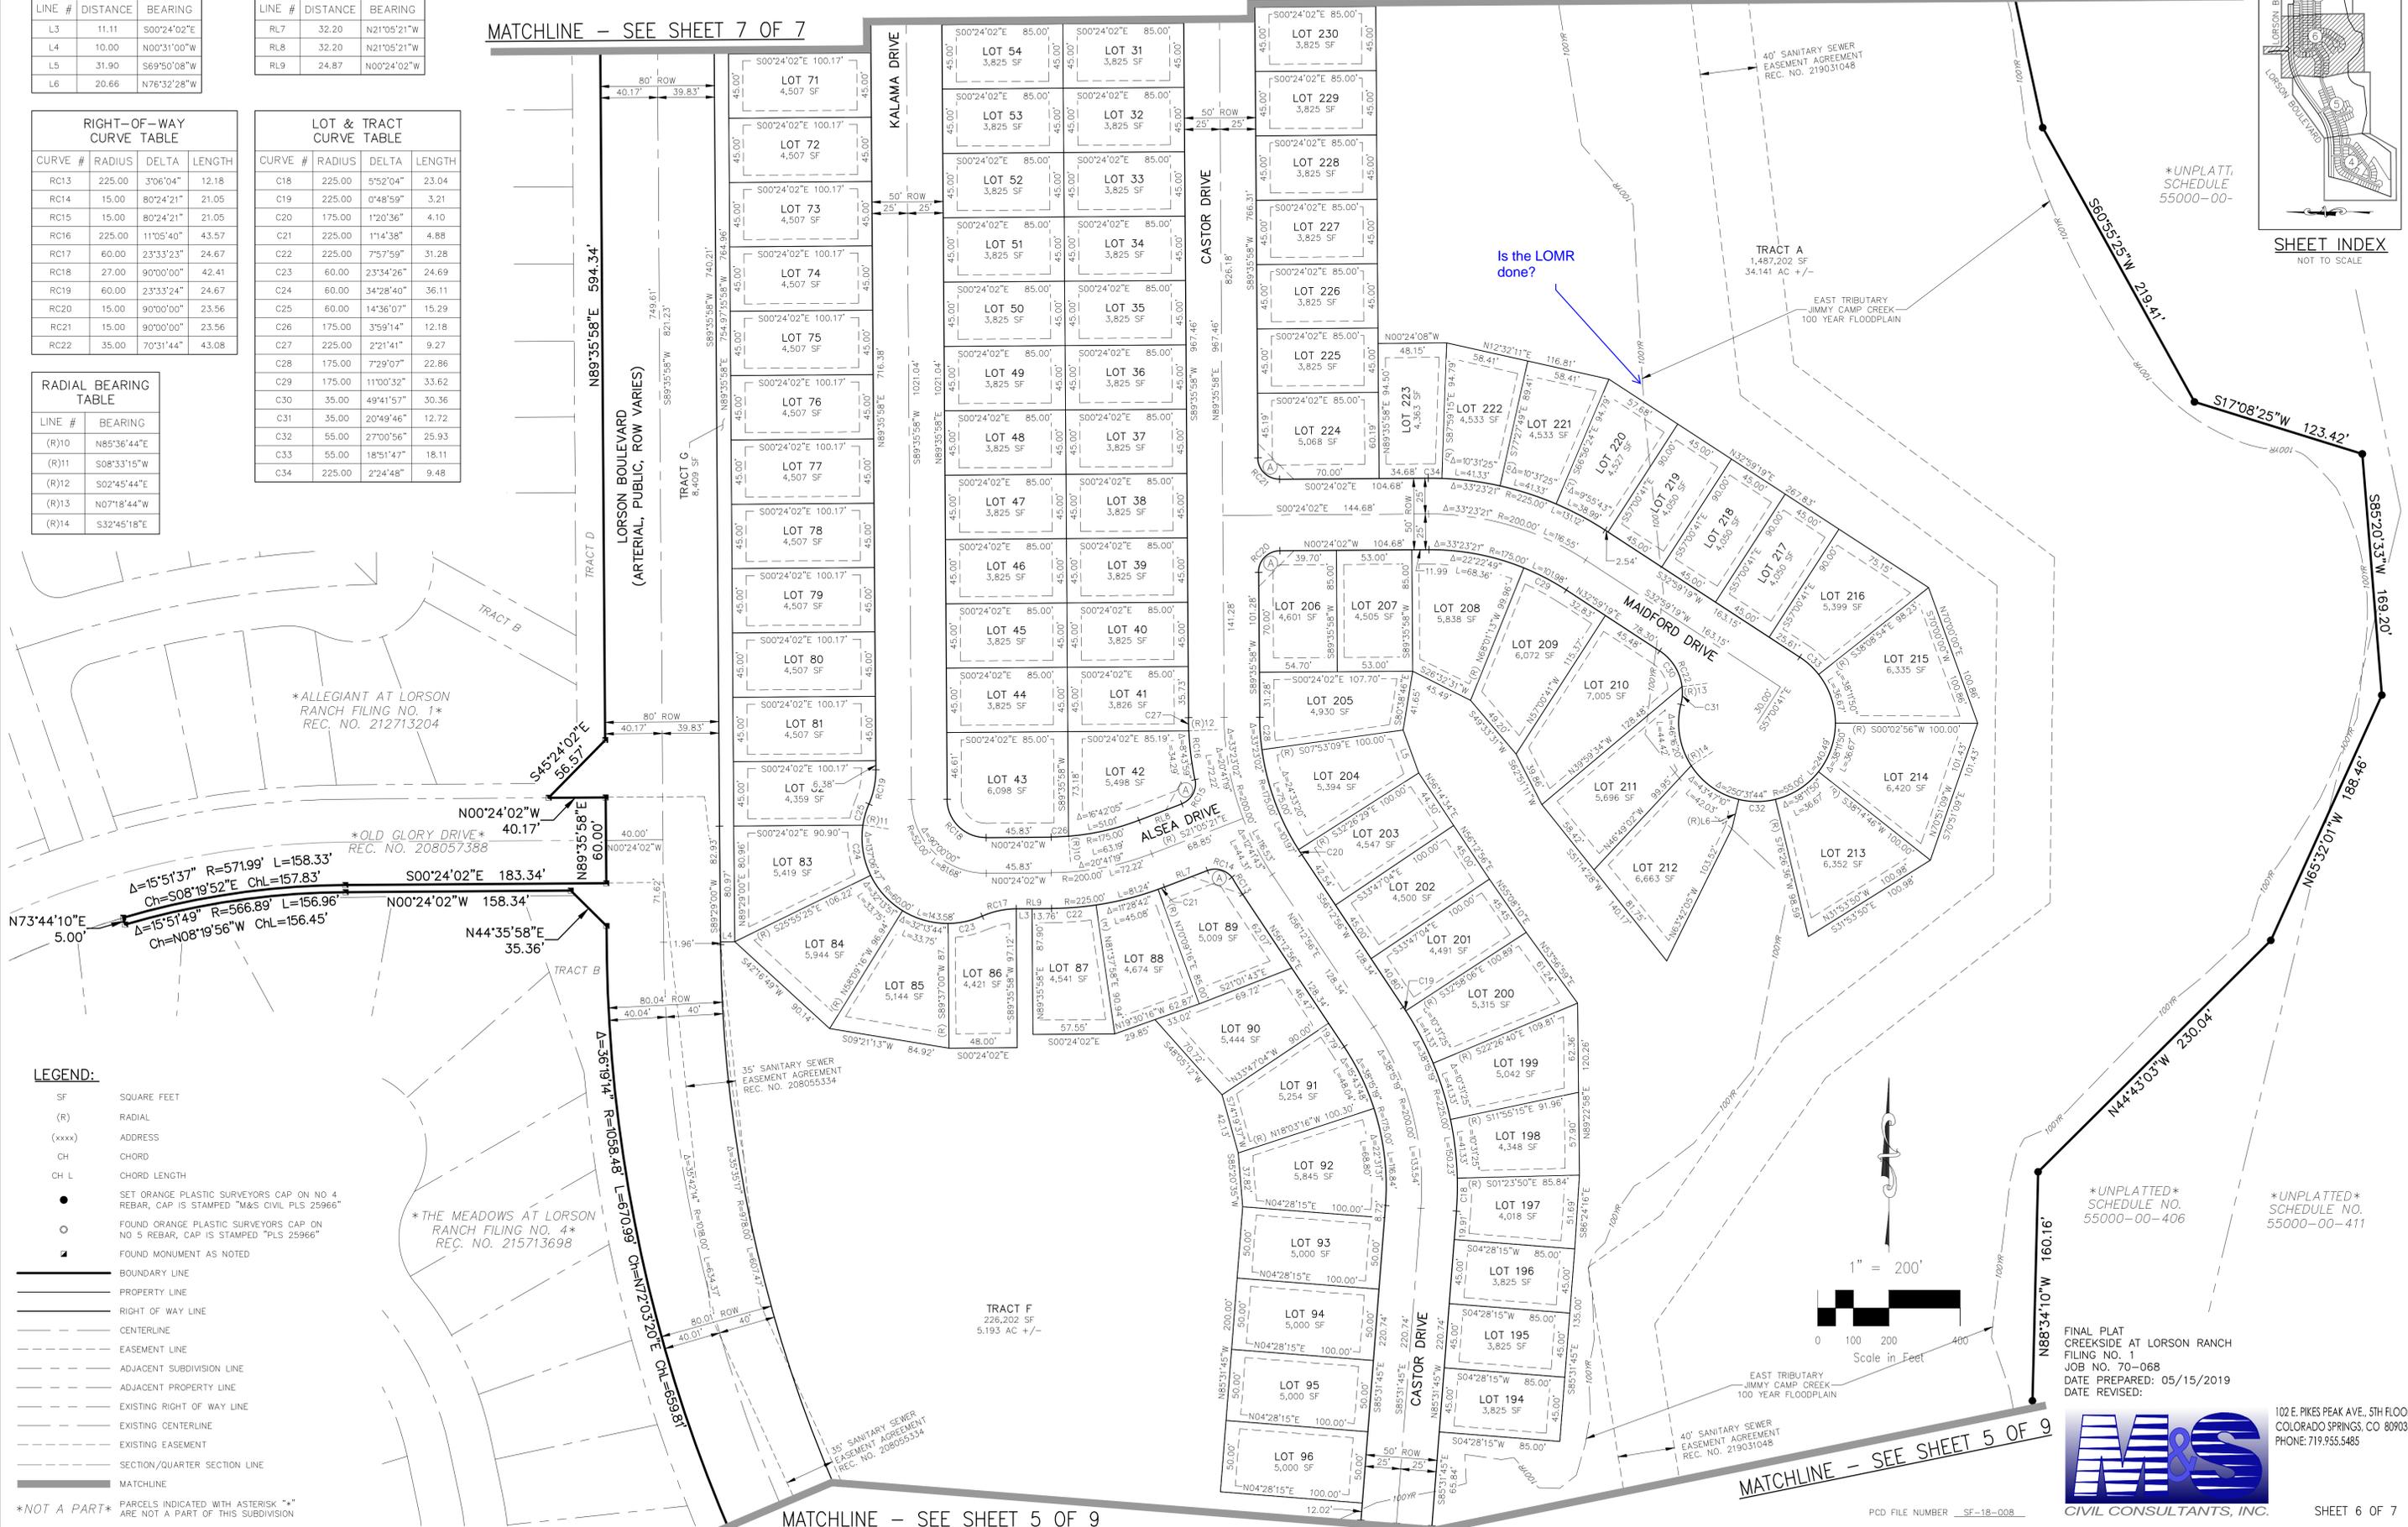

CREEKSIDE AT LORSON RANCH FILING NO. 1
 A PORTION OF THE SW 1/4 SECTION 13, AND OF THE NE 1/4 SECTION 23, AND OF THE NW 1/4 SECTION 24,
 ALL IN TOWNSHIP 15 SOUTH, RANGE 65 WEST OF THE SIXTH PRINCIPAL MERIDIAN, EL PASO COUNTY, COLORADO

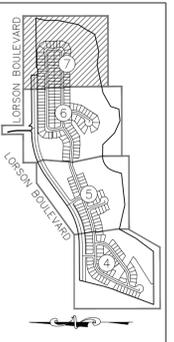

SHEET INDEX
NOT TO SCALE

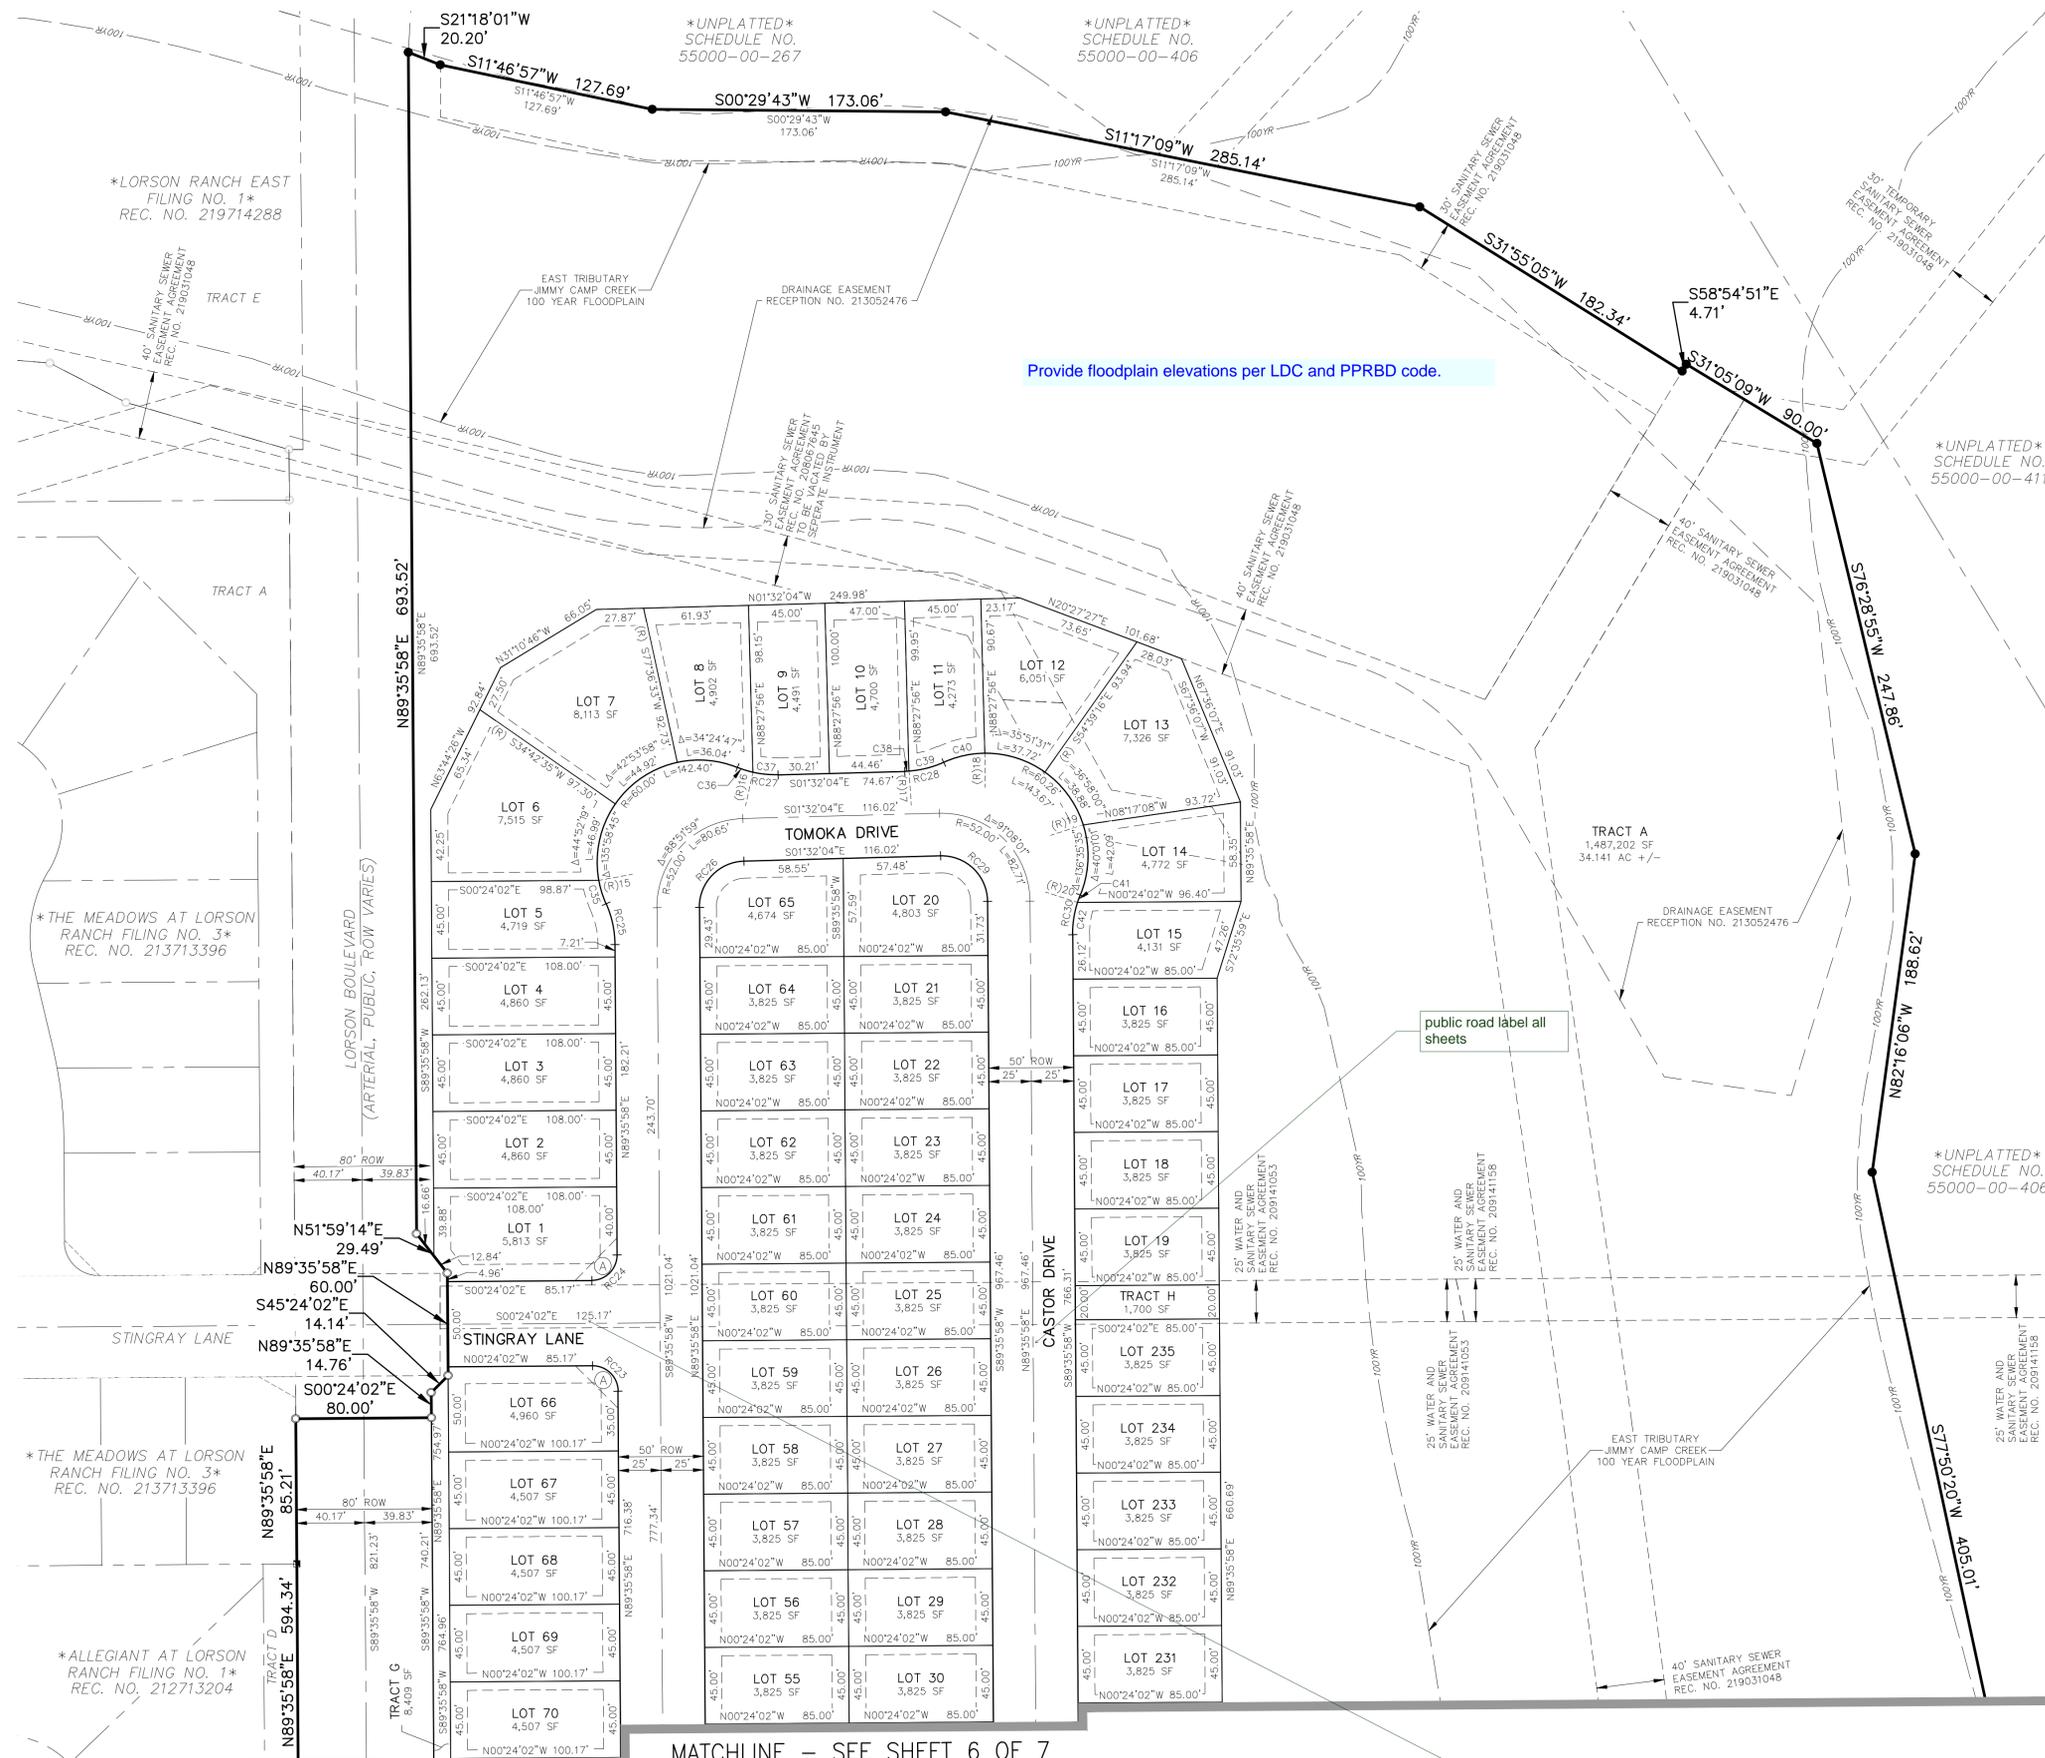

Provide floodplain elevations per LDC and PPRBD code.

LOT & TRACT CURVE TABLE

CURVE #	RADIUS	DELTA	LENGTH
C35	60.00	13°47'41"	14.45
C36	60.00	9°17'02"	9.72
C37	60.00	14°16'21"	14.95
C38	60.00	2°25'41"	2.54
C39	60.00	20°18'07"	21.26
C40	60.26	23°45'04"	24.98
C41	60.00	4°23'16"	4.59
C42	60.00	18°20'31"	19.21


RIGHT-OF-WAY CURVE TABLE

CURVE #	RADIUS	DELTA	LENGTH
RC25	60.00	23°33'23"	24.67
RC26	27.00	88°51'59"	41.88
RC27	60.00	23°33'23"	24.67
RC28	60.00	22°43'47"	23.80
RC29	27.00	91°08'01"	42.95
RC30	60.00	22°43'47"	23.80

RADIAL BEARING TABLE

LINE #	BEARING
(R)15	N10°09'45"W
(R)16	S77°15'43"E
(R)17	N86°02'16"E
(R)18	S89°29'13"W
(R)19	N17°41'17"W
(R)20	S17°56'29"W

- LEGEND:**
- SF SQUARE FEET
 - (R) RADIAL
 - (xxxx) ADDRESS
 - CH CHORD
 - CH L CHORD LENGTH
 - SET ORANGE PLASTIC SURVEYORS CAP ON NO 4 REBAR, CAP IS STAMPED "M&S CIVIL PLS 25966"
 - FOUND ORANGE PLASTIC SURVEYORS CAP ON NO 5 REBAR, CAP IS STAMPED "PLS 25966"
 - FOUND MONUMENT AS NOTED
 - BOUNDARY LINE
 - PROPERTY LINE
 - RIGHT OF WAY LINE
 - - - CENTERLINE
 - - - EASEMENT LINE
 - - - ADJACENT SUBDIVISION LINE
 - - - ADJACENT PROPERTY LINE
 - - - EXISTING RIGHT OF WAY LINE
 - - - EXISTING CENTERLINE
 - - - EXISTING EASEMENT
 - - - SECTION/QUARTER SECTION LINE
 - MATCHLINE
 - *NOT A PART* PARCELS INDICATED WITH ASTERISK "*" ARE NOT A PART OF THIS SUBDIVISION

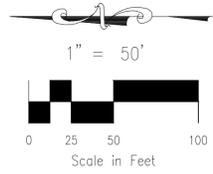

FINAL PLAT
 CREEKSIDE AT LORSON RANCH
 FILING NO. 1
 JOB NO. 70-068
 DATE PREPARED: 05/15/2019
 DATE REVISED:



102 E. PIKES PEAK AVE., 5TH FLOOR
 COLORADO SPRINGS, CO 80903
 PHONE: 719.555.5465

File: C:\10068A\Creekside\Creekside at Lorson F1 (1.dwg) Survey Plot 70-068 Creekside Final Plat.dwg Plotstamp: 5/15/2019 10:43 AM

Markup Summary 6-18-2019

dsdrice (10)



Subject: Cloud+
Page Label: 1
Author: dsdrice
Date: 6/17/2019 3:53:26 PM
Color: ■

Revise per FDR comments

V.

Subject: Highlight
Page Label: 2
Author: dsdrice
Date: 6/17/2019 4:08:50 PM
Color: ■

esmt

XXi.

Subject: Highlight
Page Label: 2
Author: dsdrice
Date: 6/17/2019 4:08:50 PM
Color: ■

esmt

xix.

Subject: Highlight
Page Label: 2
Author: dsdrice
Date: 6/17/2019 4:08:50 PM
Color: ■

esmt

XXii.

Subject: Highlight
Page Label: 2
Author: dsdrice
Date: 6/17/2019 4:08:50 PM
Color: ■

esmt

XXiii.

Subject: Highlight
Page Label: 2
Author: dsdrice
Date: 6/17/2019 4:08:50 PM
Color: ■

esmt

XX.

Subject: Highlight
Page Label: 2
Author: dsdrice
Date: 6/17/2019 4:08:50 PM
Color: ■

esmt

F. DEVELOPMENT AGREEMENT NO. 6 CONTRAC
G. SCHOOL SITE DEDICATION AGREEMENT REC-
26 PURSUANT TO RESOLUTION NO. 12-363 APPROV
PUBLIC IMPROVEMENT DISTRICT 2 AND RECORDED
AND RECORDED AT RECEPTION NUMBER: 21213
OF LORSON RANCH EAST BLVD PROJECT, RE INC
COUNTY PUBLIC IMPROVEMENT DISTRICT 2 AND
FEES AND MILL LEVY.

Subject: Highlight
Page Label: 2
Author: dsdrice
Date: 6/17/2019 4:31:55 PM
Color: ■

LORSON RANCH EAST FILING NO. 2"



Subject: Callout
Page Label: 6
Author: dsdrice
Date: 6/17/2019 4:38:39 PM
Color: ■

Is the LOMR done?




Subject: Text Box
Page Label: 7
Author: dsdrice
Date: 6/17/2019 4:44:18 PM
Color: ■

Provide floodplain elevations per LDC and PPRBD code.

dsdparsons (22)



Subject: Image
Page Label: 2
Author: dsdparsons
Date: 6/10/2019 1:26:54 PM
Color: ■

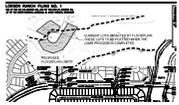


Subject: Image
Page Label: 3
Author: dsdparsons
Date: 6/10/2019 1:28:37 PM
Color: ■



Subject: Callout
Page Label: 3
Author: dsdparsons
Date: 6/10/2019 1:29:37 PM
Color: ■

IS LOMR complete? Identify the hazard and state LOMR is removing these lots from Floodplain in plat notes and leader on sheet

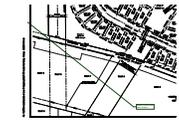

Subject: Callout
Page Label: 4
Author: dsdparsons
Date: 6/10/2019 1:30:04 PM
Color: ■

Sheets should all face same direction.



Subject: Soils & Geology
Page Label: 1
Author: dsdparsons
Date: 6/10/2019 1:30:34 PM
Color: ■

Soil and Geology Conditions:
 Geologic Hazard Note-Final Plat: (to be customized based upon the individual circumstances)
 The following lots have been found to be impacted by geologic hazards. Mitigation measures and a map of the hazard area can be found in the report (Title of Report, generally from the Preliminary Plan file) by (author of the report) (date of report) in file (name of file and file number) available at the El Paso County Planning and Community Development Department:

- Downslope Creep: (name lots or location of area)
- Rockfall Source:(name lots or location of area)
- Rockfall Runout Zone:(name lots or location of area)
- Potentially Seasonally High Groundwater:(name lots or location of area)
- Other Hazard:

In Areas of High Groundwater:
 Due to high groundwater in the area, all foundations shall incorporate an underground drainage system.



Subject: Soils & Geology
Page Label: 2
Author: dsdparsons
Date: 6/10/2019 1:31:38 PM
Color: ■

Soil and Geology Conditions:
 Geologic Hazard Note-Final Plat: (to be customized based upon the individual circumstances)
 The following lots have been found to be impacted by geologic hazards. Mitigation measures and a map of the hazard area can be found in the report (Title of Report, generally from the Preliminary Plan file) by (author of the report) (date of report) in file (name of file and file number) available at the El Paso County Planning and Community Development Department:
 ■Downslope Creep: (name lots or location of area)
 ■Rockfall Source:(name lots or location of area)
 ■Rockfall Runout Zone:(name lots or location of area)
 ■Potentially Seasonally High Groundwater:(name lots or location of area)
 ■Other Hazard:
 In Areas of High Groundwater:
 Due to high groundwater in the area, all foundations shall incorporate an underground drainage system.



Subject: Callout
Page Label: 2
Author: dsdparsons
Date: 6/10/2019 1:31:46 PM
Color: ■

Add these notes




Subject: Callout
Page Label: 2
Author: dsdparsons
Date: 6/10/2019 1:32:00 PM
Color: ■

CUSTOMIZE this Note Please add Lot nos.



Subject: Highlight
Page Label: 2
Author: dsdparsons
Date: 6/10/2019 1:32:28 PM
Color: ■

16. BUILDING SETBACKS SHALL BE IN ACCORDANCE WITH LORSON RANCH EAST FILING NO. 1 PLANNED UNI

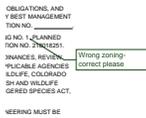


Subject: Callout
Page Label: 2
Author: dsdparsons
Date: 6/10/2019 1:32:47 PM
Color: ■

Wrong zoning- correct please



Subject: Highlight
Page Label: 2
Author: dsdparsons
Date: 6/10/2019 1:32:52 PM
Color: ■

RSON RANCH EAST FILING NO. 1" HOMEOWNERS ASSOCIATION, INC. IS RECORDED UNDER RE

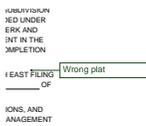

Subject: Callout
Page Label: 2
Author: dsdparsons
Date: 6/10/2019 1:33:01 PM
Color: ■

Wrong plat



Subject: Highlight
Page Label: 2
Author: dsdparsons
Date: 6/10/2019 1:33:39 PM
Color: ■

DEVELOPMENT GUIDELINES ON FILE FOR LORSON RANCH EAST PLANNED UNIT DEVELOPMENT GUIDELINES, AS RECORDED AT RECEPTION NO. 218018251, OF THE RECORDS OF THE EL PASO COUNTY CLERK AND RECORDER, OR OTHERWISE AMENDED BY EL



Subject: Highlight
Page Label: 2
Author: dsdparsons
Date: 6/10/2019 1:33:41 PM
Color: ■

WITHIN "LORSON RANCH EAST FILING NO. 2" SHALL




Subject: Callout
Page Label: 2
Author: dsdparsons
Date: 6/10/2019 1:33:59 PM
Color: ■

NO- This is Creekside- Please correct



Subject: Image
Page Label: 2
Author: dsdparsons
Date: 6/10/2019 1:34:43 PM
Color: ■

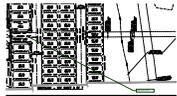

Subject: Callout
Page Label: 7
Author: dsdparsons
Date: 6/10/2019 1:41:28 PM
Color: ■

label public ROW



Subject: Callout
Page Label: 7
Author: dsdparsons
Date: 6/10/2019 1:42:34 PM
Color: ■

public road label all sheets



Subject: Image
Page Label: 3
Author: dsdparsons
Date: 6/10/2019 1:44:16 PM
Color: ■



Subject: Callout
Page Label: 3
Author: dsdparsons
Date: 6/10/2019 1:44:32 PM
Color: ■

TRACTS SHOULD MATCH THE PUD AND PRELIM

Q	0.180	UNO/RANO	DRAINAGE PER UTILITY/LANDS
H	0.200	UNO/RANO	DRAINAGE PER UTILITY/LANDS
TOTAL	43.000	UNO/RANO	DRAINAGE PER UTILITY/LANDS

UNO = LORSON RANCH UNO DISTRICT

TRACTS DO NOT MATCH APPROVED PUDSP

Subject: Callout
Page Label: 1
Author: dsdparsons
Date: 6/10/2019 1:44:54 PM
Color: ■

TRACTS DO NOT MATCH APPROVED PUDSP

