

DRAWING NOTICE:

THESE DOCUMENTS ARE CONFIDENTIAL AND ARE THE SOLE PROPERTY OF AT&T AND MAY NOT BE REPRODUCED, DISSEMINATED OR REDISTRIBUTED WITHOUT THE EXPRESS WRITTEN CONSENT OF AT&T.

REVISIONS:

DESCRIPTION	DATE	BY	REV
REVISED PER JURISDICTION COMMENTS	03/30/20	CAP	1
FINAL CD	01/22/20	CAP	0
REVISED/ISSUED FOR REVIEW	12/19/19	CAP	B
ISSUED FOR REVIEW	10/30/19	RCD	A

AT&T SITE NAME:

BLACK FOREST

AT&T SITE NUMBER:

COL02037

AT&T FA NUMBER:

10093683

SITE ADDRESS:

**14755 BLACK FOREST ROAD
BLACK FOREST, CO 80908**

SHEET DESCRIPTION:



PARCEL PLAN

SHEET NUMBER:

P-1

Vicinity map needs to provide more context to major roads. The only major road depicted here is Black Forest Rd. Please provide a new vicinity map with more context.

Please label this road.

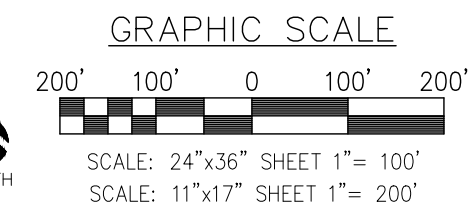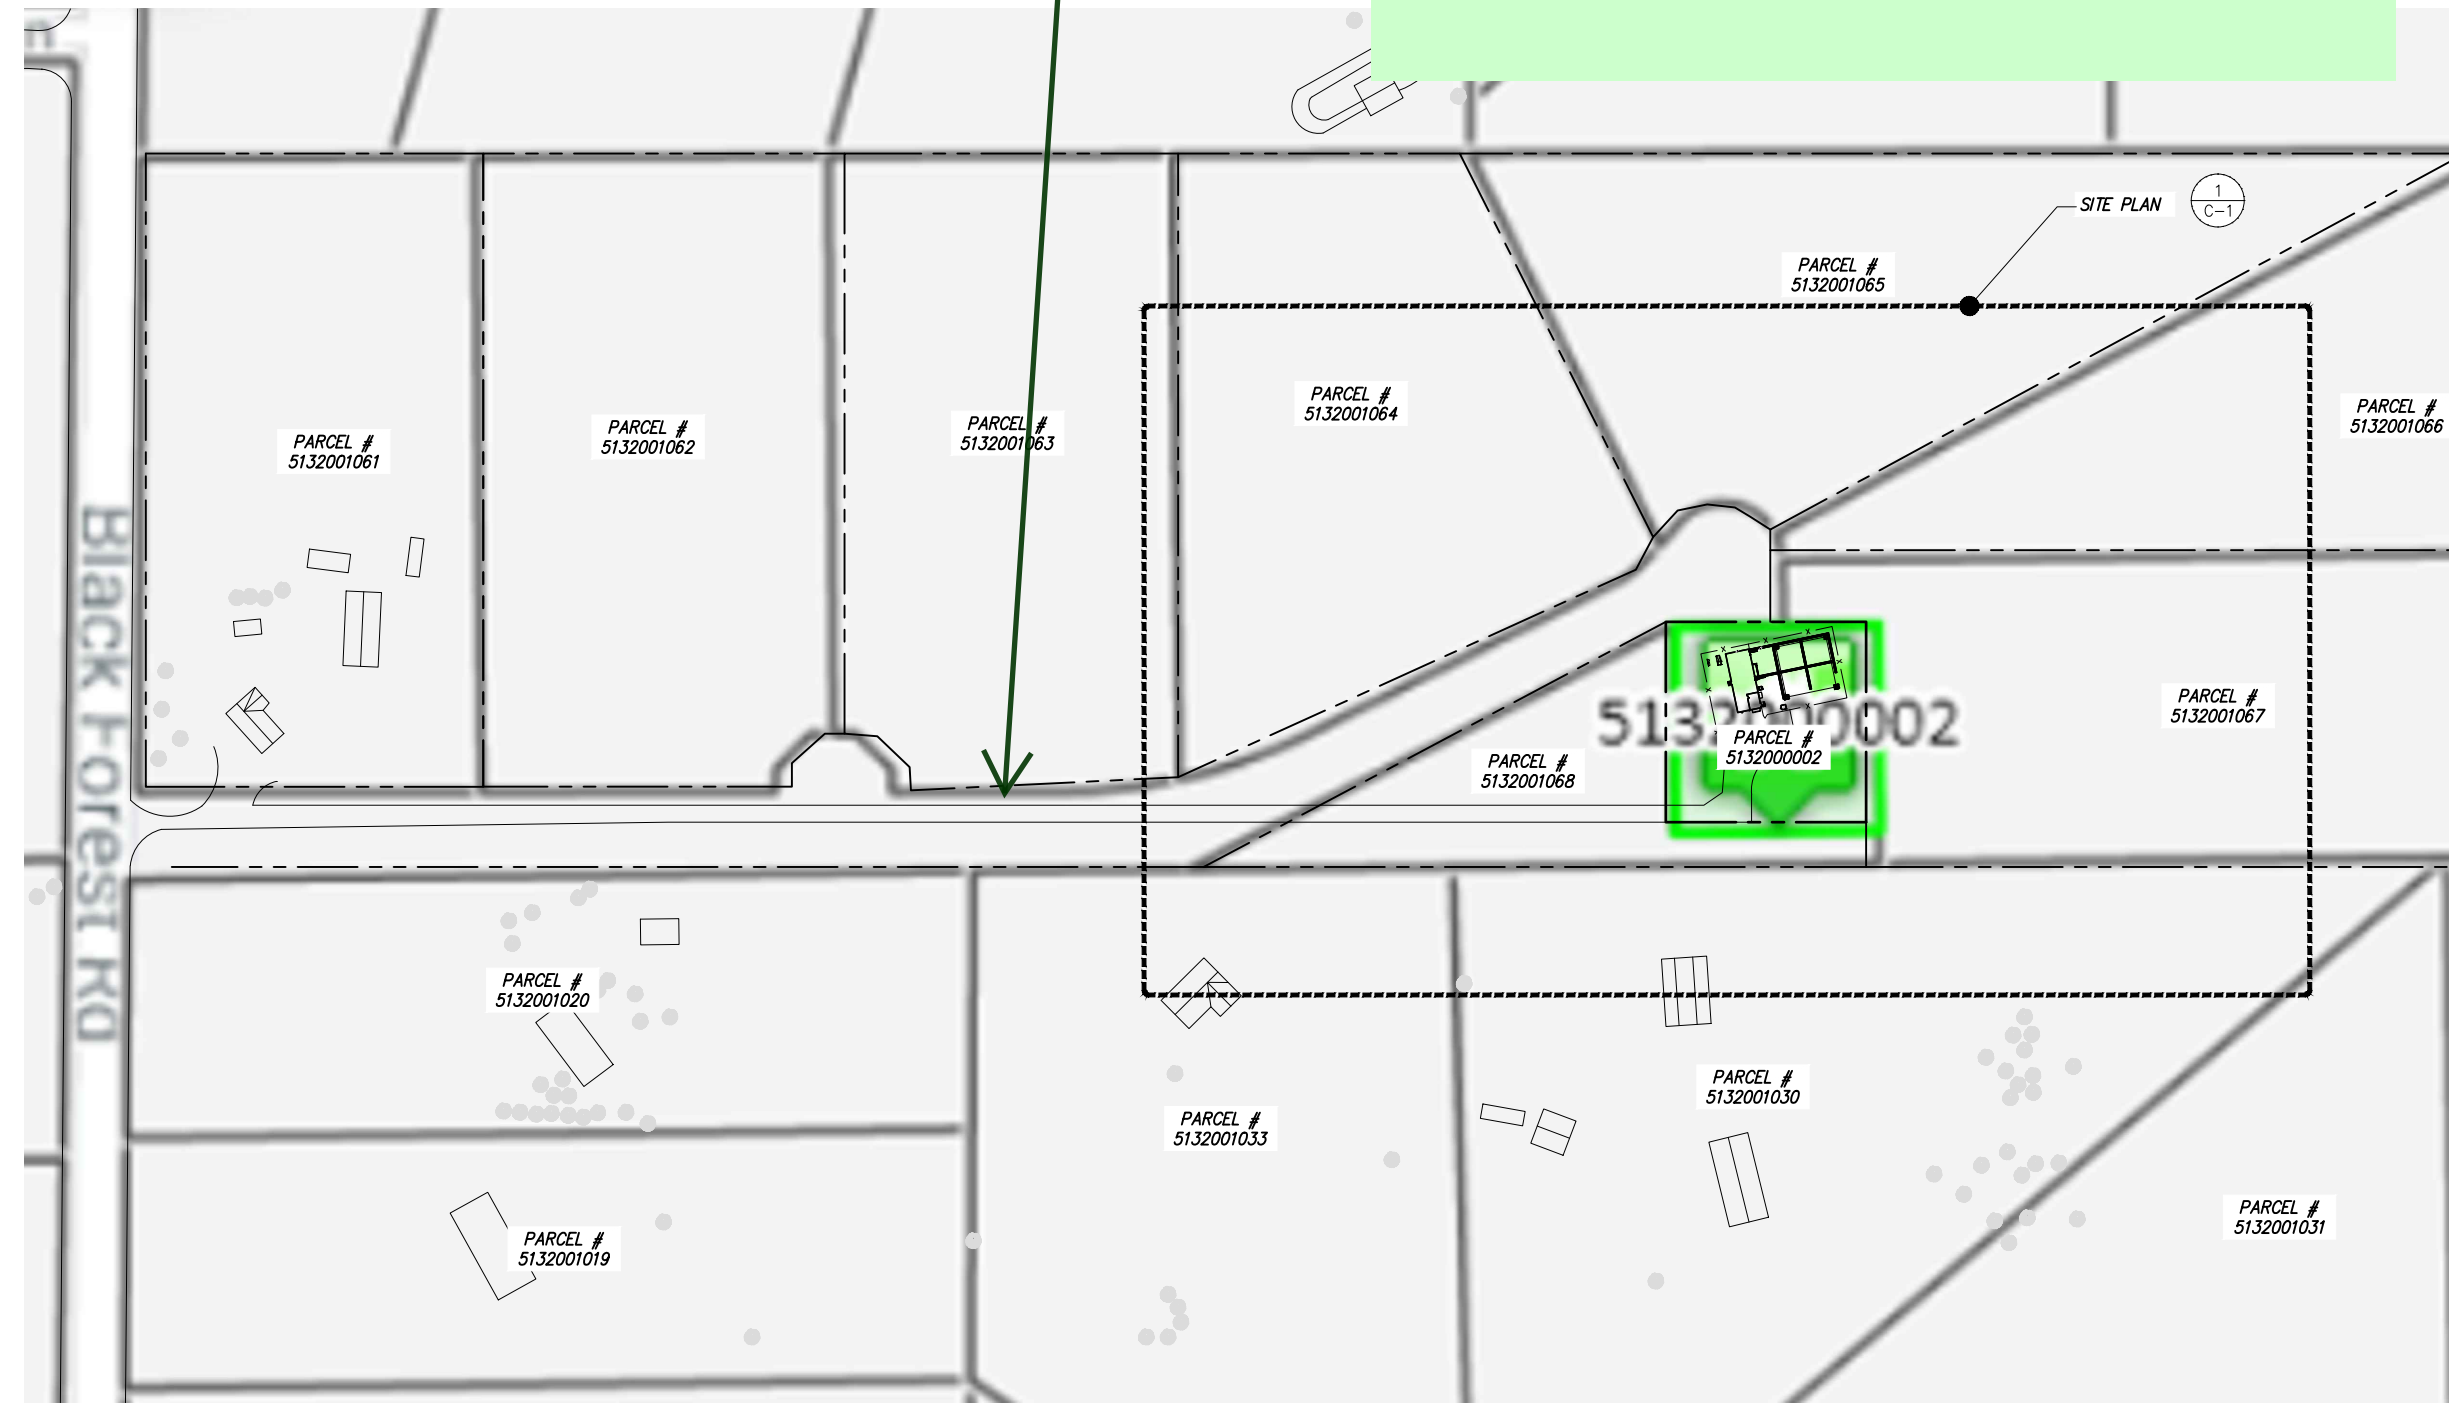

PARCEL PLAN

SCALE: AS NOTED 1