


AUTUMN ACRES

PHASE 1 PLAN REVISION 1 MARCH 2022


Identify proposed ROW dedication along Stapleton. The current Stapleton corridor plan that is currently in progress identifies a 168' ROW width for Stapleton.

https://www.briargate-stapleton.com/_files/ugd/f29967_9aef62f2169694fbd85e71364dc5d1abd.pdf

ZONING MAP

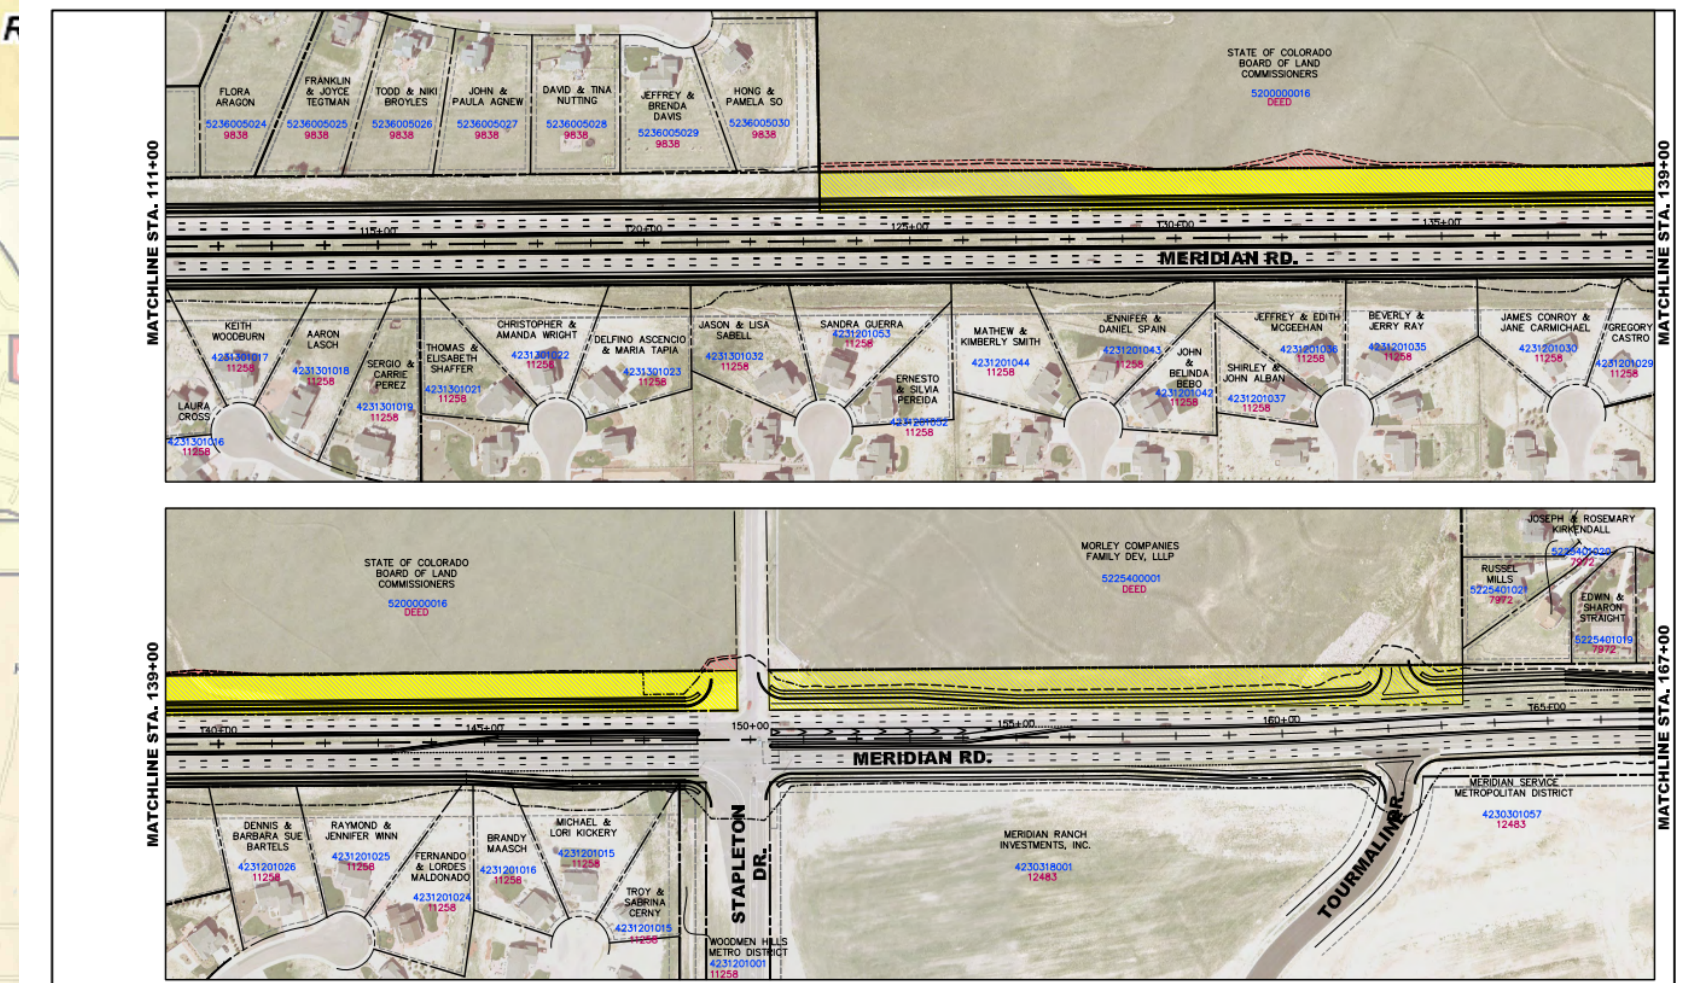


DATE	
------	--

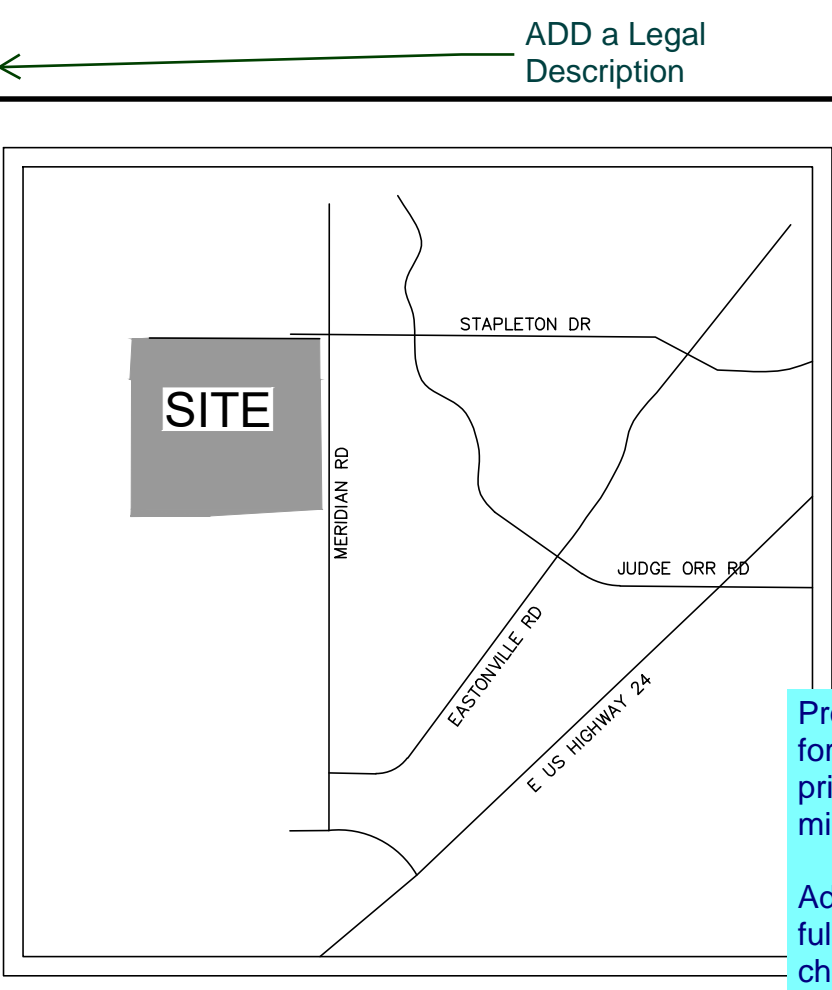

Depict the utility landuse area for the Sanitary lift station and other components.

Provide a deviation request for intersection spacing as a principal arterial requires 1/2 mile spacing.
Add a general note that the full movement access will change to a RIRO with future widening of Stapleton Road in accordance with the Stapleton-Briargate corridor access control plan.

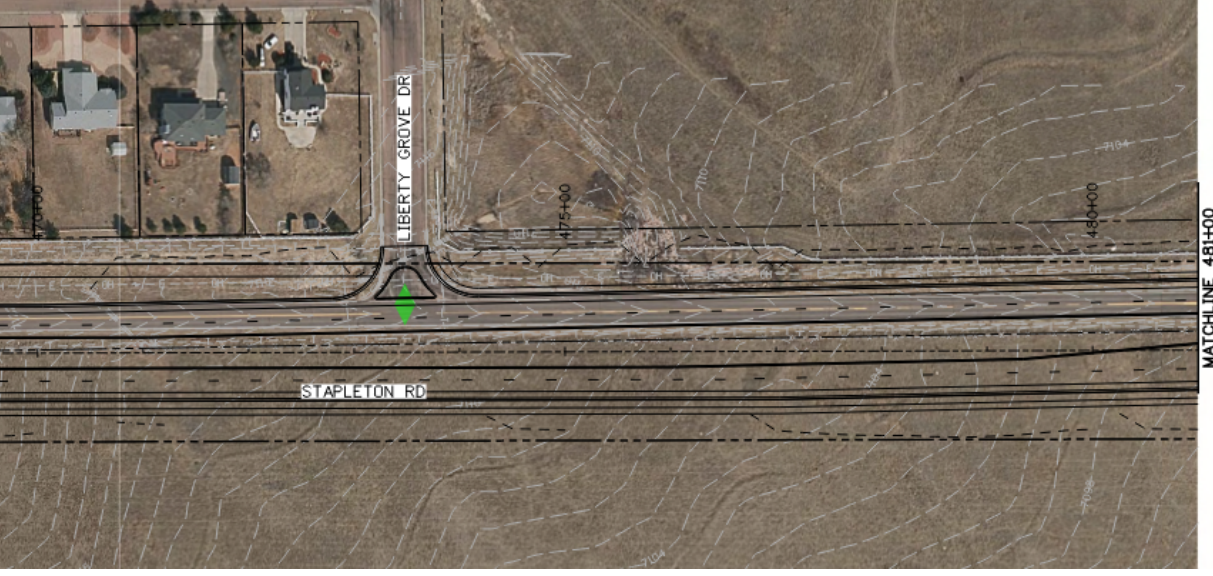

RS20000
MULTIPLE OWNERS
515 ADDRESSES WATERBURY DR
5 BLK 1 PAINT BRUSH HILLS FIL NO 4
MULTIPLE SCHEDULE NUMBERS

identify as full access in instead roundabout

COMMERCIAL REGIONAL
BARCOON LAND CORP
N MERIDIAN RD
UNDEVELOPED
5225400001

As noted during the early assistance meeting this access does not meet intersection spacing criteria and will not be approved. Remove proposed access location.

landscape setback required along major arterials outside of dedicated row- depict as buffer /landscape setback

Existing Meridian Road is currently within the property. Provide additional ROW per the Meridian North Corridor Plan. See area highlighted in yellow for additional ROW.
Control Plan study is available at <https://publicworks.elpasoco.com/road-bridge-planning/>

VICINITY MAP

FULL W/ PROP ROUND ABOUT

RT IN RT OUT

depict trails per 2023 Parks Master Plan

Show the existing ROW along the east side of Meridian Road.

only show the collector roads and arterials; w access points at key intersections; a sketch plan does not set roads. Please, remove local roadways; remove the zoning from the plan and identify density and landuse, transitions, buffers etc. Please look at SKP 223, SKP224; SKP 225; SKP201; for examples of what is to be depicted and typical notes. A phasing plan can be eliminated if notes are depicted on SKP that anticipated phasing is XYZ; subject to change without a skp amendment being required

the zoning map changes quarterly; label the zoning, aj lot lines roads and adj property info per the checklist please.

depict roadway line work for Meridian and Stapleton. Identify any dedication that will occur based on TIS

As noted during the early assistance meeting this access does not meet intersection spacing criteria and will not be approved. Remove proposed access location.

Clearly delineate bubbles for density and land use.

Add note that states that the proposed streets and access locations are conceptual and subject to change. Deviation requests must be approved for transportation and access design that is not in conformance with the EPC Engineering Criteria Manual Standards.

GENERAL NOTES:

1. SURVEY DATA FROM AUGUST 2021.
2. A NOXIOUS WEED MANAGEMENT PLAN WILL BE PROVIDED WITH THE PRELIMINARY PLAN.
3. THE PROPERTY IS SUBJECT TO FINDINGS OF THE PRELIMINARY SOILS INVESTIGATION / SOIL, GEOLOGY, AND GEOLOGIC HAZARD STUDY MERIDIAN ROAD AND STAPLETON DRIVE PARCEL NO. 52000-00-016 EL PASO COUNTY, COLORADO BY ENTECH DATED MARCH 11, 2022. CONTACT EL PASO COUNTY LAND USE REVIEW TEAM IF YOU WOULD LIKE TO REVIEW A COPY OF SAID REPORT.
4. SETBACKS AND BUFFERS BETWEEN COMMERCIAL LAND USE AND RESIDENTIAL LAND USE WILL BE ESTABLISHED WITH ZONING AND PRELIMINARY PLAN.
5. NO PORTION OF THE SITE FALLS WITHIN THE FEMA 100-YEAR FLOODPLAIN AS DESIGNATED ON MAP NO. 08041C0553G AND 08041C0551G.

remove future or proposed- this is a sketch plan which is setting the future, key access points, density and land use categories

remove the self storage label and put commercial;

this area should be depicted as open space as its not suitable for LOT MIX structures

Seasonal Shallow Groundwater Area - Constraint

This area is located in the small pond behind the earthen dam in the southeastern portion of the site. Water was not observed at the time of this investigation, however, vegetation and soils observed indicate water is near or at the surface during periods of high moisture. These areas also contain frost heave potential and highly organic soils.

Mitigation: Because the majority of the areas mapped as seasonally wet lie within defined drainages, we do not recommend structures be built within these areas. Lots are of sufficient size that these areas can be avoided as building sites. Should foundations encroach on

LAND USE	DENSITY	ACRES	LOTS/UNITS
URBAN RESIDENTIAL	7,000+ SF LOTS	99 AC	
PUD PATIO HOMES	11 / 12 DU/AC	4.5 AC	
PUD MULTI FAMILY	11 / 12 DU/AC	8.4 AC	
SUB TOTAL			
FUTURE LAND USE			
PUD MULTI FAMILY	13 DU/AC	11.6 AC	
	N/A	18 AC	
	N/A	18.5 AC	
	N/A	160 AC	

LEGAL DESCRIPTION: NE4 SEC 36-12-65
MASTER PLAN: YOUR EL PASO MASTER PLAN
EXISTING LAND USE: UNDEVELOPED
EXISTING ZONING: RR-5 (RURAL RESIDENTIAL)

SITE AREA: 160 ACRES
PROPOSED USE: MIXED RESIDENTIAL/COMMERCIAL
NUMBER OF UNITS: 619
GROSS DENSITY: 3.9 DU/AC
TOTAL AREAS: SEE LAND USE TABLE

UTILITY/SERVICE PROVIDERS: WATER - PAINT BRUSH HILLS METRO DISTRICT
SANITARY - PAINT BRUSH HILLS METRO DISTRICT
ELECTRIC - MOUNTAIN VIEW ELECTRIC ASSOCIATION
GAS - COLORADO SPRINGS UTILITIES
FIRE PROTECTION - FALCON FIRE PROTECTION DISTRICT
SCHOOLS - FALCON DISTRICT #49

DEVELOPER: MERIDIAN HILLS LLC
106 CERRITO PT
COLORADO SPRINGS, CO 80905
(719) 473-0599

PREPARED BY: TERRA NOVA ENGINEERING, INC.
721 S. 23RD STREET
COLORADO SPRINGS, CO 80904
(719) 635-6422

MINERAL RIGHTS OWNERSHIP: delete it is applicable always
ADDRESS: SW CORNER OF INTERSECTION OF STAPLETON DR AND MERIDIAN RD

DESIGNED BY	LD
DRAWN BY	LD
CHECKED BY	LD
H-SCALE	AS NOTED
V-SCALE	AS NOTED
JOB NO.	2199.13
DATE ISSUED	11/28/22
SHEET NO.	1 OF 1

PREPARED FOR:
MERIDIAN HILLS LLC
ATTN: KEVIN DONOVAN
106 CERRITO PT
COLORADO SPRINGS, CO 80905
719.473.0599

Terra Nova
Engineering, Inc.
Creative Civil Engineering
721 S. 23RD STREET
COLORADO SPRINGS, CO 80904
OFFICE: 719-635-6422
FAX: 719-635-6426
www.tnec.com

Please set up a legend to show trails, open space, ponds, density various landuse categories etc as istypical on SKP submitted

dimension buffers

See Engineering Criteria Manual (ECM) chapter 2 for roadway design criteria. Maximum cul-de-sac length is 750 ft for urban condition.


place the areas to be preserved in open space- this would cause significant concern with Criteria for approval depicting much of the site w water shallow- decide what areas will be preserved.

Show and Identify access to Theriot Road

Is there a residential unit density cap based on water? what is the cap square footage on commercial?


Depict there trail connectivity throughout the site (use notes to state internal sidewalks will connect the trails shown) please

Please categorize and match the Code definitions and use tables; Single-family attached, single family detached, commercial; multi-dwelling etc- see checklist

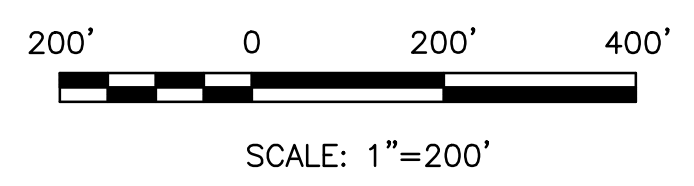


V1_Sketch Plan Drawings.pdf Markup Summary 2-22-2023

Arrow (1)

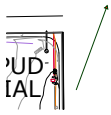


Subject: Arrow
Page Label: [1] SKETCH PLAN
Author: dsdparsons
Date: 2/22/2023 12:41:36 PM
Status:
Color: ■
Layer:
Space:

Callout (31)

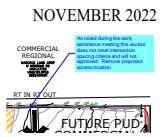

Subject: Callout
Page Label: [1] SKETCH PLAN
Author: dsdlaforce
Date: 2/14/2023 5:11:52 PM
Status:
Color: ■
Layer:
Space:

As noted during the early assistance meeting this access does not meet intersection spacing criteria and will not be approved. Remove proposed access location.

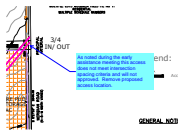

Subject: Callout
Page Label: [1] SKETCH PLAN
Author: dsdlaforce
Date: 2/14/2023 8:59:56 AM
Status:
Color: ■
Layer:
Space:


As noted during the early assistance meeting this access does not meet intersection spacing criteria and will not be approved. Remove proposed access location.



Subject: Callout
Page Label: [1] SKETCH PLAN
Author: dsdlaforce
Date: 2/14/2023 9:33:47 AM
Status:
Color: ■
Layer:
Space:


Existing Meridian Road is currently within the property. Provide additional ROW per the Meridian North Corridor Plan. See area highlighted in yellow for additional ROW.

Control Plan study is available at <https://publicworks.elpasoco.com/road-bridge-planning/>

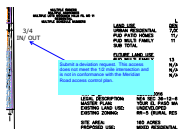

Subject: Callout
Page Label: [1] SKETCH PLAN
Author: dsdlaforce
Date: 2/14/2023 9:39:16 AM
Status:
Color: ■
Layer:
Space:

Submit a deviation request. This access does not meet the 1/2 mile intersection and is not in conformance with the Meridian Road access control plan.

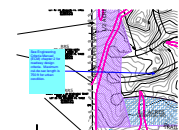


Subject: Callout
Page Label: [1] SKETCH PLAN
Author: dsdlaforce
Date: 2/14/2023 9:13:57 AM
Status:
Color: ■
Layer:
Space:

See Engineering Criteria Manual (ECM) chapter 2 for roadway design criteria. Maximum cul-de-sac length is 750 ft for urban condition.



Subject: Callout
Page Label: [1] SKETCH PLAN
Author: Daniel Torres
Date: 2/14/2023 11:25:08 AM
Status:
Color: ■
Layer:
Space:


Add note that states that the proposed streets and access locations are conceptual and subject to change. Deviation requests must be approved for transportation and access design that is not in conformance with the EPC Engineering Criteria Manual Standards.

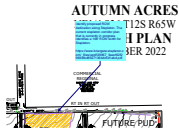

Subject: Callout
Page Label: [1] SKETCH PLAN
Author: Daniel Torres
Date: 2/15/2023 1:44:06 PM
Status:
Color: ■
Layer:
Space:

identify proposed ROW dedication along Stapleton. The current stapleton corridor plan that is currently in progress identifies a 168' ROW width for Stapleton.


https://www.briargate-stapleton.com/_files/ugd/f29967_9aecf62f29694fbd85e71364dc5d1abd.pdf

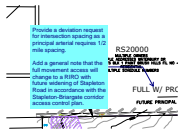

Subject: Callout
Page Label: [1] SKETCH PLAN
Author: Daniel Torres
Date: 2/21/2023 2:54:37 PM
Status:
Color: ■
Layer:
Space:


Provide a deviation request for intersection spacing as a principal arterial requires 1/2 mile spacing.

Add a general note that the full movement access will change to a RIRO with future widening of Stapleton Road in accordance with the Stapleton-Briargate corridor access control plan.

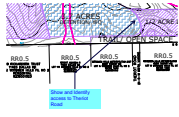


Subject: Callout
Page Label: [1] SKETCH PLAN
Author: dsdlaforce
Date: 2/21/2023 2:58:09 PM
Status:
Color: ■
Layer:
Space:

Show and Identify access to Theriot Road

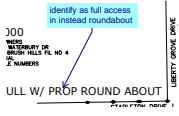

Subject: Callout
Page Label: [1] SKETCH PLAN
Author: Daniel Torres
Date: 2/21/2023 3:35:03 PM
Status:
Color: ■
Layer:
Space:

identify as full access in instead roundabout

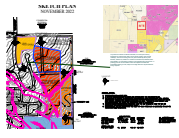


Subject: Callout
Page Label: [1] SKETCH PLAN
Author: dsdparsons
Date: 2/22/2023 10:29:22 AM
Status:
Color: ■
Layer:
Space:

only show the collector roads and arterials; w access points at key intersections; a sketch plan does not set roads. Please, remove local roadways; remove the zoning from the plan and identify density and landuse, transitions, buffers etc. Please look at SKP 223, SKP224; SKP 225; SKP201; for examples of what is to be depicted and typical notes. A phasing plan can be eliminated if notes are depicted on SKP that anticipated phasing is XYZ; subject to change without a skp amendment being required




Subject: Callout
Page Label: [1] SKETCH PLAN
Author: dsdparsons
Date: 2/22/2023 9:51:17 AM
Status:
Color: ■
Layer:
Space:

Clearly delineate bubbles for density and land use.

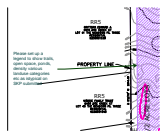


Subject: Callout
Page Label: [1] SKETCH PLAN
Author: dsdparsons
Date: 2/22/2023 10:18:07 AM
Status:
Color: ■
Layer:
Space:

Please set up a legend to show trails, open space, ponds, density various landuse categories etc as istypical on SKP submitted

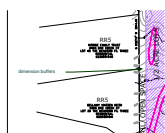


Subject: Callout
Page Label: [1] SKETCH PLAN
Author: dsdparsons
Date: 2/22/2023 9:52:58 AM
Status:
Color: ■
Layer:
Space:

dimension buffers

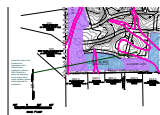


Subject: Callout
Page Label: [1] SKETCH PLAN
Author: dsdparsons
Date: 2/22/2023 9:54:19 AM
Status:
Color: ■
Layer:
Space:

place the areas to be preserved in openspace- this would cause significnat concern with Criteria for approval depicting much of the site w water shallow- decide what areas will be preserved.

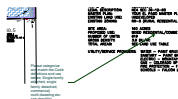

Subject: Callout
Page Label: [1] SKETCH PLAN
Author: dsdparsons
Date: 2/22/2023 10:07:51 AM
Status:
Color: ■
Layer:
Space:

Please categorize and match the Code definitions and use tables; Single-family attached, single family detached, commercial; multi-dweeling etc- see checklist

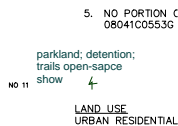

Subject: Callout
Page Label: [1] SKETCH PLAN
Author: dsdparsons
Date: 2/22/2023 9:57:37 AM
Status:
Color: ■
Layer:
Space:

parkland; detention; trails open-sapce show

1475-2599

WPER
A WOLA ENGINEERING, INC.
S. 23RD STREET
PACIFIC SPRINGS, CO 80804
781-435-8422

FOR RIGHTS OVERSIGHT, delete it is applicable always
APPLICABLE

LESS THE CORNER OF INTERSECTION OF
SECTION OR AND MERIDIAN IS

DESIGNED
DRAWN BY
CHECKED
IN-SHADE
IN-SHADE
JOB NO.:
DATE ISS:
SHEET NO:

Subject: Callout
Page Label: [1] SKETCH PLAN
Author: dsdparsons
Date: 2/22/2023 9:57:56 AM
Status:
Color: ■
Layer:
Space:

delete it is applicable always

Legend

PROPERTY LINE

TRAIL

Subject: Callout
Page Label: [1] SKETCH PLAN
Author: dsdparsons
Date: 2/22/2023 10:25:03 AM
Status:
Color: ■
Layer:
Space:

remove future or proposed- this is a sketch plan which is setting the future, key access points, density and land use categories

Depict these trail connections throughout the site (use notes to state internal sidewalks will connect the trails shown) please

Subject: Callout
Page Label: [1] SKETCH PLAN
Author: dsdparsons
Date: 2/22/2023 10:21:47 AM
Status:
Color: ■
Layer:
Space:

Depict there trail connectivity throughout the site (use notes to state internal sidewalks will connect the trails shown) please

depict the pocket parks?

Subject: Callout
Page Label: [1] SKETCH PLAN
Author: dsdparsons
Date: 2/22/2023 10:22:00 AM
Status:
Color: ■
Layer:
Space:

depict the pocket parks?

RESERVED FOR OPEN SPACE

Subject: Callout
Page Label: [1] SKETCH PLAN
Author: dsdparsons
Date: 2/22/2023 10:02:05 AM
Status:
Color: ■
Layer:
Space:

this area should be depicted as openspace as its not suitable for structures

the zoning map changes quarterly; label the zoning, lot lines roads and adj property info per the checklist please.


Subject: Callout
Page Label: [1] SKETCH PLAN
Author: dsdparsons
Date: 2/22/2023 10:09:39 AM
Status:
Color: ■
Layer:
Space:

the zoning map changes quarterly; label the zoning, lot lines roads and adj property info per the checklist please.




Subject: Callout
Page Label: [1] SKETCH PLAN
Author: dsdparsons
Date: 2/22/2023 10:10:25 AM
Status:
Color: ■
Layer:
Space:

depict roadway line work for Meridian and Stapleton. identify any dedication that will occur based on TIS

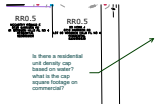


Subject: Callout
Page Label: [1] SKETCH PLAN
Author: dsdparsons
Date: 2/22/2023 10:21:05 AM
Status:
Color: ■
Layer:
Space:

Is there a residential unit density cap based on water? what is the cap square footage on commercial?

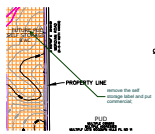

Subject: Callout
Page Label: [1] SKETCH PLAN
Author: dsdparsons
Date: 2/22/2023 10:24:46 AM
Status:
Color: ■
Layer:
Space:

remove the self storage label and put commercial;

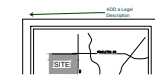


Subject: Callout
Page Label: [1] SKETCH PLAN
Author: dsdparsons
Date: 2/22/2023 12:31:12 PM
Status:
Color: ■
Layer:
Space:

ADD a Legal Description



Subject: Callout
Page Label: [1] SKETCH PLAN
Author: dsdparsons
Date: 2/22/2023 12:32:21 PM
Status:
Color: ■
Layer:
Space:

The SKP will likely require more than 1 page to depict the necessary items clearly

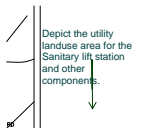


Subject: Callout
Page Label: [1] SKETCH PLAN
Author: dsdparsons
Date: 2/22/2023 12:36:53 PM
Status:
Color: ■
Layer:
Space:

Depict the utility landuse area for the Sanitary lift station and other components.



Subject: Callout
Page Label: [1] SKETCH PLAN
Author: dsdparsons
Date: 2/22/2023 12:41:33 PM
Status:
Color: ■
Layer:
Space:

landscape setback required along major arterials
 outside of dedicated row- depict as buffer
 /landscape setback

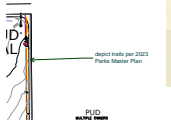


Subject: Callout
Page Label: [1] SKETCH PLAN
Author: dsdparsons
Date: 2/22/2023 12:57:36 PM
Status:
Color: ■
Layer:
Space:

depict trails per 2023 Parks Master Plan

Image (3)



Subject: Image
Page Label: [1] SKETCH PLAN
Author: dsdlaforce
Date: 2/14/2023 5:12:37 PM
Status:
Color: ■
Layer:
Space:

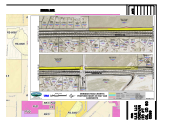

Subject: Image
Page Label: [1] SKETCH PLAN
Author: dsdlaforce
Date: 2/14/2023 9:33:27 AM
Status:
Color: ■
Layer:
Space:



Subject: Image
Page Label: [1] SKETCH PLAN
Author: dsdparsons
Date: 2/22/2023 10:01:43 AM
Status:
Color: ■
Layer:
Space:


Length Measurement (1)



Subject: Length Measurement
Page Label: [1] SKETCH PLAN
Author: dsdlaforce
Date: 2/14/2023 8:25:17 AM
Status:
Color: ■
Layer:
Space:

2,091'-11"


Polylength Measurement (1)

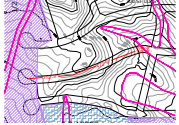

Subject: Polylength Measurement
Page Label: [1] SKETCH PLAN
Author: dsdlaforce
Date: 2/14/2023 9:08:55 AM
Status:
Color: ■
Layer:
Space:

906'-3"

Text Box (3)

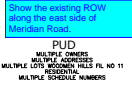

Subject: Text Box
Page Label: [1] SKETCH PLAN
Author: dsdlaforce
Date: 2/14/2023 8:56:20 AM
Status:
Color: ■
Layer:
Space:

Show the existing ROW along the east side of Meridian Road.



Subject: Text Box
Page Label: [1] SKETCH PLAN
Author: dsdlaforce
Date: 2/22/2023 1:12:50 PM
Status:
Color: ■
Layer:
Space:

The TIS noted 9,760 average daily trips (ADT) are generated by the development. This exceeds the design ADT for urban local roads. An internal collector spine road is likely required from the access on Stapleton to the access on Meridian Road and shall be shown and labeled on the plans.



Subject: Text Box
Page Label: [1] SKETCH PLAN
Author: dsdparsons
Date: 2/22/2023 10:04:49 AM
Status:
Color: ■
Layer:
Space:

<https://assets-planningdevelopment.elpasoco.com/wp-content/uploads/Checklists/SketchPlan.pdf>