

June 1, 2026

El Paso County
2880 International Circle, Suite 110
Colorado Springs, CO 80910

Re: **Legacy Church – Green Mountain Falls - PCM Certification Letter
El Paso County, Colorado**

To whom it may concern:

This letter serves as the certification for Legacy Church – Green Mountain Falls, El Paso County, CO project consistent with El Paso County Engineering Manual (“ECM”) Section 5.10.6.B, which states that Engineering Record Drawings shall be accompanied by a certification letter from the Engineer of Record which shall state that facilities constructed provide the required storage volume, meet the required release rates, the stage areas, elevations and outlet dimensions. Even though the as-built condition shows faster release rates for the WQCV compared to design levels, the ponds are generally constructed per the approved plans, have been operating effectively for multiple years, provide the required detention volumes and release at less than historic rates. Legacy Church consists of the following drainage facilities which are included in this certification:

- West Full Spectrum Detention Pond
- East Full Spectrum Detention Pond


Based upon this information and information gathered during periodic site visits to the site during significant/key phases of the infrastructure installation, *Kimley-Horn & Associates, Inc.* is of the opinion that the work performed under the County Permit, per Section 5.10.6.B of the ECM, have been constructed in general compliance with the approved Construction Plans as filed with the County dated January 31st, 2020 and approved by El Paso County on July 21st, 2020.

Statement Of Engineer In Responsible Charge:


I, Eric Gunderson, a registered Professional Engineer in the State of Colorado, in accordance with Sections 5.2 and 5.3 of the Bylaws and Rules of the State Board of Registration for Professional Engineers and Professional Land Surveyors, do hereby certify that I or a person under my responsible charge periodically observed the construction of the above-mentioned project. Based on the on-site field observations and review of pertinent documentation, it is my professional opinion that the required infrastructure improvements have been installed and are in general compliance with the approved Construction Plans as filed with El Paso County.




Eric Gunderson, P.E.
Colorado No. 49487

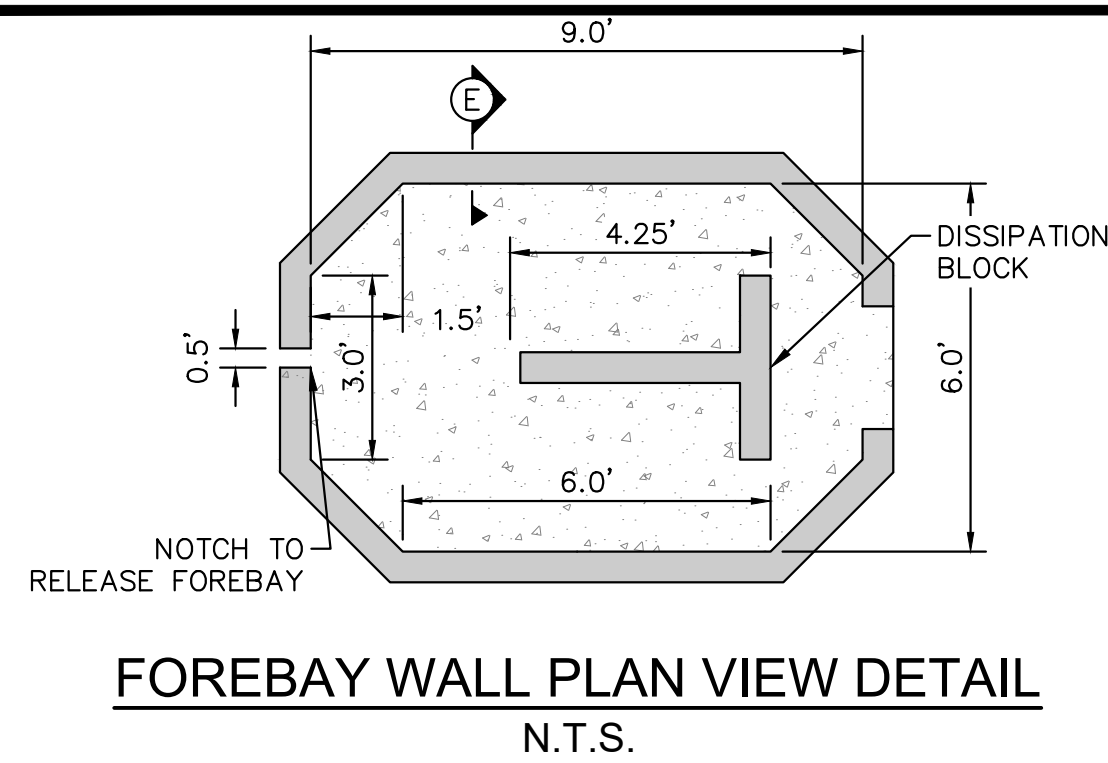



FOREBAY WALL PLAN VIEW DETAIL
N.T.S.

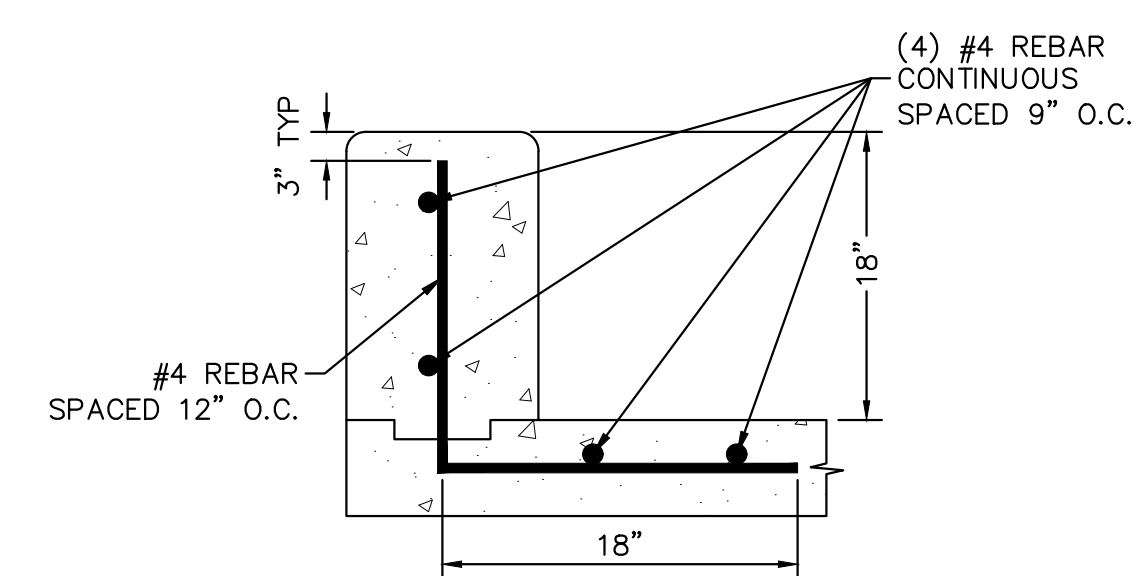


FOREBAY WALL SECTION E
N.T.S.

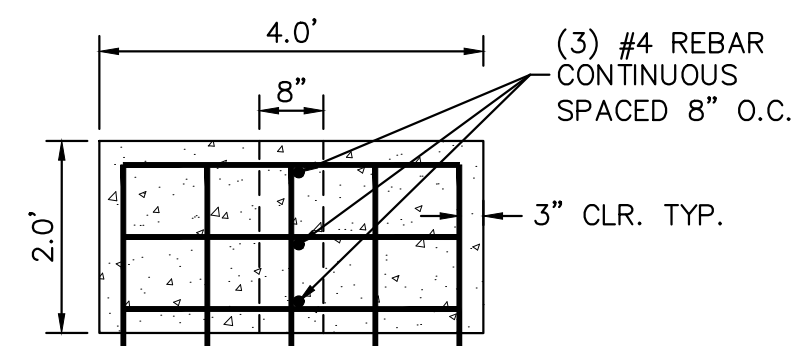

FOREBAY DISSIPATER DETAIL
N.T.S.

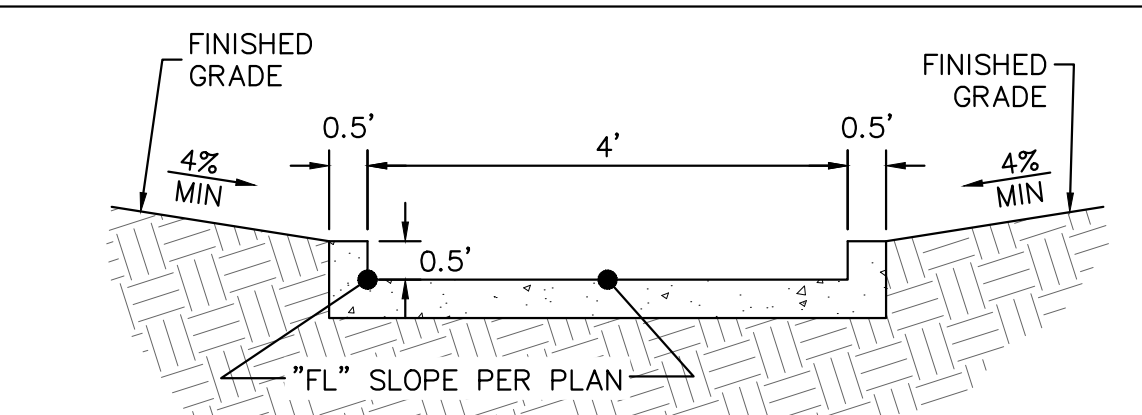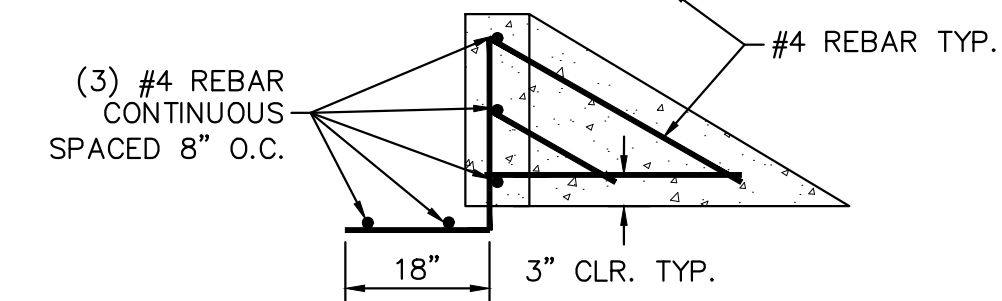


TRICKLE CHANNEL CROSS-SECTION DETAIL
N.T.S.

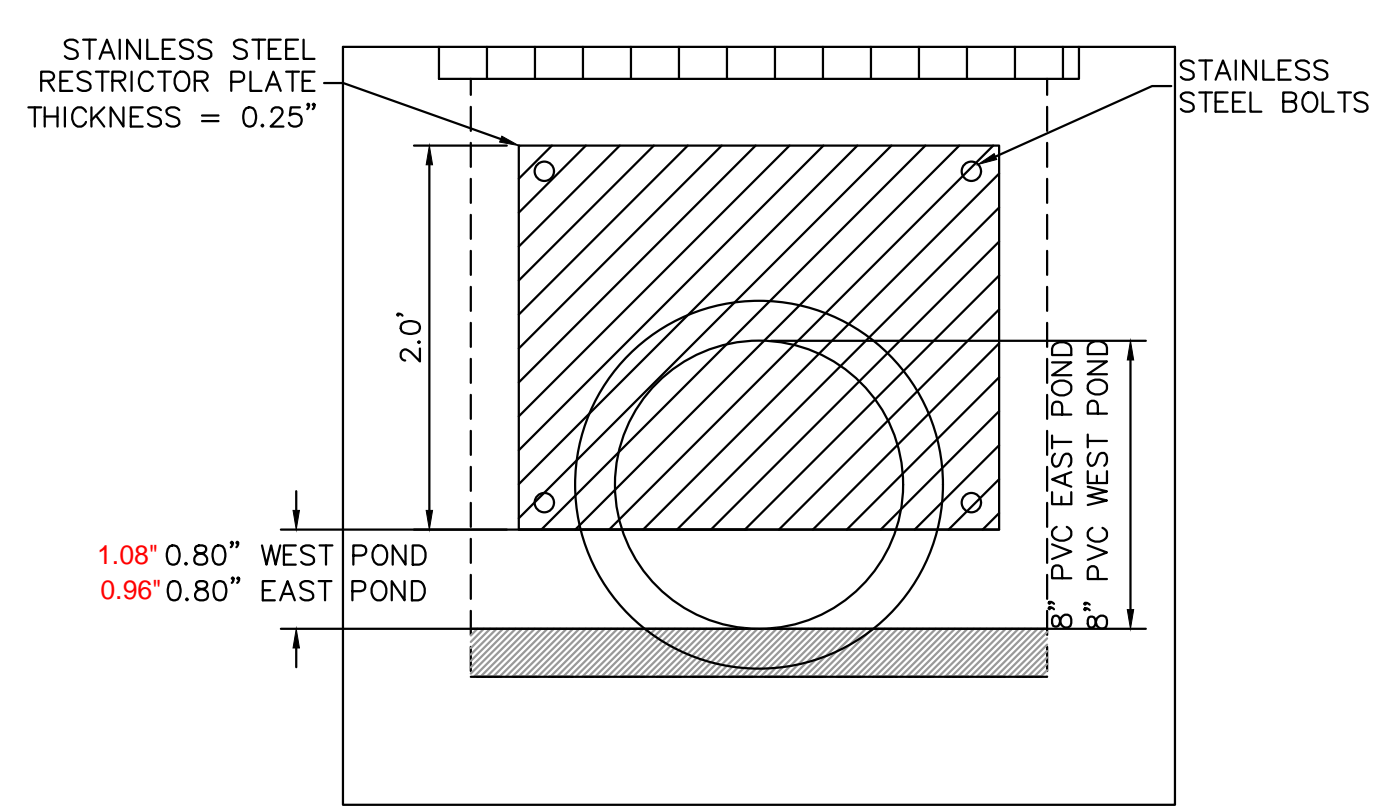


100-YEAR FLOW RESTRICTOR DETAIL
N.T.S.


- LEGEND**
- PROPERTY LINE
 - XXXX PROPOSED MAJOR CONTOUR
 - XXXX PROPOSED MINOR CONTOUR
 - EXISTING MAJOR CONTOUR
 - EXISTING MINOR CONTOUR

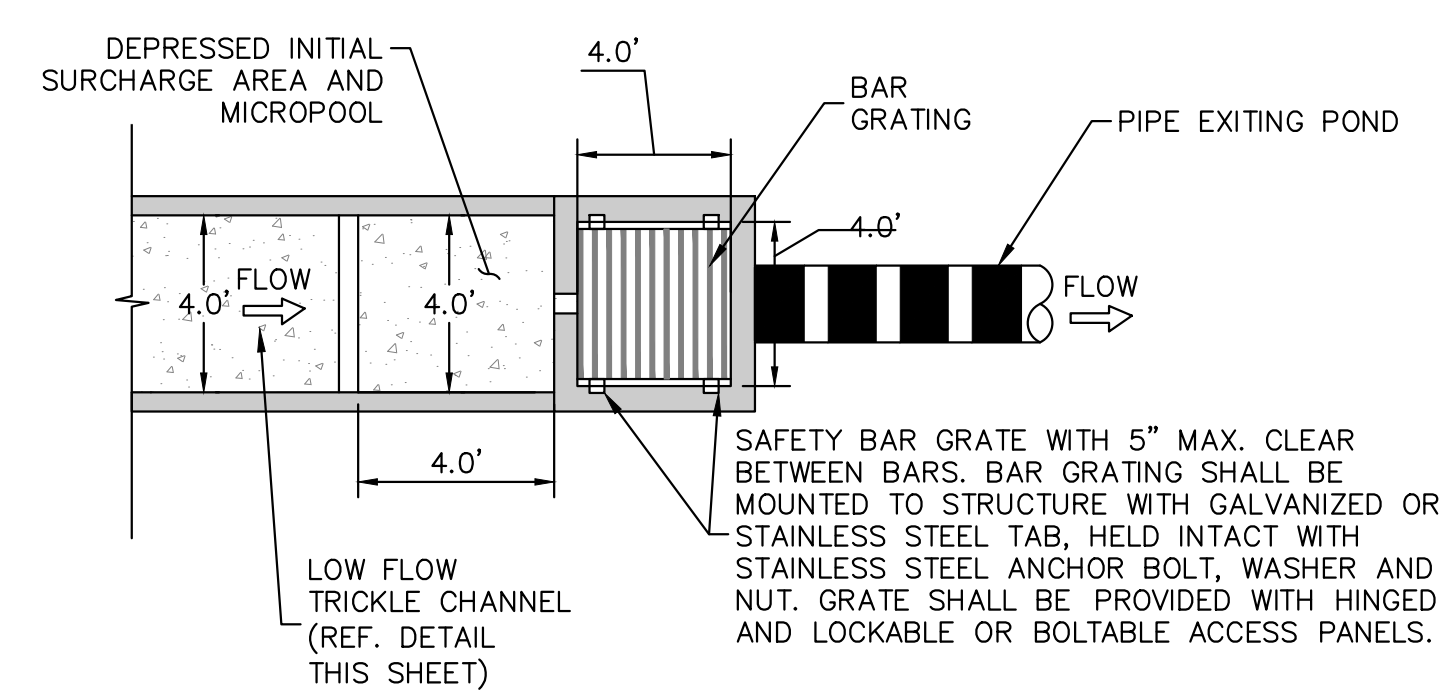


MICROPOOL DETAIL
N.T.S.

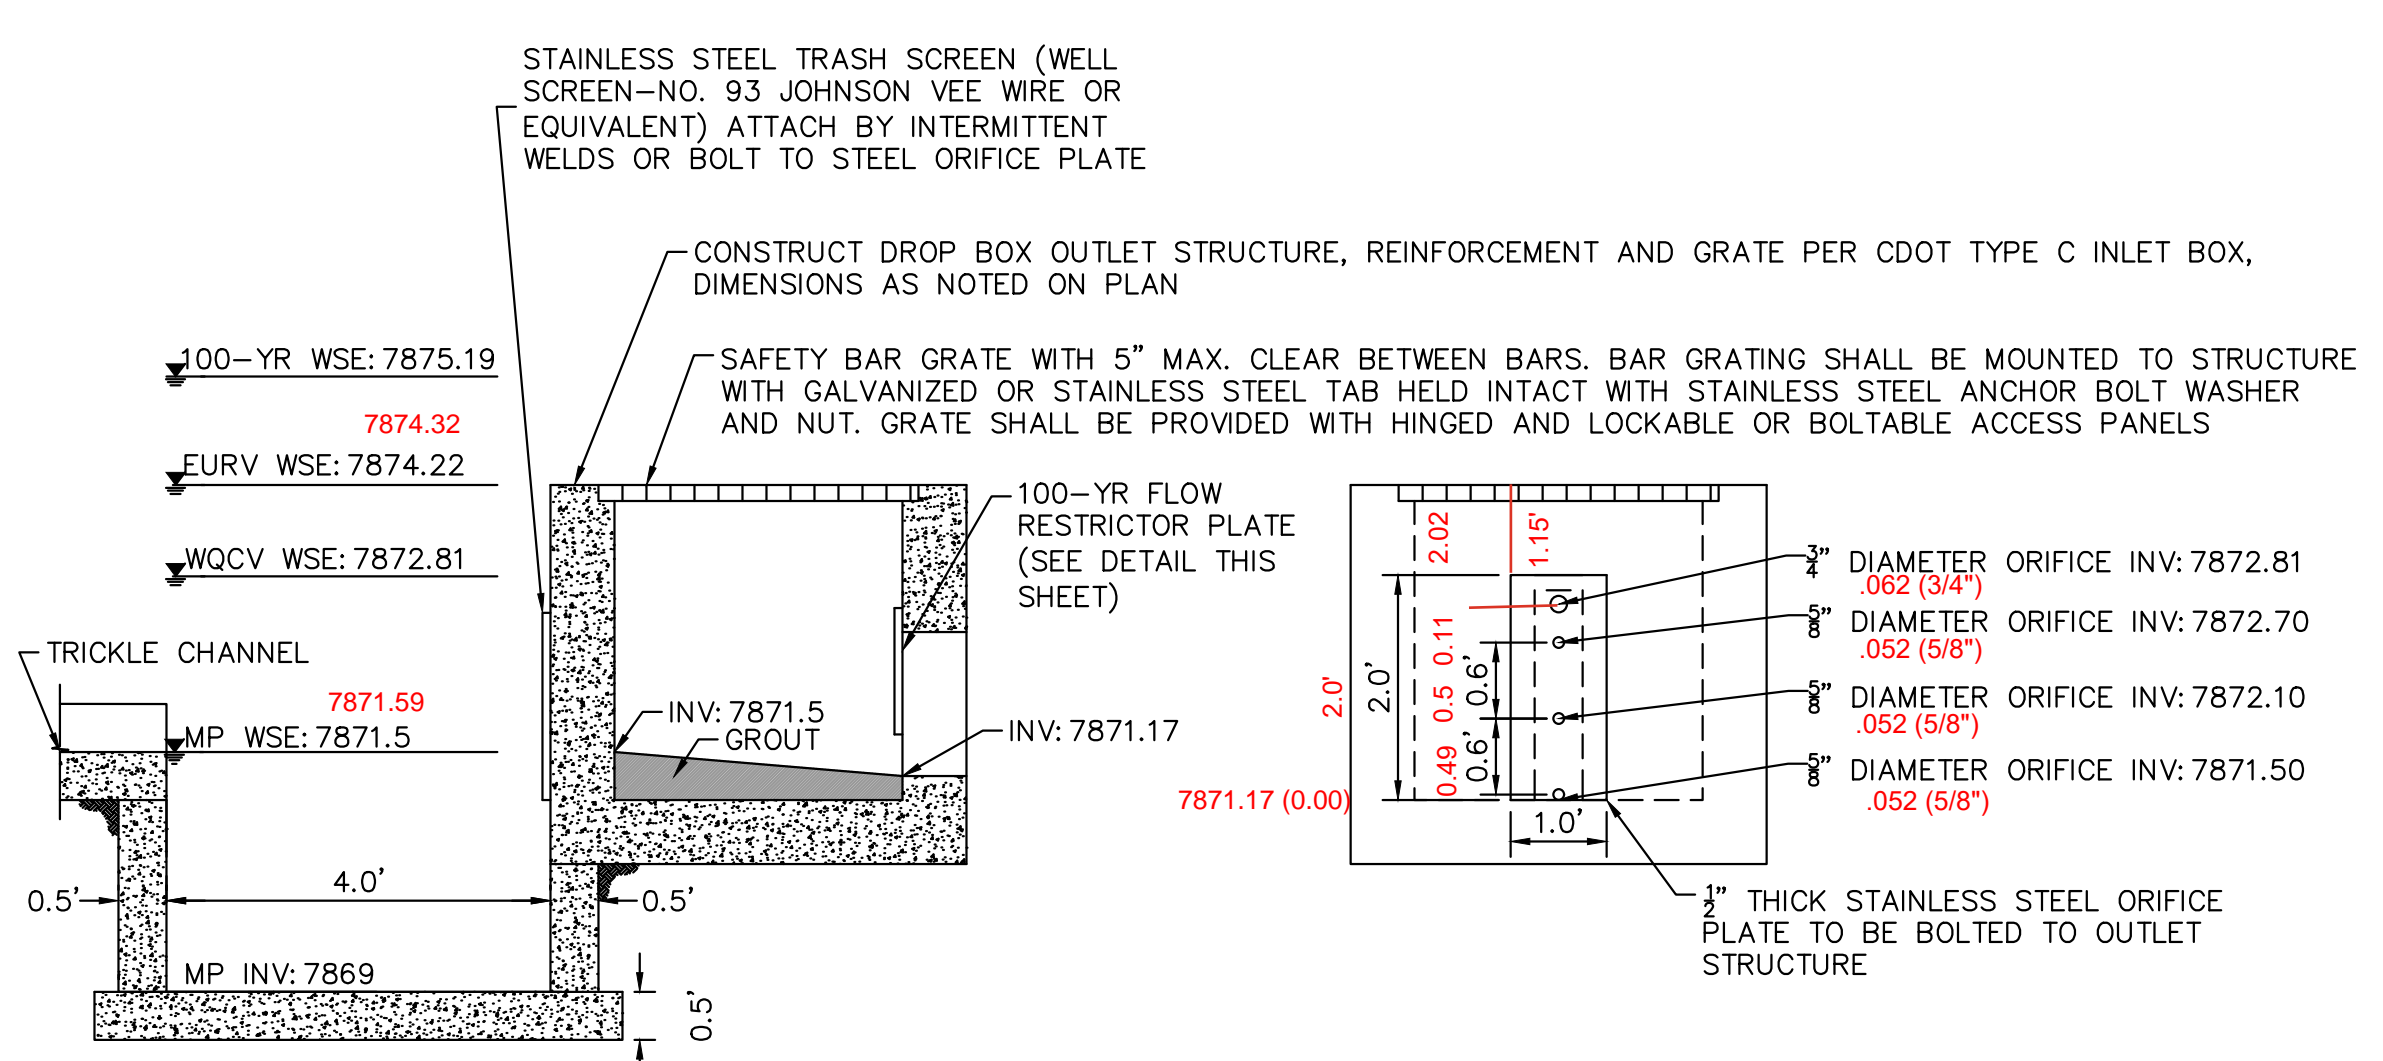


WEST POND OUTLET STRUCTURE PROFILE DETAIL
N.T.S.

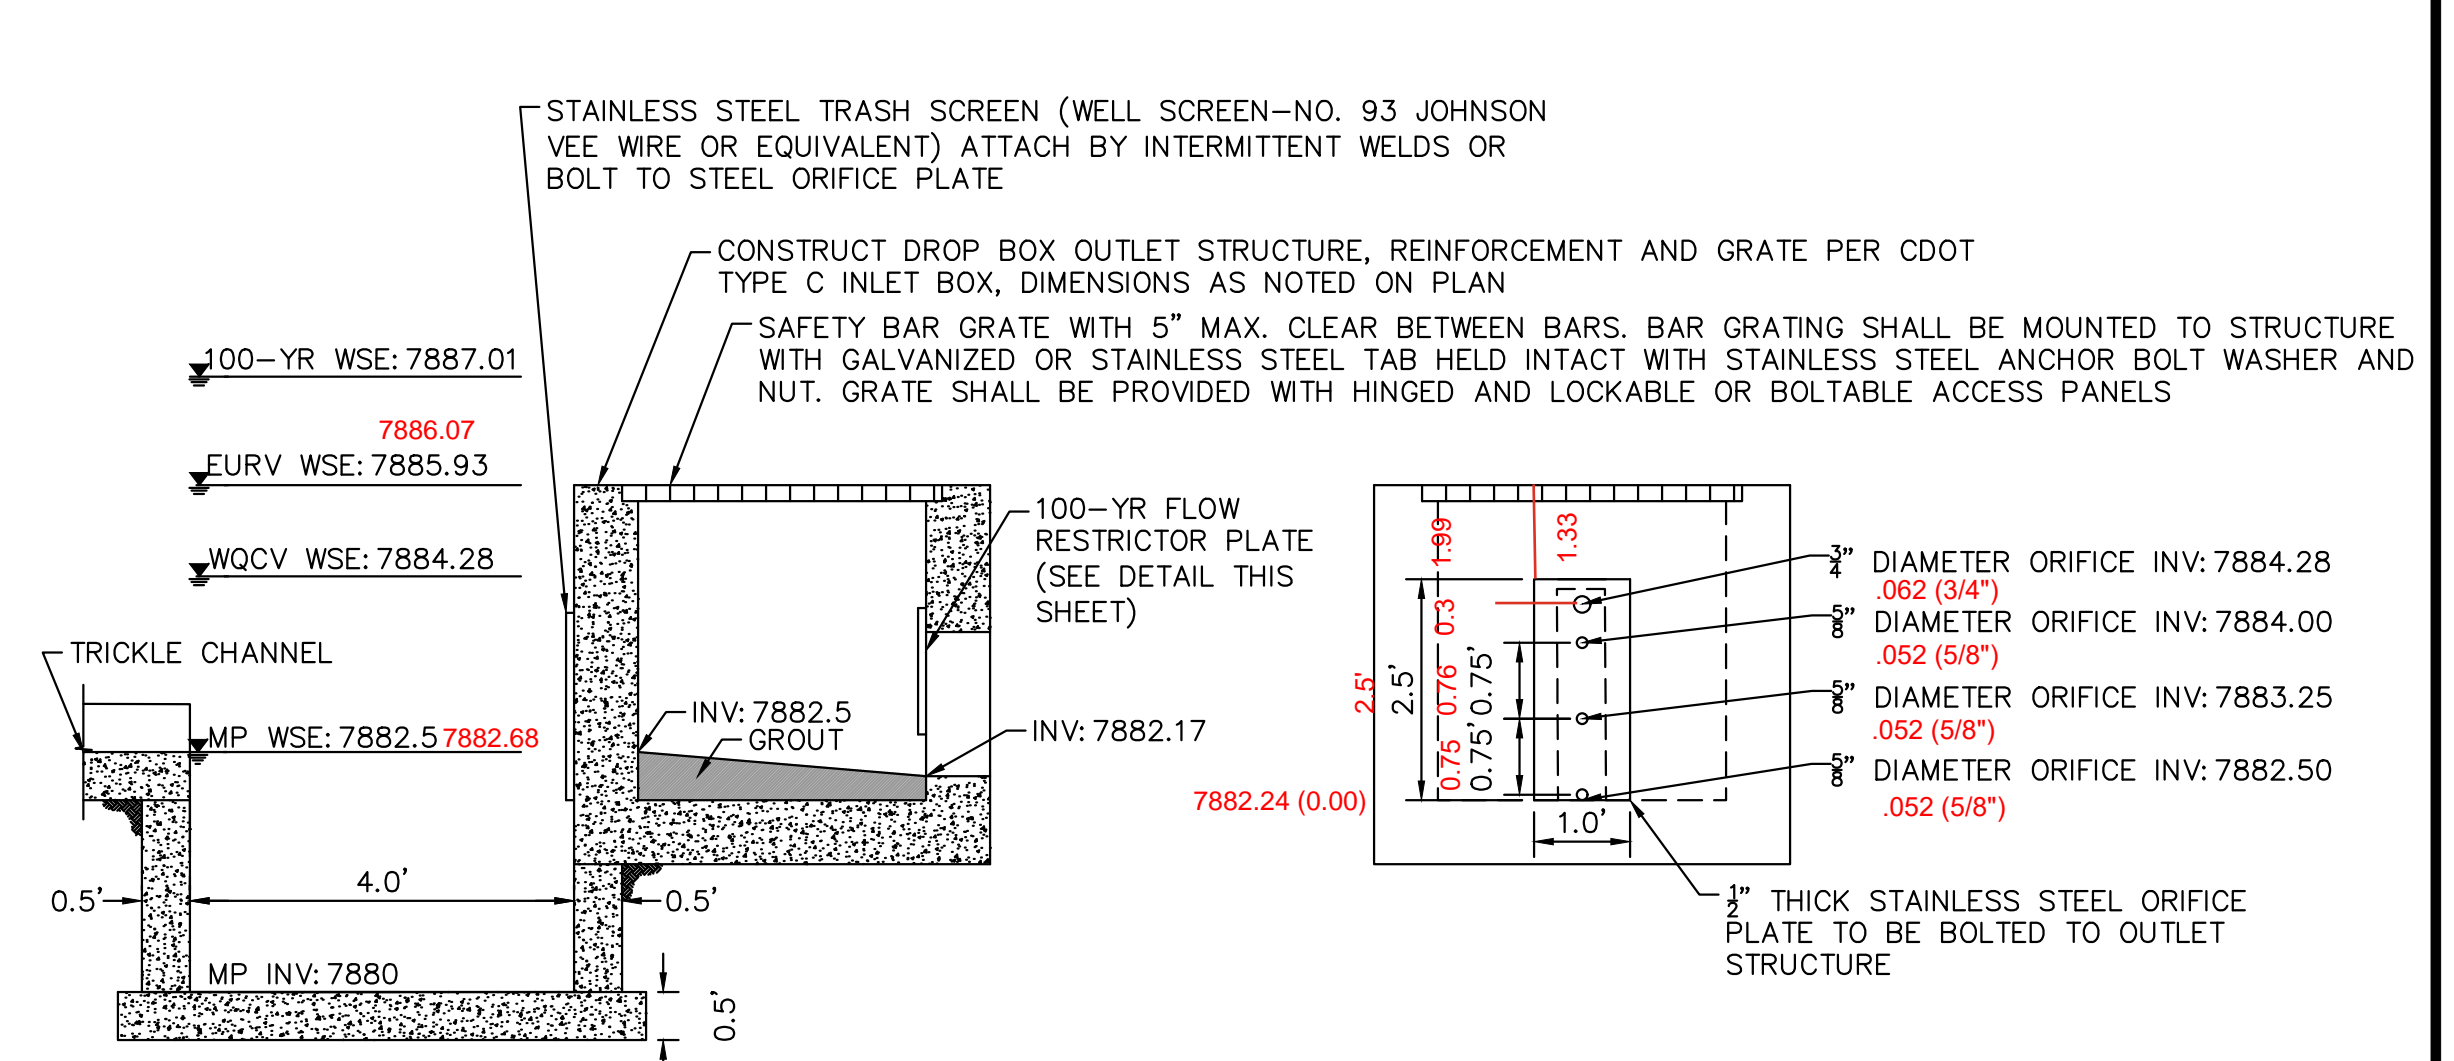


EAST POND OUTLET STRUCTURE PROFILE DETAIL
N.T.S.

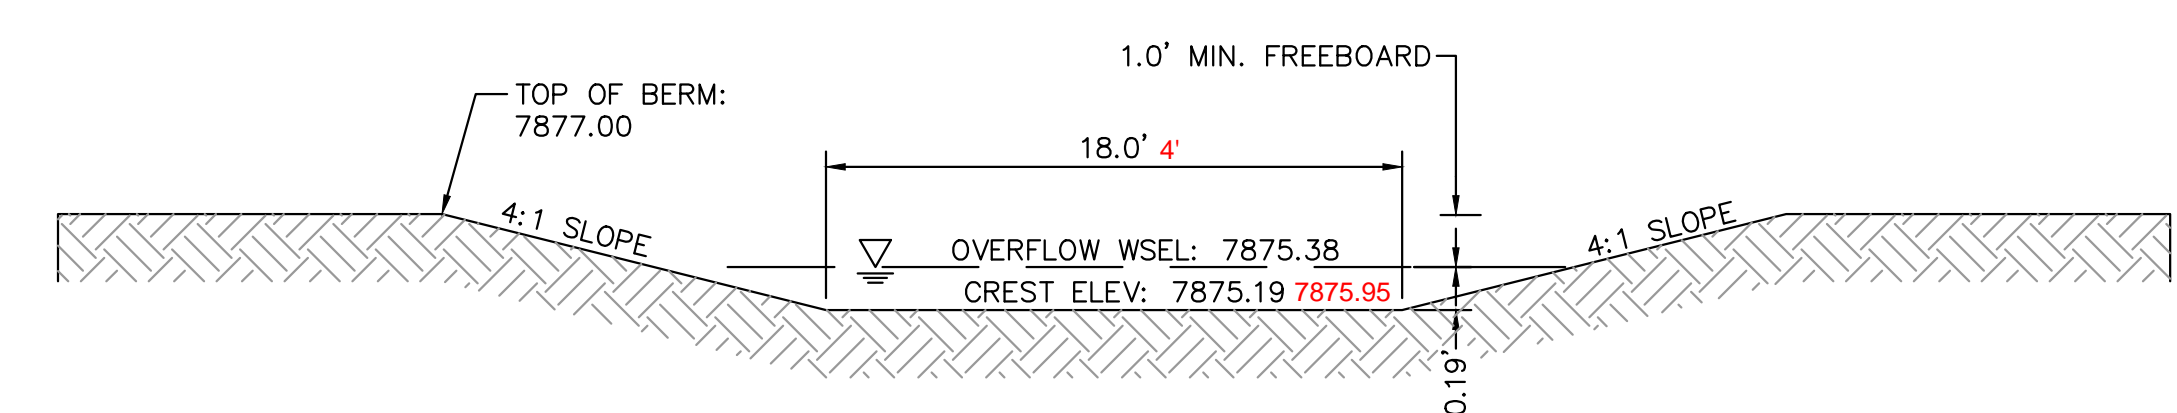

WEST POND EMERGENCY SPILLWAY DETAIL (PROFILE VIEW)
N.T.S.

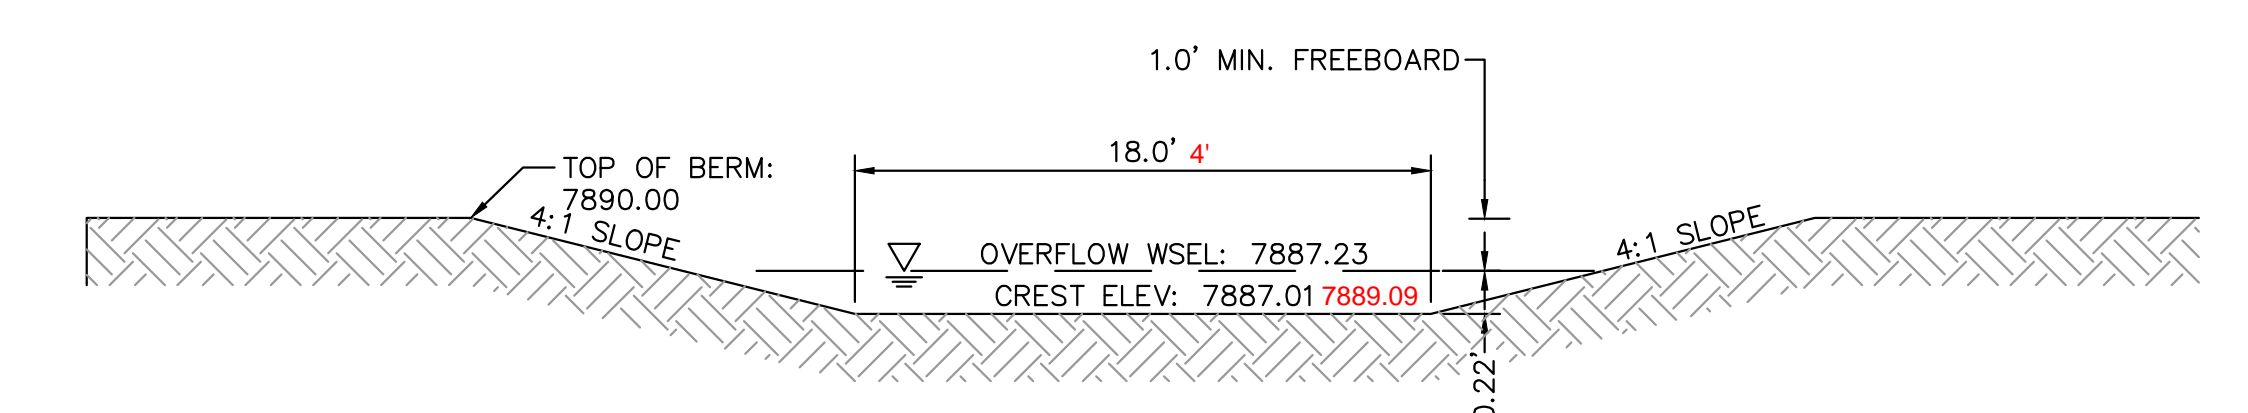

EAST POND EMERGENCY SPILLWAY DETAIL (PROFILE VIEW)
N.T.S.

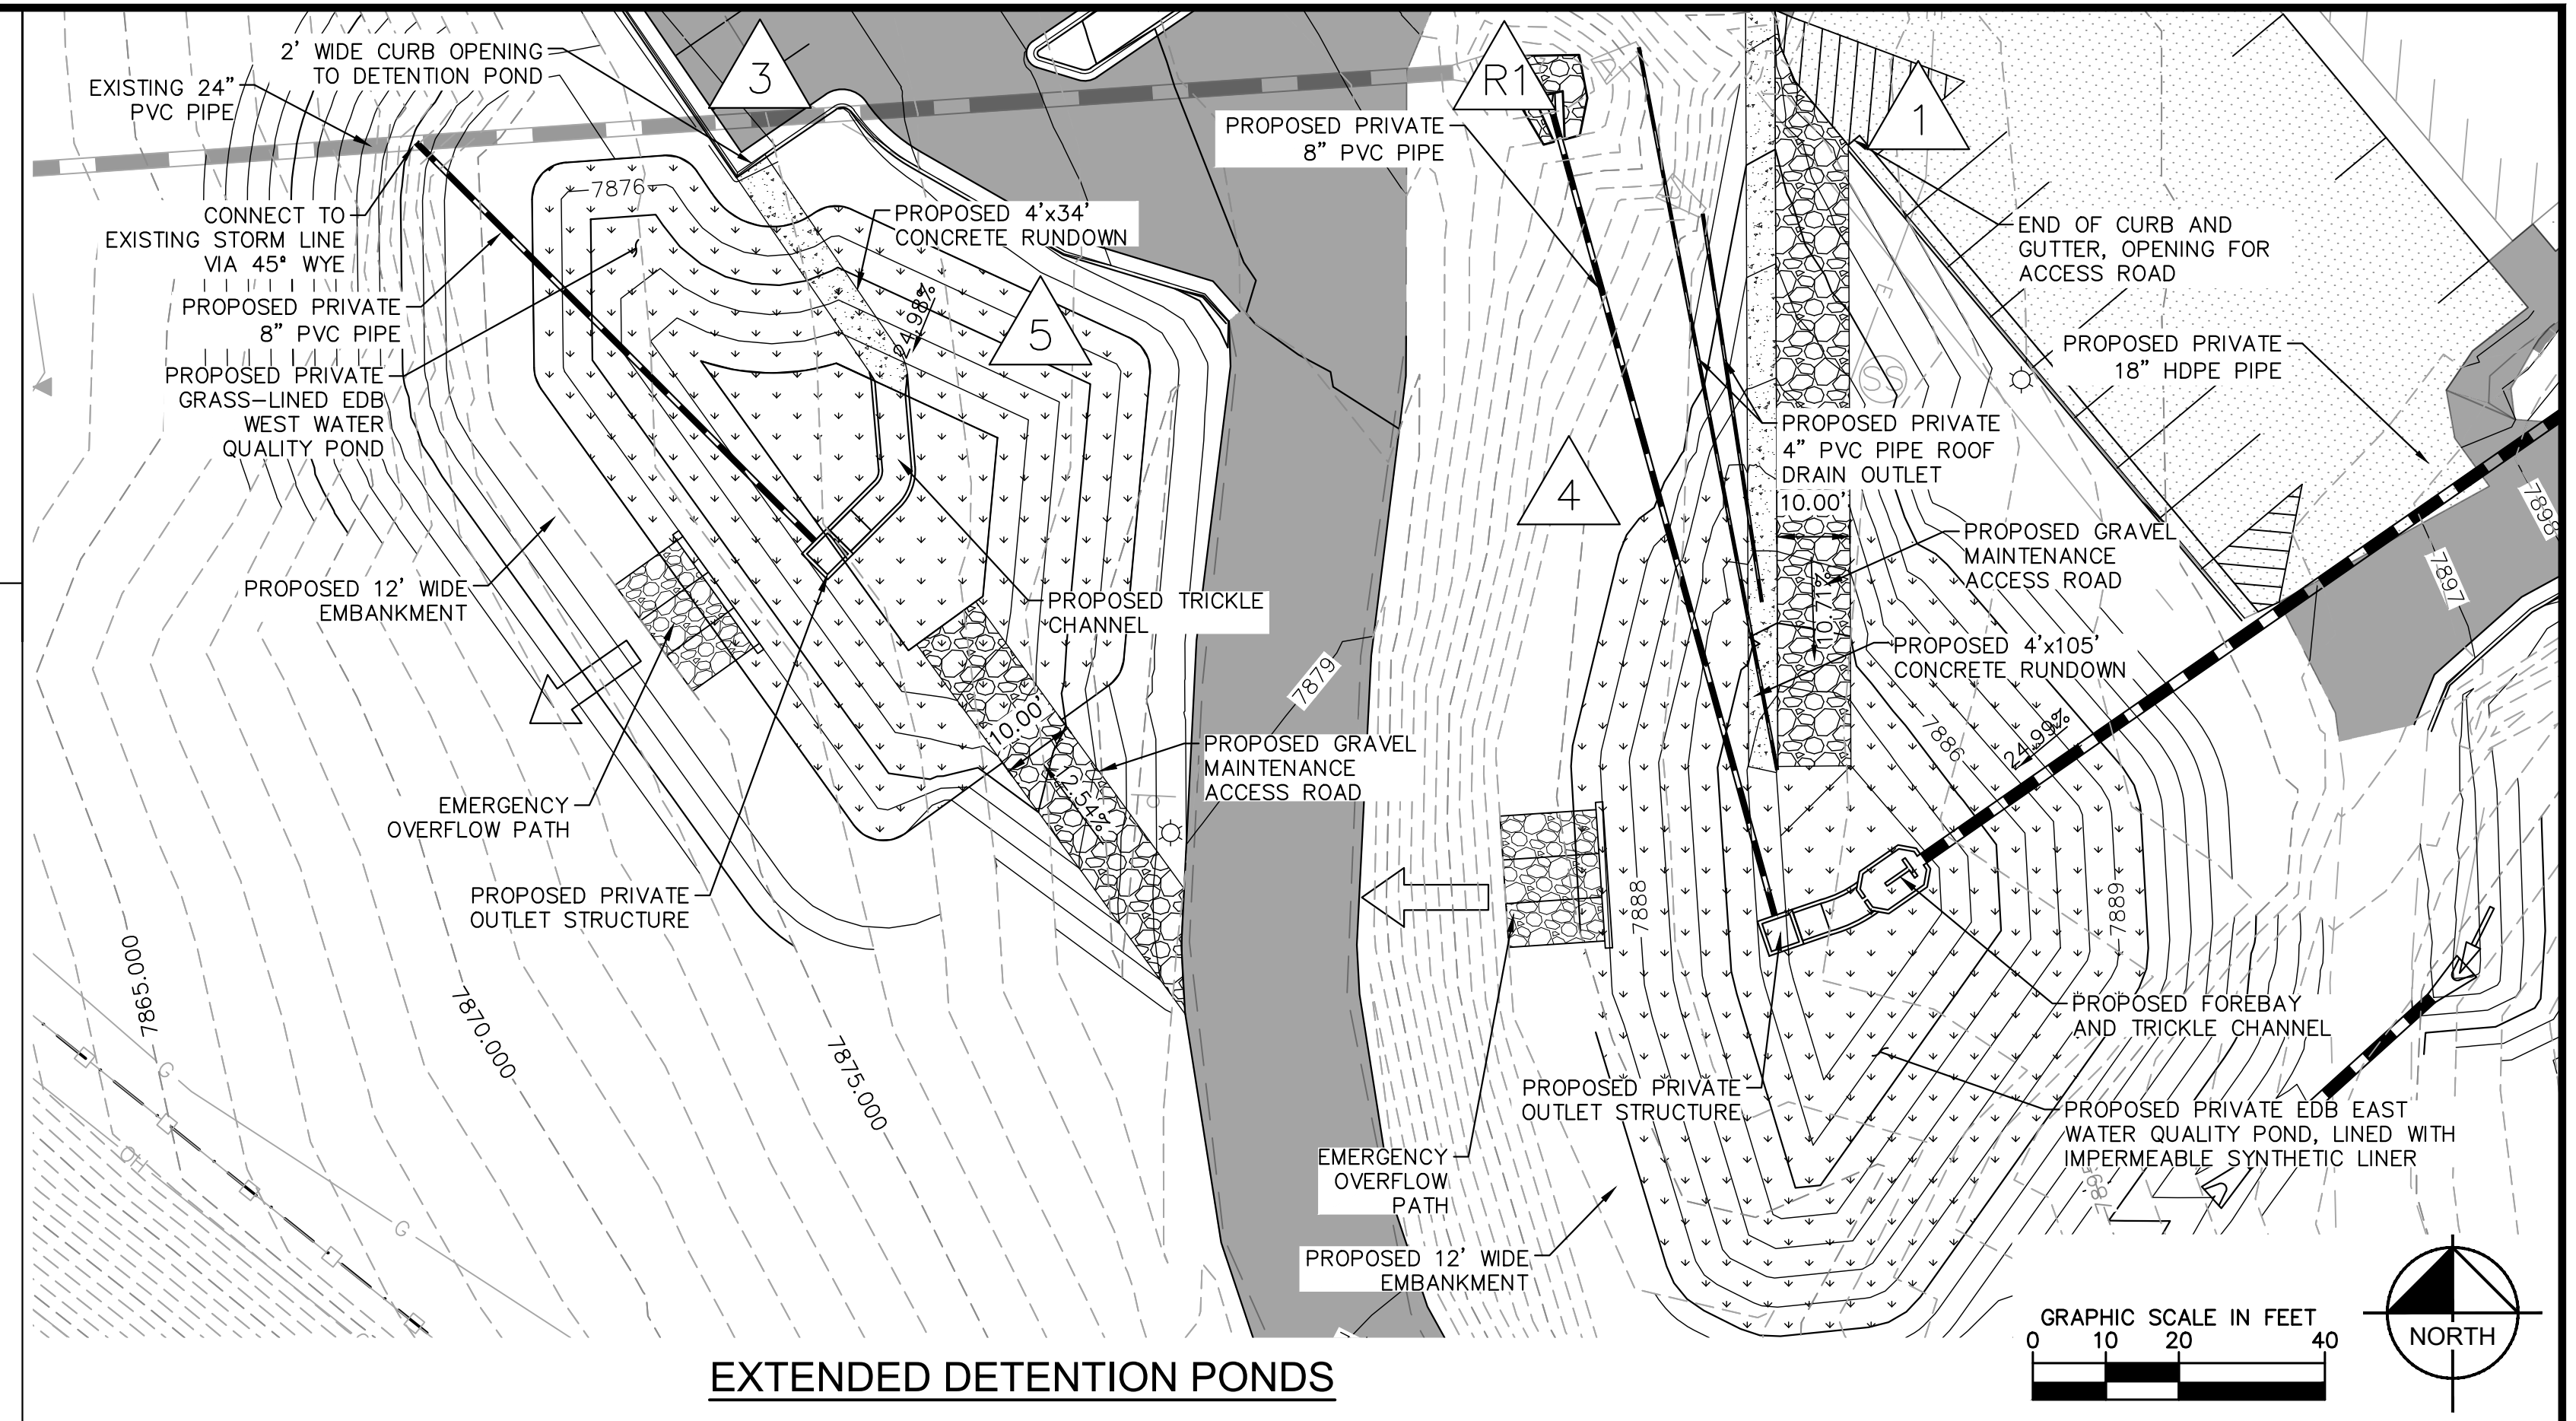

EXTENDED DETENTION PONDS



K:\cs_civil\09856000_green mountain falls church\CADD\Sheets\CDD\ Pond Details.dwg Jul 06, 2020 12:03pm



© 2019 KIMLEY-HORN AND ASSOCIATES, INC.
2 NORTH NEVADA AVENUE, SUITE 300
COLORADO SPRINGS, COLORADO 80903 (719) 453-0180




REV: 7/6/20
REV: 11/22/19
REV: 10/18/19
POND DETAILS
SHEET C2.9

Detention Basin Outlet Structure Design

UD-Detention, Version 3.07 (February 2017)

Project: Legacy Church - Green Mountain Falls - East Pond

Basin ID:

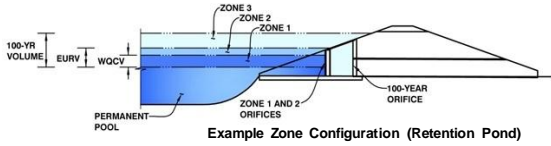

	Stage (ft)	Zone Volume (ac-ft)	Outlet Type
Zone 1 (WQCV)	2.99	0.046	Orifice Plate
Zone 2 (EURV)	4.69	0.088	Circular Orifice
Zone 3 (100-year)	5.75	0.087	Weir&Pipe (Restrict)
		0.221	Total

User Input: Orifice at Underdrain Outlet (typically used to drain WQCV in a Filtration BMP)

Underdrain Orifice Invert Depth = ft (distance below the filtration media surface)
 Underdrain Orifice Diameter = inches

Calculated Parameters for Underdrain

Underdrain Orifice Area = ft²
 Underdrain Orifice Centroid = feet

User Input: Orifice Plate with one or more orifices or Elliptical Slot Weir (typically used to drain WQCV and/or EURV in a sedimentation BMP)

Invert of Lowest Orifice = ft (relative to basin bottom at Stage = 0 ft)
 Depth at top of Zone using Orifice Plate = ft (relative to basin bottom at Stage = 0 ft)
 Orifice Plate: Orifice Vertical Spacing = inches
 Orifice Plate: Orifice Area per Row = inches

Calculated Parameters for Plate

WQ Orifice Area per Row = ft²
 Elliptical Half-Width = feet
 Elliptical Slot Centroid = feet
 Elliptical Slot Area = ft²

User Input: Stage and Total Area of Each Orifice Row (numbered from lowest to highest)

	Row 1 (required)	Row 2 (optional)	Row 3 (optional)	Row 4 (optional)	Row 5 (optional)	Row 6 (optional)	Row 7 (optional)	Row 8 (optional)
Stage of Orifice Centroid (ft)	0.03	0.78	1.54					
Orifice Area (sq. inches)	0.30	0.30	0.30					

	Row 9 (optional)	Row 10 (optional)	Row 11 (optional)	Row 12 (optional)	Row 13 (optional)	Row 14 (optional)	Row 15 (optional)	Row 16 (optional)
Stage of Orifice Centroid (ft)								
Orifice Area (sq. inches)								

User Input: Vertical Orifice (Circular or Rectangular)

	Zone 2 Circular	Not Selected	
Invert of Vertical Orifice =	1.81	N/A	ft (relative to basin bottom at Stage = 0 ft)
Depth at top of Zone using Vertical Orifice =	3.83	N/A	ft (relative to basin bottom at Stage = 0 ft)
Vertical Orifice Diameter =	0.75	N/A	inches

Calculated Parameters for Vertical Orifice

	Zone 2 Circular	Not Selected	
Vertical Orifice Area =	0.00	N/A	ft ²
Vertical Orifice Centroid =	0.03	N/A	feet

User Input: Overflow Weir (Dropbox) and Grate (Flat or Sloped)

	Zone 3 Weir	Not Selected	
Overflow Weir Front Edge Height, Ho =	3.43	N/A	ft (relative to basin bottom at Stage = 0 ft)
Overflow Weir Front Edge Length =	4.00	N/A	feet
Overflow Weir Slope =	0.00	N/A	H:V (enter zero for flat grate)
Horiz. Length of Weir Sides =	4.00	N/A	feet
Overflow Grate Open Area % =	70%	N/A	%, grate open area/total area
Debris Clogging % =	50%	N/A	%

Calculated Parameters for Overflow Weir

	Zone 3 Weir	Not Selected	
Height of Grate Upper Edge, H ₁ =	3.43	N/A	feet
Over Flow Weir Slope Length =	4.00	N/A	feet
Grate Open Area / 100-yr Orifice Area =	472.04	N/A	should be ≥ 4
Overflow Grate Open Area w/o Debris =	11.20	N/A	ft ²
Overflow Grate Open Area w/ Debris =	5.60	N/A	ft ²

User Input: Outlet Pipe w/ Flow Restriction Plate (Circular Orifice, Restrictor Plate, or Rectangular Orifice)

	Zone 3 Restrictor	Not Selected	
Depth to Invert of Outlet Pipe =	0.33	N/A	ft (distance below basin bottom at Stage = 0 ft)
Outlet Pipe Diameter =	8.00	N/A	inches
Restrictor Plate Height Above Pipe Invert =	0.96	N/A	inches

Calculated Parameters for Outlet Pipe w/ Flow Restriction Plate

	Zone 3 Restrictor	Not Selected	
Outlet Orifice Area =	0.02	N/A	ft ²
Outlet Orifice Centroid =	0.05	N/A	feet
Half-Central Angle of Restrictor Plate on Pipe =	0.71	N/A	radians

User Input: Emergency Spillway (Rectangular or Trapezoidal)

Spillway Invert Stage =	6.85	ft (relative to basin bottom at Stage = 0 ft)
Spillway Crest Length =	4.00	feet
Spillway End Slopes =	4.00	H:V
Freeboard above Max Water Surface =	1.00	feet

Calculated Parameters for Spillway

Spillway Design Flow Depth =	0.50	feet
Stage at Top of Freeboard =	8.35	feet
Basin Area at Top of Freeboard =	0.00	acres

Routed Hydrograph Results


	WQCV	EURV	2 Year	5 Year	10 Year	25 Year	50 Year	100 Year	500 Year
Design Storm Return Period									
One-Hour Rainfall Depth (in)	0.53	1.07	1.19	1.51	1.75	2.00	2.25	2.52	0.00
Calculated Runoff Volume (acre-ft)	0.046	0.135	0.130	0.178	0.213	0.260	0.300	0.348	0.000
OPTIONAL Override Runoff Volume (acre-ft)									
Inflow Hydrograph Volume (acre-ft)	0.046	0.135	0.129	0.177	0.212	0.260	0.299	0.347	#N/A
Predevelopment Unit Peak Flow, q (cfs/acre)	0.00	0.00	0.01	0.13	0.34	0.80	1.05	1.37	0.00
Predevelopment Peak Q (cfs)	0.0	0.0	0.0	0.2	0.6	1.4	1.9	2.4	0.0
Peak Inflow Q (cfs)	0.8	2.4	2.3	3.1	3.7	4.6	5.2	6.1	#N/A
Peak Outflow Q (cfs)	0.056	0.2	0.2	0.259	0.3	0.3	0.3	0.298	#N/A
Ratio Peak Outflow to Predevelopment Q	N/A	N/A	N/A	1.2	0.4	0.2	0.2	0.1	#N/A
Structure Controlling Flow	Vertical Orifice 1	Outlet Plate 1	Outlet Plate 1	Outlet Plate 1	Outlet Plate 1	Outlet Plate 1	Outlet Plate 1	Outlet Plate 1	#N/A
Max Velocity through Grate 1 (fps)	N/A	0.01	0.01	0.0	0.0	0.0	0.0	0.0	#N/A
Max Velocity through Grate 2 (fps)	N/A	N/A	N/A	N/A	N/A	N/A	N/A	N/A	#N/A
Time to Drain 97% of Inflow Volume (hours)	17	22	22	23	23	25	26	27	#N/A
Time to Drain 99% of Inflow Volume (hours)	19	25	25	26	27	28	30	31	#N/A
Maximum Ponding Depth (ft)	2.77	4.30	4.21	4.87	5.27	5.77	6.14	6.53	#N/A
Area at Maximum Ponding Depth (acres)	0.03	0.06	0.06	0.07	0.08	0.10	0.11	0.12	#N/A
Maximum Volume Stored (acre-ft)	0.039	0.110	0.104	0.148	0.179	0.224	0.261	0.307	#N/A

Detention Basin Outlet Structure Design

UD-Detention, Version 3.07 (February 2017)

Project: Legacy Church - Green Mountain Falls - West Pond

Basin ID:

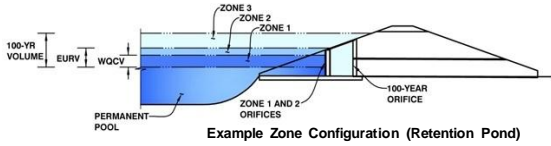

	Stage (ft)	Zone Volume (ac-ft)	Outlet Type
Zone 1 (WQCV)	2.11	0.037	Orifice Plate
Zone 2 (EURV)	3.52	0.071	Circular Orifice
Zone 3 (100-year)	4.53	0.072	Weir&Pipe (Restrict)
		0.180	Total

User Input: Orifice at Underdrain Outlet (typically used to drain WQCV in a Filtration BMP)

Underdrain Orifice Invert Depth =	N/A	ft (distance below the filtration media surface)
Underdrain Orifice Diameter =	N/A	inches

Calculated Parameters for Underdrain

Underdrain Orifice Area =	N/A	ft ²
Underdrain Orifice Centroid =	N/A	feet

User Input: Orifice Plate with one or more orifices or Elliptical Slot Weir (typically used to drain WQCV and/or EURV in a sedimentation BMP)

Invert of Lowest Orifice =	0.00	ft (relative to basin bottom at Stage = 0 ft)
Depth at top of Zone using Orifice Plate =	1.10	ft (relative to basin bottom at Stage = 0 ft)
Orifice Plate: Orifice Vertical Spacing =	N/A	inches
Orifice Plate: Orifice Area per Row =	N/A	inches

Calculated Parameters for Plate

WO Orifice Area per Row =	N/A	ft ²
Elliptical Half-Width =	N/A	feet
Elliptical Slot Centroid =	N/A	feet
Elliptical Slot Area =	N/A	ft ²

User Input: Stage and Total Area of Each Orifice Row (numbered from lowest to highest)

	Row 1 (required)	Row 2 (optional)	Row 3 (optional)	Row 4 (optional)	Row 5 (optional)	Row 6 (optional)	Row 7 (optional)	Row 8 (optional)
Stage of Orifice Centroid (ft)	0.03	0.52	1.02					
Orifice Area (sq. inches)	0.30	0.30	0.30					

	Row 9 (optional)	Row 10 (optional)	Row 11 (optional)	Row 12 (optional)	Row 13 (optional)	Row 14 (optional)	Row 15 (optional)	Row 16 (optional)
Stage of Orifice Centroid (ft)								
Orifice Area (sq. inches)								

User Input: Vertical Orifice (Circular or Rectangular)

	Zone 2 Circular	Not Selected	
Invert of Vertical Orifice =	1.10	N/A	ft (relative to basin bottom at Stage = 0 ft)
Depth at top of Zone using Vertical Orifice =	3.15	N/A	ft (relative to basin bottom at Stage = 0 ft)
Vertical Orifice Diameter =	0.75	N/A	inches

Calculated Parameters for Vertical Orifice

	Zone 2 Circular	Not Selected	
Vertical Orifice Area =	0.00	N/A	ft ²
Vertical Orifice Centroid =	0.03	N/A	feet

User Input: Overflow Weir (Dropbox) and Grate (Flat or Sloped)

	Zone 3 Weir	Not Selected	
Overflow Weir Front Edge Height, Ho =	3.15	N/A	ft (relative to basin bottom at Stage = 0 ft)
Overflow Weir Front Edge Length =	4.00	N/A	feet
Overflow Weir Slope =	0.00	N/A	H:V (enter zero for flat grate)
Horiz. Length of Weir Sides =	4.00	N/A	feet
Overflow Grate Open Area % =	70%	N/A	%, grate open area/total area
Debris Clogging % =	50%	N/A	%

Calculated Parameters for Overflow Weir

	Zone 3 Weir	Not Selected	
Height of Grate Upper Edge, H ₁ =	3.15	N/A	feet
Over Flow Weir Slope Length =	4.00	N/A	feet
Grate Open Area / 100-yr Orifice Area =	397.54	N/A	should be ≥ 4
Overflow Grate Open Area w/o Debris =	11.20	N/A	ft ²
Overflow Grate Open Area w/ Debris =	5.60	N/A	ft ²

User Input: Outlet Pipe w/ Flow Restriction Plate (Circular Orifice, Restrictor Plate, or Rectangular Orifice)

	Zone 3 Restrictor	Not Selected	
Depth to Invert of Outlet Pipe =	0.33	N/A	ft (distance below basin bottom at Stage = 0 ft)
Outlet Pipe Diameter =	8.00	N/A	inches
Restrictor Plate Height Above Pipe Invert =	1.08	N/A	inches

Calculated Parameters for Outlet Pipe w/ Flow Restriction Plate

	Zone 3 Restrictor	Not Selected	
Outlet Orifice Area =	0.03	N/A	ft ²
Outlet Orifice Centroid =	0.05	N/A	feet
Half-Central Angle of Restrictor Plate on Pipe =	0.75	N/A	radians

User Input: Emergency Spillway (Rectangular or Trapezoidal)

Spillway Invert Stage =	4.78	ft (relative to basin bottom at Stage = 0 ft)
Spillway Crest Length =	4.00	feet
Spillway End Slopes =	4.00	H:V
Freeboard above Max Water Surface =	1.00	feet

Calculated Parameters for Spillway

Spillway Design Flow Depth =	0.43	feet
Stage at Top of Freeboard =	6.21	feet
Basin Area at Top of Freeboard =	0.11	acres

Routed Hydrograph Results

	WQCV	EURV	2 Year	5 Year	10 Year	25 Year	50 Year	100 Year	500 Year
Design Storm Return Period									
One-Hour Rainfall Depth (in)	0.53	1.07	1.19	1.50	1.75	2.00	2.25	2.52	0.00
Calculated Runoff Volume (acre-ft)	0.037	0.108	0.104	0.143	0.172	0.213	0.247	0.288	0.000
OPTIONAL Override Runoff Volume (acre-ft)									
Inflow Hydrograph Volume (acre-ft)	0.036	0.107	0.103	0.142	0.172	0.213	0.246	0.288	#N/A
Predevelopment Unit Peak Flow, q (cfs/acre)	0.00	0.00	0.01	0.12	0.32	0.76	1.00	1.31	0.00
Predevelopment Peak Q (cfs)	0.0	0.0	0.0	0.2	0.5	1.1	1.5	2.0	0.0
Peak Inflow Q (cfs)	0.6	1.8	1.7	2.4	2.8	3.5	4.1	4.7	#N/A
Peak Outflow Q (cfs)	0.049	0.254	0.250	0.269	0.281	0.296	0.456	1.410	#N/A
Ratio Peak Outflow to Predevelopment Q	N/A	N/A	N/A	1.5	0.6	0.3	0.3	0.7	#N/A
Structure Controlling Flow	Vertical Orifice 1	Outlet Plate 1	Outlet Plate 1	Outlet Plate 1	Outlet Plate 1	Outlet Plate 1	Spillway	Spillway	#N/A
Max Velocity through Grate 1 (fps)	N/A	0.02	0.02	0.0	0.0	0.0	0.0	0.0	#N/A
Max Velocity through Grate 2 (fps)	N/A	N/A	N/A	N/A	N/A	N/A	N/A	N/A	#N/A
Time to Drain 97% of Inflow Volume (hours)	15	24	24	24	25	25	26	25	#N/A
Time to Drain 99% of Inflow Volume (hours)	16	26	26	27	28	29	29	29	#N/A
Maximum Ponding Depth (ft)	1.94	3.22	3.18	3.66	4.01	4.50	4.83	4.97	#N/A
Area at Maximum Ponding Depth (acres)	0.04	0.06	0.06	0.06	0.07	0.08	0.09	0.09	#N/A
Maximum Volume Stored (acre-ft)	0.030	0.090	0.088	0.116	0.141	0.177	0.206	0.217	#N/A