

# SADDLEHORN RANCH FILING NO.4

A PARCEL OF LAND LOCATED IN SECTION 3  
TOWNSHIP 13 SOUTH, RANGE 64 WEST OF THE 6TH PRINCIPAL MERIDIAN  
COUNTY OF EL PASO, STATE OF COLORADO

Include quarter-section

## KNOW ALL MEN BY THESE PRESENTS

THAT GORILLA CAPITAL CO SADDLEHORN RANCH, LLC, BEING THE OWNER OF THE FOLLOWING TRACT OF LAND:

A PARCEL OF LAND LOCATED IN SECTION 3, TOWNSHIP 13 SOUTH, RANGE 64 WEST OF THE 6TH P.M., COUNTY OF EL PASO, STATE OF COLORADO, BEING MORE PARTICULARLY DESCRIBED AS FOLLOWS:

BASIS OF BEARINGS: THE NORTH LINE OF SECTION 3, T3S, R64W, 6TH P.M., MONUMENTED BY A 3-1/4" ALUMINUM CAP STAMPED "PLS 17496" IN A RANGE BOX AT THE NORTHWEST CORNER OF SECTION 3 AND A 3-1/4" ALUMINUM CAP STAMPED "LS 17496" IN A RANGE BOX AT THE NORTHEAST CORNER OF SECTION 3, BEARING S89°59'23"E AS REFERENCED TO COLORADO STATE PLANE CENTRAL ZONE.

COMMENCING AT THE NORTHWEST CORNER OF SECTION 3, TOWNSHIP 13 SOUTH, RANGE 64 WEST OF THE 6TH PRINCIPAL MERIDIAN;

THENCE ON THE NORTH LINE OF SAID SECTION 3, S89°59'23"E A DISTANCE OF 3,376.48 FEET;

THENCE DEPARTING SAID NORTH LINE, S00°00'37"W A DISTANCE OF 30.00 FEET, TO A POINT ON THE SOUTHERLY RIGHT-OF-WAY LINE OF JUDGE ORR ROAD, SAID POINT ALSO BEING THE NORTHEASTERLY CORNER OF SADDLEHORN RANCH FILING NO. 3 RECORDED UNDER RECEPTION NO. \_\_\_\_\_ IN THE RECORDS OF THE EL PASO COUNTY CLERK AND RECORDER, AND THE POINT OF BEGINNING;

THENCE ON SAID SOUTHERLY RIGHT-OF-WAY LINE, S89°59'23"E A DISTANCE OF 1899.15 FEET, TO A POINT ON THE EAST LINE OF SAID SECTION 3;

THENCE ON SAID EAST LINE, S00°42'27"E A DISTANCE OF 2798.97 FEET;

THENCE DEPARTING SAID EAST LINE THE FOLLOWING EIGHT (8) COURSES:

- S89°17'33"W A DISTANCE OF 29.12 FEET;
- N44°37'45"W A DISTANCE OF 546.60 FEET, TO A POINT OF NON-TANGENT CURVE;
- ON THE ARC OF A CURVE TO THE RIGHT WHOSE CENTER BEARS N48°36'47"W, HAVING A RADIUS OF 60.00 FEET, A CENTRAL ANGLE OF 48°37'24" AND AN ARC LENGTH OF 50.92 FEET, TO A POINT OF TANGENT;
- N89°59'23"W A DISTANCE OF 341.47 FEET;
- S00°42'27"E A DISTANCE OF 733.37 FEET;
- S89°17'33"W A DISTANCE OF 277.39 FEET, TO A POINT OF CURVE;
- ON THE ARC OF A CURVE TO THE RIGHT, HAVING A RADIUS OF 60.00 FEET, A CENTRAL ANGLE OF 46°10'29" AND AN ARC LENGTH OF 48.35 FEET, TO A POINT OF NON-TANGENT;
- S84°04'11"W A DISTANCE OF 279.81 FEET, TO A POINT ON THE NORTHERLY LINE OF SADDLEHORN RANCH FILING NO. 2 RECORDED UNDER RECEPTION NO. \_\_\_\_\_;

THENCE ON THE NORTHERLY LINES OF SAID SADDLEHORN RANCH FILING NO. 2, THE FOLLOWING SEVEN (7) COURSES:

- N12°59'32"W A DISTANCE OF 287.70 FEET;
- N58°21'31"W A DISTANCE OF 99.14 FEET;
- N83°17'36"W A DISTANCE OF 453.41 FEET;
- N80°55'05"W A DISTANCE OF 329.85 FEET;
- N65°55'05"W A DISTANCE OF 154.37 FEET;
- S78°29'56"W A DISTANCE OF 122.41 FEET;
- N63°25'19"W A DISTANCE OF 253.86 FEET, TO A POINT OF NON-TANGENT CURVE ON THE EASTERLY LINE OF SAID SADDLEHORN RANCH FILING NO. 3;

THENCE ON THE EASTERLY LINES OF SAID SADDLEHORN RANCH FILING NO. 3, THE FOLLOWING EIGHT (8) COURSES:


- ON THE ARC OF A CURVE TO THE LEFT WHOSE CENTER BEARS N63°25'19"W, HAVING A RADIUS OF 3780.00 FEET, A CENTRAL ANGLE OF 02°54'45" AND AN ARC LENGTH OF 192.15 FEET, TO A POINT OF TANGENT;
- N23°39'56"E A DISTANCE OF 488.23 FEET, TO A POINT OF CURVE;
- ON THE ARC OF A CURVE TO THE RIGHT, HAVING A RADIUS OF 320.00 FEET, A CENTRAL ANGLE OF 29°21'21" AND AN ARC LENGTH OF 163.95 FEET, TO A POINT OF TANGENT;
- N53°01'17"E A DISTANCE OF 50.63 FEET, TO A POINT OF NON-TANGENT CURVE;
- ON THE ARC OF A CURVE TO THE RIGHT WHOSE CENTER BEARS N54°27'30"E, HAVING A RADIUS OF 710.00 FEET, A CENTRAL ANGLE OF 34°50'03" AND AN ARC LENGTH OF 431.66 FEET, TO A POINT OF TANGENT;
- N00°42'27"W A DISTANCE OF 1366.43 FEET;
- S89°59'23"E A DISTANCE OF 600.05 FEET;
- N00°42'27"W A DISTANCE OF 40.00 FEET, TO THE POINT OF BEGINNING.

CONTAINING A CALCULATED AREA OF 7,070,569 SQUARE FEET OR 162.3179 ACRES.

## DEDICATION

THE ABOVE OWNER HAS CAUSED SAID TRACT OF LAND TO BE PLATTED INTO 42 LOTS, STREETS, 2 TRACTS, AND EASEMENTS AS SHOWN ON THIS PLAT. THE UNDERSIGNED DOES HEREBY DEDICATE, GRANT AND CONVEY TO EL PASO COUNTY THOSE STREETS AND PUBLIC EASEMENTS AS SHOWN ON THE PLAT, AND FURTHER RESTRICTS THE USE OF ALL PUBLIC EASEMENTS TO EL PASO COUNTY AND/OR ITS ASSIGNS. PROVIDED HOWEVER, THAT THE SOLE RIGHT AND AUTHORITY TO VACATE, RELEASE OR QUIT-CLAIM ALL OR ANY SUCH PUBLIC EASEMENTS SHALL REMAIN EXCLUSIVELY VESTED IN EL PASO COUNTY. ALL PUBLIC STREETS ARE HEREBY DEDICATED TO EL PASO COUNTY FOR PUBLIC USE. THIS TRACT OF LAND AS HEREIN PLATTED SHALL BE KNOWN AS "SADDLEHORN RANCH FILING NO. 4" IN EL PASO COUNTY, COLORADO.

This statement is redundant to the owner's certificate.

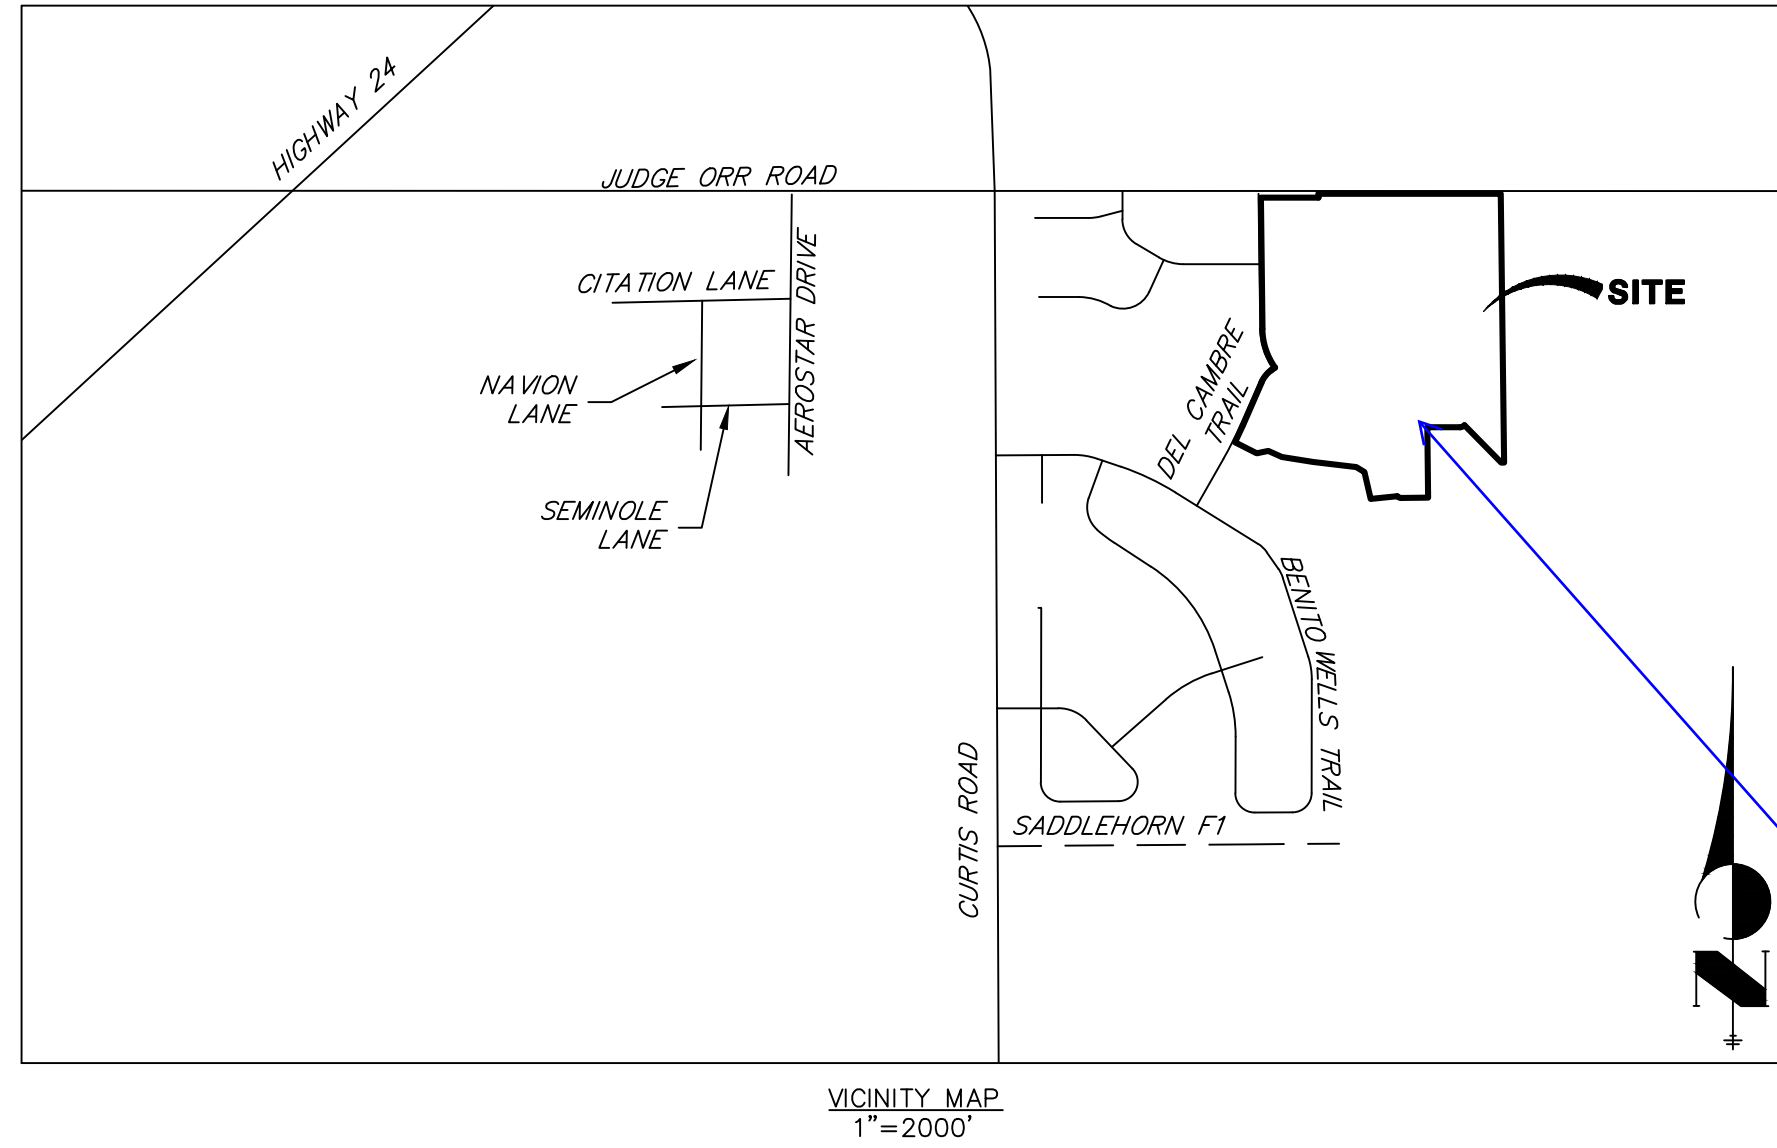

## GENERAL NOTES:

- PER C.R.S. 38-51-106, "ALL LINEAL UNITS DEPICTED ON THIS LAND SURVEY PLAT ARE U.S. SURVEY FEET". ONE METER EQUALS 39.37/12 U.S. SURVEY FEET, EXACTLY ACCORDING TO THE NATIONAL INSTITUTE OF STANDARDS AND TECHNOLOGY
- BASIS OF BEARING: THE NORTH LINE OF SECTION 3, T3S, R64W, 6TH P.M., MONUMENTED BY A 3-1/4" ALUMINUM CAP STAMPED "PLS 17496" IN A RANGE BOX AT THE NORTHWEST CORNER OF SECTION 3 AND A 3-1/4" ALUMINUM CAP STAMPED "PLS 17496" IN A RANGE BOX AT THE NORTHEAST CORNER OF SECTION 3, BEARING S89°59'23"E AS REFERENCED TO COLORADO STATE PLANE CENTRAL ZONE.
- ALL REFERENCES TO BOOKS, PAGES, MAPS, AND RECEPTION NUMBERS ARE PUBLIC DOCUMENTS ON FILE WITH THE CLERK AND RECORDER OF EL PASO COUNTY, STATE OF COLORADO.
- THIS SITE IS WITHIN A SPECIAL FLOOD HAZARD AREA "ZONE A" (SPECIAL FLOOD HAZARD AREAS SUBJECT TO INUNDATION BY THE 1% ANNUAL CHANCE FLOOD), AS DETERMINED BY GRAPHIC INTERPRETATION. FLOODPLAIN INFORMATION WAS OBTAINED FROM F.E.M.A. FLOODPLAIN, AS SHOWN ON THE FLOOD INSURANCE RATE MAPS FOR EL PASO COUNTY, COLORADO, MAP NUMBERS 08041C05586 AND 08041C05660 BOTH WITH REVISED DATES OF DECEMBER 7, 2018.
- THIS LAND SURVEY DOES NOT CONSTITUTE A TITLE SEARCH BY JR ENGINEERING, LLC. FOR ALL INFORMATION REGARDING EASEMENTS, RIGHT-OF-WAY OR TITLE OF RECORD, JR ENGINEERING, LLC RELIED UPON TITLE COMMITMENT NO. 83142ECS, AMENDMENT NO. 2, PREPARED BY STEWART TITLE GUARANTY COMPANY COMPANY, DATED JULY 10, 2021, 7:30 A.M.

The following note shall be placed on the plat: "Any person who knowingly removes, alters or defaces any public land survey monument or land boundary monument or accessory commits a Class Two (2) misdemeanor pursuant to C.R.S. § 18-4-508"

## SURVEYORS CERTIFICATE

I, DEREK LEE VAGIAS, A DULY REGISTERED PROFESSIONAL LAND SURVEYOR IN THE STATE OF COLORADO, DO HEREBY CERTIFY THAT THIS PLAT TRULY AND CORRECTLY REPRESENTS THE RESULTS OF A SURVEY MADE ON DATE OF SURVEY, BY ME OR UNDER MY DIRECT SUPERVISION AND THAT ALL MONUMENTS EXIST AS SHOWN HEREON; THAT MATHEMATICAL CLOSURE ERRORS ARE LESS THAN 1:10,000; AND THAT SAID PLAT HAS BEEN PREPARED IN FULL COMPLIANCE WITH ALL APPLICABLE LAWS OF THE STATE OF COLORADO DEALING WITH MONUMENTS, SUBDIVISION, OR SURVEYING OF LAND AND ALL APPLICABLE PROVISIONS OF THE EL PASO COUNTY LAND DEVELOPMENT CODE.


I ATTEST THE ABOVE ON THIS \_\_\_\_ DAY OF \_\_\_\_\_, 20\_\_\_\_.

DEREK LEE VAGIAS, DATE \_\_\_\_\_  
COLORADO REGISTERED PLS #38578  
FOR AND ON BEHALF OF JR ENGINEERING, LLC

## PLANNING AND COMMUNITY DEVELOPMENT DIRECTOR CERTIFICATE

THIS PLAT FOR SADDLEHORN RANCH FILING NO. 4 WAS APPROVED FOR FILING BY THE EL PASO COUNTY, COLORADO PLANNING AND COMMUNITY DEVELOPMENT DEPARTMENT DIRECTOR ON THE \_\_\_\_ DAY OF \_\_\_\_\_, 20\_\_\_\_, SUBJECT TO ANY NOTES OR CONDITIONS SPECIFIED HEREON.

PLANNING AND COMMUNITY DEVELOPMENT DIRECTOR \_\_\_\_\_

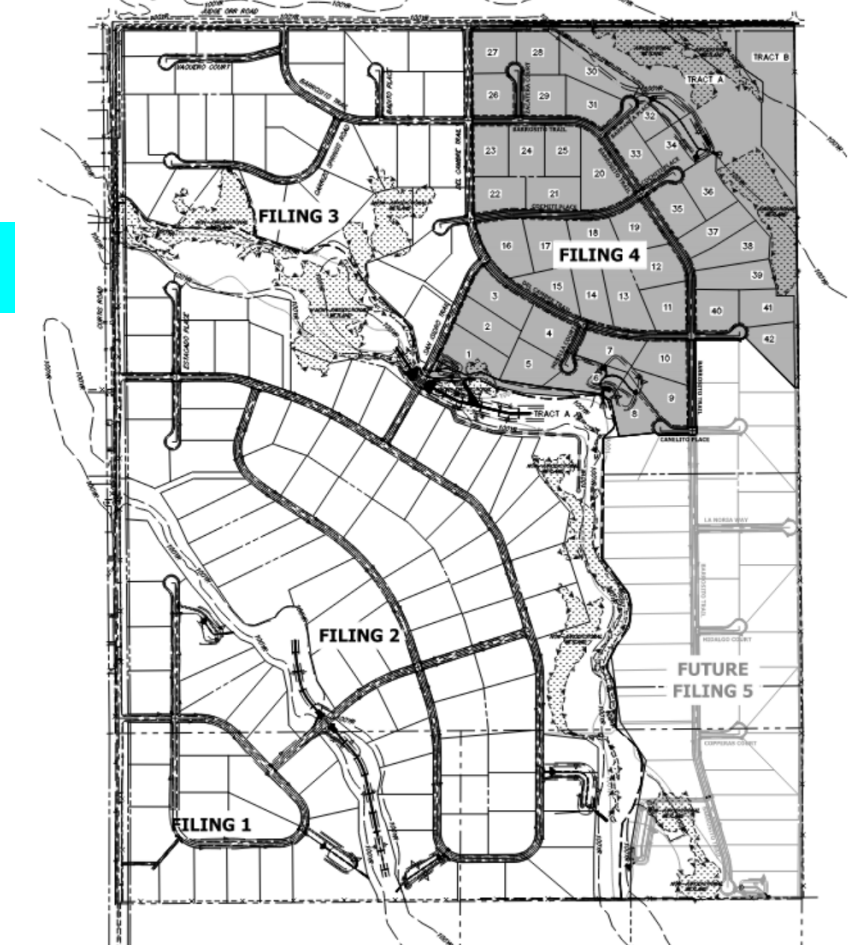

Include a filing map for clarity

## OWNERS CERTIFICATE

THE UNDERSIGNED, BEING ALL THE OWNERS, MORTGAGEES, BENEFICIARIES OF DEEDS OF TRUST AND HOLDERS OF OTHER INTERESTS IN THE LAND DESCRIBED HEREIN, HAVE LAID OUT, SUBDIVIDED, AND PLATTED SAID LANDS INTO LOTS, TRACTS, STREETS, AND EASEMENTS AS SHOWN HEREON UNDER THE NAME AND SUBDIVISION OF SADDLEHORN RANCH FILING NO. 4. ALL PUBLIC IMPROVEMENTS SO PLATTED ARE HEREBY DEDICATED TO PUBLIC USE AND SAID OWNER DOES HEREBY COVENANT AND AGREE THAT THE PUBLIC IMPROVEMENTS WILL BE CONSTRUCTED TO EL PASO COUNTY STANDARDS AND THAT PROPER DRAINAGE AND EROSION CONTROL FOR SAME WILL BE PROVIDED AT SAID OWNER'S EXPENSE. ALL TO THE SATISFACTION OF THE BOARD OF COUNTY COMMISSIONERS OF EL PASO COUNTY, COLORADO. UPON ACCEPTANCE BY RESOLUTION, ALL PUBLIC IMPROVEMENTS SO DEDICATED WILL BECOME MATTERS OF MAINTENANCE BY EL PASO COUNTY, COLORADO. THE UTILITY EASEMENTS SHOWN HEREON ARE HEREBY DEDICATED FOR PUBLIC UTILITIES AND COMMUNICATION SYSTEMS AND OTHER PURPOSES AS SHOWN HEREON. THE ENTITIES RESPONSIBLE FOR PROVIDING THE SERVICES FOR WHICH THE EASEMENTS ARE ESTABLISHED ARE HEREBY GRANTED THE PERPETUAL RIGHT OF INGRESS AND EGRESS FROM AND TO ADJACENT PROPERTIES FOR INSTALLATION, MAINTENANCE, AND REPLACEMENT OF UTILITY LINES AND RELATED FACILITIES.

GORILLA CAPITAL CO SADDLEHORN RANCH, LLC

BY: \_\_\_\_\_

STATE OF COLORADO }  
COUNTY OF \_\_\_\_\_ } SS.

ACKNOWLEDGED BEFORE ME THIS \_\_\_\_ DAY OF \_\_\_\_\_, 20\_\_\_\_ BY \_\_\_\_\_

MY COMMISSION EXPIRES \_\_\_\_\_

WITNESS MY HAND AND OFFICIAL SEAL \_\_\_\_\_  
NOTARY PUBLIC

## ACCEPTANCE CERTIFICATE FOR TRACTS

THE DEDICATION OF TRACTS A & B ARE HEREBY ACCEPTED FOR OWNERSHIP AND MAINTENANCE BY THE SADDLEHORN RANCH METROPOLITAN DISTRICT.

SADDLEHORN RANCH METROPOLITAN DISTRICT

BY: \_\_\_\_\_

STATE OF COLORADO }  
COUNTY OF \_\_\_\_\_ } SS.

ACKNOWLEDGED BEFORE ME THIS \_\_\_\_ DAY OF \_\_\_\_\_, 20\_\_\_\_ BY \_\_\_\_\_ AS \_\_\_\_\_

MY COMMISSION EXPIRES: \_\_\_\_\_

WITNESS MY HAND AND OFFICIAL SEAL \_\_\_\_\_  
NOTARY PUBLIC

## CLERK AND RECORDER

STATE OF COLORADO )  
COUNTY OF EL PASO )

I HEREBY CERTIFY THAT THIS INSTRUMENT WAS FILED FOR RECORD IN MY OFFICE

AT \_\_\_\_ O'CLOCK \_\_\_\_ M., THIS \_\_\_\_ DAY OF \_\_\_\_\_, 20\_\_\_\_, A.D.

AND IS DULY RECORDED AT RECEPTION NO. \_\_\_\_\_ OF THE RECORDS OF EL PASO COUNTY, COLORADO.

CHUCK BROERMAN, RECORDER

BY: \_\_\_\_\_  
DEPUTY

Fill this in with the appropriate fee amount. D23 school fees for 42 lots total \$7,770.00.

## FEES:

RECORDING: \_\_\_\_\_  
PARK: \_\_\_\_\_  
SCHOOL: \_\_\_\_\_  
DRAINAGE: \_\_\_\_\_  
BRIDGE: \_\_\_\_\_

23-006

PCD FILE: SF-21-033

JOB NO. 25142.06  
FEBRUARY 8, 2022  
SHEET 1 OF 4

Please update the date and include provisions for dating revisions

**J-R ENGINEERING**  
A Westrian Company

Centennial 303-740-9393 • Colorado Springs 719-593-2593  
Fort Collins 970-491-9888 • www.jrengineering.com

# SADDLEHORN RANCH FILING NO.4

## A PARCEL OF LAND LOCATED IN SECTION 3

### TOWNSHIP 13 SOUTH, RANGE 64 WEST OF THE 6TH PRINCIPAL MERIDIAN


### COUNTY OF EL PASO, STATE OF COLORADO

**GENERAL NOTES CONTINUED:**

7. TRACTS A & B ARE FOR OPEN SPACE AND DRAINAGE PURPOSES. TRACTS A & B SHALL BE OWNED AND MAINTAINED BY THE SADDLEHORN RANCH METROPOLITAN DISTRICT.
8. THE ADDRESSES EXHIBITED ON THIS PLAT ARE FOR INFORMATIONAL PURPOSES ONLY. THEY ARE NOT THE LEGAL DESCRIPTION AND ARE SUBJECT TO CHANGE.
9. ALL PROPERTY OWNERS ARE RESPONSIBLE FOR MAINTAINING PROPER STORM WATER DRAINAGE IN AND THROUGH THEIR PROPERTY. PUBLIC DRAINAGE EASEMENTS SHALL BE MAINTAINED BY THE INDIVIDUAL LOT OWNERS UNLESS OTHERWISE INDICATED. STRUCTURES, FENCES, MATERIALS OR LANDSCAPING THAT COULD IMPEDE THE FLOW OR RUNOFF SHALL NOT BE PLACED IN THE DRAINAGE EASEMENTS.
10. WATER SERVICE SHALL BE SUPPLIED BY SADDLEHORN RANCH METROPOLITAN DISTRICT.
11. SEWAGE TREATMENT IS THE RESPONSIBILITY OF EACH INDIVIDUAL PROPERTY OWNER. THE EL PASO COUNTY HEALTH DEPARTMENT MUST APPROVE EACH SYSTEM AND IN SOME CASES THE DEPARTMENT MAY REQUIRE AN ENGINEER DESIGNED SYSTEM PRIOR TO PERMIT APPROVAL.
12. IMPERVIOUS LOT COVERAGE IS RESTRICTED TO NO MORE THAN 10,900 SQUARE FEET PER LOT TO CONFORM WITH THE EL PASO COUNTY'S MS4 STORM WATER DISCHARGE PERMIT.
13. UNLESS SHOWN OTHERWISE, ALL SIDE, FRONT AND REAR LOT LINES ARE HEREBY PLATTED WITH A 10 FOOT WIDE PUBLIC UTILITY AND DRAINAGE EASEMENT. ALL EXTERIOR SUBDIVISION BOUNDARIES ARE HEREBY PLATTED WITH A 20 FOOT WIDE PUBLIC UTILITY AND DRAINAGE EASEMENT. THE SOLE RESPONSIBILITY FOR MAINTENANCE OF THESE EASEMENTS IS HEREBY VESTED WITH THE INDIVIDUAL PROPERTY OWNERS.
14. THE FOLLOWING REPORTS HAVE BEEN SUBMITTED IN ASSOCIATION WITH THE PRELIMINARY PLAN OR FINAL PLAT FOR THIS SUBDIVISION AND ARE ON FILE AT THE COUNTY PLANNING AND COMMUNITY DEVELOPMENT DEPARTMENT: TRANSPORTATION IMPACT STUDY; DRAINAGE REPORT; WATER RESOURCES REPORT; WASTEWATER DISPOSAL REPORT; GEOLOGY AND SOILS REPORT; FIRE PROTECTION REPORT; WILDFIRE HAZARDS REPORT; NATURAL FEATURES REPORT.
15. DEVELOPER SHALL COMPLY WITH FEDERAL AND STATE LAWS, REGULATION, ORDINANCES, REVIEW AND PERMIT REQUIREMENTS, AND OTHER AGENCY REQUIREMENT, IF ANY, OF APPLICABLE AGENCIES INCLUDING, BUT NOT LIMITED TO, THE COLORADO DEPARTMENT OF PARKS AND WILDLIFE, COLORADO DEPARTMENT OF TRANSPORTATION, U.S. ARMY CORPS OF ENGINEERS, AND THE U.S. FISH & WILDLIFE SERVICE REGARDING THE ENDANGERED SPECIES ACT, PARTICULARLY AS IT RELATES TO THE LISTED SPECIES (E.G., PREBLES MEADOW JUMPING MOUSE).
16. NO LOT OR INTEREST THEREIN SHALL BE SOLD, CONVEYED, OR TRANSFERRED WHETHER BY DEED OR BY CONTRACT, NOR SHALL BUILDING PERMITS BE ISSUED, UNTIL AND UNLESS EITHER THE REQUIRED PUBLIC AND COMMON DEVELOPMENT IMPROVEMENTS HAVE BEEN CONSTRUCTED AND PRELIMINARILY ACCEPTED IN ACCORDANCE WITH THE SUBDIVISION IMPROVEMENTS AGREEMENT BETWEEN THE APPLICANT/OWNER AND EL PASO COUNTY AS RECORDED UNDER RECEPTION NO. \_\_\_\_\_ IN THE OFFICE OF THE CLERK AND RECORDER OF EL PASO COUNTY, COLORADO OR, IN THE ALTERNATIVE, OTHER COLLATERAL IS PROVIDED TO MAKE PROVISION FOR THE COMPLETION OF SAID IMPROVEMENTS IN ACCORDANCE WITH THE EL PASO LAND DEVELOPMENT CODE AND ENGINEERING CRITERIA MANUAL. ANY SUCH ALTERNATIVE COLLATERAL MUST BE APPROVED BY THE BOARD OF COUNTY COMMISSIONERS OR, IF PERMITTED BY THE SUBDIVISION IMPROVEMENTS AGREEMENT, BY THE DEVELOPMENT SERVICES DEPARTMENT DIRECTOR AND MEET THE POLICY AND PROCEDURE REQUIREMENTS OF EL PASO COUNTY PRIOR TO THE RELEASE BY THE COUNTY OF ANY LOTS FOR SALE, CONVEYANCE OR TRANSFER. THIS PLAT RESTRICTION MAY BE REMOVED OR RESCINDED BY THE BOARD OF COUNTY COMMISSIONERS OR, IF PERMITTED BY THE SUBDIVISION IMPROVEMENTS AGREEMENT, BY THE PLANNING AND COMMUNITY DEVELOPMENT DEPARTMENT DIRECTOR UPON EITHER APPROVAL OF AN ALTERNATIVE FORM OF COLLATERAL OR COMPLETION AND PRELIMINARY ACCEPTANCE BY THE EL PASO BOARD OF COUNTY COMMISSIONERS OF ALL IMPROVEMENT REQUIRED TO BE CONSTRUCTED AND COMPLETED IN ACCORDANCE WITH SAID SUBDIVISION IMPROVEMENTS AGREEMENT. THE PARTIAL RELEASE OF LOTS FOR SALE, CONVEYANCE OR TRANSFER MAY ONLY BE GRANTED IN ACCORDANCE WITH ANY PLANNED PARTIAL RELEASE OF LOTS AUTHORIZED BY THE SUBDIVISION IMPROVEMENTS AGREEMENT.
17. A DRIVEWAY PERMIT IS REQUIRED TO BE APPLIED FOR AND APPROVED BY EL PASO COUNTY PLANNING AND COMMUNITY DEVELOPMENT DEPARTMENT PRIOR TO THE ESTABLISHMENT OF ANY DRIVEWAY. INDIVIDUAL LOT PURCHASERS ARE RESPONSIBLE FOR CONSTRUCTING DRIVEWAYS, INCLUDING DRAINAGE CULVERTS FROM ZACATERA COURT, BARRANCA PLACE, BARROSITO TRAIL, COCHITI PLACE, DEL CAMBRE TRAIL, AND SAND ISIDRO TRAIL PER LAND DEVELOPMENT CODE SECTION 6.3.3.C.2 AND 6.3.3.C.3. DUE TO THEIR LENGTH, SOME OF THE DRIVEWAYS WILL NEED TO BE SPECIFICALLY APPROVED BY THE FALCON FIRE PROTECTION DISTRICT.
18. THERE SHALL BE NO DIRECT LOT ACCESS TO JUDGE ORR ROAD.
19. THIS SUBDIVISION IS SURROUNDED BY AGRICULTURAL LAND. PROPERTY OWNERS MAY BE IMPACTED BY SOUNDS, SMELLS AND/OR ACTIVITIES ASSOCIATED WITH ACTIVE AGRICULTURAL PRACTICES. PURSUANT TO ARTICLE 3.5, TITLE 35, C.R.S., IT IS THE DECLARED POLICY OF THE STATE OF COLORADO TO CONSERVE, PROTECT, AND ENCOURAGE THE DEVELOPMENT AND IMPROVEMENT OF ITS AGRICULTURAL LAND FOR THE PRODUCTION OF FOOD AND OTHER AGRICULTURAL PRODUCTS. COLORADO IS A "RIGHT-TO-FARM" STATE PURSUANT TO C.R.S. 35-3.5-101, ET SEQ. LANDOWNERS, RESIDENTS AND VISITORS MUST BE PREPARED TO ACCEPT THE ACTIVITIES, SIGHTS, SOUNDS, AND SMELLS OF AGRICULTURAL OPERATIONS AS A NORMAL AND NECESSARY IMPACT OF LIVING IN A COUNTY WITH A STRONG RURAL CHARACTER AND A HEALTHY AGRICULTURAL SECTOR. STATE LAW PROVIDES THAT RANCHING, FARMING, OR OTHER AGRICULTURAL ACTIVITIES AND OPERATIONS SHALL NOT BE CONSIDERED TO BE NUISANCES SO LONG AS OPERATED IN CONFORMANCE WITH THE LAW AND IN A NON-NEGLIGENT MANNER. THEREFORE, ALL MUST BE PREPARED TO ENCOUNTER NOISES, ODORS, LIGHTS, MUD, DUST, SMOKE, CHEMICALS, MACHINERY ON PUBLIC ROADS, LIVESTOCK ON PUBLIC ROADS, STORAGE AND DISPOSAL OF MANURE, AND THE APPLICATION BY SPRAYING OR OTHERWISE OF CHEMICAL FERTILIZERS, SOIL AMENDMENTS, HERBICIDES, AND PESTICIDES, AND ONE OR MORE OF WHICH MAY NATURALLY OCCUR AS A PART OF LEGAL AND NON-NEGLIGENT AGRICULTURAL OPERATIONS.
20. MAILBOXES SHALL BE INSTALLED IN ACCORDANCE WITH ALL EL PASO COUNTY DEPARTMENT OF PUBLIC WORKS AND UNITED STATES POSTAL SERVICE REGULATIONS.
21. THE SUBDIVIDER AGREES ON BEHALF OF HIM/HERSELF AND ANY DEVELOPER OR BUILDER SUCCESSORS AND ASSIGNEES THAT SUBDIVIDER AND/OR SAID SUCCESSORS AND ASSIGNEES SHALL BE REQUIRED TO PAY TRAFFIC IMPACT FEES IN ACCORDANCE WITH THE EL PASO COUNTY ROAD IMPACT FEE PROGRAM RESOLUTION (RESOLUTION NO. 19-471), OR ANY AMENDMENTS THERETO, AT OR PRIOR TO THE TIME OF BUILDING PERMIT SUBMITTALS.
22. THIS PROPERTY IS INCLUDED WITHIN A SPECIAL TAXING DISTRICT, SADDLEHORN RANCH METROPOLITAN DISTRICT, CREATED OF THE PURPOSE OF CONSTRUCTING AND MAINTAINING CERTAIN PUBLIC IMPROVEMENTS, DRAINAGE AND RECREATION IMPROVEMENTS. SPECIAL TAXING DISTRICTS ARE SUBJECT TO GENERAL OBLIGATION INDEBTEDNESS THAT IS PAID BY REVENUES PRODUCED FROM ANNUAL TAX LEVIES ON THE TAXABLE PROPERTY WITHIN SUCH DISTRICTS. THE BUYER SHOULD FAMILIARIZE HIMSELF / HERSELF WITH THE POTENTIALITY AND RAMIFICATIONS THEREOF.
23. WATER IN THE DENVER BASIN AQUIFERS IS ALLOCATED BASED ON A 100 YEAR AQUIFER LIFE; HOWEVER, FOR EL PASO COUNTY PLANNING PURPOSES, WATER IN THE DENVER BASIN AQUIFERS IS EVALUATED BASED ON A 300 YEAR AQUIFER LIFE. APPLICANT AND ALL FUTURE OWNERS IN THE SUBDIVISION SHOULD BE AWARE THAT THE ECONOMIC LIFE OF A WATER SUPPLY BASED ON WELLS IN A GIVEN DENVER BASIN AQUIFER MAY BE LESS THAN EITHER THE 100 YEARS OR 300 YEARS USED FOR ALLOCATION INDICATED DUE TO ANTICIPATED WATER LEVEL DECLINES. FURTHERMORE, THE WATER SUPPLY PLAN SHOULD NOT RELY SOLELY UPON NON-RENEWABLE AQUIFERS. ALTERNATIVE RENEWABLE WATER RESOURCES SHOULD BE ACQUIRED AND INCORPORATED IN A PERMANENT WATER SUPPLY PLAN THAT PROVIDES FUTURE GENERATIONS WITH A WATER SUPPLY.
24. THIS PROPERTY IS PRESENTLY LOCATED IN THE VICINITY OF AN AIRPORT, WITHIN WHAT IS KNOWN AS AN AIRPORT INFLUENCE AREA. FOR THIS REASON, THE PROPERTY MAY BE SUBJECT TO SOME OF THE ANNOYANCES OR INCONVENIENCES ASSOCIATED WITH PROXIMITY TO AIRPORT OPERATIONS (E.G. NOISE, VIBRATION, OR ODORS), INDIVIDUAL SENSITIVITIES TO THOSE ANNOYANCES CAN VARY FROM PERSON TO PERSON. YOU MAY WISH TO CONSIDER WHAT AIRPORT ANNOYANCES, IF ANY, ARE ASSOCIATED WITH THE PROPERTY BEFORE YOU COMPLETE YOUR PURCHASE AND DETERMINE WHETHER THEY ARE ACCEPTABLE TO YOU.

replace notes:

or storage of materials

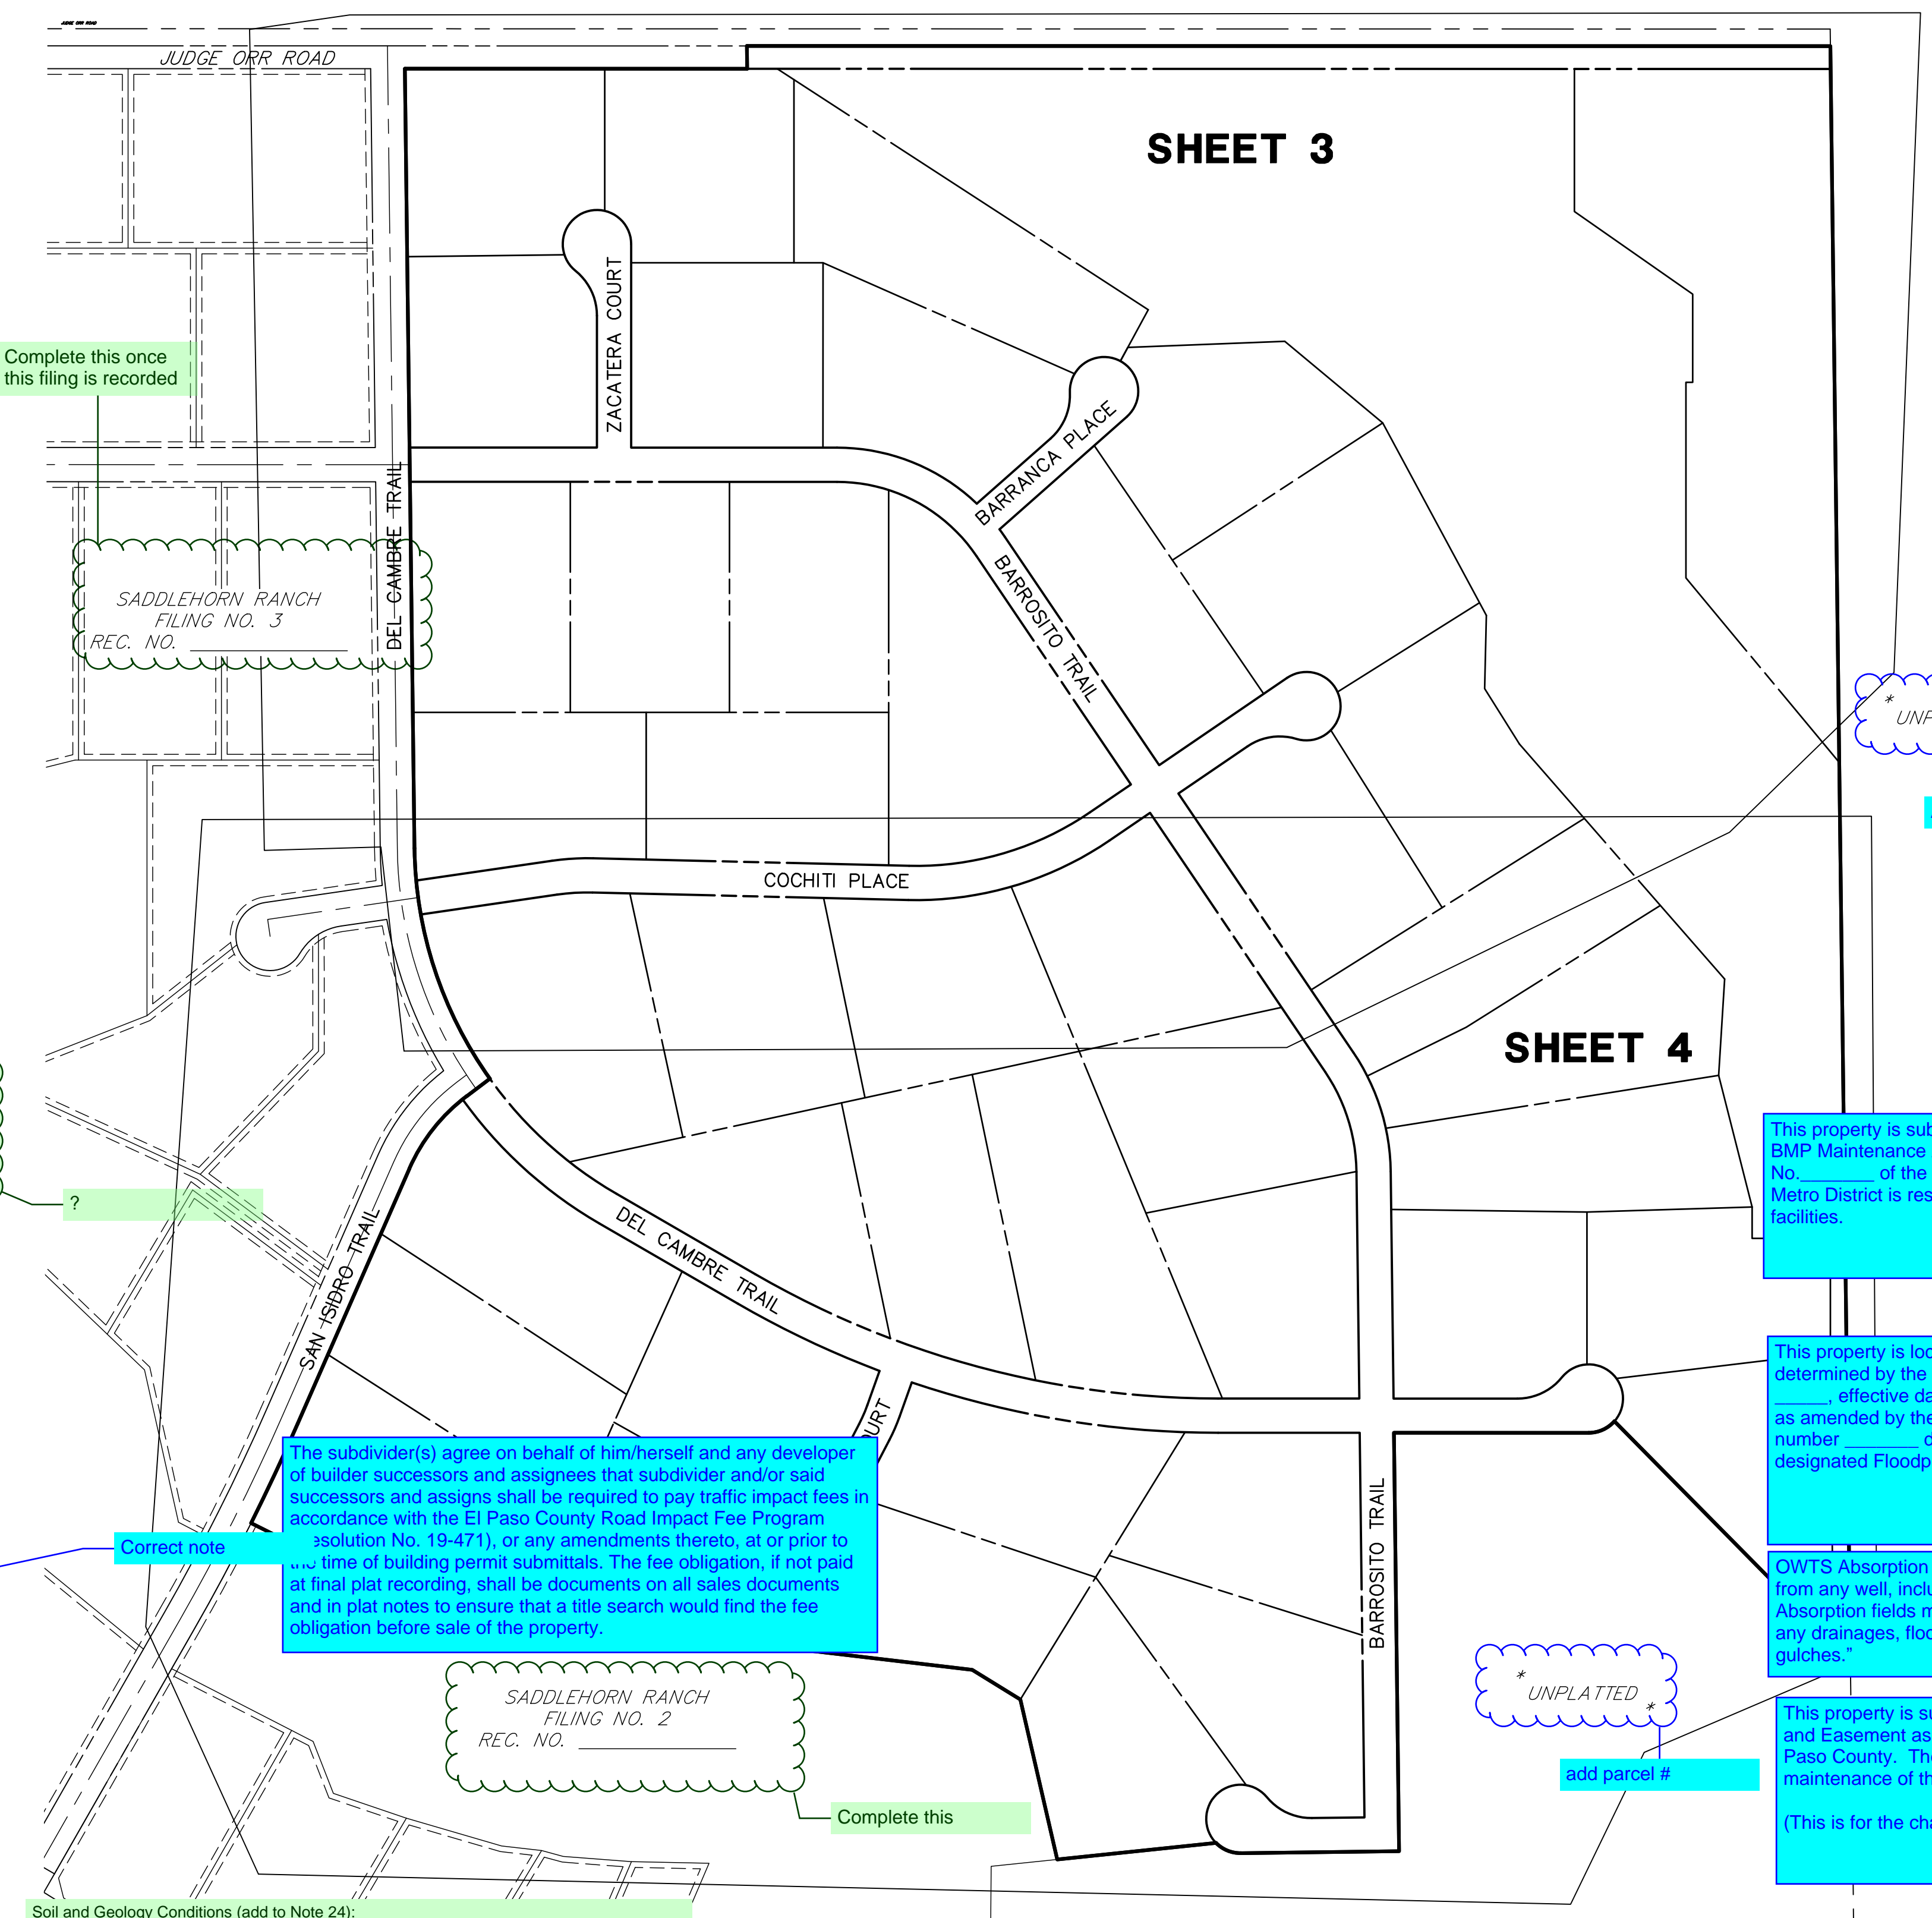

Soil and Geology Conditions (add to Note 24):  
 Geologic Hazard Note-Final Plat: (to be customized based upon the individual circumstances)  
 The following lots have been found to be impacted by geologic hazards. Mitigation measures and a map of the hazard area can be found in the report (Title of Report, generally from the Preliminary Plan file) by (author of the report) (date of report) in file (name of file and file number) available at the El Paso County Planning and Community Development Department:  
 •Dowlslope Creep: (name lots or location of area)  
 •Rockfall Source:(name lots or location of area)  
 •Rockfall Runout Zone:(name lots or location of area)  
 •Potentially Seasonally High Groundwater:(name lots or location of area)  
 •Other Hazard:  
 In Areas of High Groundwater:  
 Due to high groundwater in the area, all foundations shall incorporate an underground drainage system.  
 Please modify this note as necessary to address CGS comments as well as incorporate the recommendations of the soils & geology report.

**OWNERSHIP & MAINTENANCE TABLE**

TRACT	AREA (SF)	AREA (AC)	USE	OWNER	MAINTENANCE
A	1,144,018	26.2630	OPEN SPACE, DRAINAGE	SADDLEHORN RANCH METROPOLITAN DISTRICT	SADDLEHORN RANCH METROPOLITAN DISTRICT
B	334,461	7.6782	OPEN SPACE, DRAINAGE	SADDLEHORN RANCH METROPOLITAN DISTRICT	SADDLEHORN RANCH METROPOLITAN DISTRICT
TOTAL TRACT AREA	1,478,479	33.9412			
TOTAL ROW AREA	632,274	14.5150			
TOTAL LOT AREA(42 LOTS)	4,959,816	113.8617	(NET AREA)		
TOTAL SITE AREA	7,070,569	162.3179	(GROSS AREA)		
GROSS DENSITY	0.259 DU/AC		DU=DWELLING UNIT		
NET DENSITY	0.369 DU/AC				

Per soils & geology report, depict the geologic hazards and constraints on the subsequent pages. Some of these areas encroach into the lots. These should be located in designated no-build areas.

UNPLATTED

Add parcel #

Add missing notes

This property is subject to a Private Detention Basin/Stormwater Quality BMP Maintenance Agreement and Easement as recorded at Reception No. \_\_\_\_\_ of the records of El Paso County. The Saddlehorn Ranch Metro District is responsible for maintenance of the subject drainage facilities.

This property is located within a designated FEMA Floodplain as determined by the Flood Insurance Rate Map, Community Map Number \_\_\_\_\_ effective date \_\_\_\_ (modification when LOMR has been approved) and as amended by the FEMA approved Letter of Map Revision (LOMR) case number \_\_\_\_\_ dated \_\_\_\_\_. No structures are permitted within the designated Floodplain areas.

OWTS Absorption field must be located a minimum of 100 feet from any well, including those on adjacent properties. Absorption fields must also be located a minimum of 50 feet from any drainages, floodplains, or ponded areas and 25 feet from dry gulches.

This property is subject to a Stormwater Facility Maintenance Agreement and Easement as recorded at Reception No. \_\_\_\_\_ of the records of El Paso County. The Saddlehorn Ranch Metro District is responsible for maintenance of the subject drainage facilities.  
 (This is for the channel)

add parcel #

UNPLATTED

Complete this

Correct note

The subdivider(s) agree on behalf of him/herself and any developer of builder successors and assignees that subdivider and/or said successors and assigns shall be required to pay traffic impact fees in accordance with the El Paso County Road Impact Fee Program (Resolution No. 19-471), or any amendments thereto, at or prior to the time of building permit submittals. The fee obligation, if not paid at final plat recording, shall be documents on all sales documents and in plat notes to ensure that a title search would find the fee obligation before sale of the property.

ORIGINAL SCALE: 1" = 200'

JOB NO. 25142.06  
 FEBRUARY 8, 2022  
 SHEET 2 OF 4



Centennial 303-740-9393 • Colorado Springs 719-593-2593  
 Fort Collins 970-491-9888 • www.jrengineering.com

# SADDLEHORN RANCH FILING NO.4

A PARCEL OF LAND LOCATED IN SECTION 3  
TOWNSHIP 13 SOUTH, RANGE 64 WEST OF THE 6TH PRINCIPAL MERIDIAN  
COUNTY OF EL PASO, STATE OF COLORADO

POINT OF COMMENCEMENT  
NW COR. SEC. 3,  
T13S, R64W, 6TH P.M.  
NO. 6 REBAR WITH A  
3-1/4" ALUMINUM CAP  
STAMPED: PLS 17496 1992  
IN RANGE BOX

NE CORNER SECTION 3  
T13S, R64W, 6TH P.M.  
3.25" ALUMINUM CAP  
STAMPED: LS 17496 1992  
IN A RANGE BOX

UNPLATTED

Add parcel #

Add note about floodplain, public  
drainage easement, no storage of  
materials, fencing, and no-build  
area

Show floodplain elevations

show drainage  
easement for  
detention pond

show all geologic  
hazards/constraints  
per previous  
version


Include the road  
classifications and  
identify whether this  
is public or private  
ROW

Fill this in when you  
are able to

SADDLEHORN RANCH  
FILING NO. 3  
REC. NO.

- LEGEND**
- SET 18" LONG #5 REBAR WITH A 1.5" ALUMINUM CAP STAMPED "JR ENG LS 38578"
  - RECOVERED 1.5" ALUMINUM CAP STAMPED "JR ENG LS 38578"
  - S.F. SQUARE FEET
  - (R) RADIAL BEARING
  - (###) ADDRESS NUMBER
  - \* NOT A PART OF THIS SUBDIVISION
  - PROPOSED SUBDIVISION BOUNDARY
  - PROPOSED LOT LINE
  - PROPOSED RIGHT-OF-WAY LINE
  - PROPOSED EASEMENT
  - PROPOSED CENTERLINE
  - EXISTING RIGHT-OF-WAY
  - EXISTING PROPERTY LINE
  - EXISTING CENTERLINE
  - 100 YEAR FLOODPLAIN
  - 66.98 FEMA FIRM BASE FLOOD ELEVATION


SHEET 4

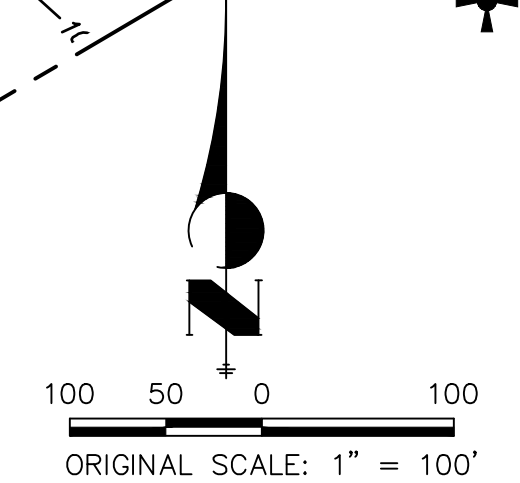

JOB NO. 25142.06  
FEBRUARY 8, 2022  
SHEET 3 OF 4



Centennial 303-740-9393 • Colorado Springs 719-593-2593  
Fort Collins 970-491-9888 • www.jrengineering.com

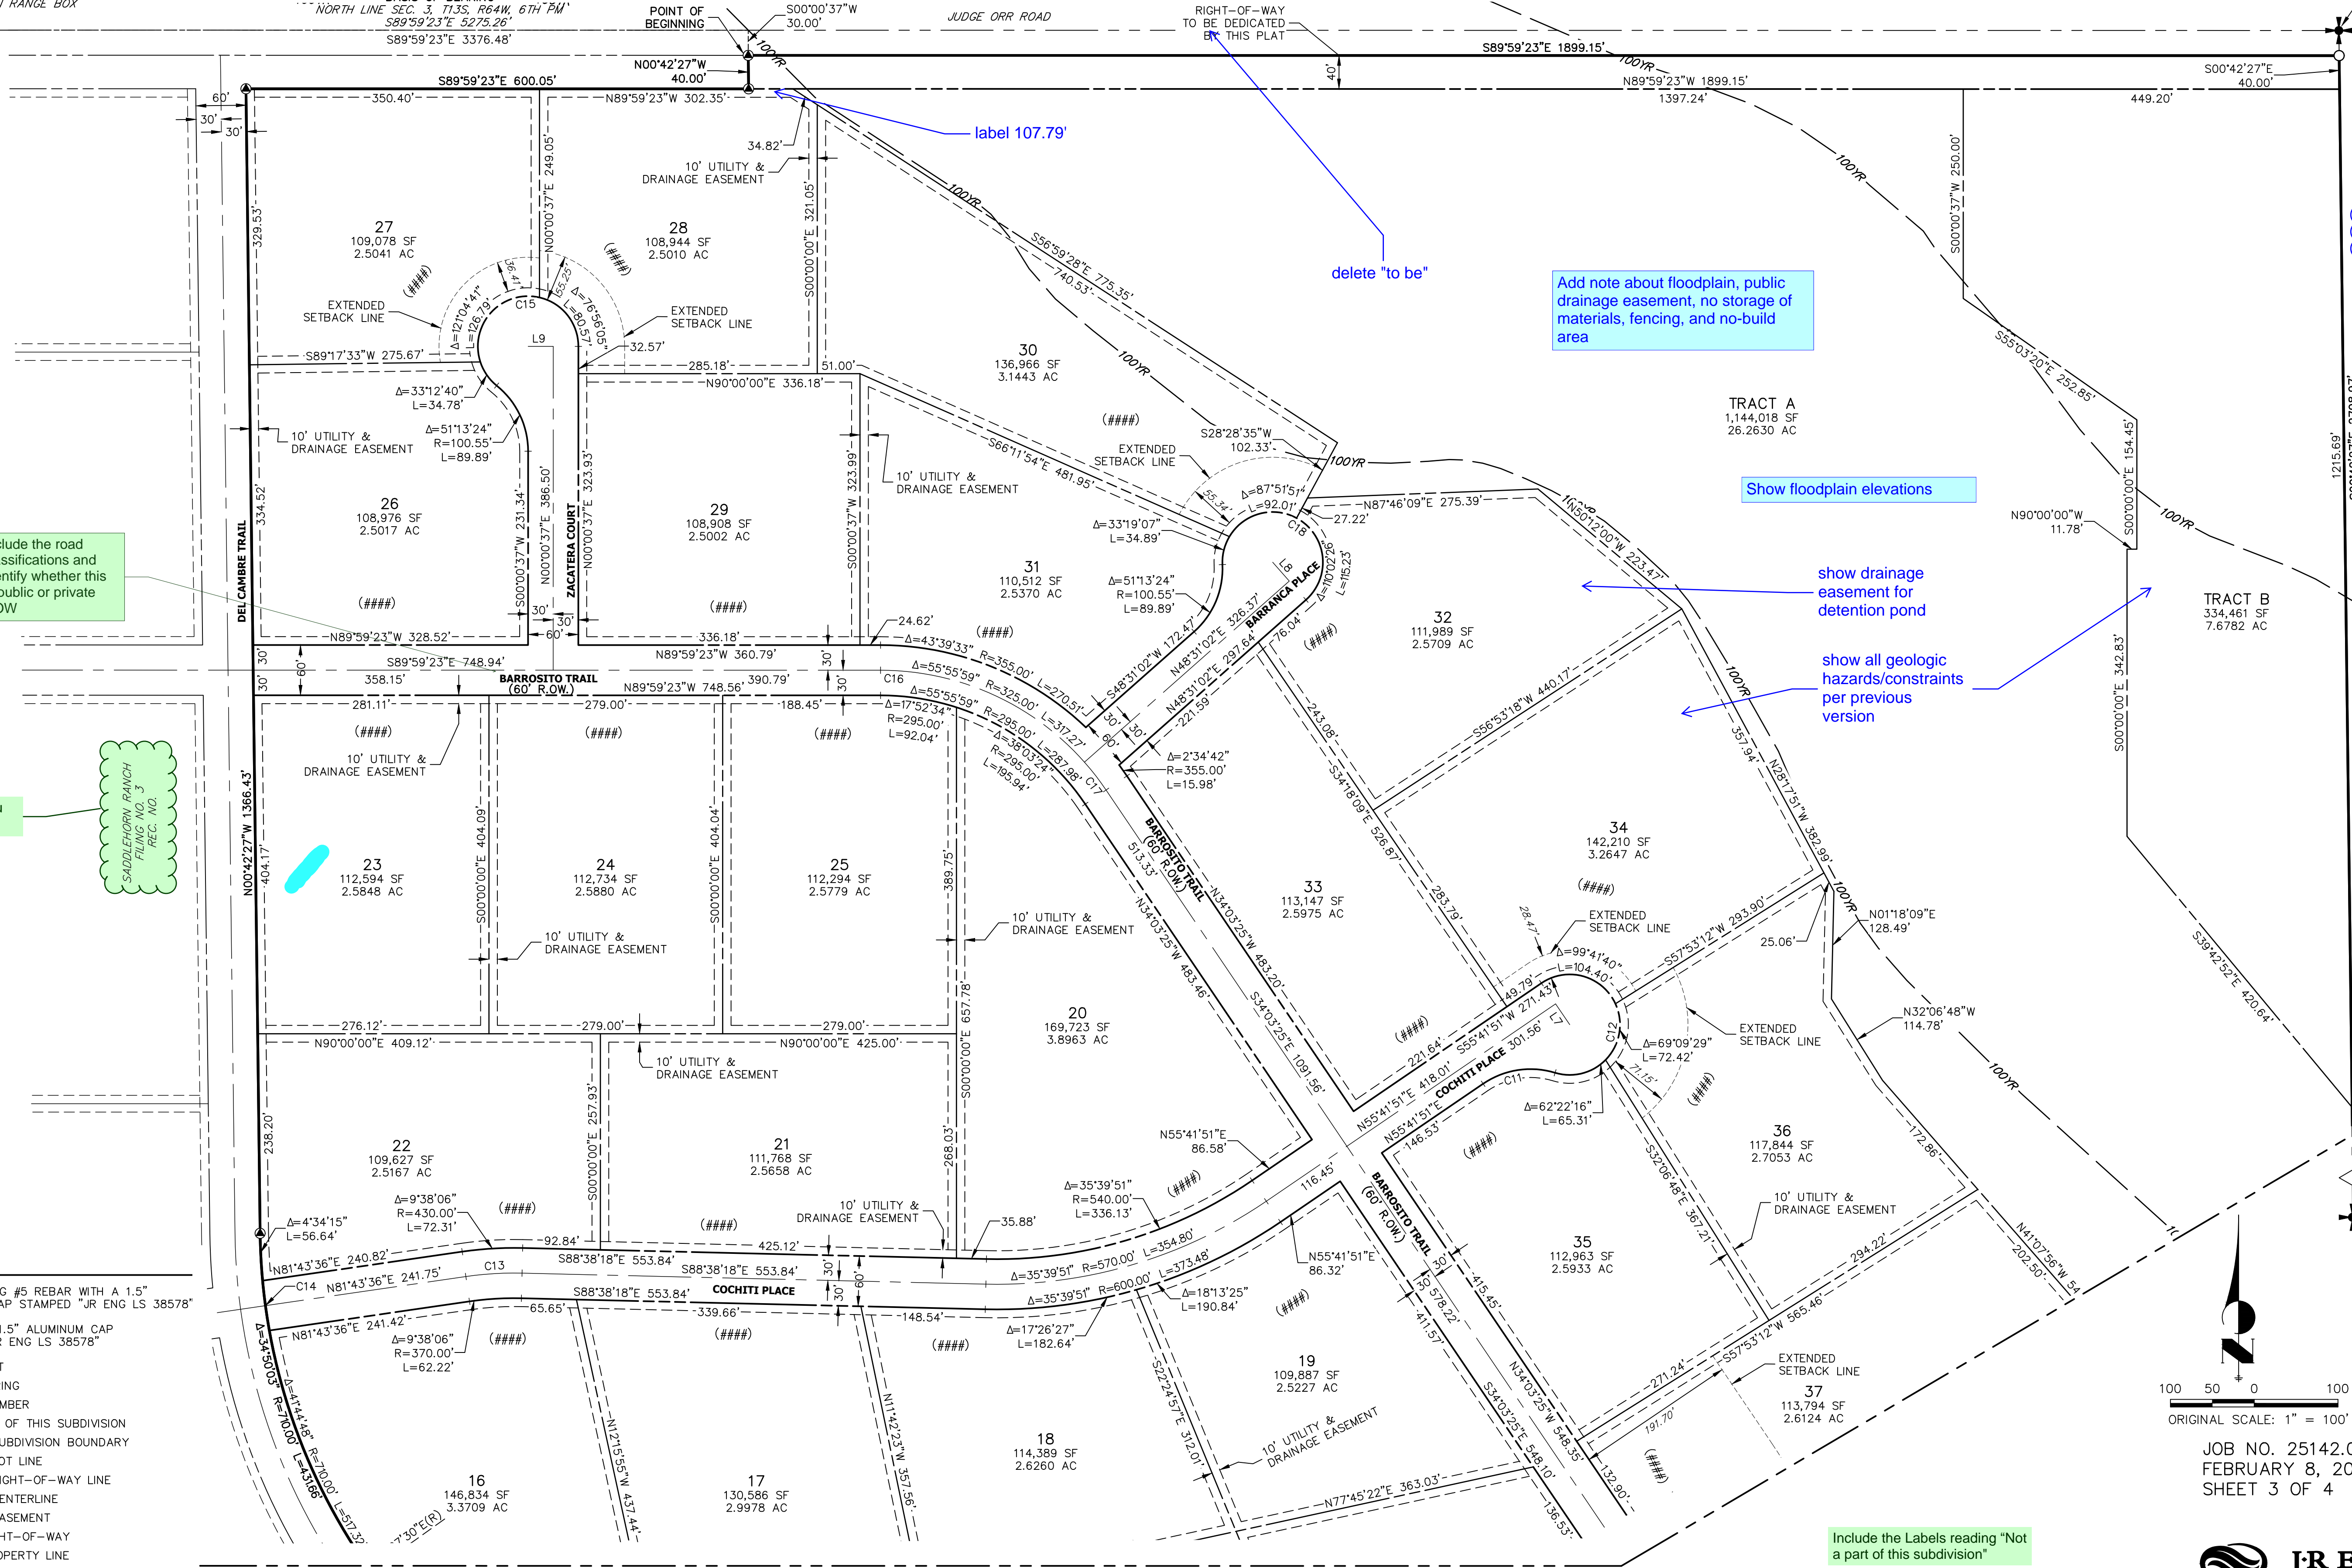

# SADDLEHORN RANCH FILING NO.4

## A PARCEL OF LAND LOCATED IN SECTION 3

### TOWNSHIP 13 SOUTH, RANGE 64 WEST OF THE 6TH PRINCIPAL MERIDIAN

### COUNTY OF EL PASO, STATE OF COLORADO



SHEET 3

CURVE TABLE			
CURVE	DELTA	RADIUS	LENGTH
C1	1°40'52"	320.00'	9.39'
C2	231°13'23"	60.00'	242.14'
C3	51°13'23"	100.55'	89.89'
C4	7°47'47"	300.00'	40.82'
C5	51°13'24"	100.55'	89.89'
C6	231°13'24"	60.00'	242.14'
C7	231°13'25"	60.00'	242.14'
C8	33°20'57"	320.00'	186.26'
C9	33°20'57"	350.00'	203.72'
C10	33°20'57"	380.00'	221.18'
C11	51°13'24"	100.55'	89.89'
C12	231°13'24"	60.00'	242.14'
C13	9°38'06"	400.00'	67.27'
C14	4°50'37"	710.00'	60.02'
C15	231°13'25"	60.00'	242.14'
C16	48°30'25"	325.00'	275.15'
C17	7°25'34"	325.00'	42.12'
C18	231°13'24"	60.00'	242.14'

LINE TABLE		
LINE	BEARING	DISTANCE
L1	S62°31'52"E	30.00'
L2	S27°28'08"W	214.36'
L3	S19°40'21"W	93.37'
L4	N00°42'27"W	30.00'
L5	S00°42'27"E	30.00'
L6	N00°00'37"E	30.00'
L7	N34°18'09"W	30.00'
L8	N41°28'58"W	30.00'
L9	N90°00'00"W	30.00'
L10	S89°17'33"W	30.00'

RADIAL BEARING TABLE	
LINE	BEARING
RB1	N48°36'47"W

Adjacent subdivisions should have dotted lines for abutting lots. As currently presented, it is difficult to tell where the subdivision boundary is.

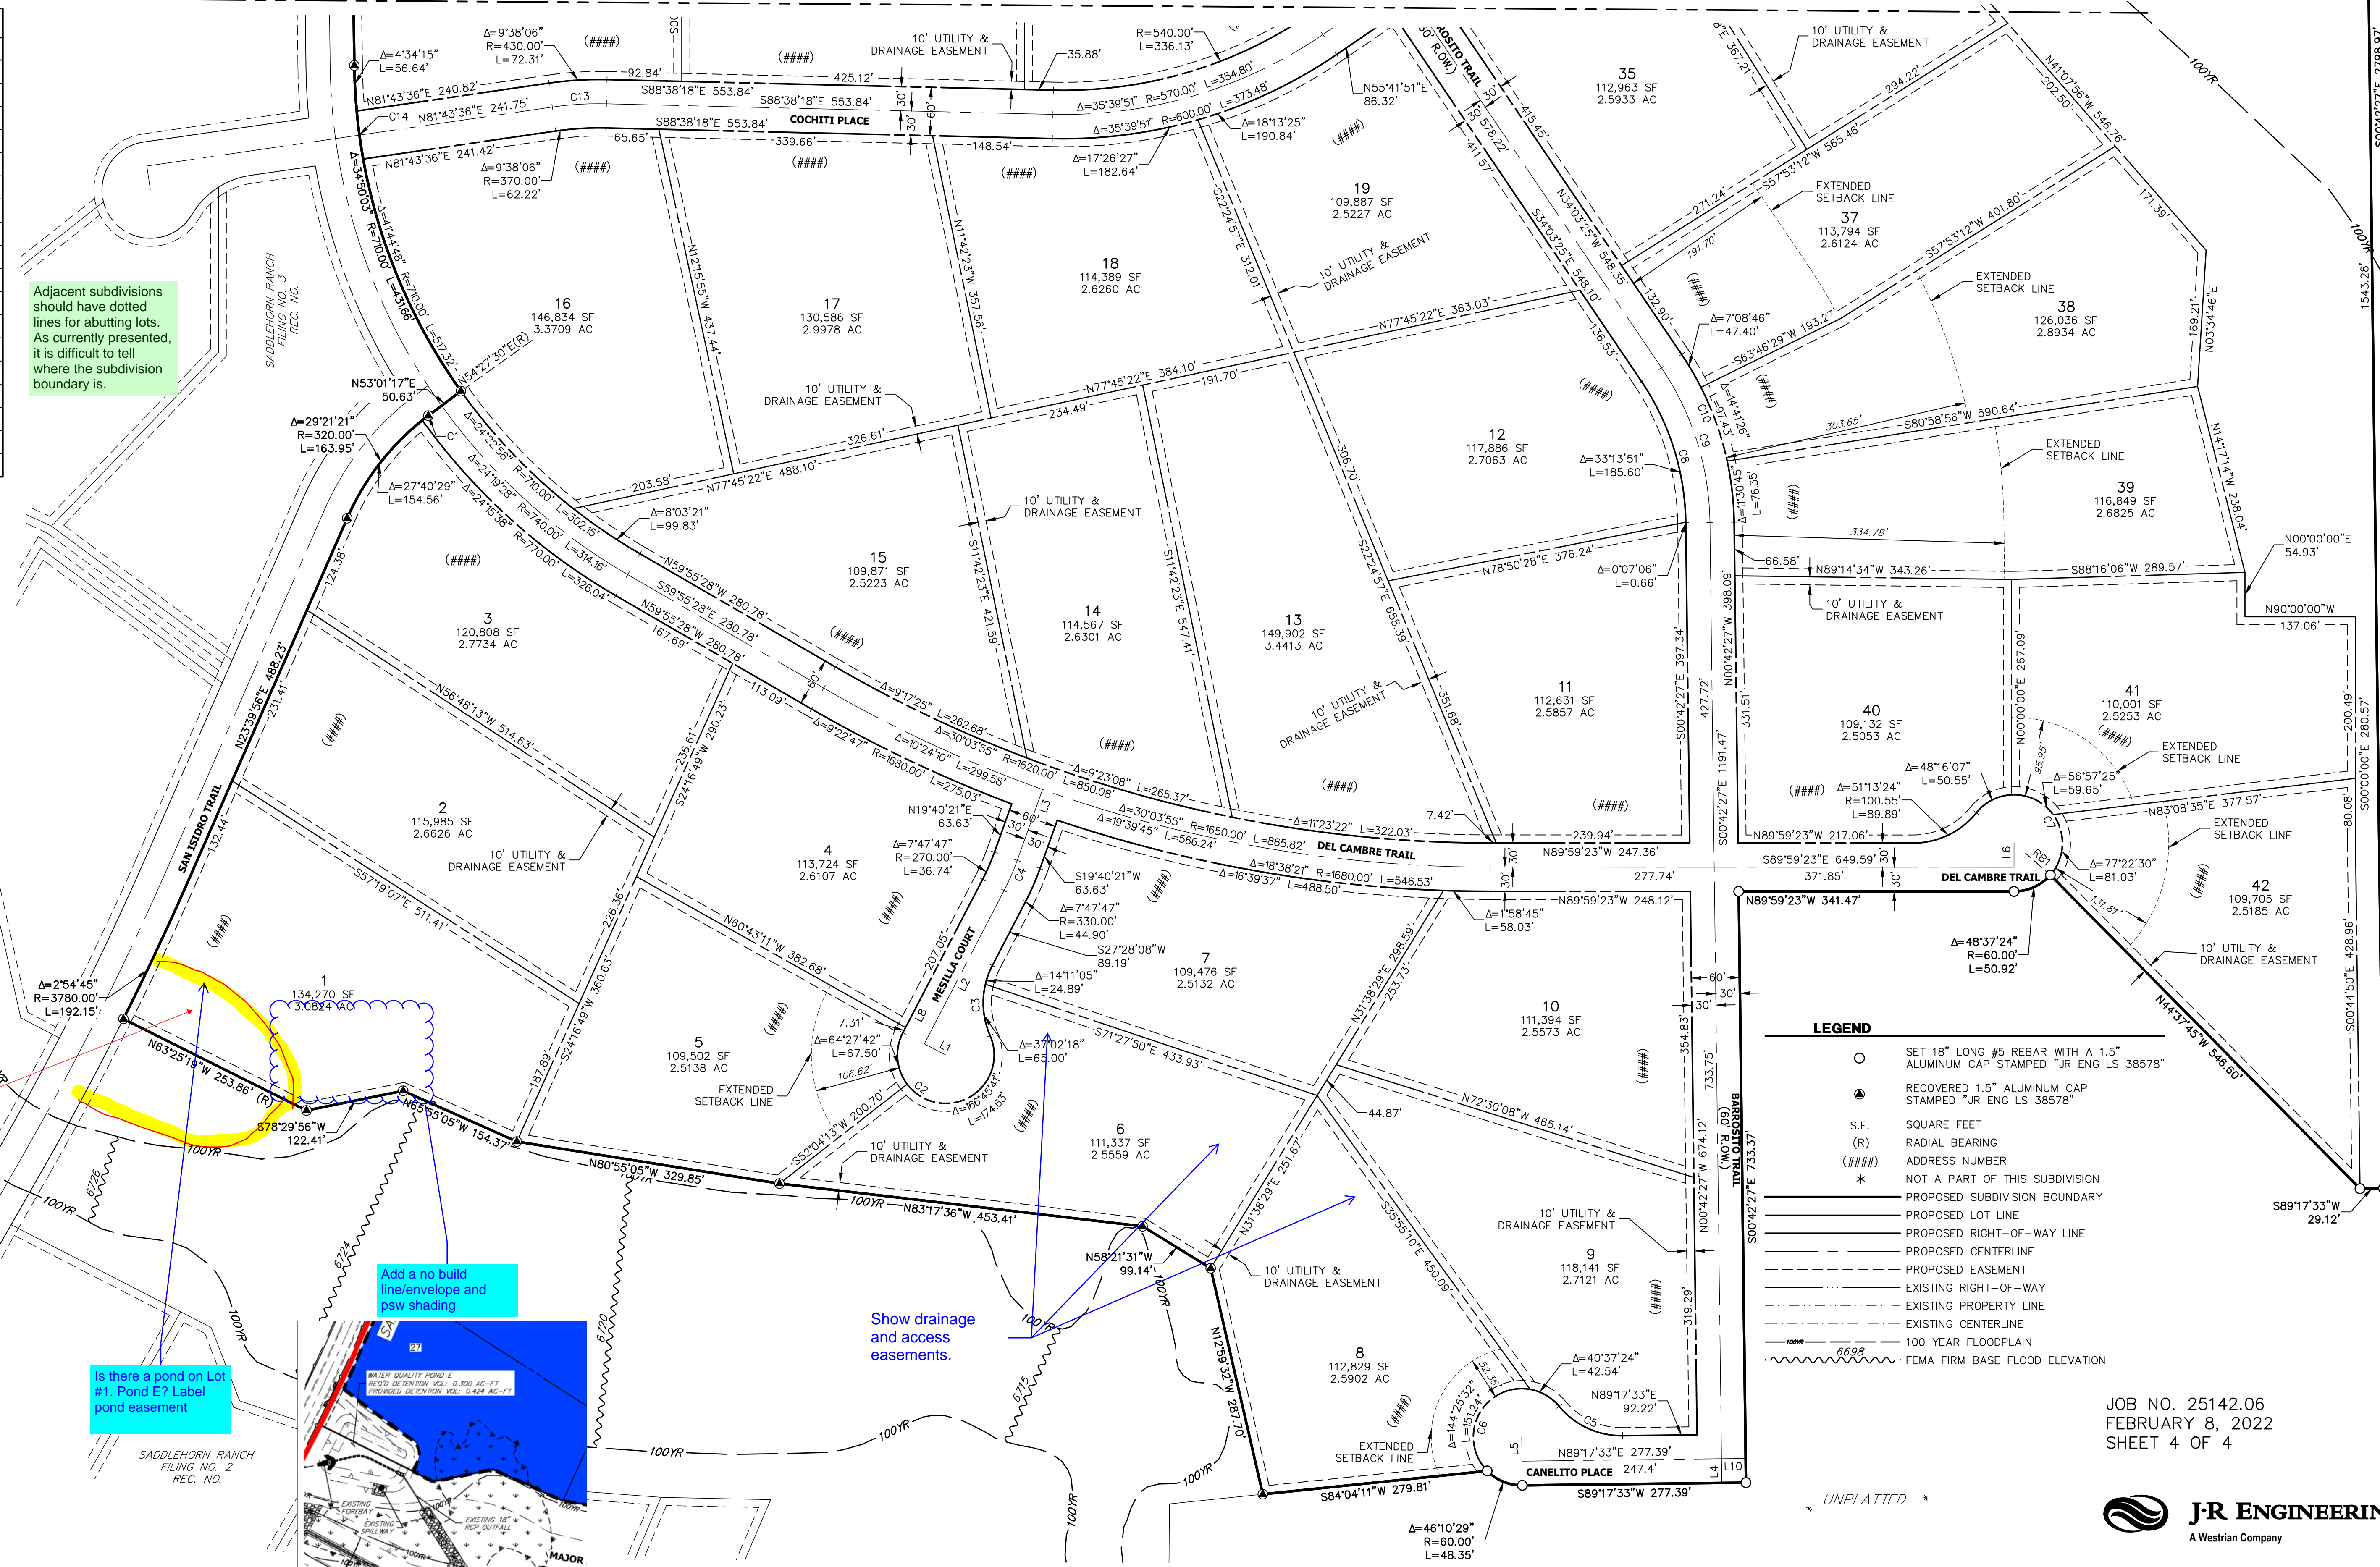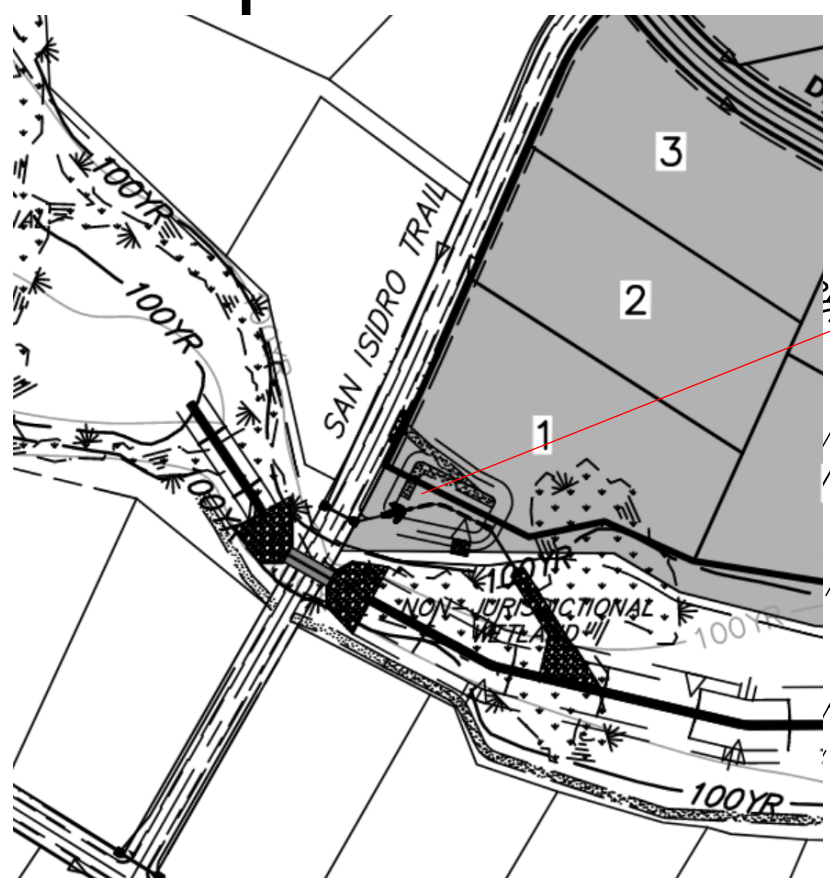


LEGEND	
	SET 18" LONG #5 REBAR WITH A 1.5" ALUMINUM CAP STAMPED "JR ENG LS 38578"
	RECOVERED 1.5" ALUMINUM CAP STAMPED "JR ENG LS 38578"
S.F.	SQUARE FEET
(R)	RADIAL BEARING
(###)	ADDRESS NUMBER
*	NOT A PART OF THIS SUBDIVISION
	PROPOSED SUBDIVISION BOUNDARY
	PROPOSED LOT LINE
	PROPOSED RIGHT-OF-WAY LINE
	PROPOSED CENTERLINE
	PROPOSED EASEMENT
	EXISTING RIGHT-OF-WAY
	EXISTING PROPERTY LINE
	EXISTING CENTERLINE
	100 YEAR FLOODPLAIN
	FEMA FIRM BASE FLOOD ELEVATION

Add a no build line/envelope and psw shading

Show drainage and access easements.

Is there a pond on Lot #1. Pond E? Label pond easement

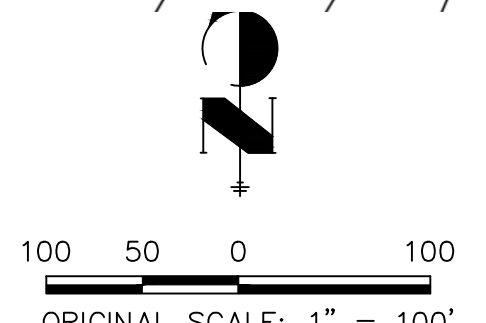

JOB NO. 25142.06  
FEBRUARY 8, 2022  
SHEET 4 OF 4



Centennial 303-740-9393 • Colorado Springs 719-593-2593  
Fort Collins 970-491-9888 • www.jrengineering.com