




3 TYPICAL WALL SECTION
1/2" = 1'-0"

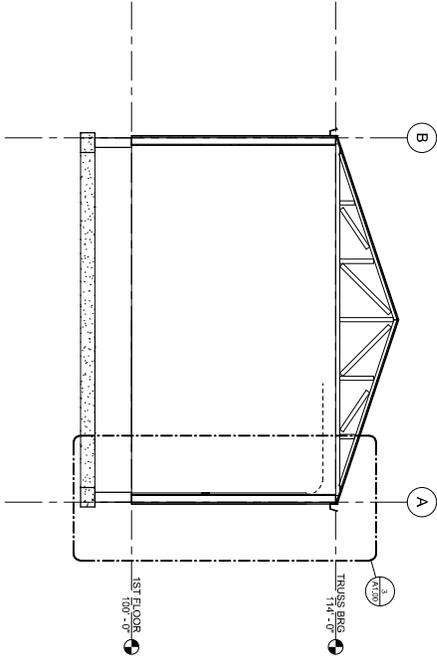

2 BUILDING SECTION
1/2" = 1'-0"

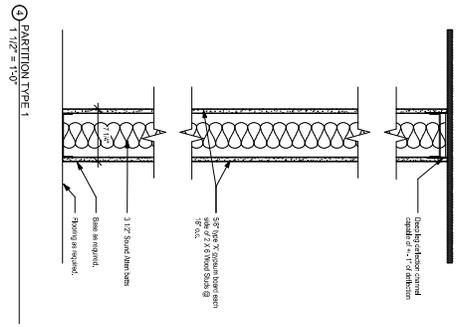

4 PARTITION TYPE 1
1/2" = 1'-0"

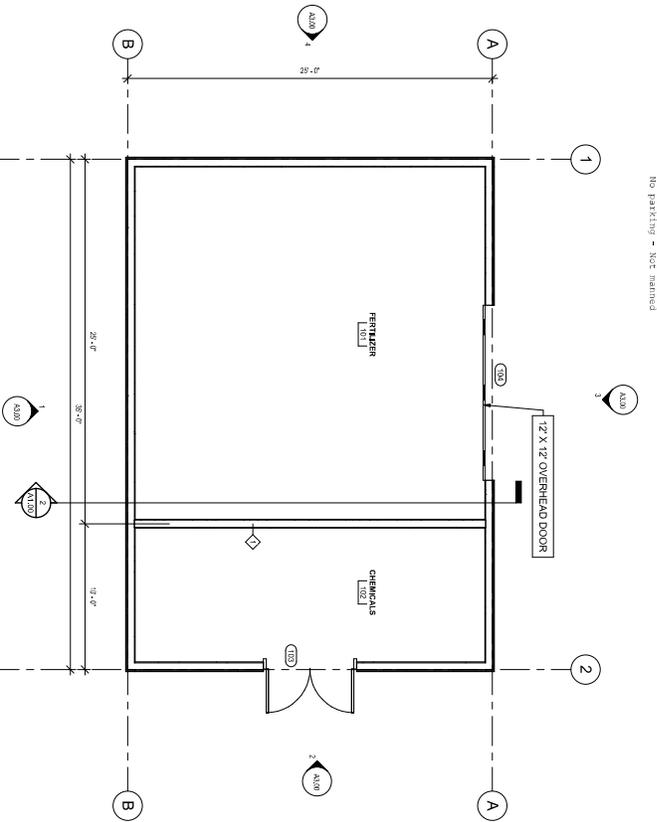

1 FLOOR PLAN
1/2" = 1'-0"

FLOOR PLAN GENERAL NOTES

1. DIMENSIONS INDICATED ARE FROM FACE OF STUD AND TO FACE OF WORKMAN UNLESS NOTED OTHERWISE.
2. CONTRACTOR TO COORDINATE LOCATIONS OF ADDITIONAL PARTITIONS THROUGH WALLS AND TO STRUCTURAL ENGINEERS FOR ALL OF ROOMS/COMPARTMENTS.



YOW

YOW Architects PC

Architecture & Planning

115 S. Weber Colorado Springs, Colorado 719-475-8133

Revision Schedule

NO.	DATE	DESCRIPTION

FERTILIZER - CHEMICAL BUILDING

FLYING HORSE NORTH
Colorado Springs, CO

Project Number
19.214

Date: 12.19

Drawn by

EAJW

Checked by

EAJW


Scale

As indicated

A1.00


Floor Plans.pdf Markup Summary

Cloud+ (2)

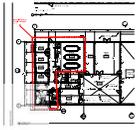

Subject: Cloud+
Page Label: 1
Author: dsdrangel
Date: 8/30/2019 12:34:10 PM
Color: ■

Parking - Professional Offices - 1space per 200 sq ft

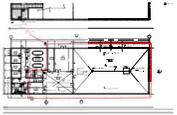

Subject: Cloud+
Page Label: 1
Author: dsdrangel
Date: 8/30/2019 12:34:28 PM
Color: ■

Parking -
Warehouse - 1 space per 1000 sq ft

Stamp (2)




Subject: Stamp
Page Label: 1
Author: BMcFarland
Date: 8/12/2019 2:15:12 PM
Color: ■



Subject: Stamp
Page Label: 2
Author: BMcFarland
Date: 8/12/2019 2:36:36 PM
Color: ■

Typewritten Text (1)

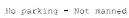

Subject: Typewritten Text
Page Label: 2
Author: dsdrangel
Date: 8/28/2019 2:06:31 PM
Color: ■

No parking - Not manned