


Schedule							
Symbol	Label	QTY	Manufacturer	Description	Catalog	LLF	Input Power
	PL1	3	Lithonia Lighting	RSX Area Fixture Size 2 P2 Lumen Package 4000K CCT Type R4 Distribution	RSX2 LED P2 40K R4	0.9	114.07
	PL2	1	Lithonia Lighting	RSX Area Fixture Size 2 P2 Lumen Package 4000K CCT Type R5S Distribution	RSX2 LED P2 40K R5S	0.9	114.07
	PL3	4	Lithonia Lighting	RSX LED Area Luminaire Size 2 P6 Lumen Package 4000K CCT Type R2 Distribution with HS shield	RSX2 LED P6 40K R2 HS	0.9	246.63
	WP1	7	Lithonia Lighting	WDGE1 LED WITH P1 - PERFORMANCE PACKAGE, 4000K, 80CRI, VISUAL COMFORT FORWARD OPTIC	WDGE1 LED P1 40K 80CRI VF	0.9	10.0002

Statistics							
Description	Symbol	Avg	Max	Min	Max/Min	Avg/Min	Calc Height
PARKING LOT		4.2 fc	15.8 fc	0.7 fc	22.6:1	6.0:1	0 ft
PARKING LOT > DRIVE THRU	+	9.7 fc	15.8 fc	3.4 fc	4.6:1	2.9:1	0 ft
PARKING LOT > GENERAL PARKING	+	2.3 fc	9.2 fc	0.7 fc	13.1:1	3.3:1	0 ft
SIDEWALK	+	3.1 fc	8.4 fc	0.4 fc	21.0:1	7.8:1	0 ft
SIDEWALK > ENTRANCE, MAIN	ж	0.6 fc	0.7 fc	0.6 fc	1.2:1	1.0:1	0 ft
SIDEWALK > ENTRANCE, SERVICE	ж	3.4 fc	4.3 fc	2.8 fc	1.5:1	1.2:1	0 ft
SIDEWALK > ENTRANCE, SIDE	ж	0.9 fc	1.0 fc	0.8 fc	1.3:1	1.1:1	0 ft

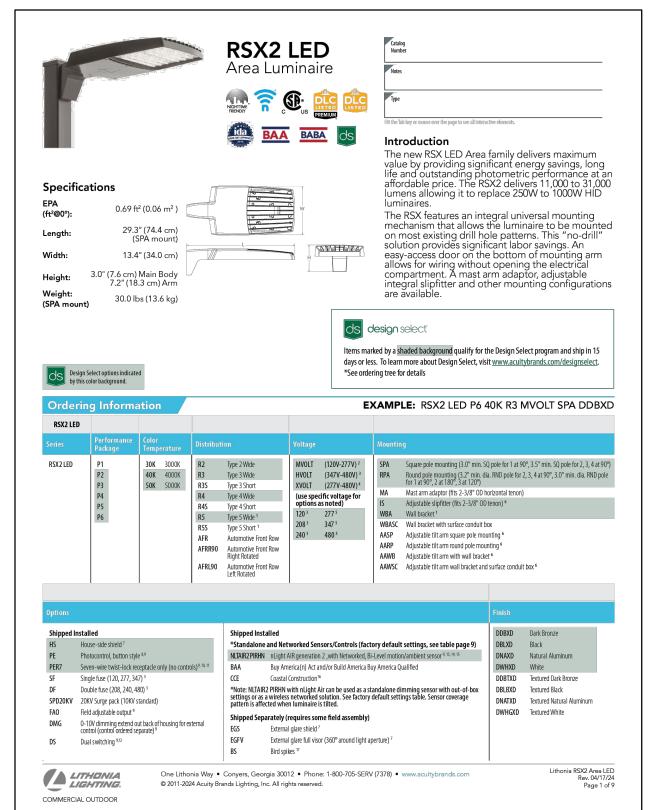

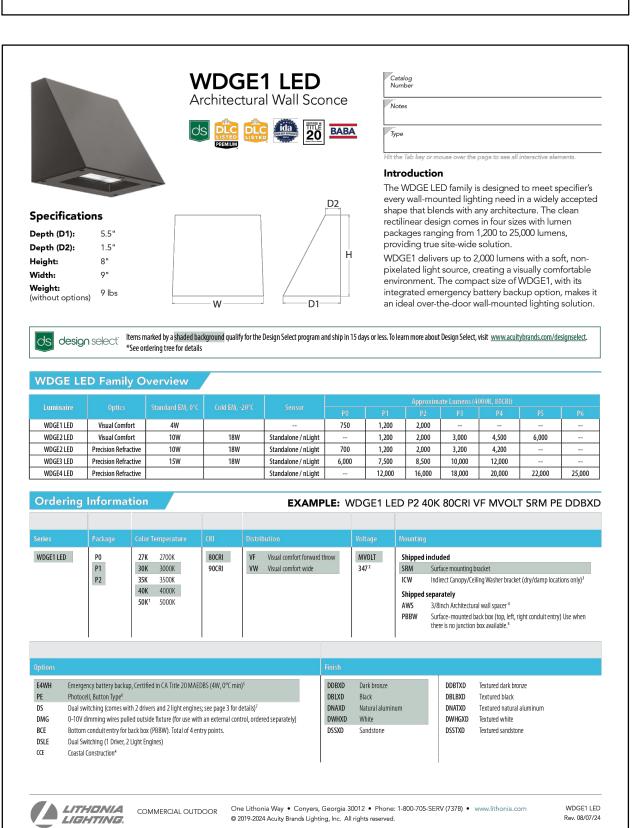

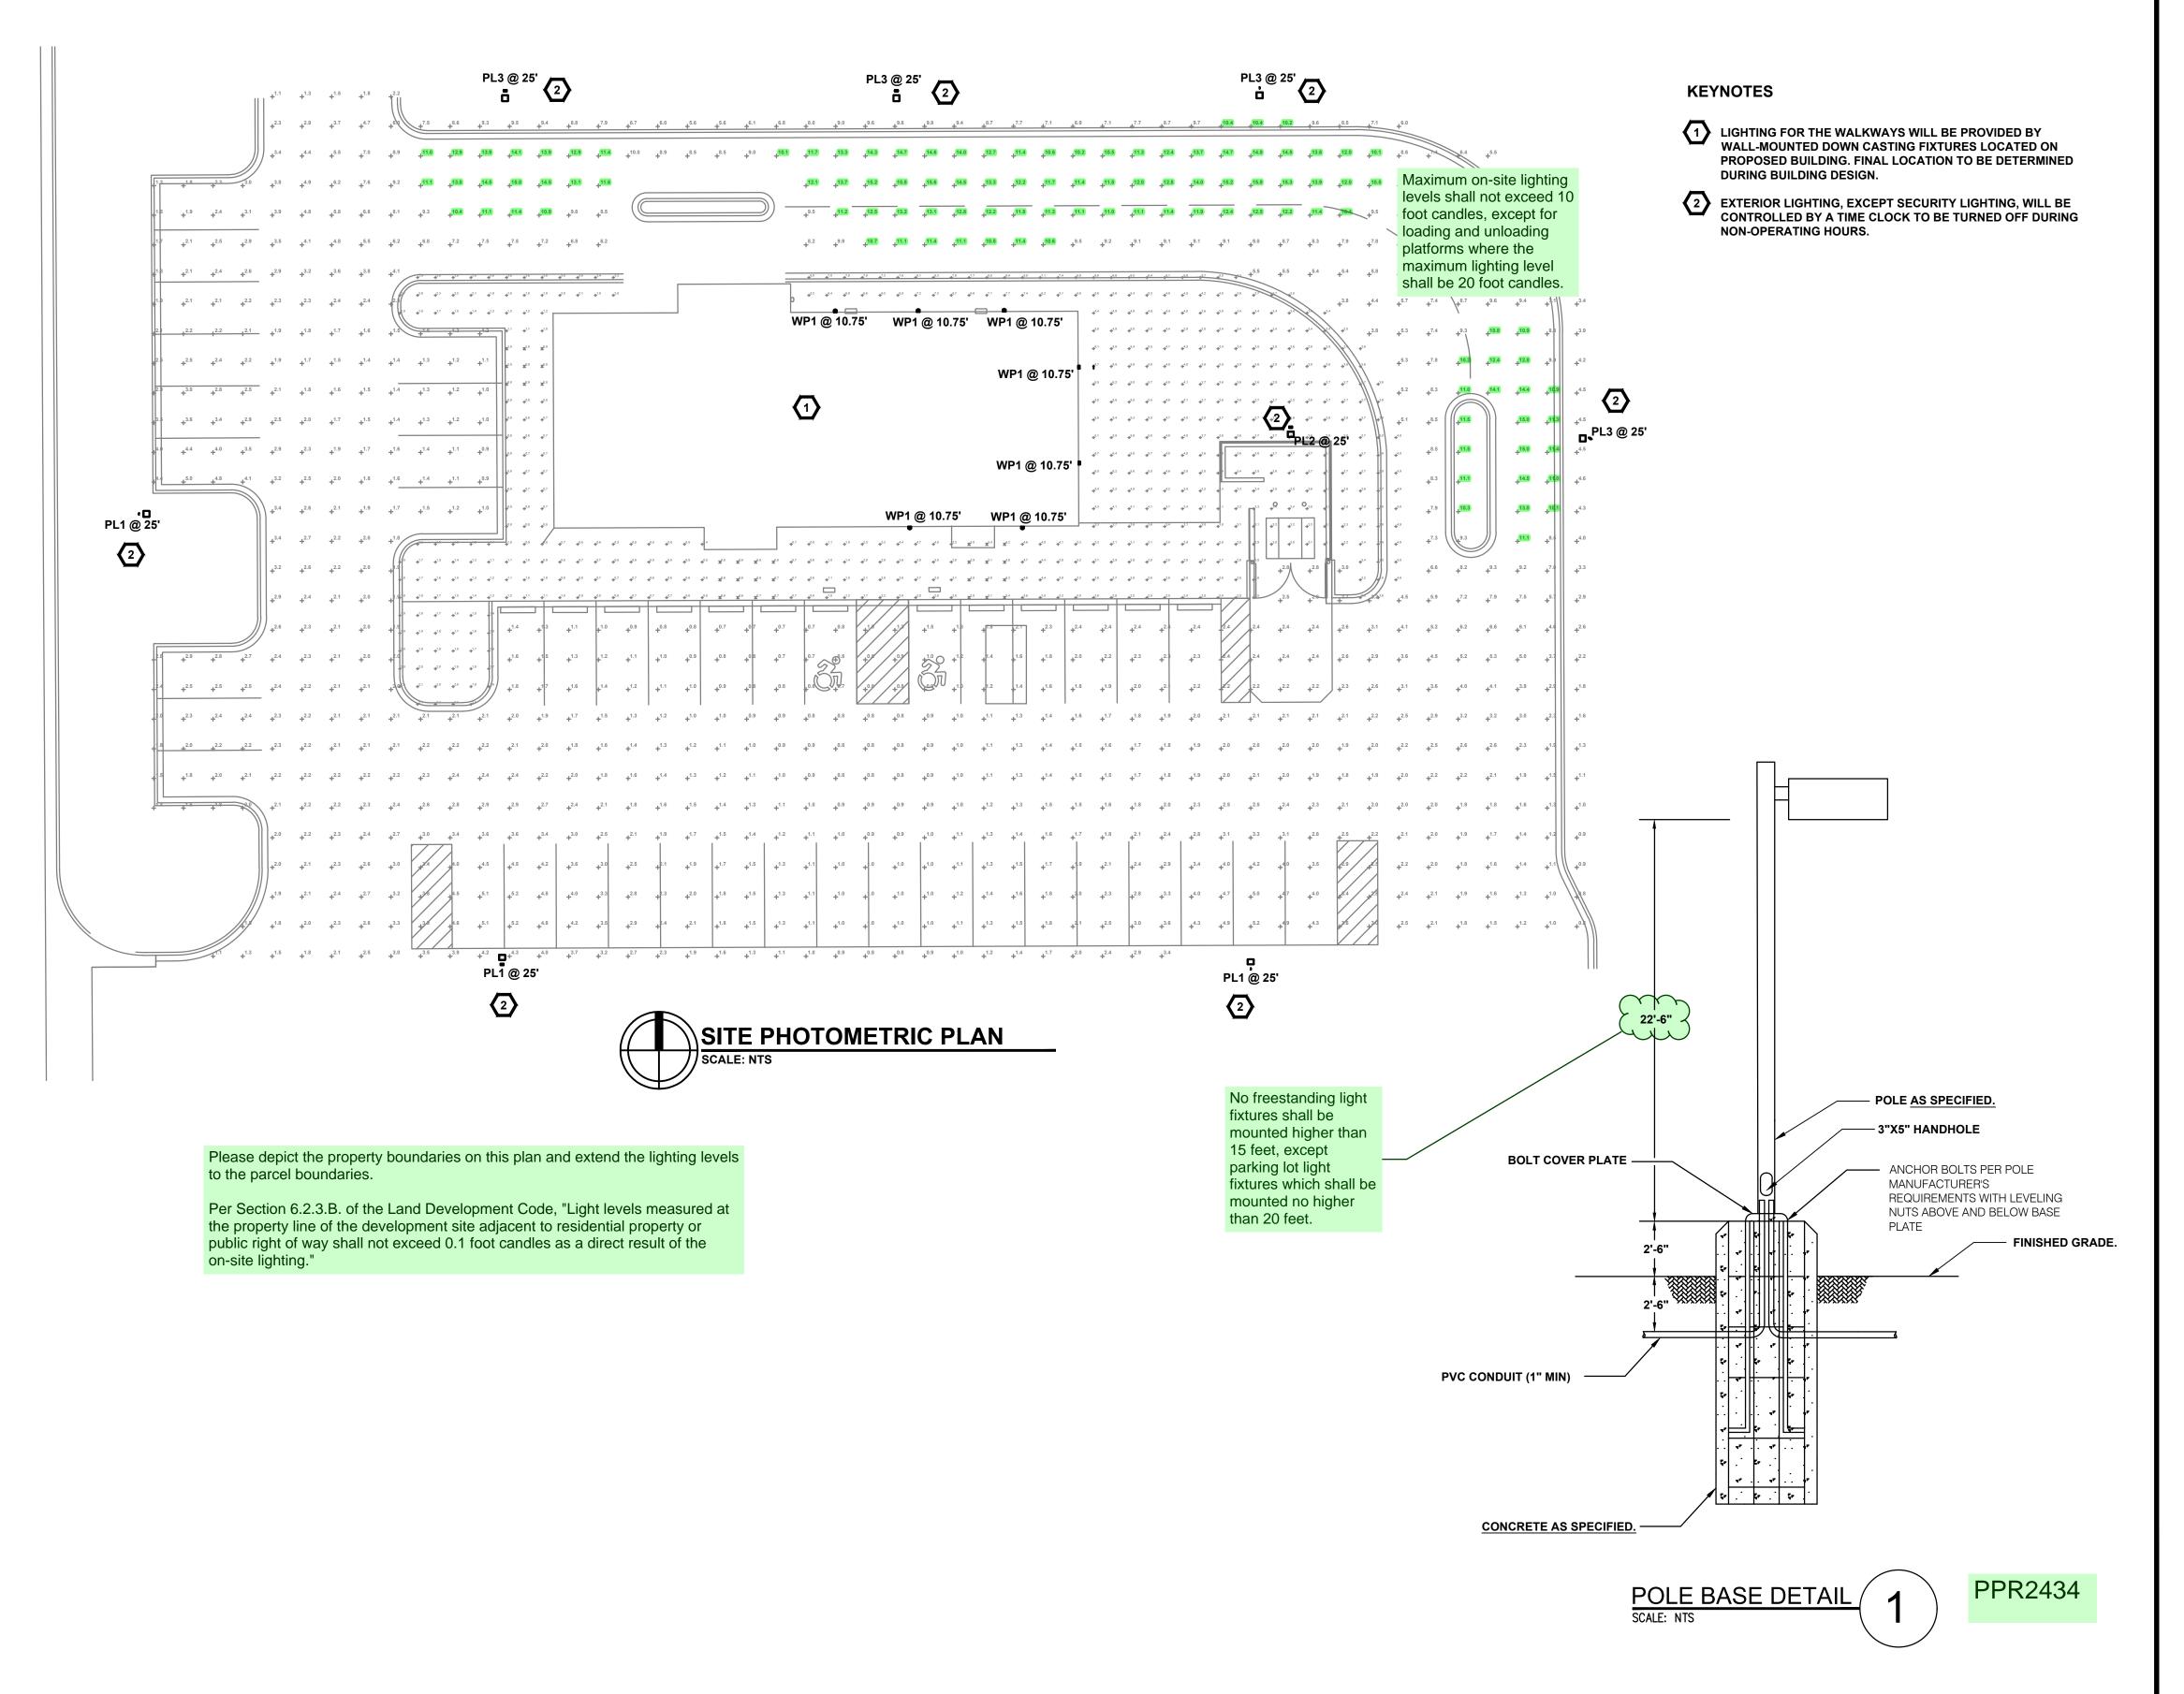

GENERAL NOTES

- A. DRAWINGS ARE BASED ON RECORD DRAWINGS (NOT GUARANTEED TO BE CURRENT AT TIME OF CONSTRUCTION)
 AND FIELD INVESTIGATION WITH DEMOLITION. EXAMINE PLANS AND VISIT THE SITE TO FIELD VERIFY ACTUAL CONDITIONS AND COORDINATE SAME WITH OTHER TRADES PRIOR TO STARTING
- B. A LICENSED AND BONDED CONTRACTOR SHALL BE USED FOR INSTALLATION. ALL LOCAL CODES SHALL BE FOLLOWED DURING INSTALLATION.
- C. ALL LIGHTING FIXTURES SHALL BE FULL CUT-OFF OR HAVE SHIELDING TO REDUCE OFF-SITE LIGHTING IMPACTS ONTO ADJACENT PROPERTIES AND ROADWAYS. ALL EXTERIOR LIGHTING SHALL BE ARRANGED TO MITIGATE LIGHT DIRECTED AWAY FROM ADJACENT PROPERTIES AND ANY PUBLIC RIGHT-OF-WAY. AN AMENDMENT TO THIS PLAN MAY BE REQUIRED IF THE LIGHTING TYPE IS CHANGED.
- D. A FINAL COMMISSIONING REPORT SHALL BE DELIVERED TO THE BUILDING OWNER PER SECTION C408.2.5 OF THE 2021 IECC.

WHATABURGER 7845 MERIDIAN PARK DR FALCON, CO 80831

10186 MT. LINCOLN DR. PEYTON, CO 80831

INFO@CHIARTANOEG.COM

719.257.2091

ENGINEER SEAL:

À	ISSUED FOR DP REVIEW	09/20/2024
NO.	REVISION	DATE
	•	

PROJECT NO: DRAWN BY: CHECKED BY: DATE: 24-0803 MPC MPC 09/20/2024

SHEET CONTENTS:

SITE PHOTOMETRIC PLAN

SHEET NUMBER:

E100A