


MAYBERRY FILING 5
LANDSCAPE PLAN
TRACT K OF MAYBERRY COLORADO SPRINGS FILING NO. 1
 SITUATED IN THE NORTHWEST QUARTER OF SECTION 14, TOWNSHIP 14 SOUTH, RANGE 63 WEST OF THE 6TH P.M.
 COUNTY OF EL PASO, STATE OF COLORADO

SHEET INDEX MAP (N.T.S.)

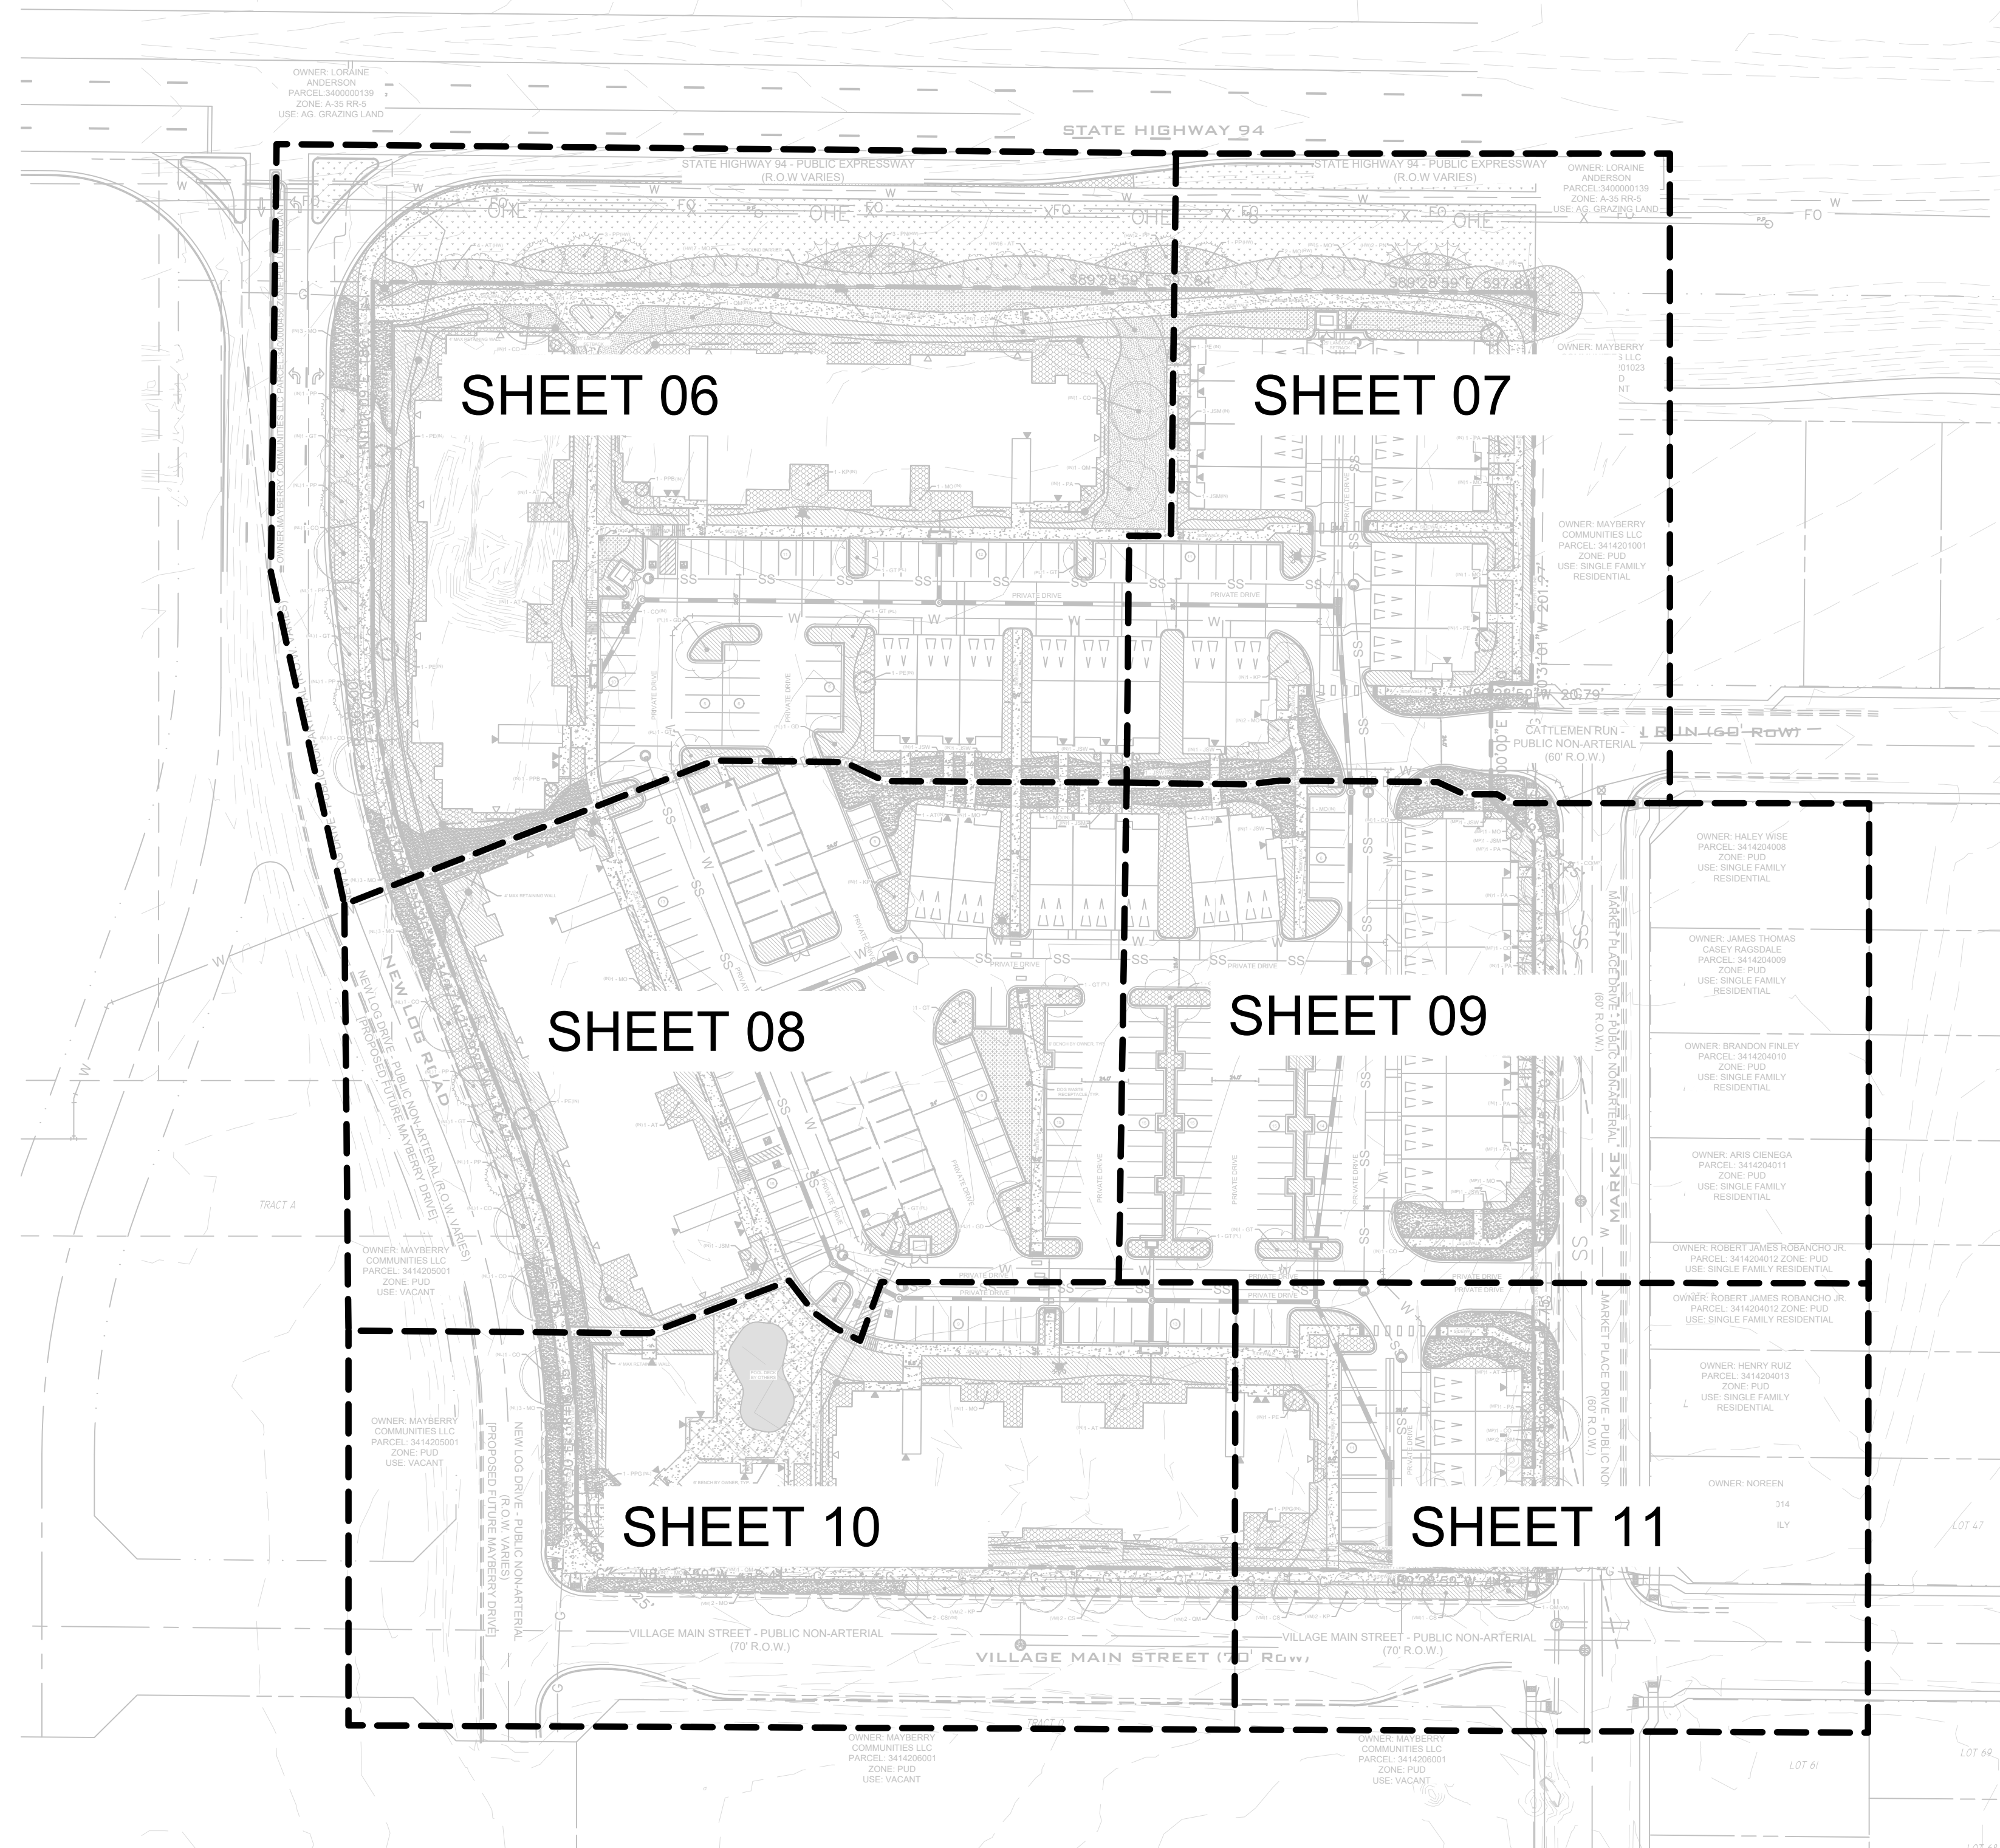

| SHEET INDEX | |
|--------------|----------------------------|
| SHEET NUMBER | SHEET TITLE |
| 05 | LANDSCAPE SHEET INDEX |
| 06 | PRELIMINARY LANDSCAPE PLAN |
| 07 | PRELIMINARY LANDSCAPE PLAN |
| 09 | PRELIMINARY LANDSCAPE PLAN |
| 08 | PRELIMINARY LANDSCAPE PLAN |
| 10 | PRELIMINARY LANDSCAPE PLAN |
| 11 | PRELIMINARY LANDSCAPE PLAN |
| 12 | LANDSCAPE NOTES |
| 13 | LANDSCAPE DETAILS |


| LANDSCAPE SETBACKS AND BUFFERS | | | | |
|--------------------------------------|------------------|--------------------|---------------------|------------------|
| STREET NAME OR BOUNDARY: | STATE HIGHWAY 94 | MARKET PLACE DRIVE | VILLAGE MAIN STREET | NEW LOG DRIVE |
| ZONE DISTRICT BOUNDARY: | NO | NO | NO | NO |
| STREET CLASSIFICATION: | EXPRESSWAY | NON-ARTERIAL | NON-ARTERIAL | NON-ARTERIAL |
| SETBACK DEPTH REQUIRED / PROVIDED: | 25' / 25' | 15' / 2-15'+ | 10' / 10' | 10' / 10' |
| LINEAR FOOTAGE: | 598' | 446' | 480' | 669' |
| TREE PER FEET REQ.: | 1 TREE PER 20 LF | 1 TREE PER 25 LF | 1 TREE PER 30 LF | 1 TREE PER 30 LF |
| NUMBER OF TREES REQ. / PROV.: | 30 / 30 | 18 / 18 | 16 / 16 | 23 / 23 |
| EVERGREEN TREES REQ. / PROV.: | N/A | 6 / 6 | N/A | N/A |
| SHRUB SUBSTITUTES REQ. / PROV.: | N/A | N/A | N/A | N/A |
| ORN. GRASS SUBSTITUTES REQ. / PROV.: | N/A | N/A | N/A | N/A |
| OPAQUE SCREEN REQ. / PROV.: | N/A | N/A | N/A | N/A |
| PLANT ABBREVIATION DENOTED ON PLAN: | HW | MP | VM | NL |

| INTERNAL LANDSCAPING | |
|---------------------------------------|------------------------|
| NET SITE AREA: | 362,156 SF (8.31 AC) |
| PERCENT MINIMUM INTERNAL AREA: | 15% |
| INTERNAL LANDSCAPE AREA REQ. / PROV.: | 54,324 SF / 133,272 SF |
| TREE PER FEET REQ.: | 1 TREE PER 500 SF |
| INTERNAL TREES REQ. / PROV.: | 109 / 73 |
| SHRUB SUBSTITUTES REQ. / PROV.: | 360 / XX* |
| ORN. GRASS SUBSTITUTES REQ. / PROV.: | N/A |
| PLANT ABBREVIATION DENOTED ON PLAN: | IN |
| % GROUND PLANE VEG. REQ. / PROV.: | 75% / 75% |

*NOTE: INTERNAL TREE REQUIREMENT SHALL BE MET WITH SHRUBS UPON INSTALLATION. SPECIES TO BE SELECTED BY CONTRACTOR/OWNER.

| PARKING LOT LANDSCAPING | |
|--|----------------------|
| NUMBER OF VEHICLE SPACES PROVIDED: | 218 |
| SHADE TREES REQUIRED: | 1 TREE PER 15 STALLS |
| SHADE TREES REQ. / PROV.: | 15 / 15 |
| PARKING LOT FRONTAGES: | N/A |
| LENGTH OF FRONTAGE: | N/A |
| LENGTH OF 3' TALL SCREENING PLANTS REQ. / PROV.: | N/A |
| LENGTH OF BERM OR FENCE REQ. / PROV.: | N/A |
| PLANT ABBREVIATION DENOTED ON PLAN: | PL |

 EPC APPROVAL:



LANDSCAPE SHEET INDEX
 SHEET 05 OF 15

OWNER: LORAIN
ANDERSON
PARCEL: 340000139
ZONE: A-35 RR-5
USE: AG. GRAZING LAND

MAYBERRY FILING 5 LANDSCAPE PLAN TRACT K OF MAYBERRY COLORADO SPRINGS FILING NO. 1 SITUATED IN THE NORTHWEST QUARTER OF SECTION 14, TOWNSHIP 14 SOUTH, RANGE 63 WEST OF THE 6TH P.M. COUNTY OF EL PASO, STATE OF COLORADO

STATE HIGHWAY 94 - PUBLIC EXPRESSWAY
(R.O.W VARIES)

OWNER: MAYBERRY COMMUNITIES LLC PARCEL: 340000456 ZONE: PUD USE: VACANT

PROPOSED FUTURE MAYBERRY DRIVE
[PROPOSED FUTURE NON-ARTERIAL (R.O.W. VARIES)]


please provide a note that indicates that a License agreement with the County and written approval from the ECM administrator shall be obtained prior to placement of landscaping within the ROW per ECM 2.5.8

Additionally, Please identify how trees in the ROW will be prevented from impacting roadway infrastructure and vehicles. Will root barriers be specified, trees with canopies that would not extend into the ROW etc. Please address.

PLANT SCHEDULE

| DECIDUOUS TREES | | CODE | QTY | BOTANICAL / COMMON NAME |
|-----------------|-----------|------|-----|---|
| AT | 17 | | | ACER TATARICUM / HOT WINGS / HOT WINGS TATARIAN MAPLE |
| CO | 17 | | | CELTIS OCCIDENTALIS / CHICKAGLAND / CHICKAGLAND WESTERN HACKBERRY |
| CS | 6 | | | CATALPA SPECIOSA / NORTHERN CATALPA |
| GD | 6 | | | GYMNOCALADUS DIOICA / ESPRESSO / KENTUCKY COFFEE TREE (BEEDESS) |
| GT | 13 | | | GLEDITSIA TRACANTHOS NERIMS / SUNBURST / SUNBURST HONEY LOCUST |
| KP | 8 | | | KOELREUTERIA PANICULATA / GOLDEN RAIN TREE |
| MO | 41 | | | MALUS 'CORALBURST' / CORALBURST CRABAPPLE |
| PA | 11 | | | PRUNUS CERASIFERA CRIMSON POINT / COULNAR PURPLE PLUM |
| QM | 7 | | | QUERCUS MACROCARPA / BURR OAK |
| EVERGREEN TREES | | CODE | QTY | BOTANICAL / COMMON NAME |
| JSM | 10 | | | JUNIPERUS SCOPULORUM / MOONGLOW / MOONGLOW JUNIPER LOW ROOT DAMAGE POTENTIAL |
| JSW | 8 | | | JUNIPERUS SCOPULORUM / WICHTA BLUE / WICHTA BLUE JUNIPER |
| PE | 8 | | | PINUS EDULIS / PINON PINE |
| PN | 6 | | | PINUS NIGRA / AUSTRIAN BLACK PINE |
| PP | 12 | | | PINUS PONDEROSA / PONDEROSA PINE |
| PPB | 2 | | | PICEA PLUNGENS / BLUE DIAMOND / BLUE DIAMOND DWARF SPRUCE |
| PPF | 1 | | | PICEA PLUNGENS / FASTIGIATA / FASTIGIATE BLUE SPRUCE |
| PPG | 2 | | | PICEA PLUNGENS / LAULUA / COLORADO BLUE SPRUCE |
| GROUND COVERS | | CODE | QTY | BOTANICAL / COMMON NAME |
| BREEZE | 4.641 SF | | | BREEZE / CRUISER FINES BREEZE COLOR TO VARY FROM TRAIL AND TO BE SELECTED BY OWNER/CONTRACTOR |
| ROCK-A | 43.013 SF | | | ROCK MULCH A / ROCK MULCH AND PLANTINGS ROCK MULCH TYPE TO BE DECIDED BY OWNER/CONTRACTOR. ROCK MULCH TO BE PLANTED WITH SHRUBS AND GRASSES. |
| ROCK-B | 43.318 SF | | | ROCK MULCH B / ROCK MULCH AND PLANTINGS ROCK MULCH TYPE TO BE DECIDED BY OWNER/CONTRACTOR. ROCK MULCH TO BE PLANTED WITH SHRUBS AND GRASSES. |
| SEED | 4.825 SF | | | EPC LOW GROW MIX INSTALL PER TABLE 5-1. SUBMIT SUPPLIER CUT-SHEET FOR REVIEW AND APPROVAL PRIOR TO INSTALLATION. |
| SEED2 | 20.170 SF | | | EPC ALL PURPOSE MIX INSTALL PER TABLE 5-1. SUBMIT SUPPLIER CUT-SHEET FOR REVIEW AND APPROVAL PRIOR TO INSTALLATION. |
| SOD | 18.175 SF | | | SURVALETT TALL FESCUE INSTALL PER DETAIL - 47% GRAND TALL FESCUE, 47% SR869 TALL FESCUE, 6% BRITISH BROOM BHRBG |


NOTE: SEE SHEET L-109 FOR FULL PLANT LIST AND SPECIFICATIONS

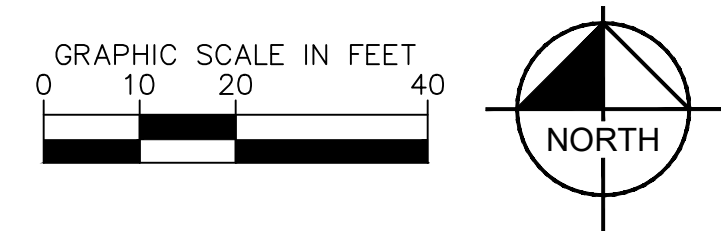

PRELIMINARY LANDSCAPE PLAN
SHEET 06 OF 15

MAYBERRY FILING 5
LANDSCAPE PLAN
TRACT K OF MAYBERRY COLORADO SPRINGS FILING NO. 1
 SITUATED IN THE NORTHWEST QUARTER OF SECTION 14, TOWNSHIP 14 SOUTH, RANGE 63 WEST OF THE 6TH P.M.
 COUNTY OF EL PASO, STATE OF COLORADO

TE HIGHWAY 94

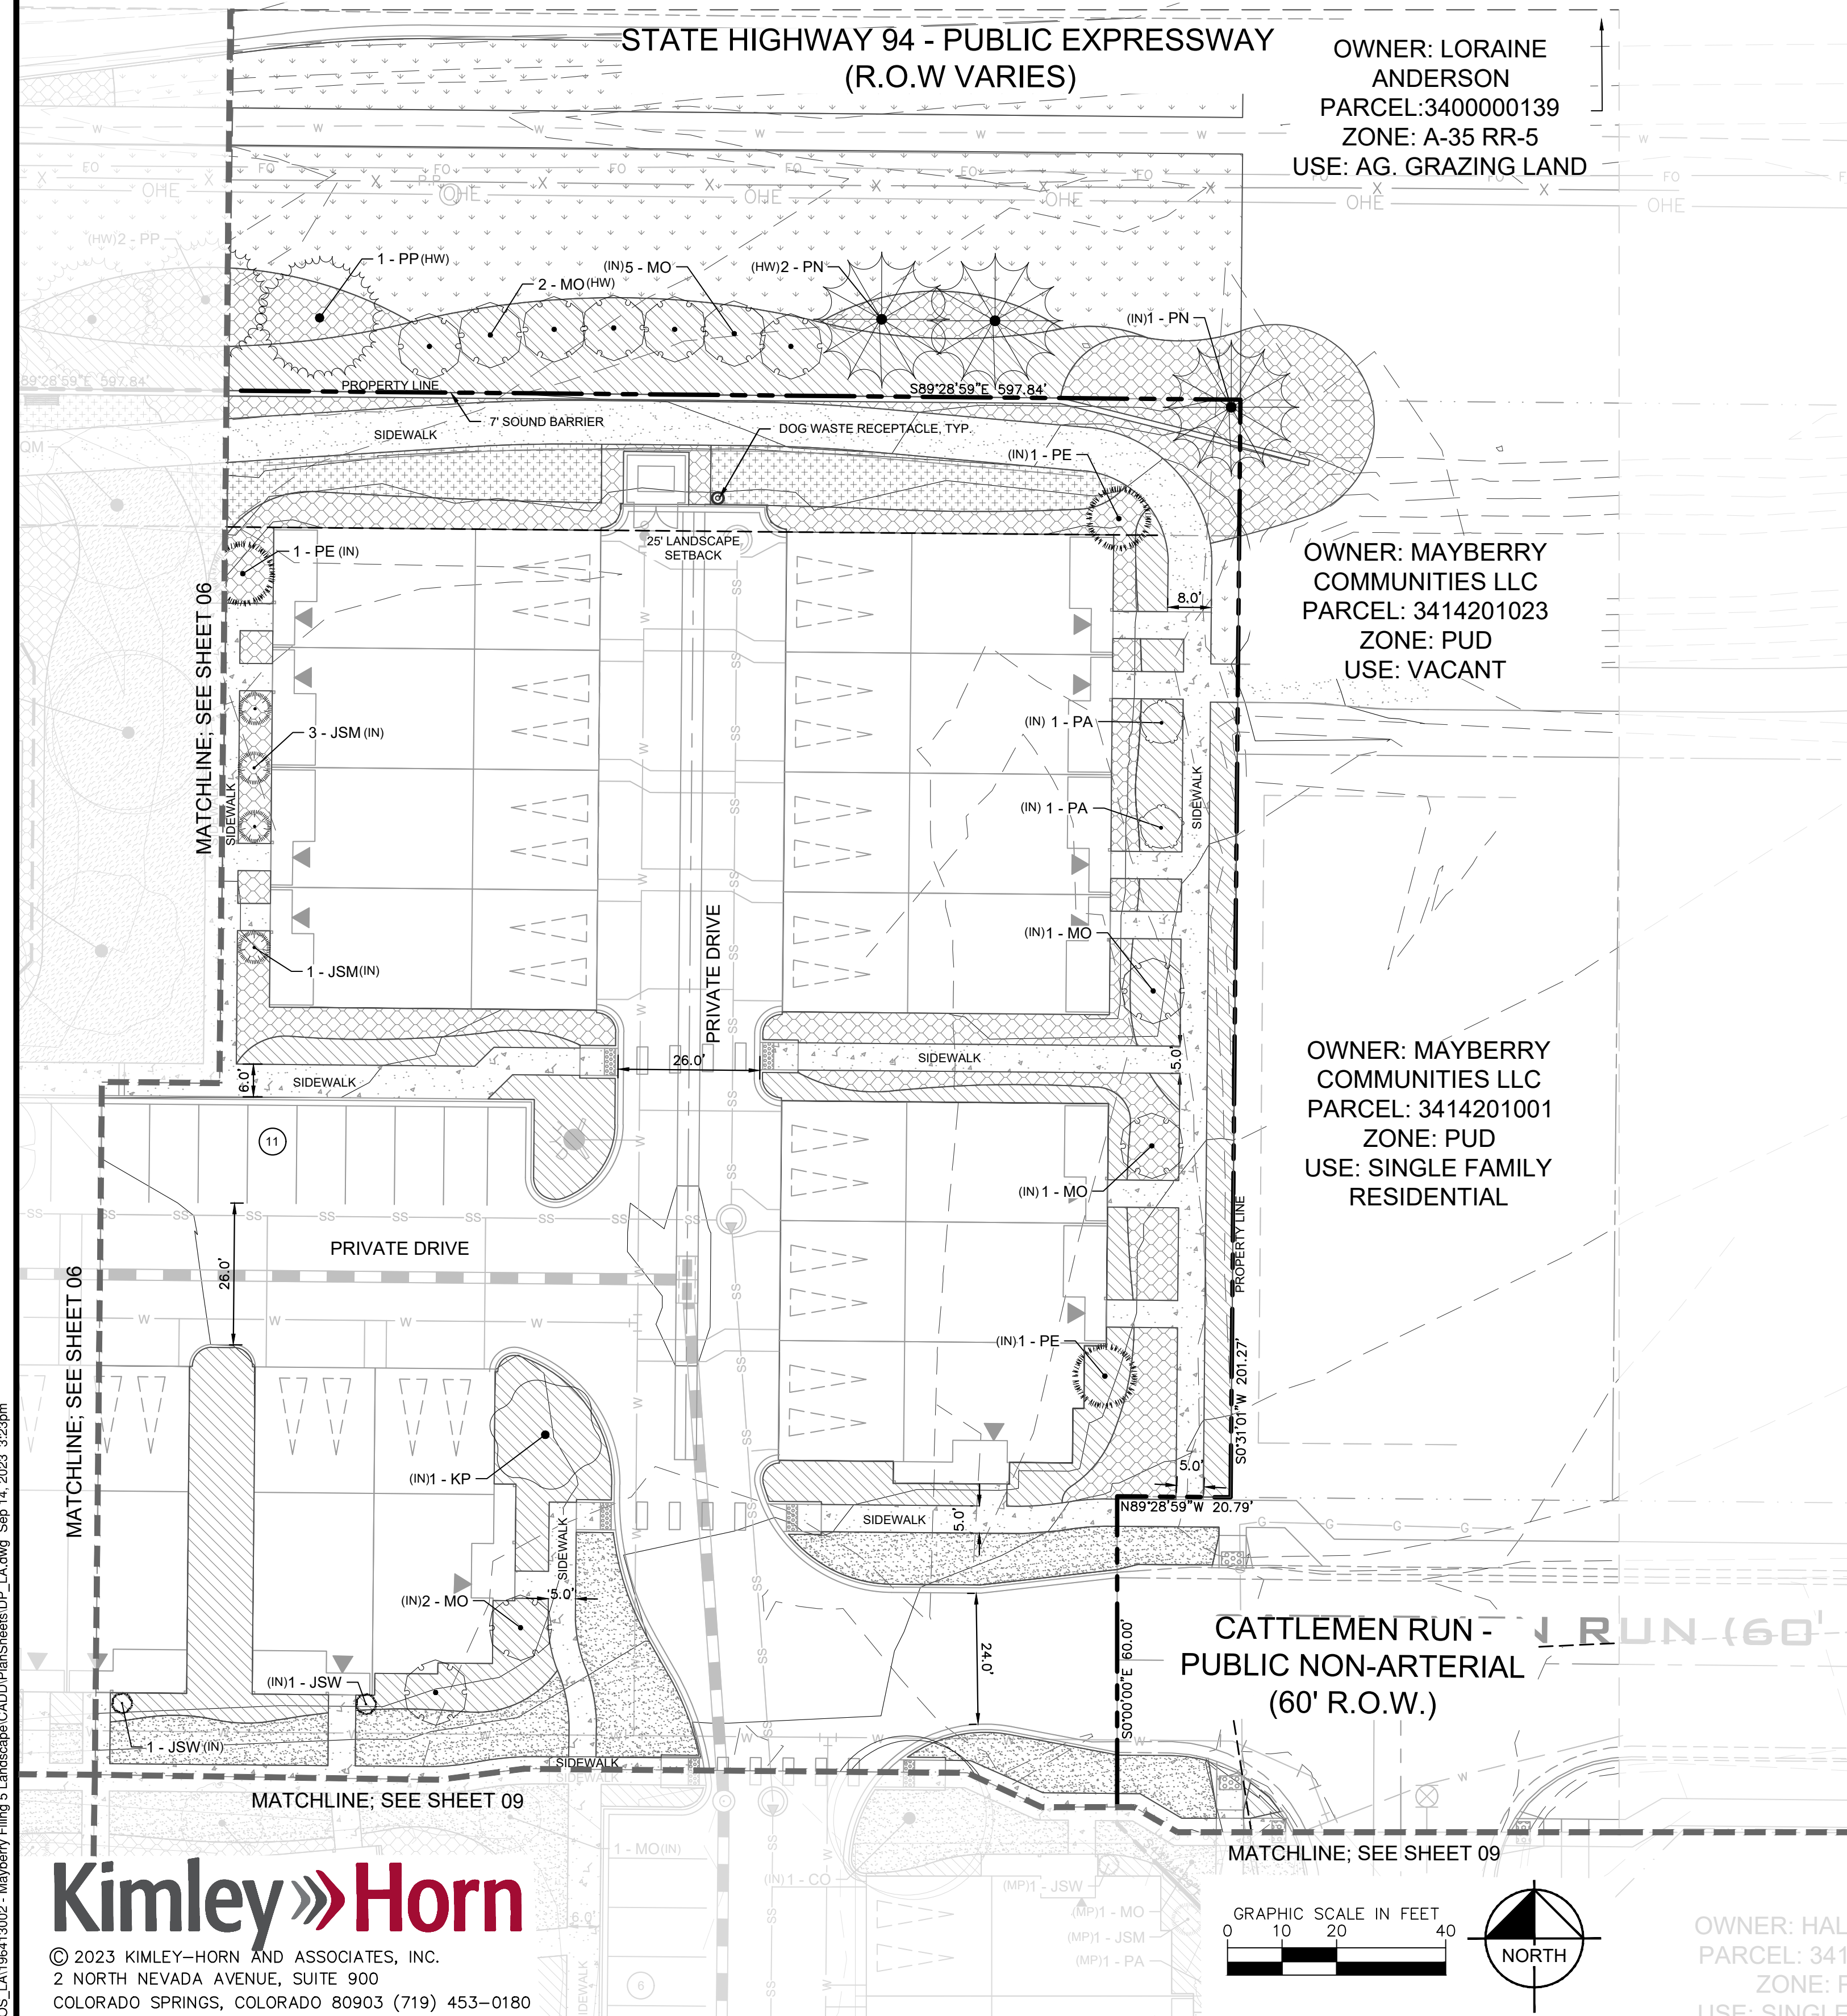

OWNER: LORAIN
 ANDERSON
 PARCEL: 3400000139
 ZONE: A-35 RR-5
 USE: AG. GRAZING LAND

OWNER: MAYBERRY
 COMMUNITIES LLC
 PARCEL: 3414201023
 ZONE: PUD
 USE: VACANT

OWNER: MAYBERRY
 COMMUNITIES LLC
 PARCEL: 3414201001
 ZONE: PUD
 USE: SINGLE FAMILY
 RESIDENTIAL


CATTLEMEN RUN - J RUN (60'±)
 PUBLIC NON-ARTERIAL
 (60' R.O.W.)

PLANT SCHEDULE


| DECIDUOUS TREES | CODE | QTY | BOTANICAL / COMMON NAME |
|-----------------|--------|-----------|---|
| | AT | 17 | ACER TATARICUM 'HOT WINGS' / HOT WINGS TATARIAN MAPLE |
| | CO | 17 | CELTIS OCCIDENTALIS 'CHICAGOLAND' / CHICAGOLAND WESTERN HACKBERRY |
| | CS | 6 | CATALPA SPECIOSA / NORTHERN CATALPA |
| | GD | 6 | GYMNOCLADUS DIOICA 'ESPRESSO' / KENTUCKY COFFEE TREE (SEEDLESS) |
| | GT | 13 | GLEDITSIA TRIACANTHOS INERMIS 'SUNBURST' / SUNBURST HONEY LOCUST |
| | KP | 8 | KOELREUTERIA PANICULATA / GOLDEN RAIN TREE |
| | MO | 41 | MALUS 'CORALBURST' / CORALBURST CRABAPPLE |
| | PA | 11 | PRUNUS CERASIFERA CRIMSON POINTE / COLUMNAR PURPLE PLUM |
| | QM | 7 | QUERCUS MACROCARPA / BURR OAK |
| EVERGREEN TREES | CODE | QTY | BOTANICAL / COMMON NAME |
| | JSM | 10 | JUNIPERUS SCOPULORUM 'MOONGLOW' / MOONGLOW JUNIPER LOW ROOT DAMAGE POTENTIAL |
| | JSW | 8 | JUNIPERUS SCOPULORUM 'WICHITA BLUE' / WICHITA BLUE JUNIPER |
| | PE | 8 | PINUS EDULIS / PINON PINE |
| | PN | 6 | PINUS NIGRA / AUSTRIAN BLACK PINE |
| | PP | 12 | PINUS PONDEROSA / PONDEROSA PINE |
| | PPB | 2 | PICEA PUNGENS 'BLUE DIAMOND' / BLUE DIAMOND DWARF SPRUCE |
| | PPF | 1 | PICEA PUNGENS 'FASTIGIATA' / FASTIGIATE BLUE SPRUCE |
| | PPG | 2 | PICEA PUNGENS 'GLAUCA' / COLORADO BLUE SPRUCE |
| GROUND COVERS | CODE | QTY | BOTANICAL / COMMON NAME |
| | BREEZE | 4,641 SF | BREEZE / CRUSHER FINES BREEZE COLOR TO VARY FROM TRAIL AND TO BE SELECTED BY OWNER/CONTRACTOR. |
| | ROCK-A | 43,013 SF | ROCK MULCH A / ROCK MULCH AND PLANTINGS ROCK MULCH TYPE TO BE DECIDED BY OWNER/CONTRACTOR. ROCK MULCH TO BE PLANTED WITH SHRUBS AND GRASSES. |
| | ROCK-B | 43,318 SF | ROCK MULCH B / ROCK MULCH AND PLANTINGS ROCK MULCH TYPE TO BE DECIDED BY OWNER/CONTRACTOR. ROCK MULCH TO BE PLANTED WITH SHRUBS AND GRASSES. |
| | SEED | 4,825 SF | EPC LOW GROW MIX INSTALL PER TABLE 5-2. SUBMIT SUPPLIER CUT-SHEET FOR REVIEW AND APPROVAL PRIOR TO INSTALLATION. |
| | SEED2 | 20,170 SF | EPC ALL PURPOSE MIX INSTALL PER TABLE 5-1. SUBMIT SUPPLIER CUT-SHEET FOR REVIEW AND APPROVAL PRIOR TO INSTALLATION. |
| | SOD | 18,175 SF | SURVIVALIST TALL FESCUE INSTALL PER DETAIL - 47% GRAND II TALL FESCUE, 47% SR8650 TALL FESCUE, 6% SPITFIRE TEXAS HYBRID |

NOTE: SEE SHEET I-109 FOR FULL PLANT LIST AND SPECIFICATIONS

 EPC APPROVAL:




Kimley»Horn
 © 2023 KIMLEY-HORN AND ASSOCIATES, INC.
 2 NORTH NEVADA AVENUE, SUITE 900
 COLORADO SPRINGS, COLORADO 80903 (719) 453-0180

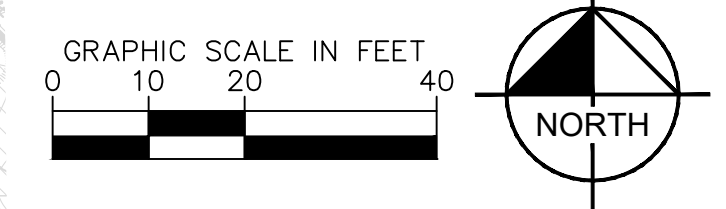

OWNER: HALE
 PARCEL: 3414
 ZONE: PL
 USE: SINGLE I

PRELIMINARY LANDSCAPE PLAN
 SHEET 07 OF 15

MAYBERRY FILING 5 LANDSCAPE PLAN TRACT K OF MAYBERRY COLORADO SPRINGS FILING NO. 1 SITUATED IN THE NORTHWEST QUARTER OF SECTION 14, TOWNSHIP 14 SOUTH, RANGE 63 WEST OF THE 6TH P.M. COUNTY OF EL PASO, STATE OF COLORADO

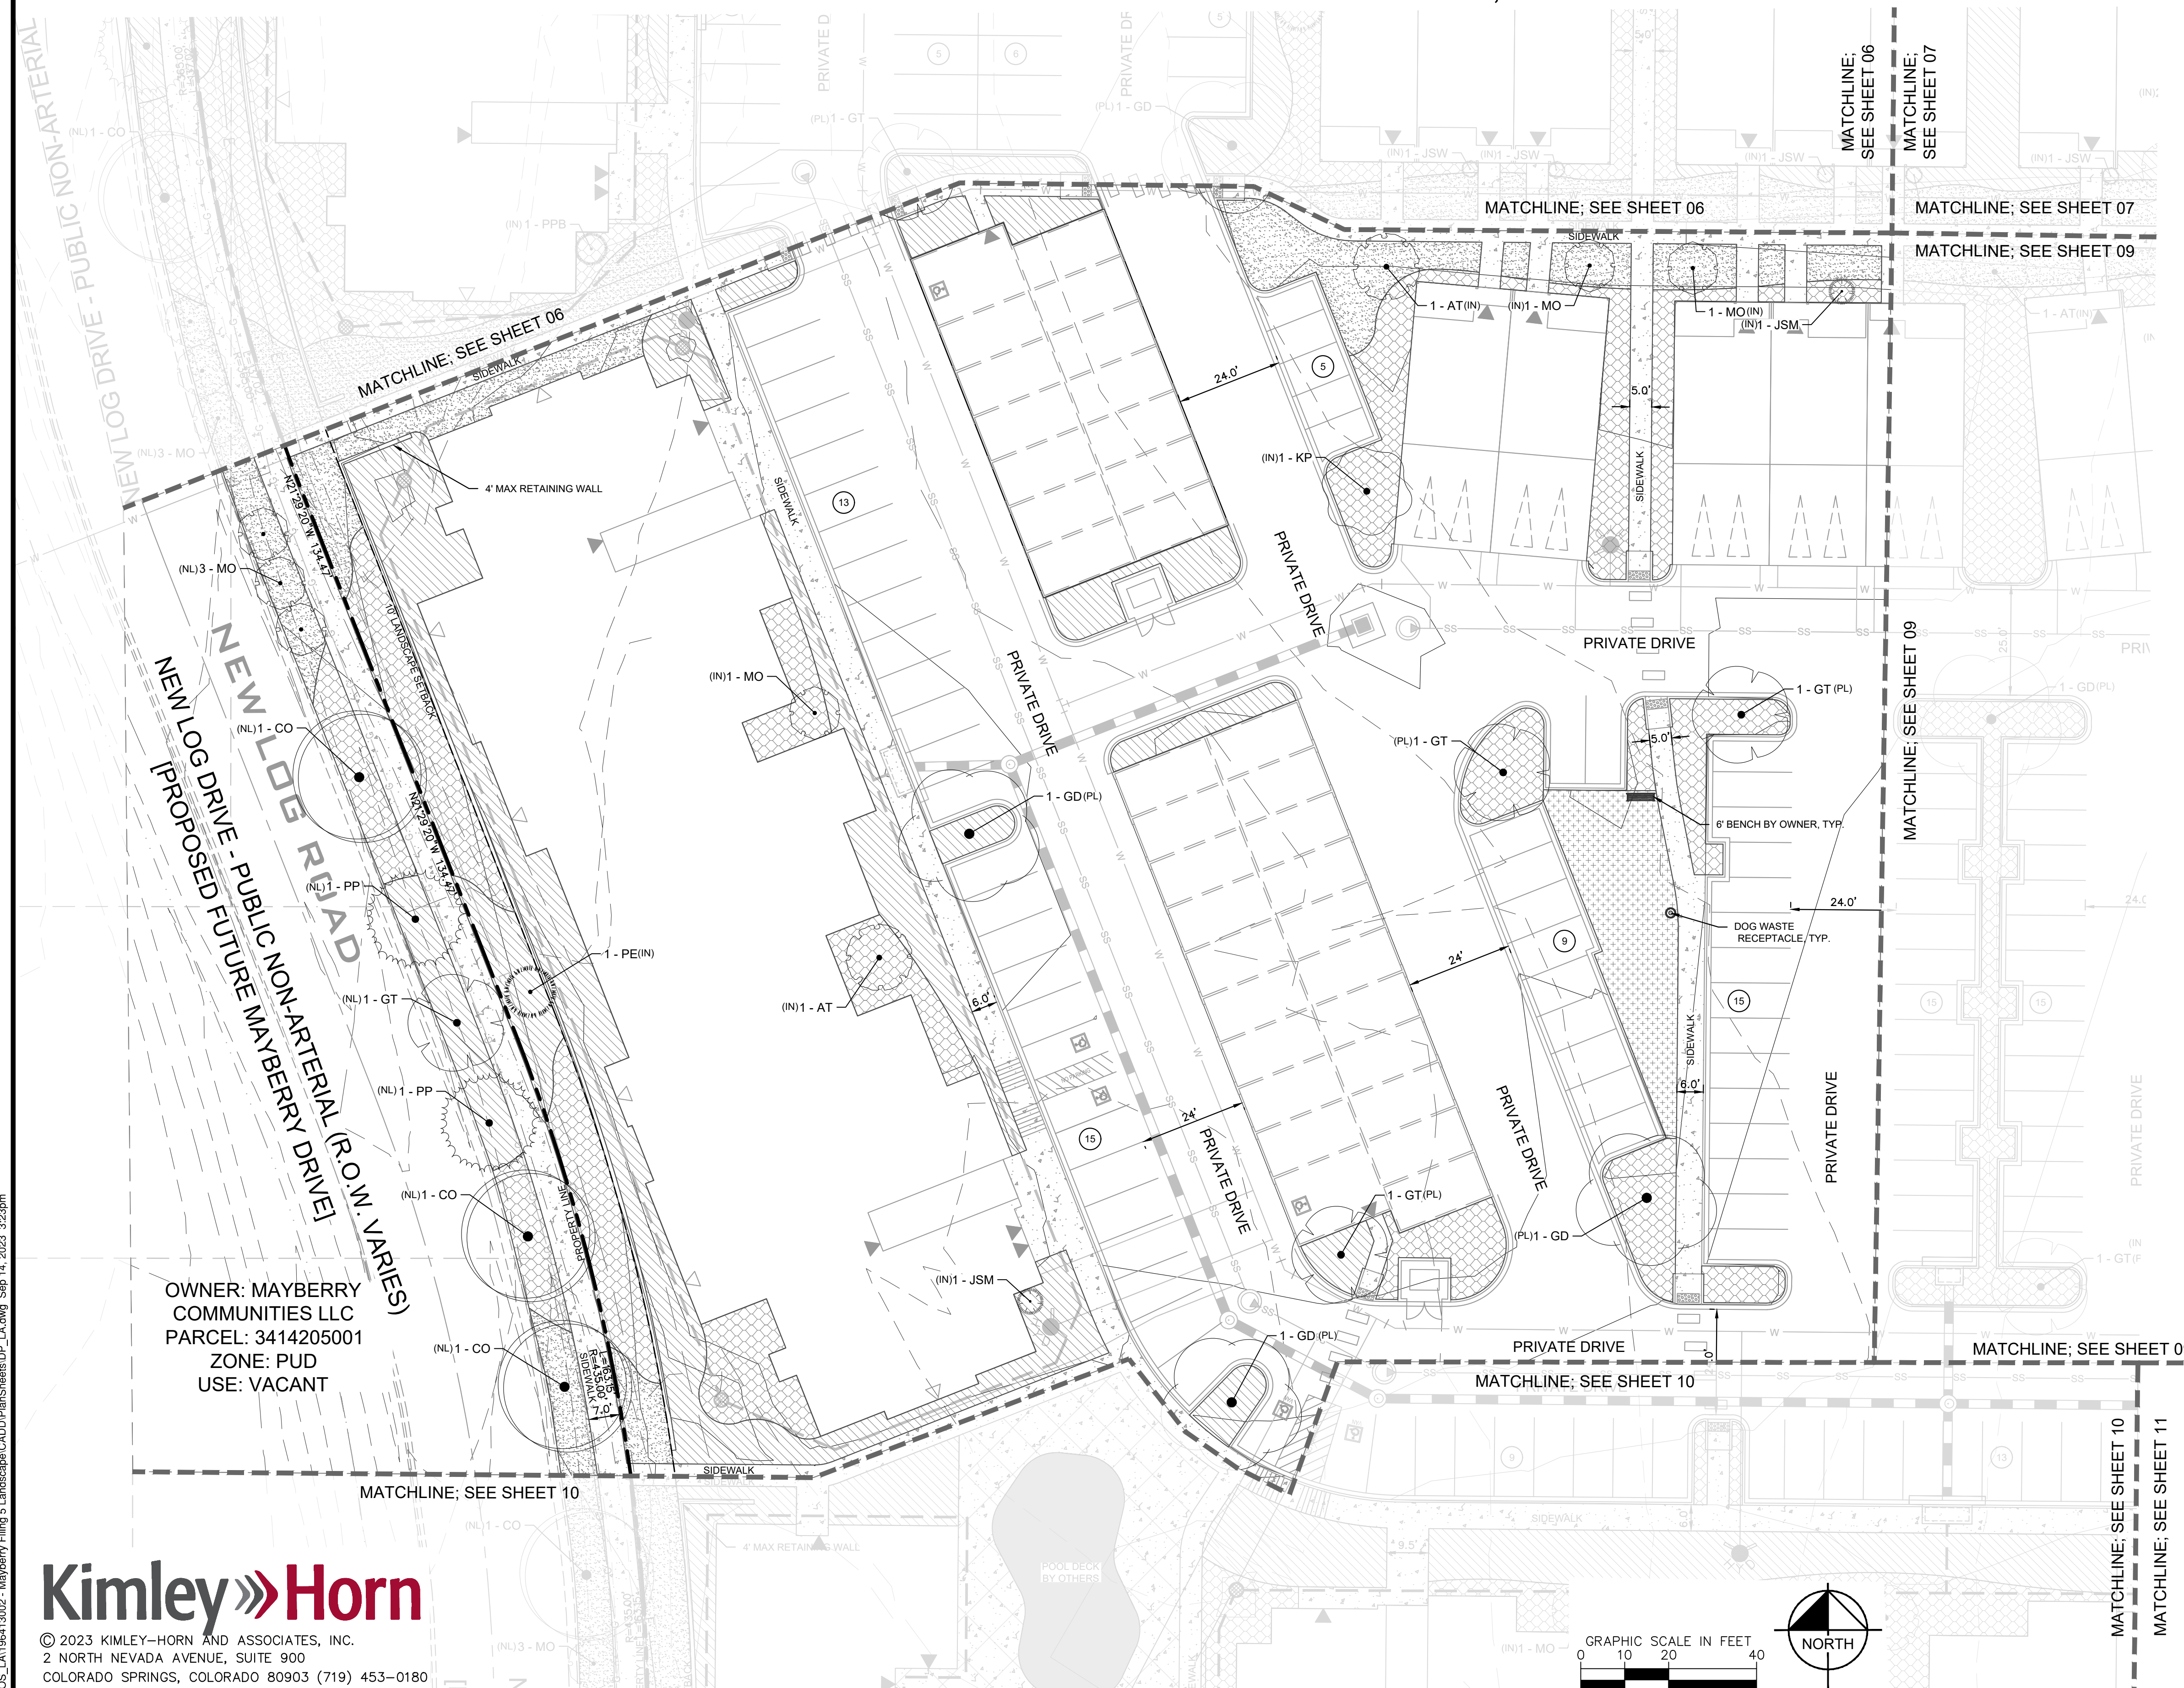

PLANT SCHEDULE


| DECIDUOUS TREES | CODE | QTY | BOTANICAL / COMMON NAME |
|-----------------|--------|-----------|---|
| | AT | 17 | ACER TATARICUM 'HOT WINGS' / HOT WINGS TATARIAN MAPLE |
| | CO | 17 | CELTIS OCCIDENTALIS 'CHICAGOLAND' / CHICAGOLAND WESTERN HACKBERRY |
| | CS | 6 | CATALPA SPECIOSA / NORTHERN CATALPA |
| | GD | 6 | GYMNOCLADUS DIOICA 'ESPRESSO' / KENTUCKY COFFEE TREE (SEEDLESS) |
| | GT | 13 | GLEDITSIA TRIACANTHOS INERMIS 'SUNBURST' / SUNBURST HONEY LOCUST |
| | KP | 8 | KOELREUTERIA PANICULATA / GOLDEN RAIN TREE |
| | MO | 41 | MALUS 'CORALBURST' / CORALBURST CRABAPPLE |
| | PA | 11 | PRUNUS CERASIFERA CRIMSON POINTE / COLUMNAR PURPLE PLUM |
| | QM | 7 | QUERCUS MACROCARPA / BURR OAK |
| EVERGREEN TREES | CODE | QTY | BOTANICAL / COMMON NAME |
| | JSM | 10 | JUNIPERUS SCOPULORUM 'MOONGLOW' / MOONGLOW JUNIPER LOW ROOT DAMAGE POTENTIAL |
| | JSW | 8 | JUNIPERUS SCOPULORUM 'WICHITA BLUE' / WICHITA BLUE JUNIPER |
| | PE | 8 | PINUS EDULIS / PINON PINE |
| | PN | 6 | PINUS NIGRA / AUSTRIAN BLACK PINE |
| | PP | 12 | PINUS PONDEROSA / PONDEROSA PINE |
| | PPB | 2 | PICEA PUNGENS 'BLUE DIAMOND' / BLUE DIAMOND DWARF SPRUCE |
| | PPF | 1 | PICEA PUNGENS 'FASTIGIATA' / FASTIGIATE BLUE SPRUCE |
| | PPG | 2 | PICEA PUNGENS 'GLAUCA' / COLORADO BLUE SPRUCE |
| GROUND COVERS | CODE | QTY | BOTANICAL / COMMON NAME |
| | BREEZE | 4,641 SF | BREEZE / CRUSHER FINES BREEZE COLOR TO VARY FROM TRAIL AND TO BE SELECTED BY OWNER/CONTRACTOR. |
| | ROCK-A | 43,013 SF | ROCK MULCH A / ROCK MULCH AND PLANTINGS ROCK MULCH TYPE TO BE DECIDED BY OWNER/CONTRACTOR. ROCK MULCH TO BE PLANTED WITH SHRUBS AND GRASSES. |
| | ROCK-B | 43,318 SF | ROCK MULCH B / ROCK MULCH AND PLANTINGS ROCK MULCH TYPE TO BE DECIDED BY OWNER/CONTRACTOR. ROCK MULCH TO BE PLANTED WITH SHRUBS AND GRASSES. |
| | SEED | 4,825 SF | EPC LOW GROW MIX INSTALL PER TABLE S-2. SUBMIT SUPPLIER CUT-SHEET FOR REVIEW AND APPROVAL PRIOR TO INSTALLATION. |
| | SEED2 | 20,170 SF | EPC ALL PURPOSE MIX INSTALL PER TABLE S-1. SUBMIT SUPPLIER CUT-SHEET FOR REVIEW AND APPROVAL PRIOR TO INSTALLATION. |
| | SOD | 18,175 SF | SURVIVALIST TALL FESCUE INSTALL PER DETAIL - 47% GRAND II TALL FESCUE, 47% SR8850 TALL FESCUE, 6% SP17FIRE TEXAS HYBRID |

NOTE: SEE SHEET L-109 FOR FULL PLANT LIST AND SPECIFICATIONS

EPC APPROVAL:

PRELIMINARY LANDSCAPE PLAN
SHEET 08 OF 15

Kimley»Horn
© 2023 KIMLEY-HORN AND ASSOCIATES, INC.
2 NORTH NEVADA AVENUE, SUITE 900
COLORADO SPRINGS, COLORADO 80903 (719) 453-0180

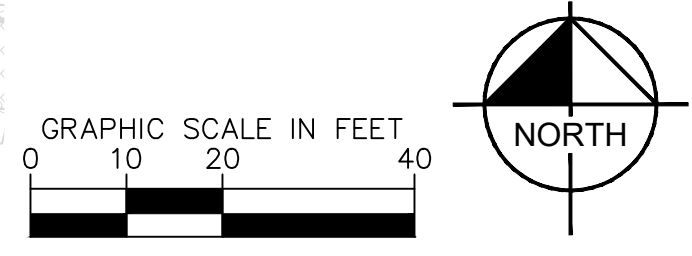


MAYBERRY FILING 5

LANDSCAPE PLAN

TRACT K OF MAYBERRY COLORADO SPRINGS FILING NO. 1

SITUATED IN THE NORTHWEST QUARTER OF SECTION 14, TOWNSHIP 14 SOUTH, RANGE 63 WEST OF THE 6TH P.M.
COUNTY OF EL PASO, STATE OF COLORADO

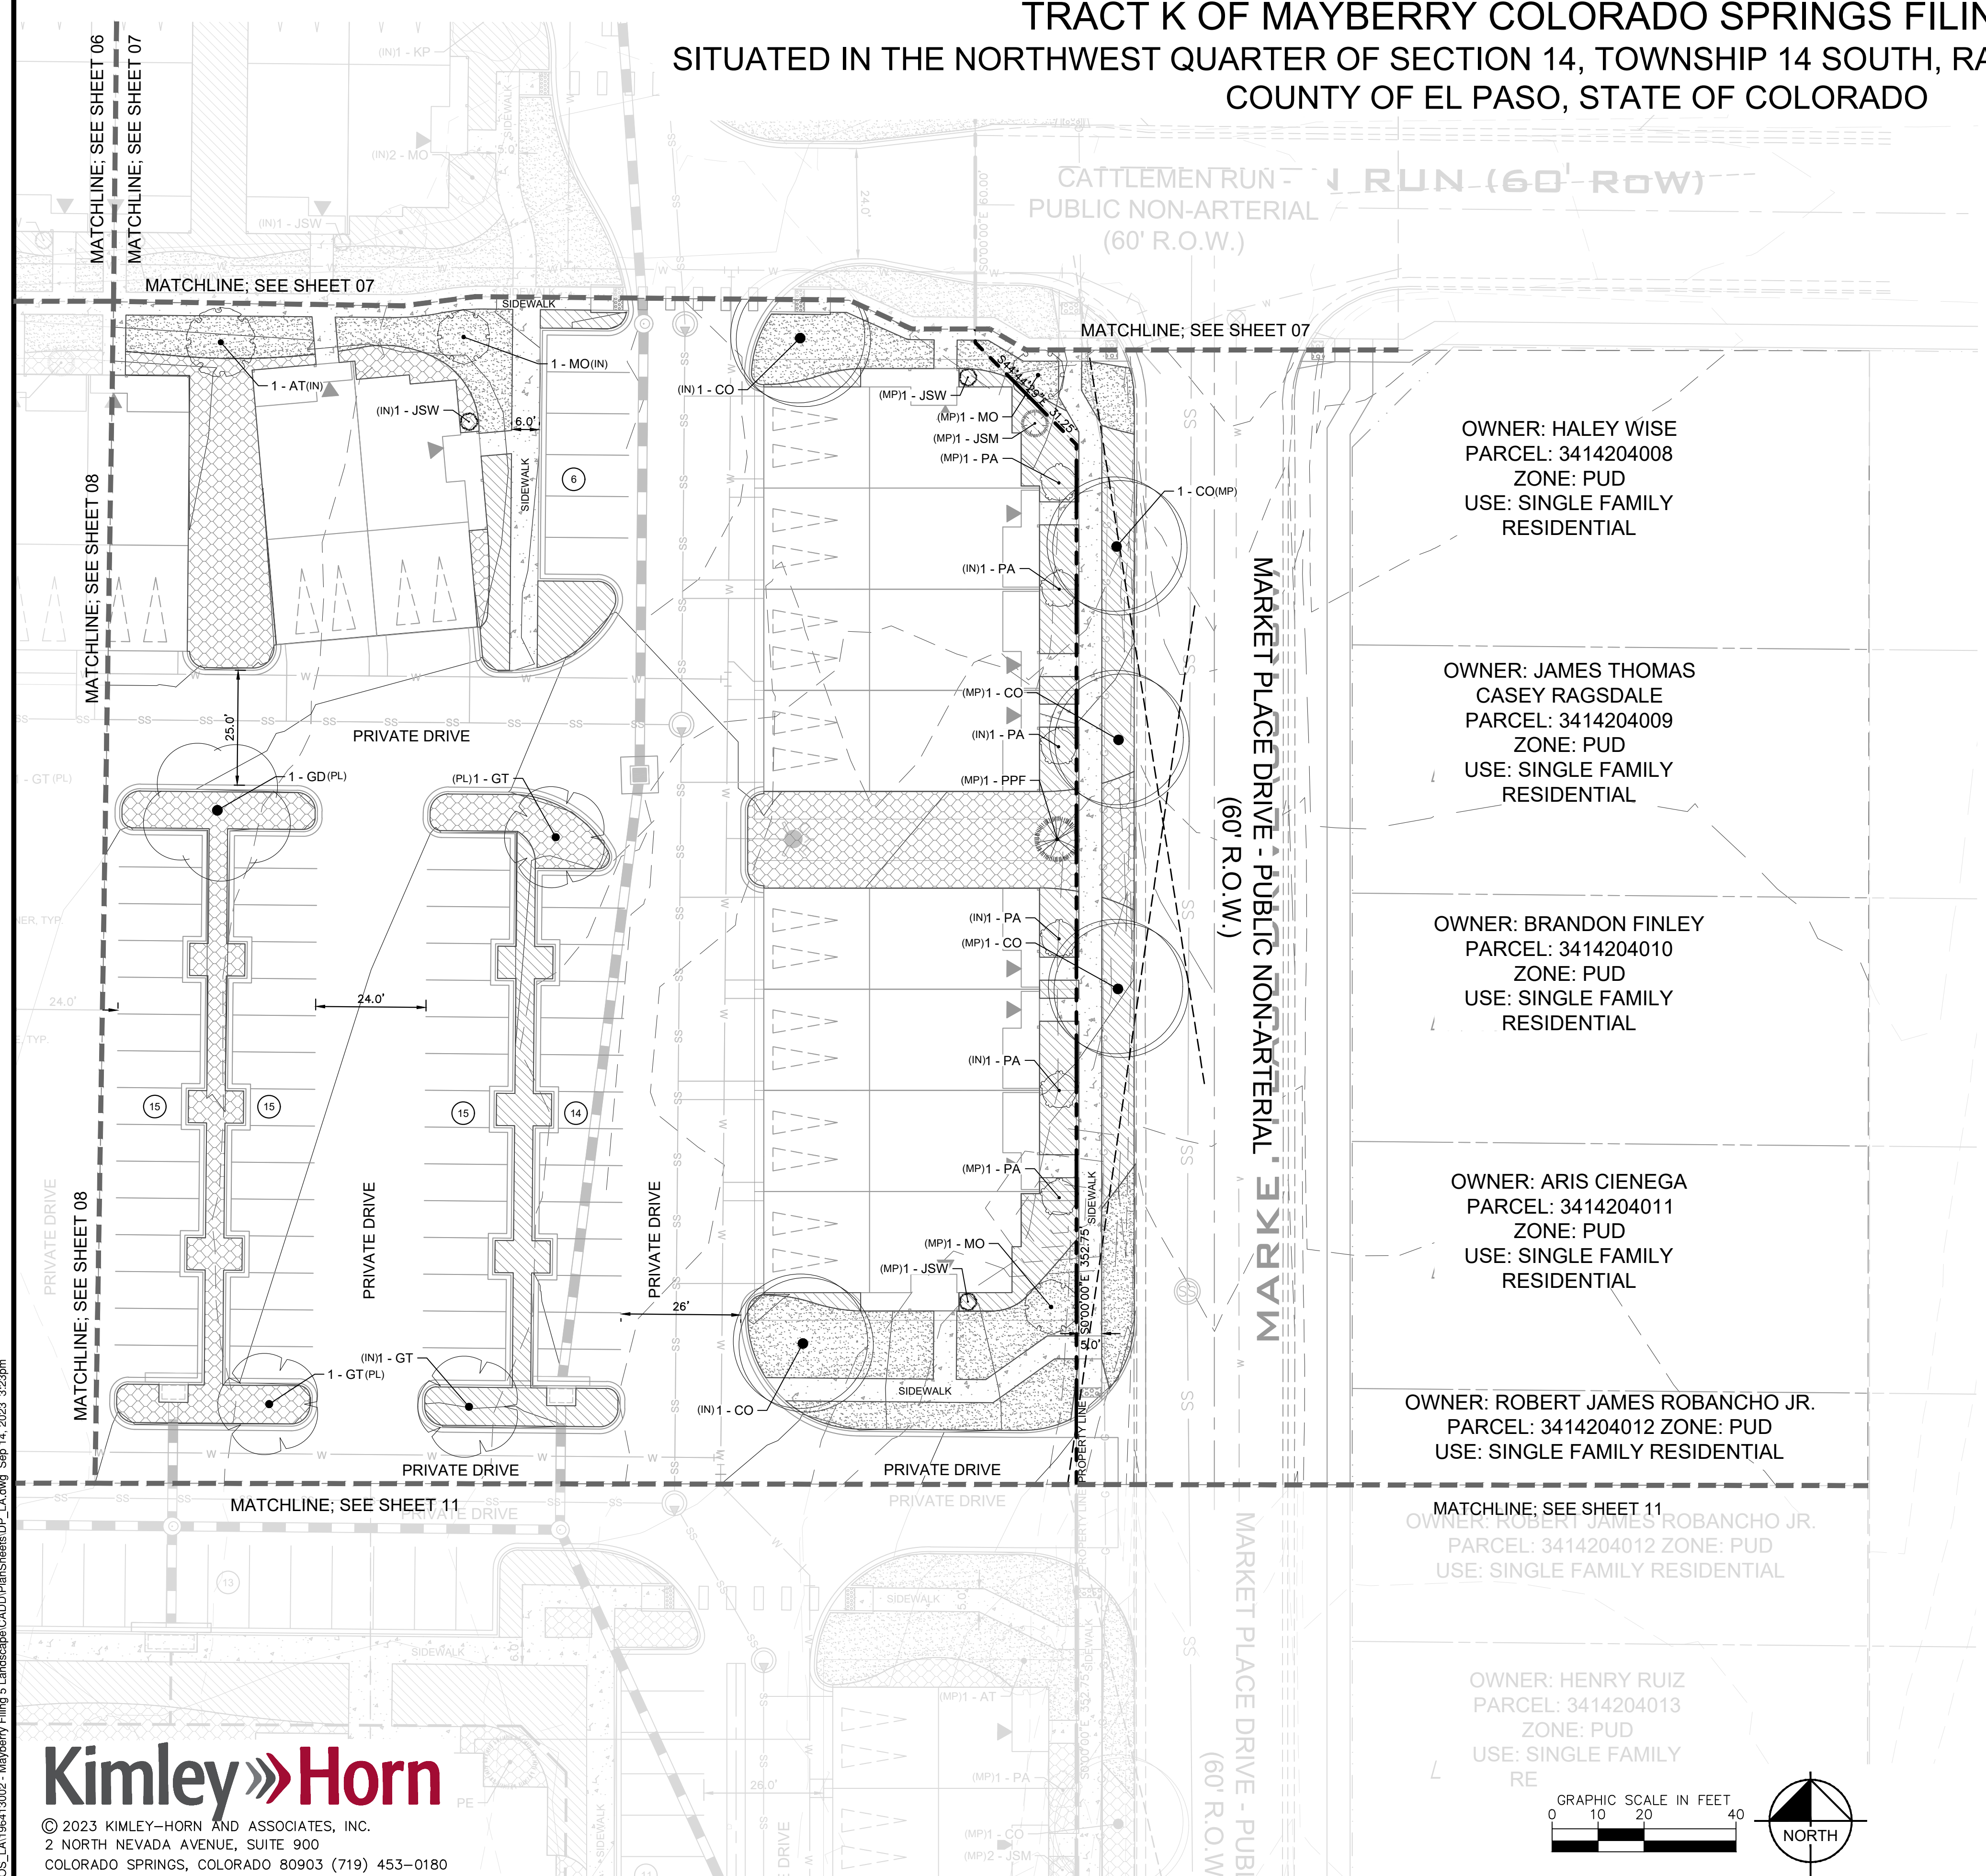

OWNER: HALEY WISE
 PARCEL: 3414204008
 ZONE: PUD
 USE: SINGLE FAMILY RESIDENTIAL

OWNER: JAMES THOMAS
 CASEY RAGSDALE
 PARCEL: 3414204009
 ZONE: PUD
 USE: SINGLE FAMILY RESIDENTIAL

OWNER: BRANDON FINLEY
 PARCEL: 3414204010
 ZONE: PUD
 USE: SINGLE FAMILY RESIDENTIAL

OWNER: ARIS CIENEGA
 PARCEL: 3414204011
 ZONE: PUD
 USE: SINGLE FAMILY RESIDENTIAL

OWNER: ROBERT JAMES ROBANCHO JR.
 PARCEL: 3414204012 ZONE: PUD
 USE: SINGLE FAMILY RESIDENTIAL

OWNER: ROBERT JAMES ROBANCHO JR.
 PARCEL: 3414204012 ZONE: PUD
 USE: SINGLE FAMILY RESIDENTIAL


OWNER: HENRY RUIZ
 PARCEL: 3414204013
 ZONE: PUD
 USE: SINGLE FAMILY RESIDENTIAL

PLANT SCHEDULE

| DECIDUOUS TREES | CODE | QTY | BOTANICAL / COMMON NAME |
|-----------------|--------|-----------|---|
| | AT | 17 | ACER TATARICUM 'HOT WINGS' / HOT WINGS TATARIAN MAPLE |
| | CO | 17 | CELTIS OCCIDENTALIS 'CHICAGOLAND' / CHICAGOLAND WESTERN HACKBERRY |
| | CS | 6 | CATALPA SPECIOSA / NORTHERN CATALPA |
| | GD | 6 | GYMNOCLADUS DIOICA 'ESPRESSO' / KENTUCKY COFFEE TREE (SEEDLESS) |
| | GT | 13 | GLEDITSIA TRIACANTHOS INERMIS 'SUNBURST' / SUNBURST HONEY LOCUST |
| | KP | 8 | KOELREUTERIA PANICULATA / GOLDEN RAIN TREE |
| | MO | 41 | MALUS 'CORALBURST' / CORALBURST CRABAPPLE |
| | PA | 11 | PRUNUS CERASIFERA CRIMSON POINTE / COLUMNAR PURPLE PLUM |
| | QM | 7 | QUERCUS MACROCARPA / BURR OAK |
| EVERGREEN TREES | CODE | QTY | BOTANICAL / COMMON NAME |
| | JSM | 10 | JUNIPERUS SCOPULORUM 'MOONGLOW' / MOONGLOW JUNIPER LOW ROOT DAMAGE POTENTIAL |
| | JSW | 8 | JUNIPERUS SCOPULORUM 'WICHITA BLUE' / WICHITA BLUE JUNIPER |
| | PE | 8 | PINUS EDULIS / PINON PINE |
| | PN | 6 | PINUS NIGRA / AUSTRIAN BLACK PINE |
| | PP | 12 | PINUS PONDEROSA / PONDEROSA PINE |
| | PPB | 2 | PICEA PUNGENS 'BLUE DIAMOND' / BLUE DIAMOND DWARF SPRUCE |
| | PPF | 1 | PICEA PUNGENS 'FASTIGIATA' / FASTIGIATE BLUE SPRUCE |
| | PPG | 2 | PICEA PUNGENS 'GLAUCA' / COLORADO BLUE SPRUCE |
| GROUND COVERS | CODE | QTY | BOTANICAL / COMMON NAME |
| | BREEZE | 4,641 SF | BREEZE / CRUSHER FINES BREEZE COLOR TO VARY FROM TRAIL AND TO BE SELECTED BY OWNER/CONTRACTOR. |
| | ROCK-A | 43,013 SF | ROCK MULCH A / ROCK MULCH AND PLANTINGS ROCK MULCH TYPE TO BE DECIDED BY OWNER/CONTRACTOR. ROCK MULCH TO BE PLANTED WITH SHRUBS AND GRASSES. |
| | ROCK-B | 43,318 SF | ROCK MULCH B / ROCK MULCH AND PLANTINGS ROCK MULCH TYPE TO BE DECIDED BY OWNER/CONTRACTOR. ROCK MULCH TO BE PLANTED WITH SHRUBS AND GRASSES. |
| | SEED | 4,825 SF | EPC LOW GROW MIX INSTALL PER TABLE 5-2. SUBMIT SUPPLIER CUT-SHEET FOR REVIEW AND APPROVAL PRIOR TO INSTALLATION. |
| | SEED2 | 20,170 SF | EPC ALL PURPOSE MIX INSTALL PER TABLE 5-1. SUBMIT SUPPLIER CUT-SHEET FOR REVIEW AND APPROVAL PRIOR TO INSTALLATION. |
| | SOD | 18,175 SF | SURVIVALIST TALL FESCUE INSTALL PER DETAIL - 47% GRAND II TALL FESCUE, 47% SR8650 TALL FESCUE, 6% SPITFIRE TEXAS HYBRID |

NOTE: SEE SHEET L-109 FOR FULL PLANT LIST AND SPECIFICATIONS

EPC APPROVAL:

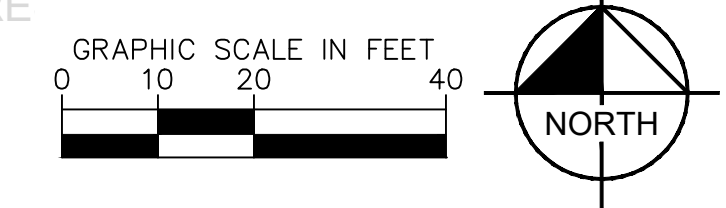

Kimley»Horn
 © 2023 KIMLEY-HORN AND ASSOCIATES, INC.
 2 NORTH NEVADA AVENUE, SUITE 900
 COLORADO SPRINGS, COLORADO 80903 (719) 453-0180


PRELIMINARY LANDSCAPE PLAN
 SHEET 09 OF 15

MAYBERRY FILING 5

LANDSCAPE PLAN

TRACT K OF MAYBERRY COLORADO SPRINGS FILING NO. 1

SITUATED IN THE NORTHWEST QUARTER OF SECTION 14, TOWNSHIP 14 SOUTH, RANGE 63 WEST OF THE 6TH P.M.
COUNTY OF EL PASO, STATE OF COLORADO

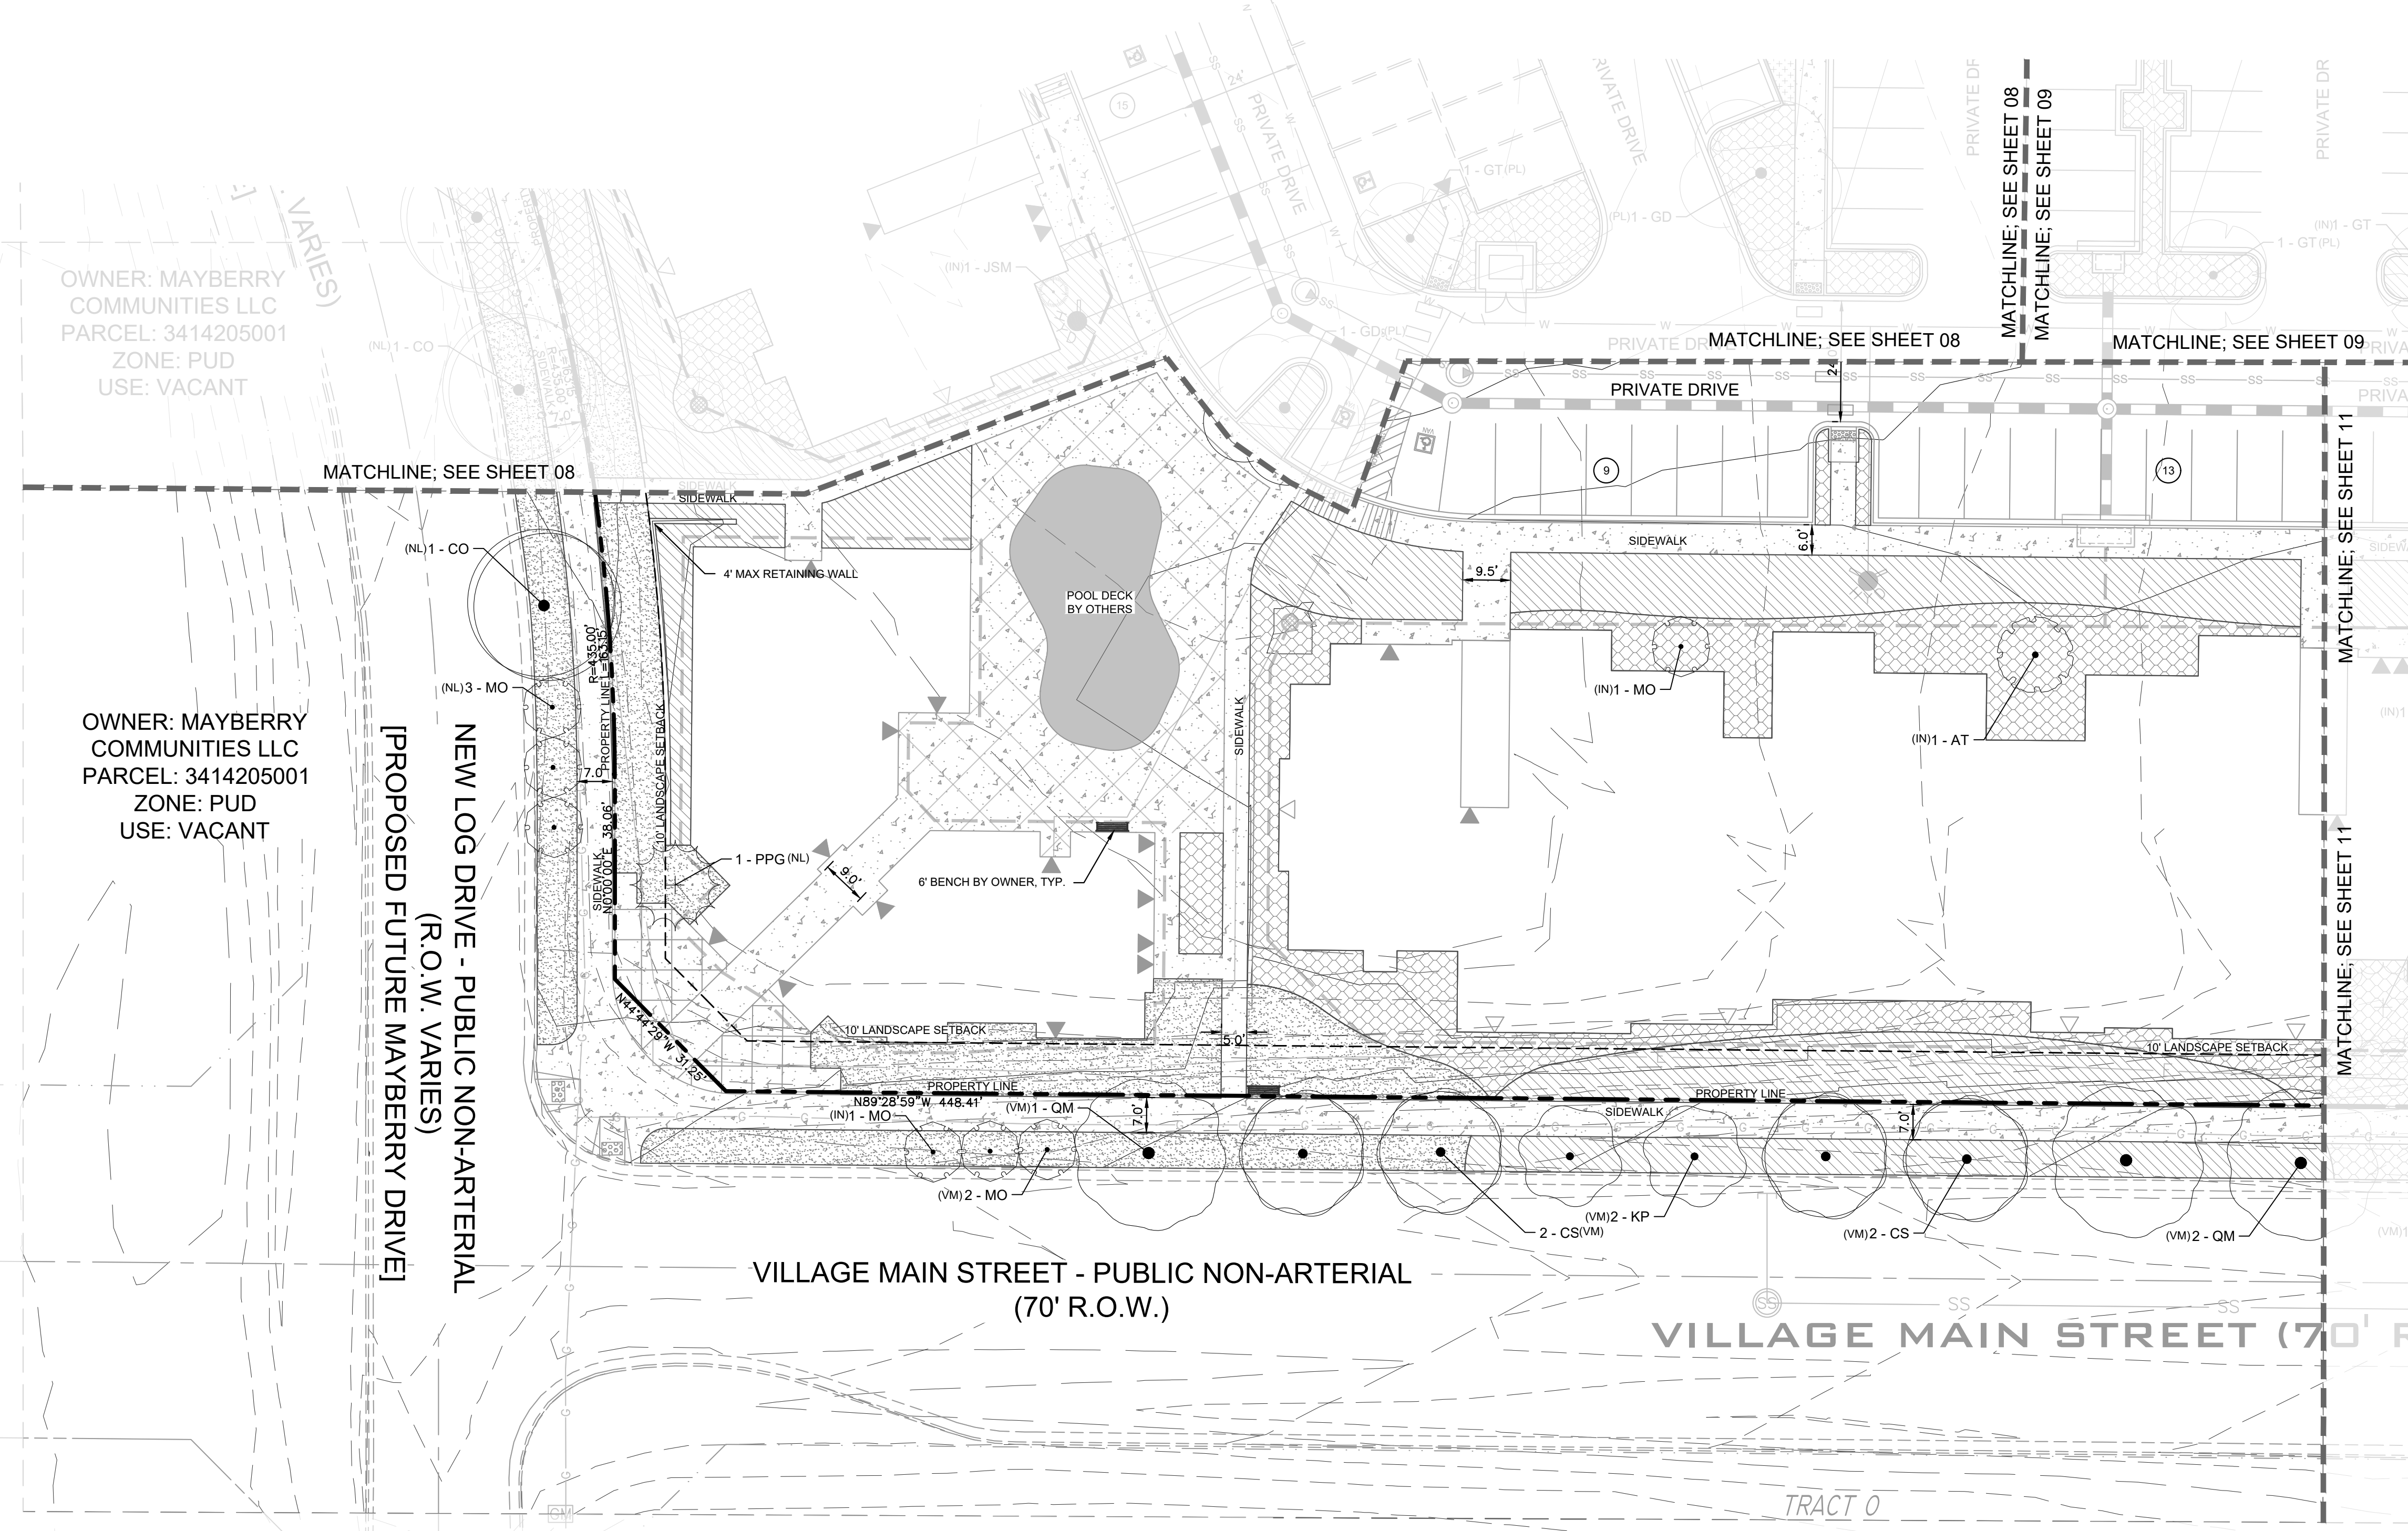

OWNER: MAYBERRY COMMUNITIES LLC
PARCEL: 3414205001
ZONE: PUD
USE: VACANT

OWNER: MAYBERRY COMMUNITIES LLC
PARCEL: 3414205001
ZONE: PUD
USE: VACANT


OWNER: MAYBERRY COMMUNITIES LLC
PARCEL: 3414206001
ZONE: PUD
USE: VACANT

PLANT SCHEDULE

| DECIDUOUS TREES | | | |
|-----------------|-----------|---|--|
| CODE | QTY | BOTANICAL / COMMON NAME | |
| AT | 17 | ACER TATARICUM 'HOT WINGS' / HOT WINGS TATARIAN MAPLE | |
| CO | 17 | CELTIS OCCIDENTALIS 'CHICAGOLAND' / CHICAGOLAND WESTERN HACKBERRY | |
| CS | 6 | CATALPA SPECIOSA / NORTHERN CATALPA | |
| GD | 6 | GYMNOCLADUS DIOICA 'ESPRESSO' / KENTUCKY COFFEE TREE (SEEDLESS) | |
| GT | 13 | GLEDTISIA TRIACANTHOS INERMIS 'SUNBURST' / SUNBURST HONEY LOCUST | |
| KP | 8 | KOELREUTERIA PANICULATA / GOLDEN RAIN TREE | |
| MO | 41 | MALUS 'CORALBURST' / CORALBURST CRABAPPLE | |
| PA | 11 | PRUNUS CERASIFERA CRIMSON POINTE / COLUMNAR PURPLE PLUM | |
| QM | 7 | QUERCUS MACROCARPA / BURR OAK | |
| EVERGREEN TREES | | | |
| CODE | QTY | BOTANICAL / COMMON NAME | |
| JSM | 10 | JUNIPERUS SCOPULORUM 'MOONGLOW' / MOONGLOW JUNIPER LOW ROOT DAMAGE POTENTIAL | |
| JSW | 8 | JUNIPERUS SCOPULORUM 'WICHITA BLUE' / WICHITA BLUE JUNIPER | |
| PE | 8 | PINUS EDULIS / PINON PINE | |
| PN | 6 | PINUS NIGRA / AUSTRIAN BLACK PINE | |
| PP | 12 | PINUS PONDEROSA / PONDEROSA PINE | |
| PPB | 2 | PICEA PUNGENS 'BLUE DIAMOND' / BLUE DIAMOND DWARF SPRUCE | |
| PPF | 1 | PICEA PUNGENS 'FASTIGIATA' / FASTIGIATE BLUE SPRUCE | |
| PPG | 2 | PICEA PUNGENS 'GLAUCA' / COLORADO BLUE SPRUCE | |
| GROUND COVERS | | | |
| CODE | QTY | BOTANICAL / COMMON NAME | |
| BREEZE | 4,641 SF | BREEZE / CRUSHER PINES BREEZE COLOR TO VARY FROM TRAIL AND TO BE SELECTED BY OWNER/CONTRACTOR. | |
| ROCK-A | 43,013 SF | ROCK MULCH A / ROCK MULCH AND PLANTINGS ROCK MULCH TYPE TO BE DECIDED BY OWNER/CONTRACTOR. ROCK MULCH TO BE PLANTED WITH SHRUBS AND GRASSES. | |
| ROCK-B | 43,318 SF | ROCK MULCH B / ROCK MULCH AND PLANTINGS ROCK MULCH TYPE TO BE DECIDED BY OWNER/CONTRACTOR. ROCK MULCH TO BE PLANTED WITH SHRUBS AND GRASSES. | |
| SEED | 4,825 SF | EPC LOW GROW MIX INSTALL PER TABLE 5-2. SUBMIT SUPPLIER CUT-SHEET FOR REVIEW AND APPROVAL PRIOR TO INSTALLATION. | |
| SEED2 | 20,170 SF | EPC ALL PURPOSE MIX INSTALL PER TABLE 5-1. SUBMIT SUPPLIER CUT-SHEET FOR REVIEW AND APPROVAL PRIOR TO INSTALLATION. | |
| SOD | 18,175 SF | SURVIVALIST TALL FESCUE INSTALL PER DETAIL - 47% GRAND II TALL FESCUE, 47% SR8650 TALL FESCUE, 6% SPITFIRE TEXAS HYBRID | |

NOTE: SEE SHEET L-109 FOR FULL PLANT LIST AND SPECIFICATIONS

 
EPC APPROVAL:



PRELIMINARY LANDSCAPE PLAN
SHEET 10 OF 15



© 2023 KIMLEY-HORN AND ASSOCIATES, INC.
2 NORTH NEVADA AVENUE, SUITE 900
COLORADO SPRINGS, COLORADO 80903 (719) 453-0180

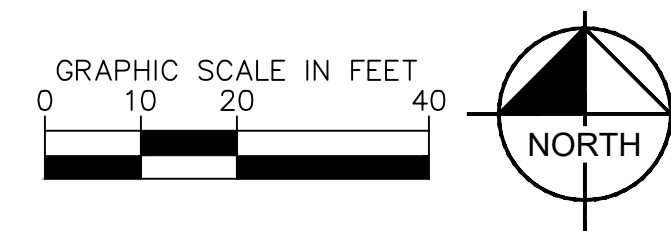


K:\COOS_LAI196413002 - Mayberry Filing 5 Landscape\CADD\PlanSheets\DF_LA.dwg Sep 14, 2023 3:23pm

MAYBERRY FILING 5

LANDSCAPE PLAN

TRACT K OF MAYBERRY COLORADO SPRINGS FILING NO. 1

SITUATED IN THE NORTHWEST QUARTER OF SECTION 14, TOWNSHIP 14 SOUTH, RANGE 63 WEST OF THE 6TH P.M.
COUNTY OF EL PASO, STATE OF COLORADO

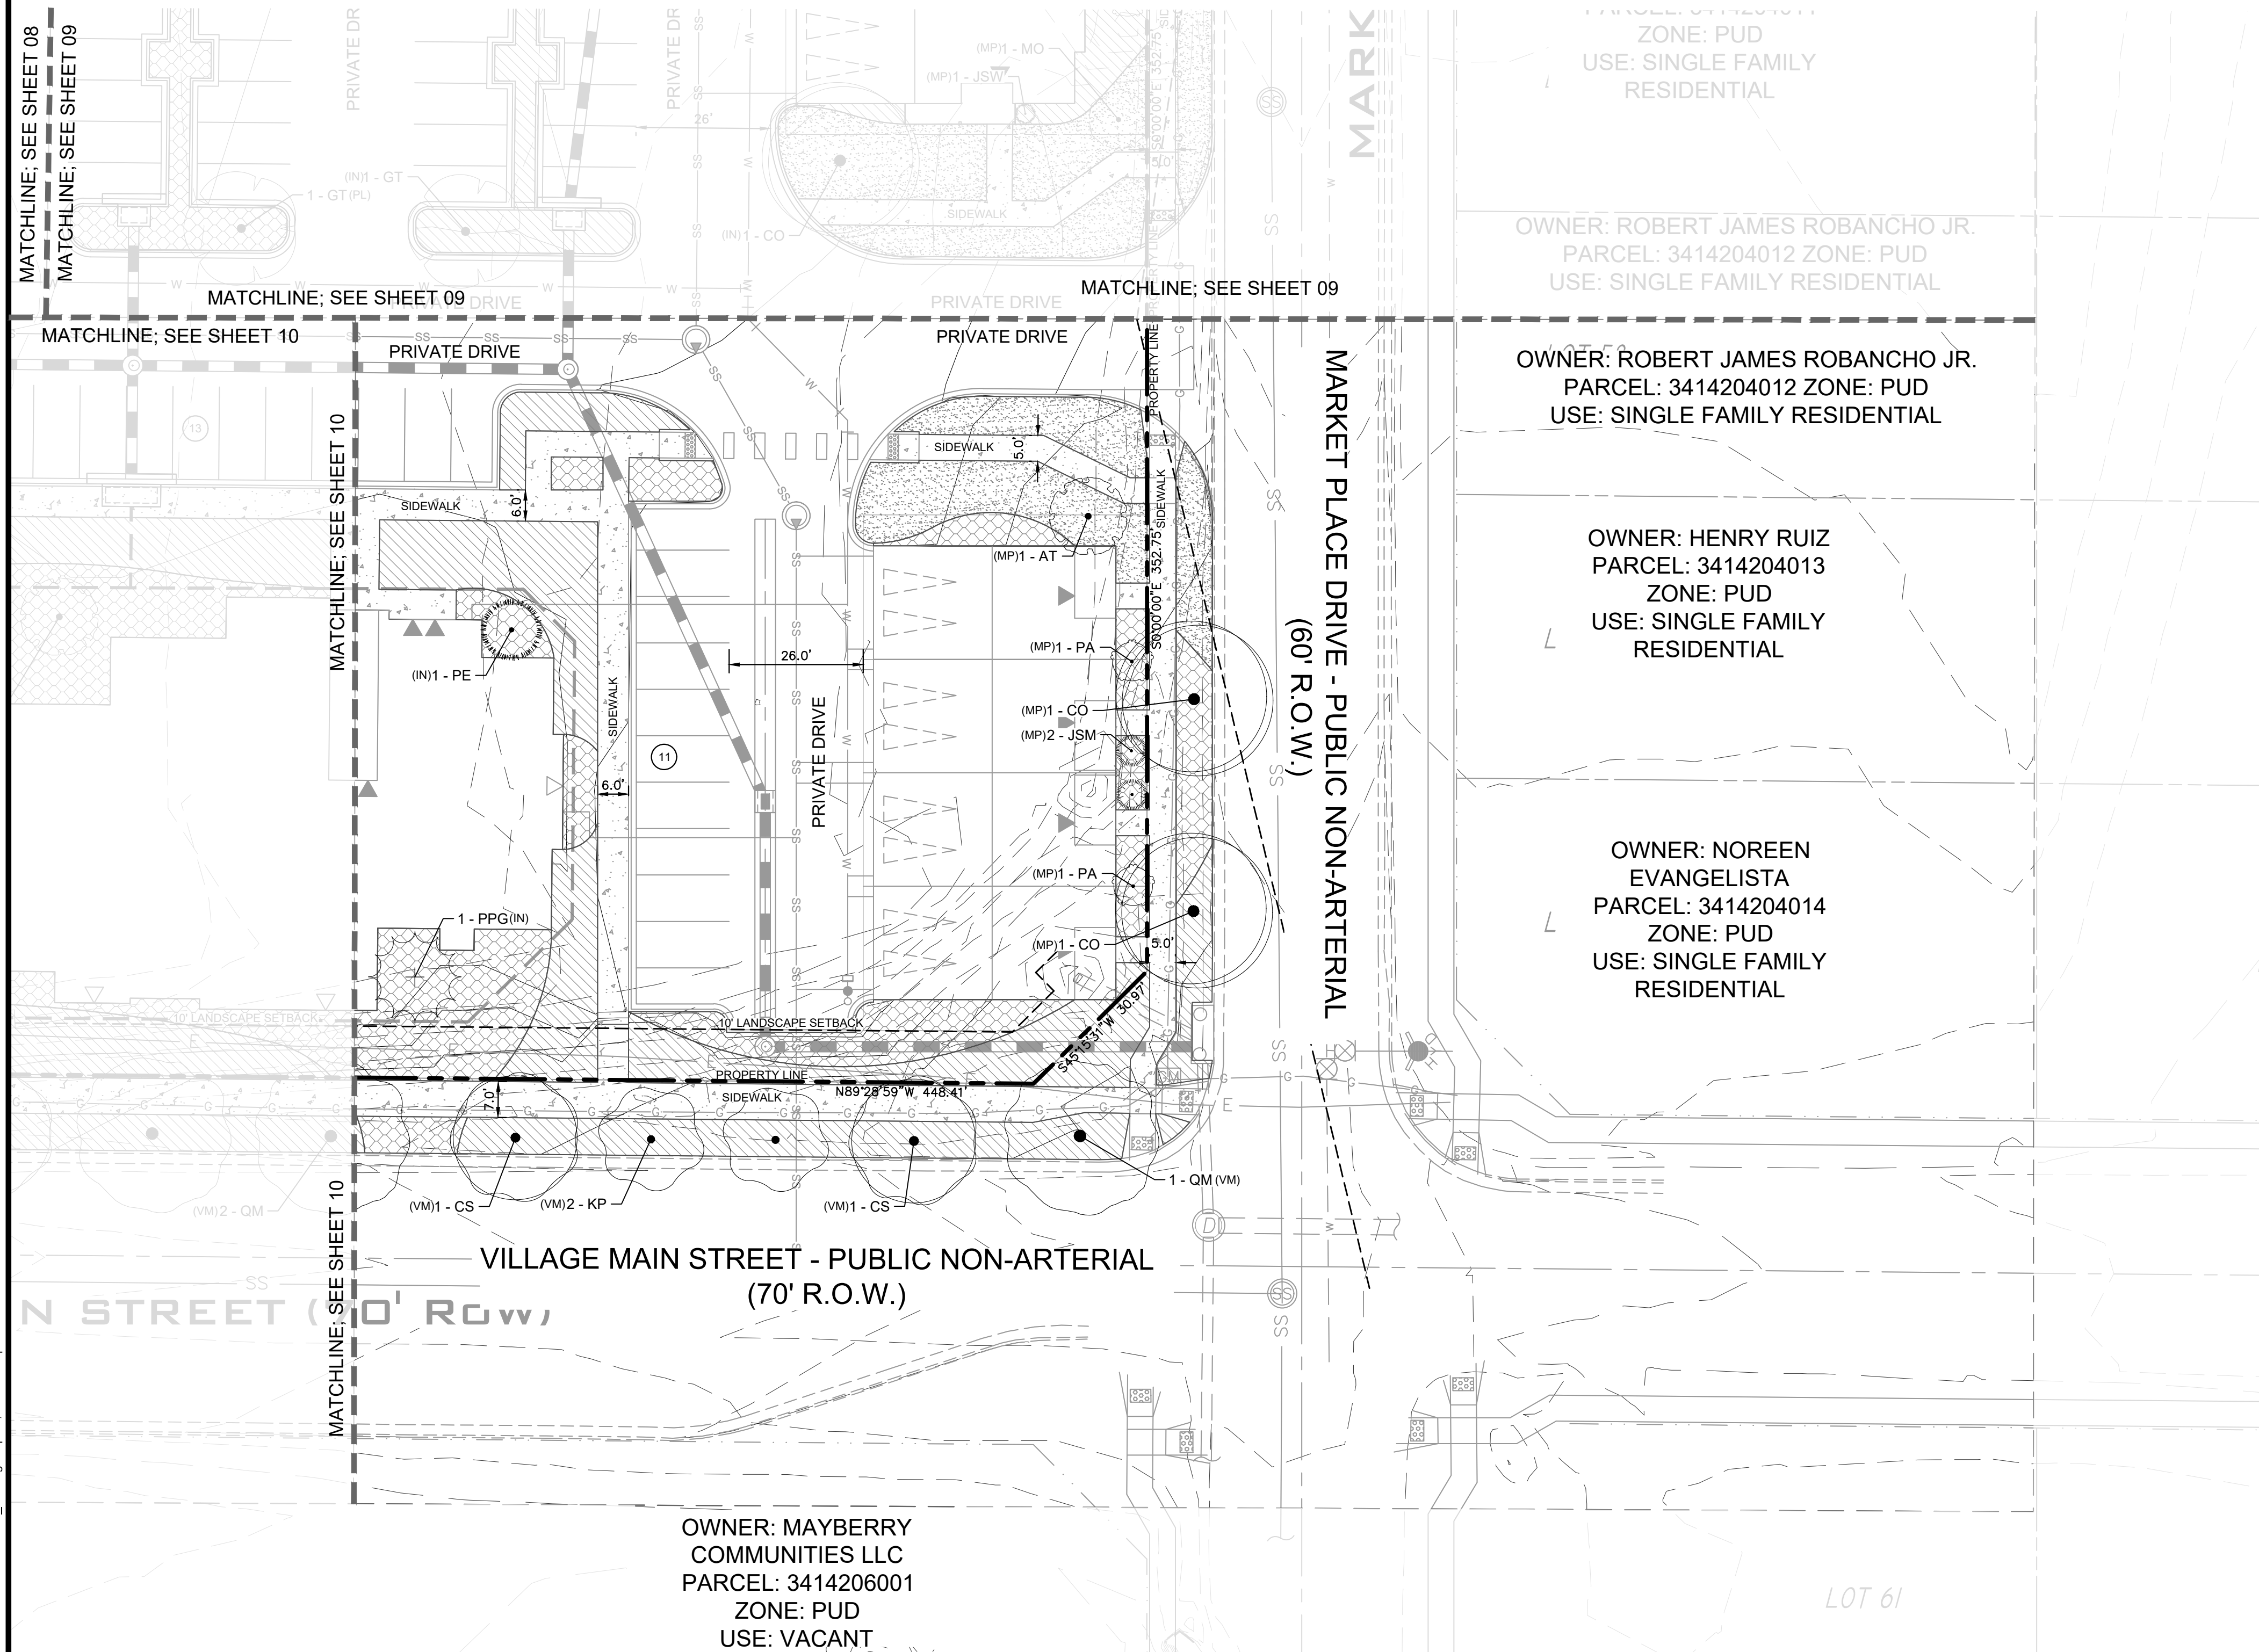


PLANT SCHEDULE


| DECIDUOUS TREES | CODE | QTY | BOTANICAL / COMMON NAME |
|-----------------|--------|-----------|---|
| | AT | 17 | ACER TATARICUM 'HOT WINGS' / HOT WINGS TATARIAN MAPLE |
| | CO | 17 | CELTIS OCCIDENTALIS 'CHICAGOLAND' / CHICAGOLAND WESTERN HACKBERRY |
| | CS | 6 | CATALPA SPECIOSA / NORTHERN CATALPA |
| | GD | 6 | GYMNOCLADUS DIOICA 'ESPRESSO' / KENTUCKY COFFEE TREE (SEEDLESS) |
| | GT | 13 | GLEDITSIA TRIACANTHOS INERMIS 'SUNBURST' / SUNBURST HONEY LOCUST |
| | KP | 8 | KOELREUTERIA PANICULATA / GOLDEN RAIN TREE |
| | MO | 41 | MALUS 'CORALBURST' / CORALBURST CRABAPPLE |
| | PA | 11 | PRUNUS CERASIFERA CRIMSON POINTE / COLUMNAR PURPLE PLUM |
| | QM | 7 | QUERCUS MACROCARPA / BURR OAK |
| EVERGREEN TREES | CODE | QTY | BOTANICAL / COMMON NAME |
| | JSM | 10 | JUNIPERUS SCOPULORUM 'MOONGLOW' / MOONGLOW JUNIPER LOW ROOT DAMAGE POTENTIAL |
| | JSW | 8 | JUNIPERUS SCOPULORUM 'WICHITA BLUE' / WICHITA BLUE JUNIPER |
| | PE | 8 | PINUS EDULIS / PINON PINE |
| | PN | 6 | PINUS NIGRA / AUSTRIAN BLACK PINE |
| | PP | 12 | PINUS PONDEROSA / PONDEROSA PINE |
| | PPB | 2 | PICEA PUNGENS 'BLUE DIAMOND' / BLUE DIAMOND DWARF SPRUCE |
| | PPF | 1 | PICEA PUNGENS 'FASTIGIATA' / FASTIGIATE BLUE SPRUCE |
| | PPG | 2 | PICEA PUNGENS 'GLAUCA' / COLORADO BLUE SPRUCE |
| GROUND COVERS | CODE | QTY | BOTANICAL / COMMON NAME |
| | BREEZE | 4,641 SF | BREEZE / CRUSHER PINES BREEZE COLOR TO VARY FROM TRAIL AND TO BE SELECTED BY OWNER/CONTRACTOR. |
| | ROCK-A | 43,013 SF | ROCK MULCH A / ROCK MULCH AND PLANTINGS ROCK MULCH TYPE TO BE DECIDED BY OWNER/CONTRACTOR. ROCK MULCH TO BE PLANTED WITH SHRUBS AND GRASSES. |
| | ROCK-B | 43,318 SF | ROCK MULCH B / ROCK MULCH AND PLANTINGS ROCK MULCH TYPE TO BE DECIDED BY OWNER/CONTRACTOR. ROCK MULCH TO BE PLANTED WITH SHRUBS AND GRASSES. |
| | SEED | 4,825 SF | EPC LOW GROW MIX INSTALL PER TABLE 5-2. SUBMIT SUPPLIER CUT-SHEET FOR REVIEW AND APPROVAL PRIOR TO INSTALLATION. |
| | SEED2 | 20,170 SF | EPC ALL PURPOSE MIX INSTALL PER TABLE 5-1. SUBMIT SUPPLIER CUT-SHEET FOR REVIEW AND APPROVAL PRIOR TO INSTALLATION. |
| | SOD | 18,175 SF | SURVIVALIST TALL FESCUE INSTALL PER DETAIL - 47% GRAND II TALL FESCUE, 47% SR8650 TALL FESCUE, 6% SPITFIRE TEXAS HYBRID |

NOTE: SEE SHEET L-109 FOR FULL PLANT LIST AND SPECIFICATIONS

 EPC APPROVAL:



© 2023 KIMLEY-HORN AND ASSOCIATES, INC.
2 NORTH NEVADA AVENUE, SUITE 900
COLORADO SPRINGS, COLORADO 80903 (719) 453-0180

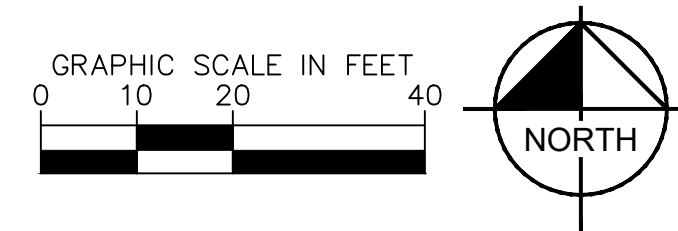

PRELIMINARY LANDSCAPE PLAN
SHEET 11 OF 15

K:\COCS_LAI196413002 - Mayberry Filing 5 Landscape\CADD\PlantSchedule\DP_LA.dwg Sep 14, 2023 3:23pm

MAYBERRY FILING 5

LANDSCAPE PLAN

TRACT K OF MAYBERRY COLORADO SPRINGS FILING NO. 1

SITUATED IN THE NORTHWEST QUARTER OF SECTION 14, TOWNSHIP 14 SOUTH, RANGE 63 WEST OF THE 6TH P.M.

COUNTY OF EL PASO, STATE OF COLORADO

GENERAL LANDSCAPE SPECIFICATIONS


- A. SCOPE OF WORK**
1. THE WORK CONSISTS OF: FURNISHING ALL LABOR, MATERIALS, EQUIPMENT, TOOLS, TRANSPORTATION, AND ANY OTHER APPURTENANCES NECESSARY FOR THE COMPLETION OF THIS PROJECT AS SHOWN ON THE DRAWINGS AND AS SPECIFIED HEREIN.
 2. WORK SHALL INCLUDE MAINTENANCE AND WATERING OF ALL CONTRACT PLANTING AREAS UNTIL CERTIFICATION OF ACCEPTANCE BY THE OWNER.
- B. PROTECTION OF EXISTING STRUCTURES**
1. ALL EXISTING BUILDINGS, WALKS, WALLS, PAVING, PIPING, OTHER SITE CONSTRUCTION ITEMS, AND PLANTING ALREADY COMPLETED OR ESTABLISHED AND DESIGNATED TO REMAIN SHALL BE PROTECTED FROM DAMAGE BY THE CONTRACTOR UNLESS OTHERWISE SPECIFIED. ALL DAMAGE RESULTING FROM NEGLIGENCE SHALL BE REPAIRED OR REPLACED TO THE SATISFACTION OF THE OWNER, AT NO COST TO THE OWNER.
 2. THE CONTRACTOR SHALL BE RESPONSIBLE FOR MAINTAINING ALL NECESSARY BEST MANAGEMENT PRACTICES (BMP) DEVICES ACCORDING TO ALL REGULATORY AGENCY'S STANDARDS THROUGHOUT THE DURATION OF ALL CONSTRUCTION ACTIVITIES.
 3. THE CONTRACTOR SHALL BE RESPONSIBLE FOR ANY MAINTENANCE OF TRAFFIC (MOT) THAT MAY BE REQUIRED FOR THE PROJECT.
 4. THE CONTRACTOR SHALL BE RESPONSIBLE FOR LOCATING ALL UTILITIES, WHETHER PUBLIC OR PRIVATE, PRIOR TO EXCAVATION. THE OWNER AND DESIGN PROFESSIONAL SHALL NOT BE RESPONSIBLE FOR THE ACCURACY AND COMPLETENESS OF ANY SUCH INFORMATION OR DATA. THE CONTRACTOR SHALL HAVE FULL RESPONSIBILITY FOR: REVIEWING AND CHECKING ALL SUCH INFORMATION AND DATA; LOCATING ALL UNDERGROUND FACILITIES DURING CONSTRUCTION; THE SAFETY AND PROTECTION THEREOF; REPAIRING ANY DAMAGE THERETO RESULTING FROM THE WORK. THE COST OF ALL WILL BE CONSIDERED HAVING BEEN INCLUDED IN THE CONTRACT PRICE. THE CONTRACTOR SHALL NOTIFY ANY AFFECTED UTILITY COMPANIES OR AGENCIES IN WRITING AT LEAST 48 HOURS PRIOR TO BEGINNING CONSTRUCTION.
- C. PROTECTION OF EXISTING PLANT MATERIALS**
1. THE CONTRACTOR SHALL BE RESPONSIBLE FOR ALL UNAUTHORIZED CUTTING OR DAMAGE TO TREES AND SHRUBS EXISTING OR OTHERWISE CAUSED BY CARELESS EQUIPMENT OPERATION, MATERIAL STOCKPILING, ETC.. THIS SHALL INCLUDE COMPACTION BY DRIVING OR PARKING INSIDE THE DRIP-LINE AND SPILLING OIL, GASOLINE, OR OTHER DELETERIOUS MATERIALS WITHIN THE DRIP-LINE. NO MATERIALS SHALL BE BURNED ON SITE. EXISTING TREES KILLED OR DAMAGED SO THAT THEY ARE MISSHAPE AND/OR UNSIGHTLY SHALL BE REPLACED AT THE COST TO THE CONTRACTOR OF FOUR HUNDRED DOLLARS (\$400) PER CALIPER INCH ON AN ESCALATING SCALE WHICH ADDS AN ADDITIONAL TWENTY (20) PERCENT PER INCH OVER FOUR (4) INCHES CALIPER AS FIXED AND AGREED LIQUIDATED DAMAGES. CALIPER SHALL BE MEASURED SIX (6) INCHES ABOVE GROUND LEVEL FOR TREES UP TO AND INCLUDING FOUR (4) INCHES IN CALIPER AND TWELVE (12) INCHES ABOVE GROUND LEVEL FOR TREES OVER FOUR (4) INCHES IN CALIPER.
 2. SEE TREE MITIGATION PLAN AND NOTES, IF APPLICABLE.
- D. MATERIALS**
1. GENERAL
MATERIAL SAMPLES LISTED BELOW SHALL BE SUBMITTED FOR APPROVAL, ON SITE OR AS DETERMINED BY THE OWNER UPON APPROVAL. DELIVERY OF MATERIALS MAY COMMENCE.

| MATERIAL | SAMPLE SIZE |
|-------------|--|
| MULCH | ONE (1) CUBIC FOOT |
| TOPSOIL MIX | ONE (1) CUBIC FOOT |
| PLANTS | ONE (1) OF EACH VARIETY (OR TAGGED IN NURSERY) |
 2. PLANT MATERIALS
 - a. FURNISH NURSERY-GROWN PLANTS TRUE TO GENUS, SPECIES, VARIETY, CULTIVAR, STEM FORM, SHEARING, AND OTHER FEATURES INDICATED IN PLANT SCHEDULE SHOWN ON DRAWINGS AND COMPLYING WITH ANSI Z60.1 AND THE COLORADO NURSERY ACT, AND WITH HEALTHY ROOT SYSTEMS DEVELOPED BY TRANSPLANTING OR ROOT PRUNING. PROVIDE WELL-SHAPED, FULLY BRANCHED, HEALTHY, VIGOROUS STOCK, INCLUDING FOLIATED WHEN IN LEAF AND FREE OF DISEASE, PESTS, EGGS, LARVAE, AND DEFECTS SUCH AS KNOTS, SUN SCALD, INJURIES, ABRASIONS, AND DISFIGUREMENT.
 - b. TREES FOR PLANTING IN ROWS SHALL BE UNIFORM IN SIZE AND SHAPE.
 - c. NO SUBSTITUTIONS SHALL BE MADE WITHOUT WRITTEN PERMISSION FROM THE PROJECT LANDSCAPE ARCHITECT. ANY ROW TREES MUST BE **APPROVED BY OFFICE OF THE CITY FORESTER**.
 - d. PROVIDE PLANTS OF SIZES, GRADES, AND BALL OR CONTAINER SIZES COMPLYING WITH ANSI Z60.1 AND COLORADO NURSERY ACT FOR TYPES AND FORM OF PLANTS REQUIRED. PLANTS OF A LARGER SIZE MAY BE USED IF ACCEPTABLE TO PROJECT LANDSCAPE ARCHITECT WITH A PROPORTIONATE INCREASE IN SIZE OF ROOTS OR BALLS.
 - e. PLANTS SHALL BE SUBJECT TO INSPECTION AND APPROVAL AT THE PLACE OF GROWTH, OR UPON DELIVERY TO THE SITE, AS DETERMINED BY THE OWNER, FOR QUALITY, SIZE, AND VARIETY. SUCH APPROVAL SHALL NOT IMPAIR THE RIGHT OF INSPECTION AND REJECTION AT THE SITE DURING PROGRESS OF THE WORK OR AFTER COMPLETION FOR SIZE AND CONDITION OF ROOT BALLS OR ROOTS, LATENT DEFECTS OR INJURIES. REJECTED PLANTS SHALL BE REMOVED IMMEDIATELY FROM THE SITE. NOTICE REQUESTING INSPECTION SHALL BE SUBMITTED IN WRITING BY THE CONTRACTOR AT LEAST ONE (1) WEEK PRIOR TO ANTICIPATED DATE.
 - f. TREES WITH DAMAGED, CROOKED, OR MULTIPLE LEADERS; TIGHT VERTICAL BRANCHES WHERE BARK IS SQUEEZED BETWEEN TWO BRANCHES OR BETWEEN BRANCH AND TRUNK ("INCLUDED BARK"); CROSSING TRUNKS; CUT-OFF LIMBS MORE THAN 1/2 INCH (19 MM) IN DIAMETER; OR WITH STEM GIRDLING ROOTS WILL BE REJECTED.
 - g. FURNISH TREES AND SHRUBS WITH ROOTS BALLS MEASURED FROM TOP OF ROOT BALL, WHICH SHALL BEGIN AT ROOT FLARE ACCORDING TO ANSI Z60.1 AND COLORADO NURSERY ACT. ROOT FLARE SHALL BE VISIBLE BEFORE PLANTING.
 - h. LABEL AT LEAST ONE PLANT OF EACH VARIETY, SIZE, AND CALIPER WITH A SECURELY ATTACHED, WATERPROOF TAG BEARING LEGIBLE DESIGNATION OF COMMON NAME AND FULL SCIENTIFIC NAME, INCLUDING GENUS AND SPECIES, INCLUDE NOMENCLATURE FOR HYBRID, VARIETY, OR CULTIVAR, IF APPLICABLE FOR THE PLANT AS SHOWN ON DRAWINGS.
 - i. IF FORMAL ARRANGEMENTS OR CONSECUTIVE ORDER OF PLANTS IS SHOWN ON DRAWINGS, SELECT STOCK FOR UNIFORM HEIGHT AND SPREAD, AND NUMBER THE LABELS TO ASSURE SYMMETRY IN PLANTING.
- E. SOIL MIXTURE**
1. CONTRACTOR SHALL TEST EXISTING SOIL AND AMEND AS NECESSARY IN ACCORDANCE WITH THE GUIDELINES BELOW:
 2. SOIL MIXTURE SHALL CONSIST OF TWO PARTS OF TOPSOIL AND ONE PART SAND, AS DESCRIBED BELOW. CONTRACTOR TO SUBMIT SAMPLES AND PH TESTING RESULTS OF SOIL MIXTURE FOR OWNER'S REPRESENTATIVE APPROVAL PRIOR TO PLANT INSTALLATION OPERATIONS COMMENCE.
 - a. TOPSOIL FOR USE IN PREPARING SOIL MIXTURE FOR BACKFILLING PLANT OPENINGS SHALL BE FERTILE, FRIABLE, AND OF A LOAMY CHARACTER; REASONABLY FREE OF SUBSOIL, CLAY LUMPS, BRUSH WEEDS AND OTHER LITTER, FREE OF ROOTS, STUMPS, STONES LARGER THAN 2" IN ANY DIRECTION, AND OTHER EXTRANEUS OR TOXIC MATTER HARMFUL TO PLANT GROWTH. IT SHALL CONTAIN THREE (3) TO FIVE (5) PERCENT DECOMPOSED ORGANIC MATTER, HAVE A PH BETWEEN 5.5 AND 8.0, AND SOLUBLE SALTS LESS THAN 3.0 MMHOS/CM. SUBMIT SOIL SAMPLE AND PH TESTING RESULTS FOR APPROVAL.
 - b. SAND SHALL BE COARSE, CLEAN, WELL-DRAINING, NATIVE SAND.
 3. TREES SHALL BE PLANTED IN THE EXISTING NATIVE SOIL ON SITE, UNLESS DETERMINED TO BE UNSUITABLE - AT WHICH POINT THE CONTRACTOR SHALL CONTACT THE PROJECT LANDSCAPE ARCHITECT TO DISCUSS ALTERNATE RECOMMENDATION PRIOR TO PLANTING.
- F. WATER**
1. WATER NECESSARY FOR PLANTING AND MAINTENANCE SHALL BE OF SATISFACTORY QUALITY TO SUSTAIN ADEQUATE PLANT GROWTH AND SHALL NOT CONTAIN HARMFUL, NATURAL OR MAN-MADE ELEMENTS DETRIMENTAL TO PLANTS. WATER MEETING THE ABOVE STANDARD SHALL BE OBTAINED ON THE SITE FROM THE OWNER, IF AVAILABLE, AND THE CONTRACTOR SHALL BE RESPONSIBLE TO MAKE ARRANGEMENTS FOR ITS USE BY HIS TANKS, HOSES, SPRINKLERS, ETC... IF SUCH WATER IS NOT AVAILABLE AT THE SITE, THE CONTRACTOR SHALL PROVIDE SATISFACTORY WATER FROM SOURCES OFF THE SITE AT NO ADDITIONAL COST TO THE OWNER.
* WATERING/IRRIGATION RESTRICTIONS MAY APPLY - REFER TO PROPERTY'S JURISDICTIONAL AUTHORITY.
- G. FERTILIZER**
1. CONTRACTOR SHALL PROVIDE FERTILIZER APPLICATION SCHEDULE TO OWNER, AS APPLICABLE TO SOIL TYPE, PLANT INSTALLATION TYPE, AND SITE'S PROPOSED USE. SUGGESTED FERTILIZER TYPES SHALL BE ORGANIC OR OTHERWISE NATURALLY-DERIVED.
* FERTILIZER RESTRICTIONS MAY APPLY - REFER TO PROPERTY'S JURISDICTIONAL AUTHORITY.
- H. MULCH**
1. MULCH MATERIAL SHALL BE MOISTENED AT THE TIME OF APPLICATION TO PREVENT WIND DISPLACEMENT, AND APPLIED AT A DEPTH OF THREE (3) INCHES CLEAR MULCH FROM EACH PLANTS' GROWN (BASE) OR AS SHOWN IN PLANTING DETAILS. MULCH SHALL BE DOUBLE SHREDDED HARDWOOD MULCH. DYED MULCH IS NOT ACCEPTABLE. SUBMIT SAMPLES TO PROJECT LANDSCAPE ARCHITECT FOR APPROVAL. MULCH SHALL BE PROVIDED OVER THE ENTIRE AREA OF EACH SHRUB BED, GROUND COVER, VINE BED, AND TREE RING (IF MINIMUM) PLANTED UNDER THIS CONTRACT, AS WELL AS FOR ANY EXISTING LANDSCAPE AREAS AS SHOWN ON PLANS.
- I. DIGGING AND HANDLING**
1. ALL TREES SPECIFIED SHALL BE BALLED AND BURLAPPED (B&B) UNLESS OTHERWISE APPROVED BY PROJECT LANDSCAPE ARCHITECT.
 2. PROTECT ROOTS OR ROOT BALLS OF PLANTS AT ALL TIMES FROM SUN, DRYING WINDS, WATER AND FREEZING, AS NECESSARY UNTIL PLANTING. PLANT MATERIALS SHALL BE ADEQUATELY PACKED TO PREVENT DAMAGE DURING TRANSIT. TREES TRANSPORTED MORE THAN TEN (10) MILES OR WHICH ARE NOT PLANTED WITHIN THREE (3) DAYS OF DELIVERY TO THE SITE SHALL BE SPRAYED WITH AN ANTI-TRANSPIRANT PRODUCT ("WILT-TRUF" OR EQUAL) TO MINIMIZE TRANSPIRATIONAL WATER LOSS.
 3. B&B AND FIELD GROWN (FG) PLANTS SHALL BE DUG WITH FIRM, NATURAL BALLS OF SOIL OF SUFFICIENT SIZE TO ENCOMPASS THE FIBROUS AND FEEDING ROOTS OF THE PLANTS. NO PLANTS MOVED WITH A ROOT BALL SHALL BE PLANTED IF THE BALL IS CRACKED OR BROKEN. PLANTS SHALL NOT BE HANDLED BY STEMS.
- J. CONTAINER GROWN STOCK**
1. ALL CONTAINER GROWN MATERIAL SHALL BE HEALTHY, VIGOROUS, WELL-ROOTED PLANTS ESTABLISHED IN THE CONTAINER IN WHICH THEY ARE SOLD. THE PLANTS SHALL HAVE TOPS WHICH ARE OF GOOD QUALITY AND ARE IN A HEALTHY GROWING CONDITION.
 2. AN ESTABLISHED CONTAINER GROWN PLANT SHALL BE TRANSPLANTED INTO A CONTAINER AND GROWN IN THAT CONTAINER SUFFICIENTLY LONG ENOUGH FOR THE NEW FIBROUS ROOTS TO HAVE DEVELOPED SO THAT THE ROOT MASS WILL RETAIN ITS SHAPE AND HOLD TOGETHER WHEN REMOVED FROM THE CONTAINER. CONTAINER GROWN STOCK SHALL NOT BE HANDLED BY THEIR STEMS.
 3. ROOT BOUND PLANTS ARE NOT ACCEPTABLE AND WILL BE REJECTED.
- K. MATERIALS LIST**
1. QUANTITIES NECESSARY TO COMPLETE THE WORK ON THE DRAWINGS SHALL BE FURNISHED BY THE CONTRACTOR. QUANTITY ESTIMATES HAVE BEEN MADE CAREFULLY, BUT THE LANDSCAPE ARCHITECT OR OWNER ASSUMES NO LIABILITY FOR OMISSIONS OR ERRORS. SHOULD A DISCREPANCY OCCUR BETWEEN THE PLANS AND THE PLANT LIST QUANTITY, THE PLANS SHALL GOVERN. ALL DIMENSIONS AND/OR SIZES SPECIFIED SHALL BE THE MINIMUM ACCEPTABLE SIZE.
- L. FINE GRADING**
1. FINE GRADING UNDER THIS CONTRACT SHALL CONSIST OF FINAL FINISHED GRADING OF LAWN AND PLANTING AREAS THAT HAVE BEEN DISTURBED DURING CONSTRUCTION.
 2. THE CONTRACTOR SHALL FINE GRADE THE LAWN AND PLANTING AREAS TO BRING THE ROUGH GRADE UP TO FINAL FINISHED GRADE ALLOWING FOR THICKNESS OF SOD AND/OR MULCH DEPTH.
 3. ALL PLANTING AREAS SHALL BE GRADED AND MAINTAINED FOR POSITIVE DRAINAGE TO SURFACE/SUBSURFACE STORM DRAIN SYSTEMS. AREAS ADJACENT TO BUILDINGS SHALL SLOPE AWAY FROM THE BUILDINGS. REFER TO CIVIL ENGINEER'S PLANS FOR FINAL GRADES, IF APPLICABLE.
- M. PLANTING PROCEDURES**
1. THE CONTRACTOR SHALL CLEAN WORK AND SURROUNDING AREAS OF ALL RUBBISH OR OBJECTABLE MATTER DAILY. ALL MORTAR, CEMENT, BUILDING MATERIALS, AND TOXIC MATERIAL SHALL BE COMPLETELY REMOVED FROM PLANTING AREAS. THESE MATERIALS SHALL NOT BE MIXED WITH THE SOIL. SHOULD THE CONTRACTOR FIND SUCH SOIL CONDITIONS IN PLANTING AREAS WHICH WILL ADVERSELY AFFECT THE PLANT GROWTH, THE CONTRACTOR SHALL IMMEDIATELY CALL IT TO THE ATTENTION OF THE OWNER'S REPRESENTATIVE. FAILURE TO DO SO BEFORE PLANTING SHALL MAKE THE CORRECTIVE MEASURES THE RESPONSIBILITY OF THE CONTRACTOR.
 2. VERIFY LOCATIONS OF ALL UTILITIES, CONDUITS, SUPPLY LINES AND CABLES, INCLUDING BUT NOT LIMITED TO: ELECTRIC, GAS (LINES AND TANKS), WATER, SANITARY SEWER, STORMWATER SYSTEMS, CABLE, AND TELEPHONE. PROPERLY MAINTAIN AND PROTECT EXISTING UTILITIES. CALL COLORADO (811) TO LOCATE UTILITIES AT LEAST 48 HOURS PRIOR TO CONSTRUCTION.
 3. CONTRACTOR IS RESPONSIBLE TO REMOVE ALL EXISTING AND IMPORTED LIMEROCK AND LIMEROCK SUB-BASE FROM ALL PLANTING AREAS TO A MINIMUM DEPTH OF 36" OR TO NATIVE SOIL. CONTRACTOR IS RESPONSIBLE TO BACKFILL THESE PLANTING AREAS TO ROUGH FINISHED GRADE WITH CLEAN TOPSOIL FROM AN ON-SITE SOURCE OR AN IMPORTED SOURCE. IF LIMEROCK OR OTHER ADVERSE CONDITIONS OCCUR IN PLANTED AREAS AFTER 36" DEEP EXCAVATION BY THE CONTRACTOR, AND POSITIVE DRAINAGE CAN NOT BE ACHIEVED, CONTRACTOR SHALL UTILIZE POOR DRAINAGE CONDITION PLANTING DETAIL.
 4. FURNISH NURSERY'S CERTIFICATE OF COMPLIANCE WITH ALL REQUIREMENTS AS SPECIFIED HEREIN. INSPECT AND SELECT PLANT MATERIALS BEFORE PLANTS ARE DUG AT NURSERY OR GROWING SITE.
 5. COMPLY WITH APPLICABLE FEDERAL, STATE, COUNTY, AND LOCAL REGULATIONS GOVERNING LANDSCAPE MATERIALS AND WORK. UPON ARRIVAL AT THE SITE, PLANTS SHALL BE THOROUGHLY WATERED AND PROPERLY MAINTAINED UNTIL PLANTED. PLANTS STORED ON SITE SHALL NOT REMAIN UNPLANTED OR APPROPRIATELY HEATED IN FOR A PERIOD EXCEEDING TWENTY-FOUR (24) HOURS. AT ALL TIMES WORKMANLIKE METHODS CUSTOMARY IN ACCEPTED HORTICULTURAL PRACTICES AS USED IN THE TRADE SHALL BE EXERCISED.
 6. WORK SHALL BE COORDINATED WITH OTHER TRADES TO PREVENT CONFLICTS. COORDINATE PLANTING WITH IRRIGATION WORK TO ASSURE AVAILABILITY OF WATER AND PROPER LOCATION OF IRRIGATION APPURTENANCES AND PLANTS.
 7. ALL PLANTING OPENINGS SHALL BE EXCAVATED TO SIZE AND DEPTH IN ACCORDANCE WITH ANSI Z60.1-2014 AMERICAN STANDARD FOR NURSERY STOCK.
 8. TEST ALL TREE OPENINGS WITH WATER BEFORE PLANTING TO ASSURE PROPER DRAINAGE PERCOLATION IS AVAILABLE. NO ALLOWANCE WILL BE MADE FOR LOST PLANTS DUE TO IMPROPER DRAINAGE. IF POOR DRAINAGE EXISTS, UTILIZE "POOR DRAINAGE CONDITION" PLANTING DETAIL.
 9. TREES SHALL BE SET PLUMBS AND HELD IN POSITION UNTIL THE PLANTING MIXTURE HAS BEEN FLUSHED INTO PLACE WITH A SLOW, FULL HOSE STREAM. ALL PLANTING SHALL BE PERFORMED BY PERSONNEL FAMILIAR WITH PLANTING PROCEDURES AND UNDER THE SUPERVISION OF A QUALIFIED LANDSCAPE FOREMAN.
 10. PRIOR TO EXCAVATION OF TREE OPENINGS, AN AREA EQUAL TO TWO TIMES THE DIAMETER OF THE ROOT BALL SHALL BE ROTO-TILLED TO A DEPTH EQUAL TO THE DEPTH OF THE ROOT BALL.
 11. EXCAVATION OF TREE OPENINGS SHALL BE PERFORMED USING EXTREME CARE TO AVOID DAMAGE TO SURFACE AND SUBSURFACE ELEMENTS SUCH AS UTILITIES OR HARDSCAPE ELEMENTS, FOOTERS AND PREPARED SUB-BASES.
 12. IN CONTINUOUS SHRUB AND GROUND COVER BEDS, THE ROTO-TILLED PERIMETER SHOULD EXTEND TO A DISTANCE OF ONE FOOT BEYOND THE DIAMETER OF A SINGLE ROOT BALL. THE BED SHALL BE TILLED TO A DEPTH EQUAL TO THE ROOT BALL DEPTH PLUS 1".
 13. TREE OPENINGS FOR WELL DRAINED SOILS SHALL BE DUG SO THAT THE BOTTOM OF THE ROOT BALL WILL REST ON UNDISTURBED SOIL AND THE TOP OF THE ROOT BALL WILL BE FLUSH WITH FINISH GRADE. IN POORLY DRAINED SOILS THE TREE OPENING SHALL BE DUG SO THAT THE ROOT BALL RESTS ON UNDISTURBED SOIL AND THE TOP OF THE ROOT BALL IS 1" ABOVE FINISH GRADE. PLANT PIT WALLS SHALL BE SCARIFIED PRIOR TO PLANT INSTALLATION.
 14. TAKE ALL NECESSARY PRECAUTIONS TO AVOID DAMAGE TO BUILDINGS AND BUILDING STRUCTURES WHILE INSTALLING TREES.
 15. SOIL MIXTURE SHALL BE AS SPECIFIED IN SECTION 'E'.
 16. TREES AND SHRUBS SHALL BE SET STRAIGHT AT AN ELEVATION THAT, AFTER SETTLEMENT, THE PLANT CROWN WILL STAND ONE (1) TO TWO (2) INCHES ABOVE GRADE. EACH PLANT SHALL BE SET IN THE CENTER OF THE PIT. SOIL MIXTURE SHALL BE BACK-FILLED, THOROUGHLY TAMPED AROUND THE BALL, AND SETTLED BY WATER (AFTER TAMPING).
 17. AMEND PINE AND OAK PLANT OPENINGS WITH ECTOMYCORRHIZAL SOIL APPLICATION PER MANUFACTURER'S RECOMMENDATION. ALL OTHER PLANT OPENINGS SHALL BE AMENDED WITH ENDOMYCORRHIZAL SOIL APPLICATION PER MANUFACTURER'S RECOMMENDATION. PROVIDE PRODUCT INFORMATION SUBMITTAL PRIOR TO INOCULATION.
- N. LAWN SODDING**
1. THE WORK CONSISTS OF LAWN BED PREPARATION, SOIL PREPARATION, AND SODDING COMPLETE, IN STRICT ACCORDANCE WITH THE SPECIFICATIONS AND THE APPLICABLE DRAWINGS TO PRODUCE A TURF GRASS LAWN ACCEPTABLE TO THE OWNER.
 2. ALL AREAS THAT ARE TO BE SODDED SHALL BE CLEARED OF ANY ROUGH GRASS, WEEDS, AND DEBRIS BY MEANS OF A SOD CUTTER TO A DEPTH OF THREE (3) INCHES, AND THE GROUND BROUGHT TO AN EVEN GRADE. THE ENTIRE SURFACE SHALL BE ROLLED WITH A ROLLER WEIGHING NOT MORE THAN ONE-HUNDRED (100) POUNDS PER FOOT OF WIDTH. DURING THE ROLLING, ALL DEPRESSIONS CAUSED BY SETTLEMENT SHALL BE FILLED WITH ADDITIONAL SOIL, AND THE SURFACE SHALL BE REGRADED AND ROLLED UNTIL PRESENTING A SMOOTH AND EVEN FINISH TO THE REQUIRED GRADE.
 3. PREPARE LOOSE BED FOUR (4) INCHES DEEP. HAND RAKE UNTIL ALL BUMPS AND DEPRESSIONS ARE REMOVED. WET PREPARED AREA THOROUGHLY.
 4. SODDING
 - a. THE CONTRACTOR SHALL SOD ALL AREAS THAT ARE NOT PAVED OR PLANTED AS DESIGNATED ON THE DRAWINGS WITHIN THE CONTRACT LIMITS, UNLESS SPECIFICALLY NOTED OTHERWISE.
 - b. SOD PANELS SHALL BE LAID TIGHTLY TOGETHER SO AS TO MAKE A SOLID SODDED LAWN AREA. SOD SHALL BE LAID UNIFORMLY AGAINST THE EDGES OF ALL CURBS AND OTHER HARDSCAPE ELEMENTS, PAVED AND PLANTED AREAS. ADJACENT TO BUILDINGS, A 24 INCH STONE MULCH STRIP SHALL BE PROVIDED. IMMEDIATELY FOLLOWING SOD LAYING, THE LAWN AREAS SHALL BE ROLLED WITH A LAWN ROLLER CUSTOMARILY USED FOR SUCH PURPOSES, AND THEN THOROUGHLY IRRIGATED. IF, IN THE OPINION OF THE OWNER, TOP-DRESSING IS NECESSARY AFTER ROLLING TO FILL THE VOIDS BETWEEN THE SOD PANELS AND TO EVEN OUT INCONSISTENCIES IN THE SOD, CLEAN SAND, AS APPROVED BY THE OWNER'S REPRESENTATIVE, SHALL BE UNIFORMLY SPREAD OVER THE ENTIRE SURFACE OF THE SOD AND THOROUGHLY WATERED IN. FERTILIZE INSTALLED SOD AS ALLOWED BY PROPERTY'S JURISDICTIONAL AUTHORITY.
 5. DURING DELIVERY, PRIOR TO, AND DURING THE PLANTING OF THE LAWN AREAS, THE SOD PANELS SHALL AT ALL TIMES BE PROTECTED FROM EXCESSIVE DRYING AND UNNECESSARY EXPOSURE OF THE ROOTS TO THE SUN. ALL SOD SHALL BE STACKED SO AS NOT TO BE DAMAGED BY SWEATING OR EXCESSIVE HEAT AND MOISTURE.
 6. LAWN MAINTENANCE
 - a. WITHIN THE CONTRACT LIMITS, THE CONTRACTOR SHALL PRODUCE A DENSE, WELL ESTABLISHED LAWN. THE CONTRACTOR SHALL BE RESPONSIBLE FOR THE REPAIR AND RE-SODDING OF ALL ERODED, SUNKEN OR BARE SPOTS (LARGER THAN 12"X12") UNTIL CERTIFICATION OF ACCEPTANCE BY THE OWNER'S REPRESENTATIVE. REPAIRED SODDING SHALL BE ACCOMPLISHED AS IN THE ORIGINAL WORK, INCLUDING REGRADE IF NECESSARY.
 - b. CONTRACTOR SHALL BE RESPONSIBLE FOR ESTABLISHING AND MAINTAINING SOD/LAWN UNTIL ACCEPTANCE BY THE OWNER'S REPRESENTATIVE. PRIOR TO AND UPON ACCEPTANCE, CONTRACTOR TO PROVIDE WATERING/IRRIGATION SCHEDULE TO OWNER. OBSERVE ALL APPLICABLE WATERING RESTRICTIONS AS SET FORTH BY THE PROPERTY'S JURISDICTIONAL AUTHORITY.
- O. EDGING**
- a. CONTRACTOR SHALL INSTALL 4"x1/2" ROLLED TOP STEEL EDGING BETWEEN ALL SOD/SEED AREAS AND PLANTING BEDS.
- P. CLEANUP**
1. UPON COMPLETION OF ALL PLANTING WORK AND BEFORE FINAL ACCEPTANCE, THE CONTRACTOR SHALL REMOVE ALL MATERIAL, EQUIPMENT, AND DEBRIS RESULTING FROM CONTRACTORS WORK. ALL PAVED AREAS SHALL BE CLEANED AND THE SITE LEFT IN A NEAT AND ACCEPTABLE CONDITION AS APPROVED BY THE OWNER'S REPRESENTATIVE.
- Q. PLANT MATERIAL MAINTENANCE**
1. ALL PLANTS AND PLANTING INCLUDED UNDER THIS CONTRACT SHALL BE MAINTAINED BY WATERING, CULTIVATING, SPRAYING, PRUNING, AND ALL OTHER OPERATIONS (SUCH AS RE-STAKING OR REPAIRING GUY SUPPORTS) NECESSARY TO INSURE A HEALTHY PLANT CONDITION BY THE CONTRACTOR UNTIL CERTIFICATION OF ACCEPTANCE BY THE OWNER'S REPRESENTATIVE.
- R. FINAL INSPECTION AND ACCEPTANCE OF WORK**
1. FINAL INSPECTION AT THE END OF THE WARRANTY PERIOD SHALL BE ON PLANTING, CONSTRUCTION AND ALL OTHER INCIDENTAL WORK PERTAINING TO THIS CONTRACT. ANY REPLACEMENT AT THIS TIME SHALL BE SUBJECT TO THE SAME ONE (1) YEAR WARRANTY (OR AS SPECIFIED BY THE LANDSCAPE ARCHITECT OR OWNER IN WRITING) BEGINNING WITH THE TIME OF REPLACEMENT AND ENDING WITH THE SAME INSPECTION AND ACCEPTANCE HEREIN DESCRIBED.
- S. WARRANTY**
1. THE LIFE AND SATISFACTORY CONDITION OF ALL PLANT MATERIAL, INSTALLED (INCLUDING SOD) BY THE LANDSCAPE CONTRACTOR SHALL BE WARRANTED BY THE CONTRACTOR FOR A MINIMUM OF ONE (1) CALENDAR YEAR COMMENCING AT THE TIME OF CERTIFICATION OF ACCEPTANCE BY THE OWNER'S REPRESENTATIVE.
 2. ANY PLANT NOT FOUND IN A HEALTHY GROWING CONDITION AT THE END OF THE WARRANTY PERIOD SHALL BE REMOVED FROM THE SITE AND REPLACED AS SOON AS WEATHER CONDITIONS PERMIT. ALL REPLACEMENTS SHALL BE PLANTS OF THE SAME KIND AND SIZE AS SPECIFIED IN THE PLANT LIST. THEY SHALL BE FURNISHED PLANTED AND MULCHED AS SPECIFIED AT NO ADDITIONAL COST TO THE OWNER.
 3. IN THE EVENT THE OWNER DOES NOT CONTRACT WITH THE CONTRACTOR FOR LANDSCAPE AND IRRIGATION MAINTENANCE, THE CONTRACTOR SHOULD VISIT THE PROJECT SITE PERIODICALLY DURING THE ONE (1) YEAR WARRANTY PERIOD TO EVALUATE MAINTENANCE PROCEDURES BEING PERFORMED BY THE OWNER. CONTRACTOR SHALL NOTIFY THE OWNER IN WRITING OF MAINTENANCE PROCEDURES OR CONDITIONS WHICH THREATEN VIGOROUS AND HEALTHY PLANT GROWTH.
- T. PARKING LOT ISLAND NOTE**
1. THE SOIL OF ANY PLANTER WITHIN THE PARKING LOT SHALL BE STRUCTURALLY RENOVATED (TILLED) OR REMOVED TO A DEPTH OF THIRTY INCHES (30") AND REPLACED WITH AN ACCEPTABLE GROWING MEDIUM FOR THE SPECIES INDICATED FOR INSTALLATION.
- U. MAINTENANCE**
1. LANDSCAPE IMPROVEMENTS AND MAINTENANCE SHALL BE THE RESPONSIBILITY OF MAYBERRY METROPOLITAN DISTRICT NO. 1.
 2. ALL STREET TREES AND STREETSCAPE IMPROVEMENTS LOCATED IN THE R.O.W. WILL BE MAINTAINED BY THE ABUTTING PROPERTY OWNER.

please remove all references to other jurisdictions

revise to the metro district

 EPC APPROVAL:



LANDSCAPE NOTES
SHEET 12 OF 15

MAYBERRY FILING 5 LANDSCAPE PLAN - EL PASO COUNTY FILE NO.


MAYBERRY FILING 5

LANDSCAPE PLAN

TRACT K OF MAYBERRY COLORADO SPRINGS FILING NO. 1

SITUATED IN THE NORTHWEST QUARTER OF SECTION 14, TOWNSHIP 14 SOUTH, RANGE 63 WEST OF THE 6TH P.M.


COUNTY OF EL PASO, STATE OF COLORADO

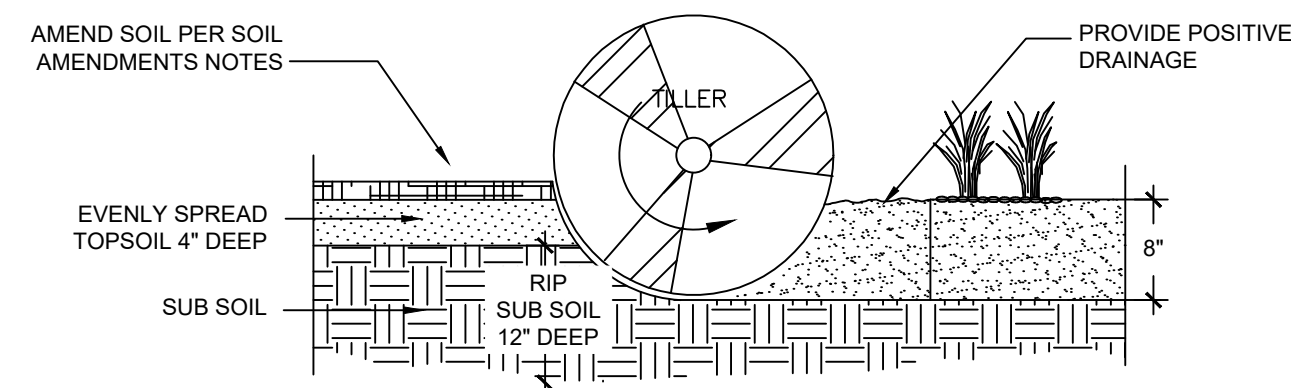

- NOTES:**
1. TOPSOIL TO CONSIST OF DARK, LIGHT LOAM SOIL FREE OF ROCKS, ROOTS, AND FOREIGN MATERIALS.
 2. THE FERTILIZER APPLICATION SHOULD BE DELAYED IF PLANTING DOES NOT OCCUR WITHIN 2-3 DAYS OF FERTILIZING.
 3. COMPOST TO CONSIST OF 1 YEAR OLD ORGANIC MATERIAL AND SHOULD NOT INCLUDE CHICKEN MANURE.
 4. FROZEN MATERIALS OR MATERIALS GREATER THAN 1" DIA. SHOULD BE REMOVED.
 5. REFER TO SPECS FOR COMPLETE SOIL PREPARATION REQUIREMENTS.
 6. THE ROTO-TILLED PERIMETER SHOULD EXTEND TO A DISTANCE OF 1 FOOT BEYOND THE DIAMETER OF A SINGLE ROOT BALL.


1 SOIL PREP

NTS 196-413-002-01

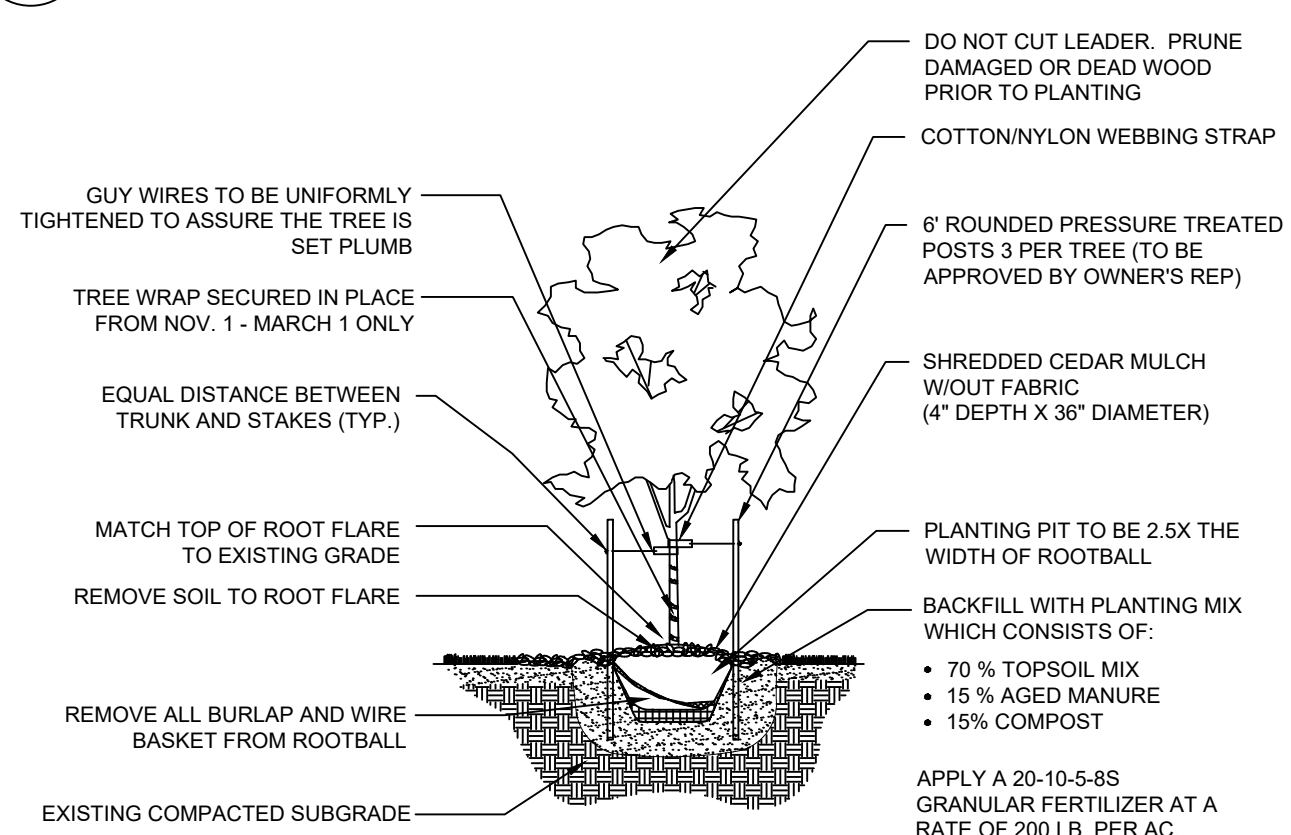


2 DECIDUOUS TREE PLANTING

NTS 196-413-002-02

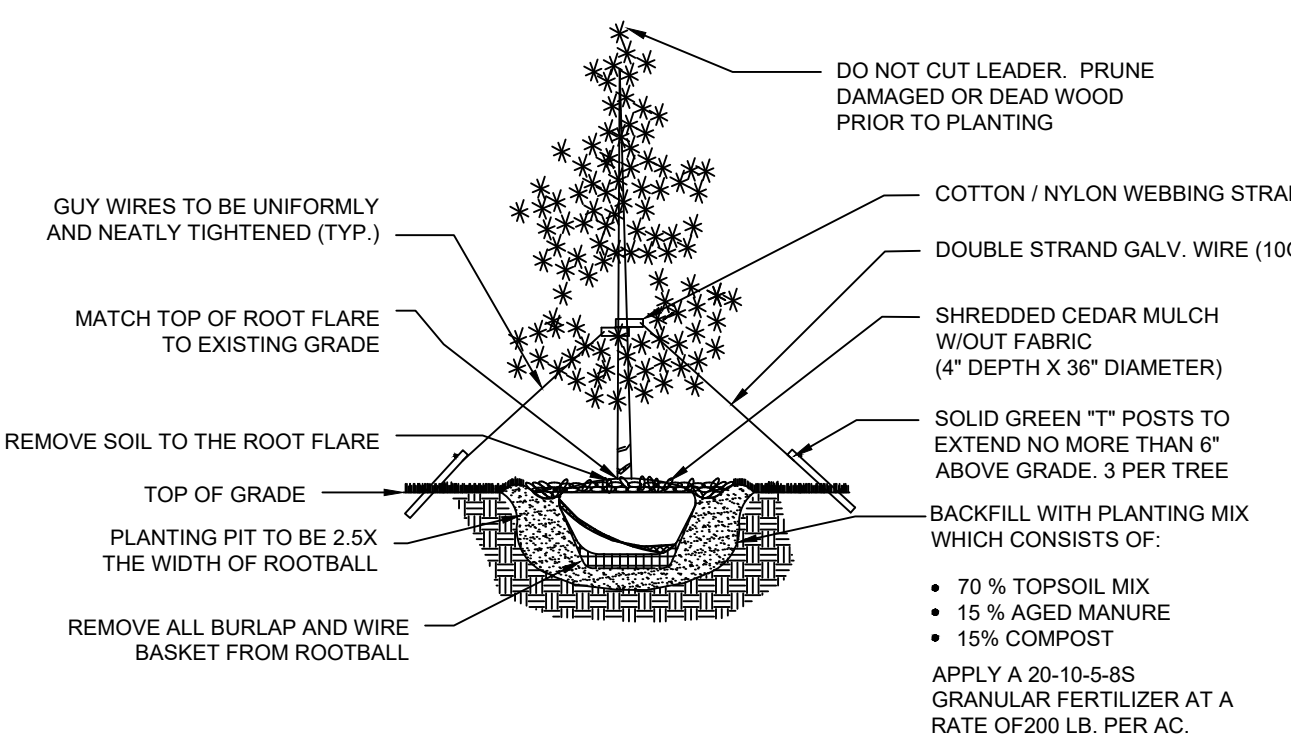

3 EVERGREEN TREE PLANTING


NTS 196-413-002-03

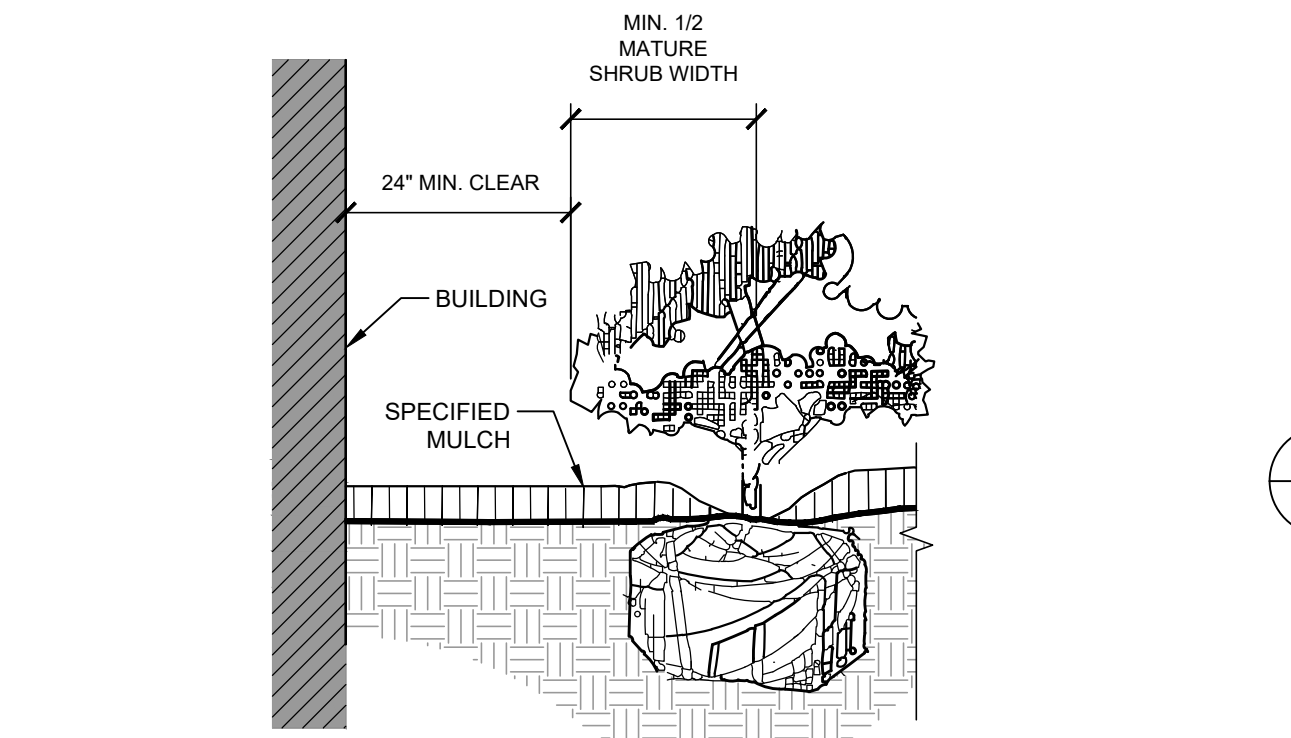

- NOTES:**
1. TOPSOIL TO CONSIST OF DARK, LIGHT LOAM SOIL FREE OF ROCKS, ROOTS, AND FOREIGN MATERIALS.
 2. THE FERTILIZER APPLICATION SHOULD BE DELAYED IF PLANTING DOES NOT OCCUR WITHIN 2-3 DAYS OF FERTILIZING.
 3. COMPOST TO CONSIST OF 1 YEAR OLD ORGANIC MATERIAL AND SHOULD NOT INCLUDE CHICKEN MANURE.
 4. FROZEN MATERIALS OR MATERIALS GREATER THAN 1" DIA. SHOULD BE REMOVED.
 5. REFER TO SPECS FOR COMPLETE SOIL PREPARATION REQUIREMENTS.

4 PLANTINGS ADJACENT TO BUILDINGS

NTS 196-413-002-07

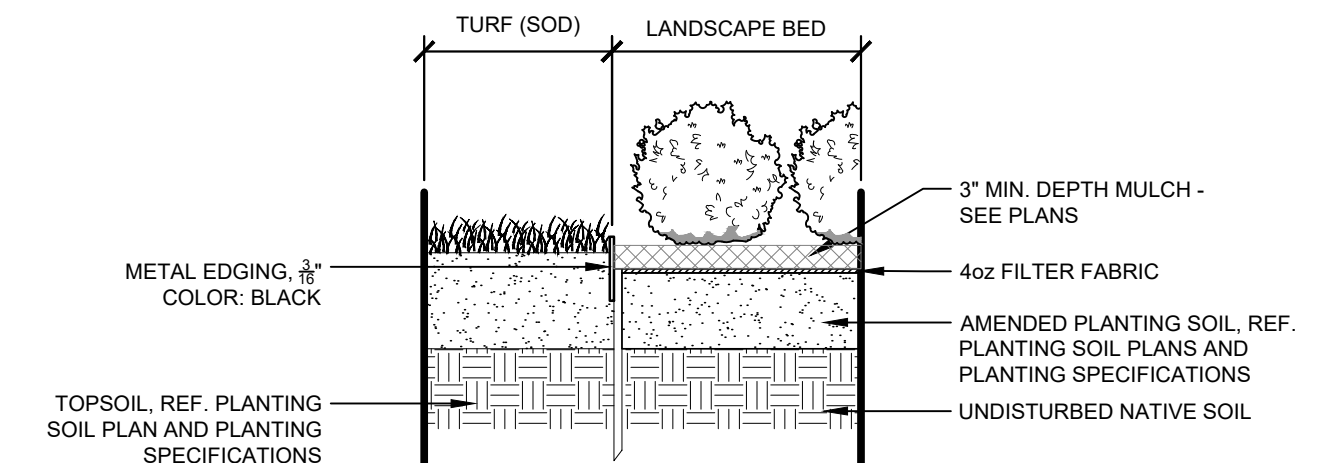

5 METAL EDGER AT PLANTING BED


1" = 1" L-109 196-413-002-08



- NOTES:**
- DISPENSER IS COMMERCIAL GRADE, POWDER-COATED ALUMINUM.
 - SQUARE, GALVANIZED POST WITH ADJUSTABLE LENGTH FROM 48-93"
 - WASTE RECEPTACLE: 11 GALLON SQUARE OR 10 GALLON PERFORATED ROUND.
 - INCLUDES HARDWARE AND INSTALLATION INSTRUCTIONS.
 - OPTIONAL SURFACE MOUNT PLATE: GALVANIZED STEEL WITH 1/2" D PRE-DRILLED MOUNTING HOLES.
 - SOLAR LIGHT: 7.25" X 4.5" WITH 34 LED LIGHTS
 - DIMENSIONS: 73"H X 18"W X 10"D
- MANUFACTURER: DOG-ON-IT PARKS
COLOR: TBD
WASTE RECEPTACLE: TBD


6 COMPLETE DOG WASTE STATION- #7408S

NTS

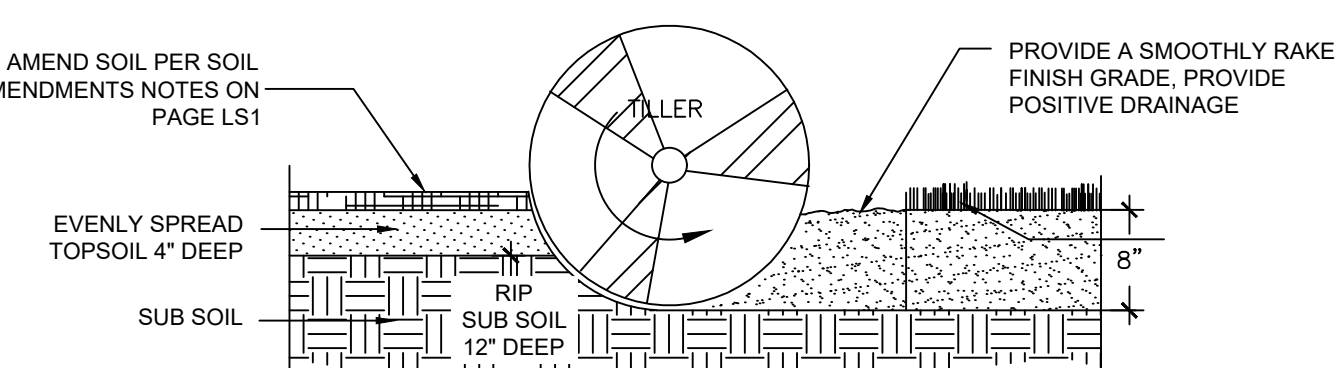


7 SOIL PREPARATION - SOD AREAS

NTS 196-413-002-04

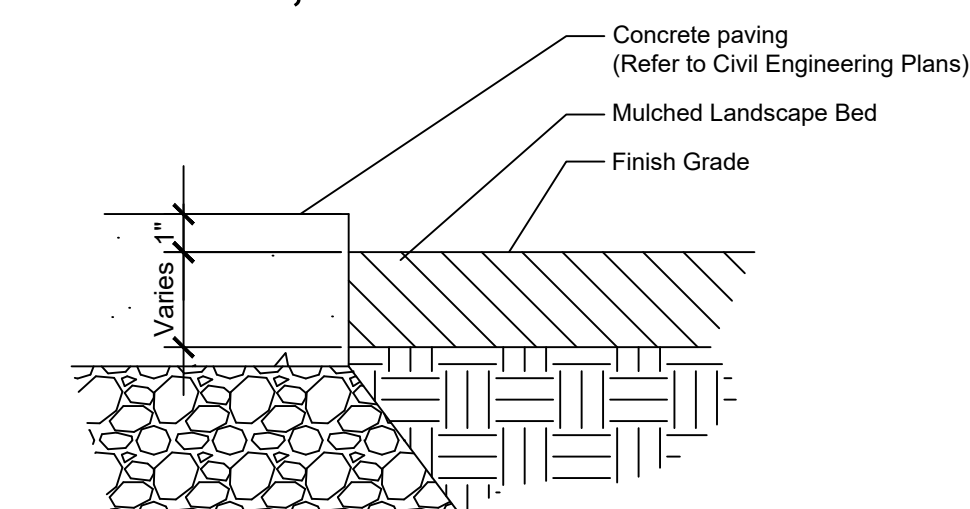

8 PAVING TO GRADE TRANSITION

1" = 1" L-109

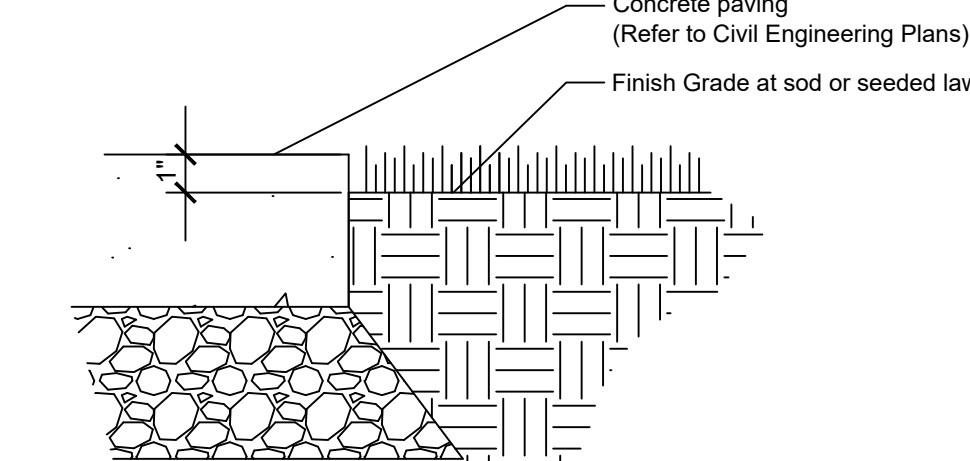

9 CRUSHER FINES AND TRANSITIONS

SCALE: NTS L-109 SECTION

8 PAVING TO GRADE TRANSITION

1" = 1" L-109

PLANT SCHEDULE

| DECIDUOUS TREES | CODE | QTY | BOTANICAL / COMMON NAME | CONT. SIZE | SIZE/CAL. | WIDTH | HEIGHT |
|-----------------|--------|-----------|---|------------|----------------|-------------|-------------------------|
| | AT | 17 | ACER TATARICUM 'HOT WINGS' / HOT WINGS TATARIAN MAPLE | B & B | 2" CAL MIN | 15'-20' | 18'-20' |
| | CO | 17 | CELTIS OCCIDENTALIS 'CHICAGOLAND' / CHICAGOLAND WESTERN HACKBERRY | B & B | 1.5" CAL MIN | 40'-50' | 50'-60' |
| | CS | 6 | CATALPA SPECIOSA / NORTHERN CATALPA | B & B | 2.5" CAL MIN | 30'-50' | 40'-60' |
| | GD | 6 | GYMNOCLADUS DIOICA 'ESPRESSO' / KENTUCKY COFFEE TREE (SEEDLESS) | B & B | 1.5" CAL MIN | 40'-50' | 50'-60' |
| | GT | 13 | GLEDITSIA TRIACANTHOS INERMIS 'SUNBURST' / SUNBURST HONEY LOCUST | B & B | 1.5" CAL MIN | 30'-35' | 30'-35' |
| | KP | 8 | KOELREUTERIA PANICULATA / GOLDEN RAIN TREE | B & B | 2" CAL MIN | 20'-30' | 20'-30' |
| | MO | 41 | MALUS 'CORALBURST' / CORALBURST CRABAPPLE | B & B | 1.5" CAL MIN | 12'-15' | 12'-15' |
| | PA | 11 | PRUNUS CERASIFERA CRIMSON POINTE / COLUMNAR PURPLE PLUM | B & B | 1.5" CAL MIN | 8'-10' | 20'-25' |
| | QM | 7 | QUERCUS MACROCARPA / BURR OAK | B & B | 2" CAL MIN | 50'-80' | 50'-80' |
| EVERGREEN TREES | CODE | QTY | BOTANICAL / COMMON NAME | CONT. SIZE | SIZE/CAL. | WIDTH | HEIGHT |
| | JSM | 10 | JUNIPERUS SCOPULORUM 'MOONGLOW' / MOONGLOW JUNIPER LOW ROOT DAMAGE POTENTIAL | B & B | 6" HGT. | 6'-8' | 12'-15' |
| | JSW | 8 | JUNIPERUS SCOPULORUM 'WICHITA BLUE' / WICHITA BLUE JUNIPER | B & B | 6" HGT. | 4'-6' | 15'-20' |
| | PE | 8 | PINUS EDULIS / PINON PINE | B & B | 6" HGT. | 10'-20' | 20'-30' |
| | PN | 6 | PINUS NIGRA / AUSTRIAN BLACK PINE | B & B | 6" HGT. | 30'-40' | 40'-60' |
| | PP | 12 | PINUS PONDEROSA / PONDEROSA PINE | B & B | 6" HGT. | 30'-40' | 60'+ |
| | PPB | 2 | PICEA PUNGENS 'BLUE DIAMOND' / BLUE DIAMOND DWARF SPRUCE | B & B | 6" HGT. | 5'-10' | 15'-20' |
| | PPF | 1 | PICEA PUNGENS 'FASTIGIATA' / FASTIGIATE BLUE SPRUCE | B & B | 6" HGT. | 10'-15' | 25'-40' |
| | PPG | 2 | PICEA PUNGENS 'GLAUCA' / COLORADO BLUE SPRUCE | B & B | 6" HGT. | 20'-30' | 40'-60' |
| GROUND COVERS | CODE | QTY | BOTANICAL / COMMON NAME | TYPE | INSTALL RATE | WEED FABRIC | MFR. |
| | BREEZE | 4,641 SF | BREEZE / CRUSHER FINES BREEZE COLOR TO VARY FROM TRAIL AND TO BE SELECTED BY OWNER/CONTRACTOR. | BREEZE | 4" | YES | PIONEER SAND & GRAVEL |
| | ROCK-A | 43,013 SF | ROCK MULCH A / ROCK MULCH AND PLANTINGS ROCK MULCH TYPE TO BE DECIDED BY OWNER/CONTRACTOR. ROCK MULCH TO BE PLANTED WITH SHRUBS AND GRASSES. | ROCK MULCH | 4" | YES | C&C SAND |
| | ROCK-B | 43,318 SF | ROCK MULCH B / ROCK MULCH AND PLANTINGS ROCK MULCH TYPE TO BE DECIDED BY OWNER/CONTRACTOR. ROCK MULCH TO BE PLANTED WITH SHRUBS AND GRASSES. | ROCK MULCH | 4" | YES | C&C SAND |
| | SEED | 4,825 SF | EPC LOW GROW MIX INSTALL PER TABLE 5-2. SUBMIT SUPPLIER CUT-SHEET FOR REVIEW AND APPROVAL PRIOR TO INSTALLATION. | SEED | PER CHART | | PAWNEE BUTTES SEED INC. |
| | SEED2 | 20,170 SF | EPC ALL PURPOSE MIX INSTALL PER TABLE 5-1. SUBMIT SUPPLIER CUT-SHEET FOR REVIEW AND APPROVAL PRIOR TO INSTALLATION. | SEED | PER CHART | | PAWNEE BUTTES SEED |
| | SOD | 18,175 SF | SURVIVALIST TALL FESCUE INSTALL PER DETAIL - 47% GRAND II TALL FESCUE, 47% SR8650 TALL FESCUE, 6% SPITFIRE TEXAS HYBRID | SOD | PER MFR. SPECS | | GREEN BELT TURF FARM |


Table 5-1. El Paso County Conservation District All-Purpose Mix for Upland, Transition and Permanent Central Measure Areas

| Common Name | Scientific Name | Growth Season / Form | % of Mix | Pounds PLS | | |
|--------------------------|------------------------|----------------------|----------|--------------------|----------------------|----------------------|
| | | | | Ingrated broadcast | Ingrated hydroseeded | Non-ingrated drilled |
| Bluestem, big | Andropogon gerardii | Warm, sod | 20 | 4.4 | 2.2 | 1.1 |
| Grass, blue | Bouteloua gracilis | Warm, bunch | 10 | 0.5 | 0.25 | 0.13 |
| Green needlegrass | Nassella viridula | Cool, bunch | 10 | 2 | 1 | 0.5 |
| Wheatgrass, western | Panicum smithii | Cool, sod | 20 | 6.4 | 3.2 | 1.6 |
| Grass, sidecoats | Bouteloua curtipendula | Warm, bunch | 10 | 2 | 1 | 0.5 |
| Switchgrass | Panicum virgatum | Warm, bunch/sod | 10 | 0.8 | 0.4 | 0.2 |
| Prairie sandreed | Calamagrostis Aleutica | Warm, sod | 10 | 1.2 | 0.6 | 0.3 |
| Yellow Indiangrass | Sorghastrum nutans | Warm, sod | 10 | 2 | 1 | 0.5 |
| Seed rate (lbs PLS/acre) | | | | 19.3 | 9.7 | 4.8 |

Table 5-2. El Paso County All-Purpose Low Grow Mix for Upland and Transition Areas

| Common Name | Scientific Name | Growth Season / Form | % of Mix | Pounds PLS | | |
|--------------------------|------------------------|----------------------|----------|--------------------|----------------------|----------------------|
| | | | | Ingrated broadcast | Ingrated hydroseeded | Non-ingrated drilled |
| Buffalograss | Bouteloua dactyloides | Warm, sod | 25 | 9.6 | 4.8 | 2.4 |
| Grass, blue | Bouteloua gracilis | Warm, bunch | 20 | 10.8 | 5.4 | 2.7 |
| Grass, sidecoats | Bouteloua curtipendula | Warm, bunch | 29 | 5.6 | 2.8 | 1.4 |
| Green needlegrass | Nassella viridula | Cool, bunch | 5 | 3.2 | 1.6 | 0.8 |
| Wheatgrass, western | Panicum smithii | Cool, sod | 20 | 12 | 6 | 3 |
| Droopseed, sand | Sporobolus cryptandrus | Warm, bunch | 1 | 0.8 | 0.4 | 0.2 |
| Seed rate (lbs PLS/acre) | | | | 42 | 21 | 10.3 |

 EPC APPROVAL:



K:\COCS_LAI196413002 - Mayberry Filing 5 Landscape\CADD\PlanSheets\DP_LA_dwg Sep 14, 2023 3:23pm



© 2023 KIMLEY-HORN AND ASSOCIATES, INC.
2 NORTH NEVADA AVENUE, SUITE 900
COLORADO SPRINGS, COLORADO 80903 (719) 453-0180