


CORRECTED CONDOMINIUM MAP OF HIGH ALTITUDE AERO HANGAR CONDOMINIUMS

A PORTION OF THE NORTHWEST QUARTER OF SECTION 4
TOWNSHIP 13 SOUTH, RANGE 64 WEST OF THE 6TH P.M.
COUNTY OF EL PASO, COLORADO

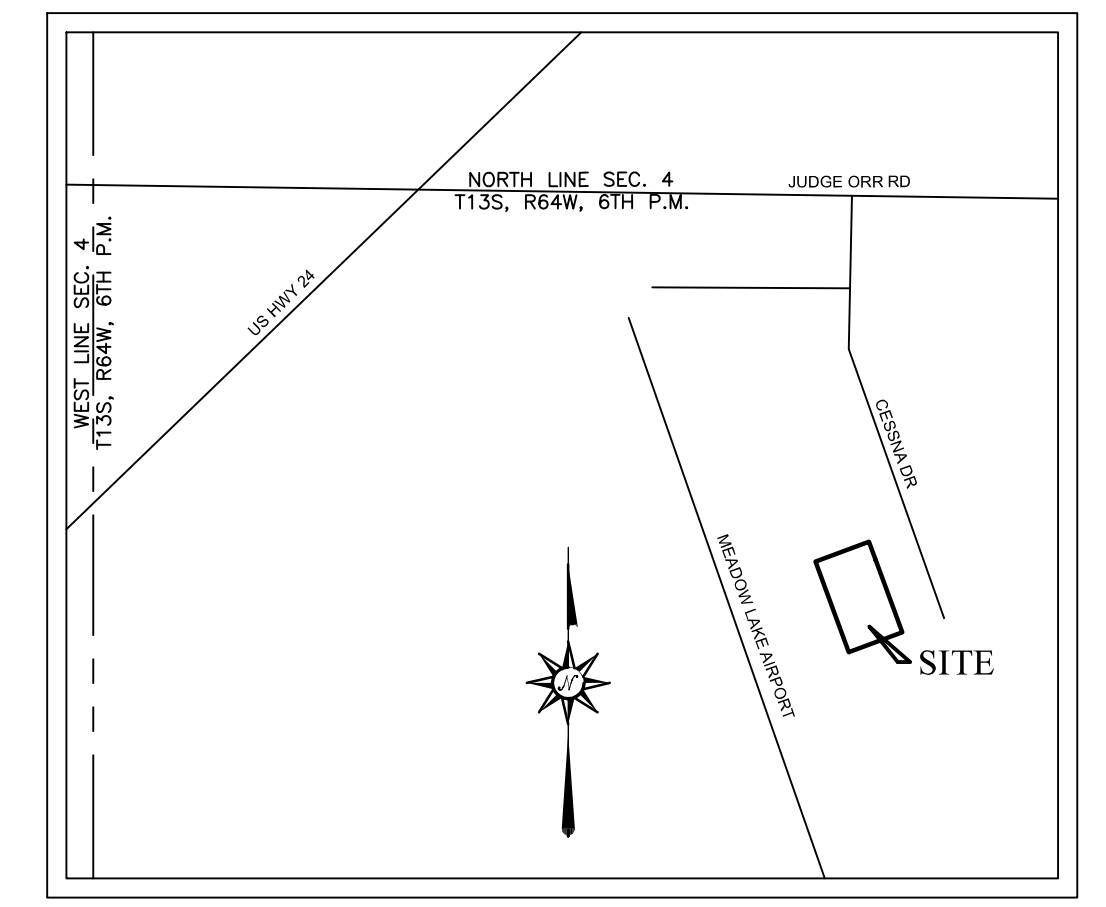


PLAT NOTES

- The entire property is subject to a Private Detention Basin/Stormwater Quality BMP Maintenance Agreement and Easement as recorded at Reception No. _____ of the records of El Paso County. The Owner, ALTITUDE AERO, LLC, is responsible for maintenance of the subject drainage facilities.
- The subdivider(s) agree on behalf of him/herself and any developer of builder successors and assigns that subdivider and/or said successors and assigns shall be required to pay traffic impact fees in accordance with the El Paso County Road Impact Fee Program (Resolution No. 19-471), or any amendments thereto, at or prior to the time of building permit submittals. The fee obligation, if not paid at final plat recording, shall be documents on all sales documents and in plat notes to ensure that a title search would find the fee obligation before sale of the property.

CONDOMINIUM NOTES

- The Property, and all portions thereof, shall be subject to all recorded licenses and easements including without limitation any as shown on any recorded plat affecting the Property, or any portion thereof, and as shown on this Condominium Map; additionally, the recording data for recorded easements and licenses appurtenant to or included in the Property, or which any portion of the Property is or may be subject by virtue of a reservation in the Condominium Declaration as recorded at Reception No. 224601052, Records of El Paso County. Each Owner and its Guests and tenants shall comply with any covenants or obligations recorded against the Property prior to the recording said Condominium Declaration.
- Subject to the provisions of this Declaration, each Owner and its Guests and tenants shall have a perpetual non-exclusive easement for the purpose of vehicular and pedestrian ingress and egress over, upon, and across the General Common Elements necessary for access to that Condominium Unit, to public or private streets, and to the Limited Common Elements designated for use in conjunction with that Condominium Unit, and each Owner shall have the right to the horizontal and vertical support of his Unit.
- The Association, its officers, agents and employees shall have a non-exclusive easement to make such use of and to enter into, upon, across, under or above the General Common Elements as may be necessary or appropriate to perform the duties and functions which it is permitted or required to perform pursuant to this Declaration or otherwise, including but not limited to the right to construct and maintain on the Common Elements any maintenance and storage facilities for use by the Association.
- If any General Common Elements are located within a Unit, or are conveniently accessible only through a Unit, the Association, its officers, agents or employees, shall have the right to enter such Unit after reasonable written notice during regular business hours, for the inspection, maintenance, repair and replacement of any of such General Common Elements or after service of such notice, if any, as is reasonable under the circumstances, at any time as may be necessary for making emergency repairs to prevent damage to the Common Elements or to another Unit or Units. Damage to any part of a Unit or Units resulting from the above-described repairs, shall be a common expense of all of the Owners, unless such damage is the result of the misuse or negligence of the Owner, his tenants or his Guests, in which case such Owner shall be responsible and liable for all of such damage and may be charged for any cost thereof by special assessment. No diminution or abatement of assessments shall be claimed or allowed for inconveniences or discomfort arising from the making of the above-described repairs or from action taken to comply with any law, ordinance or order of any governmental authority. Damaged improvements, fixtures or personal property shall be restored to substantially the same condition in which they existed prior to the damage.
- If any part of the Common Elements encroaches upon a Unit or Units, a valid easement for such encroachment and for the repair and maintenance of the same, so long as it stands, shall and does exist. If any portion of a Unit encroaches upon the Common Elements, or upon any adjoining Unit or Units, a valid easement for the encroachment and for the repair and maintenance of the same, so long as it stands, shall and does exist. In the event that a Building or Condominium Unit is partially or totally destroyed, and then rebuilt, the Owners agree that minor encroachments of parts of the Common Elements due to such construction shall be permitted and that a valid easement for said encroachments and the repair and maintenance thereof shall exist. Encroachments referred to herein include, but are not limited to, encroachments constructed by error in the construction of any Building or Unit constructed on the Property, by error in the Condominium Map, by setting, rising, or shifting of the earth, or by changes in position caused by repair or reconstruction of the Property or any part thereof. Such encroachments and easements shall not be considered or constructed to be encumbrances on the Common Elements or on the Condominium Units. In interpreting any and all provisions of this Condominium Declaration, subsequent deeds, mortgages, deeds of trust or other security instruments relating to Condominium Units, the actual location of a Condominium Unit shall be deemed conclusively to be the property intended to be conveyed, reserved or encumbered, notwithstanding any minor deviations, either horizontally, vertically or laterally from the location of such Condominium Unit as indicated on the Condominium Map.
- Declarant reserves the right to create, grant and transfer non-exclusive easements in, under, over, across, through, and upon the Property and the General Common Elements for the purpose of installing, maintaining, repairing and replacing any utilities, including but not limited to gas, electric, water, sewer and telephone and cable television lines, any heating or cooling installations, any cable, telephone, or master television antenna system and any other necessary and related facilities. The foregoing easements shall include the right of ingress and egress and the right to erect and maintain the necessary pipes, wires, lines, poles and other equipment. Should any person or party furnishing a service covered by the general easement herein above described request a specific easement by separate recordable document, Declarant shall have the right to grant such easement without conflicting with the terms hereof. The foregoing easements shall not affect any other recorded easement on the Property, including but not limited to any easements granted in the Condominium Map. Furthermore, easements are hereby declared and granted to install, lay, maintain, repair and replace any pipes, wires, ducts, conduits, public utility lines or structural components running through the General Common Elements, subject to the right to repair and restore any damage caused by such installations.
- No changes shall be made by any Owner, tenant or Guest in the exterior appearance of a Unit and/or Building without the prior written consent of the Architectural Control Committee ("Committee"), which shall be appointed by the Board; such changes shall include without limitation, any painting or repainting, any roofing or reroofing, any changes as to exterior doors, windows, window coverings, signage, trim, or any other exterior improvement and any other change, addition or deletion of any item, whether within or outside the Building and/or Unit which is visible from the outside of the Building and/or Unit, as determined by the Committee.
- No building, fence, wall or other structure shall be commenced, erected or maintained upon the Common Elements, nor shall an addition to, or change or alteration thereto or to any Unit be made until the plans and specifications showing the nature, shape, height, material and location of the same shall have been submitted to and approved in writing by the Committee as to harmony of external design and location in relation to surrounding structures and topography. In the event the Committee fails to approve or disapprove such plans and specifications within sixty (60) days after they have been submitted to it and have been received for in writing by the Association's President, approval will not be required, and this Section will be deemed to have been fully complied with.
- No structures of a temporary character, trailer, storage facility, tent, shack, garage, barn or other out-buildings shall be constructed on any portion of the Property without the Committee's prior written approval, either temporarily or permanently.
- No Owner shall undertake any work in his Unit which would jeopardize the safety of the Property, reduce the value thereof or impair an easement thereon or thereto, nor shall any Owner enclose, by means of screening or otherwise, any Common Element including without limitation, any yard, balcony, patio or porch which is accessible from, associated with and which adjoins a Unit, without having first obtained the prior written approval of the Committee with respect to the materials, design and specifications for such enclosure, as more particularly provided in this paragraph.
- Nothing shall be done or kept in any Unit, or in the Common Elements, or any part thereof, which would result in any violation of this Declaration and/or the Rules or in the cancellation of any insurance on the Property, or in an increase in the rate of any insurance on the Property, without the prior written consent of the Board. No part of the Property or of any Condominium Unit shall be used in any way or for any purpose which may endanger the health, safety or life of any person or which may unreasonably disturb any other Owner. No activities shall be permitted upon any portion of the Property which will violate the provisions of any applicable statute, ordinance, regulation, permit, or other validly imposed requirement of any governmental body. No nuisance shall be allowed upon the Property, nor shall any use or practice be allowed which is a source of annoyance to Owners, or which interferes with the peaceful possession and proper use of the Property by Owners and Guests. No damage to or waste of the Common Elements, or any part thereof, or any Unit, shall be committed by any Owner, or any Guest of any Owner, and each Owner shall indemnify and hold the Association and the other Owners harmless against any loss resulting from any such damage or waste caused by such Owners or their Guests. No excessive noise, odors or disturbance shall be allowed upon the Property as determined by the Board in its reasonable discretion.
- High Altitude Aero Hangar Condominiums, Inc. is formed in Articles of Incorporation recorded at Reception No. 224601052, Records of El Paso County.

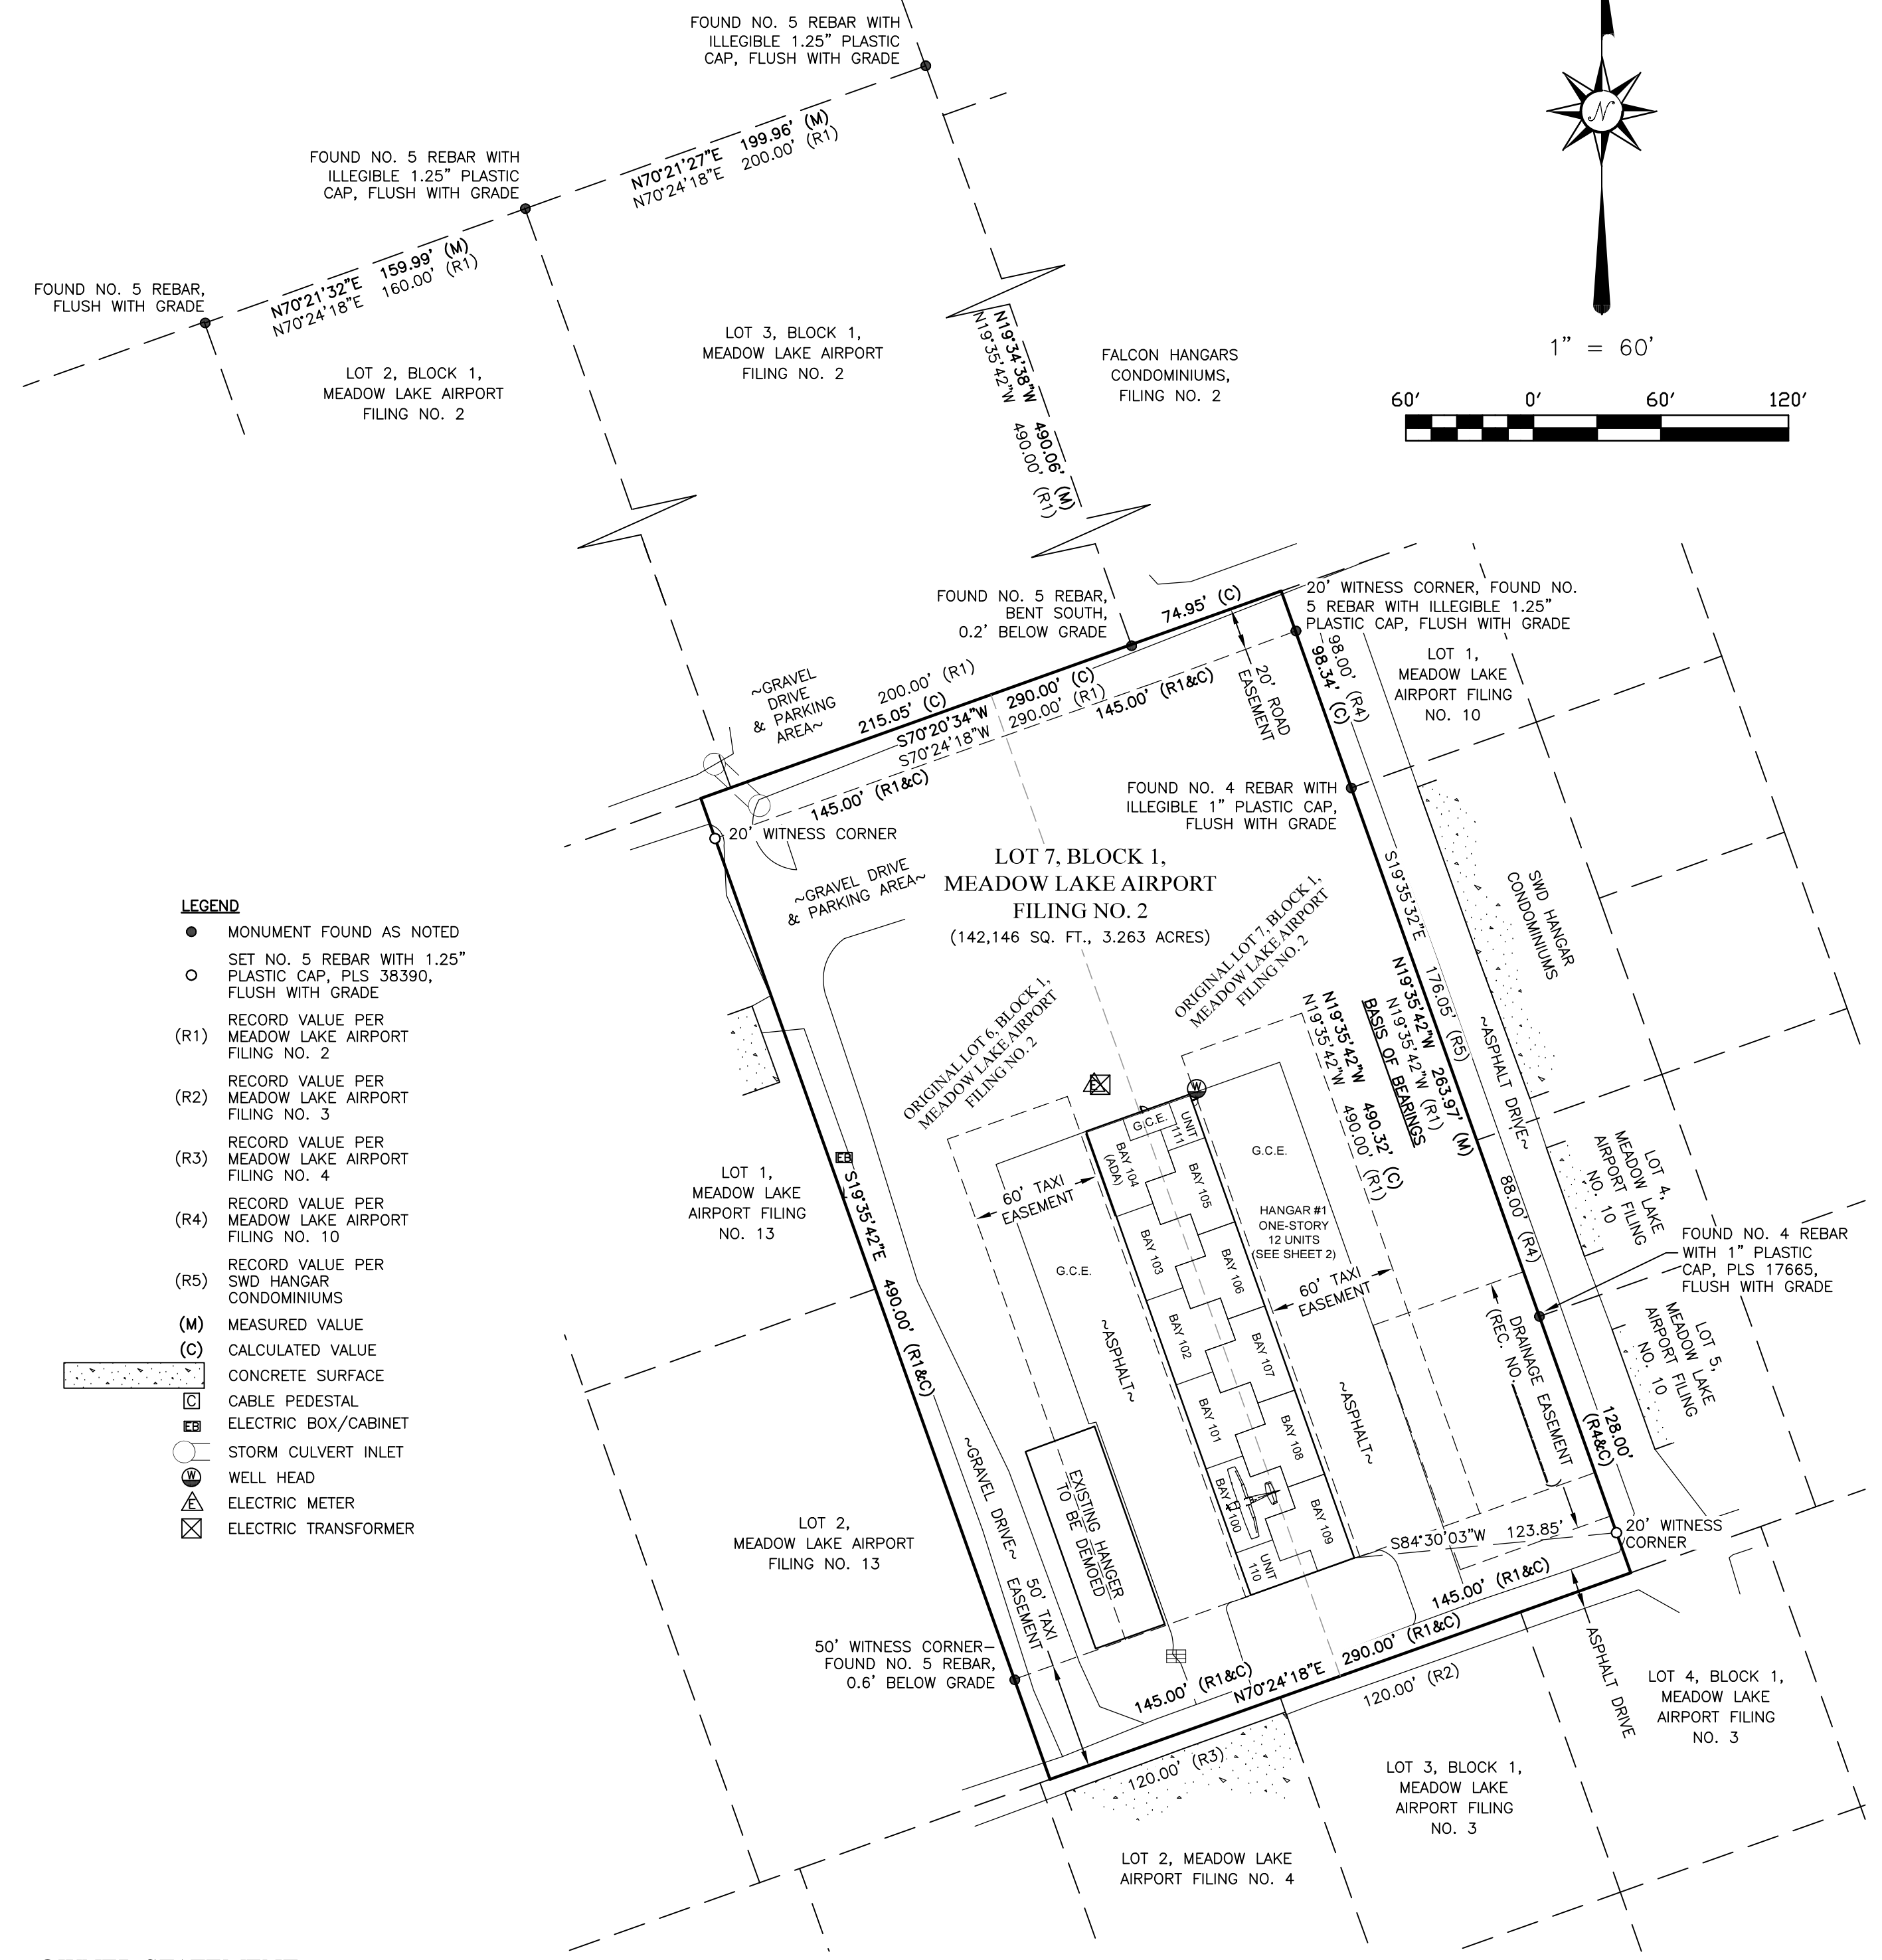

OWNER STATEMENT:

ALTITUDE AERO, LLC as owner of the property described hereon, does hereby state that this Condominium Map is in accordance with the direction and desire of _____

By: _____

Print Name: Ryan Schneider

Print Title: Managing Member

NOTARIAL:

STATE OF COLORADO }
COUNTY OF EL PASO } ss.

The foregoing instrument was acknowledged before me this _____ day of _____, 2024 by _____ as _____ of _____ a _____

Witness my hand and seal:

My Commission expires _____

Notary Public _____

PLANNING COMMUNITY DEVELOPMENT APPROVAL:

On behalf of the El Paso County Planning Community Development Department, the undersigned hereby approve for filing the accompanying plat of "HIGH ALTITUDE AERO HANGAR CONDOMINIUMS".

PCD Director _____

PARENT PARCEL LEGAL DESCRIPTION

Lot 7, Block 1, MEADOW LAKE AIRPORT FILING NO. 2, County of El Paso, State of Colorado.

(Per Title Commitment 2309365, with an effective date of April 22, 2024 at 8:00AM as provided by Stewart Title Guaranty Company.)

Note: The original Lots 6 and 7, Block 1, Meadow Lake Airport Filing No. 2 were combined by Resolution No. 84-65, Land Use-38 recorded June 4, 1984 in Book 3878 at Page 153, El Paso County Records.

PARENT PARCEL DETAILS

Address: 8140 Cessna Drive, Peyton, Colorado

El Paso County Schedule No: 430402086

SURVEYOR'S NOTES

- NOTICE: According to Colorado law you must commence any legal action based upon any defect in this survey within three years after you first discover such defect. In no event may any action based upon any defect in this survey be commenced more than ten years from the date of the certification shown hereon.
- Any person who knowingly removes, alters or defaces any public land survey monument or land boundary monument or accessory corner a class 2 misdemeanor pursuant to the Colorado Revised Statute 18-4-508.
- The lineal units used in this drawing are U.S. Survey Feet.
- The fieldwork for this survey was completed on January 22, 2024.
- The overall parent parcel contains a calculated area of 142,146 square feet (3.263 acres) of land, more or less.
- For information regarding easements, rights-of-way and title of record, Forth Land Surveying, Inc. relied upon Title Commitment 2309365, with an effective date of April 22, 2024 at 8:00AM as provided by Stewart Title Guaranty Company.
- Bearings are based on the westerly line of SWD Hangar Condominiums and Lot 4 of Meadow Lake Airport Filing No. 10, monumented on the southerly end by a No. 4 rebar with 1" plastic cap, PLS 17665, and on the northerly end by a No. 4 rebar with illegible 1" plastic cap, and bears N19°35'42"W a measured distance of 263.97 feet per an averaged 30 GPS RTK fixed observations.
- Any underground or above ground utilities shown hereon have been located from field survey information. Forth Land Surveying, Inc. does not guarantee said underground utilities to be shown in their exact location and that said underground utilities are shown in their entirety. Forth Land Surveying, Inc. did not physically enter any manholes or inlets to verify size and material. Where additional or more detailed information is required, the client is advised that excavation may be necessary.
- The Federal Emergency Management Agency, Flood Insurance Rate Map No. 08041C0554G, effective date 12/7/2018, indicates this parcel of land to be located in Zone X (Areas determined outside the 500-year floodplain).

SURVEYOR'S STATEMENT

The undersigned Colorado Registered Professional Land Surveyor does hereby state and declare to Altitude Aero LLC, Managing Member Ryan Schneider, that the accompanying plat was surveyed and drawn under his direct responsibility and supervision and to the normal standard of practice by surveyors in the State of Colorado and accurately shows the described tract of land thereon, and that the requirements of Title 38 of the Colorado Revised Statutes, 1973, as amended, have been met to the best of his professional knowledge, belief and opinion.

Cameron Forth
State of Colorado Professional Land Surveyor No. 38390
For and on behalf of Forth Land Surveying, Inc.

DEPOSITING CERTIFICATION

Deposited this _____ day of _____, A.D. 2024 at _____ o'clock _____ M. in Book _____ of Land Survey Plats, at Page(s) _____ Deposit Number _____ of the records of _____ the Clerk and Recorder's Office of El Paso County, Colorado.

By: Deputy _____

No.	Remarks	Date	By
3	Added vicinity map, title, cert, edited notes	4/29/24	CEF
4	Changed condo name, corrected areas of bays	7/10/24	CEF
5	Revised per County comments	10/18/24	CEF

DATE: February 23, 2024 REVISIONS

Field: TEC/CEF Drawn: TEC/CEF Checked: CEF

FORTH LAND SURVEYING, INC.
1586 S. 21st Street, Suite 10
Colorado Springs, CO 80904
Phone: 719-722-7446
E-mail: Cameron@ForthLS.com
Website: www.ForthLS.com

PROJECT No.: 24000 SHEET 1 OF 2

