



April 10, 2023

El Paso County  
Planning & Community Development  
2880 International Circle, Suite 110  
Colorado Springs, CO 80910

Attn.: Project Manager

RE: The Ridge at Lorson Ranch Filing No. 1 (SF 22-004)  
Private Stormwater Quality Pond F  
As-built Certification


Dear Project Manager:

Per the approved construction drawings for The Ridge at Lorson Ranch Filing No.1 (PUD/SP 21-006 and SF 22-004), improvements were made to construct one water quality facility in compliance with the current El Paso County Drainage Criteria and the approved Final Drainage Report for this project.

Based upon this information and periodic site visits by field personnel to the project during significant/key phases of the stormwater BMP installation, Core Engineering Group, LLC is of the opinion that the detention and stormwater BMPs have been constructed in general compliance with the approved design plans and specifications as filed with El Paso County.

Statement Of Engineer of Record

To the best of my knowledge, information and belief, for the referenced project above, the improvements have been constructed in general compliance with the approved design plans and specifications as filed with El Paso County.

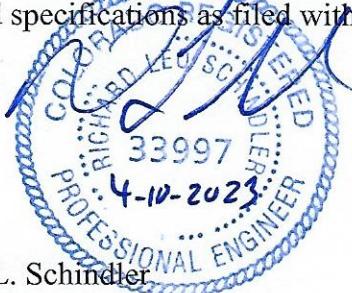

Richard L. Schindler  
Colorado P.E. No.33997  
For and on behalf of Core Engineering Group, LLC


Attachments: Water Quality Pond F As-Built Drawings

# DETENTION BASIN OUTLET STRUCTURE DESIGN

MHFD-Detention, Version 4.02 (February 2020)

**Project:** The Ridge at Lorson Ranch

**Basin ID:** Pond F-asbuilt

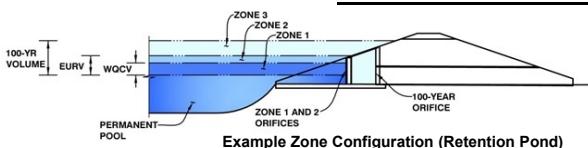

	Estimated Stage (ft)	Estimated Volume (ac-ft)	Outlet Type
Zone 1 (WQCV)	2.11	0.090	Orifice Plate
Zone 2 (EURV)	3.57	0.200	Rectangular Orifice
Z3 (100+1/2WQCV)	4.83	0.246	Weir&Pipe (Restrict)
Total (all zones)		0.537	

User Input: Orifice at Underdrain Outlet (typically used to drain WQCV in a Filtration BMP)

Underdrain Orifice Invert Depth =	N/A	ft (distance below the filtration media surface)
Underdrain Orifice Diameter =	N/A	inches

Calculated Parameters for Underdrain

Underdrain Orifice Area =	N/A	ft <sup>2</sup>
Underdrain Orifice Centroid =	N/A	feet

User Input: Orifice Plate with one or more orifices or Elliptical Slot Weir (typically used to drain WQCV and/or EURV in a sedimentation BMP)

Invert of Lowest Orifice =	0.00	ft (relative to basin bottom at Stage = 0 ft)
Depth at top of Zone using Orifice Plate =	2.11	ft (relative to basin bottom at Stage = 0 ft)
Orifice Plate: Orifice Vertical Spacing =	N/A	inches
Orifice Plate: Orifice Area per Row =	0.37	sq. inches (diameter = 11/16 inch)

Calculated Parameters for Plate

WQ Orifice Area per Row =	2.569E-03	ft <sup>2</sup>
Elliptical Half-Width =	N/A	feet
Elliptical Slot Centroid =	N/A	feet
Elliptical Slot Area =	N/A	ft <sup>2</sup>

User Input: Stage and Total Area of Each Orifice Row (numbered from lowest to highest)

Row 1 (required)	Row 2 (optional)	Row 3 (optional)	Row 4 (optional)	Row 5 (optional)	Row 6 (optional)	Row 7 (optional)	Row 8 (optional)
Stage of Orifice Centroid (ft)	0.00	0.80	1.55				
Orifice Area (sq. inches)	0.37	0.37	0.37				
Row 9 (optional)	Row 10 (optional)	Row 11 (optional)	Row 12 (optional)	Row 13 (optional)	Row 14 (optional)	Row 15 (optional)	Row 16 (optional)
Stage of Orifice Centroid (ft)							
Orifice Area (sq. inches)							

User Input: Vertical Orifice (Circular or Rectangular)

Zone 2 Rectangular	Not Selected	
Invert of Vertical Orifice =	2.35	N/A
Depth at top of Zone using Vertical Orifice =	3.57	N/A
Vertical Orifice Height =	1.00	N/A
Vertical Orifice Width =	12.00	inches

Calculated Parameters for Vertical Orifice
Zone 2 Rectangular
Vertical Orifice Area = 0.08 ft <sup>2</sup>
Vertical Orifice Centroid = 0.04 N/A feet

User Input: Overflow Weir (Dropbox with Flat or Sloped Grate and Outlet Pipe OR Rectangular/Trapezoidal Weir (and No Outlet Pipe))

Zone 3 Weir	Not Selected	
Overflow Weir Front Edge Height, H <sub>o</sub> =	3.36	N/A
Overflow Weir Front Edge Length =	6.00	N/A
Overflow Weir Grate Slope =	0.00	N/A
Horiz. Length of Weir Sides =	3.00	N/A
Overflow Grate Open Area % =	50%	N/A
Debris Clogging % =	50%	%

Calculated Parameters for Overflow Weir
Zone 3 Weir
Height of Grate Upper Edge, H <sub>r</sub> = 3.36 N/A feet
Overflow Weir Slope Length = 3.00 N/A feet
Grate Open Area / 100-yr Orifice Area = 5.09 N/A
Overflow Grate Open Area w/o Debris = 9.00 N/A ft <sup>2</sup>
Overflow Grate Open Area w/ Debris = 4.50 N/A ft <sup>2</sup>

User Input: Outlet Pipe w/ Flow Restriction Plate (Circular Orifice, Restrictor Plate, or Rectangular Orifice)

Zone 3 Restrictor	Not Selected	
Depth to Invert of Outlet Pipe =	0.05	N/A
Outlet Pipe Diameter =	18.00	N/A
Restrictor Plate Height Above Pipe Invert =	18.00	inches

Calculated Parameters for Outlet Pipe w/ Flow Restriction Plate
Zone 3 Restrictor
Outlet Orifice Area = 1.77 ft <sup>2</sup>
Outlet Orifice Centroid = 0.75 N/A feet
Half-Central Angle of Restrictor Plate on Pipe = 3.14 N/A radians

User Input: Emergency Spillway (Rectangular or Trapezoidal)

Spillway Invert Stage=	4.31	ft (relative to basin bottom at Stage = 0 ft)
Spillway Crest Length =	10.00	feet
Spillway End Slopes =	4.00	H:V
Freeboard above Max Water Surface =	0.50	feet

Calculated Parameters for Spillway
Spillway Design Flow Depth= 0.44 feet
Stage at Top of Freeboard = 5.25 feet
Basin Area at Top of Freeboard = 0.22 acres
Basin Volume at Top of Freeboard = 0.63 acre-ft

Routed Hydrograph Results

The user can override the default CUHP hydrographs and runoff volumes by entering new values in the Inflow Hydrographs table (Columns W through AF).


	WQCV	EURV	2 Year	5 Year	10 Year	25 Year	50 Year	100 Year	500 Year
Design Storm Return Period =									
One-Hour Rainfall Depth (in) =	N/A	N/A	1.19	1.50	1.75	2.00	2.25	2.52	3.14
CUHP Runoff Volume (acre-ft) =	0.090	0.290	0.270	0.379	0.474	0.597	0.699	0.827	1.089
Inflow Hydrograph Volume (acre-ft) =	N/A	N/A	0.270	0.379	0.474	0.597	0.699	0.827	1.089
CUHP Predevelopment Peak Q (cfs) =	N/A	N/A	0.3	1.0	1.5	2.8	3.5	4.5	6.3
OPTIONAL Override Predevelopment Peak Q (cfs) =	N/A	N/A							
Predevelopment Unit Peak Flow, q (cfs/acre) =	N/A	N/A	0.07	0.20	0.31	0.57	0.72	0.92	1.29
Peak Inflow Q (cfs) =	N/A	N/A	3.2	4.5	5.5	7.4	8.6	10.2	13.3
Peak Outflow Q (cfs) =	0.0	2.3	0.4	1.4	2.6	4.6	6.0	8.0	11.3
Ratio Peak Outflow to Predevelopment Q =	N/A	N/A	N/A	1.5	1.7	1.6	1.7	1.8	1.8
Structure Controlling Flow =	Plate	Overflow Weir 1	Vertical Orifice 1	Overflow Weir 1					
Max Velocity through Grate 1 (fps) =	N/A	0.30	N/A	0.1	0.2	0.5	0.6	0.8	1.2
Max Velocity through Grate 2 (fps) =	N/A	N/A	N/A	N/A	N/A	N/A	N/A	N/A	N/A
Time to Drain 97% of Inflow Volume (hours) =	46	53	54	52	49	47	45	42	38
Time to Drain 99% of Inflow Volume (hours) =	49	60	62	61	60	58	57	55	52
Maximum Ponding Depth (ft) =	2.11	3.57	3.13	3.47	3.54	3.64	3.70	3.78	3.89
Area at Maximum Ponding Depth (acres) =	0.10	0.17	0.15	0.17	0.17	0.17	0.18	0.18	0.19
Maximum Volume Stored (acre-ft) =	0.090	0.291	0.220	0.272	0.284	0.301	0.312	0.326	0.348

## DETENTION BASIN STAGE-STORAGE TABLE BUILDER

*MHFD-Detention, Version 4.02 (February 2020)*

## **Project: The Ridge at Lorson Ranch**

Basin ID: Pond F-asbuilt

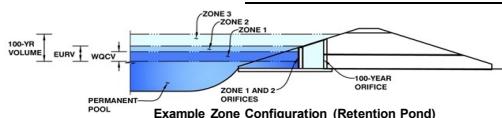

#### **Example Zone Configuration (Retention Pond)**

## Watershed Information

Selected BMP Type =	<b>EDB</b>
Watershed Area =	4.90 acres
Watershed Length =	900 ft
Watershed Length to Centroid =	450 ft
Watershed Slope =	0.009 ft/ft
Watershed Impermeability =	55.00% percent
Percentage Hydrologic Soil Group A =	0.0% percent
Percentage Hydrologic Soil Group B =	100.0% percent
Percentage Hydrologic Soil Groups C/D =	0.0% percent
Target WQWC Drain Time =	40.0 hours
Location for 1-in Rainfall Depth =	Urban Runoff

After providing required inputs above including 1-hour rainfall depths, click 'Run CUHP' to generate runoff hydrographs using the embedded Colorado Urban Hydrograph Procedure.

The Unchecked Colorado Catch-ment Runoff Procedure		Optional User Overrides
Water Quality Capture Volume (WQCV) =	0.090	acre-feet
Excess Urban Runoff Volume (EURV) =	0.290	acre-feet
2-yr Runoff Volume ( $P_1 = 1.19 \text{ in.}$ ) =	0.270	acre-feet
5-yr Runoff Volume ( $P_1 = 1.5 \text{ in.}$ ) =	0.379	acre-feet
10-yr Runoff Volume ( $P_1 = 1.75 \text{ in.}$ ) =	0.474	acre-feet
25-yr Runoff Volume ( $P_1 = 2 \text{ in.}$ ) =	0.597	acre-feet
50-yr Runoff Volume ( $P_1 = 2.25 \text{ in.}$ ) =	0.699	acre-feet
100-yr Runoff Volume ( $P_1 = 2.5 \text{ in.}$ ) =	0.827	acre-feet
500-yr Runoff Volume ( $P_1 = 3.14 \text{ in.}$ ) =	1.089	acre-feet
Approximate 2-yr Detention Volume =	0.221	acre-feet
Approximate 5-yr Detention Volume =	0.301	acre-feet
Approximate 10-yr Detention Volume =	0.393	acre-feet
Approximate 25-yr Detention Volume =	0.427	acre-feet
Approximate 50-yr Detention Volume =	0.446	acre-feet
Approximate 100-yr Detention Volume =	0.492	acre-feet

### Define Zones and Basin Geometry

Zone 1 Volume (WQCV) =	0.090	acre-feet
Zone 2 Volume (EURV - Zone 1) =	0.200	acre-feet
Zone 3 (100yr / 1 + 2 WQCV - Zones 1 & 2) =	0.246	acre-feet
Total Detention Basin Volume =	0.537	acre-feet
Initial Surcharge Volume (ISV) =	user	ft <sup>3</sup>
Initial Surcharge Depth (ISD) =	user	ft
Total Available Detention Depth ( $H_{total}$ ) =	user	ft
Depth of Trickle Channel ( $H_{trick}$ ) =	user	ft
Slope of Trickle Channel ( $S_{trick}$ ) =	user	ft/ft
Slopes of Main Basin Sides ( $S_{main}$ ) =	user	H:V
Basin Length-to-Width Ratio ( $R_{L/W}$ ) =	user	
 Initial Surcharge Area ( $A_{ISV}$ ) =	user	ft <sup>2</sup>
Surcharge Volume Length ( $L_{ISV}$ ) =	user	ft
Surcharge Volume Width ( $W_{ISV}$ ) =	user	ft
Depth of Basin Floor ( $H_{FLOOR}$ ) =	user	ft
Length of Basin Floor ( $L_{FLOOR}$ ) =	user	ft
Width of Basin Floor ( $W_{FLOOR}$ ) =	user	ft
Area of Basin Floor ( $A_{FLOOR}$ ) =	user	ft <sup>2</sup>
Volume of Basin Floor ( $V_{FLOOR}$ ) =	user	ft <sup>3</sup>
Depth of Main Basin ( $H_{MAIN}$ ) =	user	ft
Length of Main Basin ( $L_{MAIN}$ ) =	user	ft
Width of Main Basin ( $W_{MAIN}$ ) =	user	ft
Area of Main Basin ( $A_{MAIN}$ ) =	user	ft <sup>2</sup>
Volume of Main Basin ( $V_{MAIN}$ ) =	user	ft <sup>3</sup>
 Calculated Total Basin Volume ( $V_{total}$ ) =	user	acre-feet

top micropool-5842.61

**CORE**  
ENGINEERING GROUP  
15004 1ST AVENUE S.  
BURNSVILLE, MN 55306  
PH: 719.570.1100  
EMAIL: Rich@cg1.com

15004 1ST AVENUE S.  
BURNSVILLE, MN 55306  
PH: 719.570.1100  
CONTACT: RICHARD L. SCHINDLER, P.E.  
EMAIL: Rich@cg1.com

NO. 1. PREPARED FOR

NO. 1. PROJECT:

NO. 1. DRAWN:

NO. 1. DESIGNED:

NO. 1. CHECKED:

DATE: NOV 30, 2021

DESCRIPTION: FOREBAY SECTION A-A


DESCRIPTION: FOREBAY SECTION B-B

DESCRIPTION: CONCRETE LOW FLOW CHANNEL

DESCRIPTION: WQ POND F AS-BUILT

DESCRIPTION: POND STRUCTURES AND TRICKLE CHANNEL

DESCRIPTION: CORE ENGINEERING GROUP

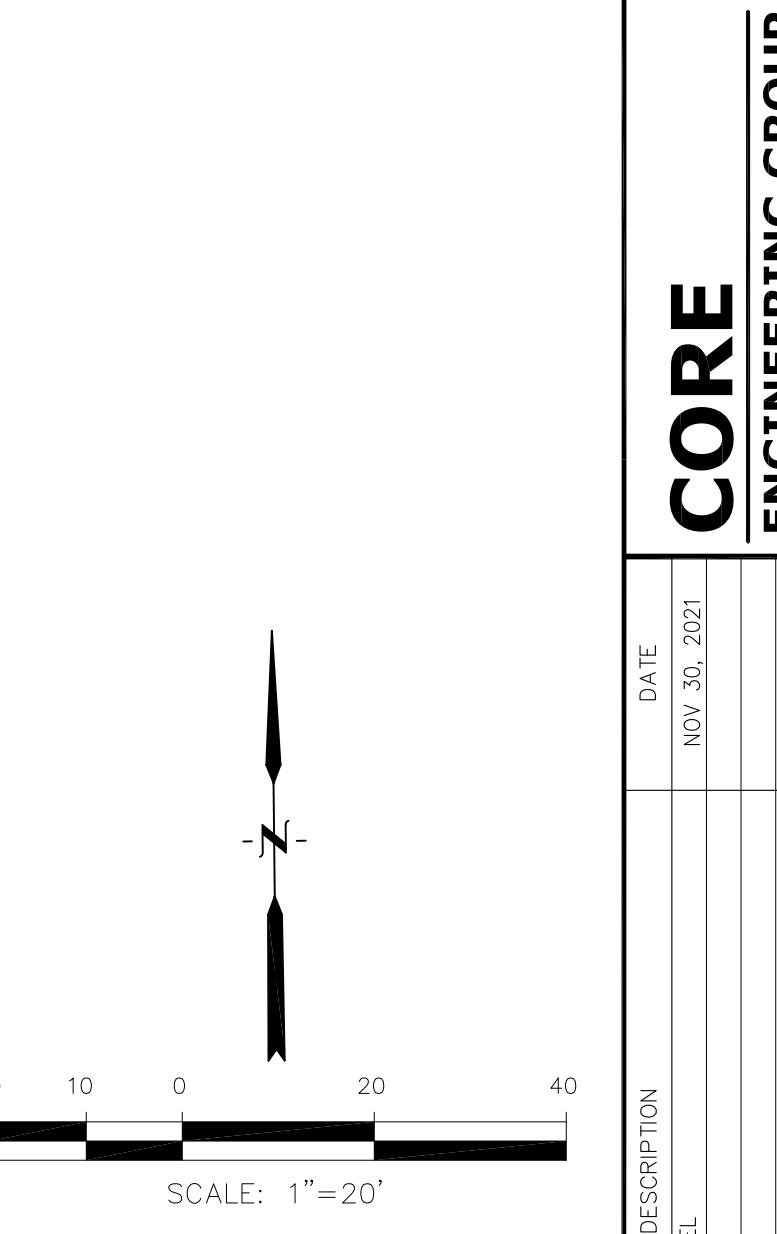

SCALE: 1"=20'

PREPARED FOR LORSON, LLC

212 N. WAHATCH AVE, SUITE 301

COLORADO SPRINGS, COLORADO 80903

CONTACT: JEFF MARK

DATE: NOV 30, 2021

DESCRIPTION: FOREBAY DETAIL

NO SCALE

NOTE:

1. POND SLOPES SHALL BE 4:1 UNLESS OTHERWISE NOTED
2. STRAW ECB SHALL BE PLACED ON ALL POND SIDE SLOPES UNLESS NOTED OTHERWISE

TYPE M SOIL RIP RAP 18" THICK 5' WIDE, 20' LONG

3-BAR RAIL (POWDERCOAT BROWN)

18" RCP INV=5844.50 44.34

FL 5843.72

43.74

1.0%

FL 5843.60 43.63

4.3" NOTCH IN WALL

SLOPE DRAIN

TW 5845.60 BW 5843.65

1.0%

FL 5845.60 BW 5843.65

4.3" NOTCH IN WALL

SLOPE DRAIN

TW 5845.60 BW 5843.65

1.0%

FL 5845.60 BW 5843.65

4.3" NOTCH IN WALL

SLOPE DRAIN


TW 5845.60 BW 5843.65

1.0%

FL 5845.60 BW 5843.65

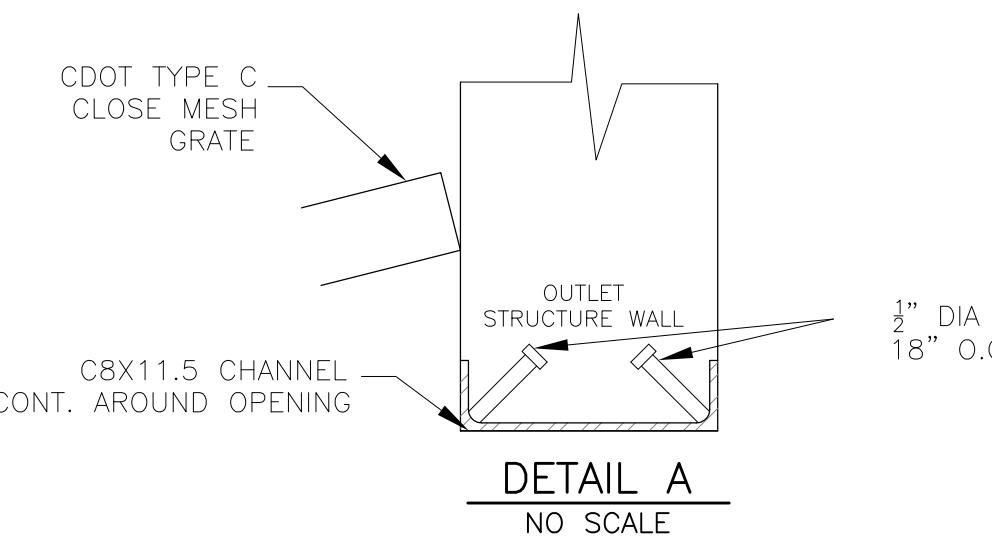


NOTE:  
AFTER CONCRETE STRUCTURE HAS BEEN POURED  
ALL GRATE DIMENSIONS SHALL BE FIELD VERIFIED  
PRIOR TO GRATE CONSTRUCTION

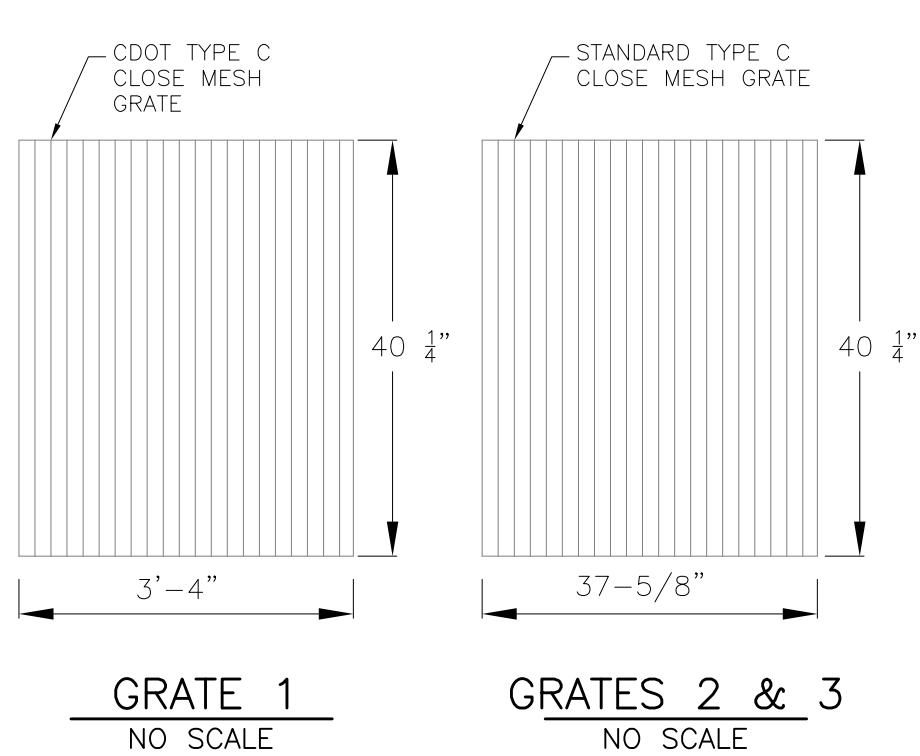


# OUTLET STRUCTURE DETAIL – PLAN VIEW

NO SCALE

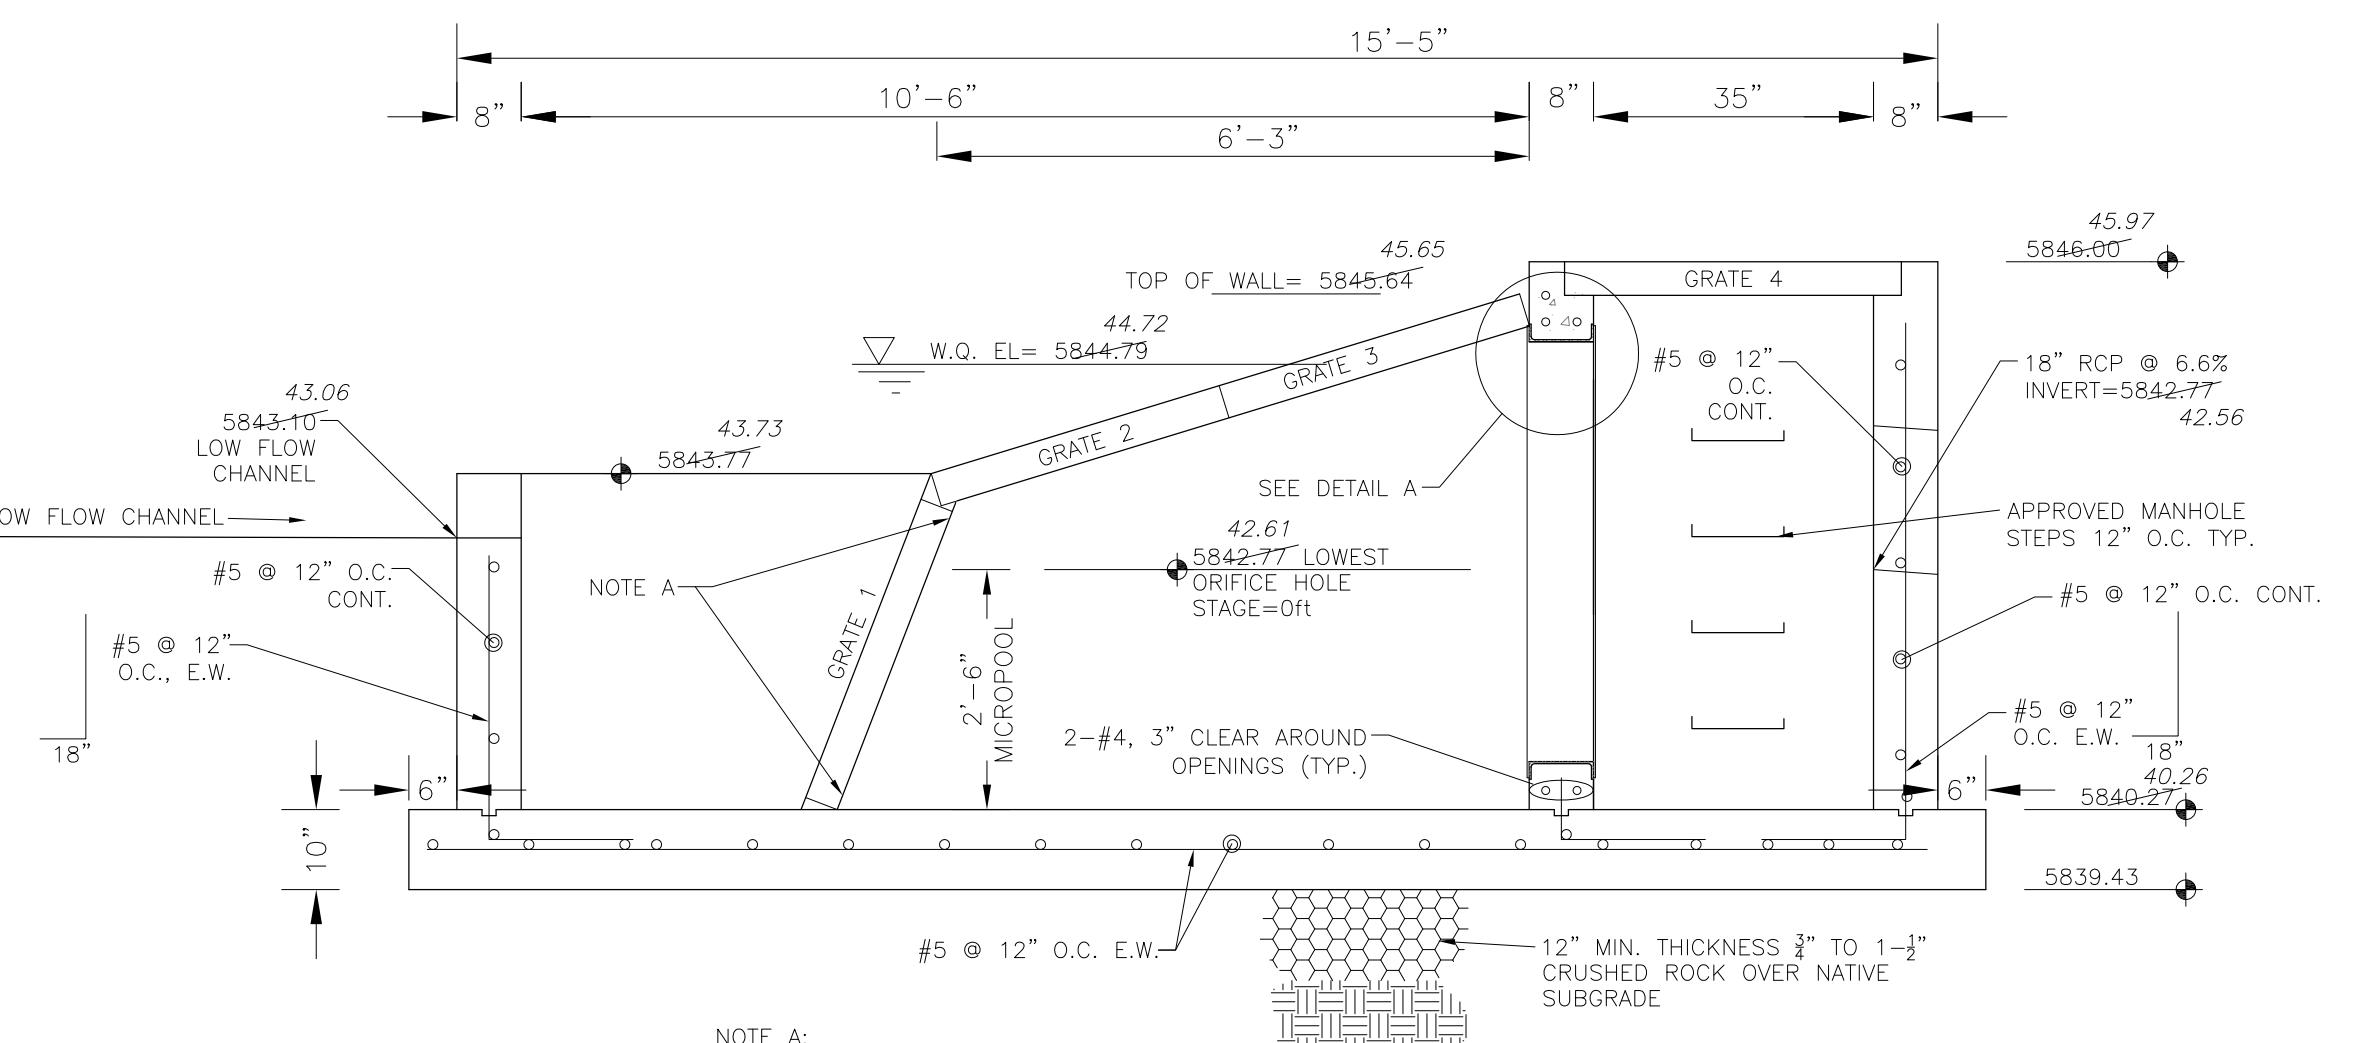

OUTLET STRUCTURE DETAIL - SECTION A-A

NO SCALE

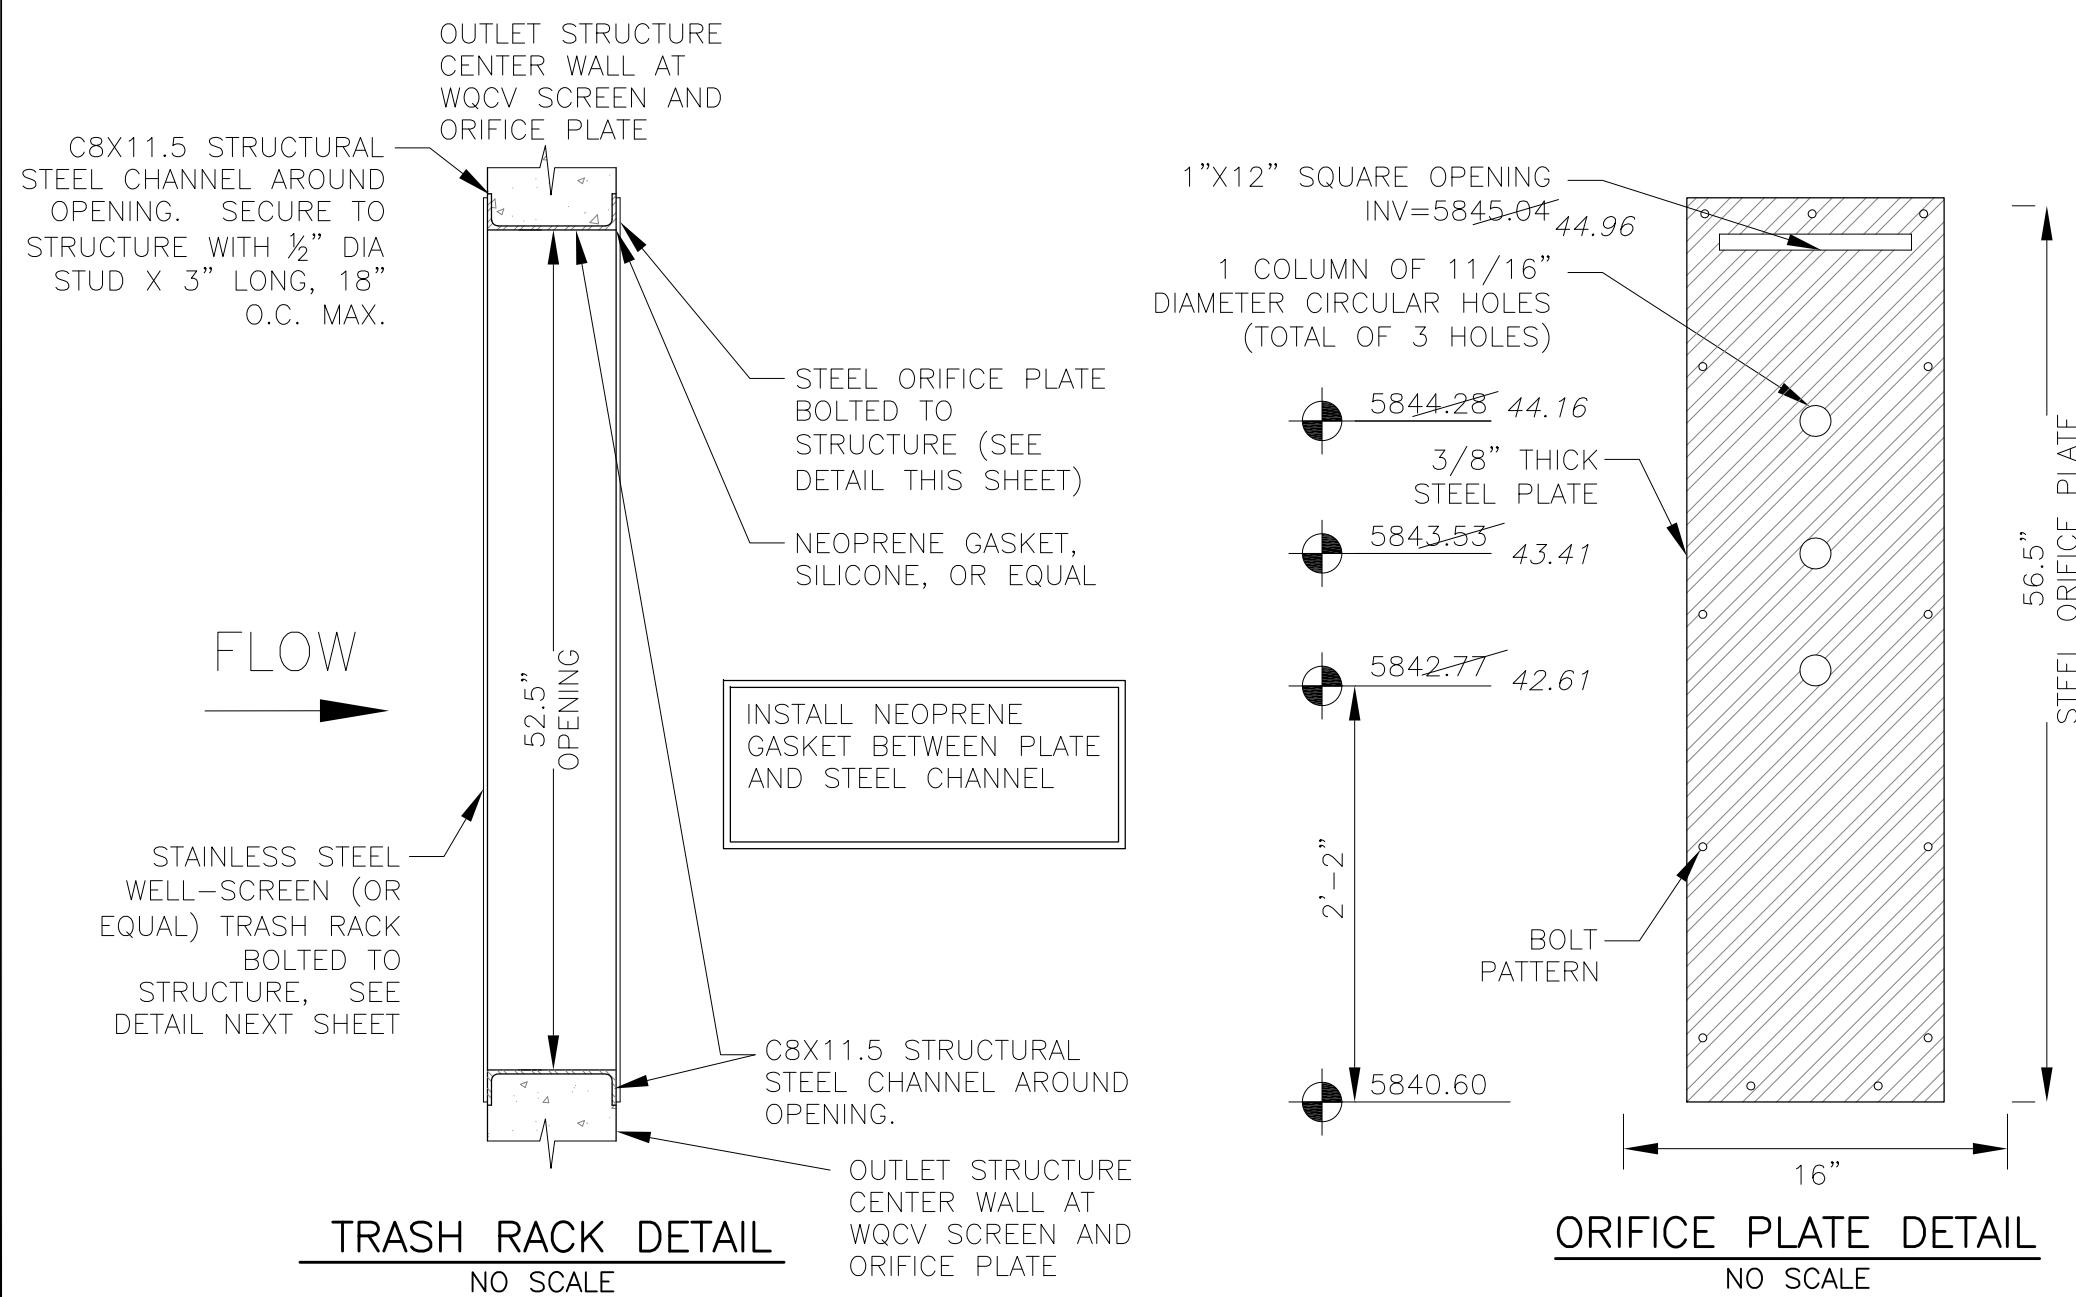

## OUTLET STRUCTURE, FOREBAY, AND DRAIN CHANNEL NOTES:


- |                      |       |       |       |
|----------------------|-------|-------|-------|
| BAR SIZE             | #4    | #5    | #6    |
| MIN. SPLICING LENGTH | 1'-3" | 1'-7" | 2'-0" |

## WQCV WELL-SCREEN NOTES:

1. Well-Screen shall be stainless steel and attached by stainless steel bolts along edge of the mounting frame.
  2. WQCV Well Screen
    - Type of Screen: Stainless steel #93 Vee Wire  
(Johnson Vee Wire (tm) Stainless Steel Screen or equivalent with 60% open area)
    - Screen slot opening dimension: 0.139" (Screen #93 Vee Wire Slot Opening)
    - Type and Size of Support Rod: TE 0.074"X0.50"
    - Spacing of Support Rod (O.C.): 1.0 Inch
    - Total Screen Thickness: 0.655"
    - Carbon Steel Holding Frame Type: 3/4" x 1.0" angle

# AS-BUILT

DATE: 04/10/2023

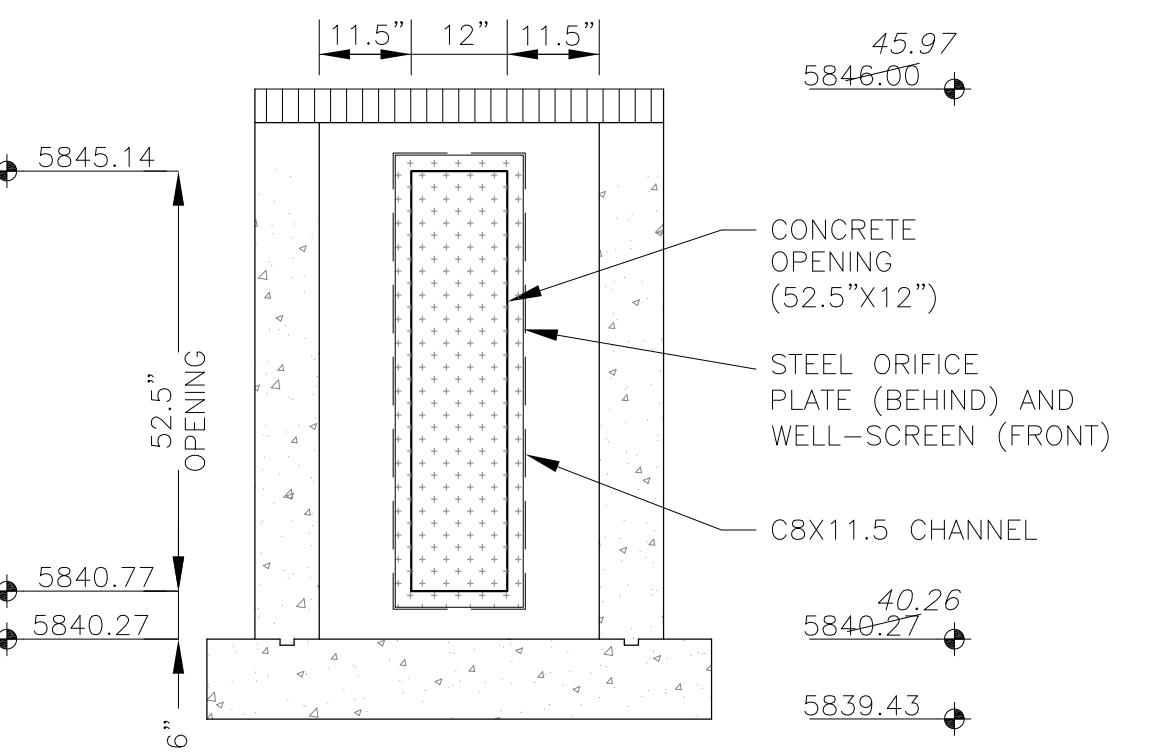

OUTLET STRUCTURE DETAIL - SECTION B-B  
NO SCALE

<h1>CORE</h1> <hr/> <h1>ENGINEERING GROUP</h1>	<p>15004 1ST AVENUE S. BURNSVILLE, MN 55306 PH: 719.570.1100 CONTACT: RICHARD L. SCHINDLER, P.E. EMAIL: Rich@ceg1.com</p>
<p>FOR: - ORSON, LLC . WAHSATCH AVE, SUITE 301 O SPRINGS, COLORADO 80903 (719) 635-3200 CONTACT: JEFF MARK</p>	<p>NOV 30, 2021</p>

**PREPARATION**

**212 COLOR**

RE:	PROJECT: THE RIDGE AT LORS RANCH	
1.	MODIFY CIRCULAR HOLES IN ORIFC	
DRAWN:	RLS	

DRAWN: RLS  
DESIGNED: RLS  
CHECKED: RLS

---

# OUTLET STRUCTURE DETAILS

## WQ POND

## POND F

A circular blue ink stamp. The outer ring contains the text "COLORADO REGISTERED PROFESSIONAL ENGINEER". Inside the ring, the number "33997" is stamped vertically. In the center, the date "11/15/2021" is stamped diagonally.

DATE:

NOV 5, 2021

---

100.064

SHEET NUMBER  
**C9.6**