



① FRONT ELEV. OPTION 1B
1/8" = 1'-0"

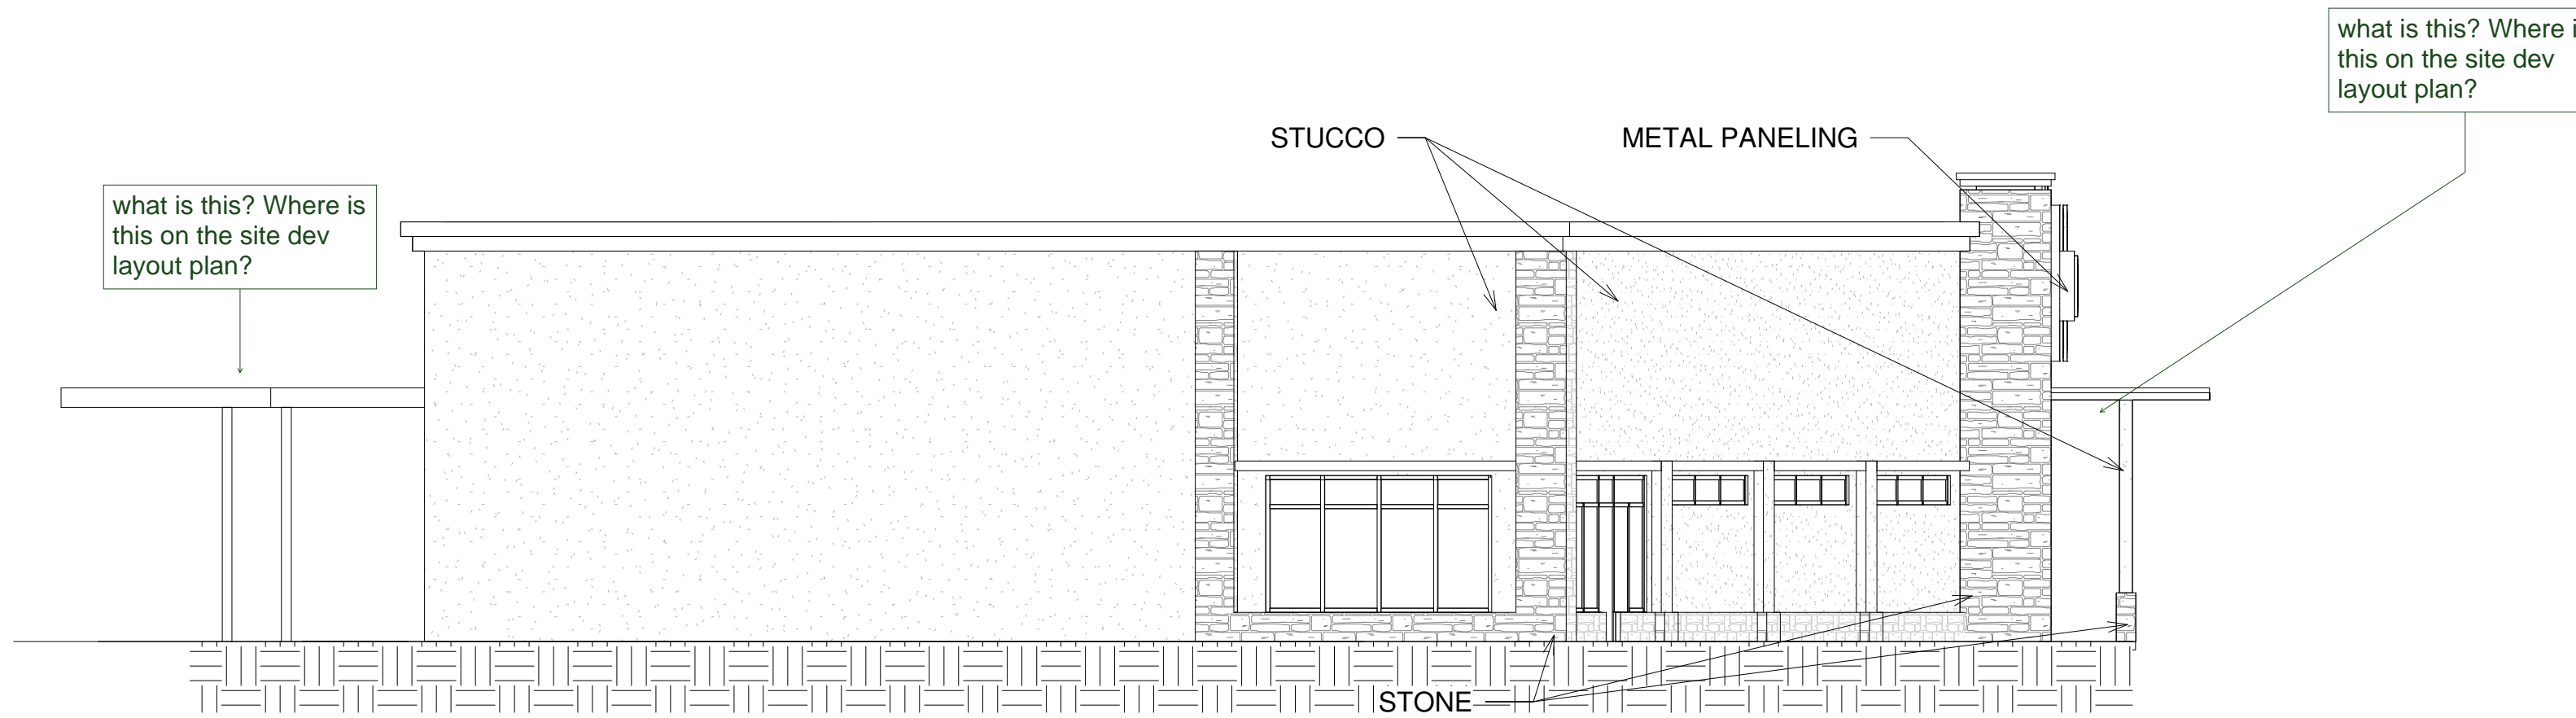


② LEFT ELEV. OPTION 1B
1/8" = 1'-0"

Please provide elevation details

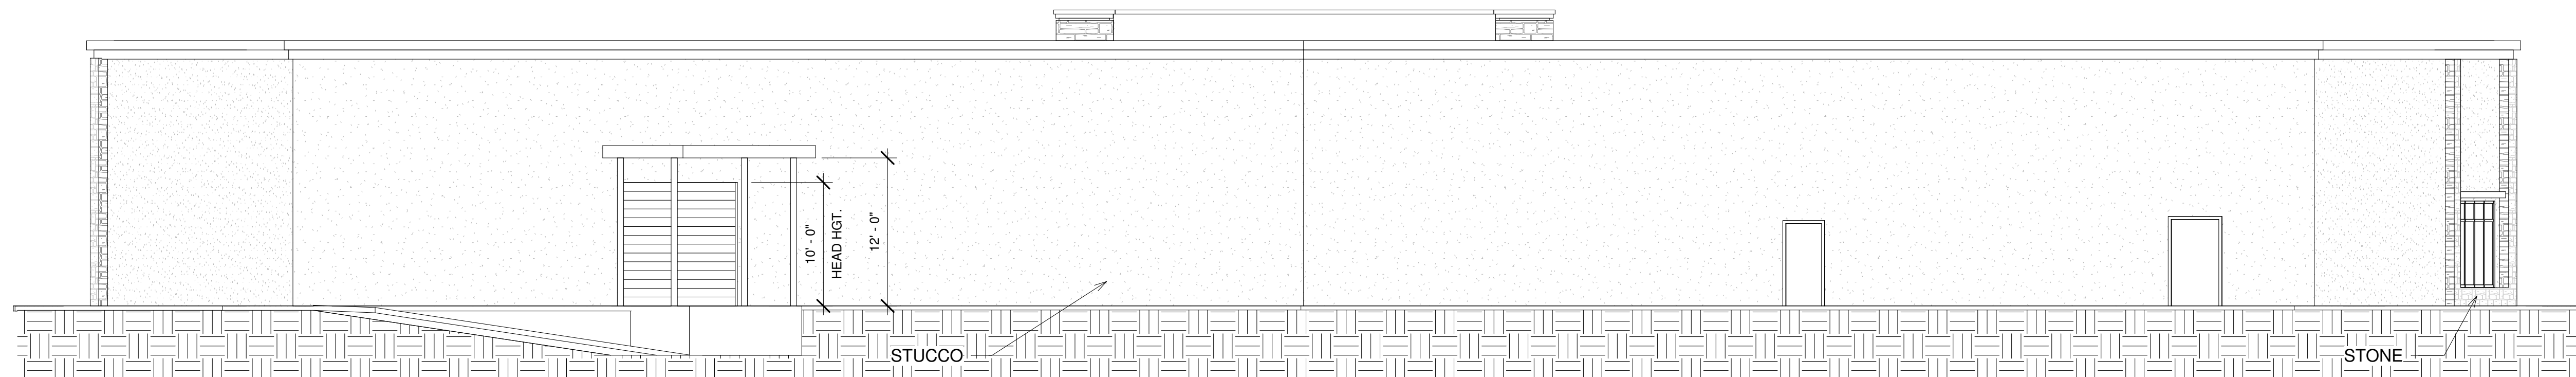

③ REAR ELEV. OPTION 1B
1/8" = 1'-0"

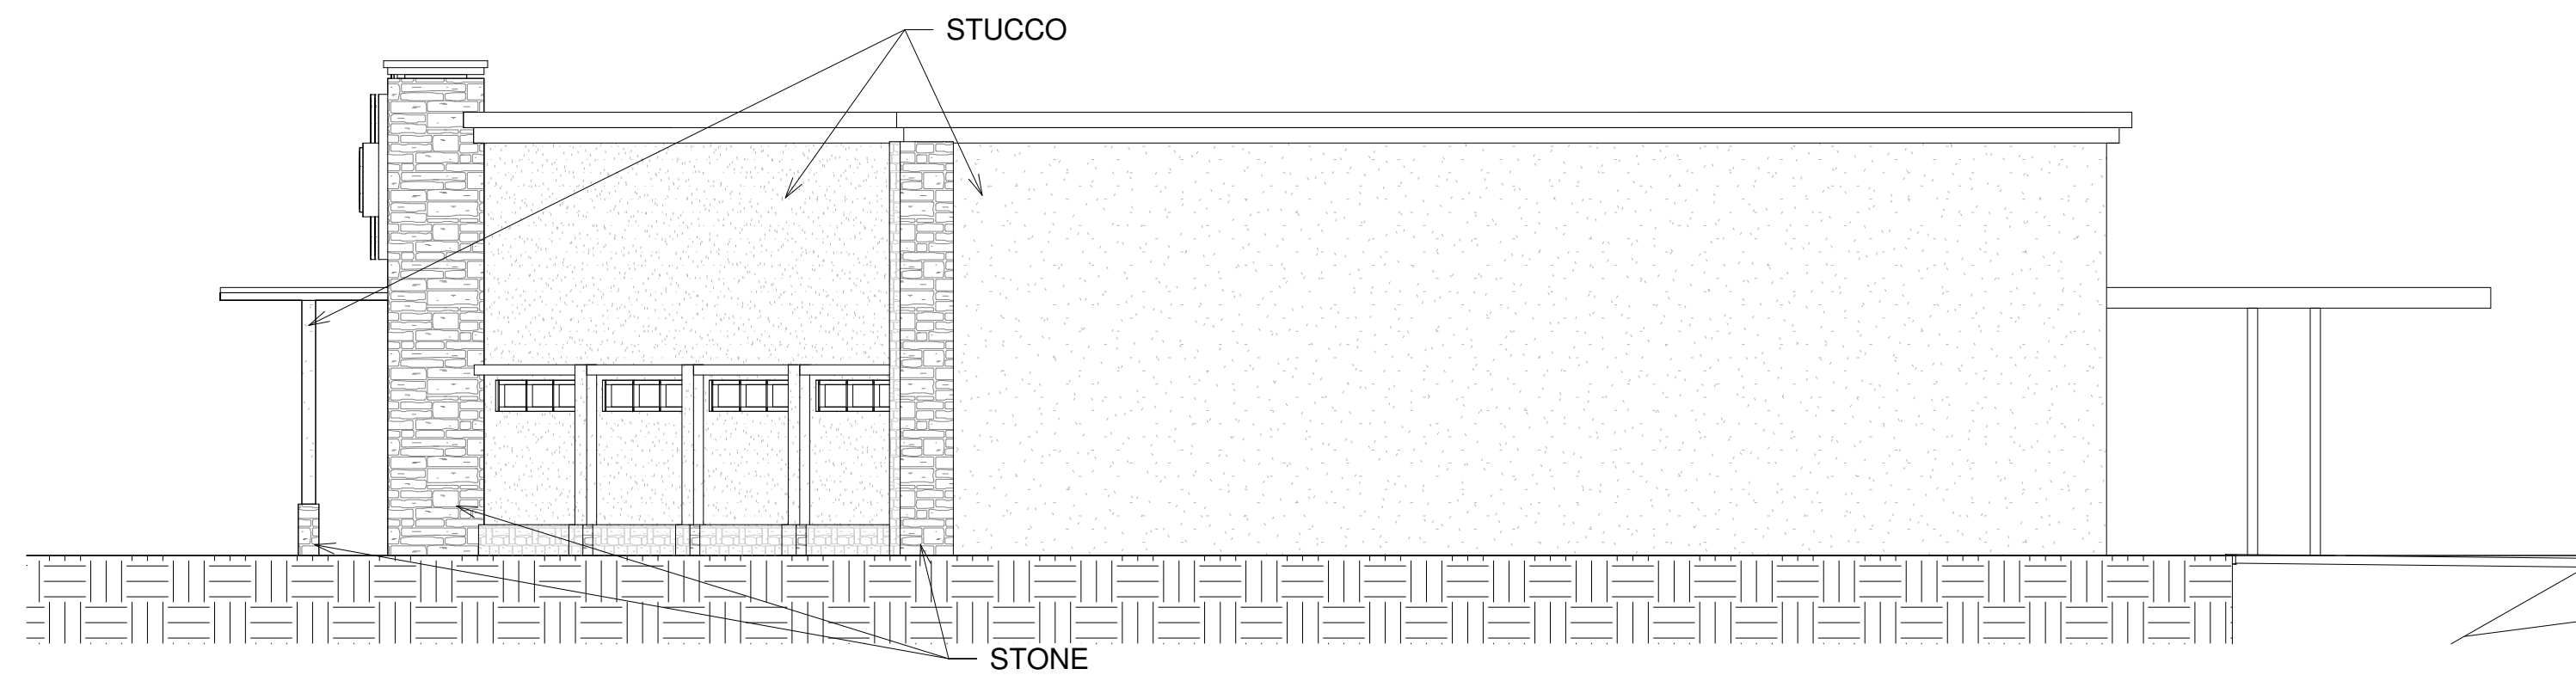

④ RIGHT ELEV. OPTION 1B
1/8" = 1'-0"

REVISIONS		
DATE	FOR	

TremmelDesignGroup

201 East Las Animas Street, Suite 113
Colorado Springs, CO 80903
719.623.5641 (Phone)
719.623.5643 (Fax)

FALCON LANDING
7344 MCLAUGHLIN ROAD
FALCON, COLORADO 80831

Option 1B
Elevations

DATE: Issue Date

DRAWN BY: Author

CHECKED BY: Checker

PROJECT NO.:

SHEET:

A104

Markup Summary


dsdparsons (4)



Please provide elevation details

Subject: Callout
Page Label: 1
Author: dsdparsons
Date: 12/12/2018 3:53:08 PM
Color: ■

Please provide elevation details

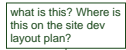


what is this? Where is this on the site dev layout plan?



Subject: Callout
Page Label: 1
Author: dsdparsons
Date: 12/13/2018 9:31:47 AM
Color: ■

what is this? Where is this on the site dev layout plan?

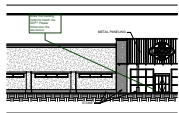

Subject: Callout
Page Label: 1
Author: dsdparsons
Date: 12/13/2018 9:32:53 AM
Color: ■

Does this building footprint match the SDP?
Please Dimension the elevations.



what is this? Where is this on the site dev layout plan?



Subject: Callout
Page Label: 1
Author: dsdparsons
Date: 12/13/2018 9:34:06 AM
Color: ■

what is this? Where is this on the site dev layout plan?