


update, needs to be
INDEPENDENCE
PLACE AT
CHEYENNE
MOUNTAIN FIL NO 1


Eldorado Springs at Cheyenne Mountain Fil. No. 1

ADMINISTRATIVE SITE DEVELOPMENT PLAN - ARCHITECTURAL FOOTPRINTS


MAY, 2019

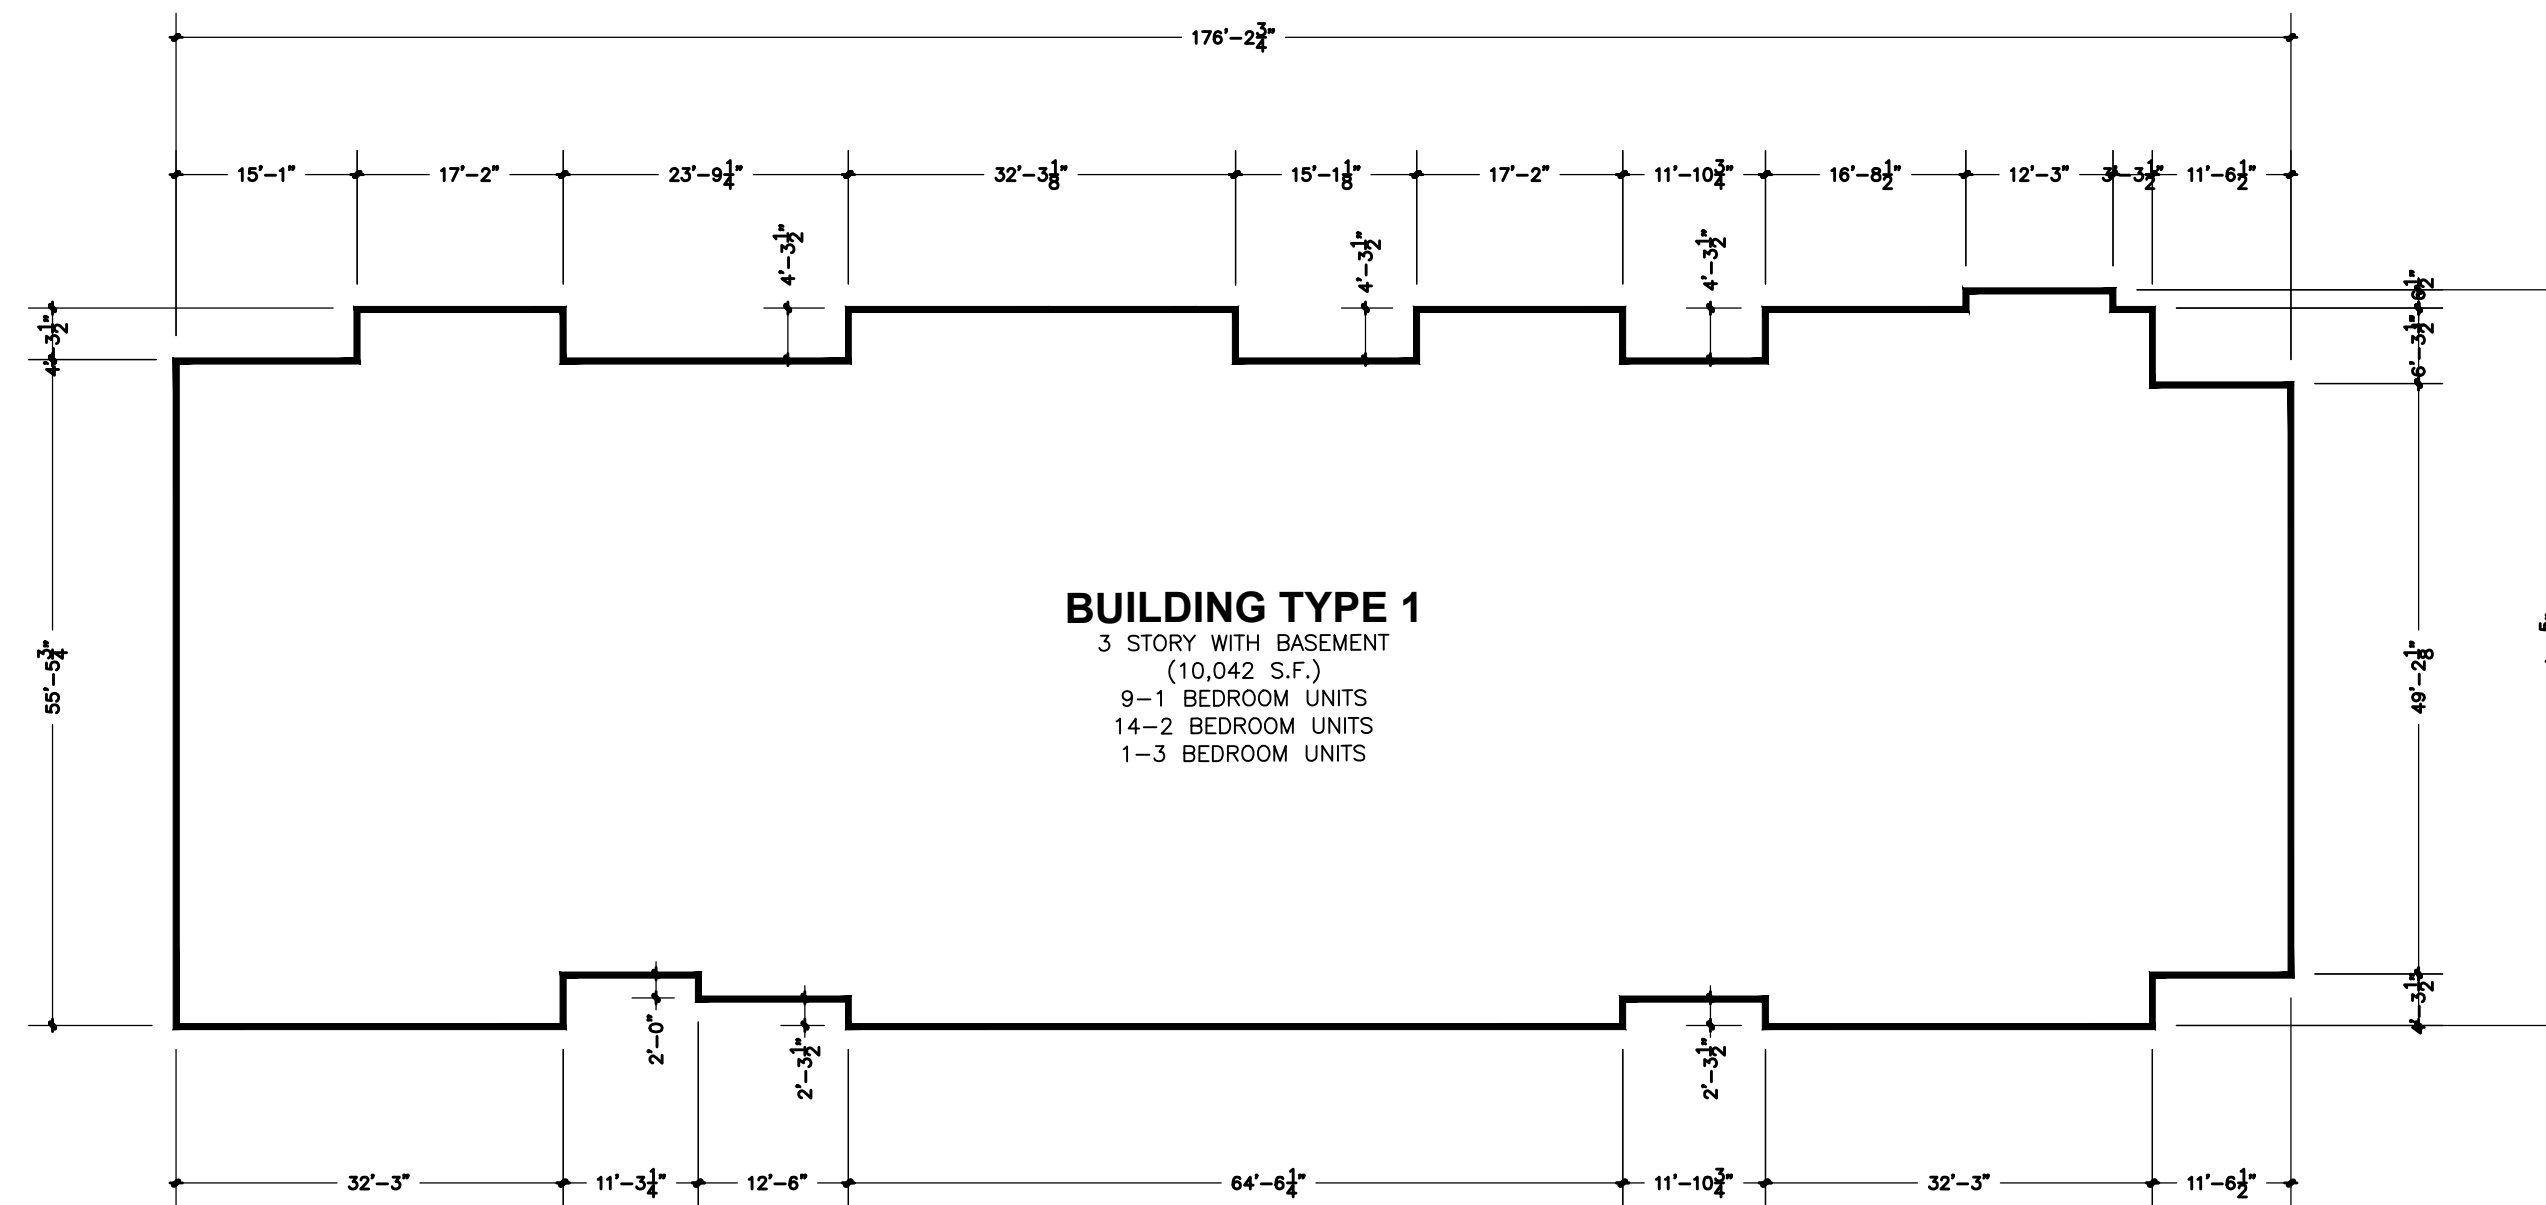


1 BUILDING TYPE 1 FOOTPRINT
SCALE: 1/16"=1'-0"

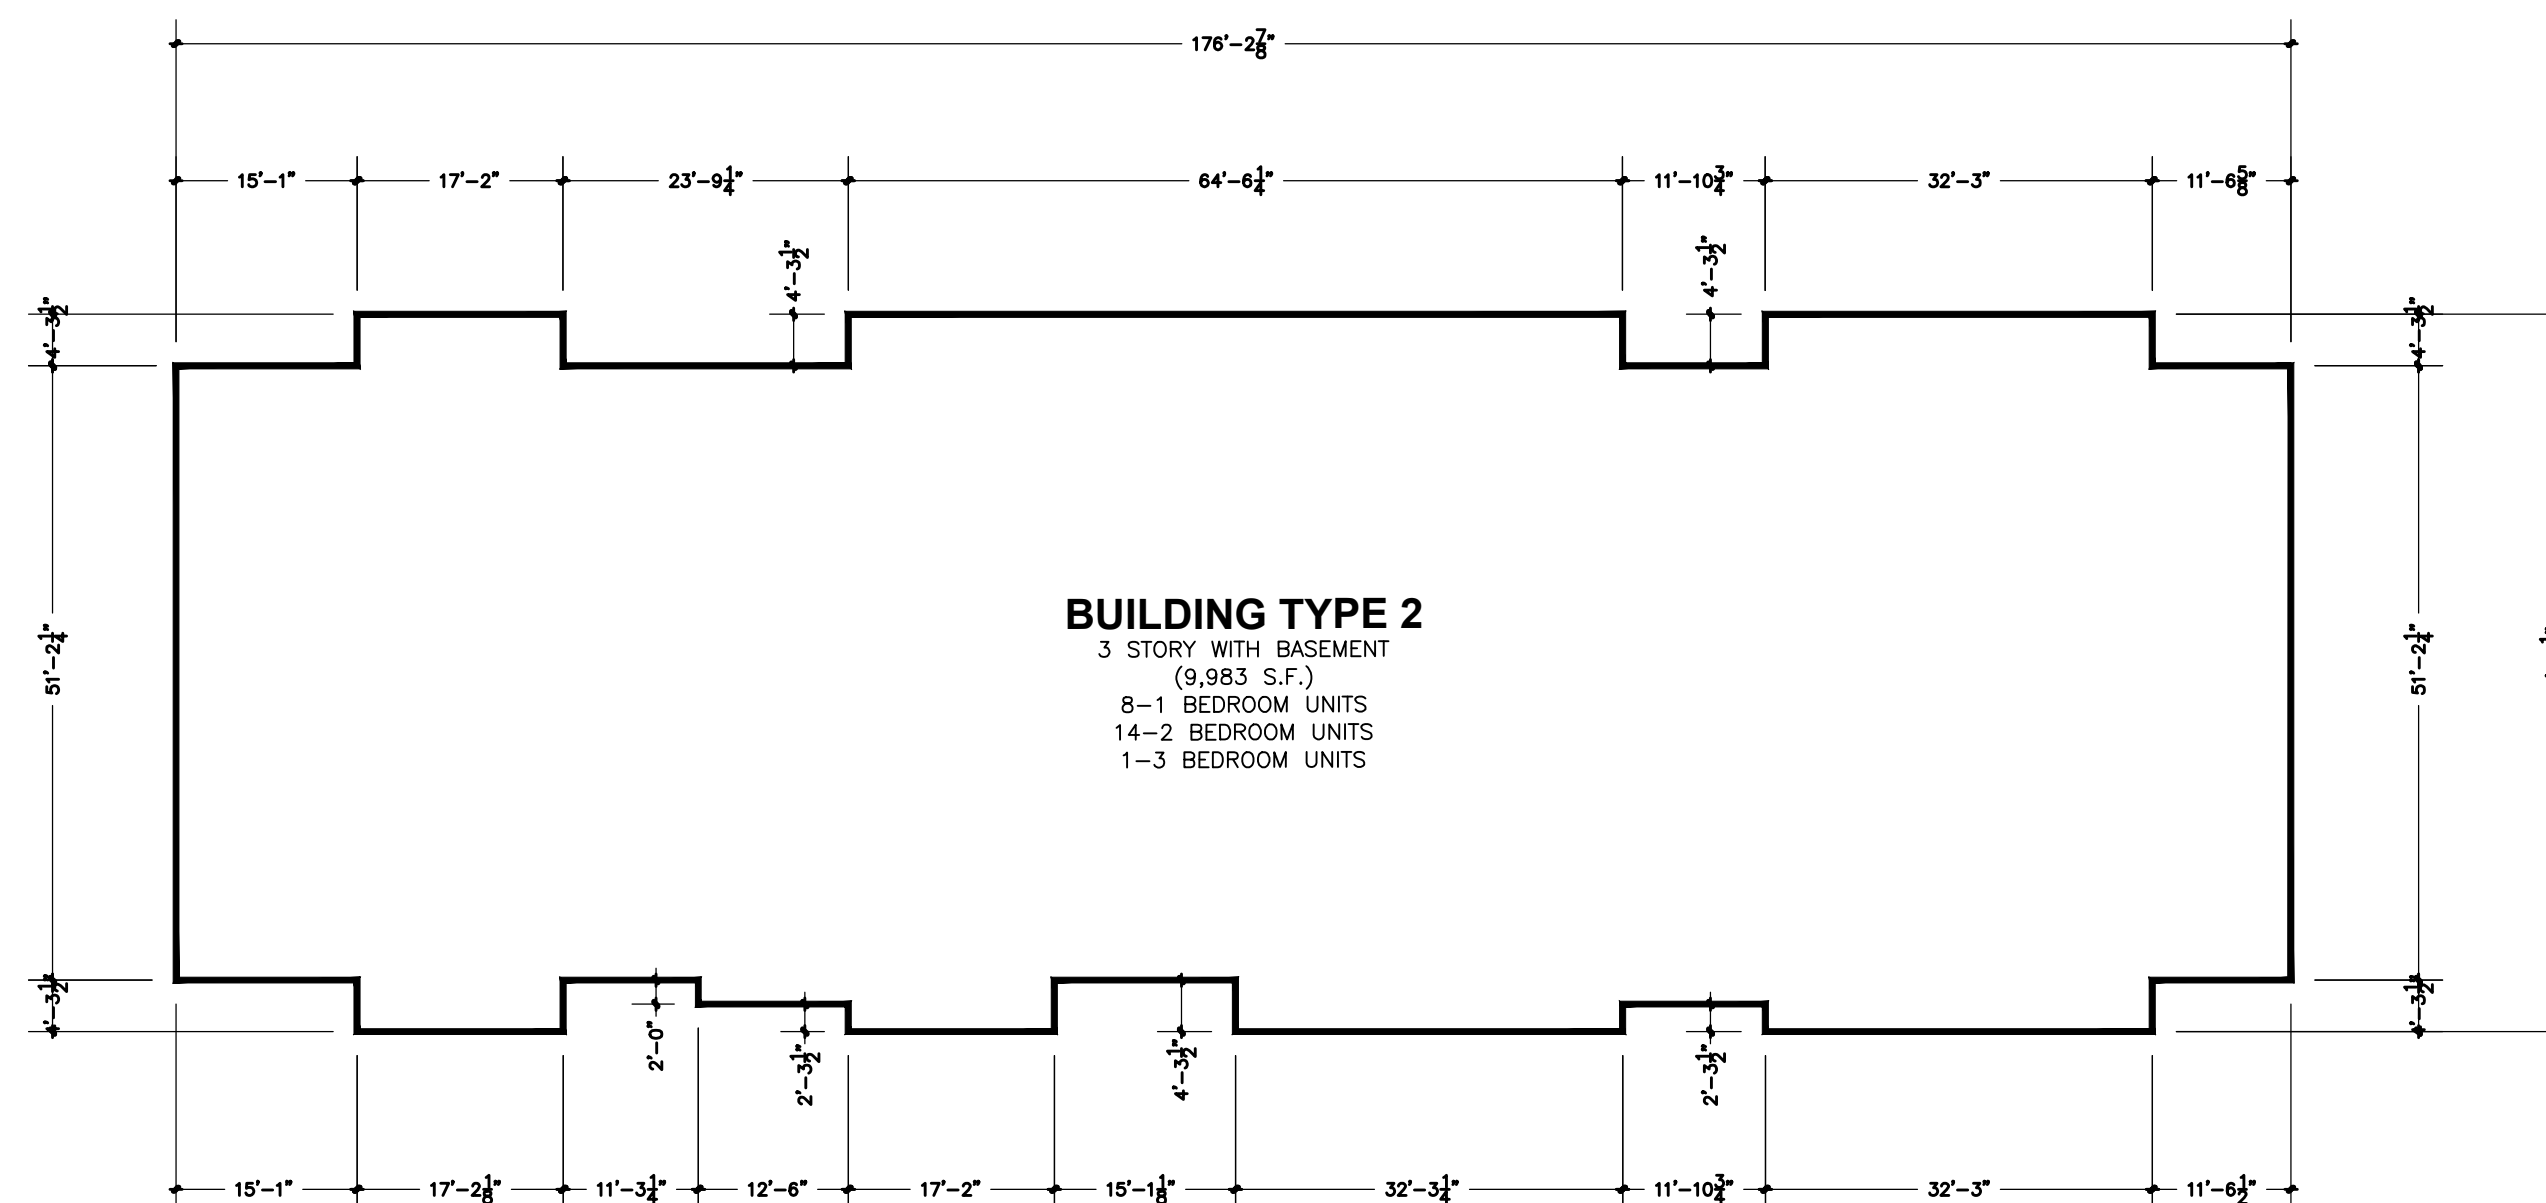

2 BUILDING TYPE 2 FOOTPRINT
SCALE: 1/16"=1'-0"

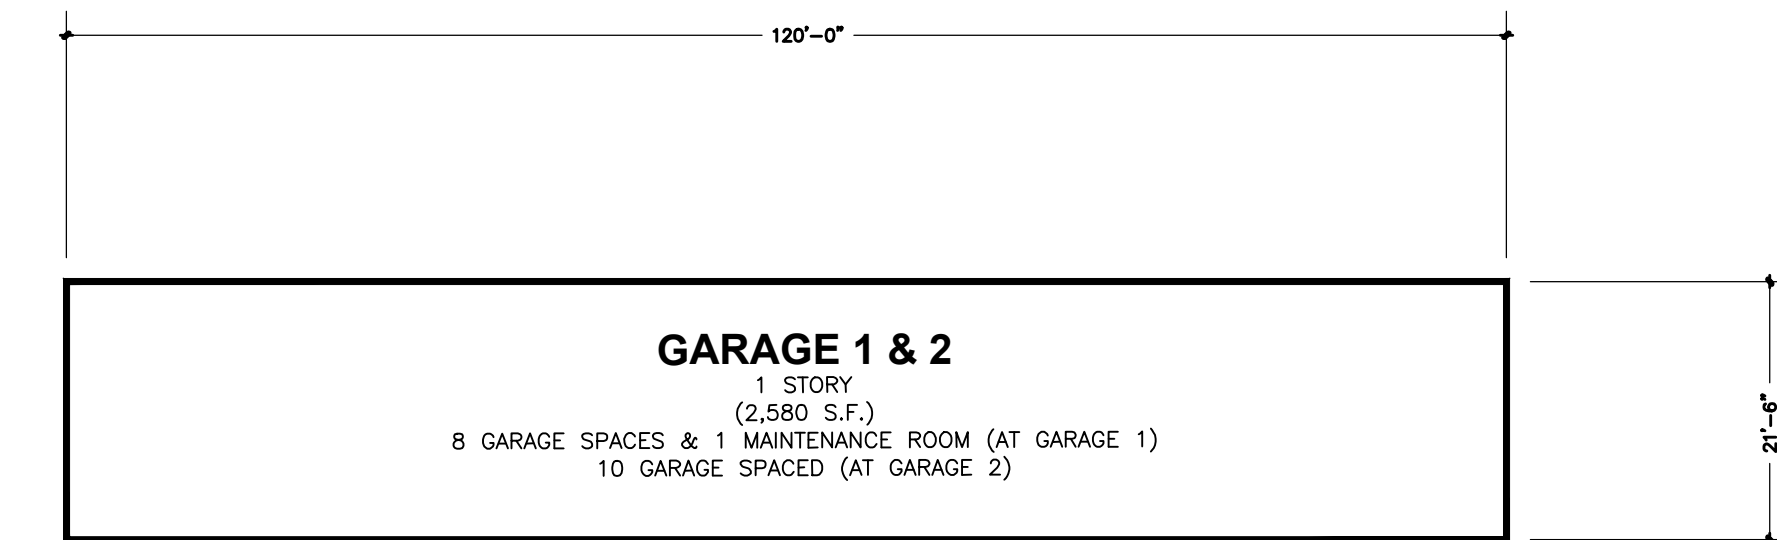


3 GARAGE 1 FOOTPRINT
SCALE: 1/16"=1'-0"

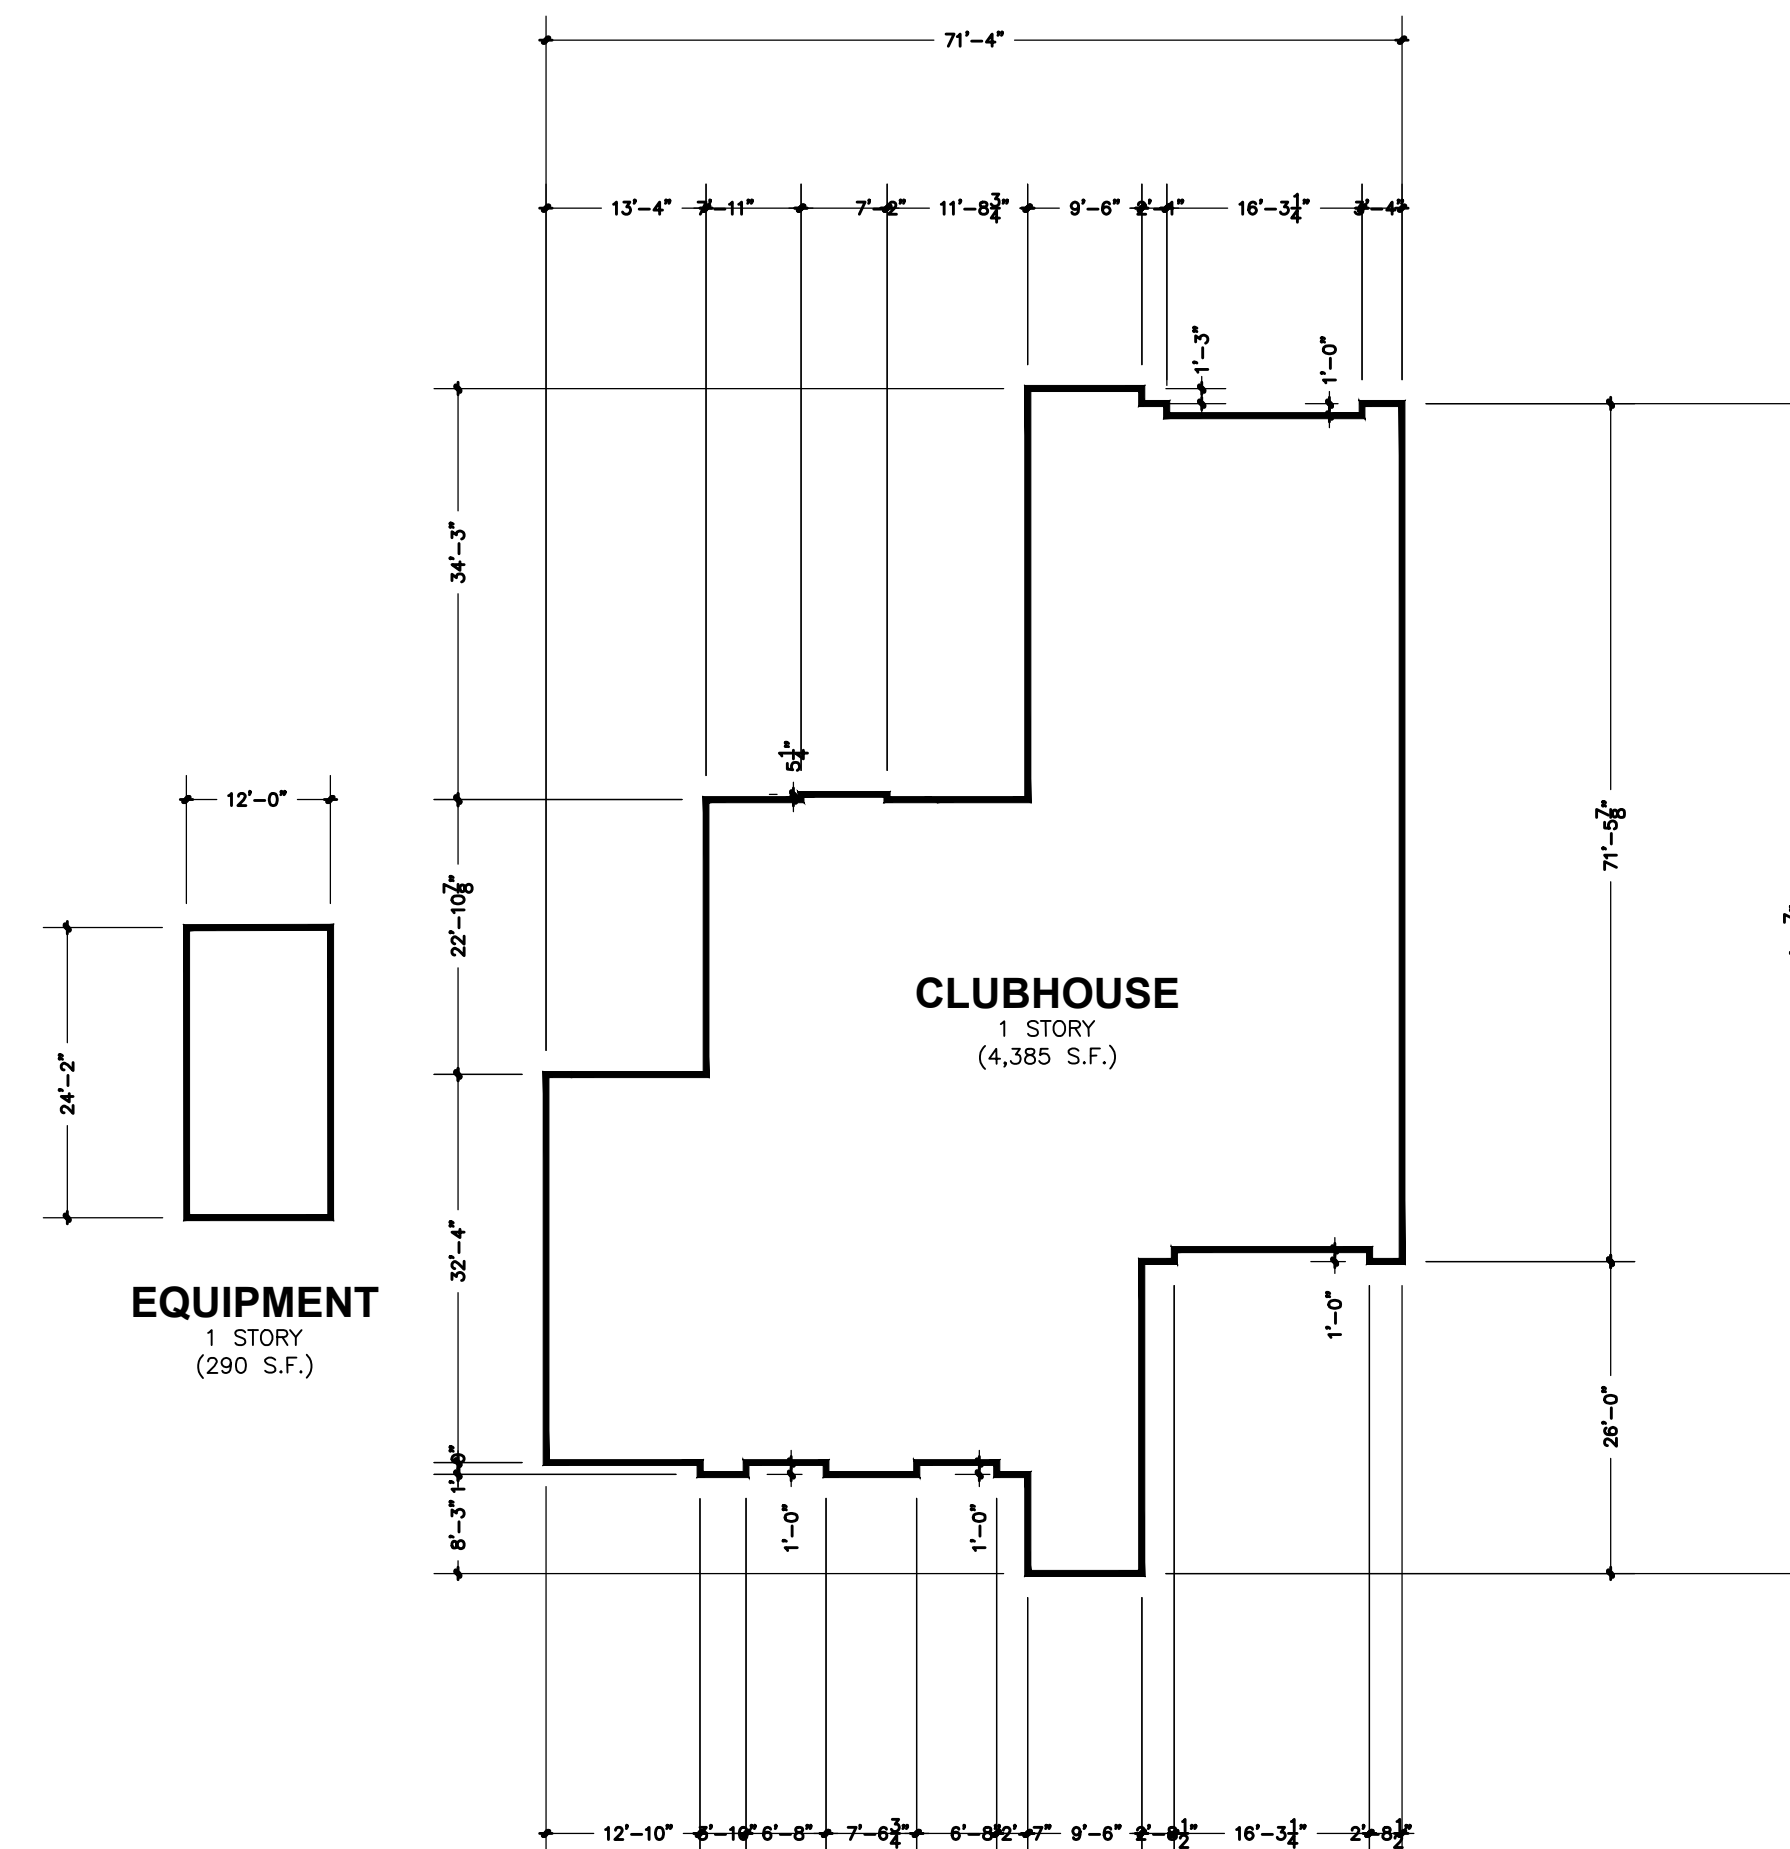

4 CLUBHOUSE & EQUIPMENT FOOTPRINT
SCALE: 1/16"=1'-0"

Footprints_V2.pdf Markup Summary

Locked (1)

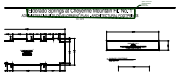

Subject: Cloud+
Page Label: 1
Lock: Locked
Author: dsdsevigny
Date: 12/17/2019 1:46:57 PM
Status:
Color:
Layer:
Space:

update, needs to be INDEPENDENCE PLACE AT
CHEYENNE MOUNTAIN FIL NO 1