


Please include a legend for linework on all field as-built drawings. Identify if the green lines are design or as-built contours.

These are as-built drawings provided by the surveyor. Only as-built contours are shown. All linework is labeled.

Please show design elevations and as-built elevations on all field as-built drawings.


Addressed  
Please label contours

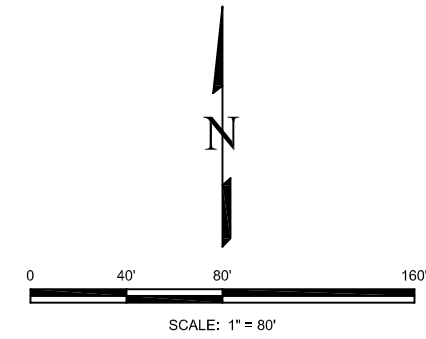

POND 1  
FINAL ASBUILT  
FIELD DATA COMPLETED 5-17-23

These are as-built drawings provided by the surveyor, a note has been added clarifying that these show the as-built conditions only. Please see our "as-built plans" which include both the design condition and as-built condition.


Please see comments on page 2/36.

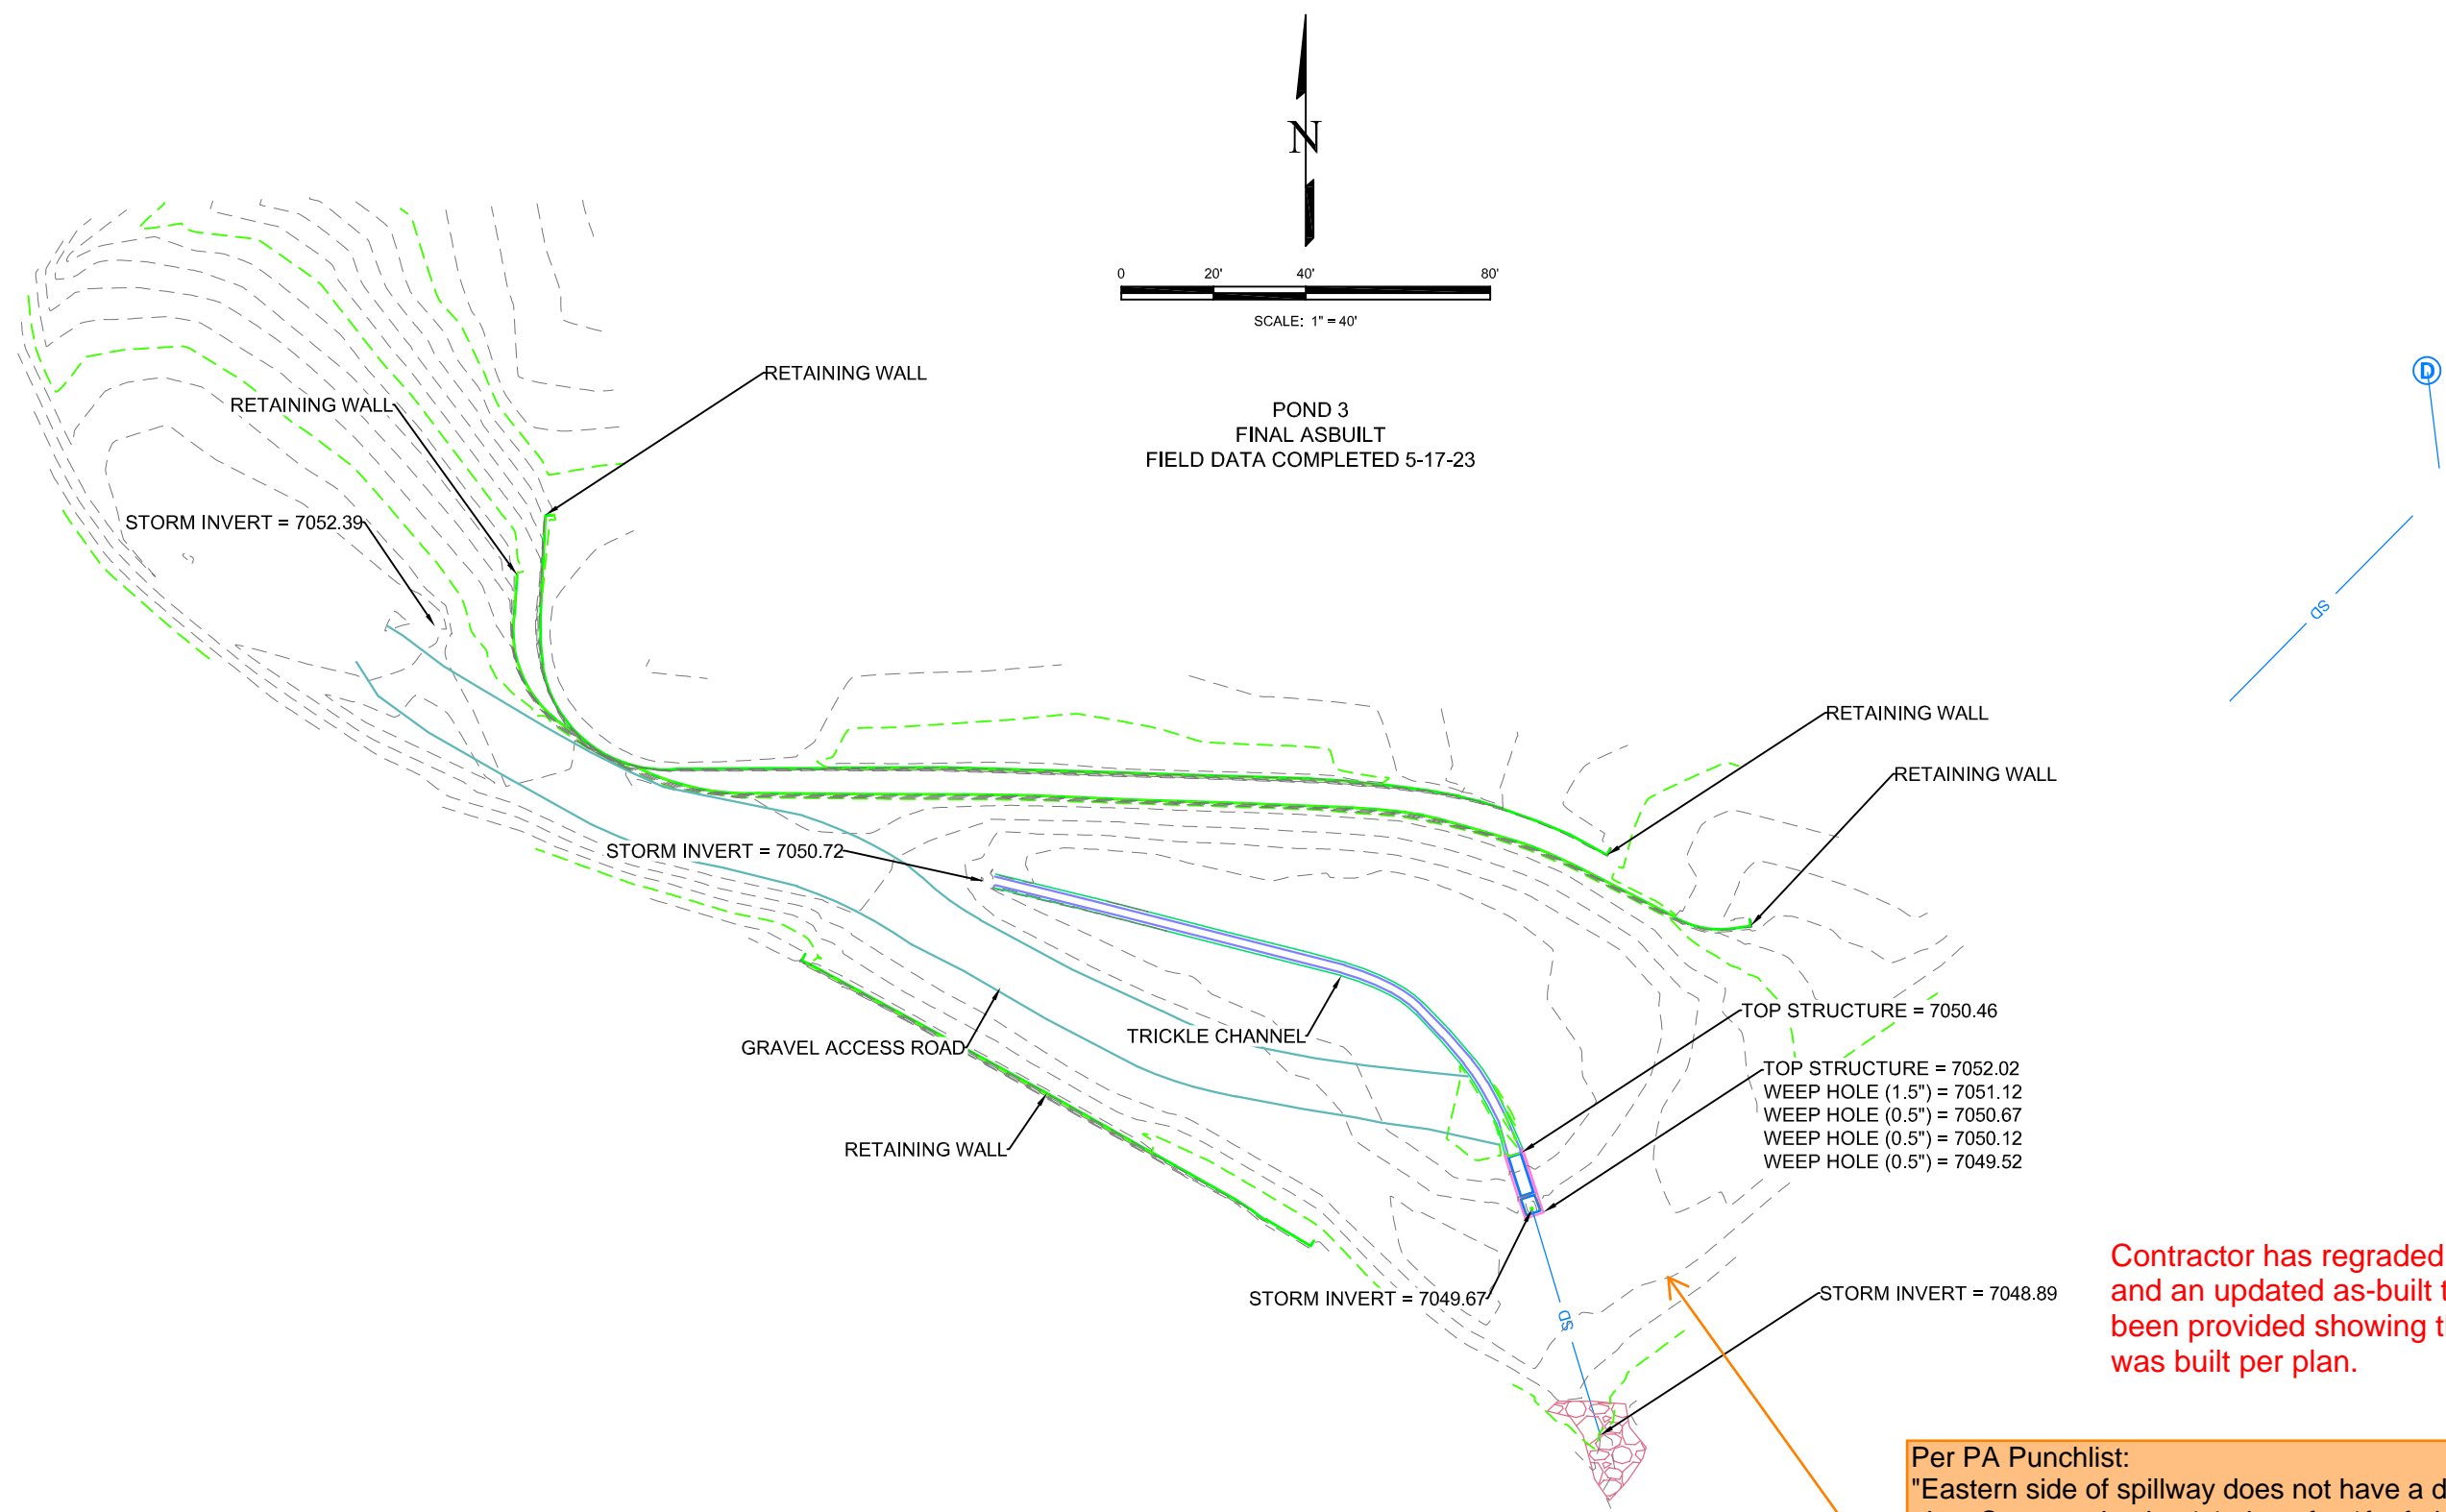

Contractor has regraded this area, and an updated as-built topo file has been provided showing the spillway was built per plan.

Per PA Punchlist:  
"Eastern side of spillway does not have a discernible embankment per plan. Supposed to be 4:1 slope for 1ft of elevation. Elevations of spillway crest or embankment likely not built per plan. Construct per plan."  
Or come up with a suitable alternative spillway design that is at an acceptable depth and properly armored.

Please see comments on page 2/36.

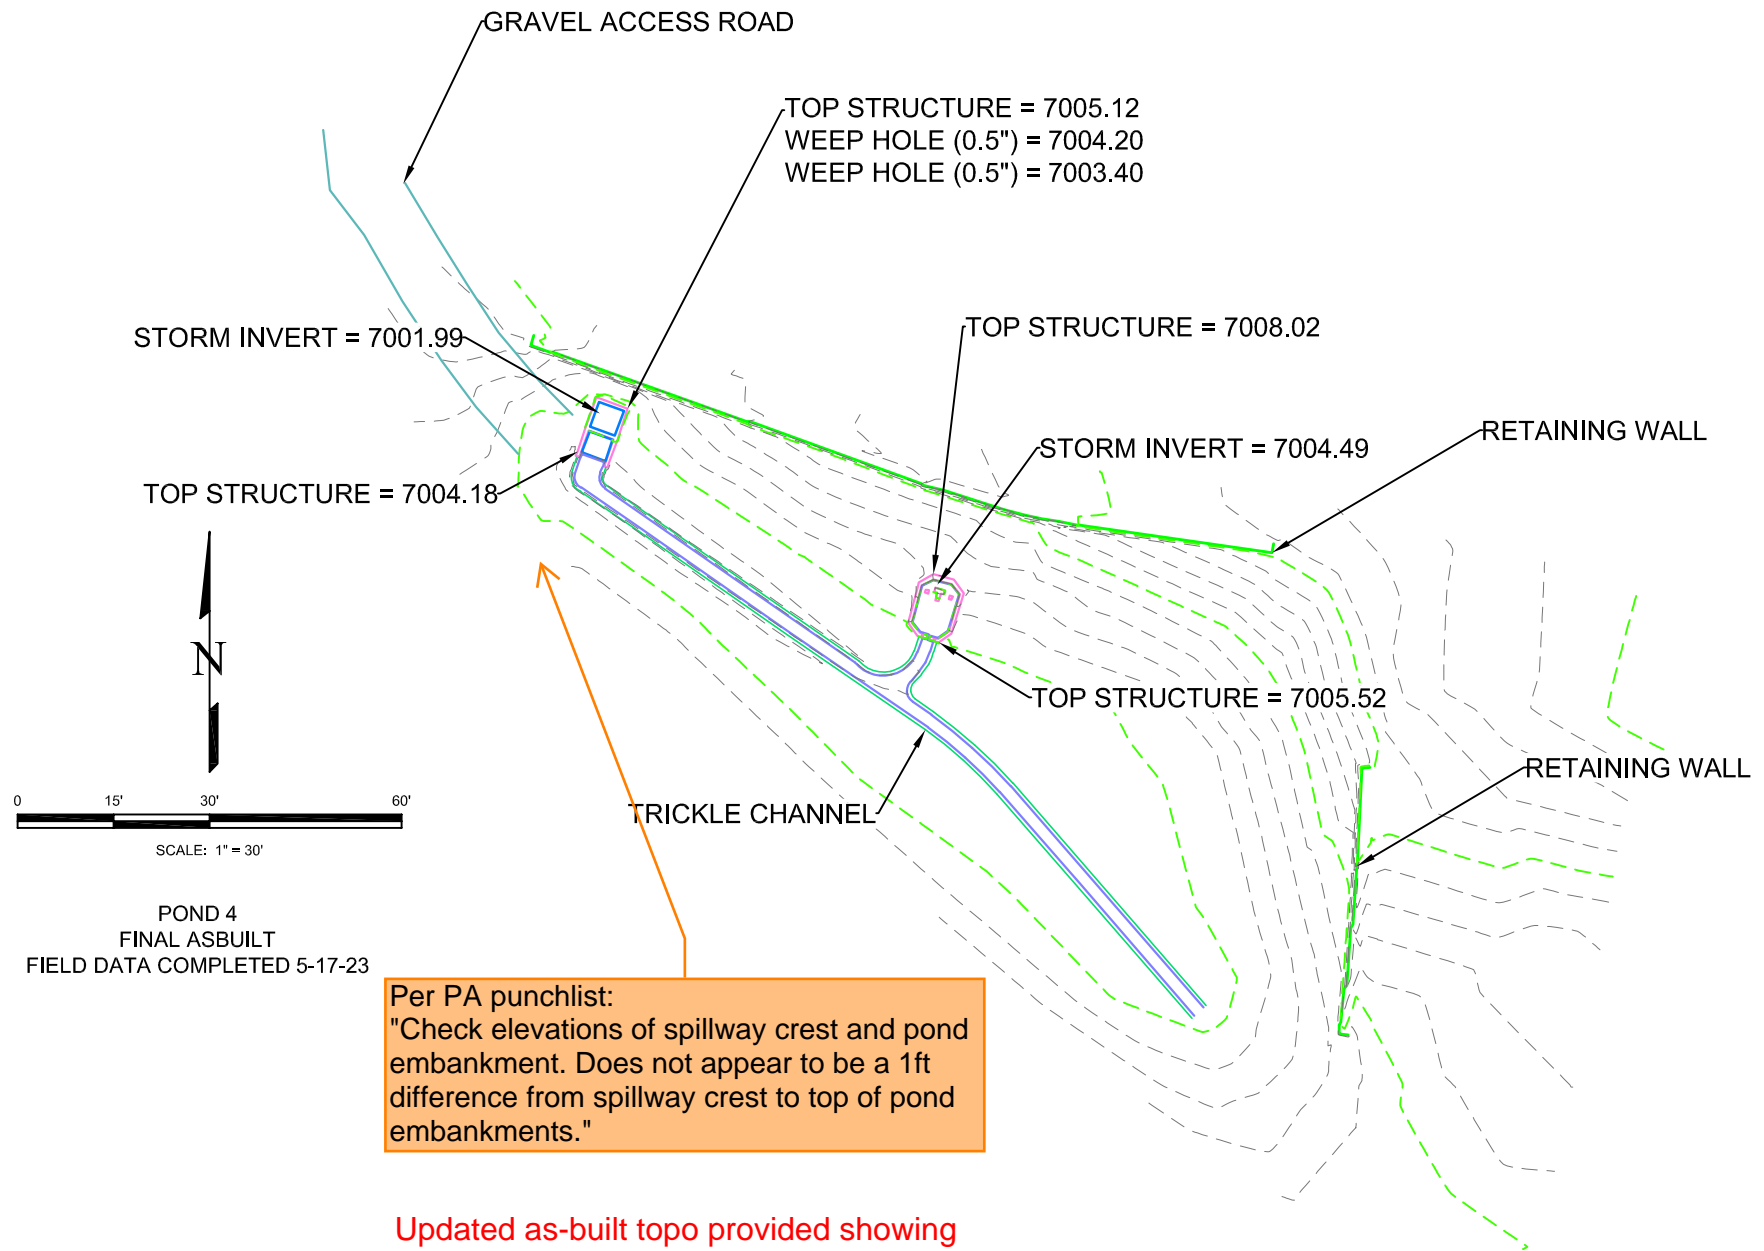

POND 4  
FINAL ASBUILT  
FIELD DATA COMPLETED 5-17-23

Per PA punchlist:  
"Check elevations of spillway crest and pond embankment. Does not appear to be a 1ft difference from spillway crest to top of pond embankments."

Updated as-built topo provided showing more than a foot between top of pond and spillway crest after contractor regraded this area to plan.

