


Please provide a legend with what the LDC requires for Landscaping and what is provided.

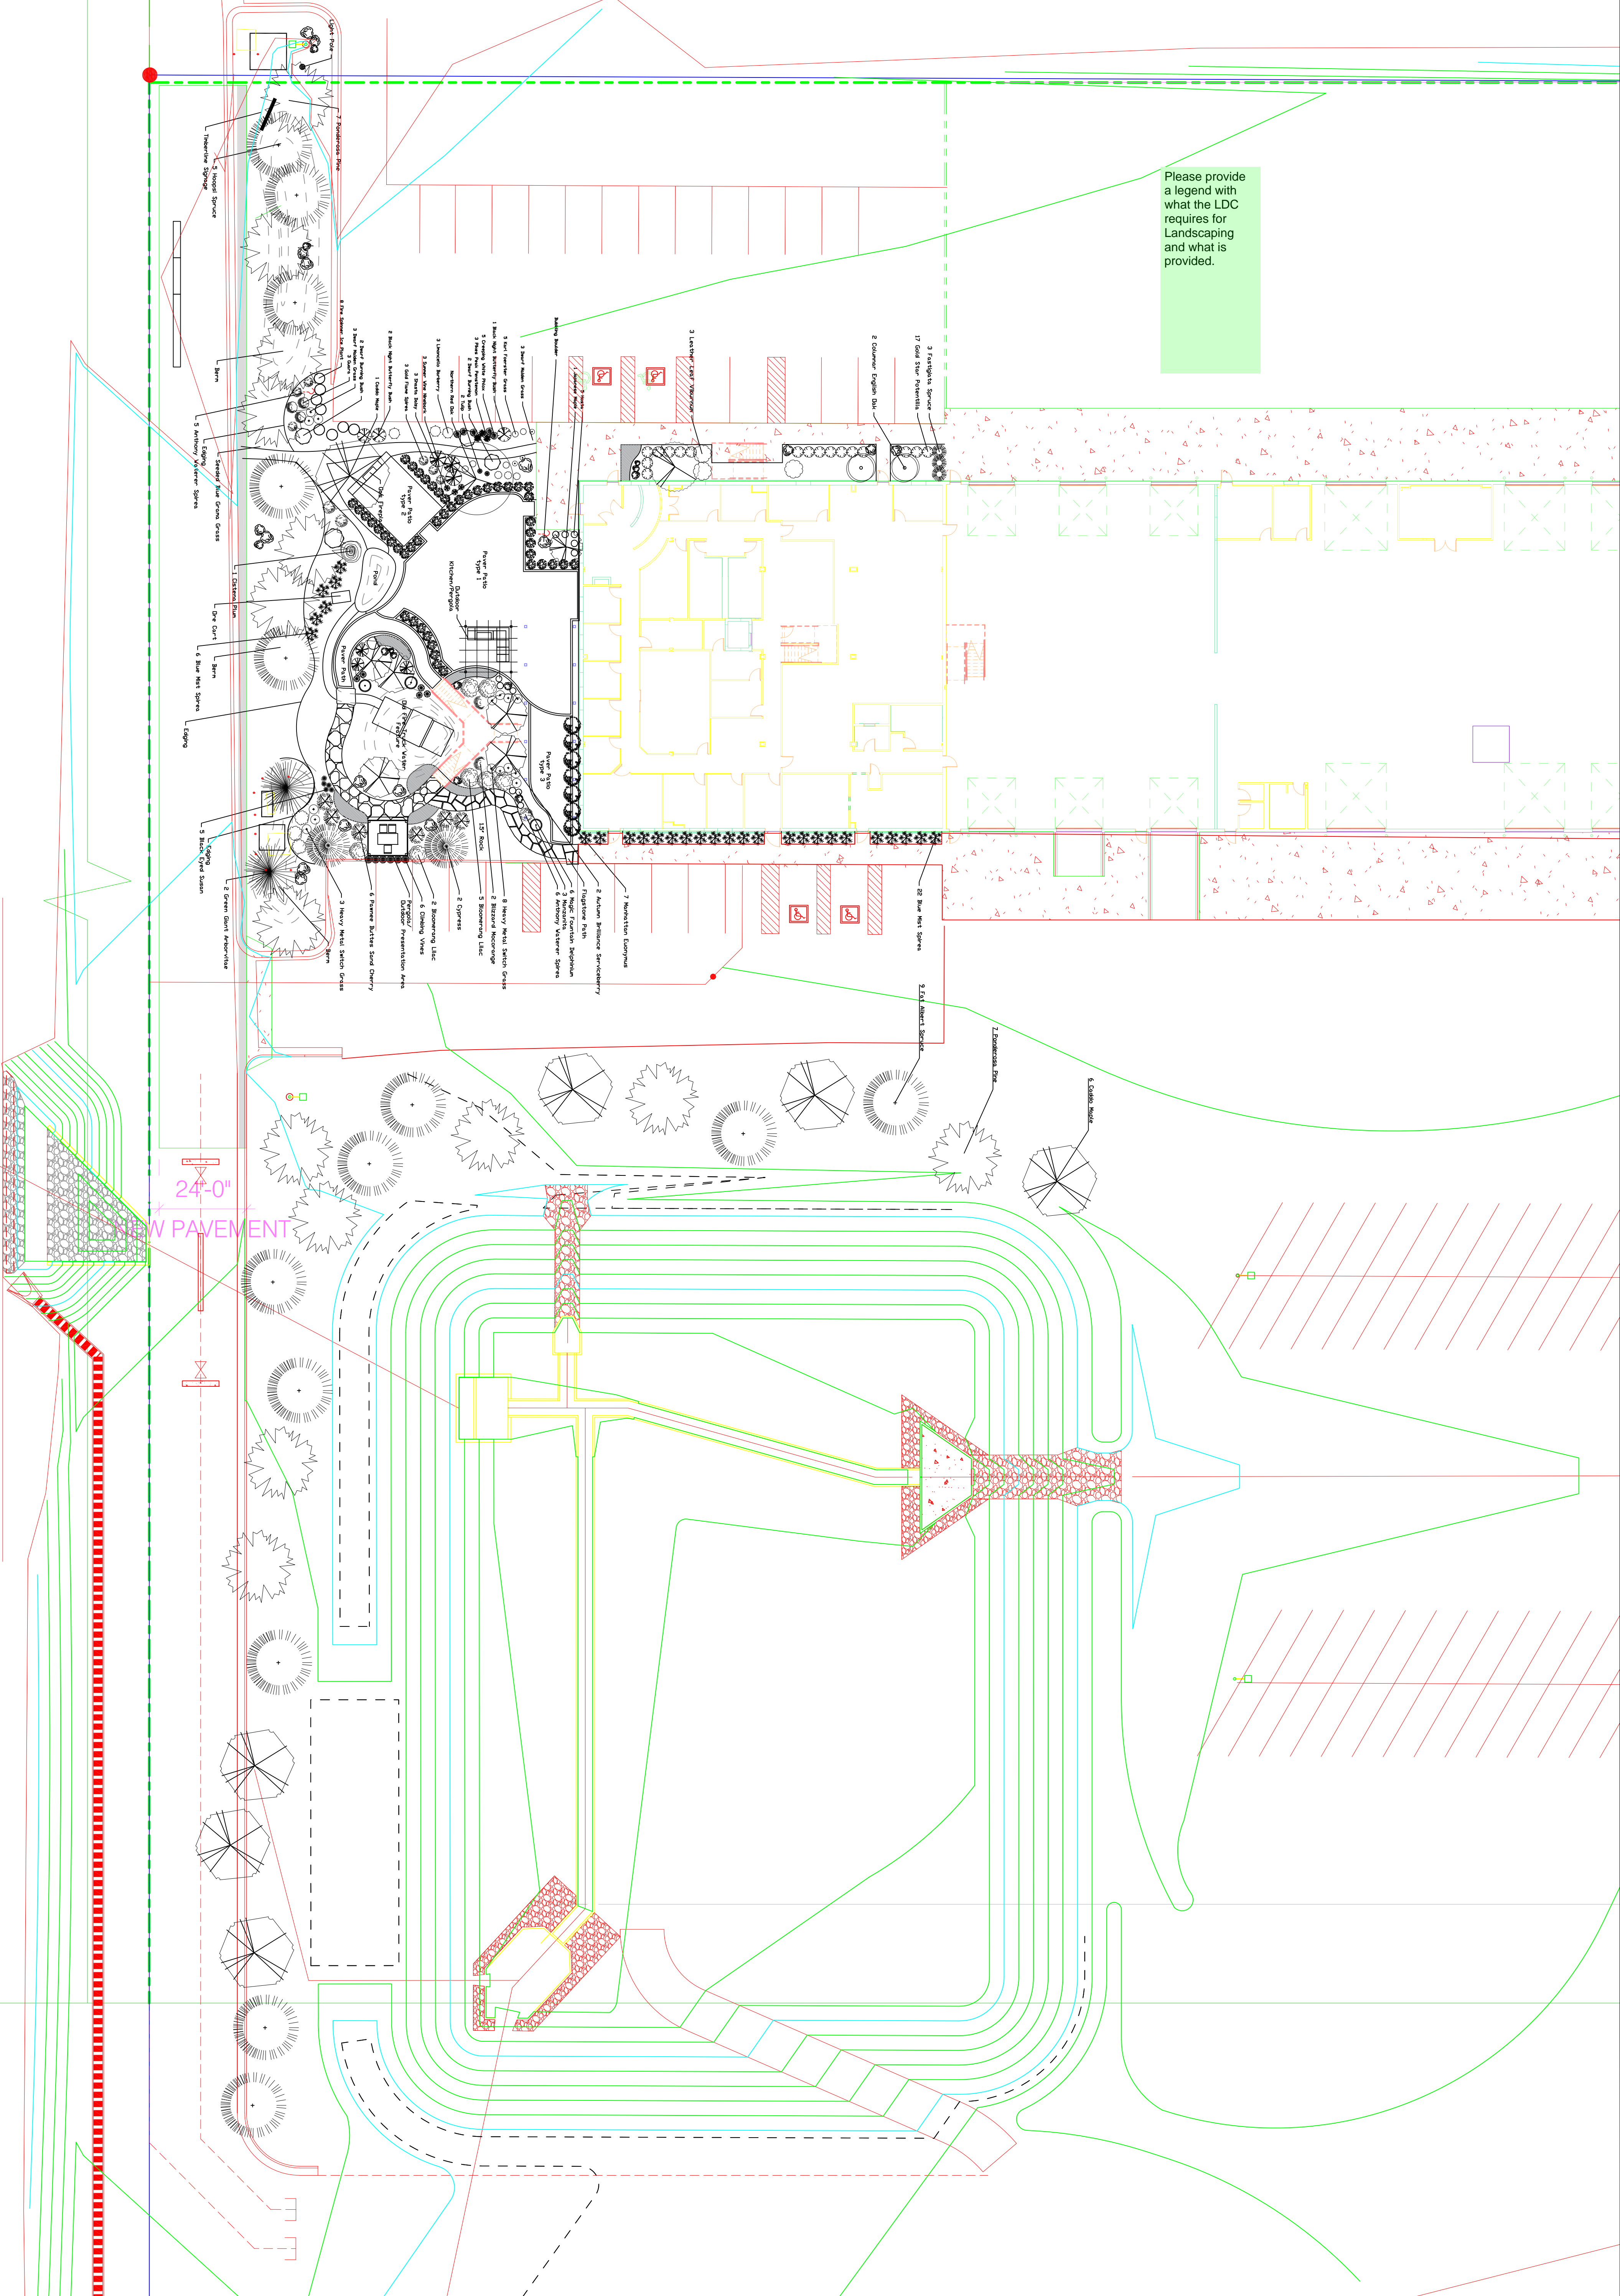

8110 Opportunity View
Colorado Springs, CO 80939
(719) 638-1000 fax (719)
638-1010

Timberline Landscaping, Inc. - Landscape Plan
8110 Opportunity View
Colorado Springs, Colorado 80939

Job #


Designed by: Elysa Engle

Date: 4.10.2019

Revised:

Scale: 1" = 10'

Drawing and the subject matter therein is the property of Timberline Landscaping, Inc. and is not to be copied or disclosed to others without the expressed written permission of Timberline Landscaping, Inc. Any such uses constitutes a purchase of design services from Timberline Landscaping, Inc.

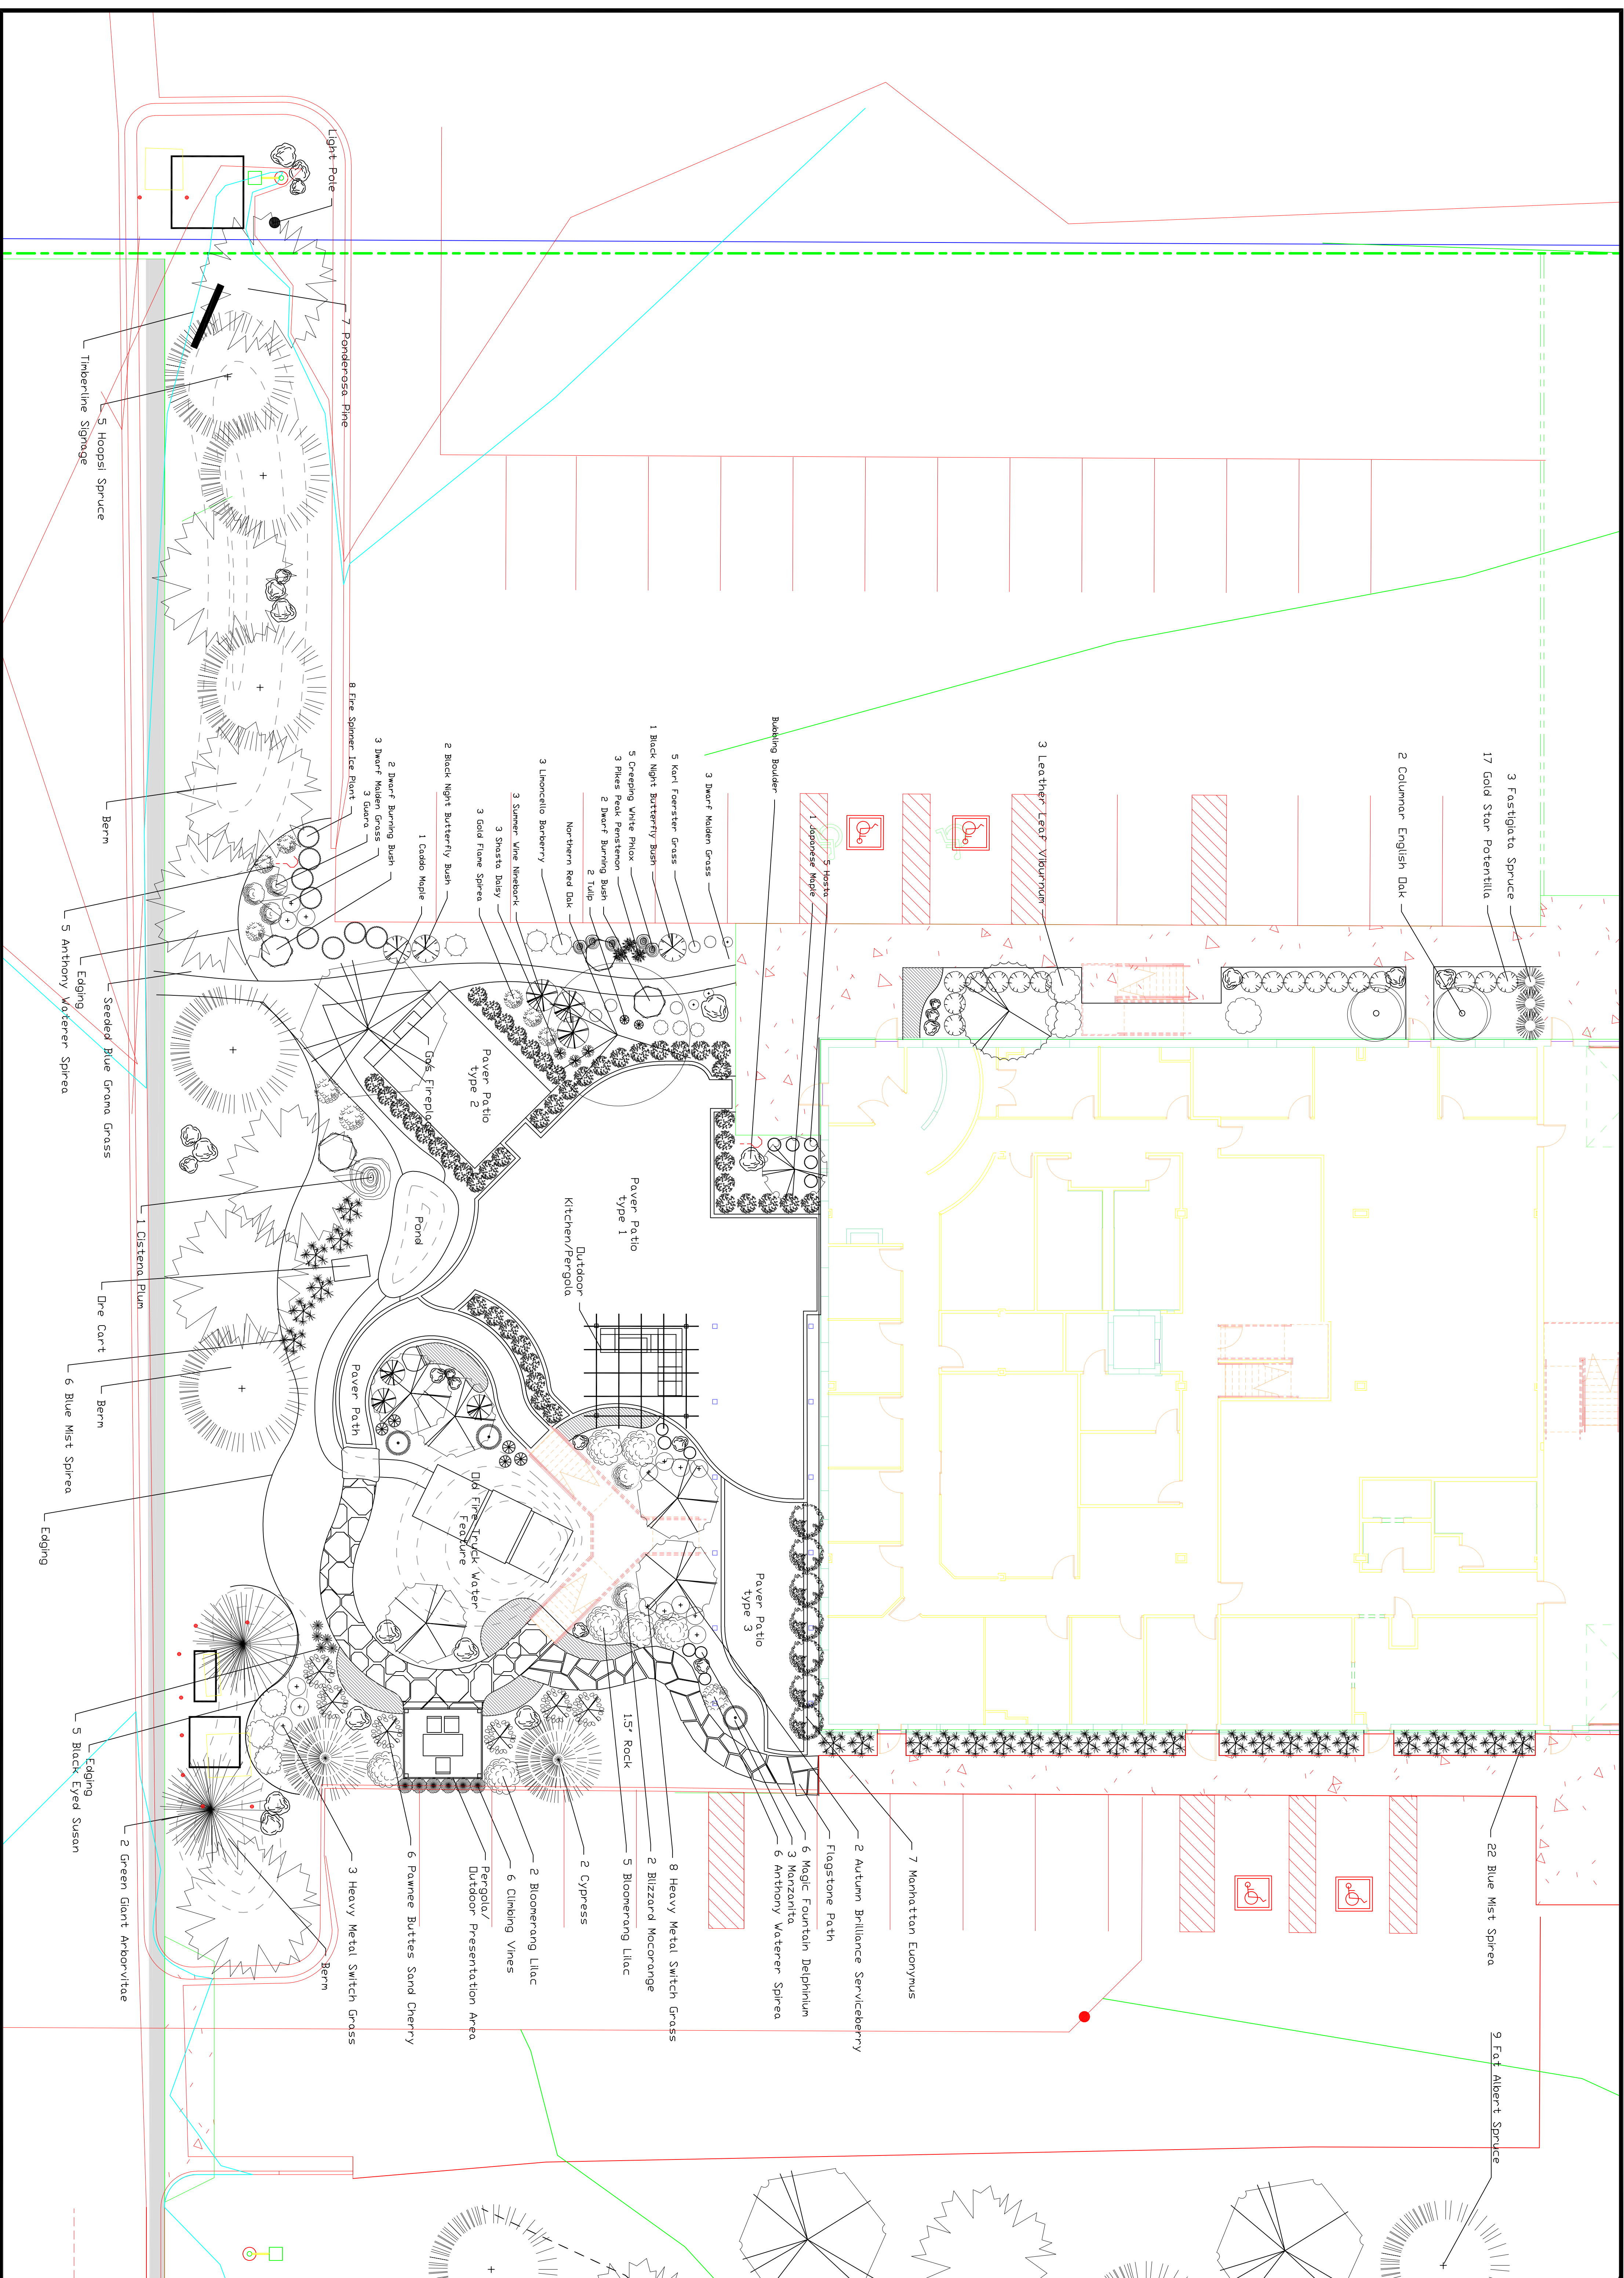

8110 Opportunity View
 Colorado Springs, CO 80939
 (719) 638-1000 Fax (719)
 638-1010

Timberline Landscaping, Inc. - Landscape Plan
 8110 Opportunity View
 Colorado Springs, Colorado 80939

Job #

Designed by: Elysa Engle

Date: 4.10.2019

Revised:

Scale: 1" = 10'

Drawing and the subject matter therein is the property of Timberline Landscaping, Inc. and is not to be copied or disclosed to others without the expressed written permission of Timberline Landscaping, Inc. Any such uses constitutes a purchase of design services from Timberline Landscaping, Inc.